



STAGE III AMMONIA AND STAGE II PHOSPHORUS REMOVAL PROJECT METROPOLITAN SYRACUSE WWTP

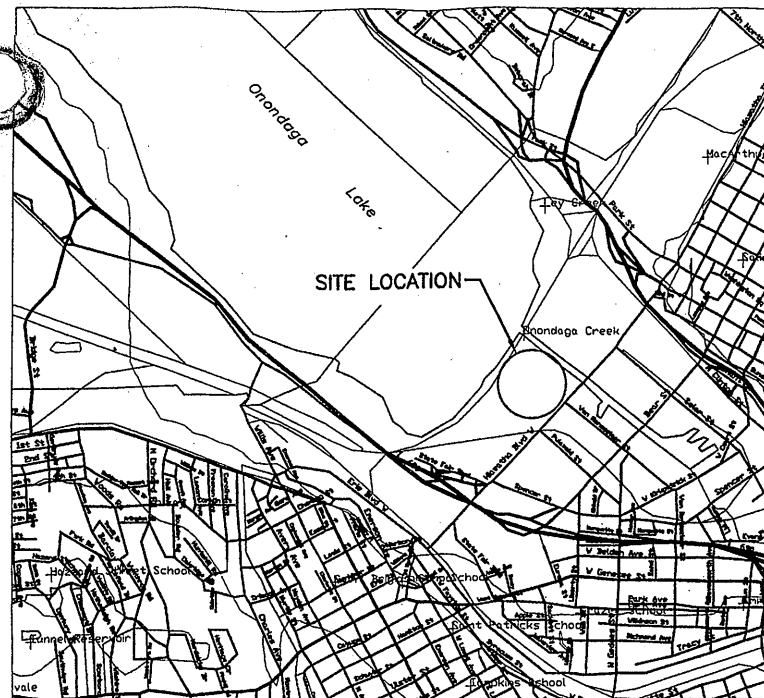

LOCATION PLAN
SCALE: 1"=2000'

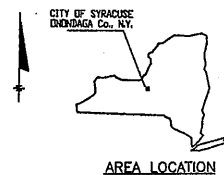

*REC'D
12/21/2005
METRO BOARD COPY
AS-BUILTS*

RICHARD L. ELANDER, PE
COMMISSIONER

DATE

CONTRACT NO. 4A - GENERAL
CONTRACT NO. 4B - ELECTRIC
CONTRACT NO. 4C - HVAC
CONTRACT NO. 4D - PLUMBING & FIRE PROTECTION

BID REFERENCE 4841
PROJECT NUMBER 587961-001

ONONDAGA COUNTY
DEPARTMENT OF DRAINAGE AND SANITATION
SYRACUSE, NEW YORK



AUGUST 2001

GENERAL DRAWINGS

- G-001 INDEX OF DRAWINGS
- G-002 INDEX OF DRAWINGS
- G-003 INDEX OF DRAWINGS
- G-004 GENERAL NOTES, LEGEND & ABBREVIATIONS
- G-005 EXISTING SITE PLAN
- G-006 EXISTING PARTIAL SITE PLAN I
- G-007 EXISTING PARTIAL SITE PLAN II
- G-008 SITE PLAN
- G-009 KEY PLAN - YARD PIPING
- G-010 YARD PIPING - AREA A
- G-011 YARD PIPING - AREA B
- G-012 YARD PIPING - AREA C
- G-013 YARD PIPING - AREA D
- G-014 YARD PIPING - AREA E
- G-015 YARD PIPING - AREA F
- G-016 YARD PIPING - AREA G
- G-017 YARD PIPING - AREA H
- G-018 YARD PIPING PROFILES
- G-019 YARD PIPING PROFILES
- G-020 YARD PIPING PROFILES
- G-021 YARD PIPING PROFILES AND SECTIONS
- G-022 YARD PIPING DETAILS
- G-023 ROADS - LAYOUT PLAN
- G-024 GRADING AND DRAINAGE PLAN
- G-025 STORM SEWER PIPING PROFILES
- G-026 STORM SEWER PIPING PROFILES
- G-027 STORM SEWER PIPING PROFILES
- G-028 EROSION AND SEDIMENT CONTROL PLAN
- G-029 EROSION AND SEDIMENT CONTROL DETAILS
- G-030 LANDSCAPE PLAN
- G-031 LANDSCAPE DETAILS
- G-032 HYDRAULIC PROFILE
- G-033 TEMPORARY TRAFFIC CONTROL PLAN
- G-034 MISCELLANEOUS DETAILS
- G-035 MISCELLANEOUS DETAILS
- G-036 MISCELLANEOUS DETAILS
- G-037 MISCELLANEOUS DETAILS
- G-038 MISCELLANEOUS DETAILS
- G-101 COORDINATE PLAN
- G-102 GRADING PLAN I
- G-103 GRADING PLAN II

ARCHITECTURAL DRAWINGS

TYPICAL ARCHITECTURAL DETAILS

- A-001 SYMBOLS, ABBREVIATIONS & NOTES
- A-002 MISCELLANEOUS ROOF DETAILS
- A-003 OVERALL ROOF PLAN

SECONDARY EFFLUENT PUMPING STATION

- A-101 SECONDARY EFFLUENT PUMPING STATION - FLOOR PLAN
- A-102 SECONDARY EFFLUENT PUMPING STATION - ELEVATIONS
- A-103 SECONDARY EFFLUENT PUMP STATION STAIRS - WALL SECTIONS
- A-104 SECONDARY EFFLUENT PUMP STATION STAIRS - EXT. WALL DETAILS
- A-105 SECONDARY EFFLUENT PUMP STATION - ROOF PLAN
- A-105 SECONDARY EFFLUENT PUMP STATION - BUILDING SECTION/DETAILS

BIOLOGICAL AERATED FILTER (BAF) COMPLEX

- A-201 BAF PROCESS/UTILITY BLDG. - PARTIAL FIRST FLOOR PLAN
- A-202 BAF PROCESS/UTILITY BLDG. - PARTIAL SECOND FLOOR PLAN
- A-203 BAF PROCESS/UTILITY BLDG. - PARTIAL ROOF PLANS
- A-204 BAF PROCESS/UTILITY BLDG. - ELEVATION & WALL SECTIONS
- A-205 BAF PROCESS/UTILITY BLDG. - STAIR PLANS & SECTIONS
- A-206 BAF PROCESS/UTILITY BLDG. - NORTH/SOUTH/EAST/WEST ELEVATIONS
- A-207 BAF PROCESS/UTILITY BLDG. - EXTERIOR DETAILS
- A-208 BAF PROCESS/UTILITY BLDG. - EXTERIOR DETAILS
- A-209 BAF PROCESS/UTILITY BLDG. - DETAILS
- A-210 BAF PROCESS/UTILITY BLDG. - BACKWASH ELEVATIONS & DETAILS

HIGH-RATE FLOCCULATED SETTLING (HRFS) COMPLEX

- A-301 HRFS COMPLEX - PARTIAL PLANS, SECTIONS AND DETAILS
- A-302 UV DISINFECTION & HRFS BUILDING - DETAILS
- A-303 UV DISINFECTION & HRFS BUILDING - SOUTH ELEVATION AND DETAIL
- A-304 UV DISINFECTION & HRFS BUILDING NORTH & EAST ELEVATIONS

UV DISINFECTION

- A-401 UV DISINFECTION FLOOR PLANS
- A-402 UV DISINFECTION ROOF PLAN & DETAILS
- A-403 UV DISINFECTION BUILDING SECTIONS
- A-404 UV DISINFECTION BUILDING DETAILS

OPERATIONS CENTER AND CHEMICAL BUILDING C

- A-501 OPERATIONS CENTER AND CHEM BLDG. C - FIRST FLOOR PLAN
- A-502 OPERATIONS CENTER AND CHEM BLDG. C - SECOND FLOOR PLAN
- A-503 OPERATIONS CENTER AND CHEM BLDG. C - THIRD FLOOR PLAN
- A-504 OPERATIONS CENTER - ROOF PLAN
- A-505 OPERATIONS CENTER AND CHEM BLDG C - EAST AND SOUTH ELEVATIONS
- A-506 OPERATIONS CENTER AND CHEM BLDG C- WEST AND NORTH ELEVATIONS
- A-507 OPERATIONS CENTER AND CHEM BLDG. C - WALL SECTIONS
- A-508 OPERATIONS CENTER AND CHEM BLDG. C - WALL SECTIONS
- A-509 OPERATIONS CENTER AND CHEM BLDG. C - WALL SECTIONS
- A-510 OPERATIONS CENTER AND CHEM BLDG. C - BUILDING SECTION, STAIR AND ELEVATOR
- A-511 OPERATIONS CENTER AND CHEM BLDG. C - WALL SECTIONS
- A-512 OPERATIONS CENTER AND CHEM BLDG. C - DETAILS
- A-513 OPERATIONS CENTER AND CHEM BLDG. C - DETAILS
- A-514 OPERATIONS CENTER AND CHEM BLDG. C - CANOPY DETAILS
- A-515 OPERATIONS CENTER AND CHEM BLDG. C - PLANS AND DETAILS
- A-516 OPERATIONS CENTER AND CHEM BLDG. C - PLANS AND DETAILS
- A-517 OPERATIONS CENTER AND CHEM BLDG. C - FLOOR FINISH LAYOUTS
- A-518 ALL BUILDING STRUCTURES ROOM FINISH SCHEDULE
- A-519 ALL BUILDING STRUCTURES DOOR SCHEDULE AND SIGNAGE
- A-520 OPERATIONS CENTER AND CHEM BLDG. C - 1st AND 2nd FLOOR REF. CEIL. PLANS
- A-521 OPERATIONS CENTER AND CHEM BLDG. C - 3rd FLOOR REF. CEIL. PLAN & DETAILS

STRUCTURAL DRAWINGS

STANDARD DETAILS

- S-001 ABBREVIATIONS & GENERAL NOTES
- S-002 STANDARD DETAILS
- S-003 STANDARD DETAILS
- S-004 STANDARD DETAILS
- S-005 STANDARD DETAILS

SECONDARY EFFLUENT PUMPING STATION

- S-101 SECONDARY EFFLUENT PUMPING STATION - FOUNDATION PLAN
- S-102 SECONDARY EFFLUENT PUMPING STATION - SECTIONS
- S-103 SECONDARY EFFLUENT PUMPING STATION - FLOOR PLAN
- S-104 SECONDARY EFFLUENT PUMPING STATION - ROOF FRAMING PLAN
- S-105 SECONDARY EFFLUENT PUMPING STATION - SECTIONS AND DETAILS
- S-106 SECONDARY EFFLUENT PUMPING STATION - SECTIONS AND DETAILS
- S-107 SECONDARY EFFLUENT PUMPING STATION - SECTIONS AND DETAILS
- S-108 SECONDARY EFFLUENT PUMPING STATION - SECTIONS AND DETAILS
- S-109 72" SECONDARY FORCEMAIN - PLAN, SECTIONS AND DETAILS
- S-110 72" SECONDARY FORCEMAIN - SUPPORT SLAB DETAILS
- S-111 SECONDARY EFFLUENT PUMPING STATION - PLATFORM PLAN SECTIONS & ELEVATION

BIOLOGICAL AERATED FILTER (BAF) COMPLEX

- S-201 GENERAL OVERALL BAF FOUNDATION PLAN
- S-202 BAF PARTIAL FOUNDATION PLAN
- S-203 BAF PARTIAL FOUNDATION PLAN
- S-204 BAF PARTIAL FOUNDATION PLAN
- S-205 BAF PARTIAL FOUNDATION PLAN
- S-206 BAF PARTIAL FOUNDATION PLAN
- S-207 BAF PARTIAL FOUNDATION PLAN
- S-208 GENERAL OVERALL BAF PLAN @ EL. 392.75
- S-209 BAF PARTIAL PLAN @ EL. 392.75
- S-210 BAF PARTIAL PLAN @ EL. 392.75
- S-211 BAF PARTIAL PLAN @ EL. 392.75
- S-212 BAF PARTIAL PLAN @ EL. 392.75
- S-213 BAF PARTIAL PLAN @ EL. 392.75
- S-214 BAF PARTIAL PLAN @ EL. 392.75
- S-215 GENERAL OVERALL BAF PLAN @ EL. 407.84
- S-216 BAF PARTIAL PLAN @ EL. 407.84
- S-217 BAF PARTIAL PLAN @ EL. 407.84
- S-218 BAF PARTIAL PLAN @ EL. 407.84
- S-219 BAF PARTIAL PLAN @ EL. 407.84
- S-220 BAF PARTIAL PLAN @ EL. 407.84
- S-221 BAF PARTIAL PLAN @ EL. 407.84
- S-222 ROOF FRAMING PLAN @ EL. 417.84
- S-223 TYPICAL BAF CELL PLAN & SECTION
- S-224 BAF PUMP ROOM / BAF GALLERY PARTIAL PLANS - SUMPS, TRENCH DRAINS & EQUIP. PADS
- S-225 SECTIONS AND DETAILS
- S-226 SECTIONS AND DETAILS
- S-227 SECTIONS AND DETAILS
- S-228 SECTIONS AND DETAILS
- S-229 SECTIONS AND DETAILS
- S-230 SECTIONS AND DETAILS
- S-231 SECTIONS AND DETAILS
- S-232 BEAM SCHEDULE, SECTIONS AND DETAILS

BIOLOGICAL AERATED FILTER (BAF) COMPLEX (CONT.)

- S-233 BAF BLOWER ROOM / BAF ELEC. ROOM FOUNDATION, SECTIONS & DETAILS
- S-234 BAF CONC. ROOF BEAMS & CONC. COLUMNS SECTIONS & DETAILS
- S-235 STEEL FRAMING ELEVATIONS, SECTIONS & DETAILS
- S-236 BAF GALLERY WALKWAY SECTIONS AND DETAILS
- S-237 TYPICAL BAF NOZZLE DECK PLAN
- S-238 TYPICAL BAF NOZZLE DECK SECTIONS
- S-239 STAIRWELL NO. 1&2 - ROOF FRAMING PLANS

HIGH-RATE FLOCCULATED SETTLING (HRFS) COMPLEX

- S-301 HRFS COMPLEX - PARTIAL LOWER PLAN
- S-302 HRFS COMPLEX - PARTIAL LOWER PLAN
- S-303 HRFS COMPLEX - PARTIAL UPPER PLAN
- S-304 HRFS COMPLEX - PARTIAL UPPER PLAN
- S-305 HRFS COMPLEX - SECTIONS
- S-306 HRFS COMPLEX - SECTIONS AND DETAILS
- S-307 HRFS COMPLEX - SECTIONS AND DETAILS
- S-308 HRFS COMPLEX - SECTIONS AND DETAILS
- S-309 HRFS COMPLEX - SECTIONS AND DETAILS
- S-310 HRFS COMPLEX - SECTIONS AND DETAILS
- S-311 HRFS COMPLEX - SCHEDULES AND MISC. DETAILS
- S-312 HRFS PROCESS TANKS ROOF FRAMING PLAN
- S-313 HRFS PROCESS TANKS CONC. ROOF BEAMS & CONC. COLUMNS SECTIONS & DETAILS

UV DISINFECTION

- S-401 UV DISINFECTION/PARSHALL FLUME - FOUNDATION PLAN
- S-402 UV DISINFECTION/PARSHALL FLUME - FIRST FLOOR PLAN
- S-403 UV DISINFECTION/PARSHALL FLUME - SECTIONS AND DETAILS
- S-404 UV DISINFECTION/PARSHALL FLUME - SECTIONS
- S-405 UV DISINFECTION/PARSHALL FLUME - SECTIONS
- S-406 UV DISINFECTION/PARSHALL FLUME - SECTIONS
- S-407 UV DISINFECTION - ROOF PLAN AND MISCELLANEOUS DETAILS

OPERATIONS CENTER

- S-501 OPERATIONS CENTER FIRST FLOOR PLAN
- S-502 OPERATIONS CENTER SECOND FLOOR FRAMING PLAN
- S-502A OPERATIONS CENTER & CHEMICAL BLDG C - STAIR PLAN & DETAILS
- S-503 OPERATIONS CENTER THIRD FLOOR FRAMING PLAN
- S-504 OPERATIONS CENTER ROOF FRAMING PLAN
- S-505 OPERATIONS CENTER FRAMING ELEVATIONS
- S-506 OPERATIONS CENTER FRAMING ELEVATIONS
- S-507 OPERATIONS CENTER FOUNDATION & FIRST FLOOR SECTIONS & DETAILS
- S-508 OPERATIONS CENTER - SECTIONS AND DETAILS
- S-509 OPERATIONS CENTER - SECTIONS AND DETAILS
- S-510 OPERATIONS CENTER - SECTIONS AND DETAILS
- S-511 OPERATIONS CENTER - SECTIONS AND DETAILS

MISCELLANEOUS STRUCTURES

- S-601 84" OUTFALL JUNCTION BOX - PLAN, SECTIONS AND DETAILS
- S-602 84" SUPPORTS - PLAN, SECTIONS AND DETAILS
- S-603 (NOT USED)
- S-604 BULK CHEMICAL STORAGE & CONTAINMENT AREA - PLANS AND SECTIONS
- S-605 BAF OUTDOOR SUBSTATION ELECTRICAL STRUCTURES PLAN AND SECTIONS
- S-606 ELECTRICAL STRUCTURES - PLANS, SECTIONS AND DETAILS
- S-607 LOW LIFT PUMP STATION BASEMENT FLOOR PLAN
- S-608 LOW LIFT PUMP STATION BOILER ROOF PLAN
- S-609 LOW LIFT PUMP STATION SECTION & DETAILS
- S-610 EXISTING CHEMICAL GALLERY PILE SECTION & DETAILS
- S-611 EXISTING MAIN GALLERY ACCESS HANDHOLE PLAN & SECTION
- S-612 LOW LIFT PUMP STATION MEZZANINE FRAMING PLAN
- S-613 PLANT OPERATIONS BUILDING MISCELLANEOUS DETAILS

MECHANICAL DRAWINGS

MISCELLANEOUS DETAILS

- M-001 SYMBOLS & ABBREVIATIONS
- M-002 MISCELLANEOUS DETAILS
- M-003 MISCELLANEOUS DETAILS
- M-003A MISCELLANEOUS DETAILS
- M-004 MISCELLANEOUS DETAILS
- M-005 MISCELLANEOUS DETAILS

SECONDARY EFFLUENT PUMPING STATION

- M-101 SECONDARY EFFLUENT PUMPING STATION - PLAN
- M-102 SECONDARY EFFLUENT PUMPING STATION - SECTIONS
- M-103 SECONDARY EFFLUENT PUMPING STATION - PLANS, SECTIONS AND DETAIL

BIOLOGICAL AERATED FILTER (BAF) COMPLEX

- M-201 BAF PARTIAL LOWER PLAN
- M-202 BAF PARTIAL LOWER PLAN
- M-203 BAF PARTIAL LOWER PLAN
- M-204 BAF BLOWER ROOM PLAN
- M-205 BAF PLENUM ROOM & MECHANICAL ROOM PARTIAL PLAN
- M-206 BAF CROSS GALLERY PARTIAL LOWER PLAN
- M-207 BAF SECTIONS
- M-208 BAF BLOWER ROOM SECTION
- M-209 BACKWASH PUMP ROOM SECTIONS
- M-210 BAF MISCELLANEOUS SECTIONS
- M-211 PLANT AIR SCHEMATIC
- M-212 BAF MISCELLANEOUS DETAILS
- M-213 BAF AIR GRID MISC. DETAILS
- M-214 BAF AIR GRID MISC. DETAILS
- M-215 BIOSTYR PROCESS CELL FEED/BACKWASH CHANNELS ASSEMBLY
- M-216 MODIFICATION NO. 4A-099

HIGH-RATE FLOCCULATED SETTLING (HRFS) COMPLEX

- M-301 HRFS COMPLEX PROCESS FLOW SCHEMATICS - HRFS SYSTEM AND SAND MAKEUP SYSTEM
- M-302 HRFS COMPLEX PROCESS FLOW SCHEMATIC - FERRIC CHLORIDE FEED SYSTEM
- M-303 HRFS COMPLEX PROCESS FLOW SCHEMATIC - POLYMER FEED SYSTEM
- M-304 HRFS COMPLEX LOWER PLAN (PARTIAL)
- M-305 HRFS COMPLEX LOWER PLAN (PARTIAL)
- M-306 HRFS COMPLEX LOWER PLAN (PARTIAL)
- M-307 HRFS COMPLEX LOWER PLAN (PARTIAL)
- M-308 HRFS COMPLEX UPPER PLAN (PARTIAL)
- M-309 HRFS COMPLEX UPPER PLAN (PARTIAL)
- M-310 HRFS COMPLEX UPPER PLAN (PARTIAL)
- M-311 HRFS COMPLEX UPPER PLAN (PARTIAL)
- M-312 HRFS COMPLEX PROCESS TANKS SECTION
- M-313 HRFS COMPLEX PROCESS TANKS SECTION
- M-314 HRFS COMPLEX PROCESS TANKS SECTIONS
- M-315 HRFS COMPLEX CHEMICAL BUILDING "C" - PLAN
- M-316 HRFS COMPLEX CHEMICAL BUILDING "C" - SECTION
- M-317 HRFS COMPLEX CHEMICAL BUILDING "C" - SECTION
- M-318 HRFS COMPLEX CHEMICAL BUILDING "B" - PARTIAL PLAN AND SECTIONS

UV DISINFECTION

- M-401 UV DISINFECTION - PLAN
- M-402 UV DISINFECTION - SECTION AND DETAILS

02/26/01 0659 JAS
0659g01

NO ALTERATIONS PERMITTED HEREON EXCEPT AS PROVIDED UNDER SECTION 7209 SUBDIVISION 2 OF THE NEW YORK STATE EDUCATION LAW

| No. | Date | Revisions | Init |
|-----|---------|---------------------------------|------|
| 0 | 4/20/01 | ISSUED FOR APPROVAL | RCG |
| 1 | 7/9/01 | AS BID | RCG |
| 2 | 5/22/03 | REVISED FOR MODIFICATION 4A-164 | RCG |
| 3 | 8/31/08 | RECORD DRAWING | |

In charge of --- AHS
Designed by --- AJS
Drawn by --- JAS
Checked by --- AJS


ENVIRONMENTAL ENGINEERING ASSOCIATES, LLP
SYRACUSE, NEW YORK

(RECORD DRAWING: MADE FROM DRAWING NO. G-001RD, FILE NO. 0659G001RD, DATED JULY 2001)

RECORD DRAWINGS
TO THE BEST OF OUR KNOWLEDGE,
INFORMATION AND BELIEF, THESE RECORD
DRAWINGS SUBSTANTIALLY REPRESENT
THE PROJECT AS CONSTRUCTED.
ENVIRONMENTAL ENGINEERING ASSOCIATES, LLP
DATE 12/12/05 BY RCG

THIS DRAWING WAS PREPARED AT THE SCALE INDICATED IN THE TITLE BLOCK. INACCURACIES IN THE STATED SCALE MAY BE INTRODUCED WHEN DRAWINGS ARE REPRODUCED BY ANY MEANS. USE THE GRAPHIC SCALE BAR IN THE TITLE BLOCK TO DETERMINE THE ACTUAL SCALE OF THIS DRAWING.

ONONDAGA COUNTY • DEPARTMENT OF DRAINAGE AND SANITATION • SYRACUSE, NEW YORK
METROPOLITAN SYRACUSE WASTEWATER TREATMENT PLANT
STAGE III AMMONIA AND STAGE II PHOSPHORUS REMOVAL PROJECT

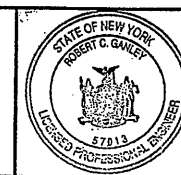

| | | |
|----------------------|--------------------|-------|
| File Number 00659 | Date APRIL 2001 | G-001 |
| | | |

INDEX OF DRAWINGS
GENERAL

BOOK 2 of 3 (CONT.)

MECHANICAL DRAWINGS (CONT.)

OUTFALL 002 DECHLORINATION SYSTEM

- M-501 BYPASS CHLORINE CONTACT TANK MODIFICATIONS - PLAN
- M-502 BYPASS CHLORINE CONTACT TANK MODIFICATIONS - SECTIONS
- M-503 EFFLUENT JUNCTION BOX PLAN & SECTIONS
- M-504 BULK CHEMICAL STORAGE CONTAINMENT & TRANSFER AREA- DEMOLITION PLAN, DETAIL & SECTIONS
- M-505 BULK CHEMICAL STORAGE, CONTAINMENT AND TRANSFER AREA - PLAN
- M-506 CHEMICAL FEED BUILDING "A"- PLAN & SECTION
- M-507 CHEMICAL FEED BUILDING "A"- SECTIONS & DETAIL
- M-508 DETAILS AND SCHEMATIC
- M-509 DETAIL AND SECTIONS
- M-510 SODIUM BISULFITE CHEMICAL FEED SCHEMATIC

EXISTING GALLERIES

- M-601 GALLERY MODIFICATIONS - KEY PLAN
- M-602 SECONDARY GALLERY "A" MODIFICATIONS - PLAN AND SECTIONS
- M-603 EFFLUENT GALLERY MODIFICATIONS- PLAN AND SECTIONS
- M-604 PRIMARY GALLERY "A" MODIFICATIONS- PLAN AND SECTIONS
- M-605 EFFLUENT GALLERY MODIFICATIONS- PLAN AND SECTIONS
- M-606 PLANT OPERATIONS BUILDING MODIFICATIONS - BASEMENT PARTIAL PLAN
- M-607 PLANT OPERATIONS BUILDING MODIFICATIONS - BASEMENT SECTIONS
- M-608 CHEMICAL GALLERY MODIFICATIONS - PLAN AND SECTIONS
- M-609 MAIN GALLERY MODIFICATIONS - PLAN AND SECTIONS
- M-610 THICKENER GALLERY MODIFICATIONS - PLAN AND SECTIONS
- M-611 THICKENER DISTRIBUTION STRUCTURE MODIFICATIONS - PLAN AND SECTIONS
- M-612 PRIMARY GALLERY "B" MODIFICATIONS- PLAN AND SECTIONS
- M-613 MAIN GALLERY MODIFICATIONS - PLAN AND SECTIONS
- M-614 LOW LIFT PUMP STATION MODIFICATIONS - PLAN AND SECTIONS

BOOK 3 of 3

INSTRUMENTATION DRAWINGS

GENERAL INFORMATION

- I-001 GENERAL NOTES, LEGEND & ABBREVIATIONS
- I-002 CONTROL SYSTEM SITE PLAN
- I-003 SCADA SYSTEM NOTES AND SCHEDULES
- I-004 SCADA SYSTEM SCHEMATIC OVERALL ONELINE
- I-005 SCADA SYSTEM SCHEMATIC COUNTYWIDE SUBSYSTEM
- I-006 SCADA SYSTEM SCHEMATIC BAF / HRFS SUBSYSTEM
- I-007 SCADA SYSTEM SCHEMATIC CHEMICAL FEED / PROCESS SUBSYSTEM
- I-008 SCADA SYSTEM ENERGY MANAGEMENT SUBSYSTEM
- I-009 SCADA SYSTEM SCHEMATIC HVAC DIRECT DIGITAL CONTROL SUBSYSTEM
- I-010 SCADA SYSTEM BAF ELECTRIC ROOM ENERGY MANAGEMENT SUBSYSTEM
- I-011 OPERATIONS CENTER CONTROL ROOM LAYOUT
- I-012 PLANT OPERATIONS BLDG. CONTROL ROOM LAYOUT DEMOLITION PLAN

SECONDARY EFFLUENT PUMPING STATION

- I-101 SECONDARY EFFLUENT PUMPING STATION PLAN
- I-102 SECONDARY EFFLUENT PUMPING STATION (PLC M13) CONTROL PANEL
- I-103 SECONDARY EFFLUENT PUMPING STATION (PLC M13) CONTROL PANEL LAYOUT
- I-104 SECONDARY EFFLUENT PUMPING STATION (PLC M13) BILL OF MATERIALS
- I-105 SECONDARY EFFLUENT PUMPING STATION (PLC M13) CONTROL CIRCUIT WIRING
- I-106 SECONDARY EFFLUENT PUMPING STATION (PLC M13) TERMINAL BLOCK LAYOUT
- I-107 SECONDARY EFFLUENT PUMPING STATION (PLC M13) ANALOG INPUT MODULES
- I-108 SECONDARY EFFLUENT PUMPING STATION (PLC M13) ANALOG INPUT MODULES
- I-109 SECONDARY EFFLUENT PUMPING STATION (PLC M13) ANALOG INPUT MODULES
- I-110 SECONDARY EFFLUENT PUMPING STATION (PLC M13) ANALOG OUTPUT MODULES
- I-111 SECONDARY EFFLUENT PUMPING STATION (PLC M13) DIGITAL INPUT MODULES
- I-112 SECONDARY EFFLUENT PUMPING STATION (PLC M13) DIGITAL INPUT MODULES
- I-113 SECONDARY EFFLUENT PUMPING STATION (PLC M13) DIGITAL INPUT MODULES
- I-114 SECONDARY EFFLUENT PUMPING STATION (PLC M13) DIGITAL INPUT MODULES
- I-115 SECONDARY EFFLUENT PUMPING STATION (PLC M13) DIGITAL OUTPUT MODULES
- I-116 SECONDARY EFFLUENT PUMPING STATION (PLC M13) DIGITAL OUTPUT MODULES

BIOLOGICAL AERATED FILTER (BAF) COMPLEX

- I-201 BAF LOWER LEVEL PARTIAL PLAN SOUTH
- I-202 BAF LOWER LEVEL PARTIAL PLAN CENTER
- I-203 BAF LOWER LEVEL PARTIAL PLAN NORTH
- I-204 BAF BLOWER AND ELECTRIC ROOM PLAN
- I-205 BAF PLENUM AND MECHANICAL ROOM PLAN
- I-206 BAF UPPER LEVEL PARTIAL PLAN
- I-207 BAF (PLC M19) INTERCONNECTION DRAWING
- I-208 BLOWER PANELS (PLC M21 & M22) INTERCONNECTION DRAWING
- I-209 BAF ELECTRIC ROOM (PLC M24) INTERCONNECTION DIAGRAM

HIGH RATE FLOCCULATED SETTLING (HRFS) COMPLEX

- I-301 HRFS LOWER LEVEL PLAN
- I-302 HRFS UPPER LEVEL PLAN
- I-303 CHEMICAL BUILDING C PLAN
- I-304 HRFS (PLC M17) INTERCONNECTION DRAWING
- I-305 FERRIC CHLORIDE FEED CONTROL DIAGRAM
- I-306 POLYMER FEED CONTROL DIAGRAM
- I-307 SAND STORAGE SILO AND SLURRY FEED SYSTEM CONTROL DIAGRAM
- I-308 M12000 HRFS CHEMICAL FEED (PLC M18) INTERCONNECTION DRAWING
- I-309 CHEMICAL BUILDING C INSTRUMENTATION MOUNTING DETAILS

UV DISINFECTION

- I-401 UV DISINFECTION/PARSHALL FLUME INSTRUMENTATION PLAN AND DETAIL
- I-402 UV DISINFECTION/FLOW MONITORING CONTROL DIAGRAM (PLC M14)
- I-403 UV DISINFECTION/FLOW MONITORING INTERCONNECT ONELINE

MISCELLANEOUS

- I-501 CHEMICAL BUILDING A AND POB PARTIAL PLANS
- I-502 CHEMICAL BUILDING B INSTRUMENTATION PLAN
- I-503 BYPASS CHLORINE CONTACT TANK AND BUILDING PLANS
- I-504 SODIUM BISULFITE (PLC M20C) CONTROL DIAGRAM
- I-505 BYPASS CHLORINE CONTACT/OUTFALL 002 PLAN (PLC M20D) CONTROL DIAGRAM
- I-506 CONTROL MODIFICATIONS TO EXISTING CHLORINE INJECTOR PUMPS
- I-507 INSTRUMENTATION CONTROL PANELS-LAYOUT
- I-508 INSTRUMENTATION CONTROL PANELS-LAYOUT
- I-509 LOOP WIRING DIAGRAMS
- I-510 CONDUIT SCHEDULE
- I-511 CONDUIT SCHEDULE (CONTINUED)
- I-512 CONDUIT SCHEDULE (CONTINUED)
- I-513 CONDUIT SCHEDULE (CONTINUED)

MISCELLANEOUS

- I-601 CHEMICAL BUILDING "A" (PLC M20C) CONTROL PANEL LAYOUT
- I-602 CHEMICAL BUILDING "A" (PLC M20C) BILL OF MATERIALS
- I-603 CHEMICAL BUILDING "A" (PLC M20C) CONTROL CIRCUIT WIRING
- I-604 CHEMICAL BUILDING "A" (PLC M20C) TERMINAL BLOCK LAYOUT
- I-605 CHEMICAL BUILDING "A" (PLC M20C) ANALOG INPUT MODULES
- I-606 CHEMICAL BUILDING "A" (PLC M20C) ANALOG INPUT MODULES
- I-607 CHEMICAL BUILDING "A" (PLC M20C) ANALOG OUTPUT MODULES
- I-608 CHEMICAL BUILDING "A" (PLC M20C) ANALOG OUTPUT MODULES
- I-609 CHEMICAL BUILDING "A" (PLC M20C) DIGITAL INPUT MODULES
- I-610 CHEMICAL BUILDING "A" (PLC M20C) DIGITAL INPUT MODULES
- I-611 CHEMICAL BUILDING "A" (PLC M20C) DIGITAL INPUT MODULES
- I-612 CHEMICAL BUILDING "A" (PLC M20C) DIGITAL OUTPUT MODULES
- I-613 CHEMICAL BUILDING "A" (PLC M20C) DIGITAL OUTPUT MODULES
- I-614 CHEMICAL BUILDING "C" (PLC M16) CONTROL PANEL LAYOUT
- I-615 CHEMICAL BUILDING "C" (PLC M16) CONTROL CIRCUIT WIRING
- I-616 CHEMICAL BUILDING "C" (PLC M16) TERMINAL BLOCK LAYOUT
- I-617 CHEMICAL BUILDING "C" (PLC M16) ANALOG INPUT MODULES
- I-618 CHEMICAL BUILDING "C" (PLC M16) DIGITAL INPUT MODULES
- I-619 CHEMICAL BUILDING "C" (PLC M16) DIGITAL INPUT MODULES
- I-620 CHEMICAL BUILDING "C" (PLC M16) DIGITAL INPUT MODULES
- I-621 CHEMICAL BUILDING "C" (PLC M16) DIGITAL INPUT MODULES
- I-622 CHEMICAL BUILDING "C" (PLC M16) DIGITAL OUTPUT MODULE
- I-623 CHLORINE BYPASS BLDG. (PLC M20D) CONTROL PANEL LAYOUT
- I-624 CHLORINE BYPASS BLDG. (PLC M20D) CONTROL CIRCUIT WIRING
- I-625 CHLORINE BYPASS BLDG. (PLC M20D) TERMINAL BLOCK LAYOUT
- I-626 CHLORINE BYPASS BLDG. (PLC M20D) ANALOG INPUT MODULES
- I-627 CHLORINE BYPASS BLDG. (PLC M20D) DIGITAL INPUT MODULES

- I-628 CHLORINE BYPASS BLDG. (PLC M20D) DIGITAL INPUT MODULES
- I-629 CHLORINE BYPASS BLDG. (PLC M20D) DIGITAL OUTPUT MODULES
- I-630 CHEMICAL BUILDING "B" (PLC M20B) CONTROL PANEL LAYOUT
- I-631 CHEMICAL BUILDING "B" (PLC M20B) ANALOG INPUT MODULE
- I-632 CHEMICAL BUILDING "B" (PLC M20B) DISCRETE INPUT MODULE
- I-633 CHEMICAL BUILDING "B" (PLC M20B) DISCRETE OUTPUT MODULE
- I-634 BAF ELECTRIC ROOM (PLC M24) CONTROL PANEL LAYOUT
- I-635 BAF ELECTRIC ROOM (PLC M24) CONTROL CIRCUIT WIRING
- I-636 BAF ELECTRIC ROOM (PLC M24) TERMINAL BLOCK LAYOUT
- I-637 BAF ELECTRIC ROOM (PLC M24) ANALOG INPUT MODULES
- I-638 BAF ELECTRIC ROOM (PLC M24) ANALOG INPUT MODULES
- I-639 BAF ELECTRIC ROOM (PLC M24) DIGITAL INPUT MODULES
- I-701 GALLERY GAS DETECTION SYSTEM

ELECTRICAL DRAWINGS

GENERAL INFORMATION

- E-001 GENERAL NOTES, LEGEND & ABBREVIATIONS
- E-002 ELECTRICAL SITE PLAN
- E-003 GROUNDING PLAN
- E-004 LIGHTNING PROTECTION PLAN
- E-005 ONE-LINE - MAIN SUBSTATION
- E-006 ONE-LINE - 5 KV DISTRIBUTION SYSTEM
- E-007 MAIN SUBSTATION PLAN
- E-008 MAIN SUBSTATION SWITCHGEAR DETAILS
- E-009 MAIN SUBSTATION MODIFICATIONS
- E-010 5 KV DUCTBANK PLAN AND SECTIONS
- E-011 5 KV CABLE TRAY PLAN AND SECTIONS
- E-012 5 KV CABLE TRAY PLAN AND SECTIONS
- E-013 5 KV CABLE TRAY PLAN AND SECTIONS
- E-014 5 KV CABLE TRAY PLAN AND SECTIONS
- E-015 5 KV SECONDARY EFFLUENT PS PLANS & SECTIONS
- E-016 BAF FIRST FLOOR ELECTRICAL PLAN
- E-017 5 KV BAF SUBSTATION 1 & 2, SECTIONS, SCHEDULES
- E-018 MAIN SUBSTATION SCHEDULES
- E-019 34.5 KV SUBSTATION BATTERY BUILDING
- E-020 LIGHTING FIXTURE SCHEDULE

SECONDARY EFFLUENT PUMPING STATION

- E-101 SECONDARY EFFLUENT PUMPING STATION POWER PLAN
- E-102 SECONDARY EFFLUENT PUMPING STATION LIGHTING PLAN
- E-103 SECONDARY EFFLUENT PUMPING STATION LIGHTNING PROTECTION PLAN
- E-104 SECONDARY EFFLUENT PUMPING STATION 5 KV SWITCHGEAR
- E-105 SECONDARY EFFLUENT PUMPING STATION MCC 44 ONE-LINE DIAGRAM
- E-106 SECONDARY EFFLUENT PUMPING STATION ELEMENTARY DIAGRAMS
- E-107 SECONDARY EFFLUENT PUMPING STATION SCHEDULES & DETAILS

BIOLOGICAL AERATED FILTER (BAF) COMPLEX

- E-201 BAF LOWER LEVEL POWER PLAN
- E-202 BAF BLOWER AND ELECTRIC ROOM POWER PLAN
- E-203 BAF LOWER LEVEL LIGHTING PLAN
- E-204 BAF BLOWER AND ELECTRIC ROOM LIGHTING PLANS
- E-205 BAF PLENUM AND MECHANICAL ROOM LIGHTING PLANS
- E-206 BAF UPPER LEVEL LIGHTING PLAN
- E-207 BAF MCC 30 AND 31 ONE-LINE DIAGRAMS
- E-208 BAF MCC 42 AND 43 ONE-LINE DIAGRAMS
- E-209 BAF MCC 34 ONE-LINE DIAGRAM
- E-210 BAF MCC 34 ONE-LINE DIAGRAM (CONTINUED)
- E-211 BAF MCC 38 ONE-LINE DIAGRAM
- E-212 BAF MCC 38 ONE-LINE DIAGRAM (CONTINUED)
- E-213 BAF MCC ELEVATIONS
- E-214 BAF ELEMENTARY DIAGRAMS
- E-215 BAF PLENUM AND MECHANICAL ROOM POWER PLAN
- E-216 BAF SCHEDULES
- E-217 BAF SCHEDULES (CONTINUED)
- E-218 BAF COMPLEX ROOF PLAN
- E-219 BAF ELEMENTARY DIAGRAMS

RECORD DRAWINGS
TO THE BEST OF OUR KNOWLEDGE,
INFORMATION AND BELIEF, THESE RECORD
DRAWINGS SUBSTANTIALLY REPRESENT
THE PROJECT AS CONSTRUCTED.

ENVIRONMENTAL ENGINEERING ASSOCIATES, LLP

DATE 1/12/01 BY RCG


THIS DRAWING WAS PREPARED AT THE SCALE INDICATED IN THE
TITLE BLOCK. INACCURACIES IN THE STATED SCALE MAY BE
INTRODUCED WHEN DRAWINGS ARE REPRODUCED BY ANY MEANS.
USE THE GRAPHIC SCALE BAR IN THE TITLE BLOCK TO
DETERMINE THE ACTUAL SCALE OF THIS DRAWING.

02/26/01 080 JAS
065902


(RECORD DRAWING: MADE FROM DRAWING NO. G-002RD, FILE NO. 0659G002RD, DATED JULY 2001)

| No. | Date | Revisions | Init |
|-----|---------|---------------------|------|
| 0 | 4/20/01 | ISSUED FOR APPROVAL | RCG |
| 1 | 7/9/01 | AS BID | RCG |
| 2 | 8/31/04 | RECORD DRAWING | RCG |

In charge of --- AHS
Designed by --- AHS
Drawn by --- JAS
Checked by --- AHS

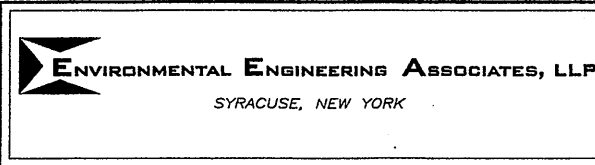

ONONDAGA COUNTY • DEPARTMENT OF DRAINAGE AND SANITATION • SYRACUSE, NEW YORK
METROPOLITAN SYRACUSE WASTEWATER TREATMENT PLANT
STAGE III AMMONIA AND STAGE II PHOSPHORUS REMOVAL PROJECT

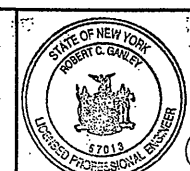

File Number
00659
Date
APRIL 2001

G-002

INDEX OF DRAWINGS
GENERAL

BOOK 3 of 3 (CONT.)

ELECTRICAL DRAWINGS (CONT.)

UV DISINFECTION

- E-401 UV DISINFECTION/PARSHALL FLUME POWER PLAN AND ROOM PLAN
- E-402 UV DISINFECTION/PARSHALL FLUME LIGHTING PLANS
- E-403 UV DISINFECTION/PARSHALL FLUME ONE-LINE DIAGRAM
- E-404 UV DISINFECTION/PARSHALL FLUME ELEMENTARY DIAGRAMS
- E-405 UV DISINFECTION/PARSHALL FLUME SCHEDULES

OPERATIONS CENTER

- E-501 OPERATIONS CENTER 1ST FLOOR POWER PLAN
- E-502 OPERATIONS CENTER 2ND FLOOR POWER PLAN
- E-503 OPERATIONS CENTER 3RD FLOOR POWER PLAN
- E-504 OPERATIONS CENTER 1ST FLOOR LIGHTING PLAN
- E-505 OPERATIONS CENTER 2ND FLOOR LIGHTING PLAN
- E-506 OPERATIONS CENTER 3RD FLOOR LIGHTING PLAN
- E-507 OPERATIONS CENTER 1ST FLOOR MISCELLANEOUS SYSTEMS PLAN
- E-508 OPERATIONS CENTER 2ND FLOOR MISCELLANEOUS SYSTEMS PLAN
- E-509 OPERATIONS CENTER 3RD FLOOR MISCELLANEOUS SYSTEMS PLAN
- E-510 OPERATIONS CENTER SCADA ROOM / CONTROL ROOM POWER PLAN
- E-511 OPERATIONS CENTER MCC 35 ONE LINE DIAGRAM
- E-512 OPERATIONS CENTER MCC 35 ONE LINE DIAGRAM
- E-513 OPERATIONS CENTER ELEMENTARY DIAGRAMS
- E-514 OPERATIONS CENTER SCHEDULES
- E-515 OPERATIONS CENTER SCHEDULES AND DETAILS

MISCELLANEOUS

- E-601 FIRE ALARM SYSTEM SCHEMATIC
- E-602 FIRE ALARM SYSTEM SCHEMATIC
- E-603 FIRE ALARM SYSTEM SCHEMATIC
- E-604 TELEPHONE / PA SYSTEM SCHEMATIC
- E-605 CCTV SYSTEM SCHEMATIC
- E-606 MISCELLANEOUS SCHEMATICS AND DETAILS
- E-607 EXTERIOR LIGHTING PLAN AND DETAILS
- E-608 BULK STORAGE & CONTROL ROOM DEMOLITION & MODIFICATIONS & TRANSFER STATION MODIFICATIONS
- E-609 CHEMICAL BUILDING A POWER PLAN
- E-610 CHEMICAL FILL PORT MODIFICATIONS AND ONE-LINE DIAGRAMS
- E-611 BYPASS CHLORINE CONTACT TANK PLAN AND BUILDING PLANS
- E-612 BYPASS CHLORINE CONTACT TANK POWER PLAN AND DETAILS
- E-613 CHLORINE BYPASS BUILDING PANEL SCHEDULES AND DETAIL
- E-614 CHEMICAL BUILDING B POWER PLAN
- E-615 LOW LIFT PUMP STATION BASEMENT
- E-616 LOW LIFT PUMP STATION FIRST FLOOR
- E-617 GATE OPERATOR SCHEMATIC, GATE AND SITE DETAILS
- E-701 PARTIAL GALLERY PLAN

HEATING, VENTILATING & AIR CONDITIONING DRAWINGS

MISCELLANEOUS

- H-001 ABBREVIATIONS, SYMBOLS & NOTES
- H-002 SCHEDULES
- H-003 EQUIPMENT SCHEDULES
- H-004 SCHEMATICS AND DETAILS
- H-005 SCHEMATICS AND DETAILS
- H-006 DETAILS
- H-007 HVAC CONTROL SYSTEM ARCHITECTURE

SECONDARY EFFLUENT PUMP STATION

- H-101 SECONDARY EFFLUENT PUMP STATION HVAC PLAN

BIOLOGICAL AERATED FILTERS (BAF) COMPLEX

- H-201 BAF GALLERY PARTIAL PLANS
- H-202 PLENUM ROOM AND MECHANICAL ROOM PARTIAL PLAN
- H-203 BLOWER ROOM AND ELECTRICAL ROOM PARTIAL PLAN

HIGH RATE FLOCCULATED SETTLING (HRFS) COMPLEX

- H-301 HRFS GALLERY PARTIAL PLAN
- H-302 HRFS GALLERY PARTIAL PLAN
- H-303 CHEMICAL FEED BUILDING PLAN

UV DISINFECTION

- H-401 UV DISINFECTION/PARSHALL FLUME STRUCTURS PLAN, SECTIONS & DETAILS

OPERATIONS CENTER

- H-501 OPERATIONS CENTER FIRST FLOOR PLANS
- H-502 OPERATIONS CENTER SECOND FLOOR PLANS
- H-503 OPERATIONS CENTER THIRD FLOOR PLANS
- H-504 OPERATIONS CENTER MECHANICAL ROOM PLANS
- H-505 OPERATIONS CENTER SECTIONS
- H-506 OPERATIONS CENTER SECTIONS
- H-507 OPERATIONS CENTER SECTIONS
- H-508 OPERATIONS CENTER PIPING SYSTEM SCHEMATICS

LOW LIFT PUMP STATION

- H-601 LOW LIFT PUMP STATION BASEMENT FLOOR PLAN
- H-602 LOW LIFT PUMP STATION ELEVATIONS, SCHEMATICS & DETAILS
- H-603 LOW LIFT PUMP STATION BASEMENT DEMOLITION PLAN

GALLERIES VENTILATION

- H-701 GALLERIES KEY PLAN
- H-702 PLANT OPERATIONS BUILDING BASEMENT PLAN
- H-703 PLANT OPERATIONS BUILDING FIRST FLOOR PLAN
- H-704 PLANT OPERATIONS BUILDING ROOF PLAN
- H-705 PLANT OPERATIONS BUILDING SECTIONS
- H-706 PLANT OPERATIONS BUILDING SECTION
- H-707 TERTIARY FLOW CONTROL STRUCTURES EQUIPMENT PLAN & DETAIL
- H-708 LOW-LIFT PUMP STATION REMOVALS PLAN
- H-709 LOW-LIFT PUMP STATION FIRST FLOOR PLAN
- H-710 LOW-LIFT PUMP STATION MEZZANINE PLAN
- H-901 SCREENING AND GRIT BUILDING PLAN

PLUMBING

MISCELLANEOUS

- P-001 SYMBOL LIST & NOTES
- P-002 SCHEDULES/SCHEMATICS

SECONDARY EFFLUENT PUMP STATION

- P-101 SECONDARY EFFLUENT PUMP STATION FLOOR PLAN AND SCHEMATIC
- P-102 SECONDARY EFFLUENT PUMP STATION ROOF PLAN

BIOLOGICAL AERATED FILTERS (BAF) COMPLEX

- P-201 BAF - FIRST FLOOR PLAN
- P-202 BAF - SECOND FLOOR PLAN
- P-203 BAF - UPPER LEVEL PLAN

HIGH RATE FLOCCULATED SETTLING (HRFS) COMPLEX

- P-301 HRFS GALLERY - FIRST FLOOR PLAN
- P-302 HRFS GALLERY - SECOND FLOOR PLAN
- P-303 HRFS GALLERY - ROOF PLAN

UV DISINFECTION

- P-401 UV DISINFECTION/PARSHALL FLUME-PLAN AND ROOF PLAN

OPERATIONS CENTER

- P-500 FOUNDATION PLUMBING PLAN - DRAIN/WASTE/VENT
- P-501 FIRST FLOOR PLUMBING PLAN - DRAIN/WASTE/VENT
- P-501A FIRST FLOOR PLUMBING PLAN - WATER
- P-502 SECOND FLOOR PLUMBING PLAN - DRAIN/WASTE/VENT
- P-502A SECOND FLOOR PLUMBING PLAN - WATER
- P-503 THIRD FLOOR PLUMBING PLAN - DRAIN/WASTE/VENT
- P-503A THIRD FLOOR PLUMBING PLAN - WATER
- P-504 MECHANICAL ROOM PLAN
- P-505 MISCELLANEOUS DETAILS
- P-506 MISCELLANEOUS DETAILS AND SCHEDULE
- P-507 SCHEDULES
- P-600 YARD PIPING AREA D - HOT BOX LOCATION AND DETAIL

FIRE PROTECTION

- FP-001 SYMBOL LIST & NOTES
- FP-002 NOT USED
- FP-003 OPERATIONS CENTER FIRST FLOOR SPRINKLER PLAN
- FP-004 OPERATIONS CENTER SECOND FLOOR SPRINKLER PLAN
- FP-005 OPERATIONS CENTER THIRD FLOOR SPRINKLER PLAN
- FP-006 OPERATIONS CENTER SCHEMATICS AND DETAILS
- FP-007 OPERATIONS CENTER SCHEMATICS AND DETAILS
- FP-008 OPERATIONS CENTER DETAILS

02/26/01 OBG JAS
0659g03

(RECORD DRAWING: MADE FROM DRAWING NO. G-003RD, FILE NO. 0659G003RD, DATED JULY 2001)

RECORD DRAWINGS
TO THE BEST OF OUR KNOWLEDGE,
INFORMATION AND BELIEF, THESE RECORD
DRAWINGS SUBSTANTIALLY REPRESENT
THE PROJECT AS CONSTRUCTED.
ENVIRONMENTAL ENGINEERING ASSOCIATES, LLP
DATE 12/12/05 BY RCG

THIS DRAWING WAS PREPARED AT THE SCALE INDICATED IN THE
TITLE BLOCK. INACCURACIES IN THE STATED SCALE MAY BE
INTRODUCED WHEN DRAWINGS ARE REPRODUCED BY ANY MEANS.
USE THE GRAPHIC SCALE BAR IN THE TITLE BLOCK TO
DETERMINE THE ACTUAL SCALE OF THIS DRAWING.

| No. | Date | Revisions | Init |
|-----|---------|---------------------------------|------|
| 0 | 4/20/01 | ISSUED FOR APPROVAL | RCG |
| 1 | 7/9/01 | AS BID | RCG |
| 2 | 5/22/03 | REVISED FOR MODIFICATION 4A-164 | RCG |
| 3 | 8/31/05 | RECORD DRAWING | |

In charge of ___ AHS ___
Designed by ___ AHS ___
Drawn by ___ JAS ___
Checked by ___ AHS ___



ONONDAGA COUNTY • DEPARTMENT OF DRAINAGE AND SANITATION • SYRACUSE, NEW YORK
METROPOLITAN SYRACUSE WASTEWATER TREATMENT PLANT
STAGE III AMMONIA AND STAGE II PHOSPHORUS REMOVAL PROJECT



File Number
00659
Date
APRIL 2001

G-003

INDEX OF DRAWINGS
GENERAL

NO ALTERATIONS PERMITTED HEREON EXCEPT
AS PROVIDED UNDER SECTION 7209 SUBDIVISION
2 OF THE NEW YORK STATE EDUCATION LAW

INSTRUMENT IDENTIFICATION TABLE

ISA-85.1-1991

| LETTER | FIRST LETTER | | SUCCEEDING LETTERS | | |
|--------|---------------------------------|---------------------|-----------------------------|--|------------------------|
| | MEASURED OR INITIATING VARIABLE | MODIFIER | READOUT OR PASSIVE FUNCTION | OUTPUT FUNCTION | MODIFIER |
| A | ANALYSIS (2) | | ALARM | | |
| B | BURNER, COMBUSTION | | | CLOSE, STOP, DECREASE (1) CONTROL | |
| C | | | | | |
| D | DENSITY (1) | DIFFERENTIAL | | OPEN, START, INCREASE (1) | |
| E | VOLTAGE | | SENSOR (PRIMARY ELEMENT) | | |
| F | FLOW RATE | RATIO (FRACTION) | | | FAIL (1) |
| G | | | GLASS, VIEWING DEVICE | | |
| H | HAND | | | | HIGH (OPENED) |
| I | CURRENT (ELECTRICAL) | | INDICATE | | |
| J | POWER | SCAN | | | |
| K | TIME, TIME SCHEDULE | TIME RATE OF CHANGE | | CONTROL STATION | |
| L | LEVEL | | LIGHT | | LOW (CLOSED) |
| M | MOTOR, MOTION (1) | MOMENTARY | | MOTOR (1) | MIDDLE OR INTERMEDIATE |
| N | | | | | ON OR OPERATE (1) |
| O | | | ORIFICE, RESTRICTION | | OVERLOAD (1) |
| P | PRESSURE, VACUUM | | POINT (TEST) CONNECTION | PUMP (1) | |
| Q | EVENT, QUANTITY (2) | INTEGRATE, TOTALIZE | | | |
| R | RADIATION | | RECORD | | |
| S | SPEED, FREQUENCY (3) | SAFETY | | SWITCH | |
| T | TEMPERATURE | | | TRANSMIT | |
| U | MULTIVARIABLE (2) | | MULTIFUNCTION (2) | MULTIFUNCTION (2) | MULTIFUNCTION (2) |
| V | VIBRATION, MECHANICAL ANALYSIS | | | VALVE, DAMPER, LOUVER | |
| W | WEIGHT, FORCE | | WELL | | |
| X | UNCLASSIFIED (2) | X AXIS | UNCLASSIFIED (2) | UNCLASSIFIED (2) | UNCLASSIFIED (2) |
| Y | STATE, PRESENCE | Y AXIS | | RELAY, COMPUTE, CONVERT | |
| Z | POSITION, DIMENSION | Z AXIS | | DRIVER, ACTUATOR, UNCLASSIFIED FINAL CONTROL ELEMENT | |

- (1) USER'S CHOICE
- (2) WHEN USED, SYMBOL OR SIGNAL LINE IS ANNOTATED.
- (3) MAY BE PRECEDED BY AN 'E' OR AN 'H' FOR ELECTRIC OR HAND

SYMBOL LEGEND:

| | | | | | |
|--|--------------------------|--|------------------------|--|---------------------------|
| | S/SL START/STOP LOCK | | CIRCUIT BREAKER (CB) | | JUNCTION BOX |
| | CONTACT | | SWITCH | | COMBINATION MOTOR STARTER |
| | GROUND | | MOTOR (HP=HORSEPOWER) | | CAMERA |
| | TRANSFORMER | | SURGE ARRESTOR | | EMERGENCY EYEWASH/SHOWER |
| | FUSE | | PUBLIC ADDRESS SPEAKER | | SOLENOID VALVE |
| | HAND-OFF-AUTOMATIC (HOA) | | TELEPHONE | | MOTORIZED VALVE |
| | RECEPTACLE | | SMOKE DETECTOR | | FLOW SWITCH |
| | ANCHOR BOLT | | HEAT DETECTOR | | LIMIT SWITCH |
| | PULL BOX | | MANUAL PULL STATION | | ULTRASONIC LEVEL |
| | TEARDROP FLOAT | | AUDIO/VISUAL DEVICE | | LEVEL FLOAT |
| | | | PANEL LIGHT | | DEVICENET CONDUIT |
| | | | | | FIELDBUS CONDUIT |

NOTE:

** INDICATES AN ITEM OR ITEMS SUPPLIED BY OWNER FOR INSTALLATION BY THE CONTRACTOR.

INSTRUMENT & FUNCTION SYMBOLS

| | | | |
|--|------------------------------|--|------------------------------------|
| | FIELD MOUNTED | | INTERIOR OF PANEL MOUNTED |
| | FACE OF PANEL MOUNTED | | INSTRUMENTS SHARING COMMON HOUSING |
| | MOTOR CONTROL CENTER MOUNTED | | PROGRAMMABLE PLC FUNCTION |

Layer: ON=*, OFF=*REF*

5/30/01 BBL DCC
0550300/08591001.DWG

NOT TO SCALE

| No. | Date | Revisions | Init |
|-----|----------|---------------------|------|
| 0 | 4/20/01 | ISSUED FOR APPROVAL | ll |
| 1 | 7/11/01 | AS BID | |
| 2 | 10/31/05 | RECORD DRAWING | |

In charge of TEL
Designed by AHL
Drawn by DCC
Checked by FKP

ENVIRONMENTAL ENGINEERING ASSOCIATES, L.L.P.
SYRACUSE, NEW YORK

NO ALTERATIONS PERMITTED HEREON EXCEPT AS PROVIDED UNDER SECTION 7209 SUBDIVISION 2 OF THE NEW YORK STATE EDUCATION LAW

INSTRUMENT & FUNCTION TAGGING


XXXX = FUNCTIONAL INSTRUMENT IDENTIFICATION LETTERS FROM GENERAL INSTRUMENTATION DESIGNATIONS
####X = LOOP NUMBER

ANALYZER DESIGNATIONS

- CL = CHLORINE RESIDUAL
- DO = DISSOLVED OXYGEN
- NH3 = AMMONIA
- ORP = OXIDATION REDUCTION POTENTIAL
- P = PHOSPHATE
- PH = pH
- TEMP = TEMPERATURE
- UVT = ULTRAVIOLET TRANSMITTANCE

TYPICAL P&ID DEVICE NUMBER DESCRIPTION


10000 = SECONDARY EFFLUENT SYSTEM
20000 = BAF SYSTEM (BAF CELL NO. 01-18)
30000 = HRFS SYSTEM (HRFS TRAIN NO. 01-04)
40000 = UV DISINFECTION/FLUME
50000 = CHEMICAL FEED/BYPASS CL2
60000 = RESERVED FOR EXISTING WWTP
70000 = GALLERY
80000 = HVAC/POWER MONITORING
90000 = RESERVED FOR EXISTING WWTP

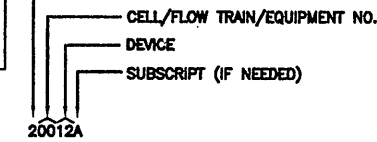

GENERAL INSTRUMENTATION DESIGNATIONS

| | |
|--|---------------------------------------|
| AA ANALYZER ALARM | PSL PRESSURE SWITCH LOW |
| AE ANALYZER ELEMENT | SC SPEED CONTROL |
| AT ANALYZER INDICATOR/TRANSMITTER | SI SPEED INDICATOR |
| FC FLOW CONTROL (STROKE LENGTH) | SV SOLENOID VALVE |
| FE FLOW ELEMENT | TE TEMPERATURE ELEMENT |
| FT FLOW INDICATOR/TRANSMITTER | TIT TEMPERATURE INDICATOR/TRANSMITTER |
| FQ FLOW TOTALIZER | TSH TEMPERATURE SWITCH HIGH |
| FS FLOW SWITCH | TT TEMPERATURE TRANSMITTER |
| FSA FLOW SWITCH ALARM | UV UNIVERSAL VALVE |
| FT FLOW TRANSMITTER | VE VIBRATION ELEMENT |
| FV FLOW CONTROL VALVE | VT VIBRATION TRANSMITTER |
| FVA FLOW CONTROL VALVE ALARM | XAH MISC. ALARM HORN |
| FVZI FLOW CONTROL VALVE POSITION INDICATOR | XAL MISC. ALARM LIGHT |
| HS HAND SWITCH | XIT MISC. INDICATOR/TRANSMITTER |
| II SIGNAL ISOLATOR | XPB MISC. PUSHBUTTON |
| LE LEVEL ELEMENT | XSA MISC. ALARM |
| LI LEVEL INDICATOR/TRANSMITTER | XSI MISC. RUNNING INDICATOR |
| LS LEVEL SWITCH | YC START/STOP, CONTROL, RUN/STOP |
| LSH LEVEL SWITCH HIGH | YY TRANSFER SWITCH |
| LSL LEVEL SWITCH LOW | ZCC POSITION CLOSED COMMAND |
| LSLL LEVEL SWITCH LOW-LOW | ZCO POSITION OPEN COMMAND |
| LT LEVEL TRANSMITTER | ZS POSITION SWITCH |
| PDT DIFFERENTIAL PRESSURE TRANSMITTER | ZSC POSITION SWITCH CLOSED INDICATOR |
| PI PRESSURE INDICATOR/TRANSMITTER | ZSI POSITION SWITCH INDICATOR |
| PSHL PRESSURE SWITCH - HIGH/LOW | ZSO POSITION SWITCH OPEN INDICATOR |

CONTROL CONDUIT NUMBER DESCRIPTION

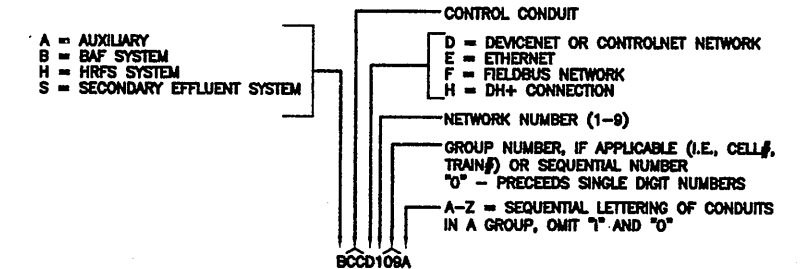

ABBREVIATIONS

| | | |
|-------------------------------------|---|--|
| % PERCENT | ELEV. ELEVATOR | ORG ORANGE |
| @ AT | ES ELECTRIC SUPPLY | P.S. PUMP STATION |
| A AMPERES | Ø DIAMETER OR PHASE | PA PUBLIC ADDRESS |
| A/R AS REQUIRED | F.M. FORCE MAIN | PB PULL BOX |
| AC ALTERNATING CURRENT | FACP FIRE ALARM CONTROL PANEL | PD POSITIVE DISPLACEMENT |
| ADMIN. ADMINISTRATION | FL FLOOR | PDC POWER DISTRIBUTION CENTER |
| AI ANALOG INPUT | FO FIBER OPTIC | PL PILOT LIGHT |
| AO ANALOG OUTPUT | FT, FT. FEET | PLC PROGRAMMABLE LOGIC CONTROLLER |
| BAF BIOLOGICAL AERATED FILTER | FU FUSE | POB PLANT OPERATIONS BUILDING |
| BLDG. BUILDING | G, GRD. GROUND | POT. POTABLE |
| BLK. BLACK | GAL. GALLON | PS POWER SUPPLY |
| BW BACKWASH | GALV. GALVANIZED | PVC POLYVINYL CHLORIDE |
| C. CONDUIT | GB GROUND BUSS | R.O.W. RIGHT OF WAY |
| CAT. CATEGORY | GPD GALLONS PER DAY | REC RECEPTACLE |
| CB CIRCUIT BREAKER | GWD GYPSUM WALL BOARD | REQ'D REQUIRED |
| CCTV CLOSED-CIRCUIT TELEVISION | HOA HAND-OFF-AUTO | RGS RIGID GALVANIZED STEEL |
| CHEM. CHEMICAL | HRFS HIGH-RATE FLOCCULATED SETTLING | RMC RIGID METAL CONDUIT |
| CL2 CHLORINE | HTR HEATER | S/SL START/STOP |
| CM, COM. COMMON | HVAC HEATING, VENTILATION, AND AIR CONDITIONING | SCADA SUPERVISORY CONTROL AND DATA ACQUISITION |
| COAX COAXIAL CABLE | I/O INPUT/OUTPUT | SCC SYSTEM CONTROL CENTER |
| CORP. CORPORATE | JB JUNCTION BOX | SEC. EFF. SECONDARY EFFLUENT |
| CPT CONTROL POWER TRANSFORMER | JUNCT. JUNCTION | SH SHIELD |
| CPU CONTROL PROCESSING UNIT | KV KILOVOLTS | SPEC MATERIAL AND PERFORMANCE SPECIFICATION |
| CPVC CHLORINATED POLYVINYL CHLORIDE | KVA KILOVOLT AMPERES | SQL SEQUEL |
| CR CONTROL RELAY | LAN LOCAL AREA NETWORK | SS STAINLESS STEEL |
| CR CONTROL ROOM | LOR LOCAL-OFF-REMOTE | TB TERMINAL BLOCK |
| CRGS COATED RIGID GALVANIZED STEEL | LP LIGHTING PANELBOARD | TBD TO BE DETERMINED |
| CSU CHANNEL SERVICE UNIT | MAINT. MAINTENANCE | TERT. P.S. TERTIARY PUMP STATION |
| D DEEP | MCC MOTOR CONTROL CENTER | TPS TWISTED PAIR SHIELDED |
| DC DIRECT CURRENT | MDF MAIN DISTRIBUTION FRAME | TS, T-STAT THERMOSTAT |
| DDC DIRECT DIGITAL CONTROL | MFG. MANUFACTURER | TYP. TYPICAL |
| DI DISCRETE INPUT | MIN. MINIMUM | UPS UNINTERRUPTABLE POWER SUPPLY |
| DIST. DISTRIBUTION | MUC MULTI-UNIT CONTROLLER | UV ULTRAVIOLET |
| DN DIVISION | N NEUTRAL | V VOLTS |
| DO DEVICENET NETWORK | NEMA NATIONAL ELECTRICAL MANUFACTURER'S ASSOCIATION | VAC VOLTS ALTERNATING CURRENT |
| DSU DATA SERVICE UNIT | NO., # NUMBER | Vdc VOLTS DIRECT CURRENT |
| DWG. DRAWING | NPT NATIONAL PIPE THREAD | VFD VARIABLE FREQUENCY DRIVE |
| EFF. EFFLUENT | 'F DEGREES FAHRENHEIT | W WIDE |
| EL, EL. ELEVATION | OIS OPERATOR INTERFACE STATION | W/ WITH |
| | | WHT WHITE |

RECORD DRAWING

THESE DRAWINGS HAVE BEEN CHECKED TO REFLECT MAJOR CHANGES, IF ANY, WHICH OCCURRED DURING CONSTRUCTION. REVISIONS ARE BASED UPON INFORMATION SUPPLIED BY CONTRACTOR.

DATE: 10/21/05 FOR: Lampsol

THIS DRAWING WAS PREPARED AT THE SCALE INDICATED IN THE TITLE BLOCK. INACCURACIES IN THE STATED SCALE MAY BE INTRODUCED WHEN DRAWINGS ARE REPRODUCED BY ANY MEANS. USE THE GRAPHIC SCALE BAR IN THE TITLE BLOCK TO DETERMINE THE ACTUAL SCALE OF THIS DRAWING.

ONONDAGA COUNTY • DEPARTMENT OF DRAINAGE AND SANITATION • SYRACUSE, NEW YORK
METROPOLITAN SYRACUSE WASTEWATER TREATMENT PLANT
STAGE III AMMONIA AND STAGE II PHOSPHORUS REMOVAL PROJECT



File Number


00659

Date

APRIL 2001

1-001

GENERAL NOTES, LEGEND & ABBREVIATIONS
INSTRUMENTATION

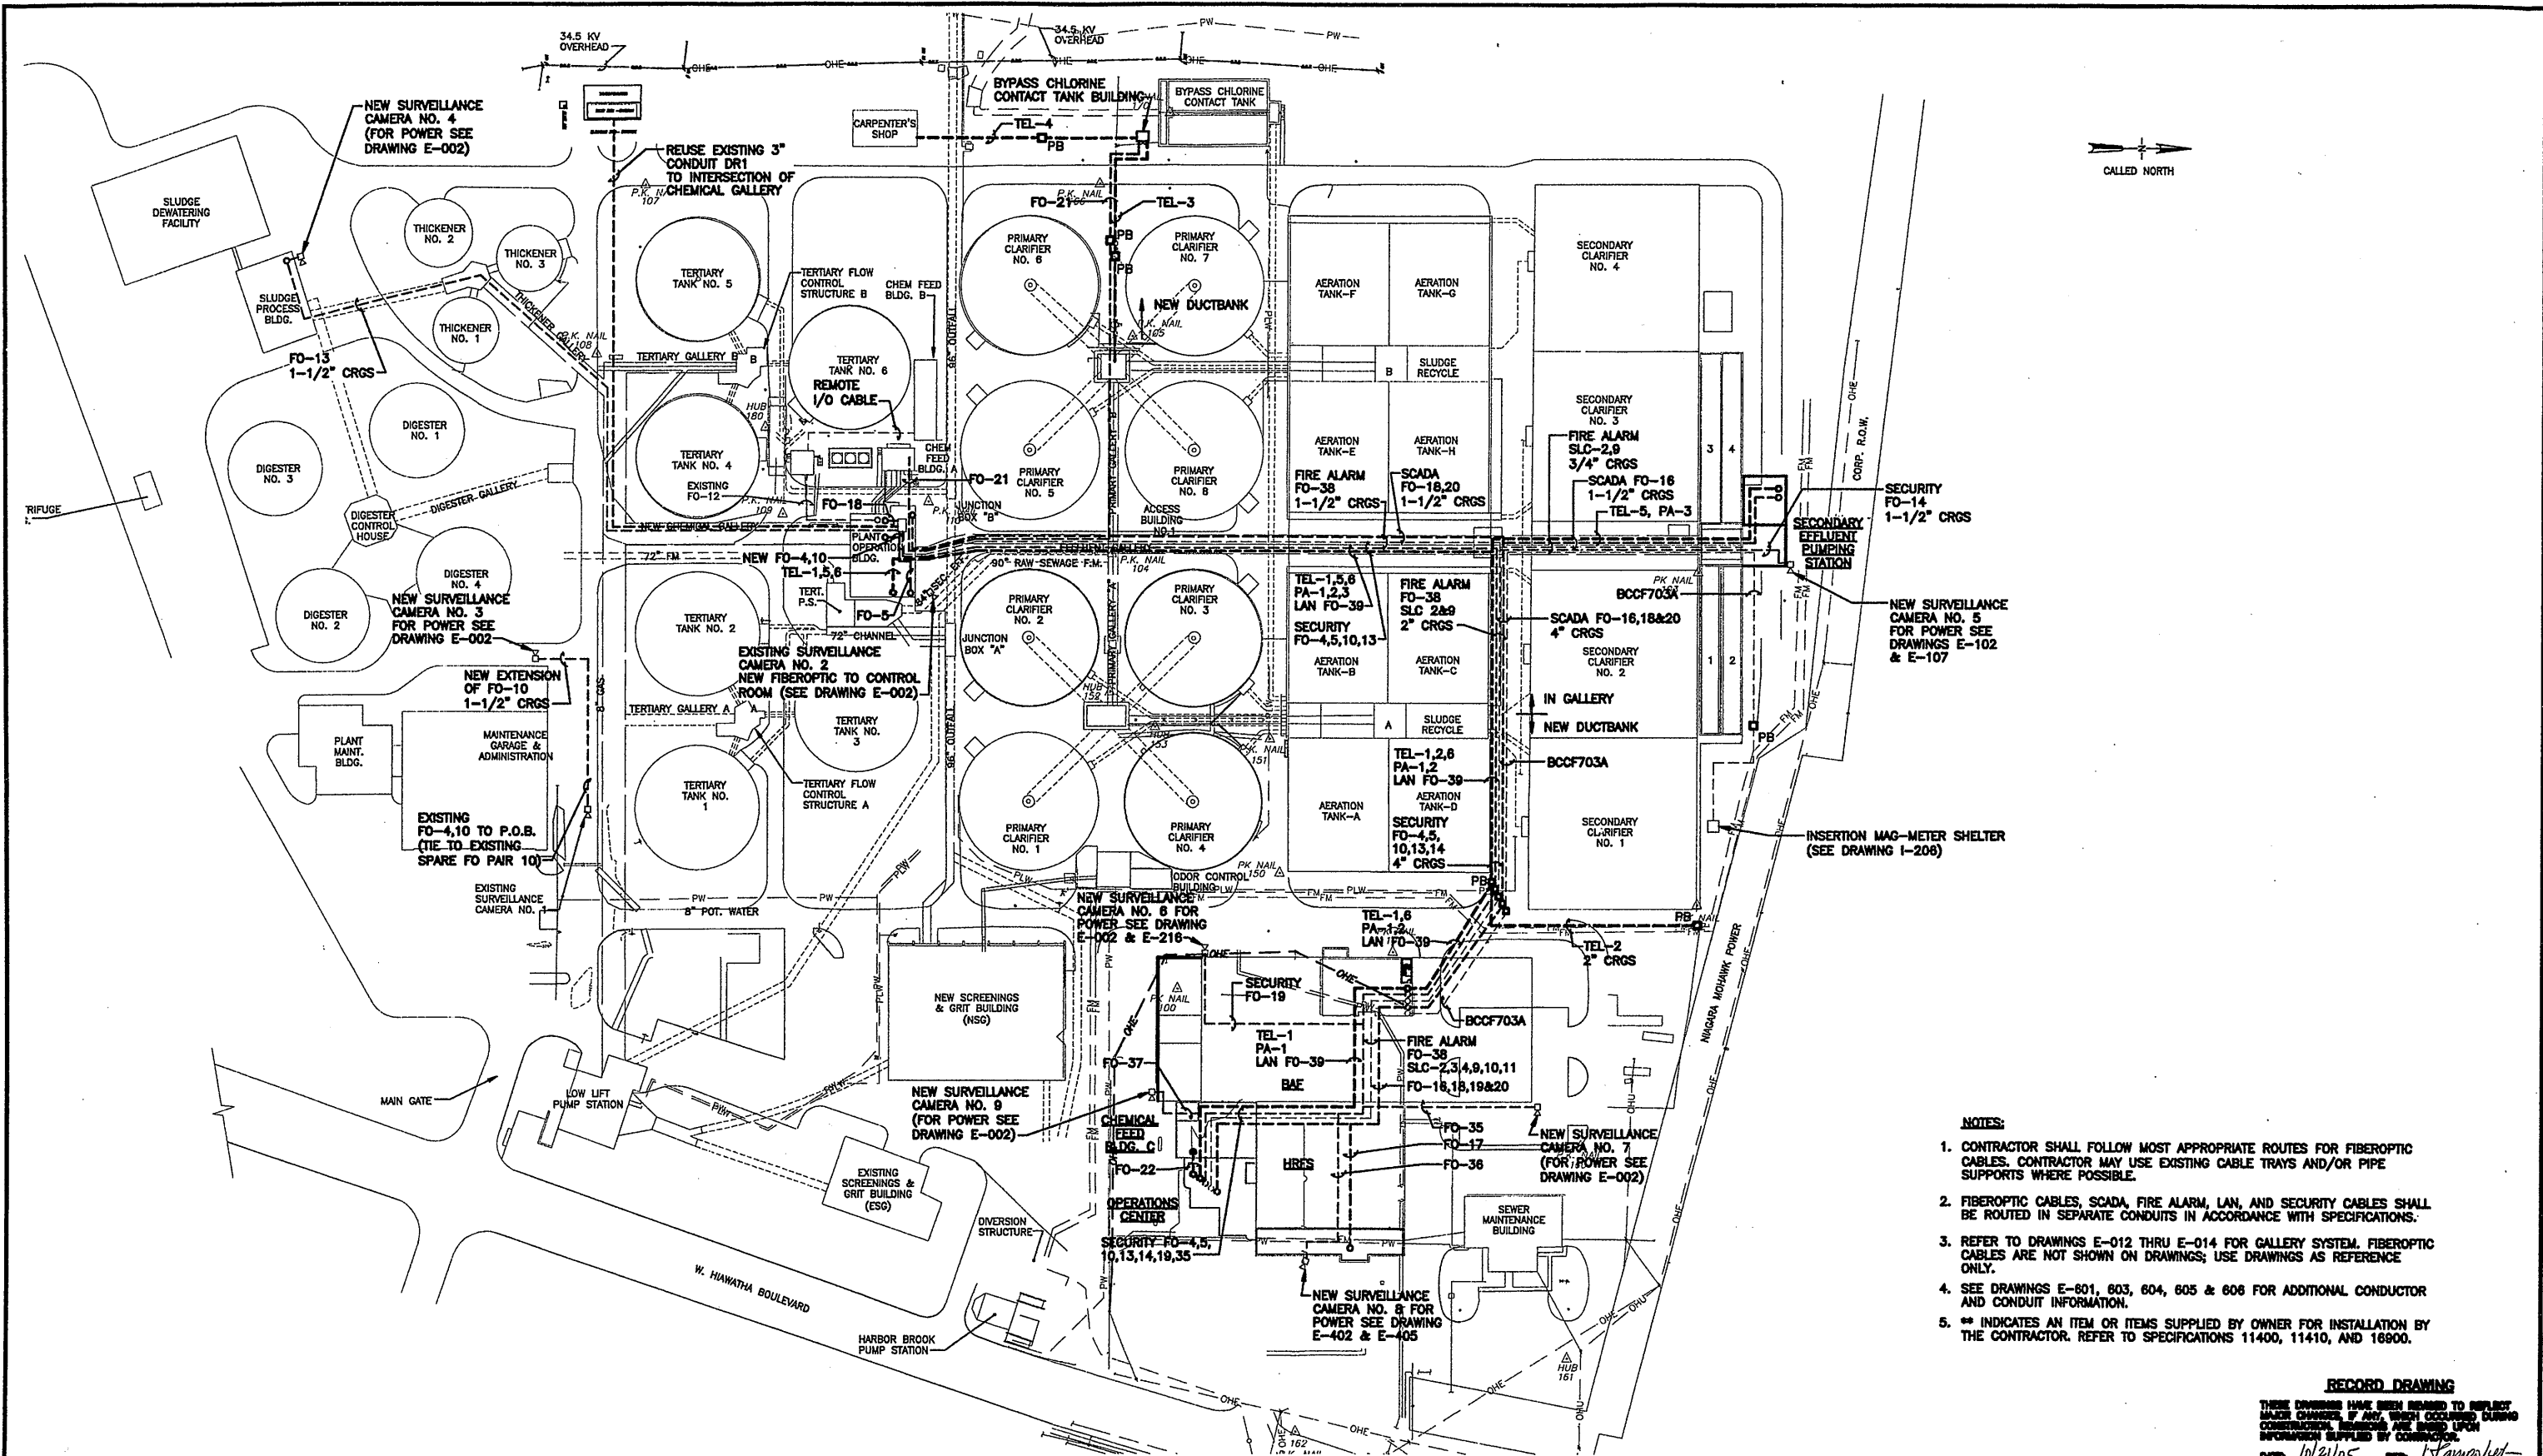


SITE PLAN
SCALE: 1"=80'-0"

- NOTES:**
- CONTRACTOR SHALL FOLLOW MOST APPROPRIATE ROUTES FOR FIBEROPTIC CABLES. CONTRACTOR MAY USE EXISTING CABLE TRAYS AND/OR PIPE SUPPORTS WHERE POSSIBLE.
 - FIBEROPTIC CABLES, SCADA, FIRE ALARM, LAN, AND SECURITY CABLES SHALL BE ROUTED IN SEPARATE CONDUITS IN ACCORDANCE WITH SPECIFICATIONS.
 - REFER TO DRAWINGS E-012 THRU E-014 FOR GALLERY SYSTEM. FIBEROPTIC CABLES ARE NOT SHOWN ON DRAWINGS; USE DRAWINGS AS REFERENCE ONLY.
 - SEE DRAWINGS E-601, 603, 604, 605 & 606 FOR ADDITIONAL CONDUCTOR AND CONDUIT INFORMATION.
 - ** INDICATES AN ITEM OR ITEMS SUPPLIED BY OWNER FOR INSTALLATION BY THE CONTRACTOR. REFER TO SPECIFICATIONS 11400, 11410, 11410, AND 16900.

RECORD DRAWING
 THESE DRAWINGS HAVE BEEN REVISIONED TO REFLECT
 ANY CHANGES, IF ANY, WHICH OCCURRED DURING
 CONSTRUCTION. REVISIONS ARE BASED UPON
 INFORMATION SUPPLIED BY CONTRACTOR.
 DWG 102105 PER [Signature]

THIS DRAWING WAS PREPARED AT THE SCALE INDICATED IN THE TITLE BLOCK. INACCURACIES IN THE STATED SCALE MAY BE INTRODUCED WHEN DRAWINGS ARE REPRODUCED BY ANY MEANS. USE THE GRAPHIC SCALE BAR IN THE TITLE BLOCK TO DETERMINE THE ACTUAL SCALE OF THIS DRAWING.

Layer: ON=*; OFF=*REF*
 X: 0659X048, FOOTPRINT1.DWG
 4/10/01 BBL DCC
 05503000/06591002.DWG

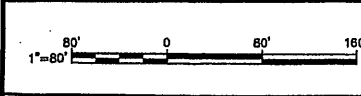

| No. | Date | Revisions | Init |
|-----|----------|---------------------|------|
| 0 | 4/20/01 | ISSUED FOR APPROVAL | TEL |
| 1 | 7/11/01 | AS BID | TEL |
| 2 | 10/31/05 | RECORD DRAWING | DCC |


In charge of --- TEL
 Designed by --- TEL
 Drawn by --- DCC
 Checked by --- FKP

ENVIRONMENTAL ENGINEERING ASSOCIATES, LLP
 SYRACUSE, NEW YORK

ONONDAGA COUNTY • DEPARTMENT OF DRAINAGE AND SANITATION • SYRACUSE, NEW YORK
 METROPOLITAN SYRACUSE WASTEWATER TREATMENT PLANT
 STAGE III AMMONIA AND STAGE II PHOSPHORUS REMOVAL PROJECT

CONTROL SYSTEM SITE PLAN

INSTRUMENTATION

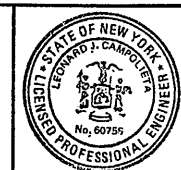

File Number
00659
 Date
APRIL 2000
 I-002
 [Signature]

NO ALTERATIONS PERMITTED HEREON EXCEPT AS PROVIDED UNDER SECTION 7209 SUBDIVISION 2 OF THE NEW YORK STATE EDUCATION LAW

FIBER OPTIC CABLE NUMBER ASSIGNMENTS

| NO. | FROM | TO | REMARKS |
|-------|--|--|------------------------|
| FD-1 | LINKSYS HUB @ SLUDGE SIDE B | EXISTING SWITCH @ POB CONTROL ROOM | EXISTING TO REMAIN |
| FD-2 | LINKSYS HUB @ SLUDGE SIDE A | EXISTING SWITCH @ POB CONTROL ROOM | EXISTING TO REMAIN |
| FD-3 | LOW LIFT PS | EXISTING SWITCH @ SLUDGE CONTROL ROOM | EXISTING TO REMAIN |
| FD-3A | SCREEN & GRIT BLDG. | MODBUS/ETHERNET BRIDGE @ SLUDGE BLDG. | EXISTING TO REMAIN |
| FD-4 | SURVEILLANCE CAMERAL NO. 1 | OPERATIONS CENTER THIRD FLOOR CR | EXISTING TO REMAIN |
| FD-5 | SURVEILLANCE CAMERAL NO. 2 | OPERATIONS CENTER THIRD FLOOR CR | EXISTING TO REMAIN |
| FD-6 | ADMIN. BLDG. ELEVATOR ROOM | EXISTING SWITCH @ SLUDGE CONTROL RM. | NEW |
| FD-7 | ADMIN. BLDG. ELEVATOR ROOM | EXISTING SWITCH @ POB CONTROL ROOM | NEW/EXISTING TO REMAIN |
| FD-8 | FIRE ALARM SYSTEM | OPERATIONS CENTER THIRD FLOOR CR | NEW |
| FD-9 | EXISTING SWITCH @ ADMIN. BLDG. | EXISTING ROUTER @ POB CONTROL ROOM | EXISTING TO REMAIN |
| FD-10 | NEW SURVEILLANCE CAMERAL NO. 3 | OPERATIONS CENTER THIRD FLOOR CR | NEW |
| FD-11 | LAN COMMUNICATIONS (POB BASEMENT) | OPERATIONS CENTER THIRD FLOOR CR | EXISTING TO REMAIN |
| FD-12 | GAS COMPRESSOR BLDG. | EXISTING SWITCH @ POB CONTROL ROOM | NEW |
| FD-13 | NEW SURVEILLANCE CAMERAL NO. 4 | SLUDGE BUILDING | NEW |
| FD-14 | NEW SURVEILLANCE CAMERAL NO. 5 | SEPS | EXISTING TO REMAIN |
| FD-15 | LINKSYS HUB @ SLUDGE BLDG. | EXISTING SWITCH @ SLUDGE CONTROL ROOM | NEW |
| FD-16 | SECONDARY EFFLUENT PS PLC M13 | OPERATIONS CENTER THIRD FLOOR CR SWITCH | NEW |
| FD-17 | UV DISINFECT / PARSHALL PLC M14 | OPERATIONS CENTER THIRD FLOOR CR SWITCH | NEW |
| FD-18 | EXISTING SWITCH "A" @ POB CONTROL ROOM | OPERATORS CENTER 3rd FLOOR CR SWICH "D" | NEW |
| FD-19 | NEW SURVEILLANCE CAMERAL NO. 6 | BAF | NEW |
| FD-20 | MAIN ELECTRIC SUBSTATION | EXISTING SWITCH @ POB CONTROL ROOM | NEW |
| FD-21 | CHLORINE BYPASS BUILDING | CHEMICAL BUILDING "A" | NEW |
| FD-22 | NOT USED | | NEW |
| FD-23 | BAF ELECTRIC ROOM PLC M24 | OPERATIONS CENTER THIRD FLOOR CR SWITCH | NEW |
| FD-31 | BAF/HRFS CONTROL PANEL HUB | OPERATIONS CENTER THIRD FLOOR CR SWITCH | NEW |
| FD-32 | BAF/HRFS CONTROL PANEL HUB | BAF VIEW PC AT OPERATIONS CENTER THIRD FLOOR CR | NEW |
| FD-33 | BAF/HRFS CONTROL PANEL HUB | OPERATIONS CENTER THIRD FLOOR CR SWITCH | NEW |
| FD-34 | BAF/HRFS CONTROL PANEL HUB | HRFS VIEW PC AT OPERATIONS CENTER THIRD FLOOR CR | NEW |
| FD-35 | NEW SURVEILLANCE CAMERAL NO. 7 | BAF | NEW |
| FD-36 | NEW SURVEILLANCE CAMERAL NO. 8 | UV | NEW |
| FD-37 | NEW SURVEILLANCE CAMERAL NO. 9 | BAF | NEW |

FIBER OPTIC CABLE NOTES:

- EXISTING FIBER OPTIC CABLE TO POB 3rd FLOOR CONTROL ROOM. SWITCH "A" TO REMAIN IN POB CONTROL ROOM.
- GENERALLY ALL ETHERNET CONNECTIONS LONGER THAN 100 FEET SHALL UTILIZE FIBER OPTIC CABLE.

PLC NUMBERING ASSIGNMENTS

| NO. | LOCATION | PROVIDED BY | REMARKS |
|--------------|---|----------------------------|------------------------------|
| PLC-M01 | SLUDGE PROCESSING BLDG. 2nd FLOOR | EXISTING (SI) | |
| PLC-M01B | SLUDGE PROCESSING BLDG. - 2nd FLOOR REM I/O | EXISTING (SI) | |
| PLC-M02 | LOW LIFT PUMP STATION | EXISTING (SI) | |
| PLC-M03 | SLUDGE RECYCLE BUILDING "A" | EXISTING (SI) | |
| PLC-M04 | SLUDGE RECYCLE BUILDING "B" | EXISTING (SI) | |
| PLC-M05 | POB 3rd FLOOR CONTROL ROOM MUX 5 | EXISTING (SI) | |
| PLC-M06 | POB 3rd FLOOR CONTROL ROOM MUX 6 | EXISTING (SI) | |
| PLC-M07 | SLUDGE DEWATERING FIRST FLOOR (MODICON #1) | EXISTING | |
| PLC-M08 | DIGESTER CONTROL HOUSE (MODICON #2) | EXISTING | |
| PLC-M09 | SCREEN & GRIT BUILDING (MODICON #3) | EXISTING | |
| PLC-M10 | AERATION SIDE "A" | EXISTING | |
| PLC-M11 | AERATION SIDE "B" | EXISTING | |
| PLC-M12 | "NOT ASSIGNED" | | |
| PLC-M13 | SECONDARY EFFLUENT PUMP STATION | CONTRACT 4B - ELECTRIC | W/LOCAL PANELVIEW |
| PLC-M14 | UV DISINFECT / PARSHALL FLUME | CONTRACT 4A - GENERAL | W/LOCAL AND REMOTE PANELVIEW |
| PLC-M15 | "NOT ASSIGNED" | | |
| PLC-M16 | CHEMICAL BUILDING "C" | CONTRACT 4B - ELECTRIC | |
| PLC-M17A/B/C | HRFS / BAF CONTROL PANEL (HRFS SECTION) | OWNER (US FILTER / KRUGER) | W/LOCAL PANELVIEW |
| PLC-M18 | M12000 CHEMICAL FEED CONTROL PANEL | OWNER (US FILTER / KRUGER) | W/LOCAL PANELVIEW |
| PLC-M18A/B/C | HRFS / BAF CONTROL PANEL (BAF SECTION) | OWNER (US FILTER / KRUGER) | W/LOCAL PANELVIEW |
| PLC-M20A | GAS COMPRESSOR BLDG. | EXISTING | W/LOCAL PANELVIEW |
| PLC-M20B | CHEMICAL BUILDING "B" | EXISTING | W/LOCAL PANELVIEW |
| PLC-M20C | CHEMICAL BUILDING "A" | CONTRACT 4B - ELECTRICAL | W/LOCAL PANELVIEW |
| PLC-M20D | CHLORINE BYPASS BLDG. | CONTRACT 4B - ELECTRICAL | W/LOCAL PANELVIEW |
| PLC-M21 | BLOWER ROOM CONTROL PANEL | OWNER (US FILTER / KRUGER) | W/LOCAL PANELVIEW |
| PLC-M22 | BLOWER ROOM CONTROL PANEL | OWNER (US FILTER / KRUGER) | W/LOCAL PANELVIEW |
| PLC-M23 | POB 4th FLOOR - BURNET AVE DIAL-UP | EXISTING | W/LOCAL PANELVIEW |
| PLC-M24 | BAF ELECTRIC ROOM | CONTRACT 4B - ELECTRICAL | W/LOCAL PANELVIEW |

OPERATOR INTERFACE TERMINAL (OIT) AND SUPPORT EQUIPMENT NUMBERING

| NO. | LOCATION | RESPONSIBILITY | REMARKS |
|------------------------|-----------------------------------|--------------------------|------------|
| DEWATER 1 VIEW | SLUDGE DEWATERING CONTROL ROOM | EXISTING (SI) | |
| DEWATER 2 VIEW | SLUDGE DEWATERING CONTROL ROOM | EXISTING (SI) | |
| METRO 1A SERVER | OPERATIONS CENTER SCADA ROOM | EXISTING (SI) | SEE NOTE 1 |
| METRO 1B SERVER | OPERATIONS CENTER SCADA ROOM | EXISTING (SI) | SEE NOTE 1 |
| METRO SQL SERVER | OPERATIONS CENTER SCADA ROOM | EXISTING (SI) | SEE NOTE 1 |
| NETWORK ADMIN | ADMINISTRATION BUILDING | EXISTING (SI) | |
| METRO 2 VIEW | OPERATIONS CENTER CONTROL ROOM | EXISTING (SI) | SEE NOTE 1 |
| METRO 3 VIEW | OPERATIONS CENTER LAB (OC-304) | EXISTING (SI) | SEE NOTE 1 |
| HIAWATHA 1 VIEW | OPERATIONS CENTER CONTROL ROOM | EXISTING | SEE NOTE 1 |
| FRANKLIN/BURNET 1 VIEW | OPERATIONS CENTER CONTROL ROOM | EXISTING | SEE NOTE 1 |
| BAF VIEW | OPERATIONS CENTER CONTROL ROOM | US FILTER (KRUGER) | SEE NOTE 2 |
| HRFS VIEW | OPERATIONS CENTER CONTROL ROOM | US FILTER (KRUGER) | SEE NOTE 2 |
| METRO 4 VIEW | OPERATIONS CENTER OFFICE (OC-305) | CONTRACT 4B - ELECTRICAL | |
| LARGE SCREEN 1 | OPERATIONS CENTER CONTROL ROOM | CONTRACT 4B - ELECTRICAL | |
| LARGE SCREEN 2 | OPERATIONS CENTER CONTROL ROOM | CONTRACT 4B - ELECTRICAL | |
| DDC SYSTEM | OPERATIONS CENTER SCADA ROOM | CONTRACT 4C - HVAC | SEE NOTE 3 |
| CISCO 4500 ROUTER | POB 3rd FLOOR CONTROL ROOM | EXISTING (SI) | TO REMAIN |
| 24 PORT SWITCH "A" | POB 3rd FLOOR CONTROL ROOM | EXISTING (SI) | TO REMAIN |
| 24 PORT SWITCH "B" | SLUDGE DEWATERING CONTROL ROOM | EXISTING (SI) | TO REMAIN |
| 24 PORT SWITCH "C" | ADMINISTRATION BLDG. | EXISTING (SI) | TO REMAIN |
| 24 PORT SWITCH "D" | OPERATIONS CONTROL ROOM | CONTRACT 4B - ELECTRICAL | |
| ENERGY MANAGE. SERVER | OPERATIONS CENTER SCADA ROOM | CONTRACT 4B - ELECTRICAL | |

OIT AND SUPPORT EQUIPMENT NOTES:

- UNDER CONTRACT 4B - ELECTRICAL, THIS EQUIPMENT WILL BE RELOCATED FROM THE PLANT OPERATIONS BUILDING (POB) 3rd FLOOR CONTROL ROOM TO THE OPERATIONS CENTER CONTROL ROOM. STARTUP AND TESTING BY CONTRACT 4B - ELECTRICAL.
- THIS EQUIPMENT SHALL BE PROVIDED BY THE OWNER THROUGH US FILTER (KRUGER). IT WILL BE INSTALLED AND INTERCONNECTED BY CONTRACT 4B - ELECTRICAL. STARTUP AND TESTING BY THE OWNER THROUGH US FILTER (KRUGER) WITH THE ASSISTANCE OF CONTRACT 4B - ELECTRICAL.
- THIS EQUIPMENT SHALL BE PROVIDED BY CONTRACT 4C - HVAC. CONTRACT 4B - ELECTRICAL SHALL PROVIDE INTERCONNECTING CABLING, AS SHOWN.

04/11/01 OBG DW59 CRV
0659/003

NOT TO SCALE

| No. | Date | Revisions | Init |
|-----|----------|---------------------|------|
| 0 | 4/20/01 | ISSUED FOR APPROVAL | LC |
| 1 | 7/11/01 | AS BID | |
| 2 | 10/31/03 | RECORD DRAWING | |

In charge of ___ PLD ___
Designed by ___ PLD ___
Drawn by ___ CRV ___
Checked by ___ SAT ___



ONE ONDAGA COUNTY • DEPARTMENT OF DRAINAGE AND SANITATION • SYRACUSE, NEW YORK
METROPOLITAN SYRACUSE WASTEWATER TREATMENT PLANT
STAGE III AMMONIA AND STAGE II PHOSPHORUS REMOVAL PROJECT

SCADA SYSTEM NOTES AND SCHEDULES


INSTRUMENTATION



File Number
00659
Date
APRIL 2001
LCampoliet

1-003

RECORD DRAWING
THESE CHANGES HAVE BEEN REVIEWED TO REFLECT MAJOR CHANGES IF ANY, WHICH OCCURRED DURING CONSTRUCTION. REVISIONS ARE BASED UPON INFORMATION SUPPLIED BY CONTRACTOR.
DATE: 10/11/03 FILE: LCampoliet
THIS DRAWING WAS PREPARED AT THE SCALE INDICATED IN THE TITLE BLOCK. INACCURACIES IN THE STATED SCALE MAY BE INTRODUCED WHEN DRAWINGS ARE REPRODUCED BY ANY MEANS. USE THE GRAPHIC SCALE BAR IN THE TITLE BLOCK TO DETERMINE THE ACTUAL SCALE OF THIS DRAWING.

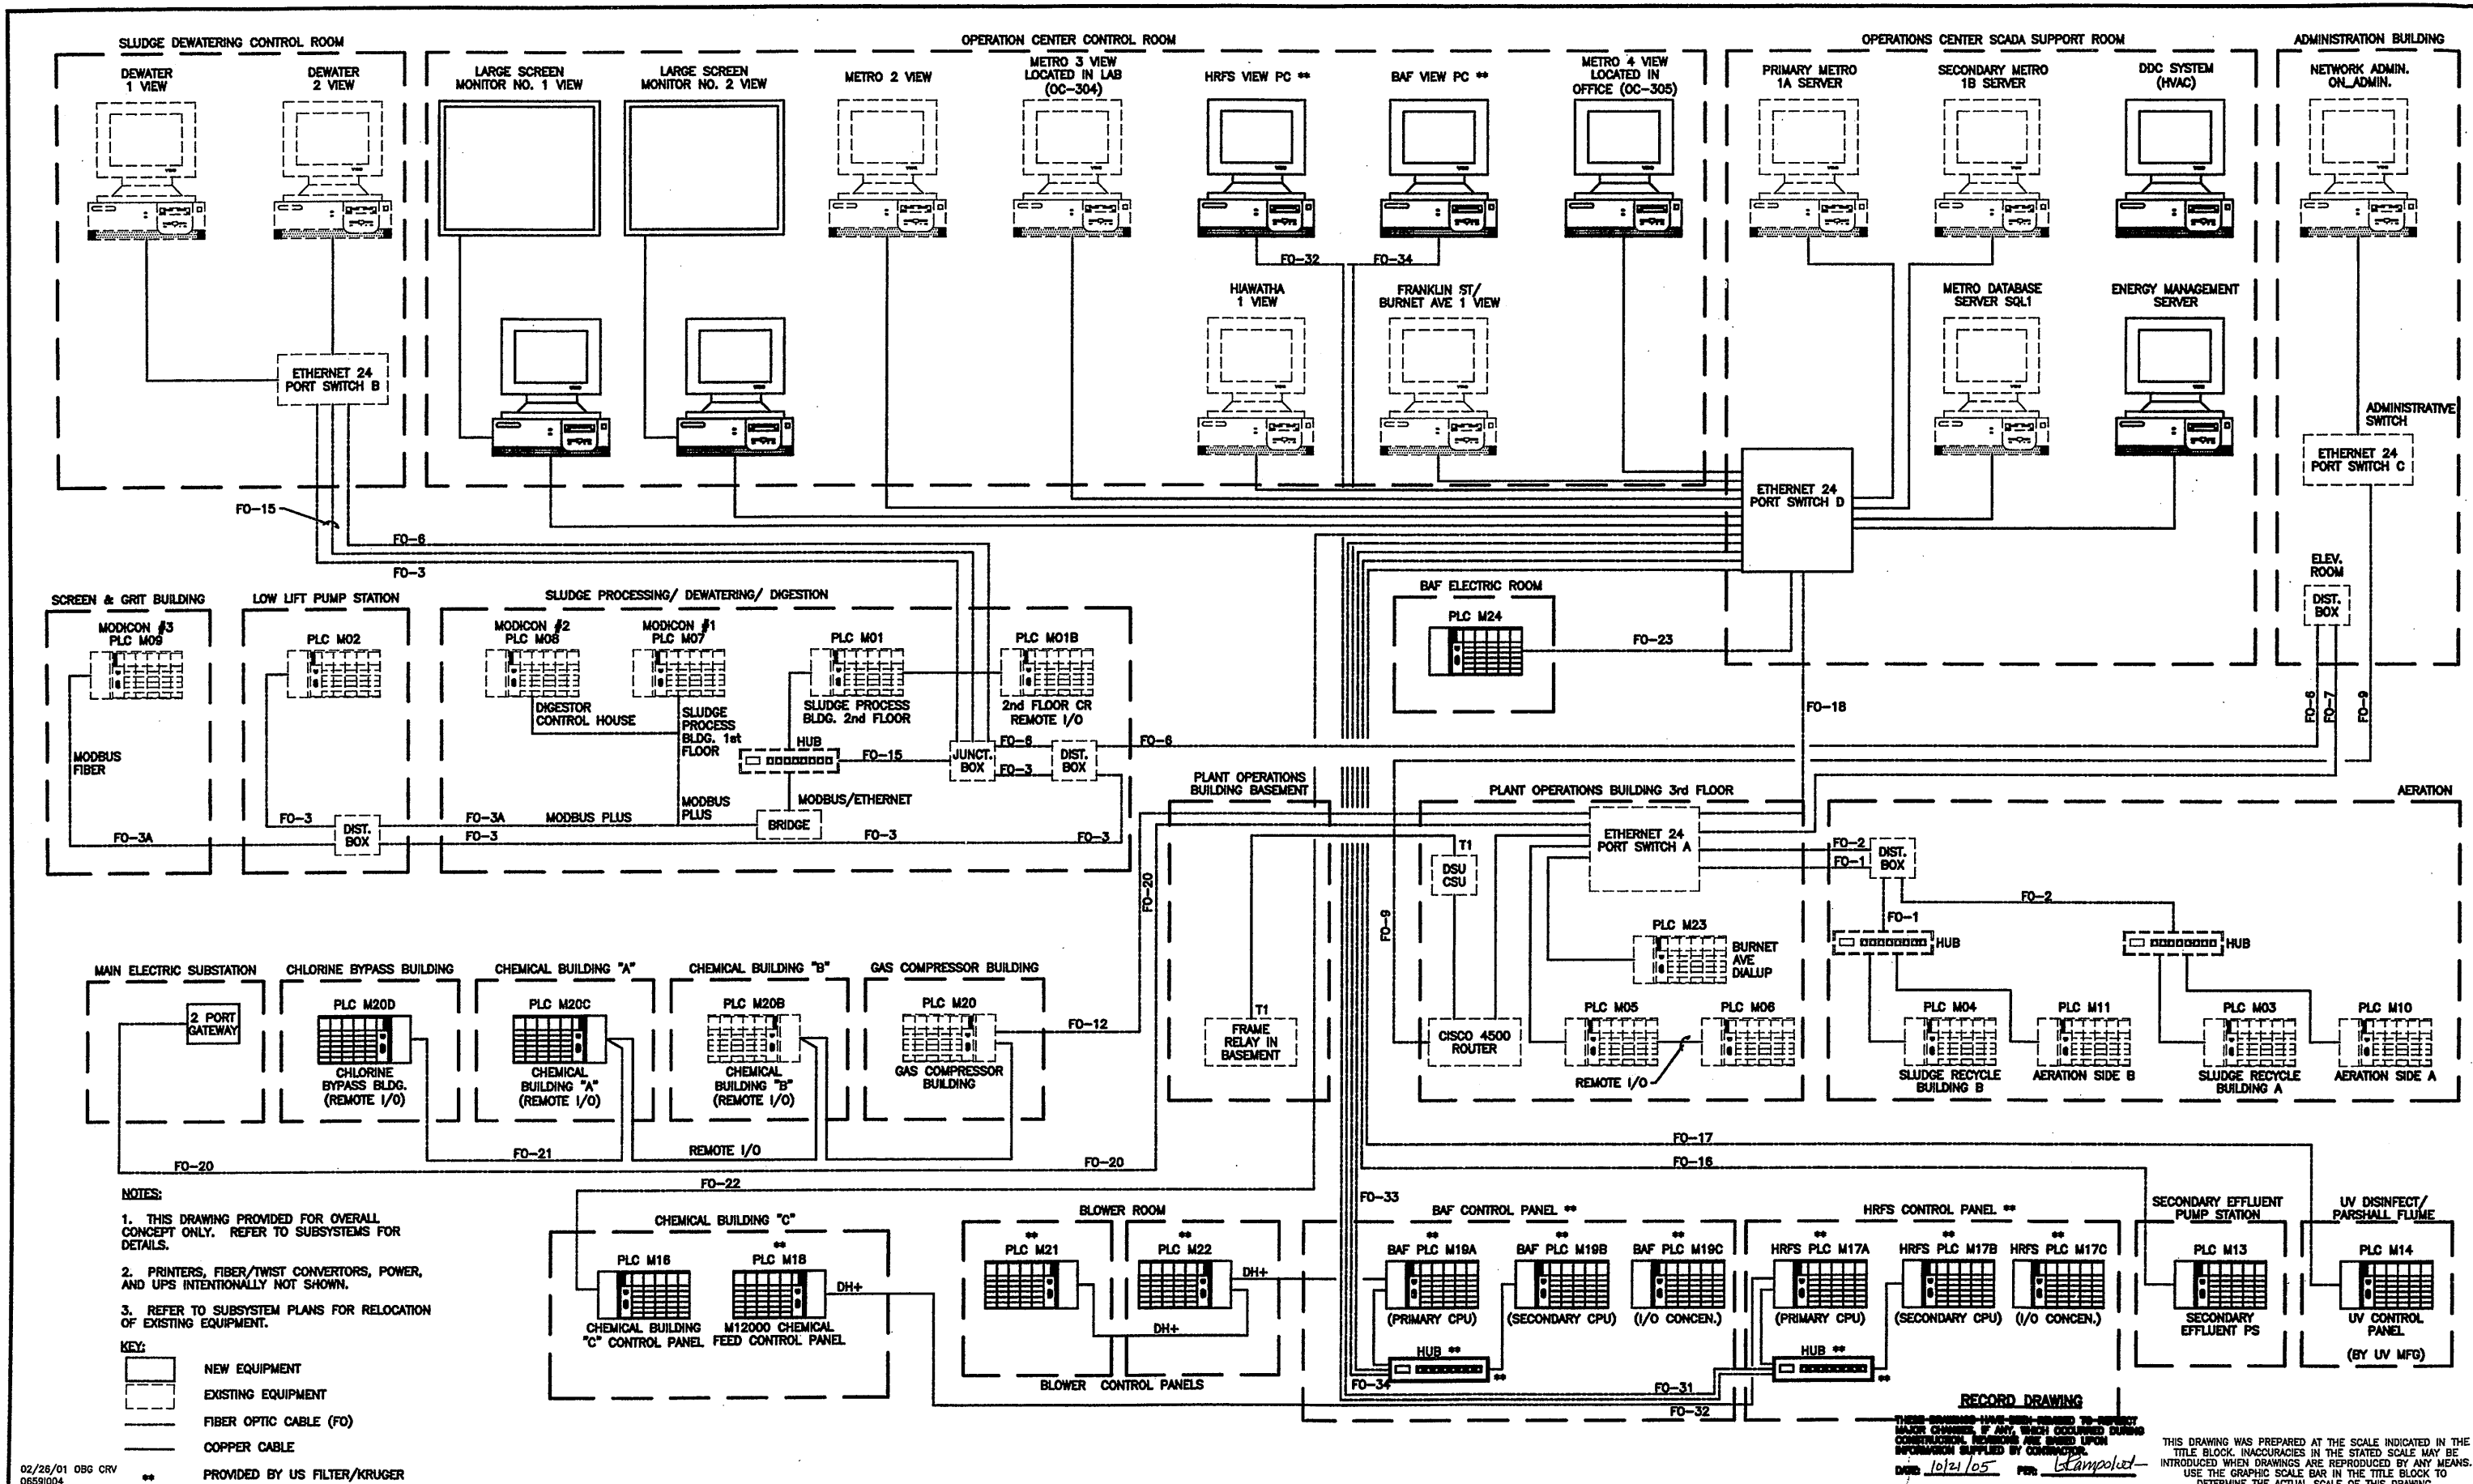

NOTES:

- THIS DRAWING PROVIDED FOR OVERALL CONCEPT ONLY. REFER TO SUBSYSTEMS FOR DETAILS.
- PRINTERS, FIBER/TWIST CONVERTORS, POWER, AND UPS INTENTIONALLY NOT SHOWN.
- REFER TO SUBSYSTEM PLANS FOR RELOCATION OF EXISTING EQUIPMENT.

KEY:

- NEW EQUIPMENT
- EXISTING EQUIPMENT
- FIBER OPTIC CABLE (FO)
- COPPER CABLE

PROVIDED BY US FILTER/KRUGER

RECORD DRAWING

THIS DRAWING WAS PREPARED AT THE SCALE INDICATED IN THE TITLE BLOCK. INACCURACIES IN THE STATED SCALE MAY BE INTRODUCED WHEN DRAWINGS ARE REPRODUCED BY ANY MEANS. USE THE GRAPHIC SCALE BAR IN THE TITLE BLOCK TO DETERMINE THE ACTUAL SCALE OF THIS DRAWING.

DATE: 10/21/05 FOR: Stampolet

02/26/01 DBG CRV
06591004

NOT TO SCALE

NO ALTERATIONS PERMITTED HEREON EXCEPT AS PROVIDED UNDER SECTION 7209 SUBDIVISION 2 OF THE NEW YORK STATE EDUCATION LAW

| No. | Date | Revisions | Init |
|-----|----------|---------------------|------|
| 0 | 4/20/01 | ISSUED FOR APPROVAL | PLD |
| 1 | 7/11/01 | AS BID | PLD |
| 2 | 10/31/05 | RECORD DRAWING | SAT |

In charge of _____ PLD
Designed by _____ PLD
Drawn by _____ CRV
Checked by _____ SAT

ENVIRONMENTAL ENGINEERING ASSOCIATES, LLP
SYRACUSE, NEW YORK


ONONDAGA COUNTY • DEPARTMENT OF DRAINAGE AND SANITATION • SYRACUSE, NEW YORK
METROPOLITAN SYRACUSE WASTEWATER TREATMENT PLANT
STAGE III AMMONIA AND STAGE II PHOSPHORUS REMOVAL PROJECT

SCADA SYSTEM SCHEMATIC OVERALL ONLINE

INSTRUMENTATION

File Number: 006591004
Date: APRIL 2001
I-004

Stampolet

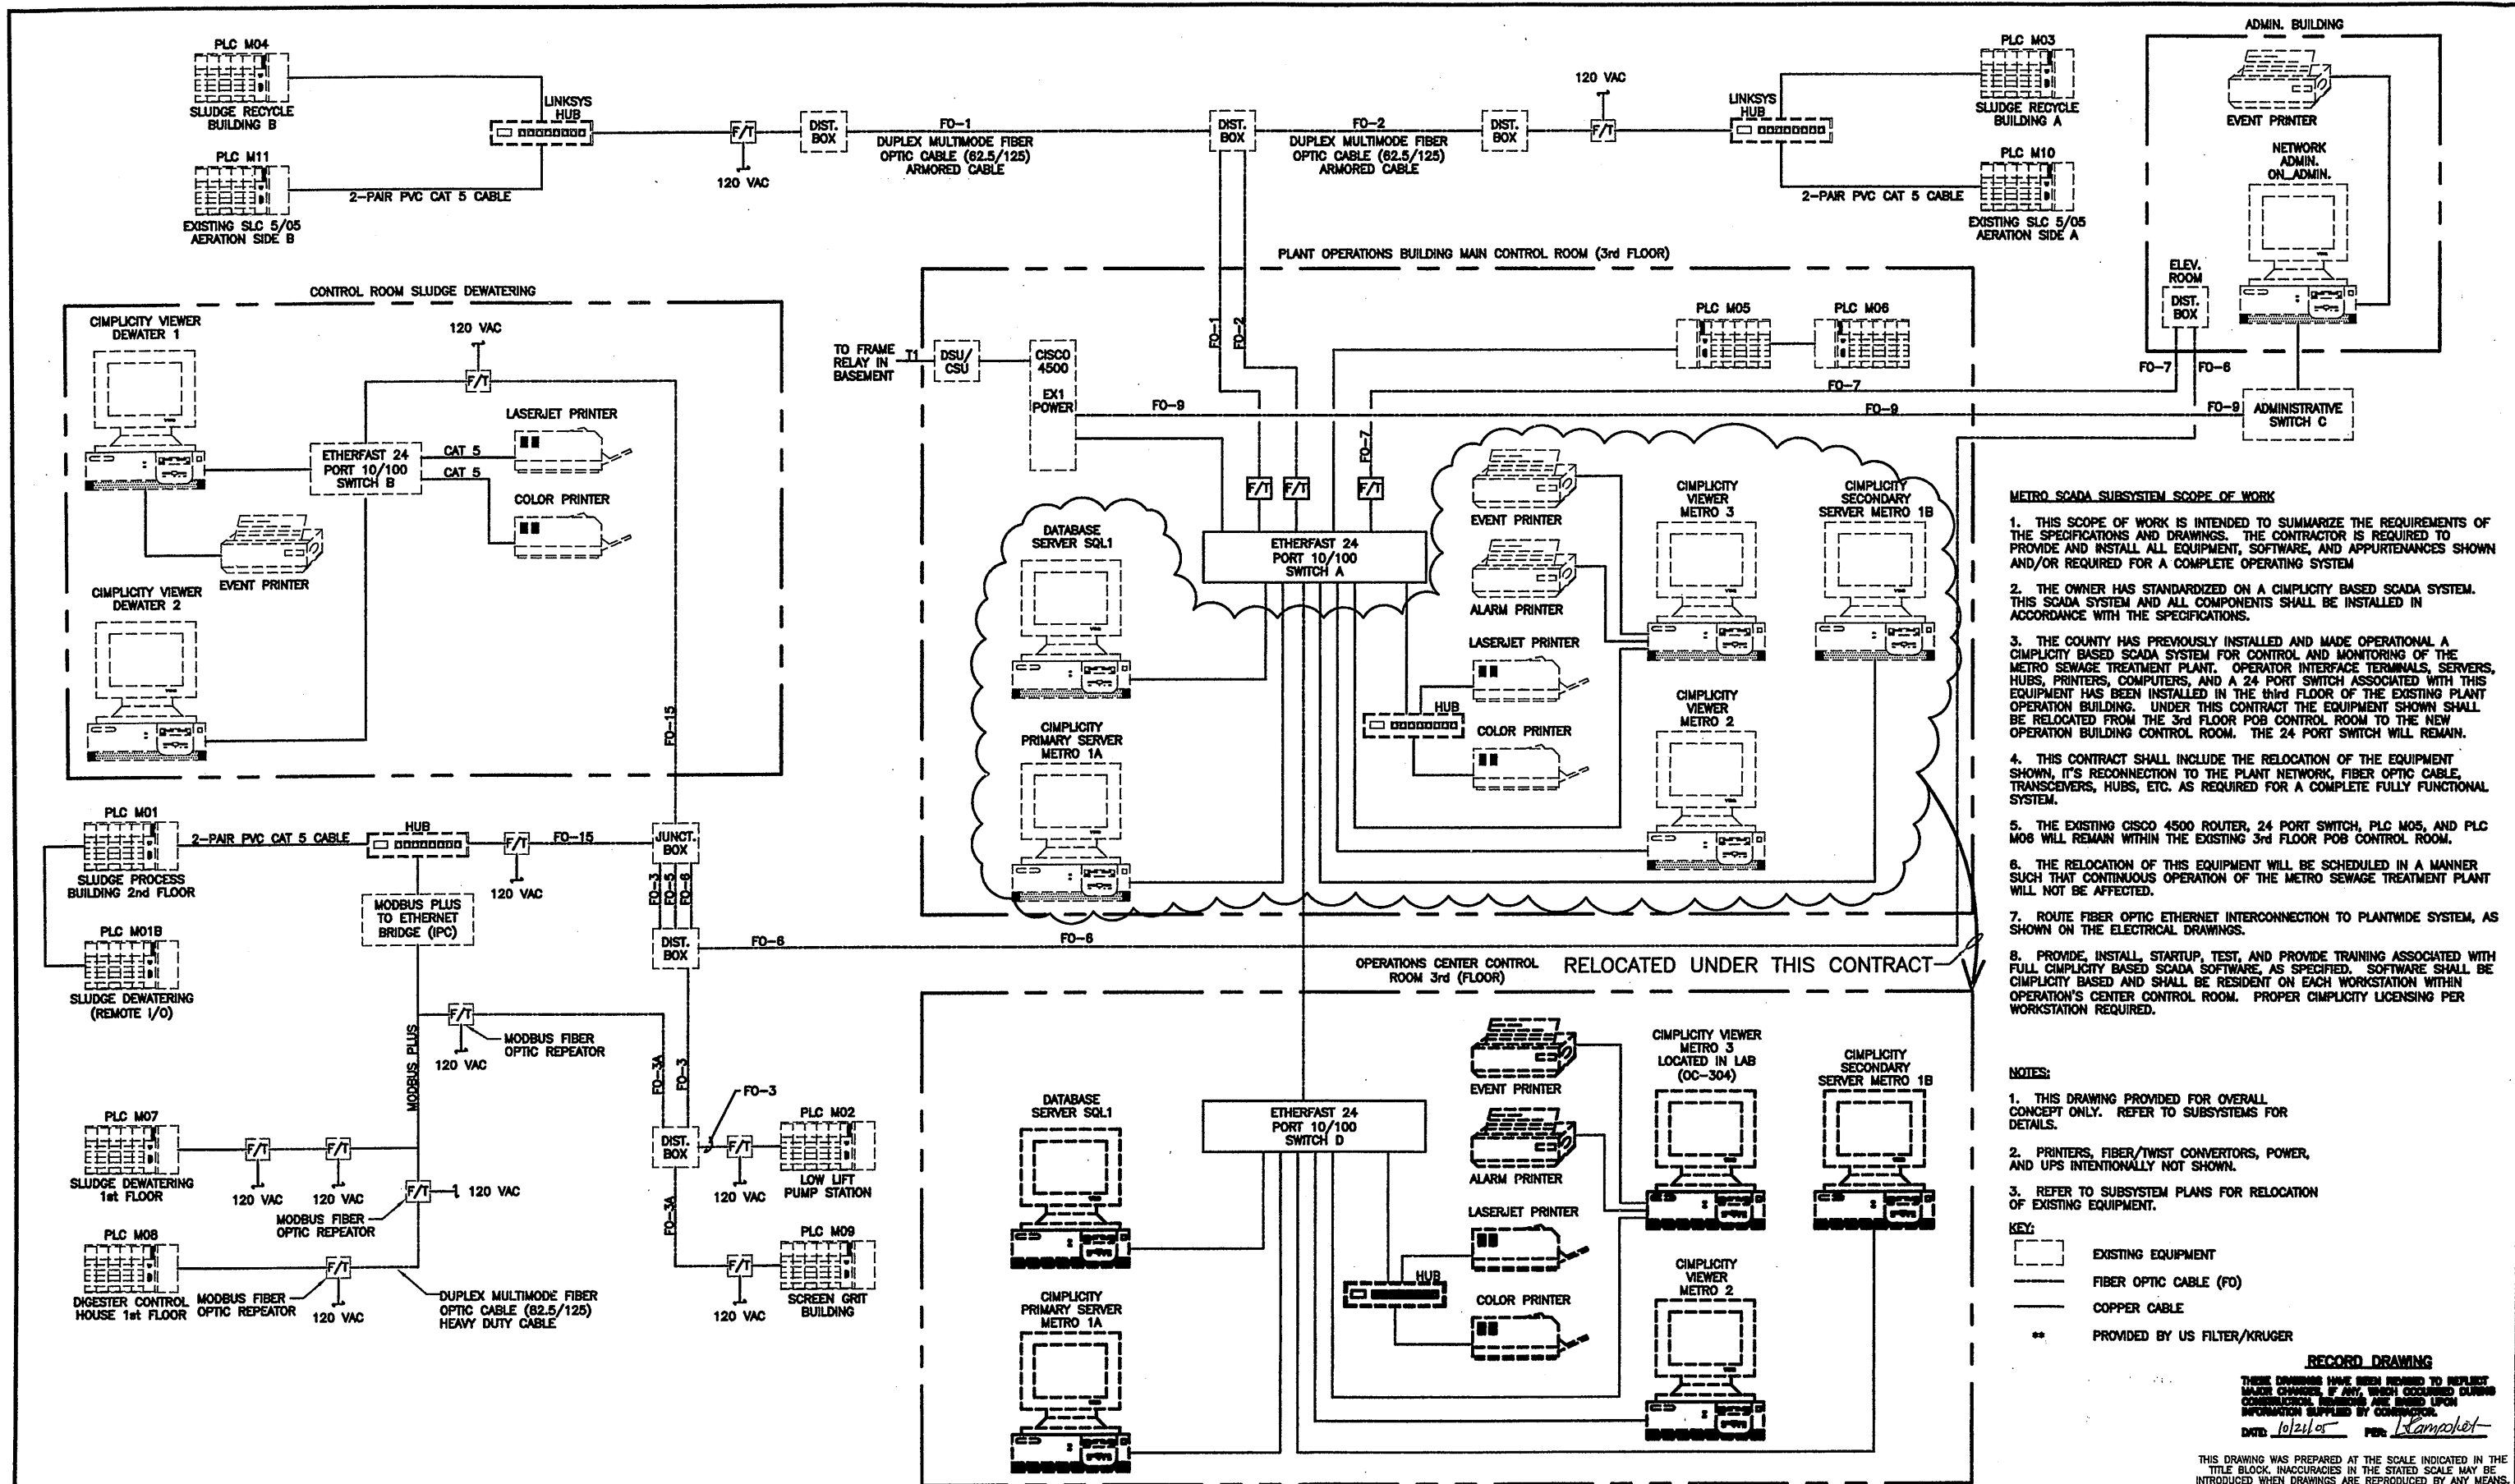

- METRO SCADA SUBSYSTEM SCOPE OF WORK**
1. THIS SCOPE OF WORK IS INTENDED TO SUMMARIZE THE REQUIREMENTS OF THE SPECIFICATIONS AND DRAWINGS. THE CONTRACTOR IS REQUIRED TO PROVIDE AND INSTALL ALL EQUIPMENT, SOFTWARE, AND APPURTENANCES SHOWN AND/OR REQUIRED FOR A COMPLETE OPERATING SYSTEM.
 2. THE OWNER HAS STANDARDIZED ON A CIMPLICITY BASED SCADA SYSTEM. THIS SCADA SYSTEM AND ALL COMPONENTS SHALL BE INSTALLED IN ACCORDANCE WITH THE SPECIFICATIONS.
 3. THE COUNTY HAS PREVIOUSLY INSTALLED AND MADE OPERATIONAL A CIMPLICITY BASED SCADA SYSTEM FOR CONTROL AND MONITORING OF THE METRO SEWAGE TREATMENT PLANT. OPERATOR INTERFACE TERMINALS, SERVERS, HUBS, PRINTERS, COMPUTERS, AND A 24 PORT SWITCH ASSOCIATED WITH THIS EQUIPMENT HAS BEEN INSTALLED IN THE THIRD FLOOR OF THE EXISTING PLANT OPERATION BUILDING. UNDER THIS CONTRACT THE EQUIPMENT SHOWN SHALL BE RELOCATED FROM THE 3RD FLOOR POB CONTROL ROOM TO THE NEW OPERATION BUILDING CONTROL ROOM. THE 24 PORT SWITCH WILL REMAIN.
 4. THIS CONTRACT SHALL INCLUDE THE RELOCATION OF THE EQUIPMENT SHOWN, IT'S RECONNECTION TO THE PLANT NETWORK, FIBER OPTIC CABLE, TRANSCEIVERS, HUBS, ETC. AS REQUIRED FOR A COMPLETE FULLY FUNCTIONAL SYSTEM.
 5. THE EXISTING CISCO 4500 ROUTER, 24 PORT SWITCH, PLC M05, AND PLC M06 WILL REMAIN WITHIN THE EXISTING 3RD FLOOR POB CONTROL ROOM.
 6. THE RELOCATION OF THIS EQUIPMENT WILL BE SCHEDULED IN A MANNER SUCH THAT CONTINUOUS OPERATION OF THE METRO SEWAGE TREATMENT PLANT WILL NOT BE AFFECTED.
 7. ROUTE FIBER OPTIC ETHERNET INTERCONNECTION TO PLANTWIDE SYSTEM, AS SHOWN ON THE ELECTRICAL DRAWINGS.
 8. PROVIDE, INSTALL, STARTUP, TEST, AND PROVIDE TRAINING ASSOCIATED WITH FULL CIMPLICITY BASED SCADA SOFTWARE, AS SPECIFIED. SOFTWARE SHALL BE CIMPLICITY BASED AND SHALL BE RESIDENT ON EACH WORKSTATION WITHIN OPERATION'S CENTER CONTROL ROOM. PROPER CIMPLICITY LICENSING PER WORKSTATION REQUIRED.

- NOTES:**
1. THIS DRAWING PROVIDED FOR OVERALL CONCEPT ONLY. REFER TO SUBSYSTEMS FOR DETAILS.
 2. PRINTERS, FIBER/TWIST CONVERTORS, POWER, AND UPS INTENTIONALLY NOT SHOWN.
 3. REFER TO SUBSYSTEM PLANS FOR RELOCATION OF EXISTING EQUIPMENT.
- KEY:**
- EXISTING EQUIPMENT
 - FIBER OPTIC CABLE (FO)
 - COPPER CABLE
 - ** PROVIDED BY US FILTER/KRUGER

RECORD DRAWING
 THESE DRAWINGS HAVE BEEN REVIEWED TO REFLECT MAJOR CHANGES, IF ANY, WHICH OCCURRED DURING CONSTRUCTION. REVISIONS ARE BASED UPON INFORMATION SUPPLIED BY CONTRACTOR.
 DATE: 10/21/05 PER: [Signature]

THIS DRAWING WAS PREPARED AT THE SCALE INDICATED IN THE TITLE BLOCK. INACCURACIES IN THE STATED SCALE MAY BE INTRODUCED WHEN DRAWINGS ARE REPRODUCED BY ANY MEANS. USE THE GRAPHIC SCALE BAR IN THE TITLE BLOCK TO DETERMINE THE ACTUAL SCALE OF THIS DRAWING.

02/26/01 OBG CRV
 06591005

| No. | Date | Revisions | Init |
|-----|----------|---------------------|------|
| 0 | 4/20/01 | ISSUED FOR APPROVAL | JK |
| 1 | 7/11/01 | AS BID | |
| 2 | 10/31/05 | RECORD DRAWING | |

NOT TO SCALE

NO ALTERATIONS PERMITTED HEREON EXCEPT AS PROVIDED UNDER SECTION 7209 SUBDIVISION 2 OF THE NEW YORK STATE EDUCATION LAW

In charge of: PLD
 Designed by: PLD
 Drawn by: CRV
 Checked by: SAT

ENVIRONMENTAL ENGINEERING ASSOCIATES, LLP
 SYRACUSE, NEW YORK

ONONDAGA COUNTY • DEPARTMENT OF DRAINAGE AND SANITATION • SYRACUSE, NEW YORK
 METROPOLITAN SYRACUSE WASTEWATER TREATMENT PLANT
 STAGE III AMMONIA AND STAGE II PHOSPHORUS REMOVAL PROJECT


SCADA SYSTEM SCHEMATIC
COUNTYWIDE SUBSYSTEM

INSTRUMENTATION

File Number: 006591005
 Date: APRIL 2001
 1-005

[Professional Engineer Seal: LEONARD J. CAMPBELL, No. 60795]

[Signature]

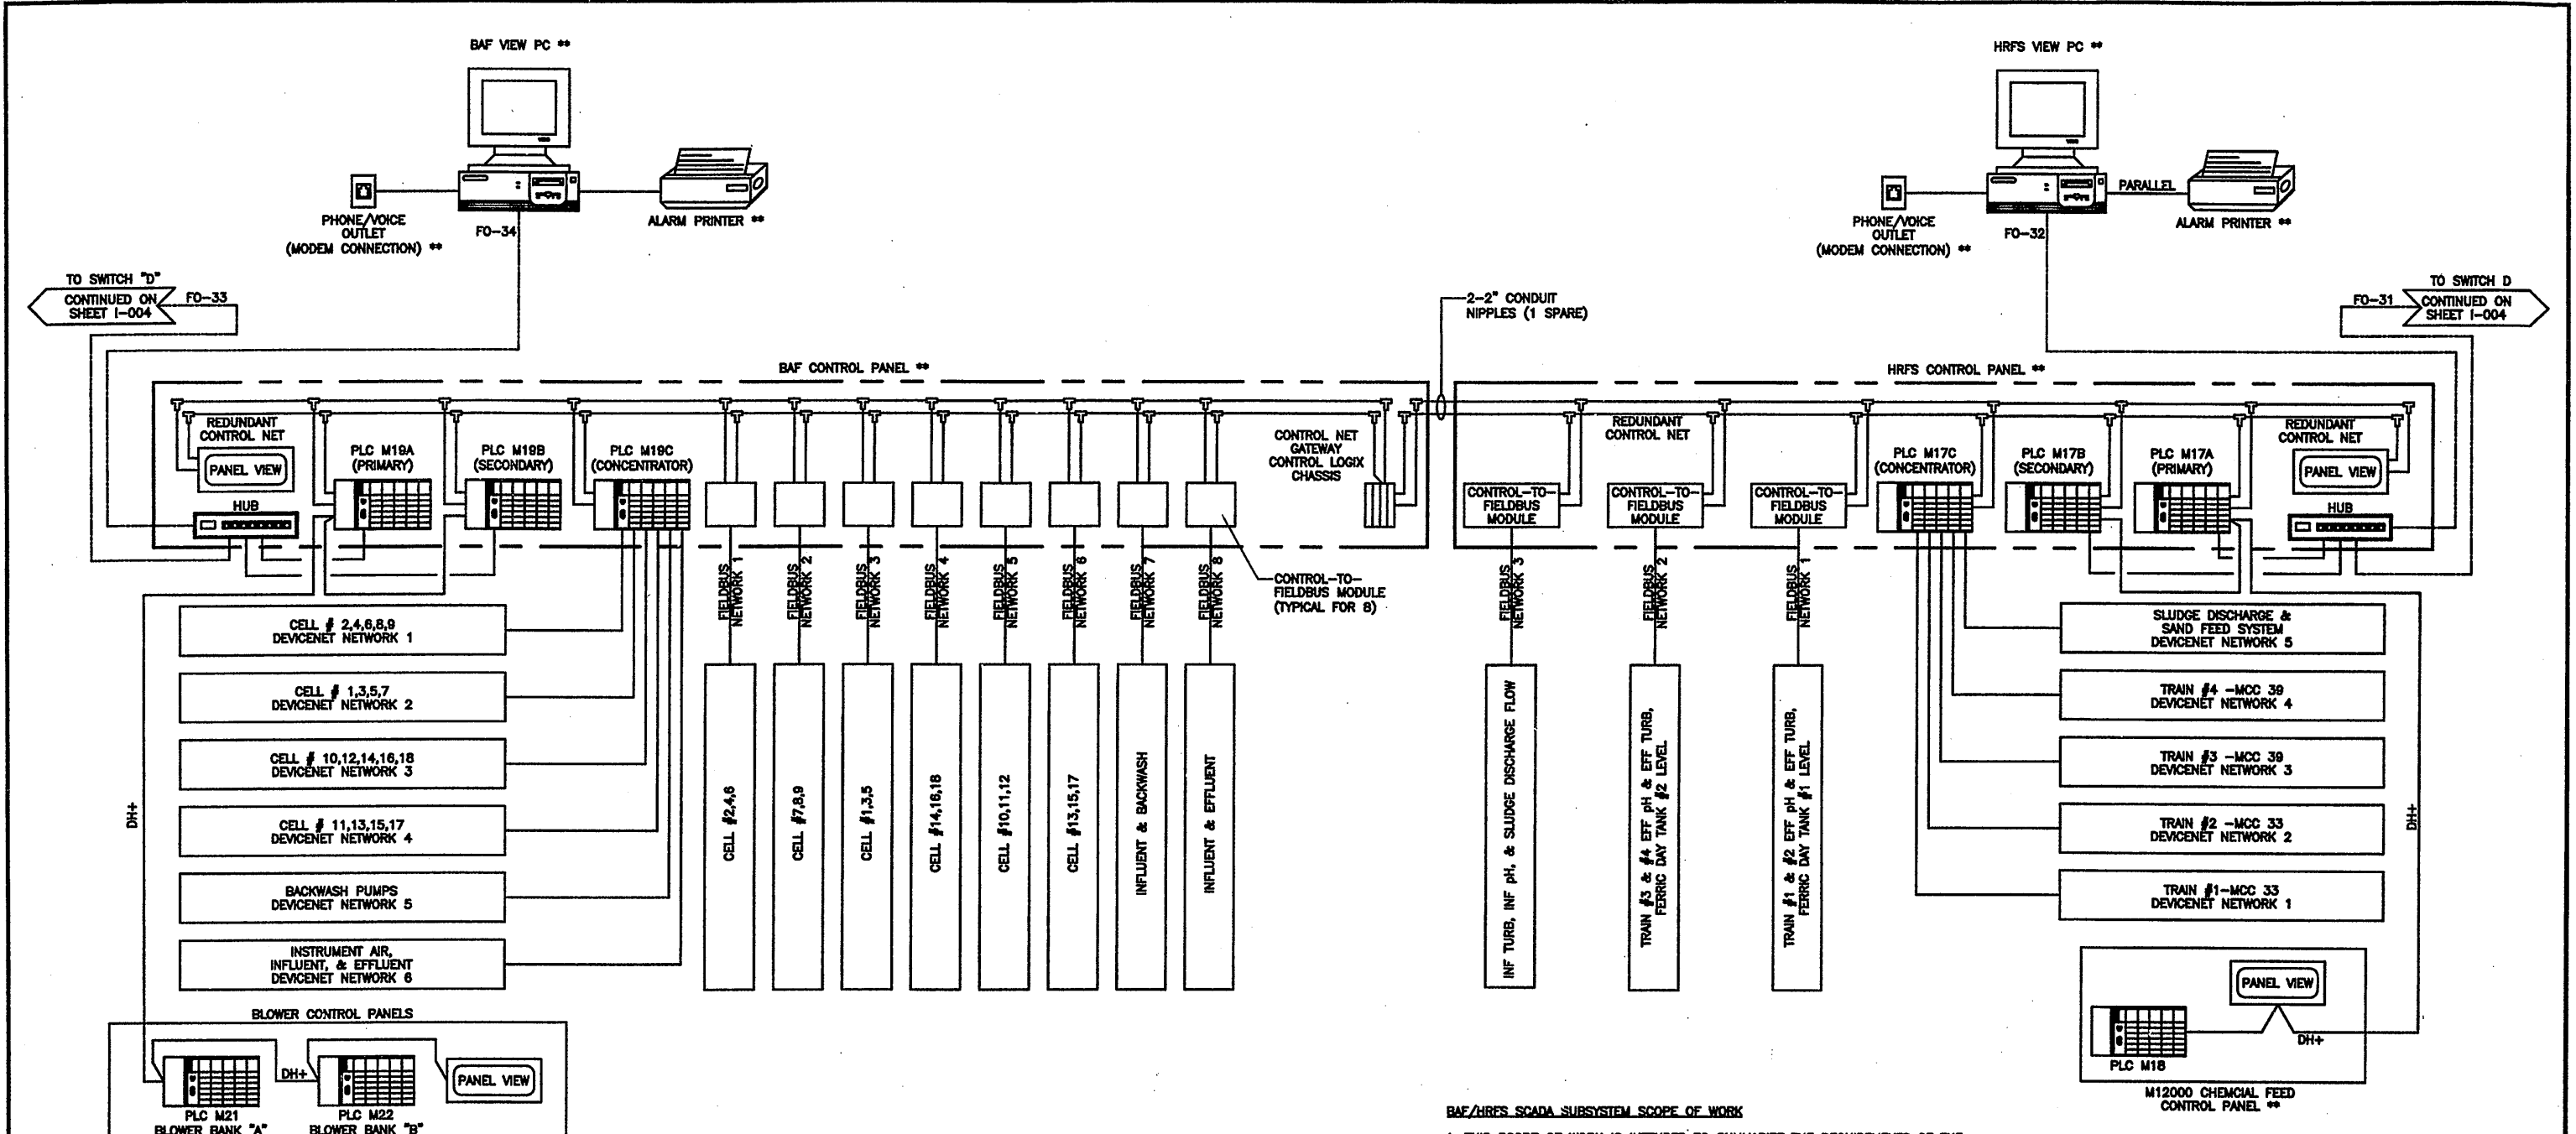

- NOTES:**
1. THIS DRAWING PROVIDED FOR OVERALL CONCEPT ONLY. REFER TO SUBSYSTEMS FOR DETAILS.
 2. PRINTERS, FIBER/TWIST CONVERTORS, POWER, AND UPS INTENTIONALLY NOT SHOWN.
 3. REFER TO SUBSYSTEM PLANS FOR RELOCATION OF EXISTING EQUIPMENT.
- KEY:**
- EXISTING EQUIPMENT
 - FIBER OPTIC CABLE (FO)
 - COPPER CABLE
 - ** PROVIDED BY US FILTER/KRUGER

- BAF/HRFS SCADA SUBSYSTEM SCOPE OF WORK**
1. THIS SCOPE OF WORK IS INTENDED TO SUMMARIZE THE REQUIREMENTS OF THE SPECIFICATIONS AND DRAWINGS. THE CONTRACTOR IS REQUIRED TO PROVIDE AND INSTALL ALL EQUIPMENT, SOFTWARE, AND APPURTENANCES SHOWN AND/OR REQUIRED FOR A COMPLETE OPERATING SYSTEM.
 2. THE OWNER HAS STANDARDIZED ON A SIMPLICITY BASED SCADA SYSTEM. THIS SCADA SYSTEM AND ALL COMPONENTS SHALL BE INSTALLED IN ACCORDANCE WITH THE SPECIFICATIONS.
 3. THE COUNTY HAS PREVIOUSLY CONTRACTED FOR A SIMPLICITY / A-B PLC BASED BAF / HRFS SCADA SUBSYSTEM WITH US FILTER / KRUGER. CONTRACT 48 ELECTRICAL SHALL INCLUDE THE INSTALLATION OF THE VARIOUS COMPONENTS ASSOCIATED WITH THIS SYSTEM INCLUDING, BUT NOT LIMITED TO THE TWO OPERATOR INTERFACE TERMINALS (OITs), PRINTERS, HUBS, TRANSCEIVERS, CONVERTERS, BAF/HRFS CONTROL PANEL, FIBER OPTIC AND COPPER INTERCONNECTION CABLES, SIGNAL WIRE, CONDUIT, ETC.
 4. THIS CONTRACT SHALL INCLUDE THE INSTALLATION OF THE EQUIPMENT SHOWN, IT'S CONNECTION TO THE PLANT NETWORK, FIBER OPTIC CABLE, TRANSCEIVERS, CONVERTERS, HUBS, ETC. AS REQUIRED FOR A COMPLETE FULLY FUNCTIONAL SYSTEM.
 5. ROUTE FIBER OPTIC ETHERNET INTERCONNECTION TO PLANTWIDE SYSTEM, AS SHOWN ON THE ELECTRICAL DRAWINGS.
 6. PROVIDE, INSTALL, AND ASSIST THE OWNER'S VENDOR (US FILTER / KRUGER) IN THE STARTUP, TESTING, AND TRAINING ASSOCIATED WITH THIS EQUIPMENT.

NOTE: PROVIDED BY US FILTER/KRUGER INSTALLED UNDER CONTRACT NO. 48 UNLESS OTHERWISE NOTED.

RECORD DRAWING
 THESE CHANGES HAVE BEEN REVIEWED TO REFLECT MAJOR CHANGES, IF ANY, WHICH OCCURRED DURING CONSTRUCTION. REVISIONS ARE BASED UPON INFORMATION SUPPLIED BY CONTRACTOR.
 DATE: 10/21/05 PER: [Signature]
 THIS DRAWING WAS PREPARED AT THE SCALE INDICATED IN THE TITLE BLOCK. INACCURACIES IN THE STATED SCALE MAY BE INTRODUCED WHEN DRAWINGS ARE REPRODUCED BY ANY MEANS. USE THE GRAPHIC SCALE BAR IN THE TITLE BLOCK TO DETERMINE THE ACTUAL SCALE OF THIS DRAWING.

04/10/01 OBG CRV
 06591006

NOT TO SCALE

NO ALTERATIONS PERMITTED HEREON EXCEPT AS PROVIDED UNDER SECTION 7209 SUBDIVISION 2 OF THE NEW YORK STATE EDUCATION LAW

| No. | Date | Revisions | Init |
|-----|----------|---------------------|------|
| 0 | 4/20/01 | ISSUED FOR APPROVAL | |
| 1 | 7/11/01 | AS BID | |
| 2 | 10/31/05 | RECORD DRAWING | |

In charge of ___ PLD ___
 Designed by ___ PLD ___
 Drawn by ___ CRV ___
 Checked by ___ SAT ___

ENVIRONMENTAL ENGINEERING ASSOCIATES, LLP
 SYRACUSE, NEW YORK

ONONDAGA COUNTY • DEPARTMENT OF DRAINAGE AND SANITATION • SYRACUSE, NEW YORK
 METROPOLITAN SYRACUSE WASTEWATER TREATMENT PLANT
 STAGE III AMMONIA AND STAGE II PHOSPHORUS REMOVAL PROJECT

SCADA SYSTEM SCHEMATIC
BAF/HRFS SUBSYSTEM


INSTRUMENTATION

File Number
 006591006



Date
 APRIL 2001

1-006



[Professional Engineer Seal]

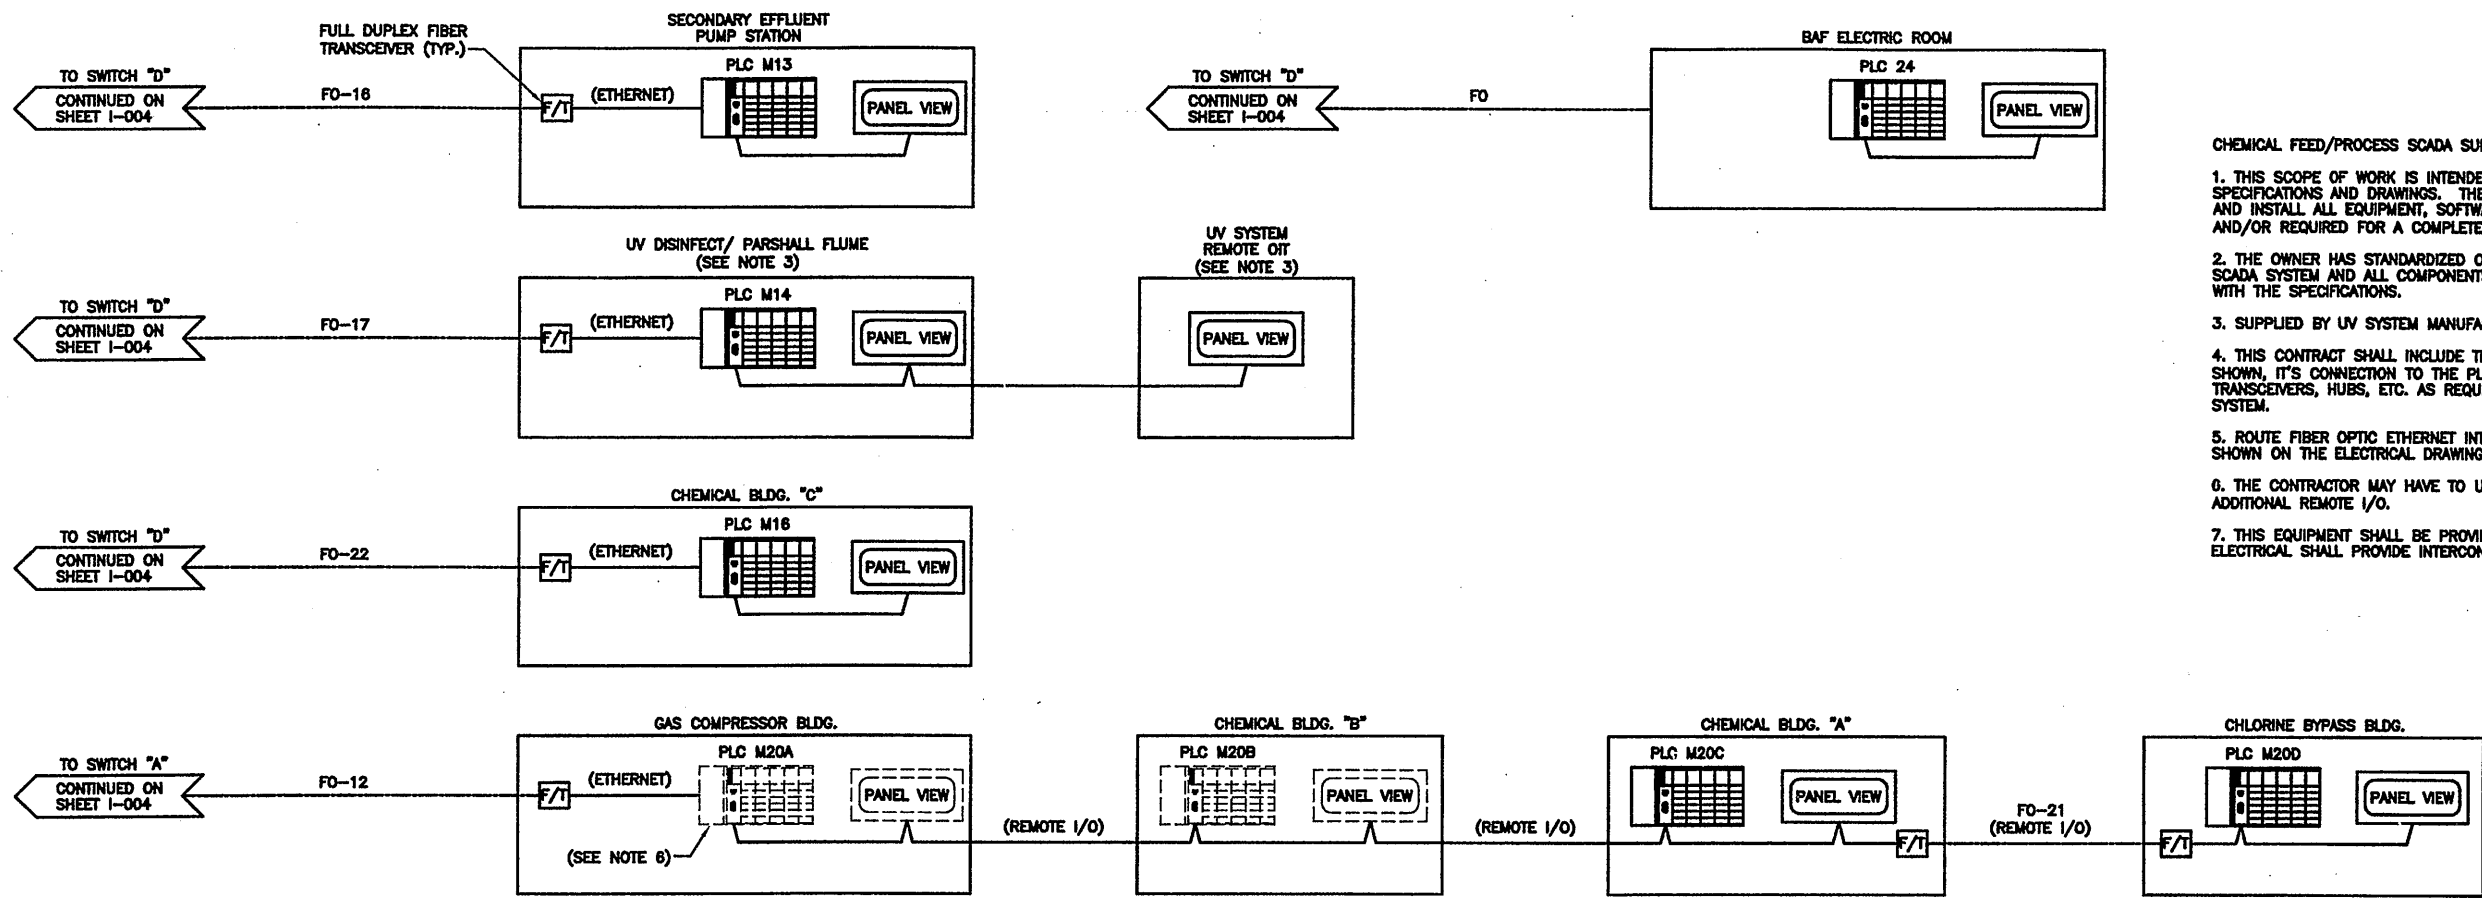

- CHEMICAL FEED/PROCESS SCADA SUBSYSTEM SCOPE OF WORK**
1. THIS SCOPE OF WORK IS INTENDED TO SUMMARIZE THE REQUIREMENTS OF THE SPECIFICATIONS AND DRAWINGS. THE CONTRACTOR IS REQUIRED TO PROVIDE AND INSTALL ALL EQUIPMENT, SOFTWARE, AND APPURTENANCES SHOWN AND/OR REQUIRED FOR A COMPLETE OPERATING SYSTEM.
 2. THE OWNER HAS STANDARDIZED ON A SIMPLICITY BASED SCADA SYSTEM. THIS SCADA SYSTEM AND ALL COMPONENTS SHALL BE INSTALLED IN ACCORDANCE WITH THE SPECIFICATIONS.
 3. SUPPLIED BY UV SYSTEM MANUFACTURER.
 4. THIS CONTRACT SHALL INCLUDE THE INSTALLATION OF THE EQUIPMENT SHOWN, IT'S CONNECTION TO THE PLANT NETWORK, FIBER OPTIC CABLE, TRANSCEIVERS, HUBS, ETC. AS REQUIRED FOR A COMPLETE FULLY FUNCTIONAL SYSTEM.
 5. ROUTE FIBER OPTIC ETHERNET INTERCONNECTION TO PLANTWIDE SYSTEM, AS SHOWN ON THE ELECTRICAL DRAWINGS.
 6. THE CONTRACTOR MAY HAVE TO UPGRADE THE PLC IN ORDER TO SUPPORT ALL ADDITIONAL REMOTE I/O.
 7. THIS EQUIPMENT SHALL BE PROVIDED BY CONTRACT 4C - HVAC. CONTRACT 4B - ELECTRICAL SHALL PROVIDE INTERCONNECTING CABLING, AS SHOWN.

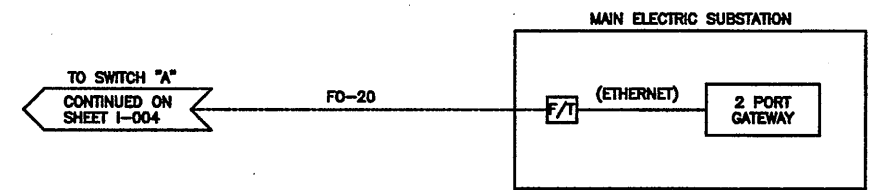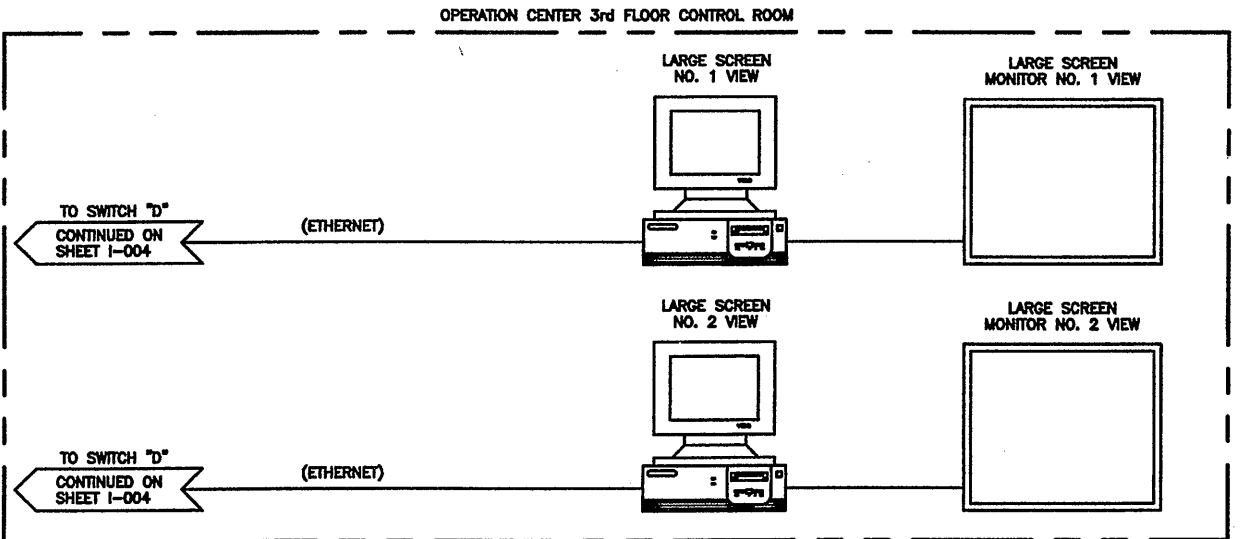

- NOTES:**
1. THIS DRAWING PROVIDED FOR OVERALL CONCEPT ONLY. REFER TO SUBSYSTEMS FOR DETAILS.
 2. PRINTERS, FIBER/TWIST CONVERTORS, POWER, AND UPS INTENTIONALLY NOT SHOWN.
 3. REFER TO SUBSYSTEM PLANS FOR RELOCATION OF EXISTING EQUIPMENT.
- KEY:**
- NEW EQUIPMENT
 - EXISTING EQUIPMENT
 - FIBER OPTIC CABLE (FO)
 - COPPER CABLE
 - ** PROVIDED BY US FILTER/KRUGER

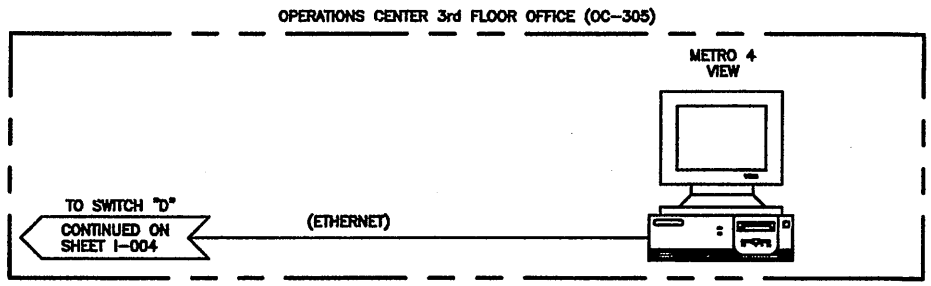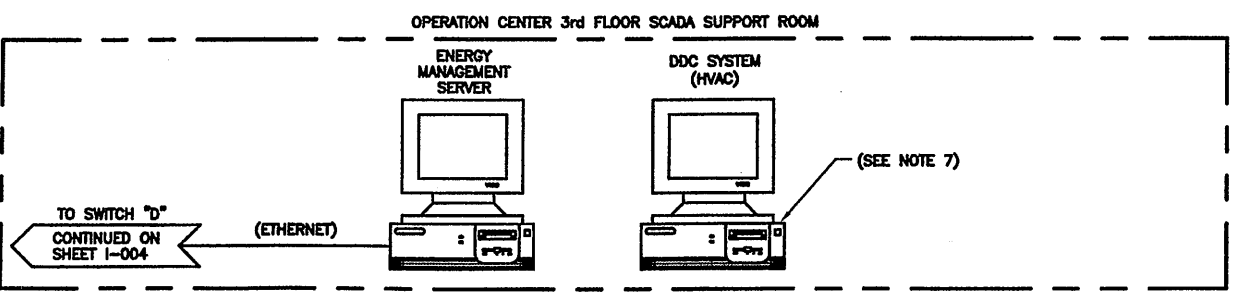

NOTE: PROVIDED AND INSTALLED UNDER CONTRACT NO. 4B UNLESS OTHERWISE NOTED.

RECORD DRAWING
 THESE DRAWINGS HAVE BEEN REVIEWED TO REFLECT MAJOR CHANGES, IF ANY, WHICH OCCURRED DURING CONSTRUCTION. REVISIONS ARE BASED UPON INFORMATION SUPPLIED BY CONTRACTOR.
 DATE: 10/21/05 FOR: R. Rampollet

THIS DRAWING WAS PREPARED AT THE SCALE INDICATED IN THE TITLE BLOCK. INACCURACIES IN THE STATED SCALE MAY BE INTRODUCED WHEN DRAWINGS ARE REPRODUCED BY ANY MEANS. USE THE GRAPHIC SCALE BAR IN THE TITLE BLOCK TO DETERMINE THE ACTUAL SCALE OF THIS DRAWING.

02/28/01 OBG CRV
06591007

| | | | | | |
|--------------|-----|----------|---------------------|------|--------------|
| NOT TO SCALE | No. | Date | Revisions | Init | |
| | 0 | 4/20/01 | ISSUED FOR APPROVAL | PLD | In charge of |
| | 1 | 7/11/01 | AS BID | PLD | Designed by |
| | 2 | 10/31/05 | RECORD DRAWING | CRV | Drawn by |
| | | | | SAT | Checked by |

ENVIRONMENTAL ENGINEERING ASSOCIATES, LLP
 SYRACUSE, NEW YORK

ONONDAGA COUNTY • DEPARTMENT OF DRAINAGE AND SANITATION • SYRACUSE, NEW YORK
 METROPOLITAN SYRACUSE WASTEWATER TREATMENT PLANT
 STAGE III AMMONIA AND STAGE II PHOSPHORUS REMOVAL PROJECT

SCADA SYSTEM SCHEMATIC
CHEMICAL FEED/PROCESS SUBSYSTEM

INSTRUMENTATION


FILE NUMBER: 006591007
 DATE: APRIL 2001
 I-007

Professional Engineer Seal: STATE OF NEW YORK, LEONARD J. CAMPOLLET, No. 80765

ENERGY MANAGEMENT SCADA SUBSYSTEM SCOPE OF WORK

1. THIS SCOPE OF WORK IS INTENDED TO SUMMARIZE THE REQUIREMENTS OF THE SPECIFICATION AND DRAWINGS. THE CONTRACTOR IS REQUIRED TO PROVIDE AND INSTALL ALL EQUIPMENT, SOFTWARE, AND APPURTENANCES SHOWN AND/OR REQUIRED FOR A COMPLETE OPERATING SYSTEM.
2. THE OWNER HAS STANDARDIZED ON A SIMPLICITY BASED ENERGY MANAGEMENT SOFTWARE. THE ENERGY MANAGEMENT SOFTWARE SHALL BE GE'S POWER MANAGEMENT CONTROL SYSTEM (PMCS) IN ACCORDANCE WITH THE SPECIFICATIONS.
3. PROVIDE AND INSTALL FEEDER PROTECTION RELAYS AT INDIVIDUAL 4160 VOLT FEEDER BREAKERS AT MAIN SUBSTATION. RELAYS SHALL BE CAPABLE OF COMMUNICATING WITH THE SPECIFIED ENERGY MANAGEMENT SOFTWARE (GE PMCS) VIA A RS485 LINK. COMMUNICATION RELAYS ARE SPECIFIED AND SHOWN ON THE ELECTRICAL CONTRACT DRAWINGS (SEE SHEET E-005).
4. PROVIDE AND INSTALL 2-PORT RS-485 / ETHERNET GATEWAY REMOTE COMMUNICATIONS SERVERS AS SHOWN. LOCATE WITHIN SUBSTATION SWITCHGEAR IN ACCORDANCE w/SPECIFICATION 16350.
5. PROVIDE AND INSTALL AN ETHERNET HUB AND ASSOCIATED COPPER/FIBER OPTIC FULL DUPLEX TRANSCEIVER WITHIN THE SUBSTATION SWITCHGEAR IN ACCORDANCE w/SPECIFICATION 16350.
6. ROUTE FIBER OPTIC ETHERNET INTERCONNECTION TO PLANTWIDE SYSTEM, AS SHOWN ON THE ELECTRICAL DRAWINGS.
7. PROVIDE, INSTALL, STARTUP, TESTING, AND TRAINING ASSOCIATED WITH FULL SIMPLICITY BASED ENERGY MANAGEMENT SOFTWARE, AS SPECIFIED. SOFTWARE SHALL BE SIMPLICITY BASED AND SHALL BE RESIDENT ON THE ENERGY MANAGEMENT SERVER WITHIN OPERATION'S CENTER SCADA SUPPORT ROOM.
8. AT BATTERY BUILDING PROVIDE EMERGENCY EYEWASH PB (MUSHROOM HEAD) ADJACENT TO EYEWASH W/ 12"x12" LAMACOID LABEL. CONNECT TO POWER MONITORING RELAY "BACKEND I/O INPUT" AS SHOWN.

KEY:
 ——— FIBER OPTIC CABLE (FO)
 ——— COPPER CABLE

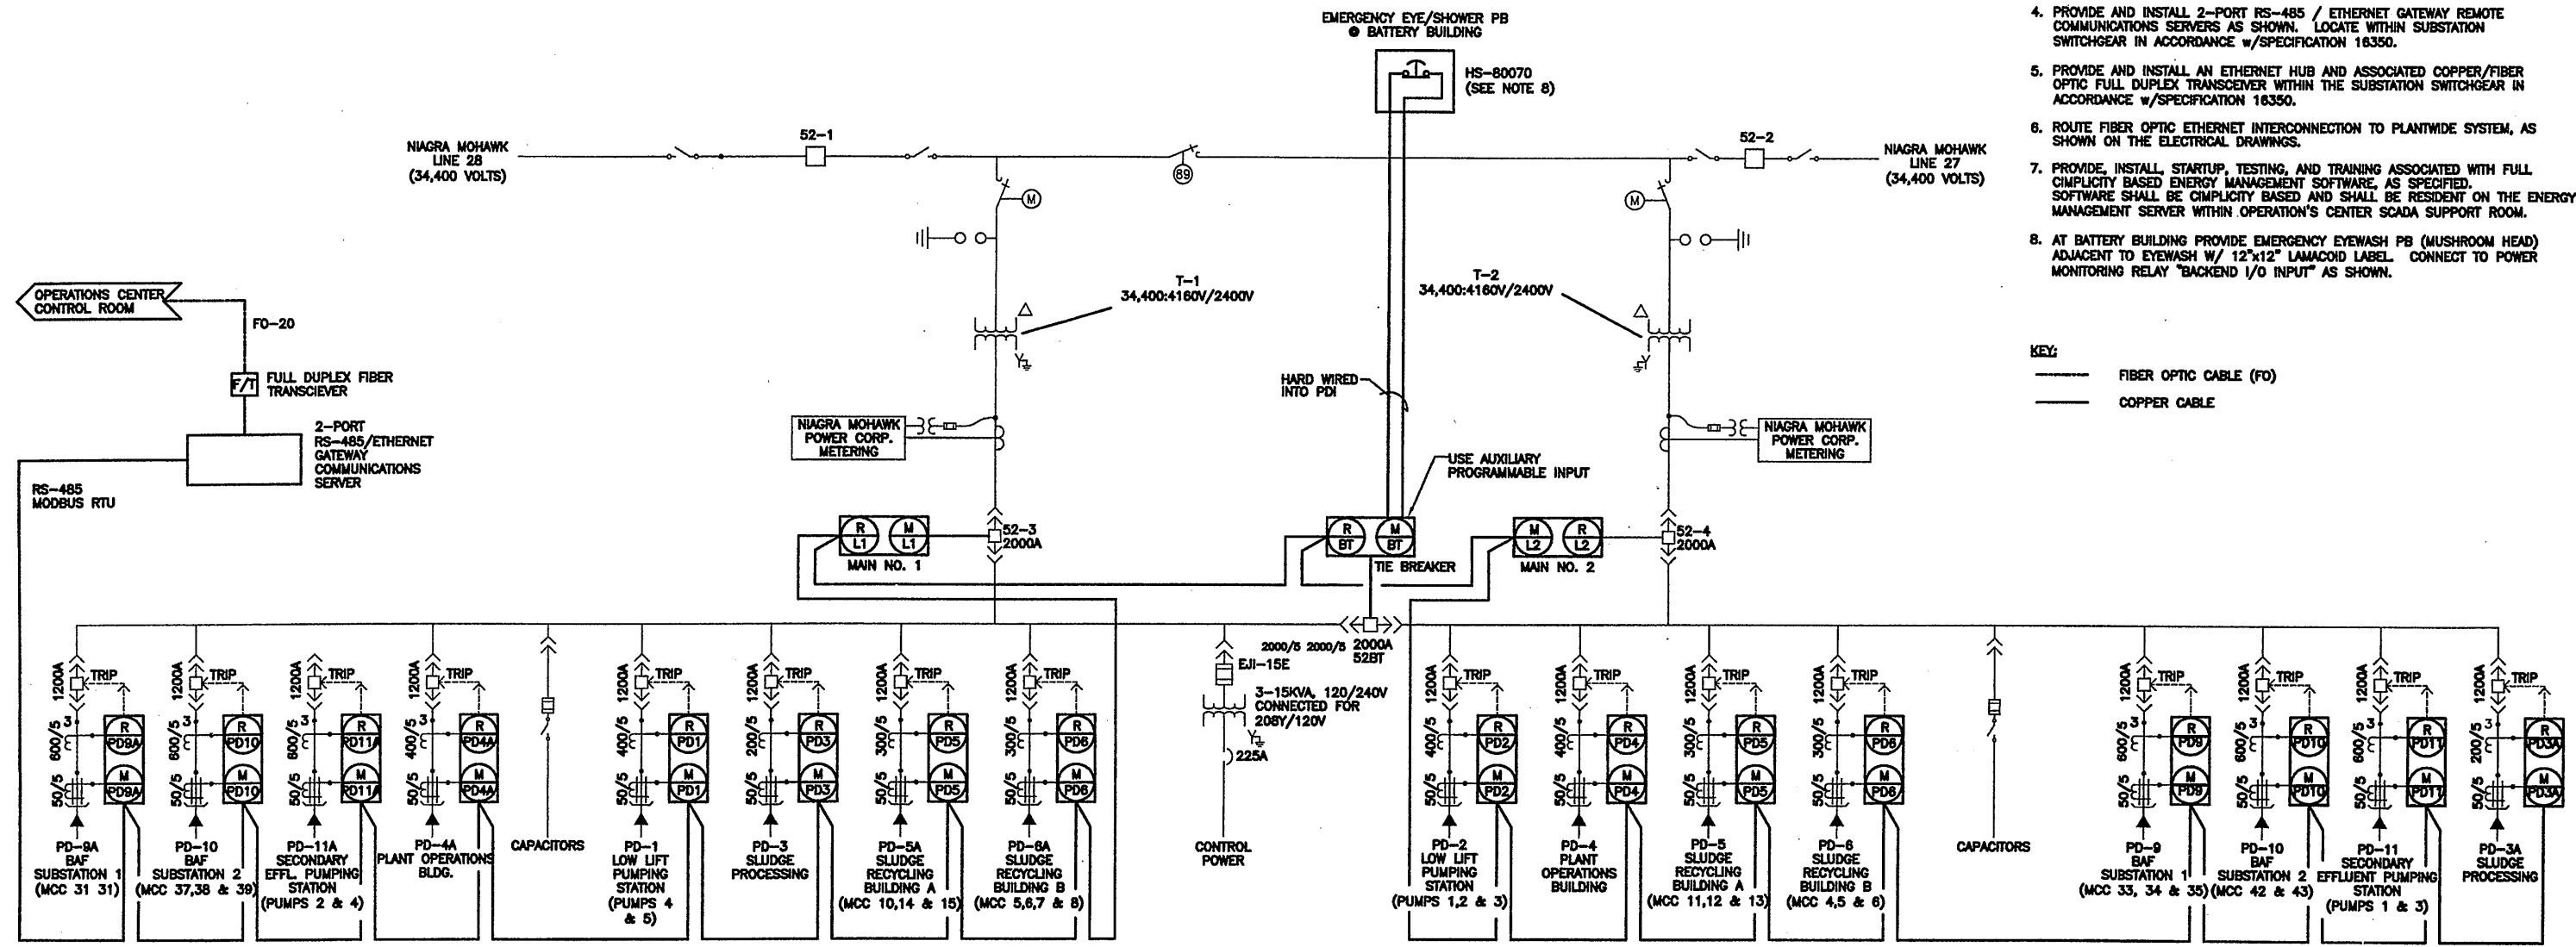

NOTE:
 PROVIDED AND INSTALLED UNDER
 CONTRACT NO. 48

RECORD DRAWING

THESE DRAWINGS HAVE BEEN REVIEWED TO REFLECT MAJOR CHANGES, IF ANY, WHICH OCCURRED DURING CONSTRUCTION. REVISIONS ARE BASED UPON INFORMATION SUPPLIED BY CONTRACTOR.
 DATE: 10/21/05 FOR: [Signature]

THIS DRAWING WAS PREPARED AT THE SCALE INDICATED IN THE TITLE BLOCK. INACCURACIES IN THE STATED SCALE MAY BE INTRODUCED WHEN DRAWINGS ARE REPRODUCED BY ANY MEANS. USE THE GRAPHIC SCALE BAR IN THE TITLE BLOCK TO DETERMINE THE ACTUAL SCALE OF THIS DRAWING.

02/28/01 OBG CRV
 06591008

| No. | Date | Revisions | Init |
|-----|----------|---------------------|------|
| 0 | 4/20/01 | ISSUED FOR APPROVAL | PLD |
| 1 | 7/11/01 | AS BID | PLD |
| 2 | 10/31/05 | RECORD DRAWING | CRV |


In charge of: PLD
 Designed by: PLD
 Drawn by: CRV
 Checked by: SAT

ENVIRONMENTAL ENGINEERING ASSOCIATES, LLP
 SYRACUSE, NEW YORK

ONONDAGA COUNTY • DEPARTMENT OF DRAINAGE AND SANITATION • SYRACUSE, NEW YORK
 METROPOLITAN SYRACUSE WASTEWATER TREATMENT PLANT
 STAGE III AMMONIA AND STAGE II PHOSPHORUS REMOVAL PROJECT

**SCADA SYSTEM
 ENERGY MANAGEMENT SUBSYSTEM**

ELECTRICAL

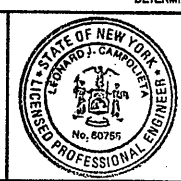


File Number
 006591008
 Date
 APRIL 2001
 [Signature]

I-008

NO ALTERATIONS PERMITTED HEREON EXCEPT AS PROVIDED UNDER SECTION 7209 SUBDIVISION 2 OF THE NEW YORK STATE EDUCATION LAW

PROVIDED & INSTALLED BY CONTRACT NO.4C (HVAC)

PROVIDED & INSTALLED BY CONTRACT NO.4B (ELECTRICAL)

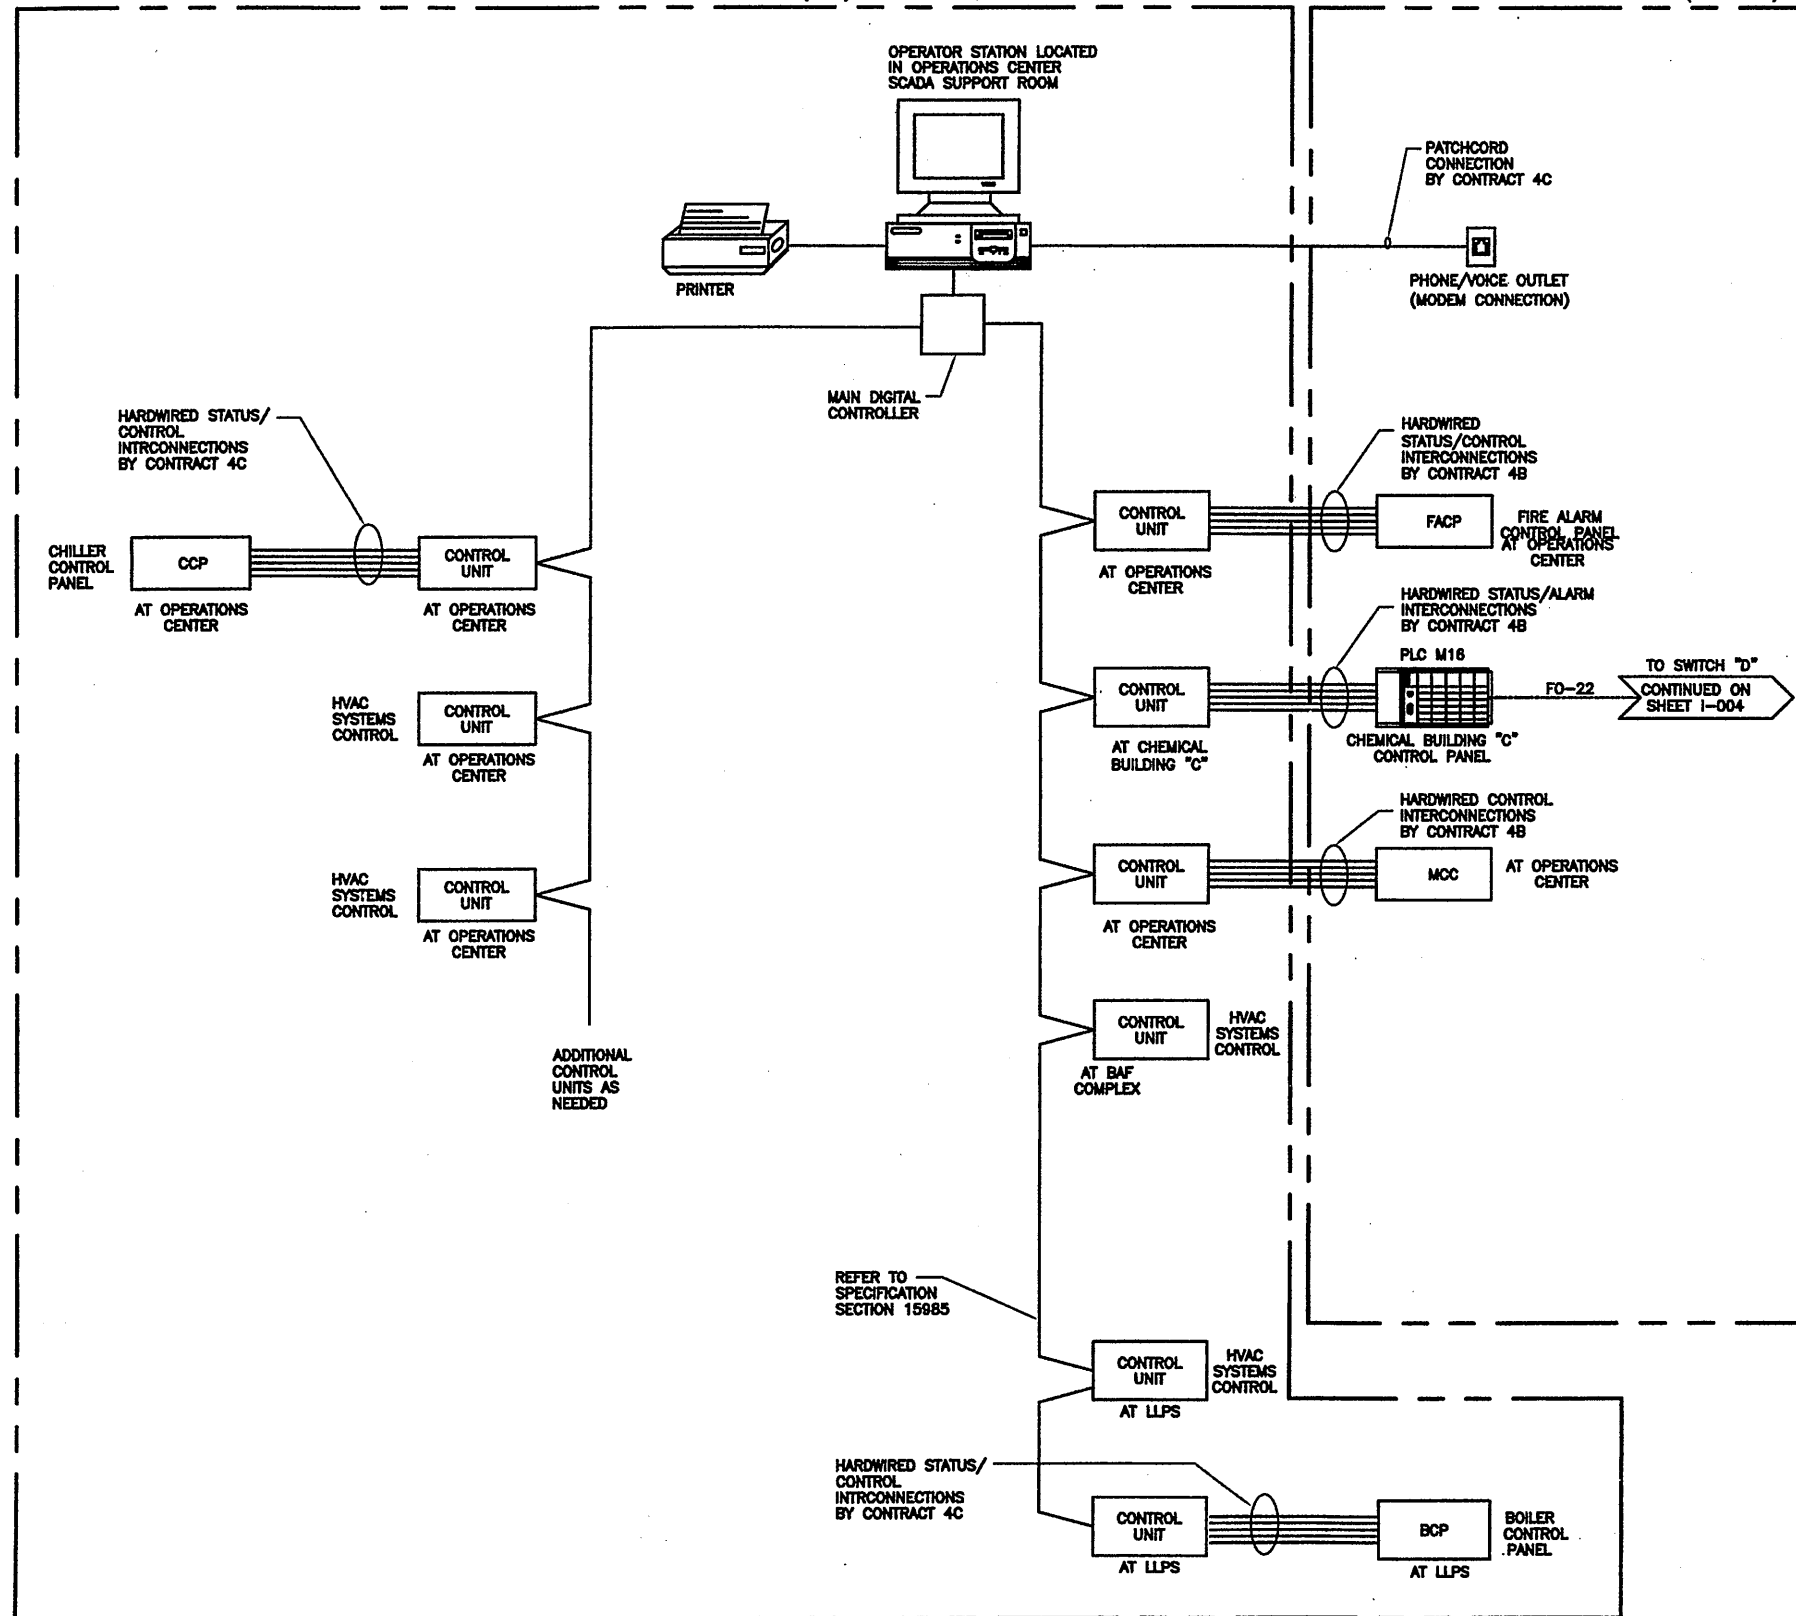

HVAC DIRECT CONTROL (DDC) SCADA SUBSYSTEM SCOPE OF WORK

1. THIS SCOPE OF WORK IS INTENDED TO SUMMARIZE THE REQUIREMENTS OF THE SPECIFICATION AND DRAWINGS. THE CONTRACTOR IS REQUIRED TO PROVIDE AND INSTALL ALL EQUIPMENT, SOFTWARE, AND APPURTENANCES SHOWN AND/OR REQUIRED FOR A COMPLETE OPERATING SYSTEM.
2. THE BUILDING MANAGEMENT SUPERVISORY CONTROL AND DATA ACQUISITION SYSTEM SHALL BE A SEPARATE STAND-ALONE SYSTEM PROVIDED AND INSTALLED BY CONTRACT 4C - HVAC. THE BUILDING MANAGEMENT SYSTEM SHALL INTERFACE WITH THE OVERALL PLANTWIDE SCADA SYSTEM THROUGH A HARDWIRED INTERCONNECTION TO BE PROVIDED AND INSTALLED BY CONTRACT 4B - ELECTRICAL, AS SHOWN.
3. PROVIDE HARDWIRED INTERCONNECTION BETWEEN PLC M16 AND BUILDING MANAGEMENT LOCAL CONTROL UNIT, AS SHOWN.
4. ACTUAL BUILDING MANAGEMENT SYSTEM COMPONENTS AND CONNECTIONS SHALL BE AS SPECIFIED UNDER DIVISION 15 AND SHOWN ON "H" SHEETS.
5. SIMPLICITY BASED ALARM AND STATUS SCREENS FOR MONITORED POINTS AND ALARMS SHALL BE RESIDENT ON EACH WORKSTATION WITHIN OPERATIONS CENTER CONTROL ROOM.
6. PROVIDE, INSTALL, STARTUP, TEST, AND PROVIDE TRAINING ASSOCIATED INTERCONNECTION OF PLANTWIDE SCADA SYSTEM AND DIRECT DIGITAL CONTROL SYSTEM.
7. DDC SYSTEM (HVAC) OIT IS TO BE LOCATED IN THE OPERATION CENTER SCADA SUPPORT ROOM.
8. ACTUAL HVAC DDC SYSTEM COMPONENTS AND CONNECTIONS SHALL BE AS SPECIFIED UNDER DIVISION 15 AND SHOWN ON "H" SHEETS.
9. REFER TO DRAWING G-004 FOR PLANT LAYOUT AND BUILDING LOCATIONS.

LEGEND

- LLPS- LOW-LIFT PUMP STATION
- MCC- MOTOR CONTROL CENTER
- PLC- PROGRAMMABLE LOGIC CONTROLLER
- SCADA- SUPERVISORY CONTROL AND DATA ACQUISITION

KEY:

- FIBER OPTIC CABLE (FO)
- COPPER CABLE

RECORD DRAWING

THESE DRAWINGS HAVE BEEN REVIEWED TO REFLECT MAJOR CHANGES, IF ANY, WHICH OCCURRED DURING CONSTRUCTION. REVISIONS ARE BASED UPON INFORMATION SUPPLIED BY CONTRACTOR.
 DATE: 10/21/05 PER: [Signature]

THIS DRAWING WAS PREPARED AT THE SCALE INDICATED IN THE TITLE BLOCK. INACCURACIES IN THE STATED SCALE MAY BE INTRODUCED WHEN DRAWINGS ARE REPRODUCED BY ANY MEANS. USE THE GRAPHIC SCALE BAR IN THE TITLE BLOCK TO DETERMINE THE ACTUAL SCALE OF THIS DRAWING.

02/26/01 OBG CRV
06591009

| No. | Date | Revisions | Init |
|-----|----------|---------------------|------|
| 0 | 4/20/01 | ISSUED FOR APPROVAL | PLD |
| 1 | 7/11/01 | AS-BID | PLD |
| 2 | 10/31/05 | RECORD DRAWING | CRV |

NOT TO SCALE

NO ALTERATIONS PERMITTED HEREON EXCEPT AS PROVIDED UNDER SECTION 72.09 SUBDIVISION 2 OF THE NEW YORK STATE EDUCATION LAW

In charge of: PLD
 Designed by: PLD
 Drawn by: CRV
 Checked by: SAT



ONONDAGA COUNTY • DEPARTMENT OF DRAINAGE AND SANITATION • SYRACUSE, NEW YORK
 METROPOLITAN SYRACUSE WASTEWATER TREATMENT PLANT
 STAGE III AMMONIA AND STAGE II PHOSPHORUS REMOVAL PROJECT

**SCADA SYSTEM SCHEMATIC
 HVAC DIRECT DIGITAL CONTROL SUBSYSTEM**

INSTRUMENTATION




File Number: 006591009
 Date: APRIL 2001
 [Signature]

I-009

ENERGY MANAGEMENT SCADA SUBSYSTEM SCOPE OF WORK

1. THIS SCOPE OF WORK IS INTENDED TO SUMMARIZE THE REQUIREMENTS OF THE SPECIFICATION AND DRAWINGS. THE CONTRACTOR IS REQUIRED TO PROVIDE AND INSTALL ALL EQUIPMENT, SOFTWARE, AND APPURTENANCES SHOWN AND/OR REQUIRED FOR A COMPLETE OPERATING SYSTEM.
2. THE OWNER HAS STANDARDIZED ON A SIMPLICITY BASED ENERGY MANAGEMENT SOFTWARE. THE ENERGY MANAGEMENT SOFTWARE SHALL BE GE'S POWER MANAGEMENT CONTROL SYSTEM (PMCS) IN ACCORDANCE WITH THE SPECIFICATIONS.
3. PROVIDE AND INSTALL FEEDER PROTECTION RELAYS AT INDIVIDUAL BREAKERS AS SHOWN. RELAYS SHALL BE CAPABLE OF COMMUNICATING WITH THE SPECIFIED ENERGY MANAGEMENT SOFTWARE (GE PMCS) VIA A RS485 LINK.
4. PROVIDE AND INSTALL DEVICE LEVEL PROTOCOL TO RS485, MODBUS RTU PROTOCOL AS SHOWN.
5. PROVIDE AND INSTALL AN ETHERNET HUB AND ASSOCIATED COPPER/FIBER OPTIC FULL DUPLEX TRANSCEIVER WITHIN THE SUBSTATION SWITCHGEAR IN ACCORDANCE w/SPECIFICATION 16350.
6. ROUTE FIBER OPTIC ETHERNET INTERCONNECTION TO PLANTWIDE SYSTEM, AS SHOWN ON THE ELECTRICAL DRAWINGS.
7. PROVIDE, INSTALL, STARTUP, TESTING, AND TRAINING ASSOCIATED WITH FULL SIMPLICITY BASED ENERGY MANAGEMENT SOFTWARE, AS SPECIFIED. SOFTWARE SHALL BE SIMPLICITY BASED AND SHALL BE RESIDENT ON THE ENERGY MANAGEMENT SERVER WITHIN OPERATION'S CENTER SCADA SUPPORT ROOM.

KEY:
 ——— FIBER OPTIC CABLE (FO)
 ——— COPPER CABLE

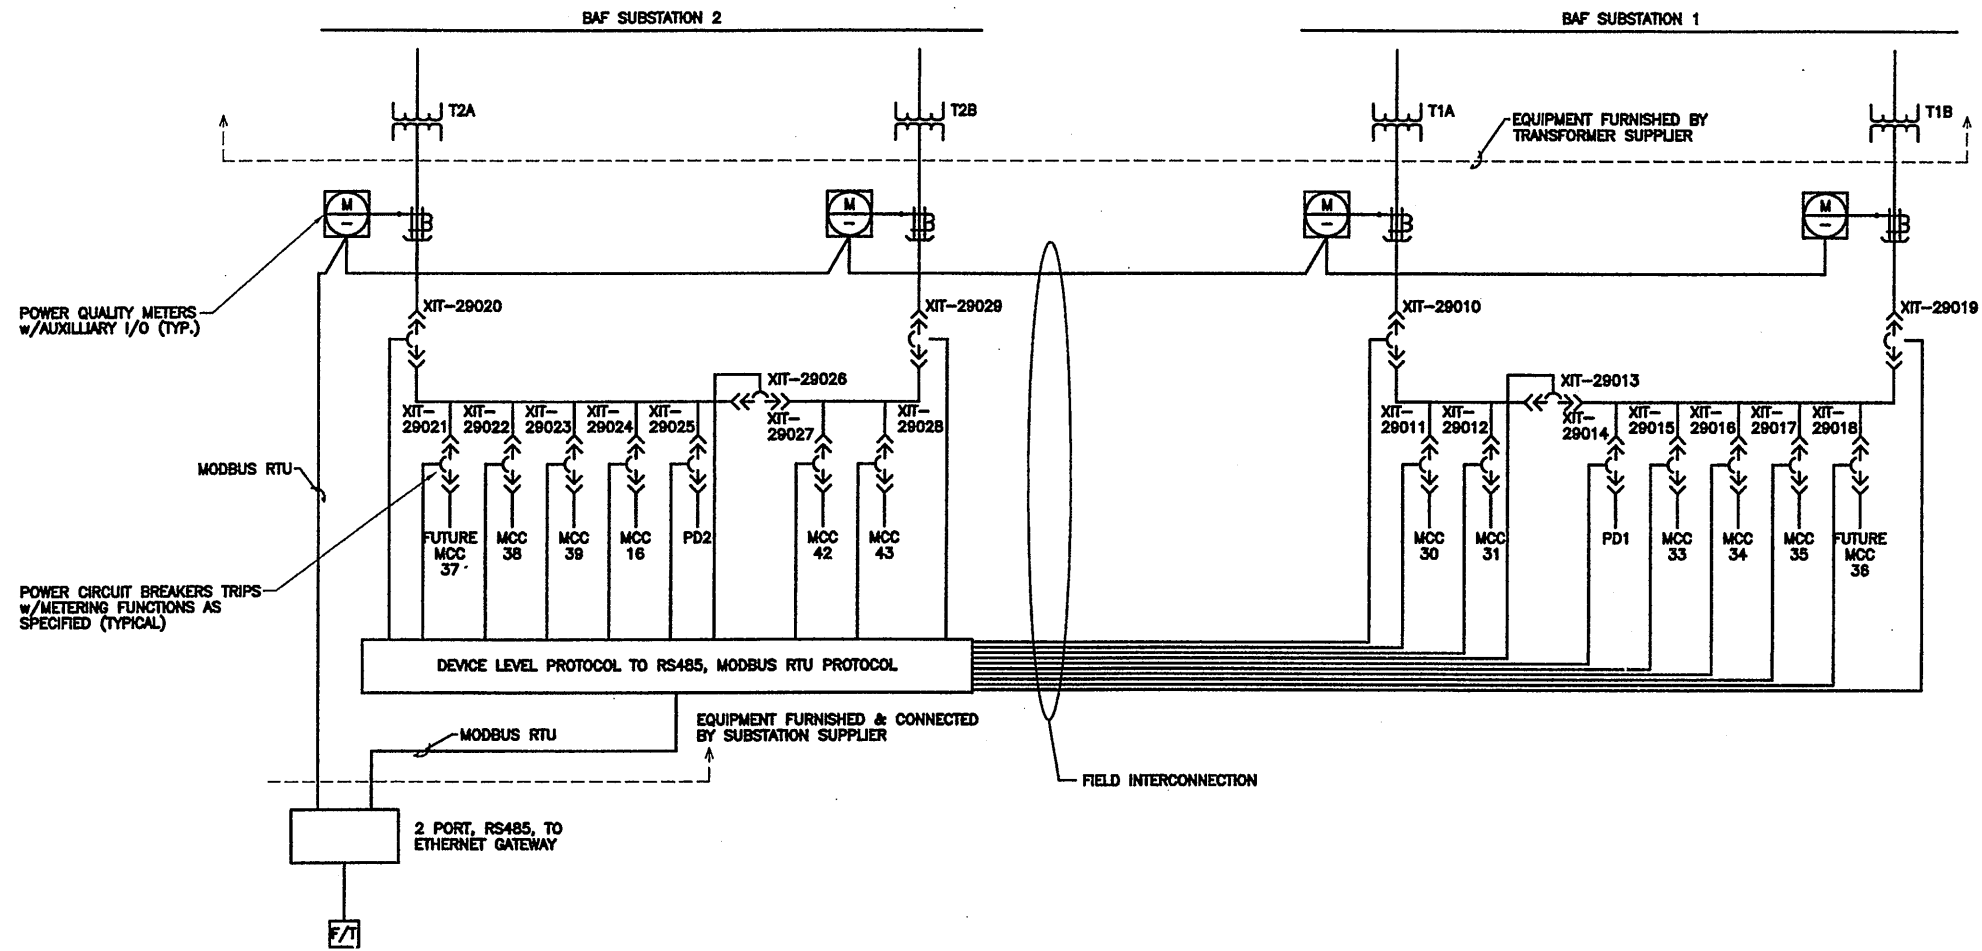

NOTE:
 PROVIDED AND INSTALLED UNDER
 CONTRACT NO. 4B

RECORD DRAWING
 THESE DRAWINGS HAVE BEEN REVIEWED TO REFLECT
 MAJOR CHANGES IF ANY, WHICH OCCURRED DURING
 CONSTRUCTION. REVISIONS ARE BASED UPON
 INFORMATION SUPPLIED BY CONTRACTOR.
 DATE: 10/21/05 FOR: Karpolov

THIS DRAWING WAS PREPARED AT THE SCALE INDICATED IN THE
 TITLE BLOCK. INACCURACIES IN THE STATED SCALE MAY BE
 INTRODUCED WHEN DRAWINGS ARE REPRODUCED BY ANY MEANS.
 USE THE GRAPHIC SCALE BAR IN THE TITLE BLOCK TO
 DETERMINE THE ACTUAL SCALE OF THIS DRAWING.


03/23/01 OBG CRV
 0659

NOT TO SCALE

NO ALTERATIONS PERMITTED HEREON EXCEPT
 AS PROVIDED UNDER SECTION 7209 SUBDIVISION
 2 OF THE NEW YORK STATE EDUCATION LAW

| No. | Date | Revisions | Init |
|-----|----------|---------------------|------|
| 0 | 4/20/01 | ISSUED FOR APPROVAL | PLD |
| 1 | 7/11/01 | AS BID | PLD |
| 2 | 10/31/05 | RECORD DRAWING | CRV |

In charge of — PLD —
 Designed by — PLD —
 Drawn by — CRV —
 Checked by — SAT —

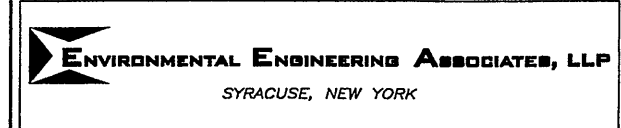

ONONDAGA COUNTY • DEPARTMENT OF DRAINAGE AND SANITATION • SYRACUSE, NEW YORK
 METROPOLITAN SYRACUSE WASTEWATER TREATMENT PLANT
 STAGE III AMMONIA AND STAGE II PHOSPHORUS REMOVAL PROJECT

**SCADA SYSTEM BAF ELECTRIC ROOM
 ENERGY MANAGEMENT SUBSYSTEM**

INSTRUMENTATION





File Number
 006591010

Date
 APRIL 2001

Signature: Karpolov

I-010

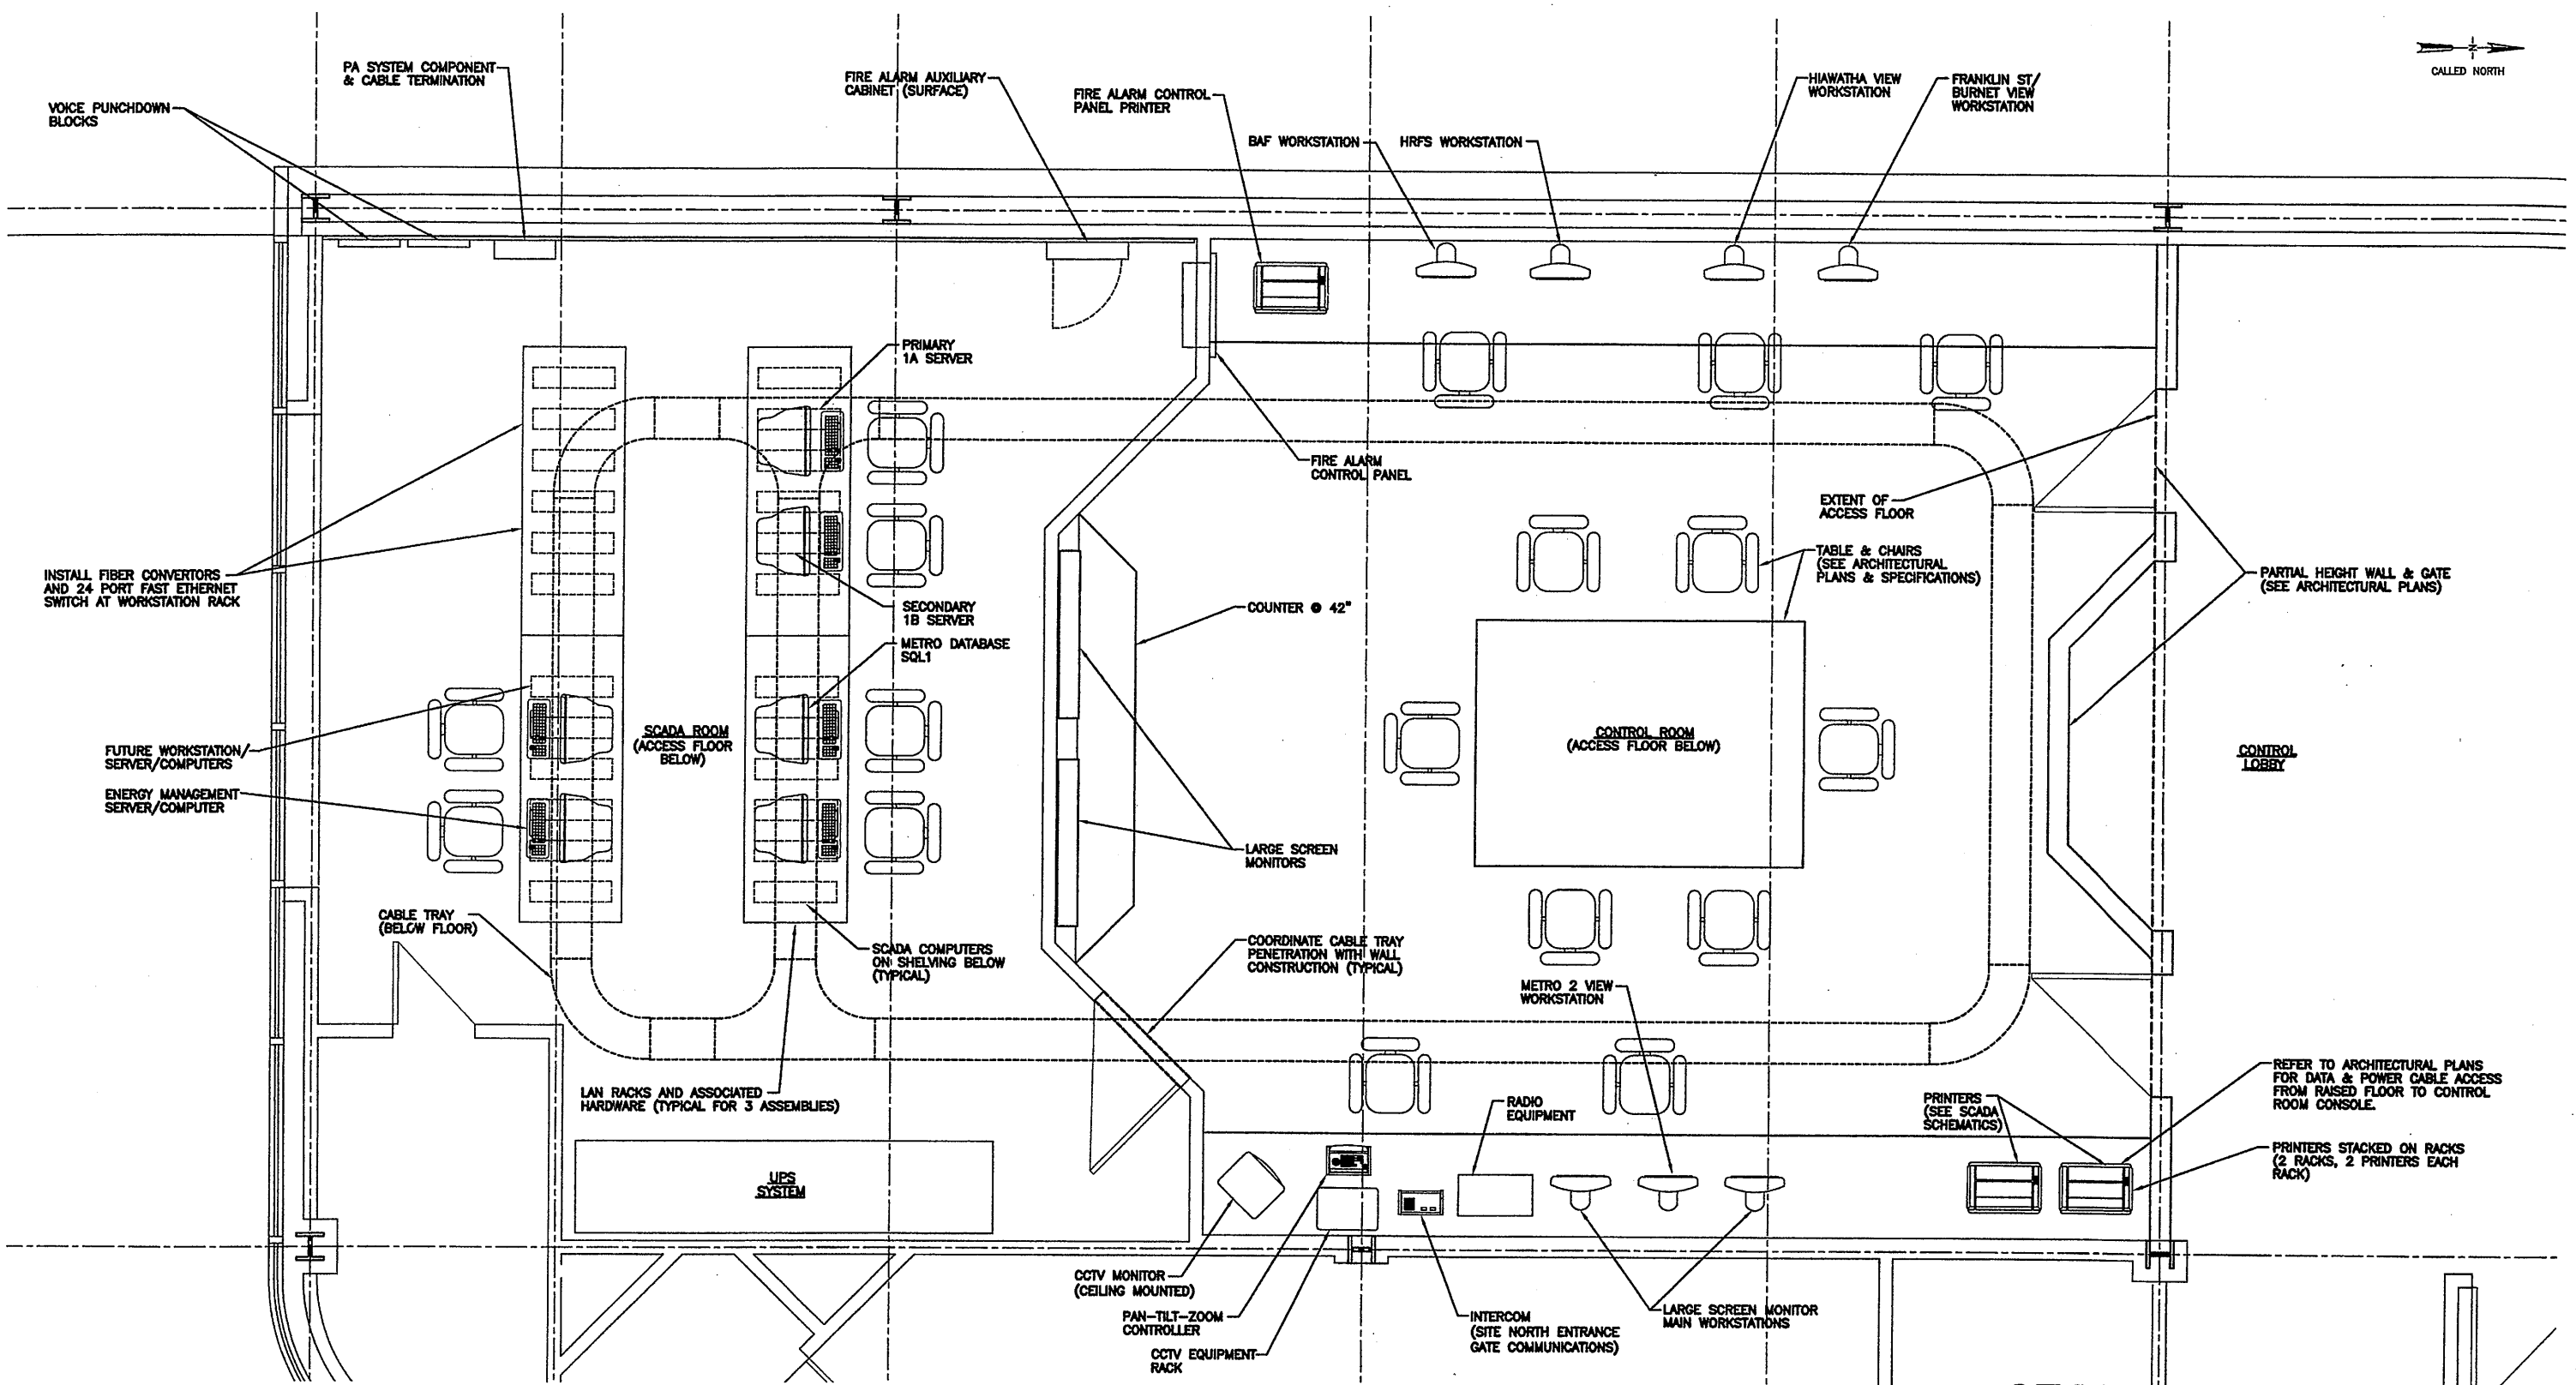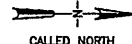

- NOTES:**
- REFER TO SPECIFICATIONS FOR CABLE TRAY, CABLE TRAY SHALL BE 12" Wx3" DEEP.
 - REFER TO SPECIFICATION SECTION 17022 FOR 3-LAN RACKS AND 8-SCADA ROOM CHAIRS TO BE LOCATED IN SCADA ROOM. REFER TO SECTION 18780 FOR TELECOMMUNICATIONS RACKS.
 - SCADA SYSTEM COMPUTERS SHALL BE LOCATED ON LAN RACKS IN SCADA ROOM. PROVIDE CABLES & ASSOCIATED HARDWARE TO MONITORS, KEYBOARDS, & ASSOCIATED COMPONENTS.

RECORD DRAWING
 THESE CHANGES HAVE BEEN MADE TO REFLECT MAJOR CHANGES IF ANY, WHICH OCCURRED DURING CONSTRUCTION. REVISIONS ARE BASED UPON INFORMATION SUPPLIED BY CONTRACTOR.
 DATE: 10/15/05 FOR: Klamplet

THIS DRAWING WAS PREPARED AT THE SCALE INDICATED IN THE TITLE BLOCK. INACCURACIES IN THE STATED SCALE MAY BE INTRODUCED WHEN DRAWINGS ARE REPRODUCED BY ANY MEANS. USE THE GRAPHIC SCALE BAR IN THE TITLE BLOCK TO DETERMINE THE ACTUAL SCALE OF THIS DRAWING.

01/28/01 OBG JEC
 06591011

NO ALTERATIONS PERMITTED HEREON EXCEPT AS PROVIDED UNDER SECTION 7209 SUBDIVISION 2 OF THE NEW YORK STATE EDUCATION LAW

| No. | Date | Revisions | Init |
|-----|----------|---------------------|------|
| 0 | 4/20/01 | ISSUED FOR APPROVAL | PLD |
| 1 | 7/11/01 | AS BID | SAT |
| 2 | 10/31/05 | RECORD DRAWING | JEC |


In charge of PLD
 Designed by SAT
 Drawn by JEC
 Checked by PLD

ENVIRONMENTAL ENGINEERING ASSOCIATES, LLP
 SYRACUSE, NEW YORK

ONONDAGA COUNTY • DEPARTMENT OF DRAINAGE AND SANITATION • SYRACUSE, NEW YORK
 METROPOLITAN SYRACUSE WASTEWATER TREATMENT PLANT
 STAGE III AMMONIA AND STAGE II PHOSPHORUS REMOVAL PROJECT
**OPERATIONS CENTER
 CONTROL ROOM LAYOUT**



File Number: 00659
 Date: APRIL 2001
 I-011

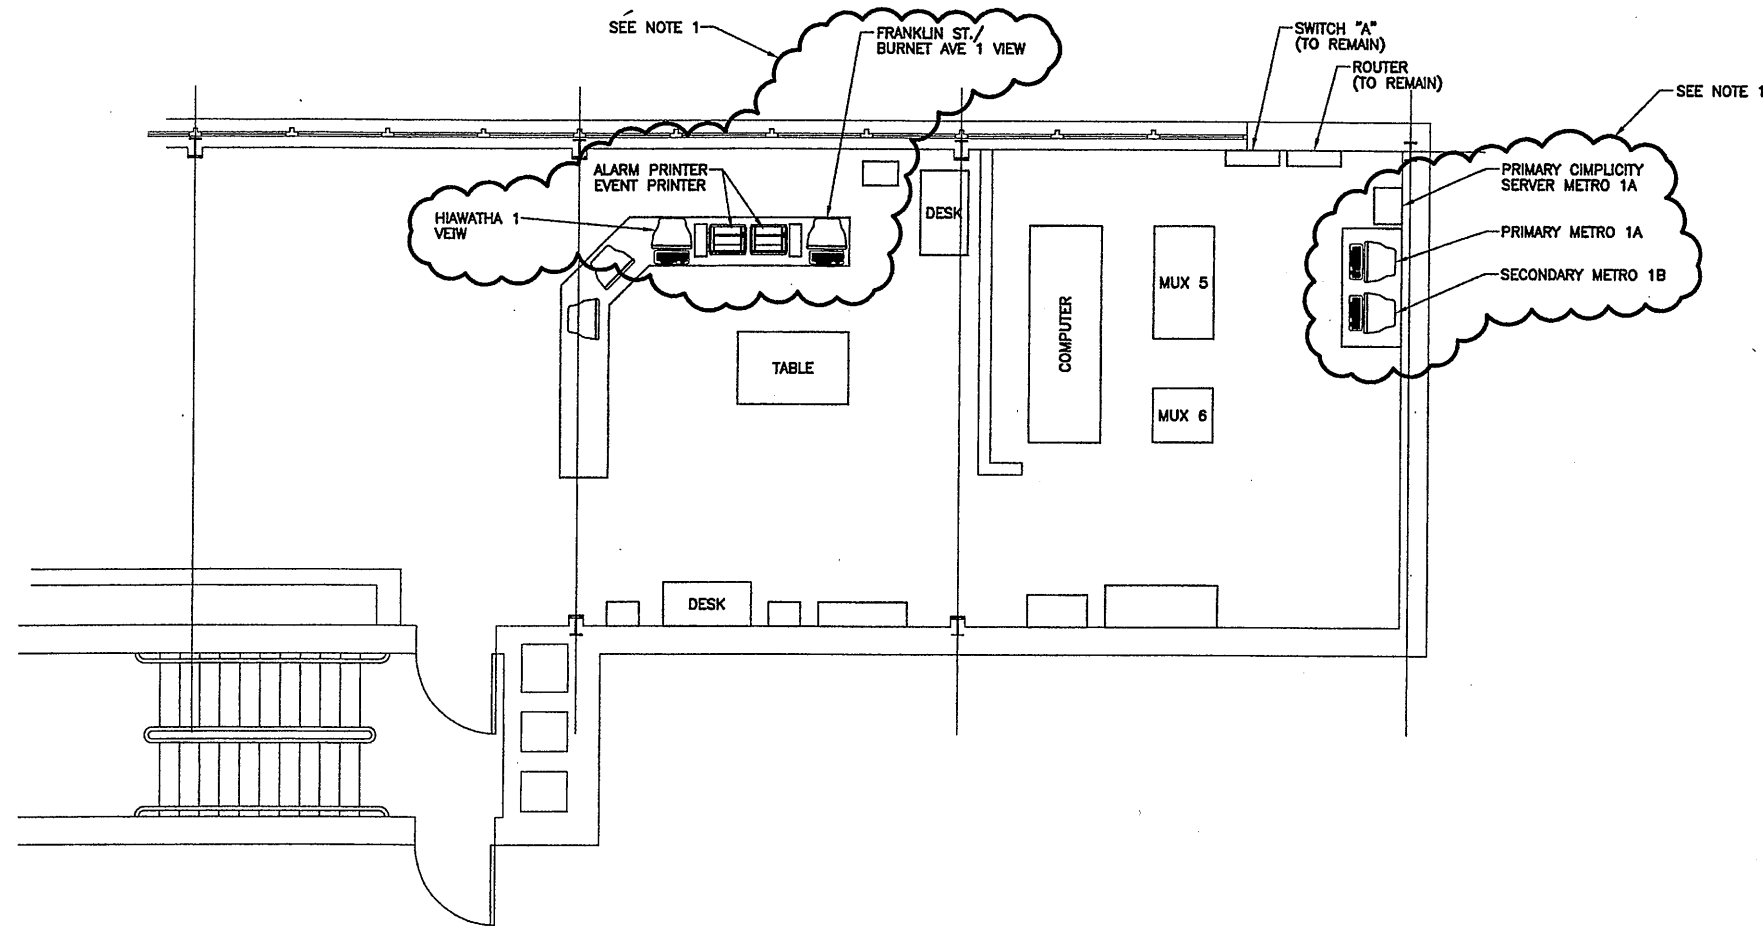

NOTES:

1. EQUIPMENT TO BE RELOCATED TO NEW OPERATIONS CENTER CONTROL ROOM BY CONTRACT 4B-ELECTRICAL.
2. REFER TO DWG. I-004 FOR NETWORKING DETAILS AND SPEC SECTION 17021 FOR EQUIPMENT RELOCATION DETAILS.

EXISTING CONTROL ROOM PLAN
SCALE: 1/4"=1'-0"

Layer: ON=*; OFF=*REF*
11/27/00 OBG JEC
EEA-VERT

RECORD DRAWING

THESE DRAWINGS HAVE BEEN REVIEWED TO REFLECT
MAJOR CHANGES, IF ANY, WHICH OCCURRED DURING
CONSTRUCTION. REVISIONS ARE BASED UPON
INFORMATION SUPPLIED BY CONTRACTOR.
DATE: 10/21/01 FOR: Rampoliet-

THIS DRAWING WAS PREPARED AT THE SCALE INDICATED IN THE
TITLE BLOCK. INACCURACIES IN THE STATED SCALE MAY BE
INTRODUCED WHEN DRAWINGS ARE REPRODUCED BY ANY MEANS.
USE THE GRAPHIC SCALE BAR IN THE TITLE BLOCK TO
DETERMINE THE ACTUAL SCALE OF THIS DRAWING.


NO ALTERATIONS PERMITTED HEREON EXCEPT
AS PROVIDED UNDER SECTION 7209 SUBDIVISION
2 OF THE NEW YORK STATE EDUCATION LAW

| No. | Date | Revisions | Init |
|-----|----------|---------------------|------|
| 0 | 4/20/01 | ISSUED FOR APPROVAL | JEC |
| 1 | 7/11/01 | AS BID | |
| 2 | 10/31/05 | RECORD DRAWING | |

In charge of PLD
Designed by SAT
Drawn by JEC
Checked by PLD


ENVIRONMENTAL ENGINEERING ASSOCIATES, LLP
SYRACUSE, NEW YORK

ONONDAGA COUNTY • DEPARTMENT OF DRAINAGE AND SANITATION • SYRACUSE, NEW YORK
METROPOLITAN SYRACUSE WASTEWATER TREATMENT PLANT
STAGE III AMMONIA AND STAGE II PHOSPHORUS REMOVAL PROJECT
**PLANT OPERATIONS BLDG. CONTROL ROOM LAYOUT
DEMOLITION PLAN**

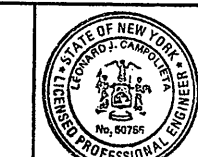


File Number
00659
Date
APRIL 2001
Signature: Rampoliet-

I-012

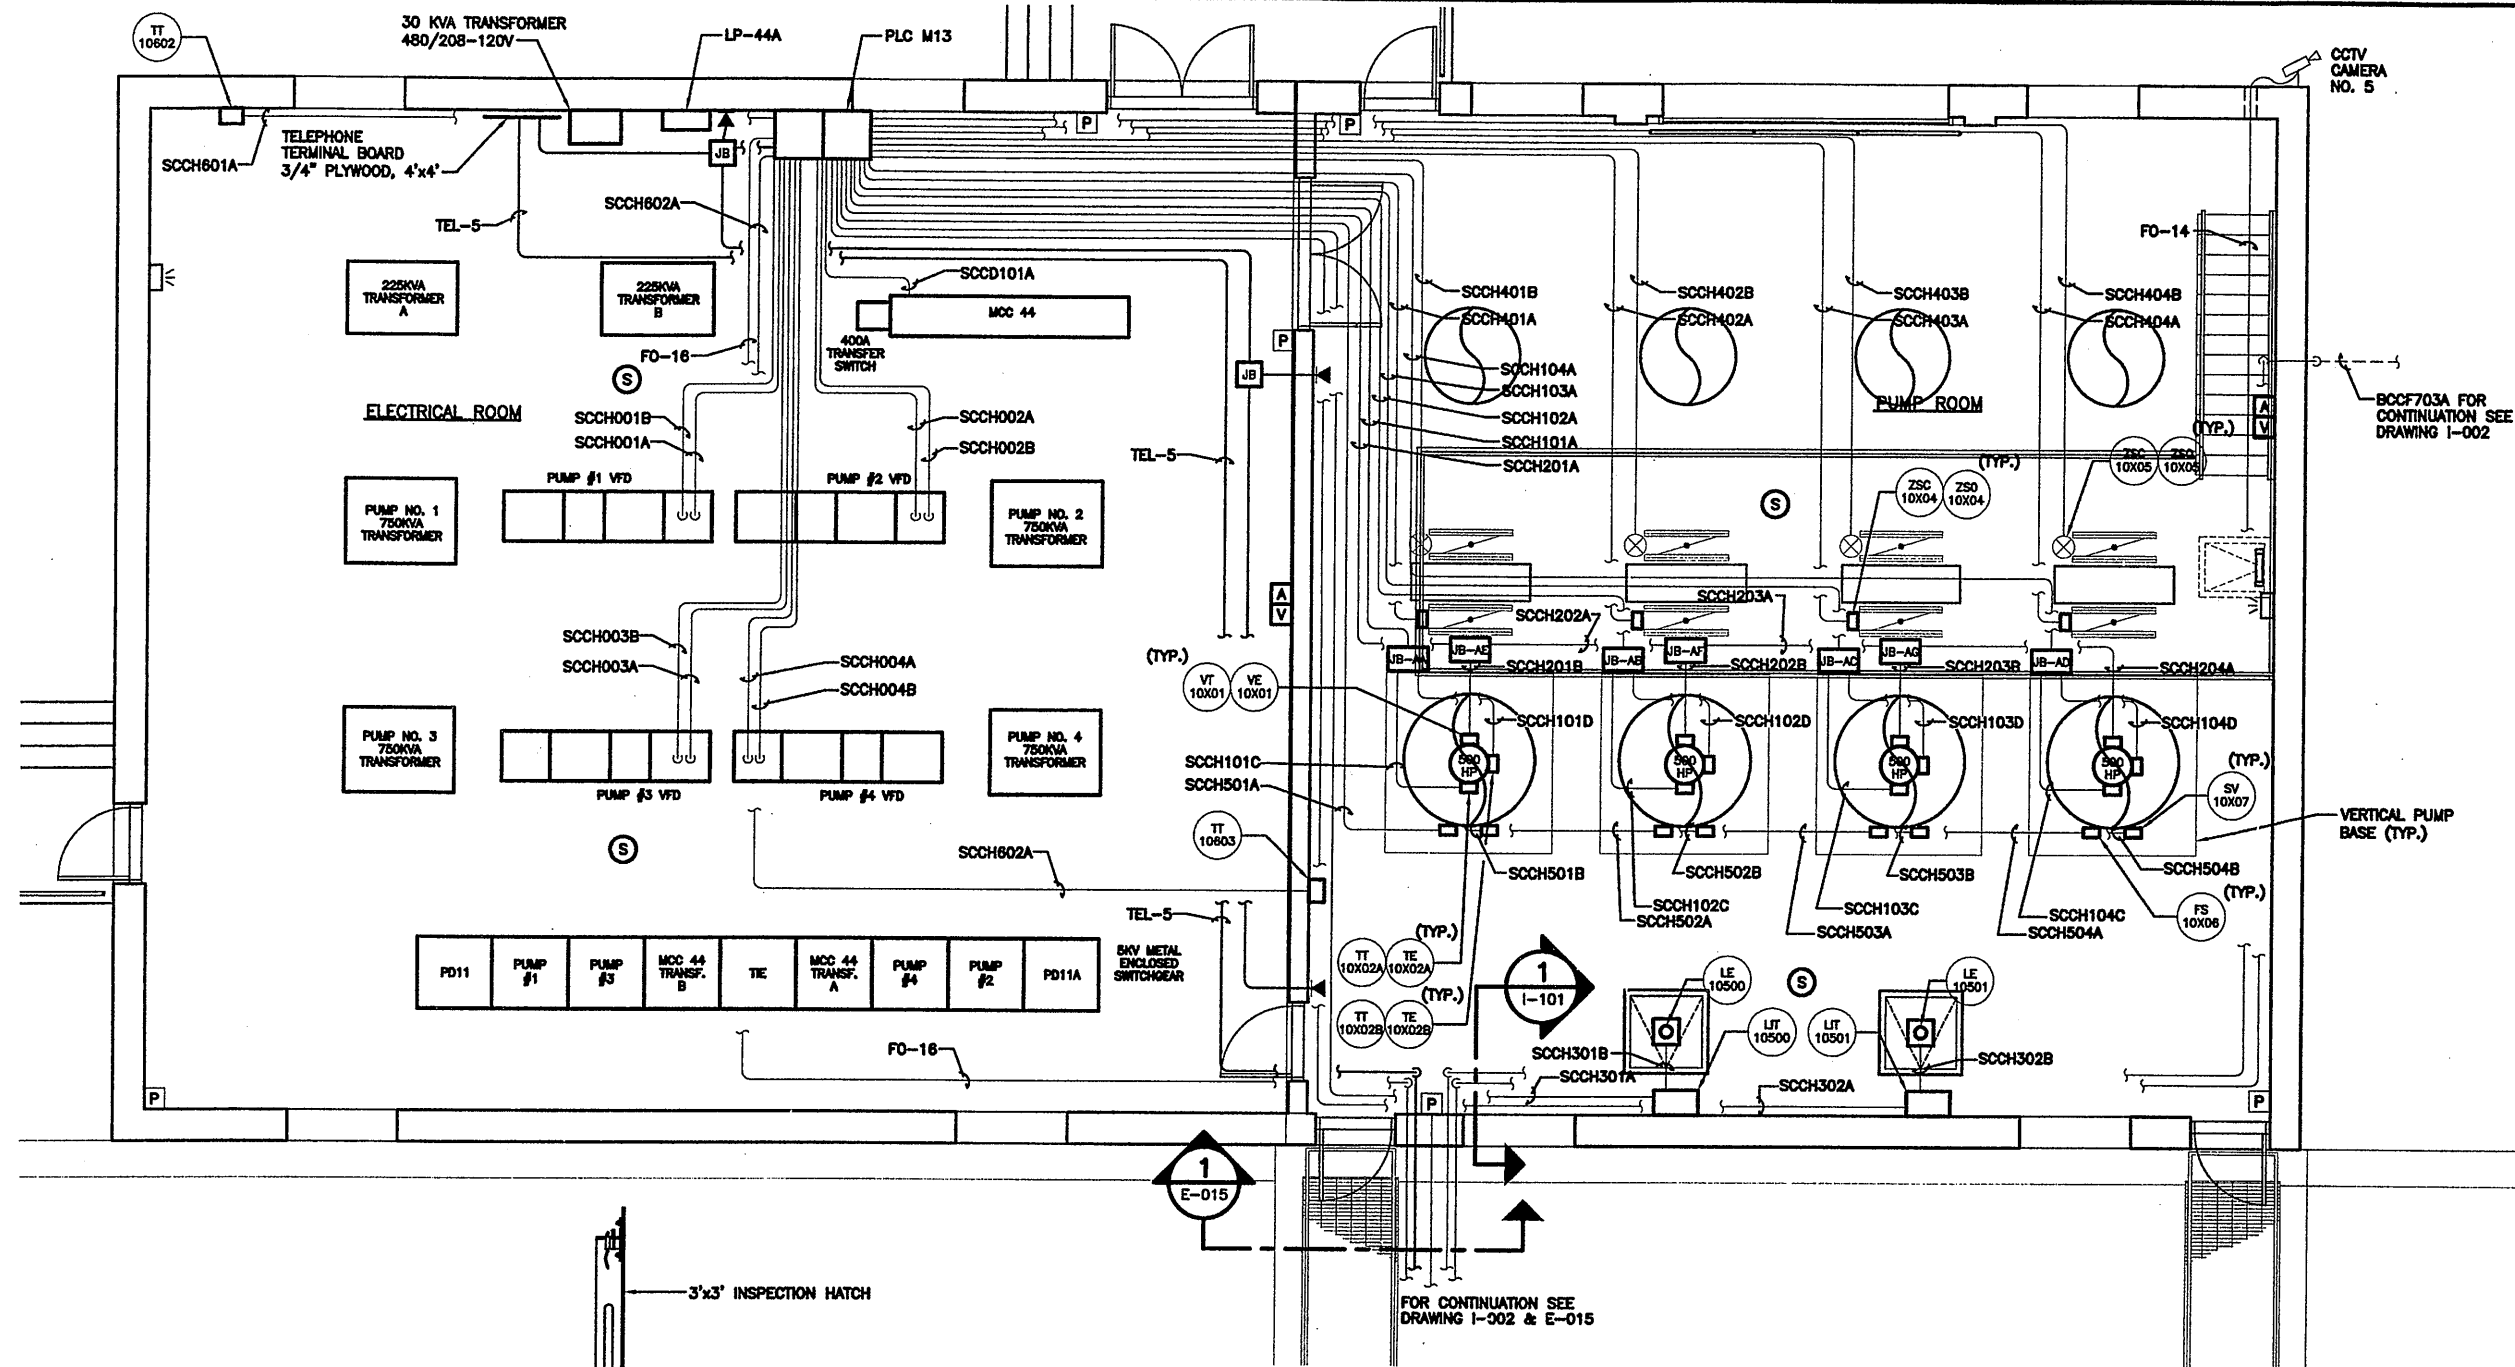

SECONDARY EFFLUENT PUMPING STATION PLAN
SCALE: 1/4"=1'-0"

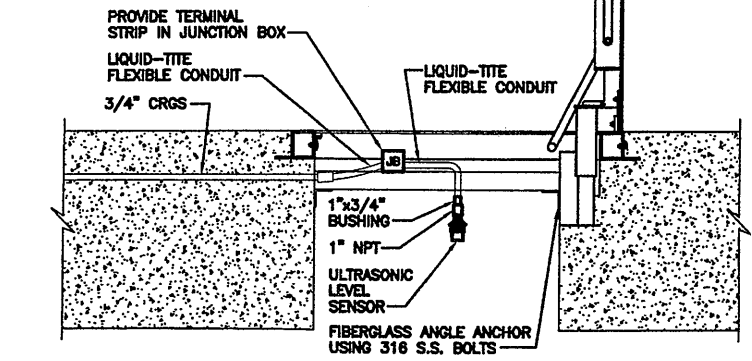

EFFLUENT PUMPING STATION LEVEL TRANSMITTER DETAIL
NOT TO SCALE

- NOTES:**
1. THE X IN INSTRUMENT TAG NUMBER REPRESENTS THE ASSOCIATED PUMP NUMBER.
 2. FOR CONDUIT SCHEDULE SEE DRAWINGS I-510, I-511, I-512 & I-513.
 3. FIRE ALARM CIRCUITS ARE TO BE RUN TO FIRE ALARM PANEL IN OPERATIONS CENTER CONTROL ROOM, SEE DRAWING E-510.
 4. PROVIDE CONNECTION OF PUMP #1 THROUGH #4 MOTOR BEARING RTD'S TO TEMPERATURE TRANSMITTERS TT-10X02A AND TT-10X02B (8 TOTAL), WIRING SHALL BE 3-#14 IN 3/4" CONDUITS, CONNECTION TO RTD'S SHALL BE MADE IN PUMP MOTOR AUXILIARY TERMINAL BOXES.

RECORD DRAWING
THESE DRAWINGS HAVE BEEN REVIEWED TO REFLECT MAKE CHANGES, IF ANY, WHICH OCCURRED DURING CONSTRUCTION. REVISIONS ARE BASED UPON INFORMATION SUPPLIED BY CONTRACTOR.
DATE: 10/21/05 FOR: Lampolet

Layer: ON=*, OFF=*REF*
X: 0659X101.DWG
4/11/01 BBL DCC
05503000/06591101.DWG

| No. | Date | Revisions | Init |
|-----|----------|---------------------|------|
| 0 | 4/20/01 | ISSUED FOR APPROVAL | |
| 1 | 7/11/01 | AS BID | |
| 2 | 10/31/05 | RECORD DRAWING | |

In charge of TEL
Designed by AHL
Drawn by DCC
Checked by FKP





ONONDAGA COUNTY • DEPARTMENT OF DRAINAGE AND SANITATION • SYRACUSE, NEW YORK
METROPOLITAN SYRACUSE WASTEWATER TREATMENT PLANT
STAGE III AMMONIA AND STAGE II PHOSPHORUS REMOVAL PROJECT
SECONDARY EFFLUENT PUMPING STATION
SECONDARY EFFLUENT PUMPING STATION PLAN
INSTRUMENTATION



File Number: 00659
Date: APRIL 2001
I-101
Lampolet

NO ALTERATIONS PERMITTED HEREON EXCEPT AS PROVIDED UNDER SECTION 7209 SUBDIVISION 2 OF THE NEW YORK STATE EDUCATION LAW

SECONDARY EFFLUENT
PUMP STATION CONTROL
PANEL PLC M13

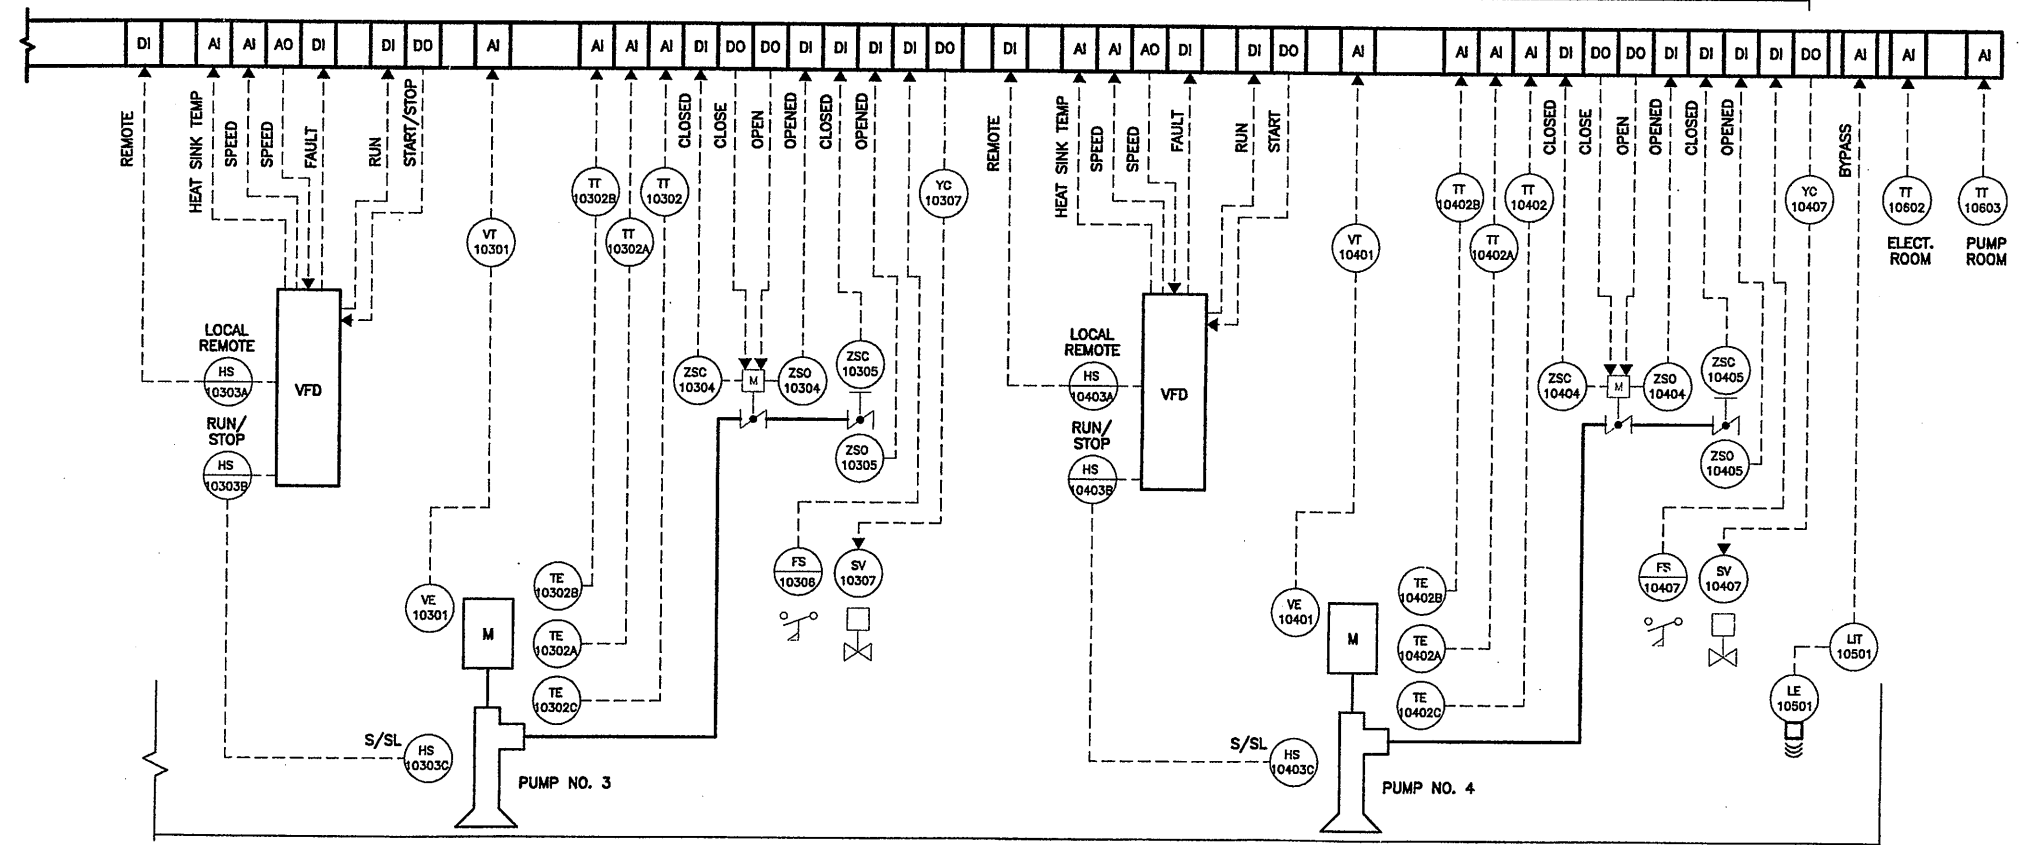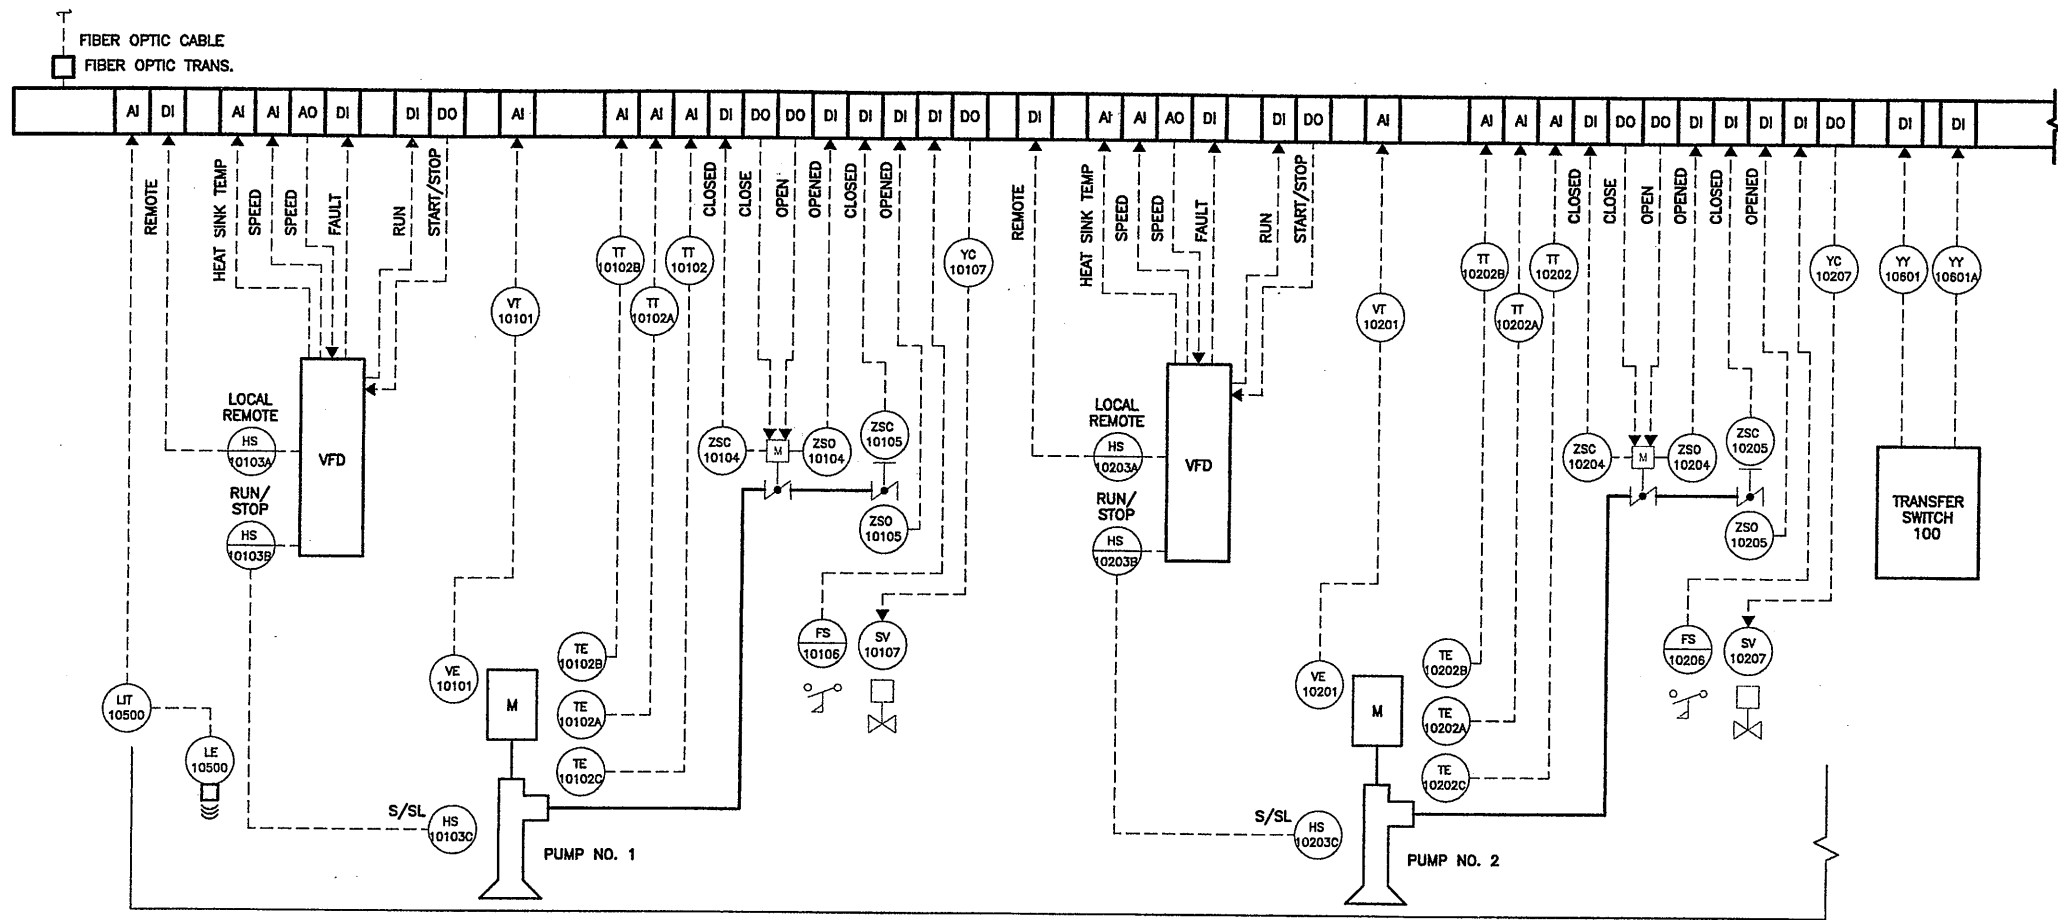

NOTES:
1. CONTROL CABINET AND PLC M13 PROVIDED
AND INSTALLED BY CONTRACT 48 - ELECTRICAL.

RECORD DRAWING
THESE CHANGES HAVE BEEN MADE TO REFLECT
MAJOR CHANGES BY ANY WHICH OCCURRED DURING
CONSTRUCTION. REVISIONS ARE BASED UPON
INFORMATION SUPPLIED BY CONSTRUCTION.
DATE: 10/15/01 PER: [Signature]

THIS DRAWING WAS PREPARED AT THE SCALE INDICATED IN THE
TITLE BLOCK. INACCURACIES IN THE STATED SCALE MAY BE
INTRODUCED WHEN DRAWINGS ARE REPRODUCED BY ANY MEANS.
USE THE GRAPHIC SCALE BAR IN THE TITLE BLOCK TO
DETERMINE THE ACTUAL SCALE OF THIS DRAWING.

Layer: ON=*; OFF=*REF*
09/15/00 BBL DCC
05503046/06591102.DWG

NOT TO SCALE
NO ALTERATIONS PERMITTED HEREON EXCEPT
AS PROVIDED UNDER SECTION 7209 SUBDIVISION
2 OF THE NEW YORK STATE EDUCATION LAW

| No. | Date | Revisions | Init |
|-----|----------|---------------------|-------------|
| 0 | 4/20/01 | ISSUED FOR APPROVAL | [Signature] |
| 1 | 7/11/01 | AS BID | [Signature] |
| 2 | 10/31/03 | RECORD DRAWING | [Signature] |

In charge of --- TEL ---
Designed by --- TEL ---
Drawn by --- DCC ---
Checked by --- FKP ---




ONONDAGA COUNTY • DEPARTMENT OF DRAINAGE AND SANITATION • SYRACUSE, NEW YORK
METROPOLITAN SYRACUSE WASTEWATER TREATMENT PLANT
STAGE III AMMONIA AND STAGE II PHOSPHORUS REMOVAL PROJECT
**SECONDARY EFFLUENT PUMPING STATION (PLC M13)
CONTROL DIAGRAM**




File Number
00659
Date
APRIL 2001
[Signature]

1-102

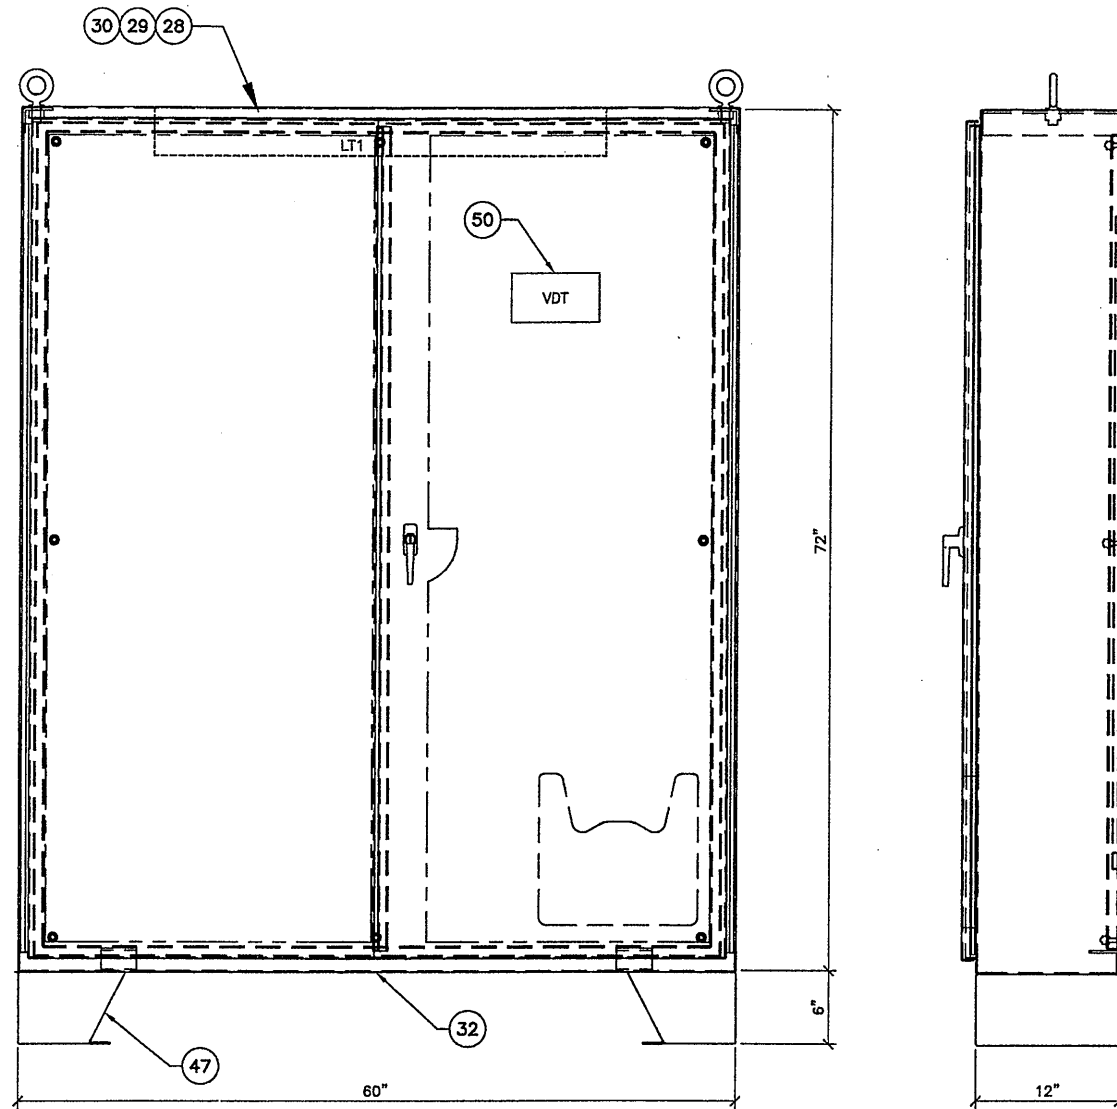



CONTROL PANEL FRONT VIEW

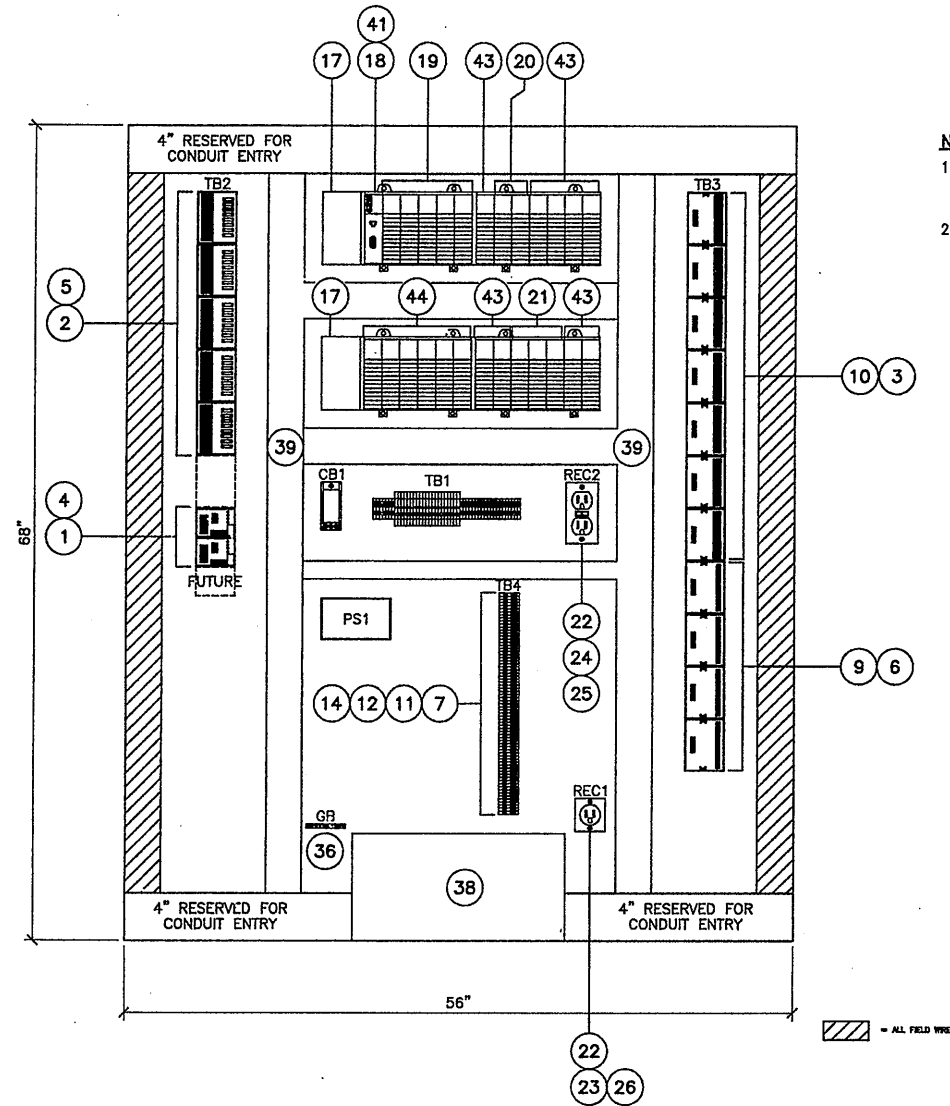

CONTROL PANEL INTERIOR VIEW

- NOTES:**
- LAYOUT SHOWN IS FOR CONCEPT ONLY. CONTRACTOR SHALL PROVIDE ALL NECESSARY APPURTENANCES REQUIRED FOR A COMPLETE AND OPERATIONAL SYSTEM.
 - PANEL SIZE IS APPROXIMATE ONLY. CONTRACTOR SHALL PROVIDE ENCLOSURE SIZE AS REQUIRED FOR EQUIPMENT.

SECONDARY EFFLUENT PUMP STATION CONTROL PANEL

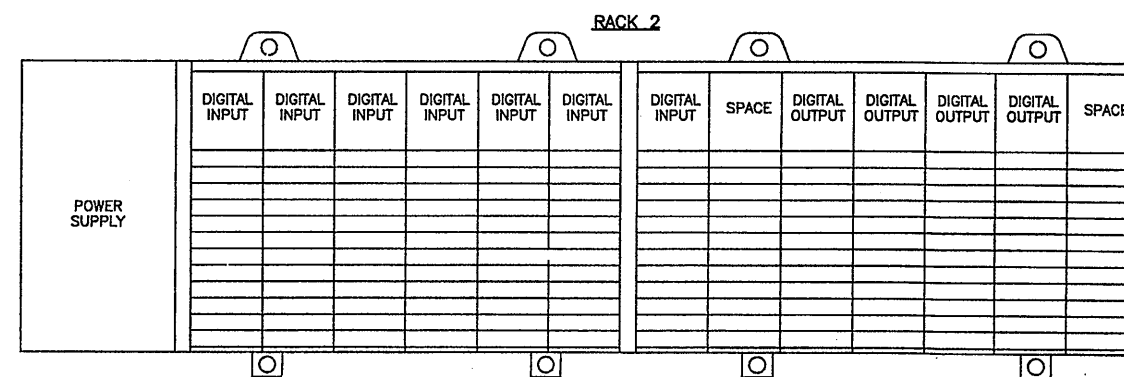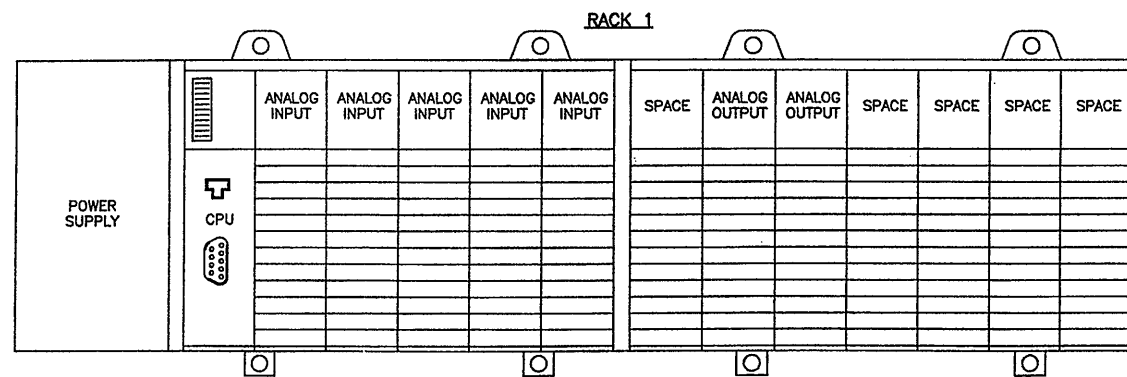

PLC MODULE LAYOUT

RECORD DRAWING
 THESE DRAWINGS HAVE BEEN REVIEWED TO REFLECT MAJOR CHANGES, IF ANY, WHICH OCCURRED DURING CONSTRUCTION. REVISIONS ARE BASED UPON INFORMATION SUPPLIED BY CONTRACTOR.
 DATE: 10/21/01 PER: [Signature]

THIS DRAWING WAS PREPARED AT THE SCALE INDICATED IN THE TITLE BLOCK. INACCURACIES IN THE STATED SCALE MAY BE INTRODUCED WHEN DRAWINGS ARE REPRODUCED BY ANY MEANS. USE THE GRAPHIC SCALE BAR IN THE TITLE BLOCK TO DETERMINE THE ACTUAL SCALE OF THIS DRAWING.

01/17/01 OBG JEC

| No. | Date | Revisions | Init |
|-----|----------|---------------------|------|
| 0 | 4/20/01 | ISSUED FOR APPROVAL | JK |
| 1 | 7/11/01 | AS BID | |
| 2 | 10/31/01 | RECORD DRAWING | |

In charge of — PLD
 Designed by — SAT
 Drawn by — JEC
 Checked by — PLD



ONONDAGA COUNTY • DEPARTMENT OF DRAINAGE AND SANITATION • SYRACUSE, NEW YORK
 METROPOLITAN SYRACUSE WASTEWATER TREATMENT PLANT
 STAGE III AMMONIA AND STAGE II PHOSPHORUS REMOVAL PROJECT

**SECONDARY EFFLUENT PUMP STATION (PLC M13)
 CONTROL PANEL LAYOUT**
 INSTRUMENTATION



File Number
 00659
 Date
 APRIL 2001
 [Signature]

| BILL OF MATERIALS | | | | |
|-------------------|----------|--------------------|---------------|---|
| SYMBOL | QUANTITY | MODEL NUMBER | MANUFACTURER | DESCRIPTION |
| 1 | A/R | SEE SPECIFICATIONS | Allen-Bradley | Analog Output Interface Module |
| 2 | A/R | SEE SPECIFICATIONS | Allen-Bradley | Analog Input Interface Module |
| 3 | A/R | SEE SPECIFICATIONS | Allen-Bradley | Digital Input Interface Cable - 1 meter |
| 4 | A/R | SEE SPECIFICATIONS | Allen-Bradley | Analog Output Interface Cable - 2.5 meter |
| 5 | A/R | SEE SPECIFICATIONS | Allen-Bradley | Analog Input Interface Cable - 1 meter |
| 6 | A/R | SEE SPECIFICATIONS | Allen-Bradley | Relay Output Interface Cable - 0.5 meter |
| 7 | A/R | SEE SPECIFICATIONS | Allen-Bradley | High Density Terminal Block |
| 8 | A/R | SEE SPECIFICATIONS | Allen-Bradley | Fusible Switch |
| 9 | A/R | SEE SPECIFICATIONS | Allen-Bradley | Relay Output Interface Module |
| 10 | A/R | SEE SPECIFICATIONS | Allen-Bradley | Digital Input Interface Module |
| 11 | A/R | SEE SPECIFICATIONS | Allen-Bradley | End Anchor |
| 12 | A/R | SEE SPECIFICATIONS | Allen-Bradley | High Density Terminal Block End Barrier |
| 13 | A/R | SEE SPECIFICATIONS | Allen-Bradley | Fusible Switch End Barrier |
| 14 | A/R | SEE SPECIFICATIONS | Allen-Bradley | High Density Jumper |
| 15 | A/R | SEE SPECIFICATIONS | | |
| 16 | A/R | SEE SPECIFICATIONS | Allen-Bradley | 13 Slot I/O Chassis |
| 17 | A/R | SEE SPECIFICATIONS | Allen-Bradley | I/O Chassis Power Supply |
| 18 | A/R | SEE SPECIFICATIONS | Allen-Bradley | CPU |
| 19 | A/R | SEE SPECIFICATIONS | Allen-Bradley | Analog Input - 8 point |
| 20 | A/R | SEE SPECIFICATIONS | Allen-Bradley | Analog Output - 4 point |
| 21 | A/R | SEE SPECIFICATIONS | Allen-Bradley | Relay Output - 8 point |
| 22 | A/R | SEE SPECIFICATIONS | RACO | Box |
| 23 | A/R | SEE SPECIFICATIONS | RACO | Cover - single 15 amp |
| 24 | A/R | SEE SPECIFICATIONS | RACO | Cover - duplex 15 amp |
| 25 | A/R | SEE SPECIFICATIONS | Hubbell | 15A Duplex receptacle |
| 26 | A/R | SEE SPECIFICATIONS | Hubbell | 15A Single receptacle |
| 27 | A/R | SEE SPECIFICATIONS | | |
| 28 | A/R | SEE SPECIFICATIONS | Hoffman | Mounting bracket for light |
| 29 | A/R | SEE SPECIFICATIONS | Hoffman | 2' light |
| 30 | A/R | SEE SPECIFICATIONS | Hoffman | Door Switch for light |
| 31 | A/R | SEE SPECIFICATIONS | | |
| 32 | A/R | SEE SPECIFICATIONS | Hoffman | Nema 12 Enclosure |
| 33 | A/R | SEE SPECIFICATIONS | Hoffman | Sub-Panel |
| 34 | A/R | SEE SPECIFICATIONS | Panduit | 3"W x 3"D Slotted Wiring Duct |
| 35 | A/R | SEE SPECIFICATIONS | Panduit | 2"W x 3"D Slotted Wiring Duct |
| 36 | A/R | SEE SPECIFICATIONS | Square D | Ground Bar |
| 37 | A/R | SEE SPECIFICATIONS | Allen-Bradley | 20 amp Circuit Breaker, single pole |
| 38 | A/R | SEE SPECIFICATIONS | Best Power | Uninterruptible Power Supply |
| 39 | A/R | SEE SPECIFICATIONS | Power One | DC Power Supply 24 Vdc Output |
| 40 | A/R | SEE SPECIFICATIONS | TBD | Fuses |
| 41 | A/R | SEE SPECIFICATIONS | Allen-Bradley | Flash EEprom Memory for CPU |
| 42 | A/R | SEE SPECIFICATIONS | - | - |
| 43 | A/R | SEE SPECIFICATIONS | Allen-Bradley | Blank Slot Filler Module |
| 44 | A/R | SEE SPECIFICATIONS | Allen-Bradley | Discrete Input - 8 point |
| 45 | A/R | SEE SPECIFICATIONS | - | - |
| 46 | A/R | SEE SPECIFICATIONS | - | - |
| 47 | A/R | SEE SPECIFICATIONS | Hoffman | Leg Kit |
| 48 | A/R | SEE SPECIFICATIONS | - | - |
| 50 | A/R | SEE SPECIFICATIONS | Allen-Bradley | VDT |

Layer: ON=*; OFF=*REF*
01/17/01 080 JEC

RECORD DRAWING

THESE DRAWINGS HAVE BEEN REVISIONED TO REFLECT
MAJOR CHANGES, IF ANY, WHICH OCCURRED DURING
CONSTRUCTION. REVISIONS ARE BASED UPON
INFORMATION SUPPLIED BY CONTRACTOR.
DWG. 102101 PER. PLD

THIS DRAWING WAS PREPARED AT THE SCALE INDICATED IN THE
TITLE BLOCK. INACCURACIES IN THE STATED SCALE MAY BE
INTRODUCED WHEN DRAWINGS ARE REPRODUCED BY ANY MEANS.
USE THE GRAPHIC SCALE BAR IN THE TITLE BLOCK TO
DETERMINE THE ACTUAL SCALE OF THIS DRAWING.

| No. | Date | Revisions | Init |
|-----|----------|---------------------|------|
| 0 | 4/20/01 | ISSUED FOR APPROVAL | PLD |
| 1 | 7/11/01 | AS BID | SAT |
| 2 | 10/31/09 | RECORD DRAWING | JEC |

NO ALTERATIONS PERMITTED HEREON EXCEPT
AS PROVIDED UNDER SECTION 7209 SUBDIVISION
2 OF THE NEW YORK STATE EDUCATION LAW

In charge of PLD
Designed by SAT
Drawn by JEC
Checked by PLD

ENVIRONMENTAL ENGINEERING ASSOCIATES, LLP
SYRACUSE, NEW YORK


ONONDAGA COUNTY • DEPARTMENT OF DRAINAGE AND SANITATION • SYRACUSE, NEW YORK
METROPOLITAN SYRACUSE WASTEWATER TREATMENT PLANT
STAGE III AMMONIA AND STAGE II PHOSPHORUS REMOVAL PROJECT
SECONDARY EFFLUENT PUMPING STATION (PLC M13)
BILL OF MATERIALS



File Number
00659
Date
APRIL 2001
PLD

I-104

INSTRUMENTATION

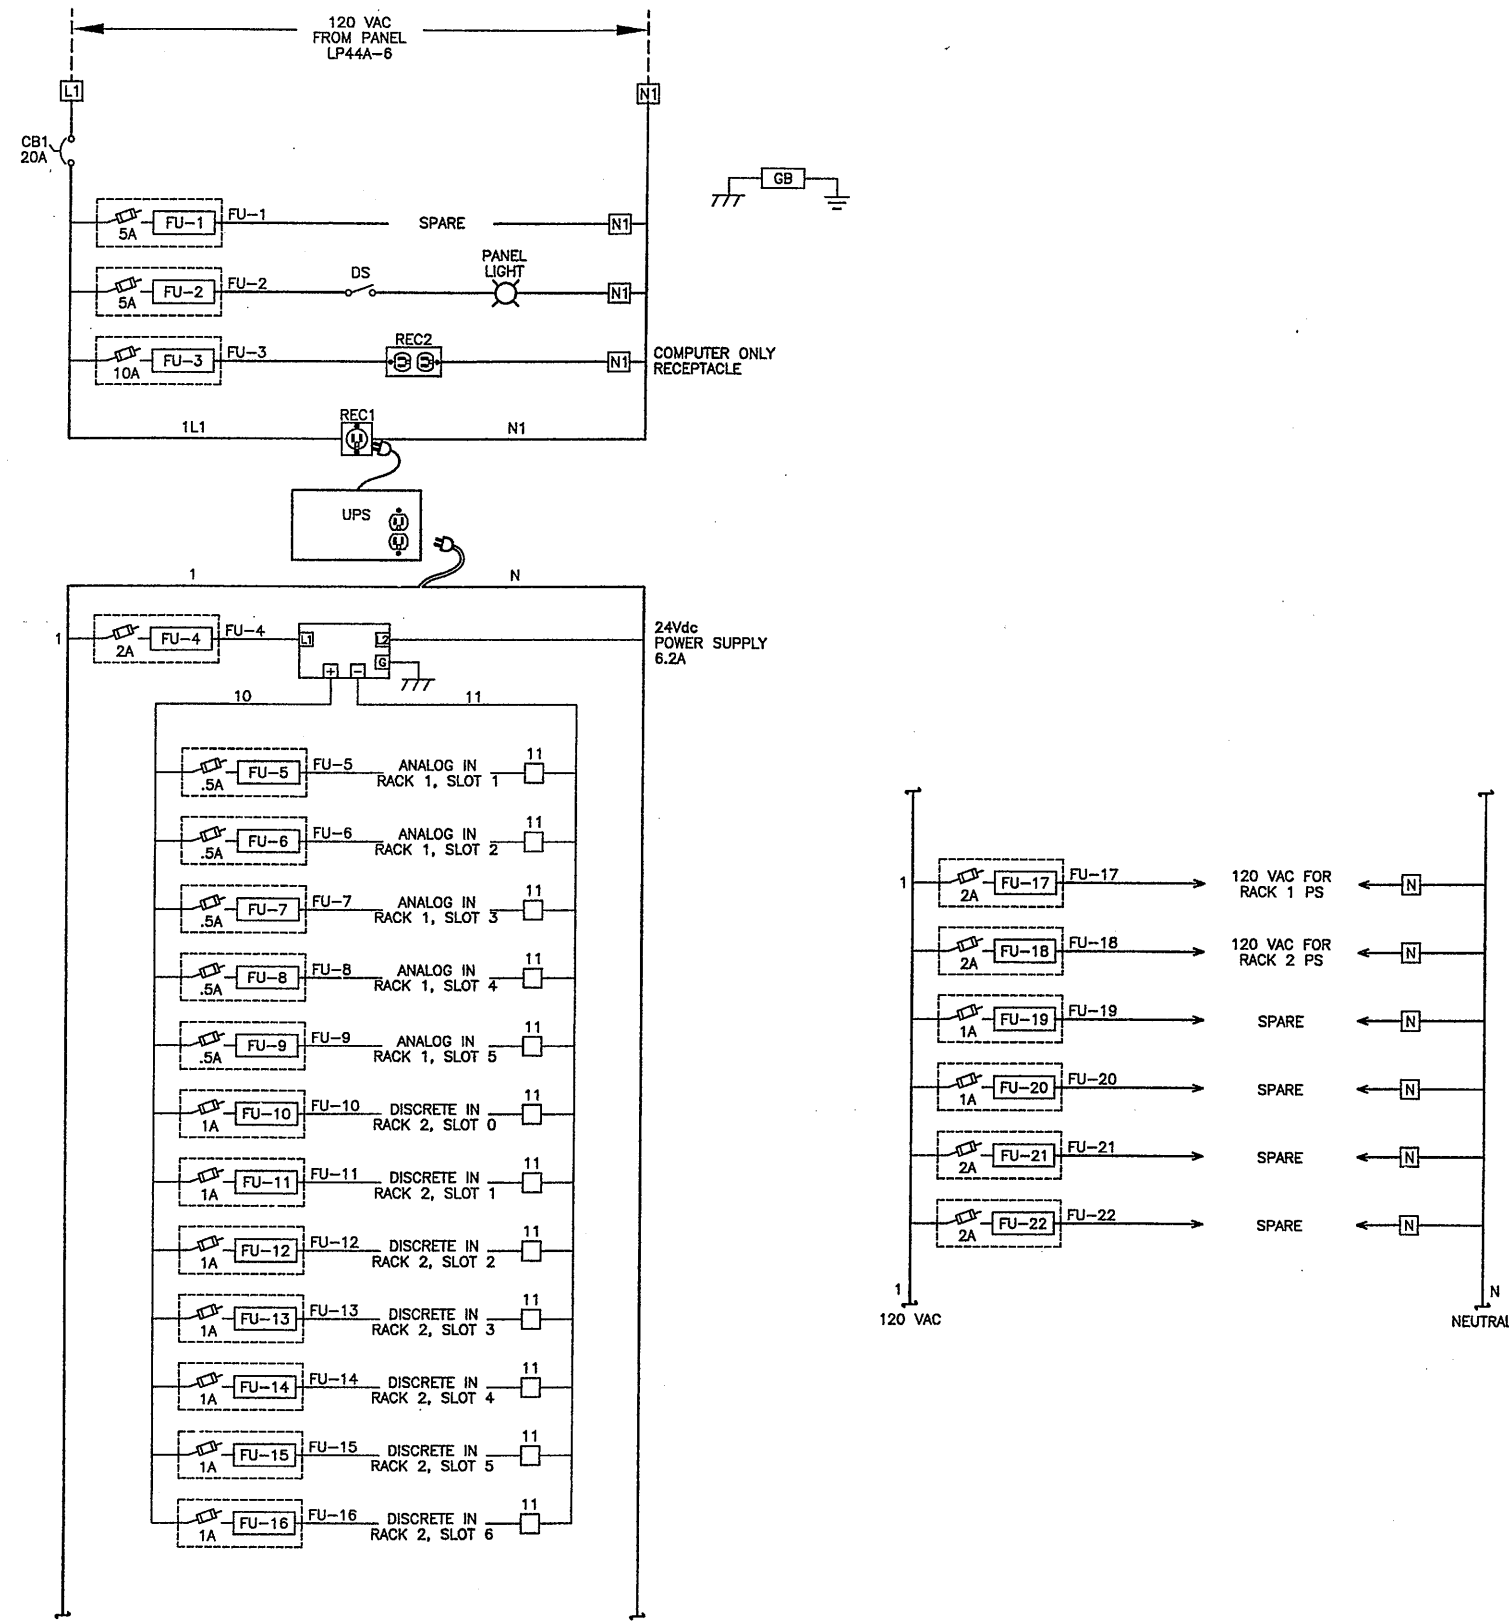


Layer: ON=; OFF=*REF*
07/17/00 OBG JEC

RECORD DRAWING
 THESE CHANGES HAVE BEEN MADE TO REFLECT MAJOR CHANGES, IF ANY, WHICH OCCURRED DURING CONSTRUCTION. REVISIONS ARE BASED UPON INFORMATION SUPPLIED BY CONTRACTOR.
 DATE: 10/21/05 FOR: L. Campolieto
 THIS DRAWING WAS PREPARED AT THE SCALE INDICATED IN THE TITLE BLOCK. INACCURACIES IN THE STATED SCALE MAY BE INTRODUCED WHEN DRAWINGS ARE REPRODUCED BY ANY MEANS. USE THE GRAPHIC SCALE BAR IN THE TITLE BLOCK TO DETERMINE THE ACTUAL SCALE OF THIS DRAWING.

| No. | Date | Revisions | Init |
|-----|----------|---------------------|------|
| 0 | 4/20/01 | ISSUED FOR APPROVAL | PLD |
| 1 | 7/11/01 | AS BID | SAT |
| 2 | 10/31/05 | RECORD DRAWING | JEC |

NO ALTERATIONS PERMITTED HEREON EXCEPT AS PROVIDED UNDER SECTION 7209 SUBDIVISION 2 OF THE NEW YORK STATE EDUCATION LAW


In charge of PLD
 Designed by SAT
 Drawn by JEC
 Checked by PLD

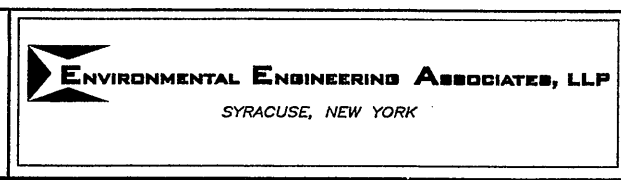


ONONDAGA COUNTY • DEPARTMENT OF DRAINAGE AND SANITATION • SYRACUSE, NEW YORK
 METROPOLITAN SYRACUSE WASTEWATER TREATMENT PLANT
 STAGE III AMMONIA AND STAGE II PHOSPHORUS REMOVAL PROJECT
**SECONDARY EFFLUENT PUMPING STATION (PLC M13)
 CONTROL CIRCUIT WIRING**
 INSTRUMENTATION

File Number: 00659
 Date: APRIL 2001
 I-105
 L. Campolieto


TB1

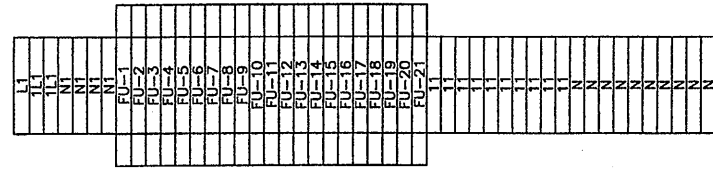


TB2 (ANALOG)

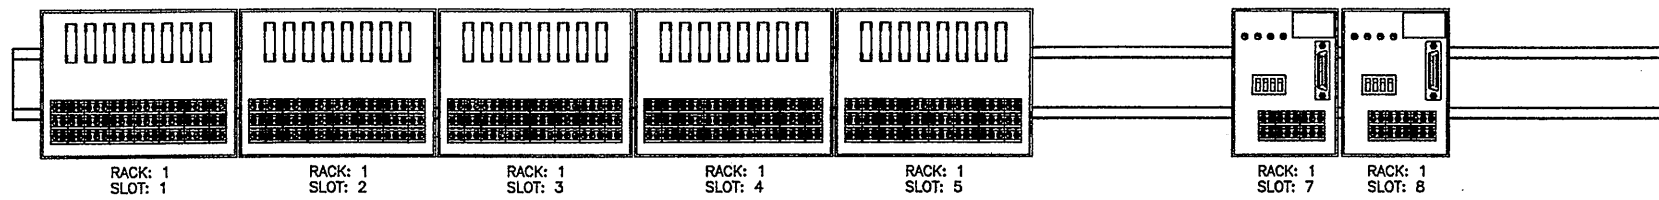

TB3 (DIGITAL)

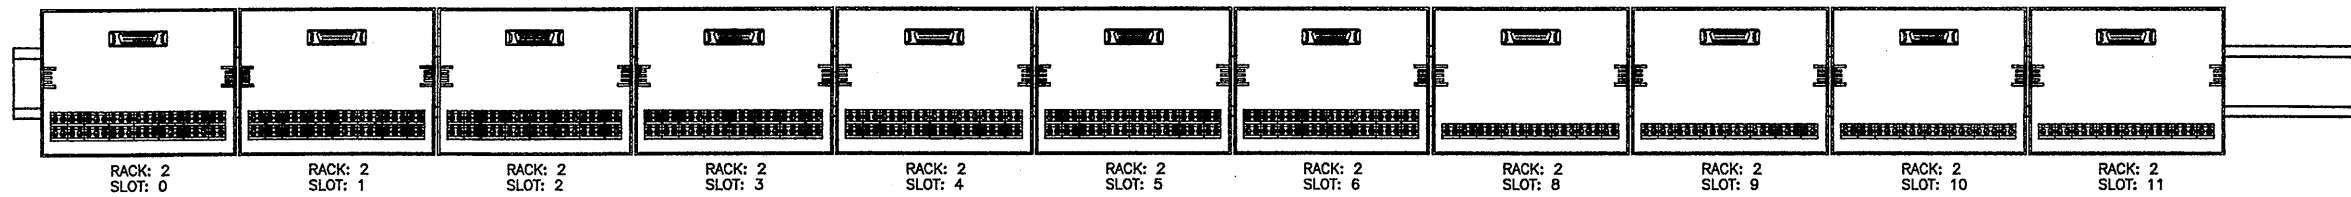

TB4 (24Vdc DI)

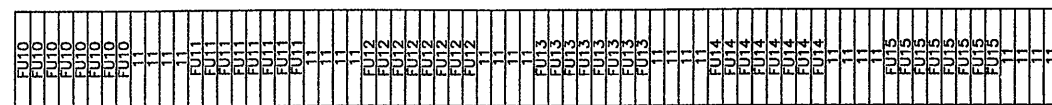

Layer: ON=*; OFF=*REF*
11/27/00 OBS JEC

RECORD DRAWING
THIS DRAWING HAS BEEN REVISIONED TO REFLECT
MAJOR CHANGES, IF ANY, WHICH OCCURRED DURING
CONSTRUCTION. REVISIONS ARE BASED UPON
INFORMATION SUPPLIED BY CONTRACTOR.
DATE: 10/21/05 FOR: [Signature]

THIS DRAWING WAS PREPARED AT THE SCALE INDICATED IN THE
TITLE BLOCK. INACCURACIES IN THE STATED SCALE MAY BE
INTRODUCED WHEN DRAWINGS ARE REPRODUCED BY ANY MEANS.
USE THE GRAPHIC SCALE BAR IN THE TITLE BLOCK TO
DETERMINE THE ACTUAL SCALE OF THIS DRAWING.

| No. | Date | Revisions | Init |
|-----|----------|---------------------|-------------|
| 0 | 4/20/01 | ISSUED FOR APPROVAL | [Signature] |
| 1 | 7/11/01 | AS BID | [Signature] |
| 2 | 10/31/05 | RECORD DRAWING | [Signature] |

NO ALTERATIONS PERMITTED HEREON EXCEPT
AS PROVIDED UNDER SECTION 7209 SUBDIVISION
2 OF THE NEW YORK STATE EDUCATION LAW

In charge of... PLD
Designed by... SAT
Drawn by... JEC
Checked by... PLD




ONONDAGA COUNTY • DEPARTMENT OF DRAINAGE AND SANITATION • SYRACUSE, NEW YORK
METROPOLITAN SYRACUSE WASTEWATER TREATMENT PLANT
STAGE III AMMONIA AND STAGE II PHOSPHORUS REMOVAL PROJECT
SECONDARY EFFLUENT PUMPING STATION (PLC M13)
TERMINAL BLOCK LAYOUT
INSTRUMENTATION



File Number
00659
Date
APRIL 2001
[Signature]

I-106

8 POINT ANALOG INPUT MODULE
(AB 1746-NIB)

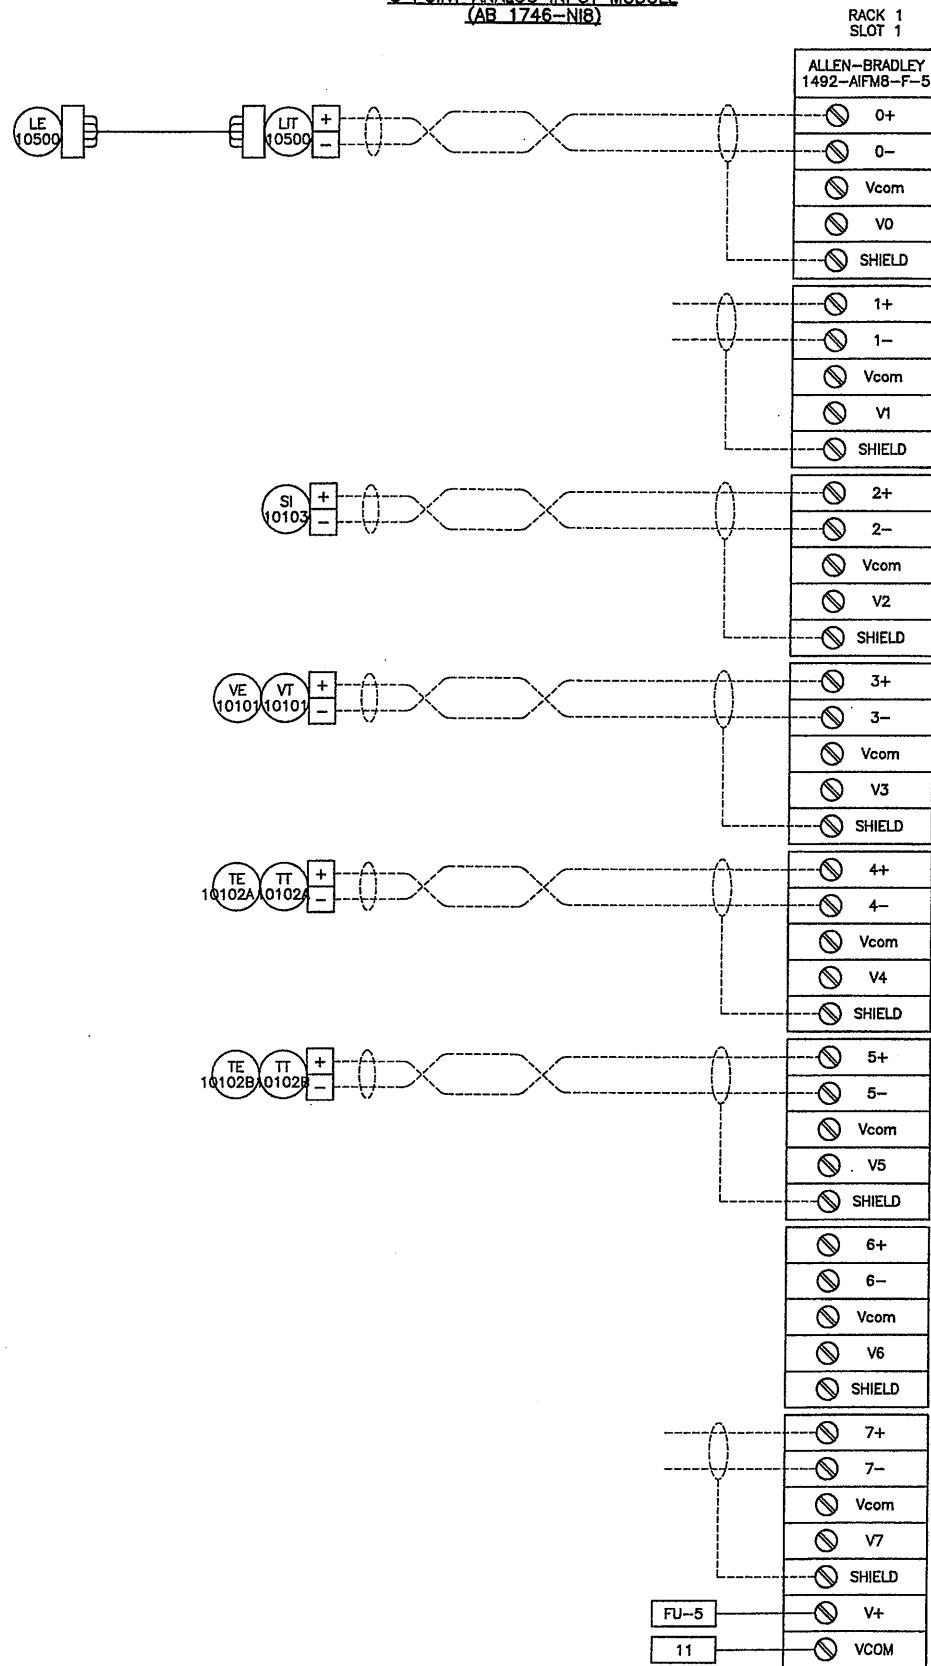

SECONDARY EFFLUENT
WET WELL LEVEL
0-XX FT.

SPARE

PUMP NO.1
SPEED
0-100 %


PUMP NO.1
VIBRATION
XX IN/SEC

PUMP NO.1
MOTOR TEMPERATURE
0-XX °F

PUMP NO.1
MOTOR TEMPERATURE
0-XX °F

SPARE

8 POINT ANALOG INPUT MODULE
(AB 1746-NIB)

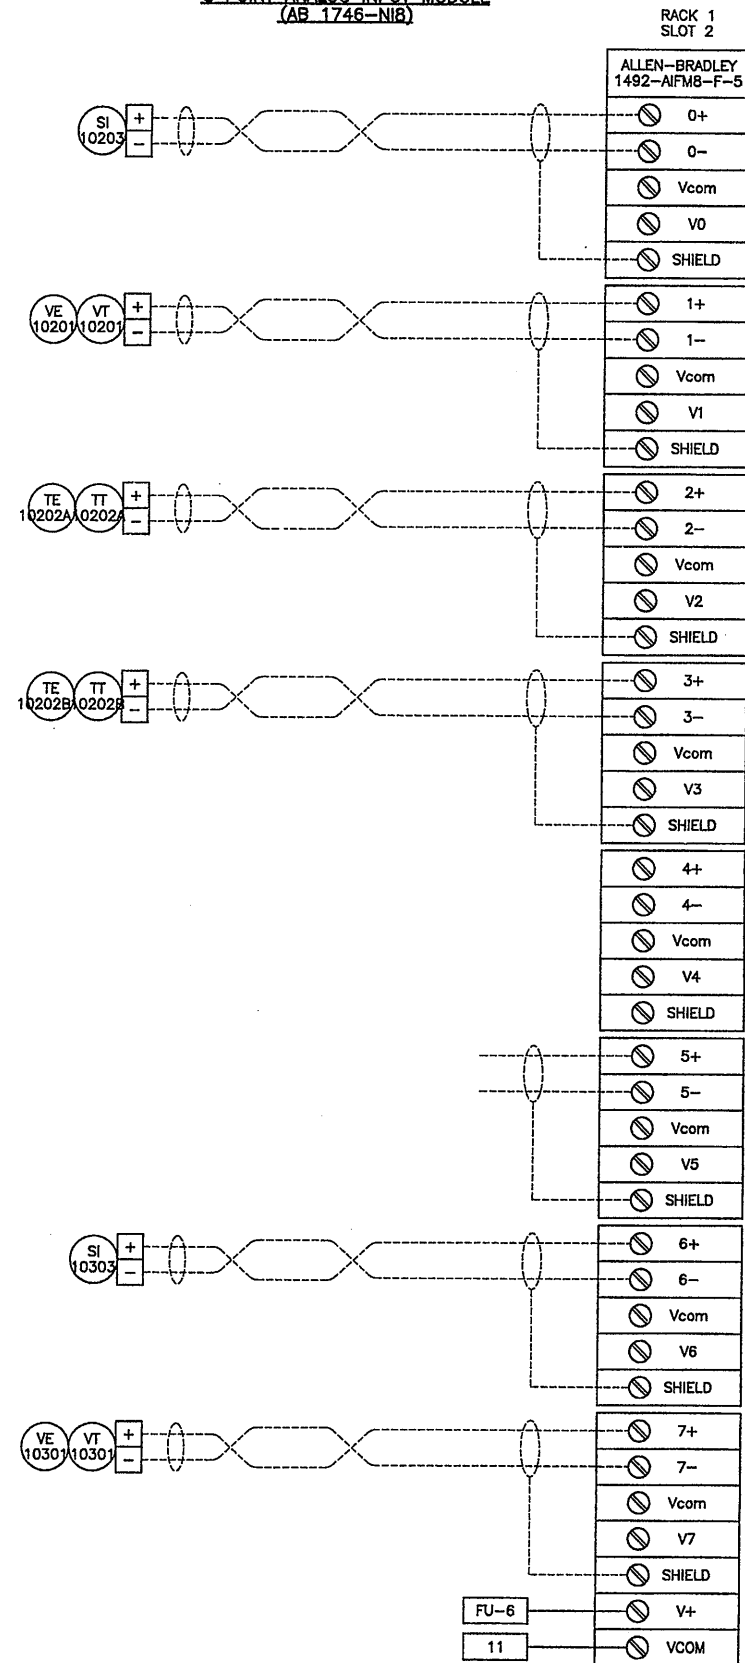

PUMP NO.2
SPEED
0-100 %

PUMP NO.2
VIBRATION
XX IN/SEC

PUMP NO.2
MOTOR TEMPERATURE
0-XX °F

PUMP NO.2
MOTOR TEMPERATURE
0-XX °F

SPARE

PUMP NO.3
SPEED
0-100 %

PUMP NO.3
VIBRATION
XX IN/SEC

RECORD DRAWING

THESE CHANGES HAVE BEEN MADE TO REFLECT MAJOR CHANGES IF ANY, WHICH OCCURRED DURING CONSTRUCTION. REVISIONS ARE BASED UPON INFORMATION SUPPLIED BY CONTRACTOR.

DATE: 10/21/05 PER: [Signature]

THIS DRAWING WAS PREPARED AT THE SCALE INDICATED IN THE TITLE BLOCK. INACCURACIES IN THE STATED SCALE MAY BE INTRODUCED WHEN DRAWINGS ARE REPRODUCED BY ANY MEANS. USE THE GRAPHIC SCALE BAR IN THE TITLE BLOCK TO DETERMINE THE ACTUAL SCALE OF THIS DRAWING.

Layer: ON=*; OFF=*REF*

01/17/01 OBG JEC
EEA-VERT

| No. | Date | Revisions | Init |
|-----|----------|---------------------|------|
| 0 | 4/20/01 | ISSUED FOR APPROVAL | PLD |
| 1 | 7/11/01 | AS BID | |
| 2 | 10/31/05 | RECORD DRAWING | |

In charge of -- PLD
Designed by -- SAT
Drawn by -- JEC
Checked by -- PLD



ONONDAGA COUNTY • DEPARTMENT OF DRAINAGE AND SANITATION • SYRACUSE, NEW YORK
METROPOLITAN SYRACUSE WASTEWATER TREATMENT PLANT
STAGE III AMMONIA AND STAGE II PHOSPHORUS REMOVAL PROJECT

SECONDARY EFFLUENT PUMPING STATION (PLC M13)
ANALOG INPUT MODULES
INSTRUMENTATION




File Number
00659
Date
APRIL 2001
[Signature]

I-107

NO ALTERATIONS PERMITTED HEREON EXCEPT AS PROVIDED UNDER SECTION 7209 SUBDIVISION 2 OF THE NEW YORK STATE EDUCATION LAW

8 POINT ANALOG INPUT MODULE
(AB 1746-N18)

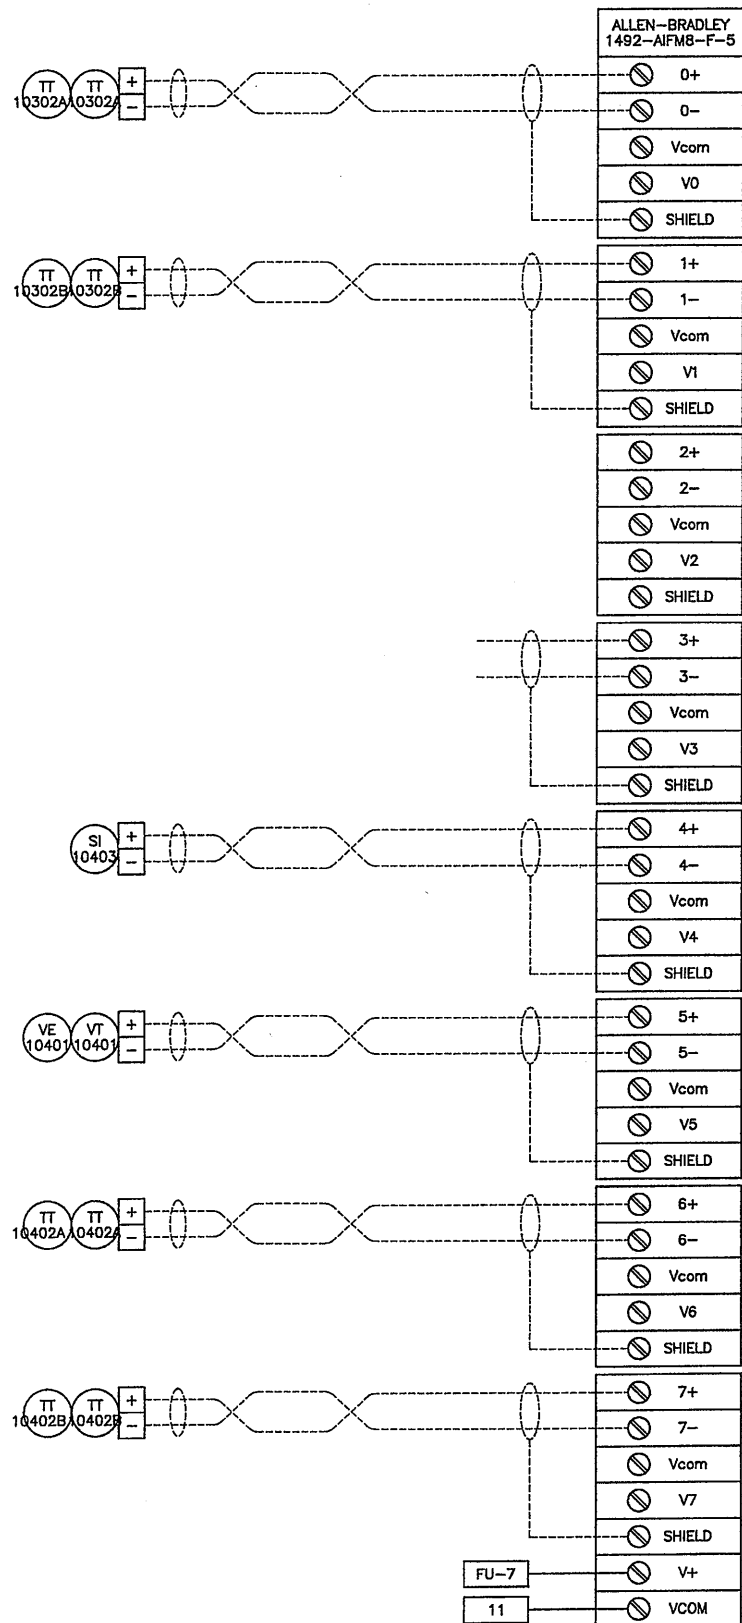

PUMP NO.3
MOTOR TEMPERATURE
0-XX °F

PUMP NO.3
MOTOR TEMPERATURE
0-XX °F

SPARE


PUMP NO.4
SPEED
0-100 %

PUMP NO.4
VIBRATION
XX IN/SEC

PUMP NO.4
MOTOR TEMPERATURE
0-XX °F

PUMP NO.4
MOTOR TEMPERATURE
0-XX °F

8 POINT ANALOG INPUT MODULE
(AB 1746-N18)

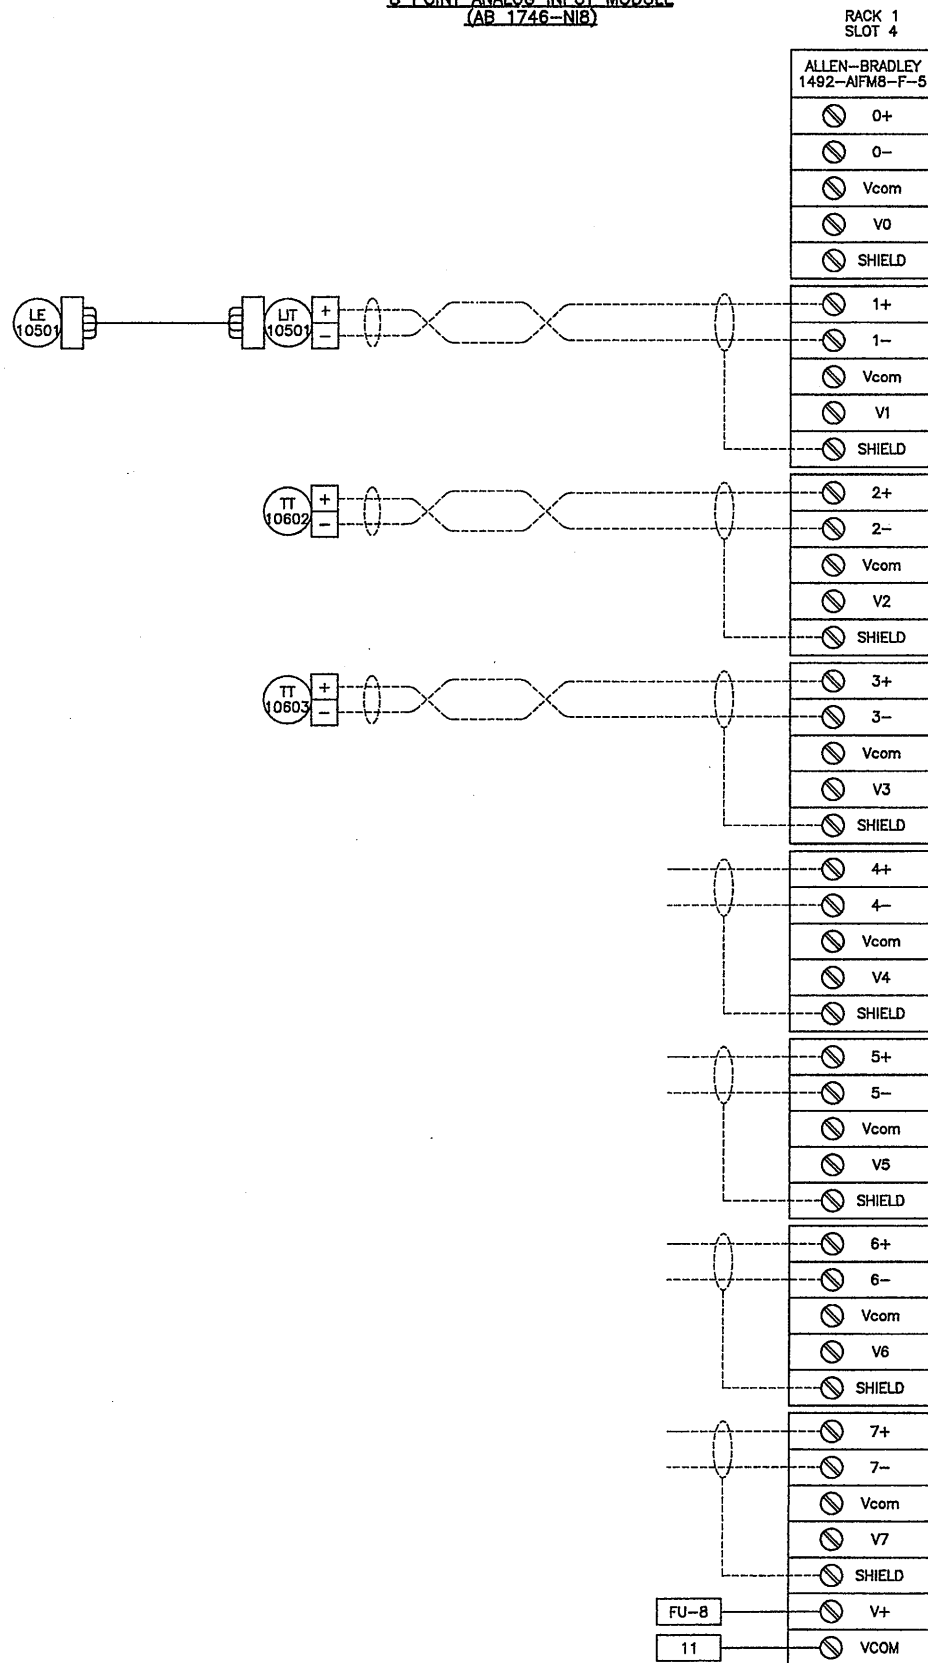

SECONDARY EFFLUENT
WET WELL LEVEL
0-XX FT.

ELECTRIC ROOM
TEMPERATURE
0-XX °F

PUMP ROOM
TEMPERATURE
0-XX °F

SPARE

SPARE

SPARE

SPARE

RECORD DRAWING

THESE DRAWINGS HAVE BEEN REVISIONED TO REFLECT
MAJOR CHANGES, IF ANY, WHICH OCCURRED DURING
CONSTRUCTION. REVISIONS ARE BASED UPON
INFORMATION SUPPLIED BY CONTRACTOR.

DATE: 10/21/05 FOR: Stamped

THIS DRAWING WAS PREPARED AT THE SCALE INDICATED IN THE
TITLE BLOCK. INACCURACIES IN THE STATED SCALE MAY BE
INTRODUCED WHEN DRAWINGS ARE REPRODUCED BY ANY MEANS.
USE THE GRAPHIC SCALE BAR IN THE TITLE BLOCK TO
DETERMINE THE ACTUAL SCALE OF THIS DRAWING.


Layer: ON=*, OFF=*REF*
01/12/01 OBG JEC
EEA-VERT

| No. | Date | Revisions | Init |
|-----|----------|---------------------|------|
| 0 | 4/20/01 | ISSUED FOR APPROVAL | PLD |
| 1 | 7/11/01 | AS BID | |
| 2 | 10/31/05 | RECORD DRAWING | |

In charge of PLD
Designed by SAT
Drawn by JEC
Checked by PLD




ONONDAGA COUNTY • DEPARTMENT OF DRAINAGE AND SANITATION • SYRACUSE, NEW YORK
METROPOLITAN SYRACUSE WASTEWATER TREATMENT PLANT
STAGE III AMMONIA AND STAGE II PHOSPHORUS REMOVAL PROJECT
SECONDARY EFFLUENT PUMPING STATION (PLC M13)
ANALOG INPUT MODULES

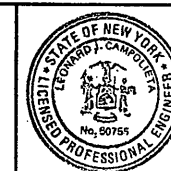

File Number
00659
Date
APRIL 2001
Stamped

I-108

8 POINT ANALOG INPUT MODULE
(AB 1746-NIB)

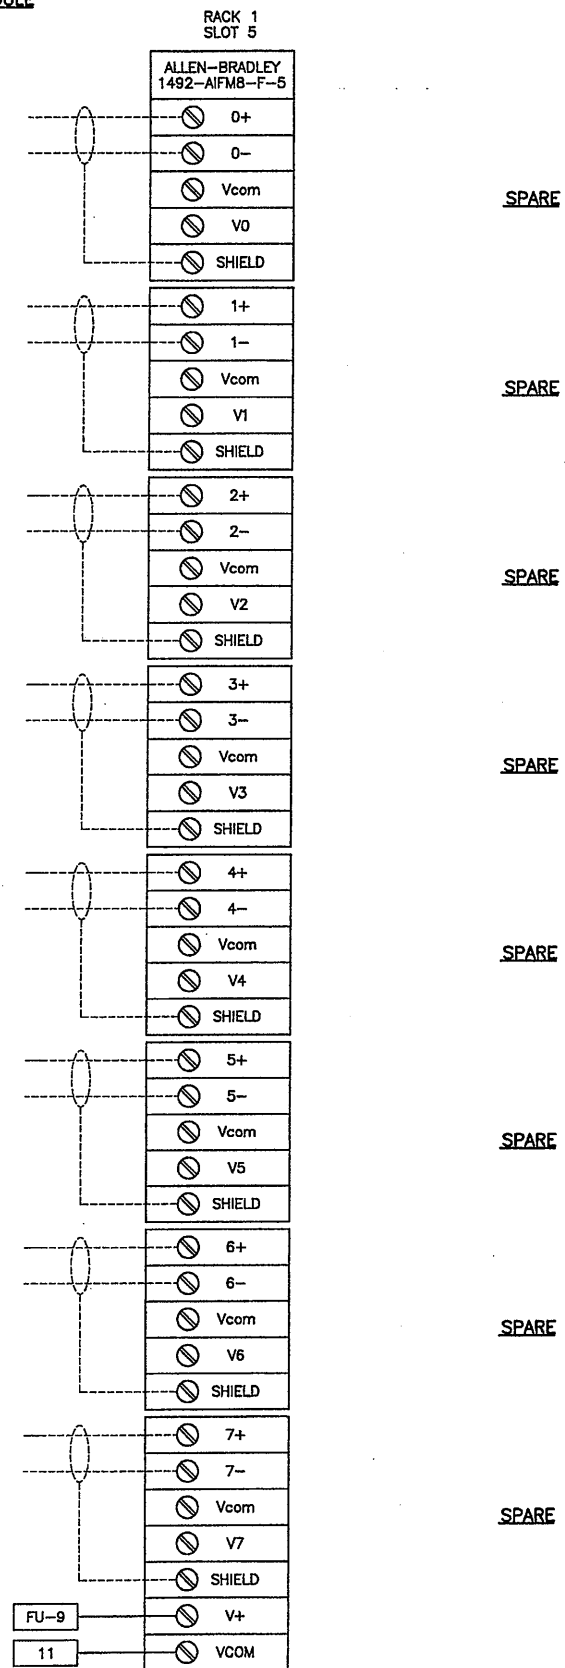

Layer: ON=*; OFF=*REF*
01/17/01 OBG JEC
EEA-VERT

RECORD DRAWING

THESE DRAWINGS HAVE BEEN REVIEWED TO REFLECT
MAJOR CHANGES, IF ANY, WHICH OCCURRED DURING
CONSTRUCTION. REVISIONS ARE BASED UPON
INFORMATION SUPPLIED BY CONTRACTOR.
DATE: 10/26/01 FOR: Stampolet

THIS DRAWING WAS PREPARED AT THE SCALE INDICATED IN THE
TITLE BLOCK. INACCURACIES IN THE STATED SCALE MAY BE
INTRODUCED WHEN DRAWINGS ARE REPRODUCED BY ANY MEANS.
USE THE GRAPHIC SCALE BAR IN THE TITLE BLOCK TO
DETERMINE THE ACTUAL SCALE OF THIS DRAWING.

NO ALTERATIONS PERMITTED HEREON EXCEPT
AS PROVIDED UNDER SECTION 7209 SUBDIVISION
2 OF THE NEW YORK STATE EDUCATION LAW

| No. | Date | Revisions | Init |
|-----|----------|---------------------|------|
| 0 | 4/20/01 | ISSUED FOR APPROVAL | PLD |
| 1 | 7/11/01 | AS BID | |
| 2 | 10/31/01 | RECORD DRAWING | |

In charge of -- PLD
Designed by -- SAT
Drawn by -- JEC
Checked by -- PLD

ENVIRONMENTAL ENGINEERING ASSOCIATES, LLP
SYRACUSE, NEW YORK

ONONDAGA COUNTY • DEPARTMENT OF DRAINAGE AND SANITATION • SYRACUSE, NEW YORK
METROPOLITAN SYRACUSE WASTEWATER TREATMENT PLANT
STAGE III AMMONIA AND STAGE II PHOSPHORUS REMOVAL PROJECT
SECONDARY EFFLUENT PUMPING STATION (PLC M13)
ANALOG INPUT MODULES

INSTRUMENTATION





File Number
00659
Date
APRIL 2001
Stampolet

I-109

4 POINT ANALOG OUTPUT MODULE
(AB 1746-NO4)

4 POINT ANALOG OUTPUT MODULE
(AB 1746-NO4)

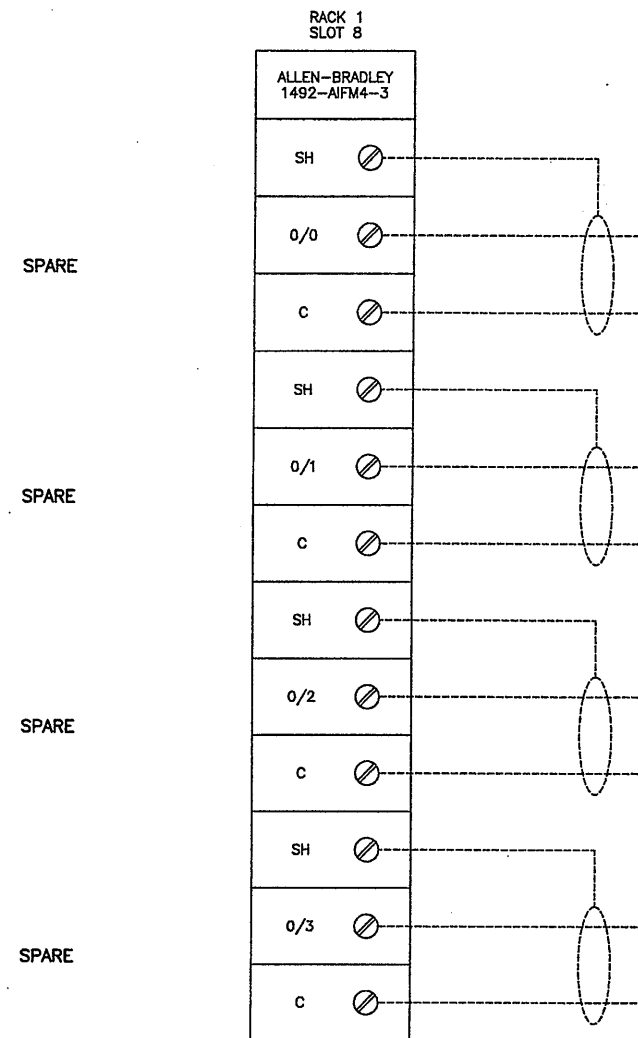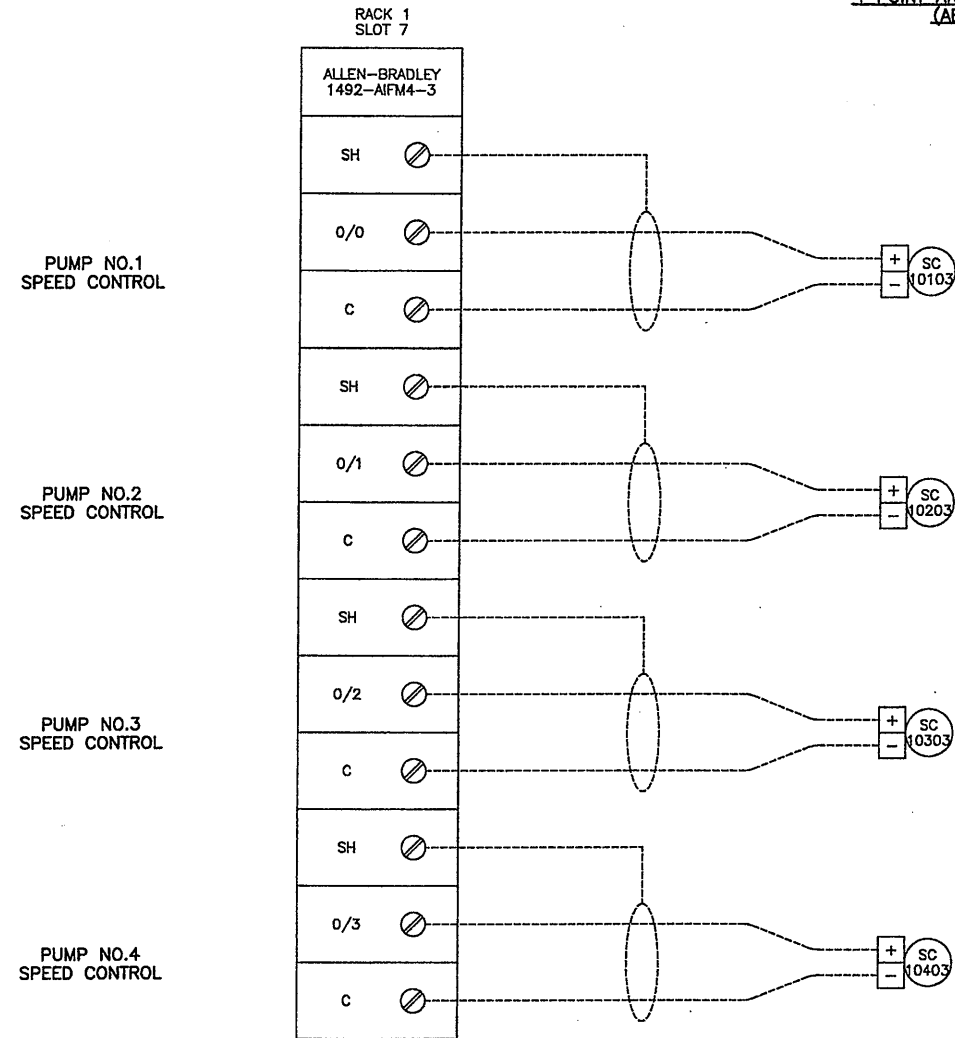

Layer: ON=*; OFF=*REF*
01/12/01 OBG JEC
EEA-VERT

RECORD DRAWING

THESE DRAWINGS HAVE BEEN REVISIONED TO REFLECT
MAJOR CHANGES, IF ANY, WHICH OCCURRED DURING
CONSTRUCTION. REVISIONS ARE BASED UPON
NOTIFICATION SUPPLIED BY CONTRACTOR.
DATE: 10/21/01 PER: PLD

THIS DRAWING WAS PREPARED AT THE SCALE INDICATED IN THE
TITLE BLOCK. INACCURACIES IN THE STATED SCALE MAY BE
INTRODUCED WHEN DRAWINGS ARE REPRODUCED BY ANY MEANS.
USE THE GRAPHIC SCALE BAR IN THE TITLE BLOCK TO
DETERMINE THE ACTUAL SCALE OF THIS DRAWING.


NO ALTERATIONS PERMITTED HEREON EXCEPT
AS PROVIDED UNDER SECTION 7209 SUBDIVISION
2 OF THE NEW YORK STATE EDUCATION LAW

| No. | Date | Revisions | Init |
|-----|----------|---------------------|------|
| 0 | 4/20/01 | ISSUED FOR APPROVAL | PLD |
| 1 | 7/11/01 | AS BID | |
| 2 | 10/31/05 | RECORD DRAWING | |

In charge of PLD
Designed by SAT
Drawn by JEC
Checked by PLD


ENVIRONMENTAL ENGINEERING ASSOCIATES, LLP
SYRACUSE, NEW YORK

ONONDAGA COUNTY • DEPARTMENT OF DRAINAGE AND SANITATION • SYRACUSE, NEW YORK
METROPOLITAN SYRACUSE WASTEWATER TREATMENT PLANT
STAGE III AMMONIA AND STAGE II PHOSPHORUS REMOVAL PROJECT
SECONDARY EFFLUENT PUMPING STATION (PLC M13)
ANALOG OUTPUT MODULES
INSTRUMENTATION

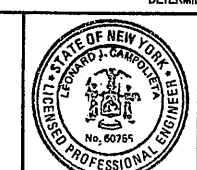

File Number
00659
Date
APRIL 2001
PER: PLD

I-110

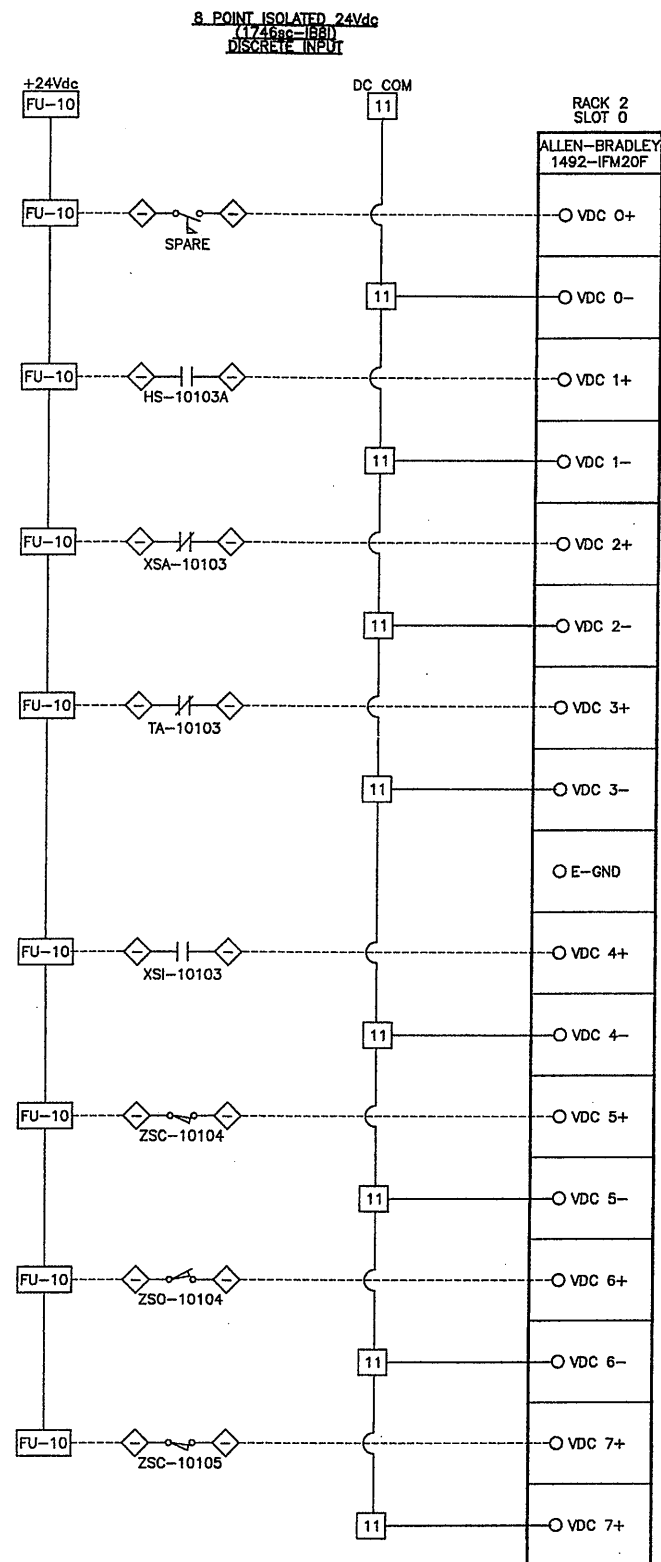

SPARE

PUMP NO.1
REMOTE CONTROL

PUMP NO.1
VFD FAULT STATUS


PUMP NO.1
VFD TEMPERATURE ALARM

PUMP NO.1
VFD RUN

PUMP NO.1 AUTOMATIC
DISCHARGE VALVE FULLY CLOSED

PUMP NO.1 AUTOMATIC
DISCHARGE VALVE FULLY OPENED

PUMP NO.1 HAND
DISCHARGE VALVE FULLY CLOSED

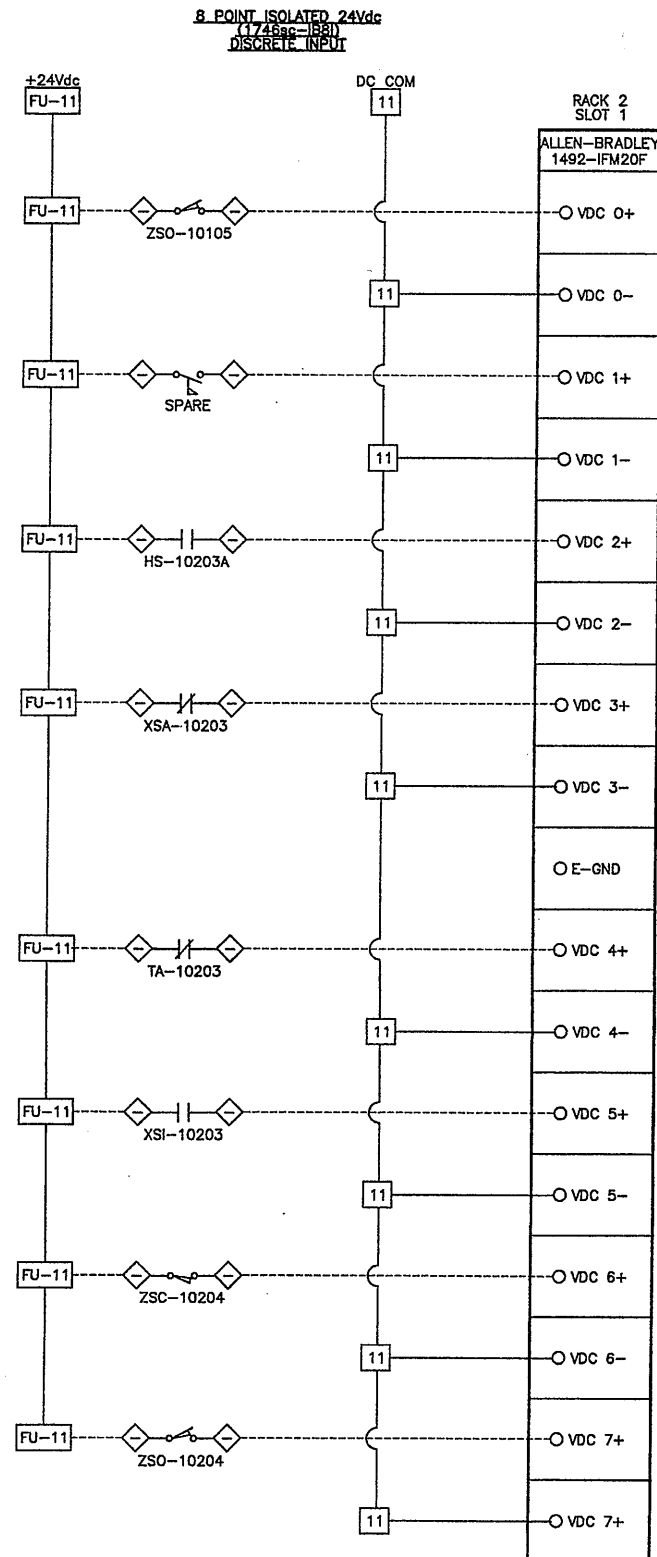

PUMP NO.1 HAND
DISCHARGE VALVE FULLY OPENED

SPARE

PUMP NO.2
REMOTE CONTROL

PUMP NO.2
VFD FAULT STATUS

PUMP NO.2
VFD TEMPERATURE ALARM

PUMP NO.2
VFD RUN

PUMP NO.2 AUTOMATIC
DISCHARGE VALVE FULLY CLOSED

PUMP NO.2 AUTOMATIC
DISCHARGE VALVE FULLY OPENED

Layer: ON=*, OFF=**REF*
01/12/01 OBG JEC
EAA-VERT

| No. | Date | Revisions | Init |
|-----|----------|---------------------|------|
| 0 | 4/20/01 | ISSUED FOR APPROVAL | JK |
| 1 | 7/11/01 | AS BID | |
| 2 | 10/31/05 | RECORD DRAWING | |

In charge of PLD
Designed by SAT
Drawn by JEC
Checked by PLD

ENVIRONMENTAL ENGINEERING ASSOCIATES, LLP
SYRACUSE, NEW YORK

ONONDAGA COUNTY • DEPARTMENT OF DRAINAGE AND SANITATION • SYRACUSE, NEW YORK
METROPOLITAN SYRACUSE WASTEWATER TREATMENT PLANT
STAGE III AMMONIA AND STAGE II PHOSPHORUS REMOVAL PROJECT
SECONDARY EFFLUENT PUMPING STATION (PLC M13)
DIGITAL INPUT MODULES



File Number
00659
Date
APRIL 2001
Campollet


I-111

NO ALTERATIONS PERMITTED HEREON EXCEPT AS PROVIDED UNDER SECTION 7209 SUBDIVISION 2 OF THE NEW YORK STATE EDUCATION LAW

INSTRUMENTATION

RECORD DRAWING
THESE DRAWINGS HAVE BEEN REVIEWED TO REFLECT MAKE CHANGES, IF ANY, WHICH OCCURRED DURING CONSTRUCTION. REVISIONS ARE BASED UPON INFORMATION SUPPLIED BY CONTRACTOR.
DATE: 10/21/05 PUN: *Campollet*

THIS DRAWING WAS PREPARED AT THE SCALE INDICATED IN THE TITLE BLOCK. INACCURACIES IN THE STATED SCALE MAY BE INTRODUCED WHEN DRAWINGS ARE REPRODUCED BY ANY MEANS. USE THE GRAPHIC SCALE BAR IN THE TITLE BLOCK TO DETERMINE THE ACTUAL SCALE OF THIS DRAWING.

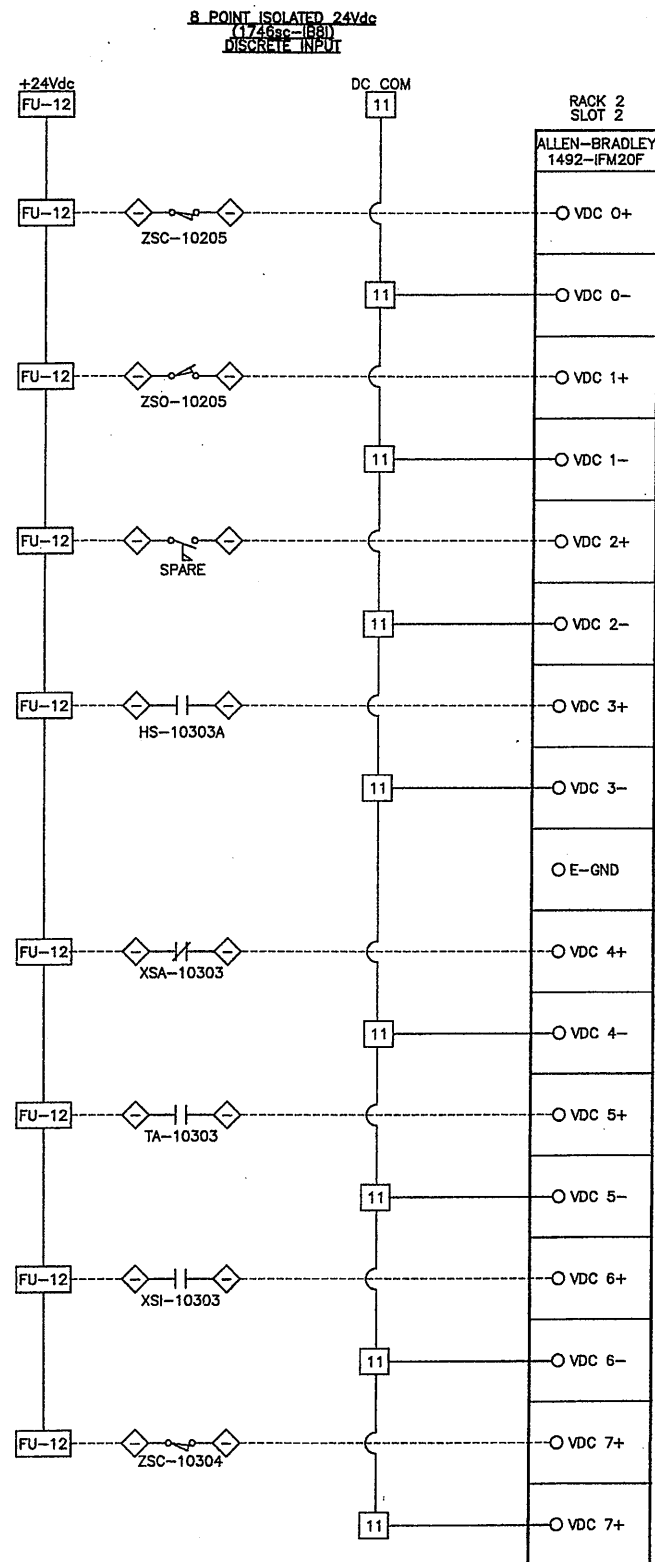

PUMP NO.2 HAND
DISCHARGE VALVE FULLY CLOSED

PUMP NO.2 HAND
DISCHARGE VALVE FULLY OPENED

SPARE


PUMP NO.3
REMOTE CONTROL

PUMP NO.3
VFD FAULT STATUS

PUMP NO.3
VFD TEMPERATURE ALARM

PUMP NO.3
VFD RUN

PUMP NO.3 AUTOMATIC
DISCHARGE VALVE FULLY CLOSED

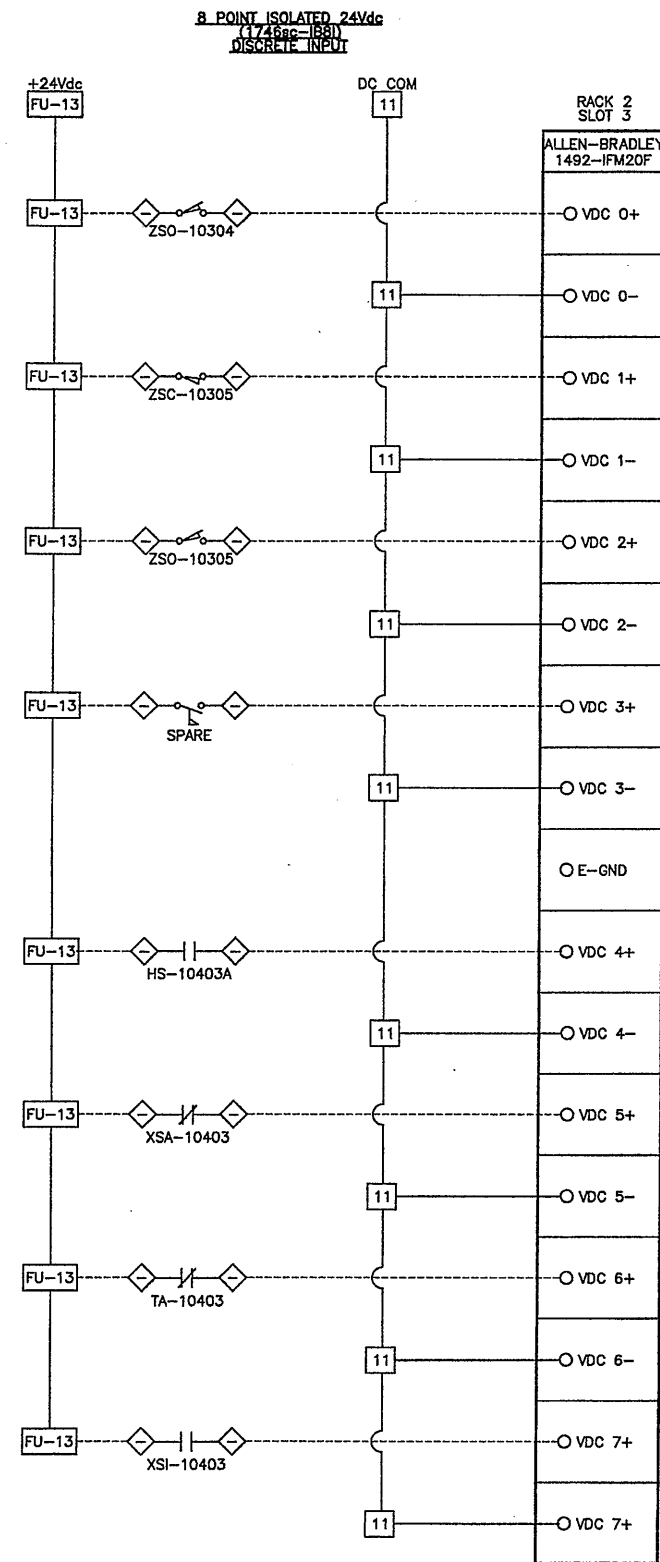

PUMP NO.3 AUTOMATIC
DISCHARGE VALVE FULLY OPENED

PUMP NO.3 HAND
DISCHARGE VALVE FULLY CLOSED

PUMP NO.3 HAND
DISCHARGE VALVE FULLY OPENED

SPARE

PUMP NO.4
REMOTE CONTROL

PUMP NO.4
VFD FAULT STATUS

PUMP NO.4
VFD TEMPERATURE ALARM

PUMP NO.4
VFD RUN


Layer: ON=*, OFF=*REF*
01/12/01 OBG JEC
EEA-VERT

| No. | Date | Revisions | Init |
|-----|----------|---------------------|------|
| 0 | 4/20/01 | ISSUED FOR APPROVAL | JEC |
| 1 | 7/11/01 | AS BID | |
| 2 | 10/31/03 | RECORD DRAWING | |

In charge of PLD
Designed by SAT
Drawn by JEC
Checked by PLD



ONONDAGA COUNTY • DEPARTMENT OF DRAINAGE AND SANITATION • SYRACUSE, NEW YORK
METROPOLITAN SYRACUSE WASTEWATER TREATMENT PLANT
STAGE III AMMONIA AND STAGE II PHOSPHORUS REMOVAL PROJECT
SECONDARY EFFLUENT PUMPING STATION (PLC M13)
DIGITAL INPUT MODULES

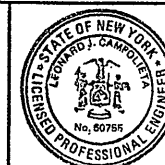

File Number
00659
Date
APRIL 2001


I-112

RECORD DRAWING
THESE DRAWINGS HAVE BEEN REVISIONED TO REFLECT
MAJOR CHANGES, IF ANY, WHICH OCCURRED DURING
CONSTRUCTION. REVISIONS ARE BASED UPON
INFORMATION SUPPLIED BY CONTRACTOR.
DATE: 10/21/05 PER: [Signature]

THIS DRAWING WAS PREPARED AT THE SCALE INDICATED IN THE
TITLE BLOCK. INACCURACIES IN THE STATED SCALE MAY BE
INTRODUCED WHEN DRAWINGS ARE REPRODUCED BY ANY MEANS.
USE THE GRAPHIC SCALE BAR IN THE TITLE BLOCK TO
DETERMINE THE ACTUAL SCALE OF THIS DRAWING.

INSTRUMENTATION

8 POINT ISOLATED 24Vdc
(1746ac-1881)
DISCRETE INPUT

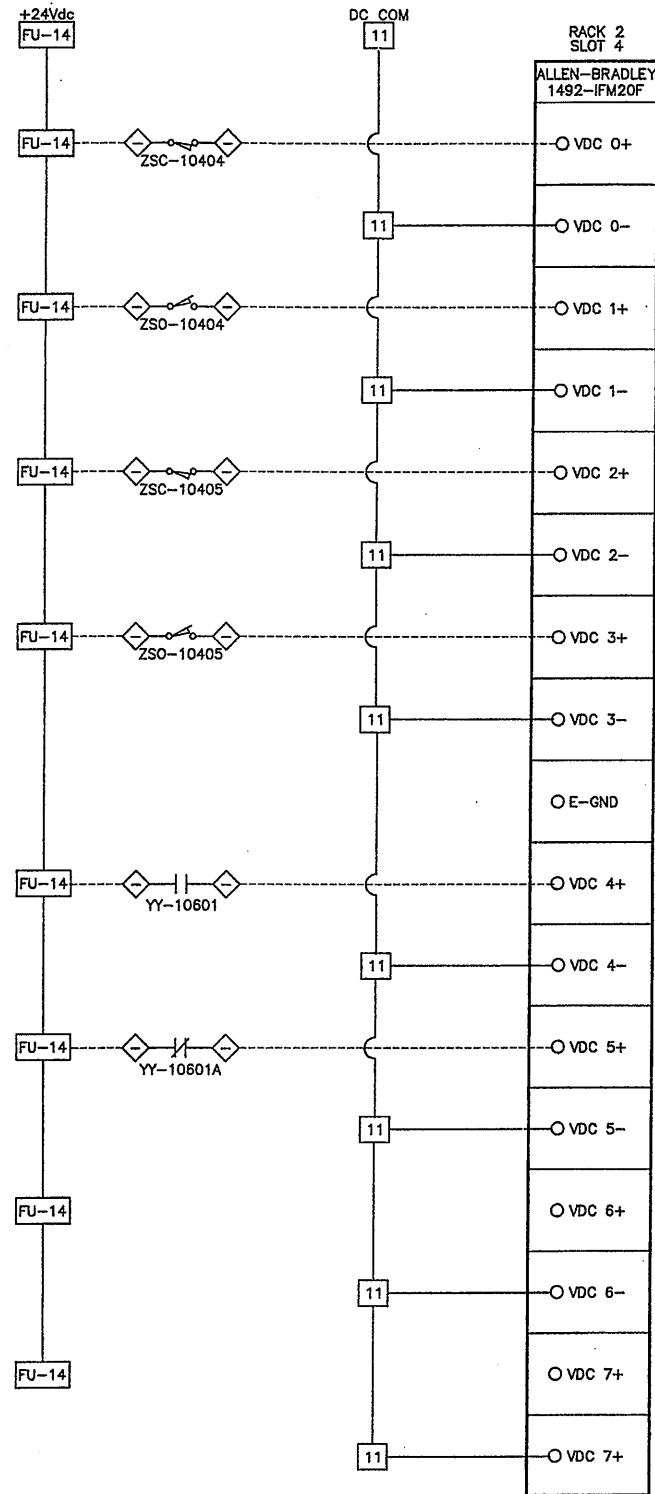

PUMP NO.4 AUTOMATIC
DISCHARGE VALVE FULLY CLOSED

PUMP NO.4 AUTOMATIC
DISCHARGE VALVE FULLY OPENED

PUMP NO.4 HAND
DISCHARGE VALVE FULLY CLOSED

PUMP NO.4 HAND
DISCHARGE VALVE FULLY OPENED


TRANSFER SWITCH 100
NORMAL
POWER

TRANSFER SWITCH 100
STANDBY
EMERGENCY POWER

SPARE

SPARE

8 POINT ISOLATED 24Vdc
(1746ac-1881)
DISCRETE INPUT

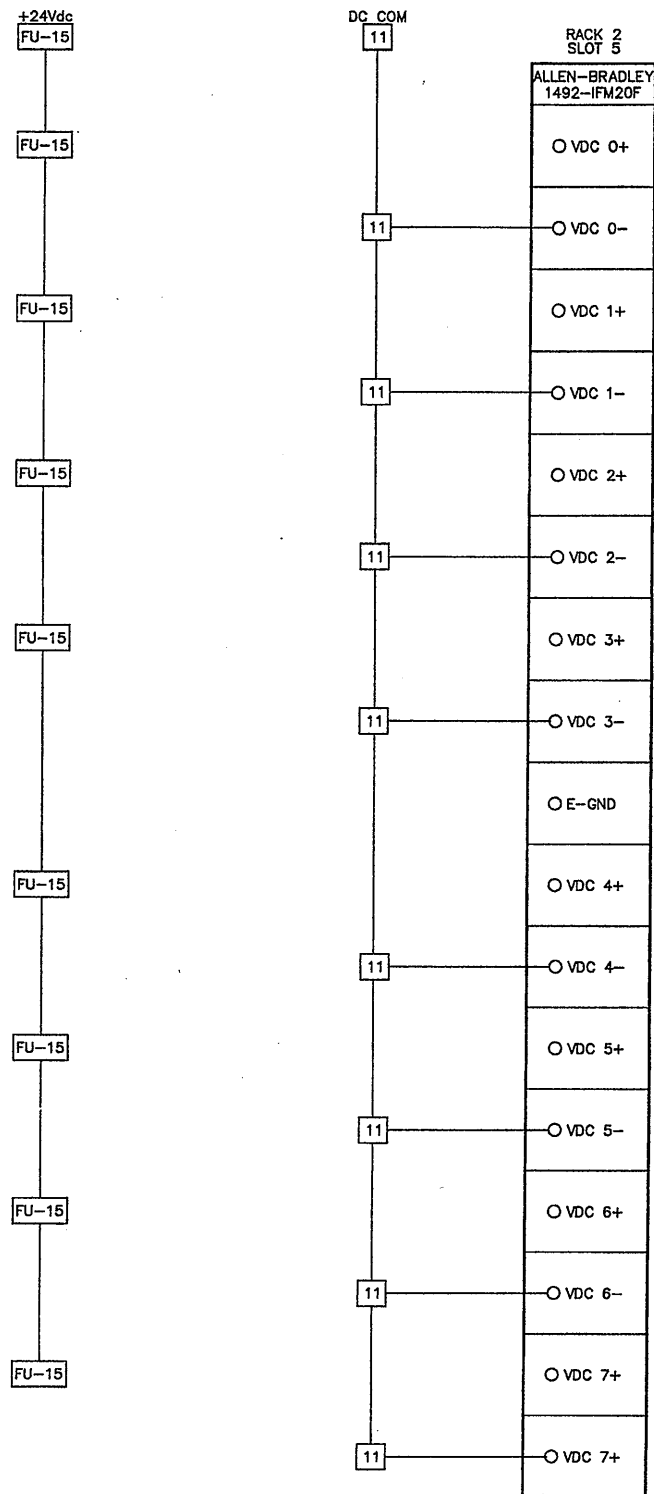

SPARE

SPARE

Layer: ON=*, OFF=*REF*
01/12/01 DBG JEC
EEA-VERT

| No. | Date | Revisions | Init |
|-----|----------|---------------------|------|
| 0 | 4/20/01 | ISSUED FOR APPROVAL | PLD |
| 1 | 7/11/01 | AS BID | SAT |
| 2 | 10/31/05 | RECORD DRAWING | JEC |

In charge of --- PLD
Designed by --- SAT
Drawn by --- JEC
Checked by --- PLD



ONONDAGA COUNTY • DEPARTMENT OF DRAINAGE AND SANITATION • SYRACUSE, NEW YORK
METROPOLITAN SYRACUSE WASTEWATER TREATMENT PLANT
STAGE III AMMONIA AND STAGE II PHOSPHORUS REMOVAL PROJECT
SECONDARY EFFLUENT PUMPING STATION (PLC M13)
DIGITAL INPUT MODULES




File Number
00659
Date
APRIL 2001
Stamp

RECORD DRAWING

THESE CHANGES HAVE BEEN MADE TO REFLECT
MAJOR CHANGES, IF ANY, WHICH OCCURRED DURING
CONSTRUCTION. REVISIONS ARE BASED UPON
INFORMATION SUPPLIED BY CONTRACTOR.
DATE: 10/24/05 FOR: Stamp

THIS DRAWING WAS PREPARED AT THE SCALE INDICATED IN THE
TITLE BLOCK. INACCURACIES IN THE STATED SCALE MAY BE
INTRODUCED WHEN DRAWINGS ARE REPRODUCED BY ANY MEANS.
USE THE GRAPHIC SCALE BAR IN THE TITLE BLOCK TO
DETERMINE THE ACTUAL SCALE OF THIS DRAWING.

8 POINT ISOLATED 24Vdc
(1748c-188)
DISCRETE INPUT

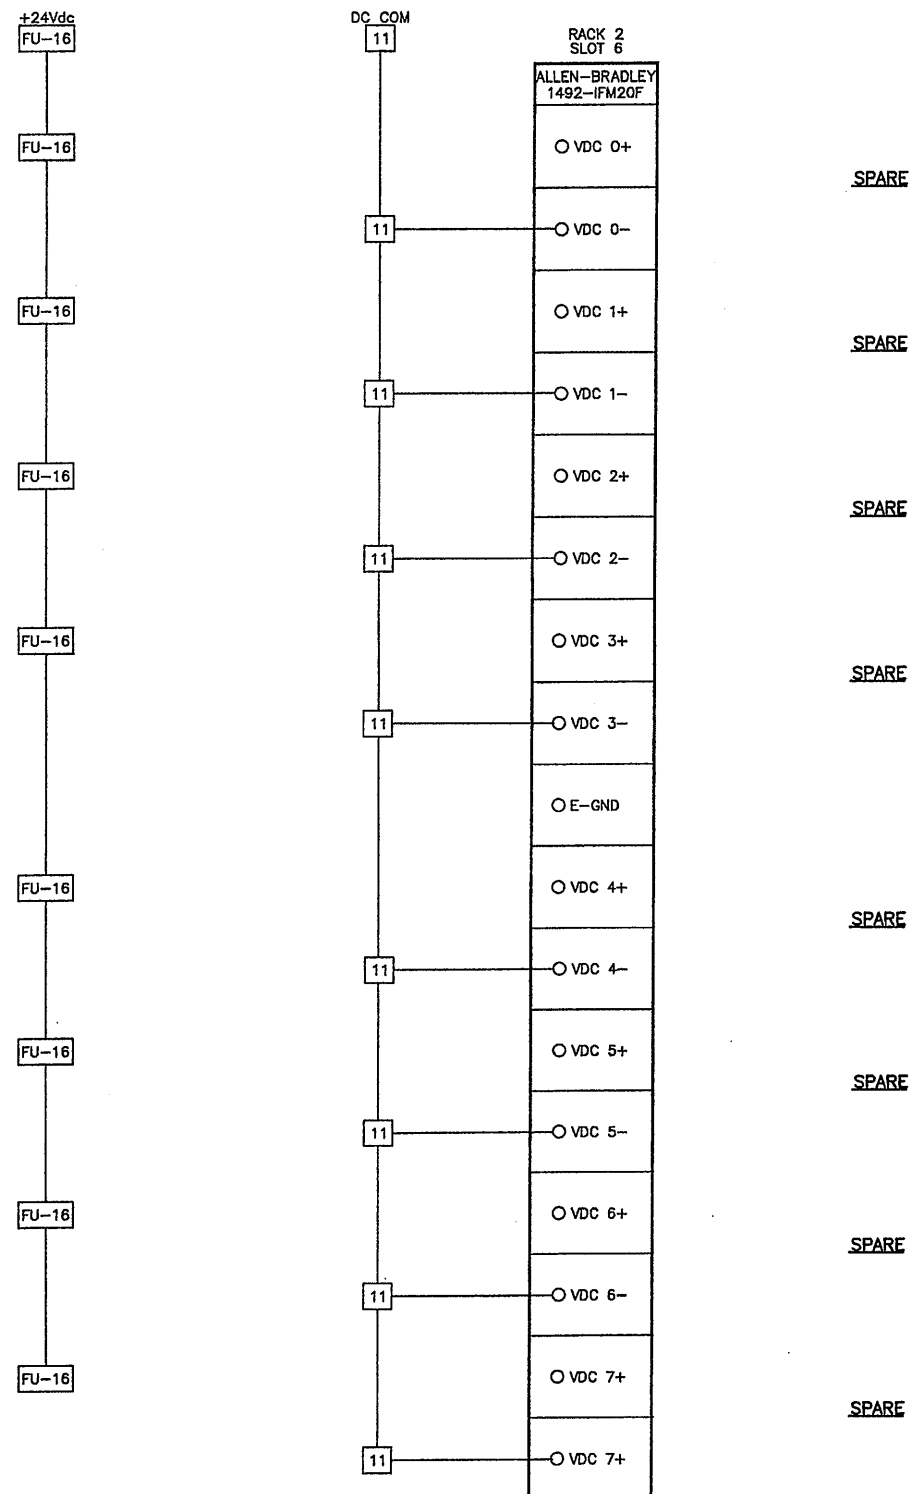

Layer: ON=*; OFF=*REF*
01/12/01 OBG JEC
EEA-VERT

RECORD DRAWING
THESE CHANGES HAVE BEEN MADE TO REFLECT
MAJOR CHANGES, IF ANY, WHICH OCCURRED DURING
CONSTRUCTION. REVISIONS ARE BASED UPON
INFORMATION SUPPLIED BY CONTRACTOR.
DATE: 10/21/03 FOR: L. Lampoliet

THIS DRAWING WAS PREPARED AT THE SCALE INDICATED IN THE
TITLE BLOCK. INACCURACIES IN THE STATED SCALE MAY BE
INTRODUCED WHEN DRAWINGS ARE REPRODUCED BY ANY MEANS.
USE THE GRAPHIC SCALE BAR IN THE TITLE BLOCK TO
DETERMINE THE ACTUAL SCALE OF THIS DRAWING.

| No. | Date | Revisions | Init |
|-----|----------|---------------------|------|
| 0 | 4/20/01 | ISSUED FOR APPROVAL | JEC |
| 1 | 7/11/01 | AS BID | |
| 2 | 10/31/03 | RECORD DRAWING | |



In charge of ___ PLD ___
Designed by ___ SAT ___
Drawn by ___ JEC ___
Checked by ___ PLD ___



ONONDAGA COUNTY • DEPARTMENT OF DRAINAGE AND SANITATION • SYRACUSE, NEW YORK
METROPOLITAN SYRACUSE WASTEWATER TREATMENT PLANT
STAGE III AMMONIA AND STAGE II PHOSPHORUS REMOVAL PROJECT
SECONDARY EFFLUENT PUMPING STATION (PLC M13)
DIGITAL INPUT MODULES
INSTRUMENTATION



File Number
00659
Date
APRIL 2001
1-114
L. Lampoliet

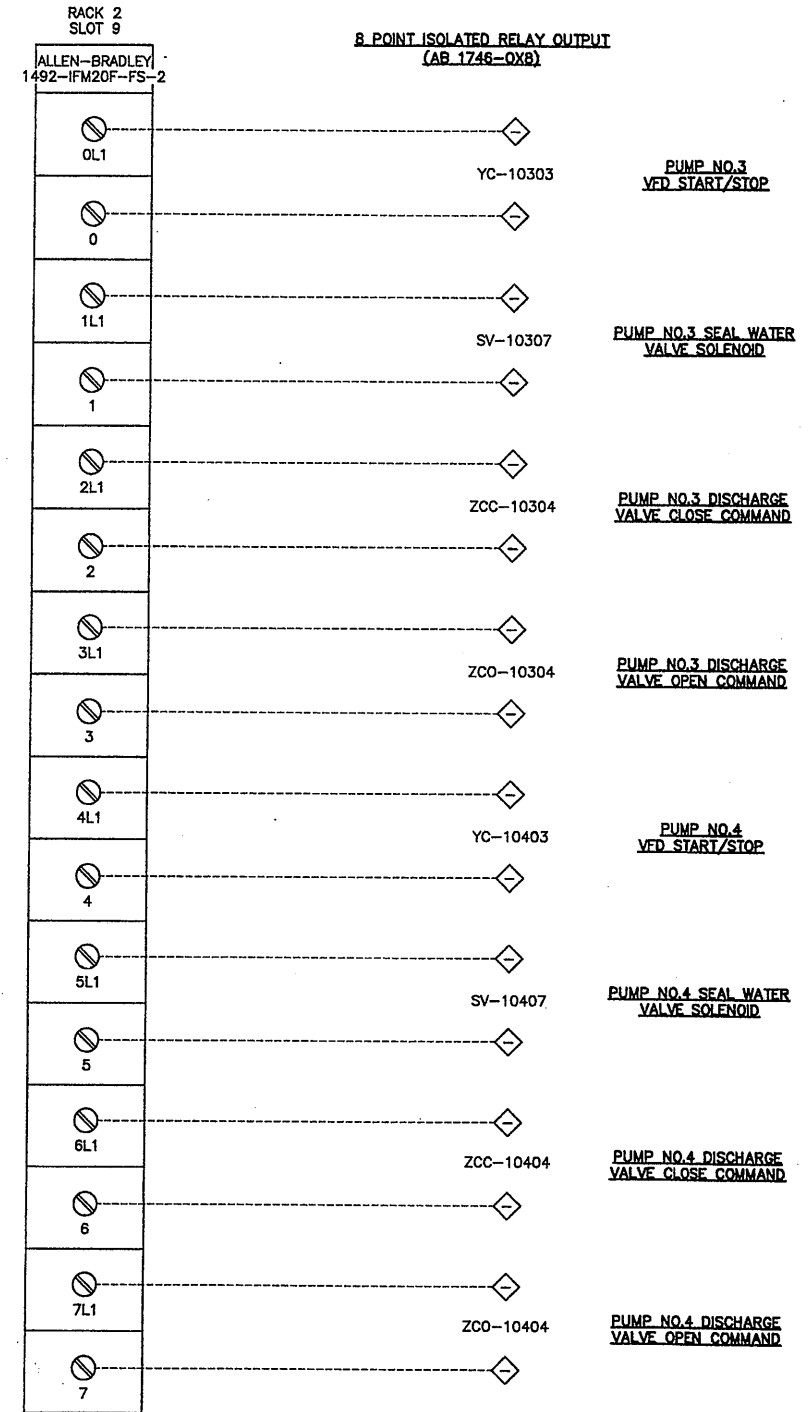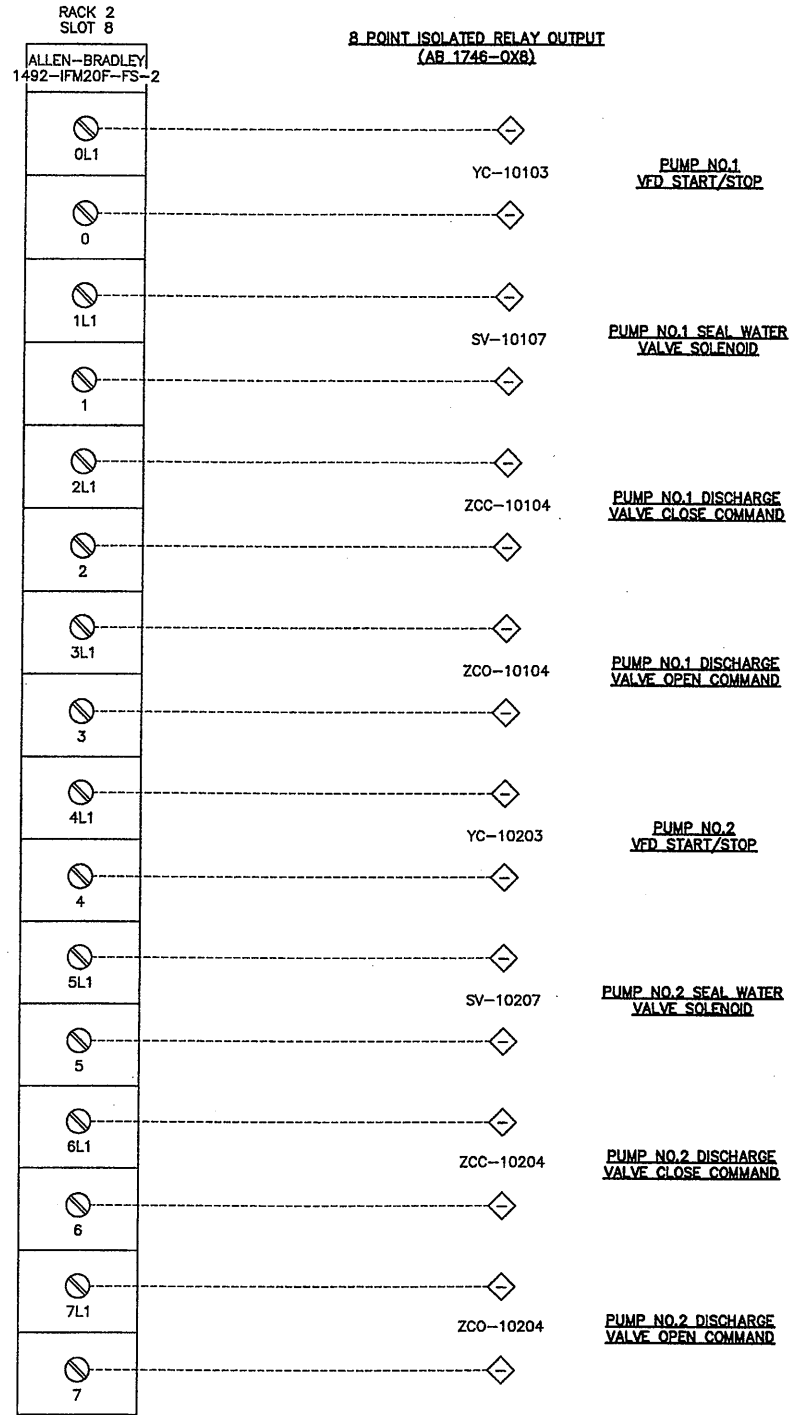

Layer: ON=*; OFF=*REF*
11/27/00 OBG JEC
EEA-VERT

RECORD DRAWING
THESE DRAWINGS HAVE BEEN REVISIONED TO REFLECT
MAJOR CHANGES, IF ANY, WHICH OCCURRED DURING
CONSTRUCTION. REVISIONS ARE BASED UPON
INFORMATION SUPPLIED BY CONTRACTOR.
DATE: 10/21/05 FOR: Karpollet

THIS DRAWING WAS PREPARED AT THE SCALE INDICATED IN THE
TITLE BLOCK. INACCURACIES IN THE STATED SCALE MAY BE
INTRODUCED WHEN DRAWINGS ARE REPRODUCED BY ANY MEANS.
USE THE GRAPHIC SCALE BAR IN THE TITLE BLOCK TO
DETERMINE THE ACTUAL SCALE OF THIS DRAWING.

| No. | Date | Revisions | Init |
|-----|----------|---------------------|------|
| 0 | 4/20/01 | ISSUED FOR APPROVAL | PLD |
| 1 | 7/11/01 | AS BID | |
| 2 | 10/31/03 | RECORD DRAWING | |

NO ALTERATIONS PERMITTED HEREON EXCEPT
AS PROVIDED UNDER SECTION 7209 SUBDIVISION
2 OF THE NEW YORK STATE EDUCATION LAW

In charge of --- PLD
Designed by --- SAT
Drawn by --- JEC
Checked by --- PLD

ENVIRONMENTAL ENGINEERING ASSOCIATES, LLP
SYRACUSE, NEW YORK

ONONDAGA COUNTY • DEPARTMENT OF DRAINAGE AND SANITATION • SYRACUSE, NEW YORK
METROPOLITAN SYRACUSE WASTEWATER TREATMENT PLANT
STAGE III AMMONIA AND STAGE II PHOSPHORUS REMOVAL PROJECT
SECONDARY EFFLUENT PUMPING STATION (PLC M13)
DIGITAL OUTPUT MODULES


INSTRUMENTATION



File Number
00659
Date
APRIL 2001
I-115
Karpollet

RACK 2
SLOT 10
ALLEN-BRADLEY
1492-IFM20F-FS-2

8 POINT ISOLATED RELAY OUTPUT
(AB 1746-OX8)

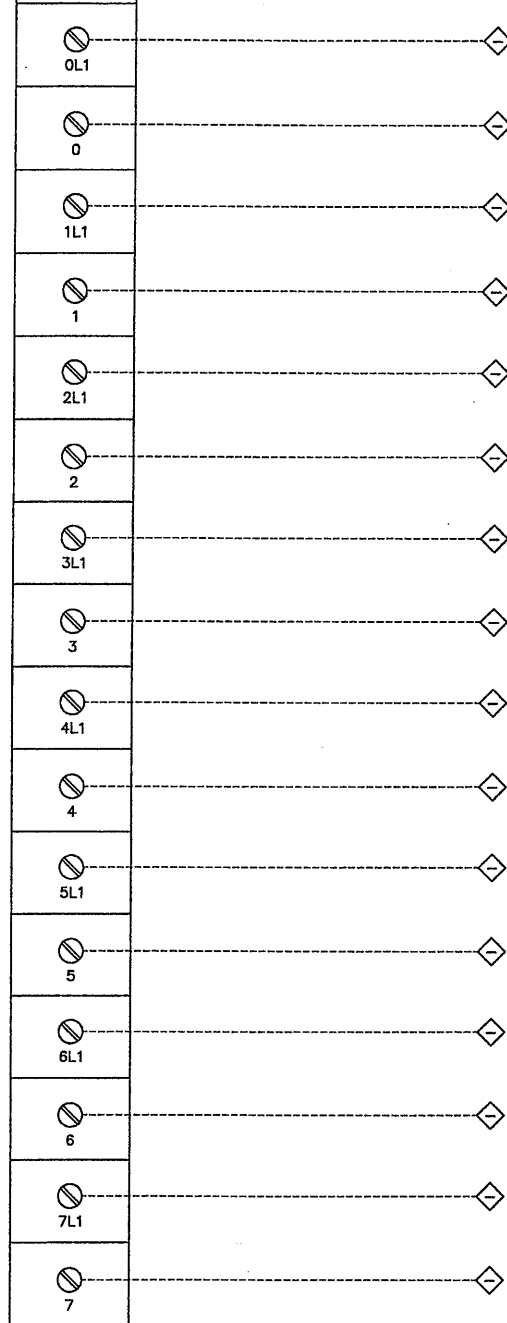

SPARE

SPARE

RACK 2
SLOT 11
ALLEN-BRADLEY
1492-IFM20F-FS-2

8 POINT ISOLATED RELAY OUTPUT
(AB 1746-OX8)

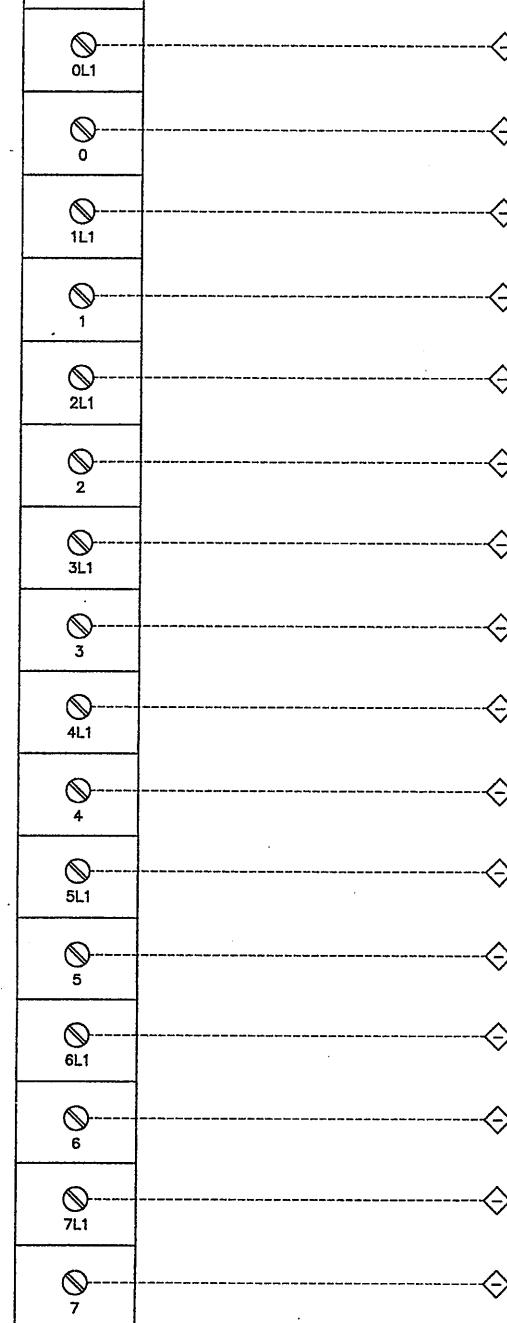

SPARE

SPARE

Layer: ON=*; OFF=*REF*

11/27/00 OBG JEC
EEA-VERT

| No. | Date | Revisions | Init |
|-----|----------|---------------------|------|
| 0 | 4/20/01 | ISSUED FOR APPROVAL | JEC |
| 1 | 7/11/01 | AS BID | |
| 2 | 10/31/05 | RECORD DRAWING | |

In charge of --- PLD
Designed by --- SAT
Drawn by --- JEC
Checked by --- PLD



ONONDAGA COUNTY • DEPARTMENT OF DRAINAGE AND SANITATION • SYRACUSE, NEW YORK
METROPOLITAN SYRACUSE WASTEWATER TREATMENT PLANT
STAGE III AMMONIA AND STAGE II PHOSPHORUS REMOVAL PROJECT



SECONDARY EFFLUENT PUMPING STATION (PLC M13)
DIGITAL OUTPUT MODULE
INSTRUMENTATION



RECORD DRAWING
THIS DRAWING HAS BEEN REVISIONED TO REFLECT
MAJOR CHANGES, IF ANY, WHICH OCCURRED DURING
CONSTRUCTION. REVISIONS ARE BASED UPON
INFORMATION SUPPLIED BY CONTRACTOR.
DATE 10/21/05 FOR Campalot

THIS DRAWING WAS PREPARED AT THE SCALE INDICATED IN THE
TITLE BLOCK. INACCURACIES IN THE STATED SCALE MAY BE
INTRODUCED WHEN DRAWINGS ARE REPRODUCED BY ANY MEANS.
USE THE GRAPHIC SCALE BAR IN THE TITLE BLOCK TO
DETERMINE THE ACTUAL SCALE OF THIS DRAWING.

File Number
00659
Date
APRIL 2001
I-116
Campalot

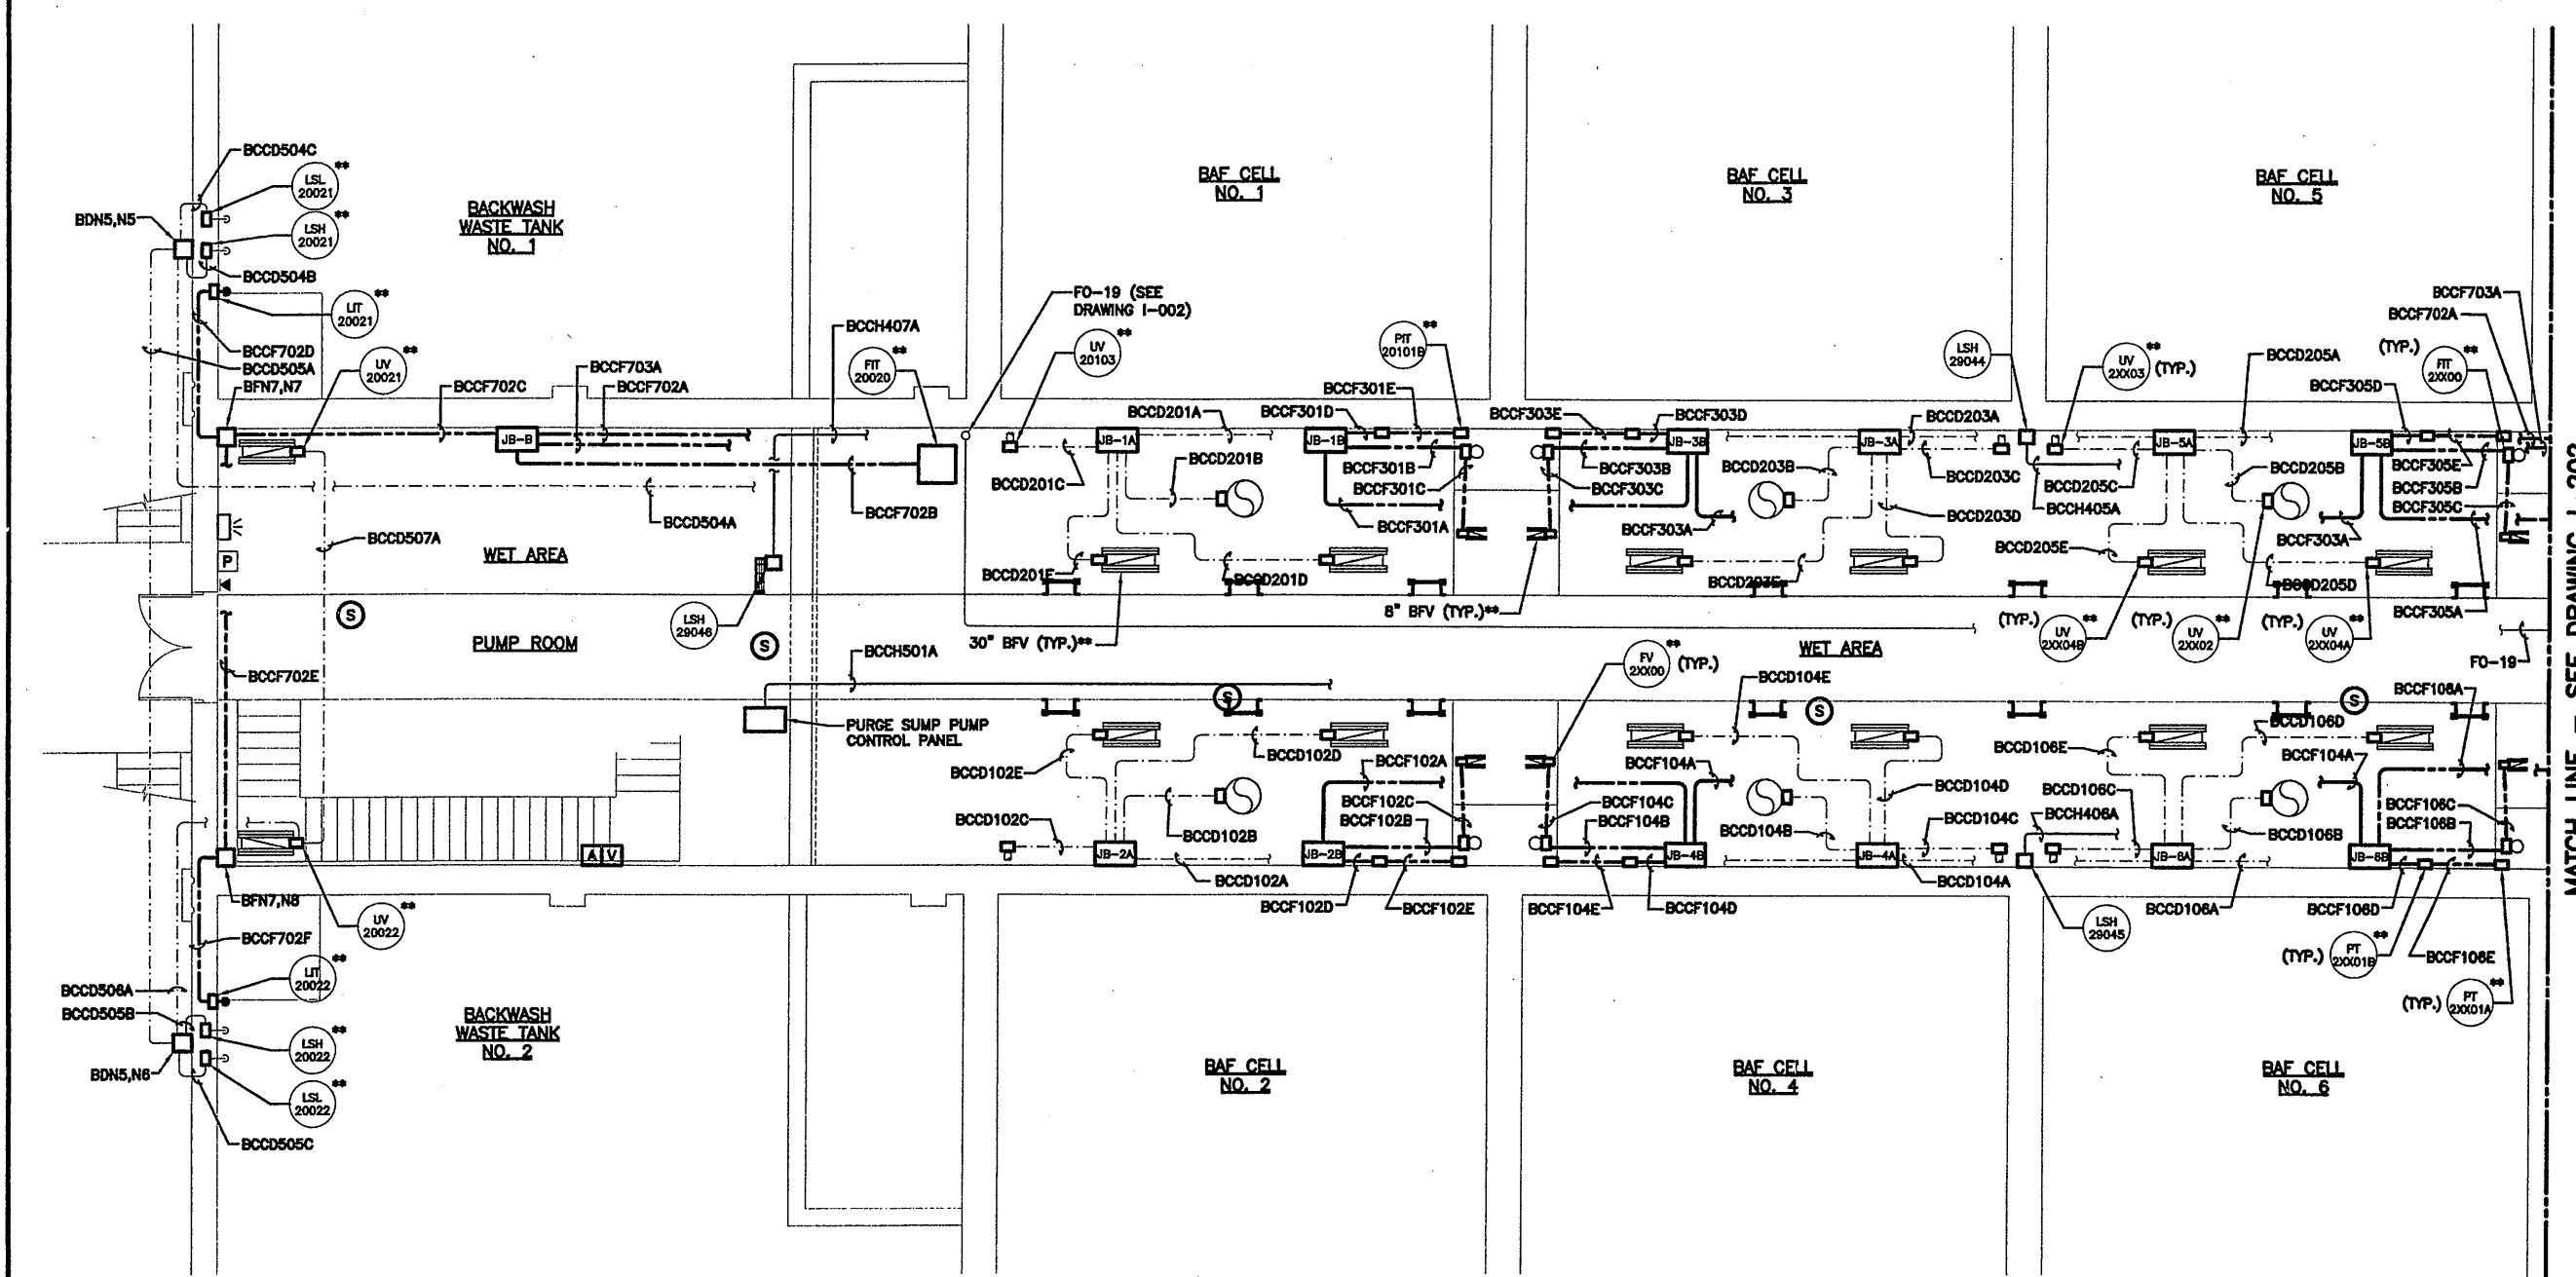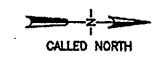

MATCH LINE - SEE DRAWING I-202

BAF LOWER LEVEL PARTIAL PLAN SOUTH
SCALE: 3/16"=1'-0"

- NOTES:**
1. THE XX IN EACH TAG NUMBER REPRESENTS THE ASSOCIATED CELL NUMBER.
 2. PT-2XX01A AND PT-2XX01B ARE VERTICALLY ALIGNED AT EL. 379.20 AND EL. 371.75 RESPECTIVELY; HORIZONTAL VIEW IS FOR CLARITY ONLY.
 3. ** INDICATES AN ITEM OR ITEMS SUPPLIED BY OWNER FOR INSTALLATION BY THE CONTRACTOR.
 4. FOR CONDUIT SCHEDULES SEE DRAWINGS I-510, I-511, I-512 & I-513.

RECORD DRAWING

THESE CHANGES HAVE BEEN DRAWN TO REFLECT MAJOR CHANGES IF ANY, WHICH OCCURRED DURING CONSTRUCTION. REVISIONS ARE BASED UPON INFORMATION SUPPLIED BY CONTRACTOR.

DATE: 10/26/05 PER: Rampolot

THIS DRAWING WAS PREPARED AT THE SCALE INDICATED IN THE TITLE BLOCK. INACCURACIES IN THE STATED SCALE MAY BE INTRODUCED WHEN DRAWINGS ARE REPRODUCED BY ANY MEANS. USE THE GRAPHIC SCALE BAR IN THE TITLE BLOCK TO DETERMINE THE ACTUAL SCALE OF THIS DRAWING.

Layer: ON=*, OFF=*REF*
X: 0659X201_212.DWG
4/23/01 BBL DCC
05503000/06591201.DWG

3/16"=1'-0"
NO ALTERATIONS PERMITTED HEREON EXCEPT AS PROVIDED UNDER SECTION 7209 SUBDIVISION 2 OF THE NEW YORK STATE EDUCATION LAW



| No. | Date | Revisions | Init |
|-----|----------|---------------------|------|
| 0 | 4/20/01 | ISSUED FOR APPROVAL | TEL |
| 1 | 7/11/01 | AS BID | |
| 2 | 10/31/05 | RECORD DRAWING | |

In charge of TEL
Designed by AHL
Drawn by DCC
Checked by FKP

ENVIRONMENTAL ENGINEERING ASSOCIATES, LLP
 SYRACUSE, NEW YORK

ONONDAGA COUNTY • DEPARTMENT OF DRAINAGE AND SANITATION • SYRACUSE, NEW YORK
 METROPOLITAN SYRACUSE WASTEWATER TREATMENT PLANT
 STAGE III AMMONIA AND STAGE II PHOSPHORUS REMOVAL PROJECT
BAF COMPLEX
BAF LOWER LEVEL PARTIAL PLAN SOUTH
 INSTRUMENTATION

| | | |
|----------------------|--------------------|-------|
| File Number 00659 | Date APRIL 2001 | I-201 |
| Rampolot | | |

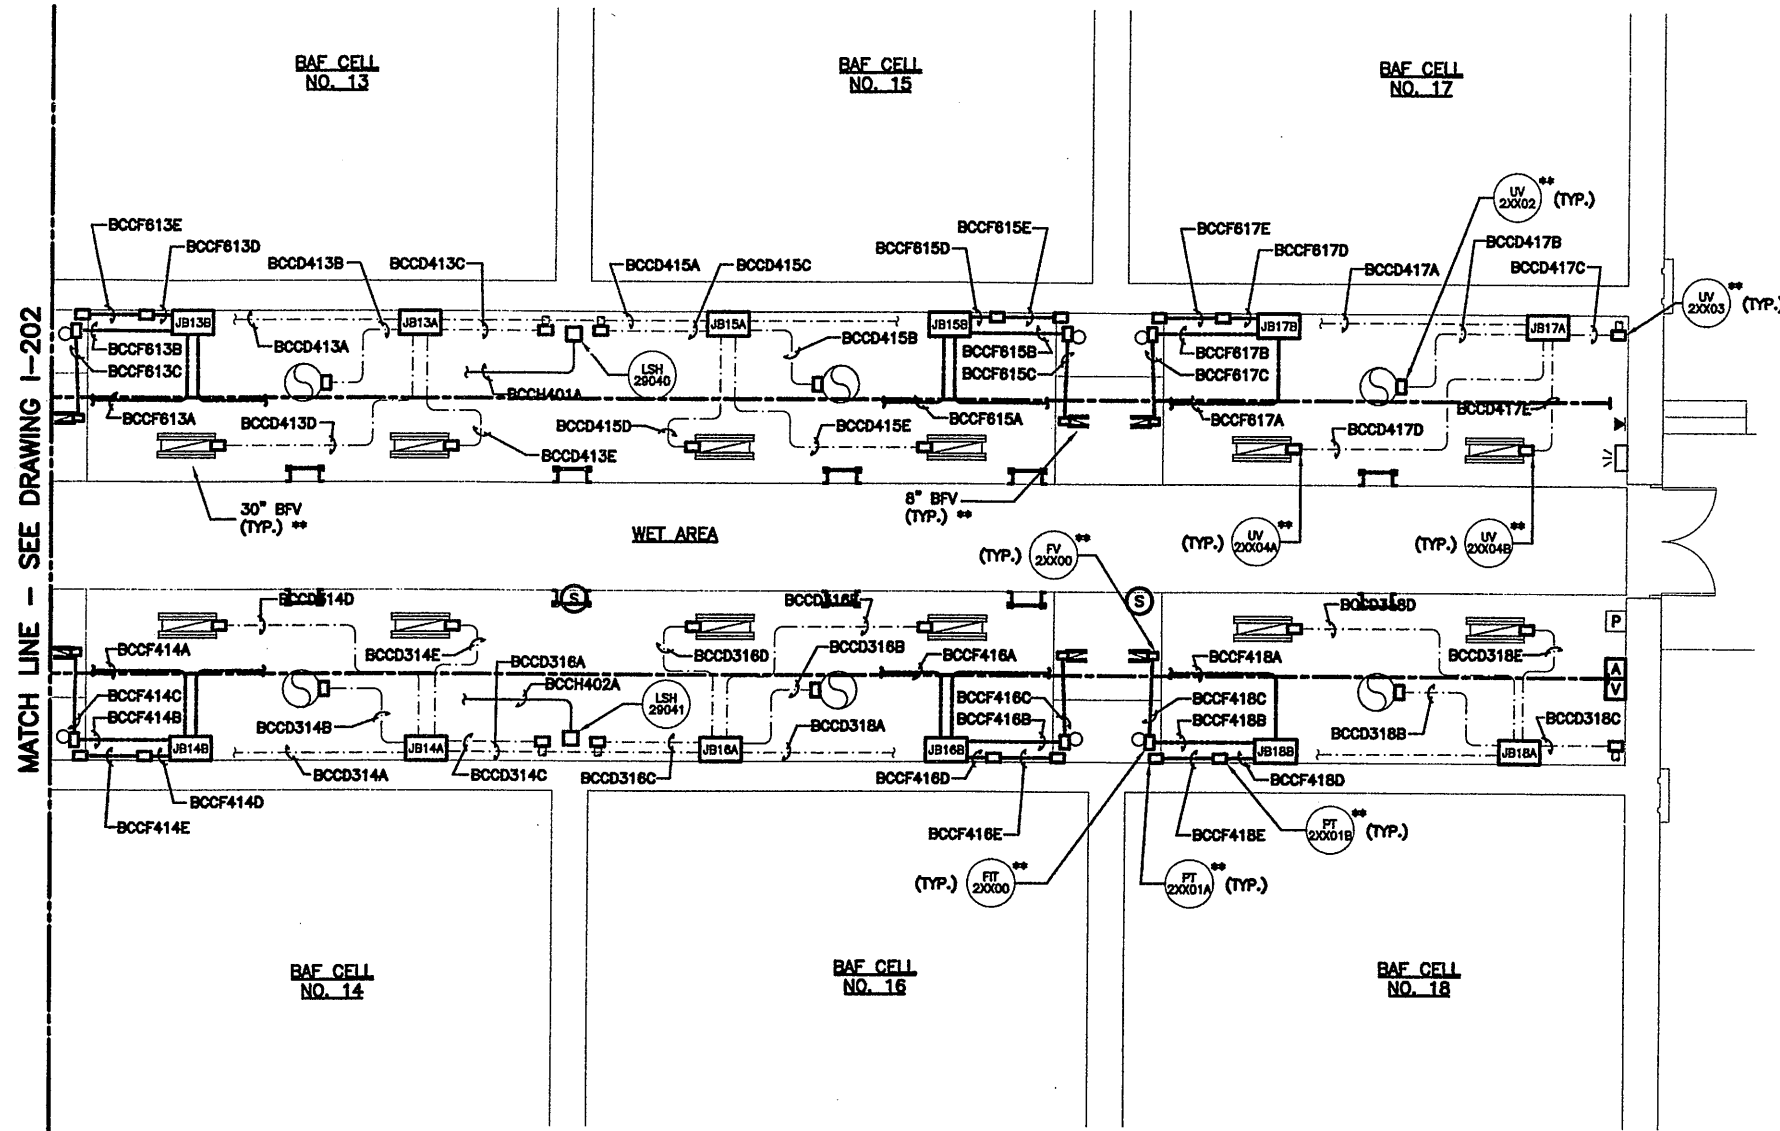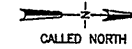

BAF LOWER LEVEL PARTIAL PLAN NORTH
SCALE: 3/16"=1'-0"

NOTES:

1. THE XX IN EACH TAG NUMBER REPRESENTS THE ASSOCIATED CELL NUMBER.
2. PT-2XX01A AND PT-2XX01B ARE VERTICALLY ALIGNED AT EL. 379.20 AND EL. 371.75 RESPECTIVELY; HORIZONTAL VIEW IS FOR CLARITY ONLY.
3. ** INDICATES AN ITEM OR ITEMS SUPPLIED BY OWNER FOR INSTALLATION BY THE CONTRACTOR.
4. FOR CONDUIT SCHEDULES SEE DRAWINGS 1-510, 1-511, 1-512 & 1-513.

RECORD DRAWING

THESE DRAWINGS HAVE BEEN REVISIONED TO REFLECT MAJOR CHANGES, IF ANY, WHICH OCCURRED DURING CONSTRUCTION. REVISIONS ARE BASED UPON INFORMATION SUPPLIED BY CONTRACTOR.

DATE: 10/10/03 FOR: Lampolet

THIS DRAWING WAS PREPARED AT THE SCALE INDICATED IN THE TITLE BLOCK. INACCURACIES IN THE STATED SCALE MAY BE INTRODUCED WHEN DRAWINGS ARE REPRODUCED BY ANY MEANS. USE THE GRAPHIC SCALE BAR IN THE TITLE BLOCK TO DETERMINE THE ACTUAL SCALE OF THIS DRAWING.

Layer: ON=*, OFF=**REF*
X: 0659201, 212.DWG
4/13/01 BBL DCC
05503000/06591203.DWG



| No. | Date | Revisions | Init |
|-----|----------|---------------------|------|
| 0 | 4/20/01 | ISSUED FOR APPROVAL | TEL |
| 1 | 7/11/01 | AS BID | |
| 2 | 10/31/03 | RECORD DRAWING | |

In charge of TEL
Designed by AHL
Drawn by DCC
Checked by TEL



ENVIRONMENTAL ENGINEERING ASSOCIATES, LLP
SYRACUSE, NEW YORK

ONONDAGA COUNTY • DEPARTMENT OF DRAINAGE AND SANITATION • SYRACUSE, NEW YORK
METROPOLITAN SYRACUSE WASTEWATER TREATMENT PLANT
STAGE III AMMONIA AND STAGE II PHOSPHORUS REMOVAL PROJECT
BAF COMPLEX
BAF LOWER LEVEL PARTIAL PLAN NORTH



File Number
00659
Date
APRIL 2001

I-203

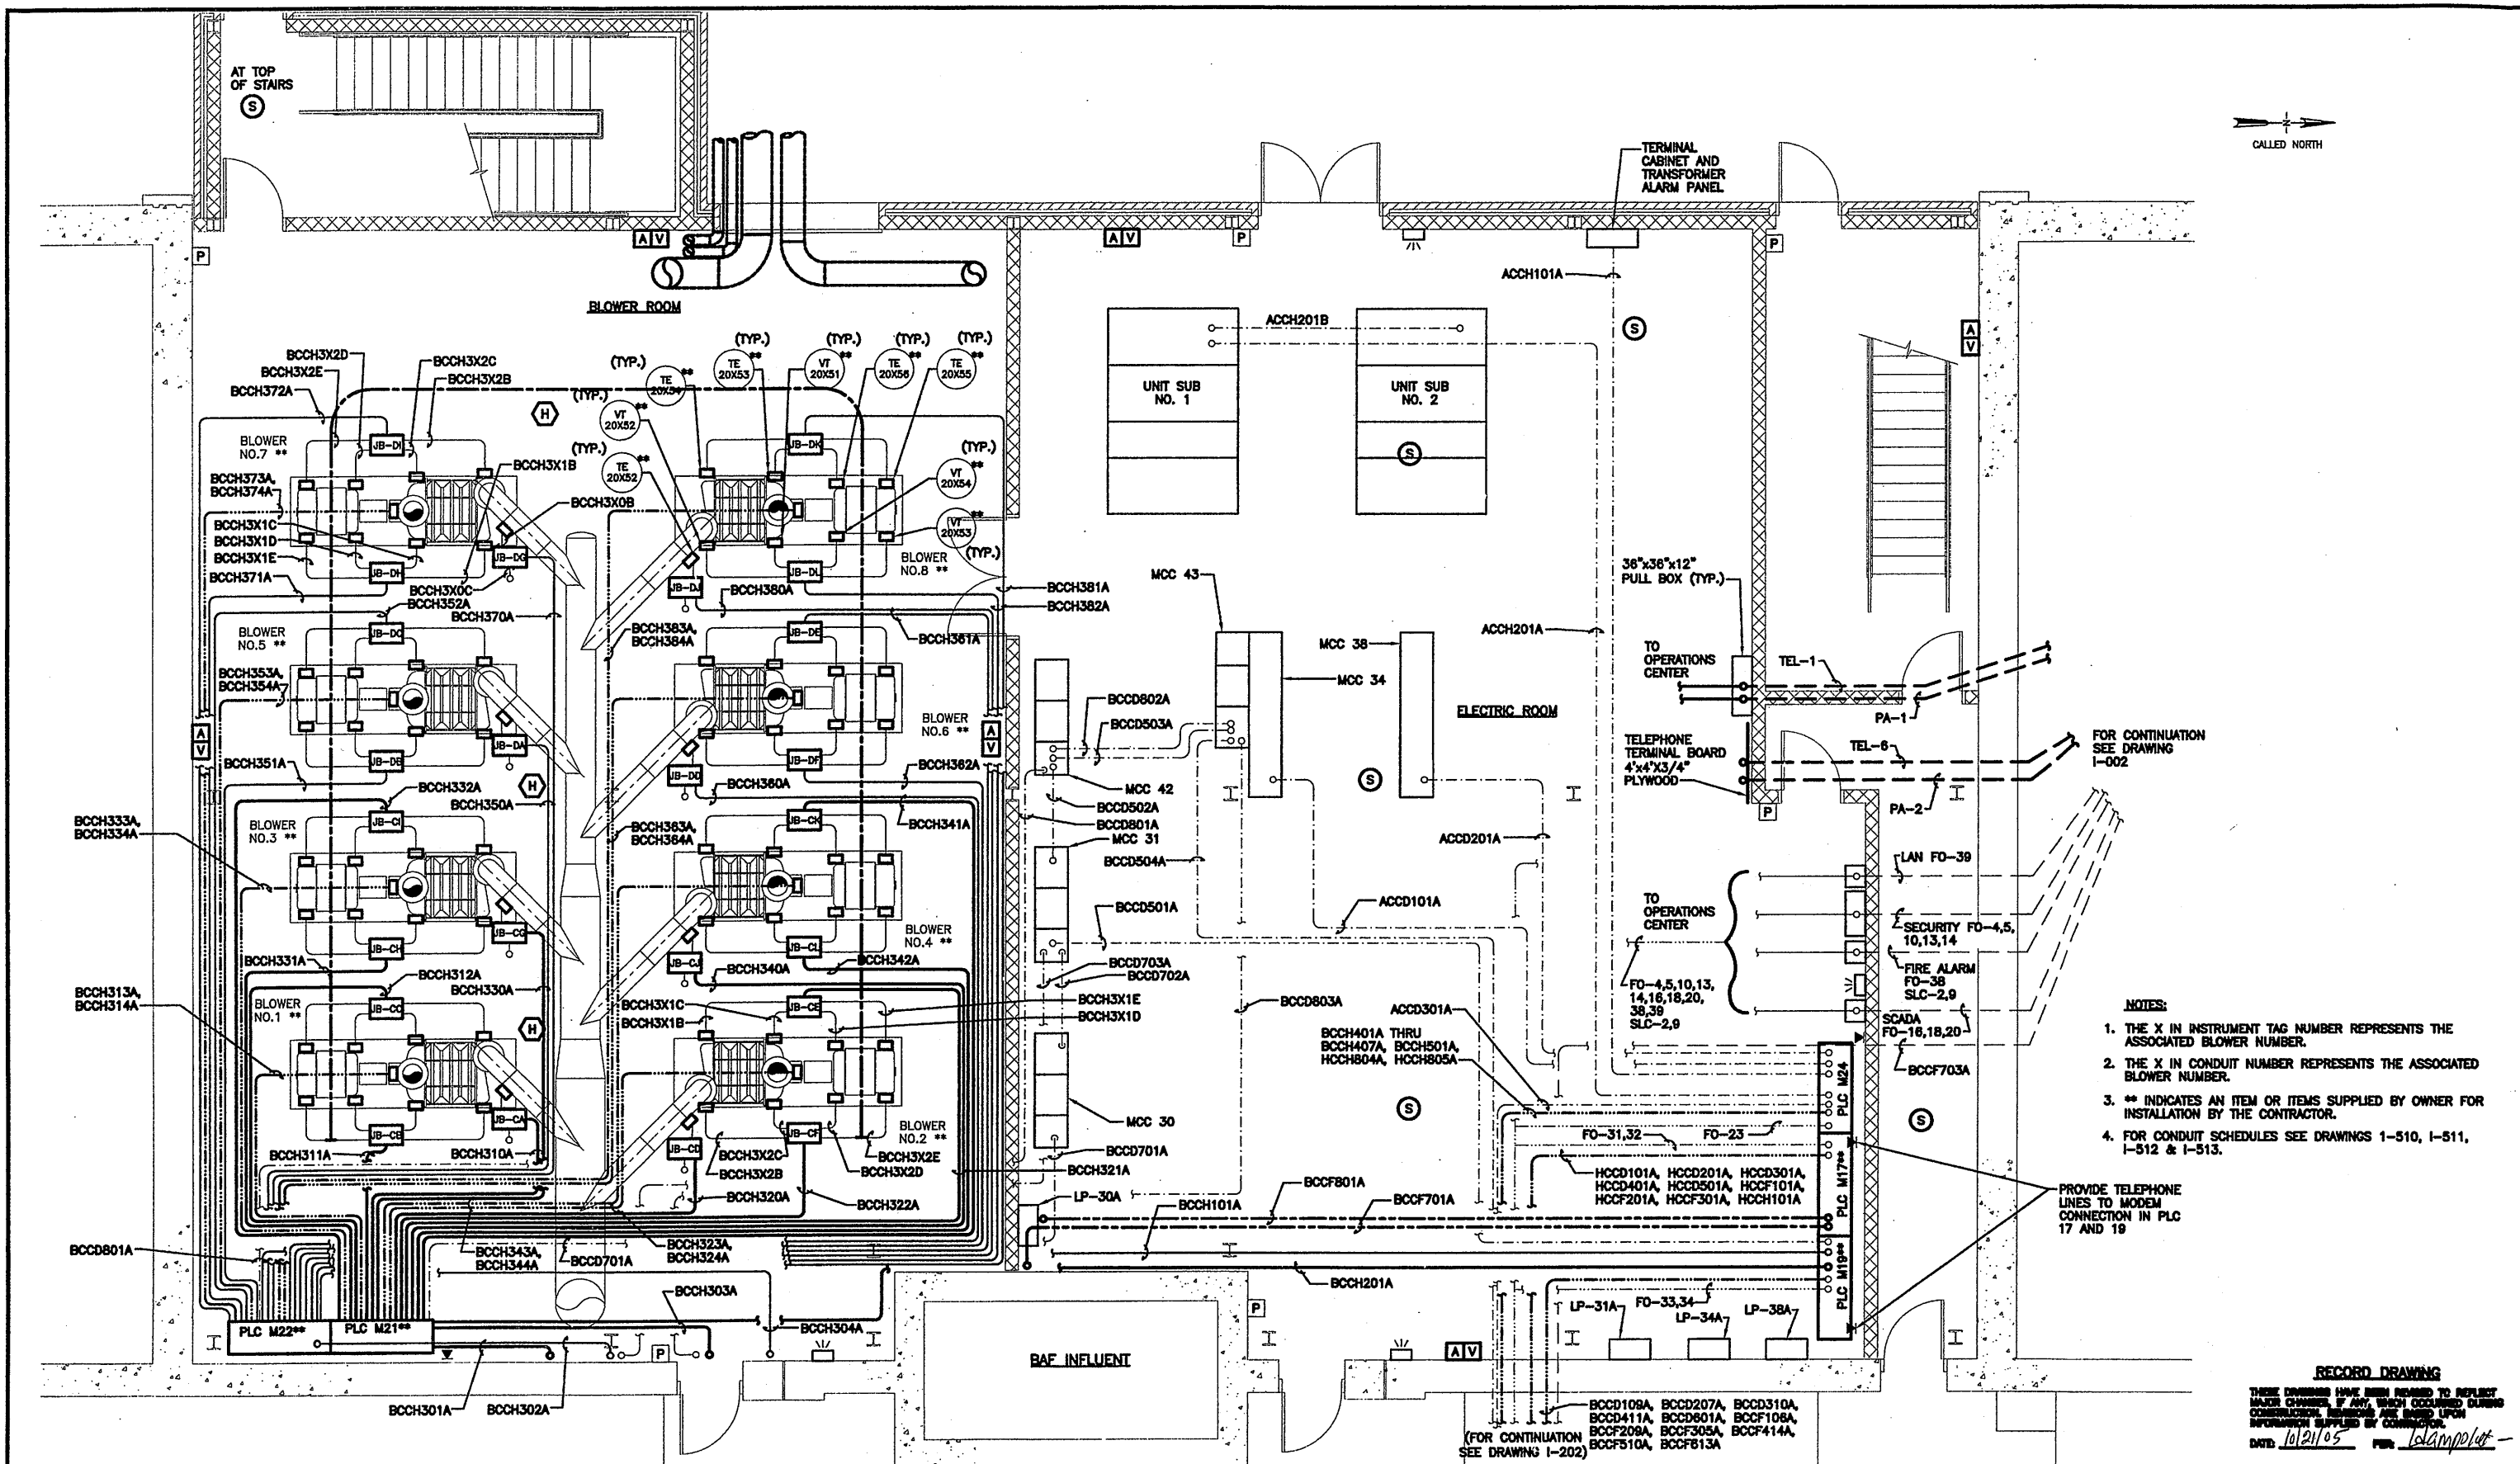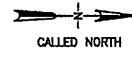


- NOTES:**
1. THE X IN INSTRUMENT TAG NUMBER REPRESENTS THE ASSOCIATED BLOWER NUMBER.
 2. THE X IN CONDUIT NUMBER REPRESENTS THE ASSOCIATED BLOWER NUMBER.
 3. ** INDICATES AN ITEM OR ITEMS SUPPLIED BY OWNER FOR INSTALLATION BY THE CONTRACTOR.
 4. FOR CONDUIT SCHEDULES SEE DRAWINGS 1-510, 1-511, 1-512 & 1-513.

PROVIDE TELEPHONE LINES TO MODEM CONNECTION IN PLC 17 AND 19

BAF BLOWER AND ELECTRIC ROOM PLANS
SCALE: 1/4"=1'-0"

Layer: ON=*, OFF=REF*
X: 0659X201.DWG
4/23/01 BBL DCC
05503000/0659E204.DWG

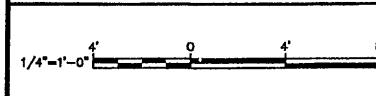

| No. | Date | Revisions | Init |
|-----|----------|---------------------|------|
| 0 | 4/20/01 | ISSUED FOR APPROVAL | |
| 1 | 7/11/01 | AS BID | |
| 2 | 10/31/05 | RECORD DRAWING | |

In charge of TEL
Designed by AHL
Drawn by DCC
Checked by TEL



ONONDAGA COUNTY • DEPARTMENT OF DRAINAGE AND SANITATION • SYRACUSE, NEW YORK
METROPOLITAN SYRACUSE WASTEWATER TREATMENT PLANT
STAGE III AMMONIA AND STAGE II PHOSPHORUS REMOVAL PROJECT



BAF COMPLEX
BAF BLOWER AND ELECTRIC ROOM PLANS
INSTRUMENTATION



File Number 00659
Date APRIL 2001
1-204
Stampolet

RECORD DRAWING
THESE DRAWINGS HAVE BEEN REVIEWED TO REFLECT MAJOR CHANGES, IF ANY, WHICH OCCURRED DURING CONSTRUCTION. REVISIONS ARE BASED UPON INFORMATION SUPPLIED BY CONTRACTOR.
DATE: 10/21/05 FOR: Stampolet

THIS DRAWING WAS PREPARED AT THE SCALE INDICATED IN THE TITLE BLOCK. INACCURACIES IN THE STATED SCALE MAY BE INTRODUCED WHEN DRAWINGS ARE REPRODUCED BY ANY MEANS. USE THE GRAPHIC SCALE BAR IN THE TITLE BLOCK TO DETERMINE THE ACTUAL SCALE OF THIS DRAWING.

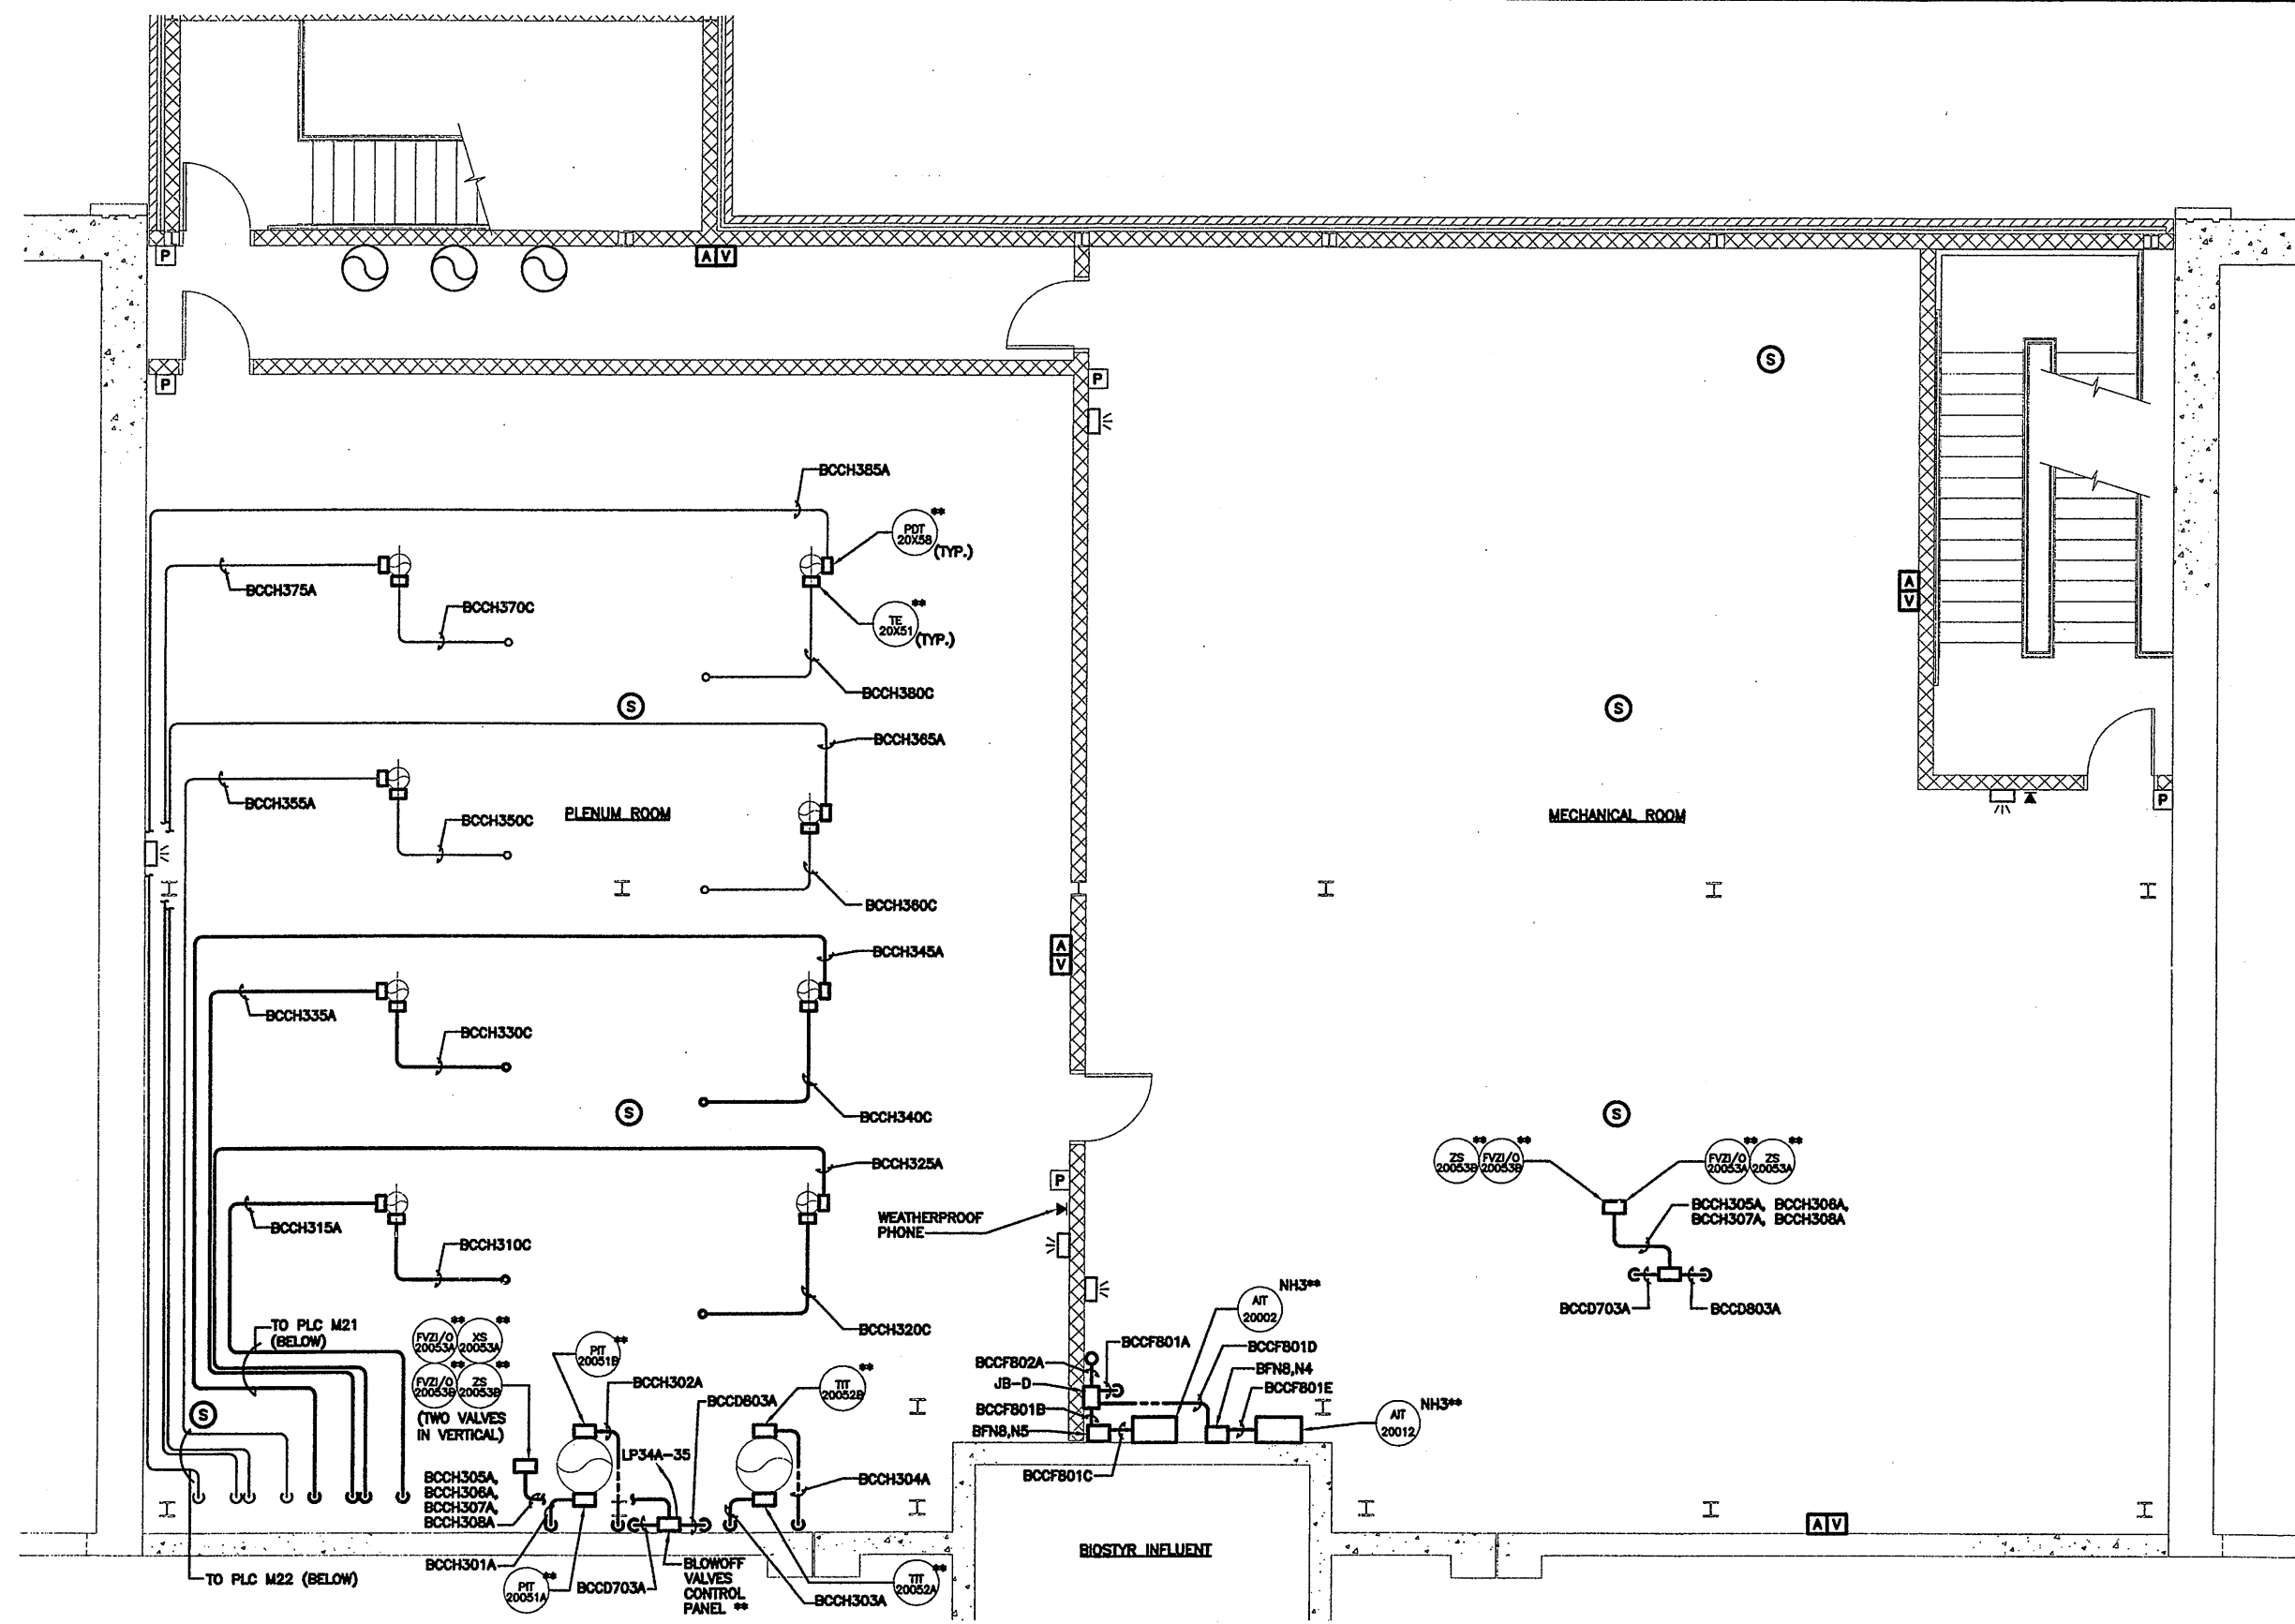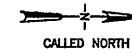

- NOTE:**
1. THE X IN INSTRUMENT TAG NUMBER REPRESENTS THE ASSOCIATED BLOWER NUMBER.
 2. ** INDICATES AN ITEM OR ITEMS SUPPLIED BY OWNER FOR INSTALLATION BY THE CONTRACTOR.
 3. FOR CONDUIT SCHEDULES SEE DRAWINGS 1-510, 1-511, 1-512 & 1-513.

RECORD DRAWING


THESE DRAWINGS HAVE BEEN REVISIONED TO REFLECT MAJOR CHANGES, IF ANY, WHICH OCCURRED DURING CONSTRUCTION. REVISIONS ARE BASED UPON INFORMATION SUPPLIED BY CONTRACTOR.

DATE: 10/1/05 PER: L. Kampalet

THIS DRAWING WAS PREPARED AT THE SCALE INDICATED IN THE TITLE BLOCK. INACCURACIES IN THE STATED SCALE MAY BE INTRODUCED WHEN DRAWINGS ARE REPRODUCED BY ANY MEANS. USE THE GRAPHIC SCALE BAR IN THE TITLE BLOCK TO DETERMINE THE ACTUAL SCALE OF THIS DRAWING.

Layers: ON=*; OFF=**REF*
X: 0659X202.DWG
4/16/01 BBL DCC
0550300/06591205.DWG

BAF PLENUM AND MECHANICAL ROOM PLAN
SCALE: 1/4"=1'-0"

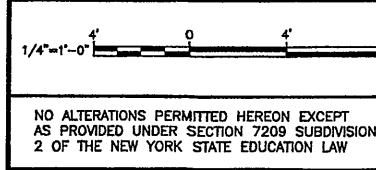


| No. | Date | Revisions | Init |
|-----|----------|---------------------|------|
| 0 | 4/20/01 | ISSUED FOR APPROVAL | |
| 1 | 7/11/01 | AS BID | |
| 2 | 10/31/05 | RECORD DRAWING | |



In charge of --- TEL ---
Designed by --- AHL ---
Drawn by --- DCC ---
Checked by --- TEL ---




ONONDAGA COUNTY • DEPARTMENT OF DRAINAGE AND SANITATION • SYRACUSE, NEW YORK
METROPOLITAN SYRACUSE WASTEWATER TREATMENT PLANT
STAGE III AMMONIA AND STAGE II PHOSPHORUS REMOVAL PROJECT
BAF COMPLEX
BAF PLENUM AND MECHANICAL ROOM PLAN
INSTRUMENTATION

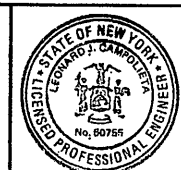

File Number
00659
Date
APRIL 2001
1-205
L. Kampalet

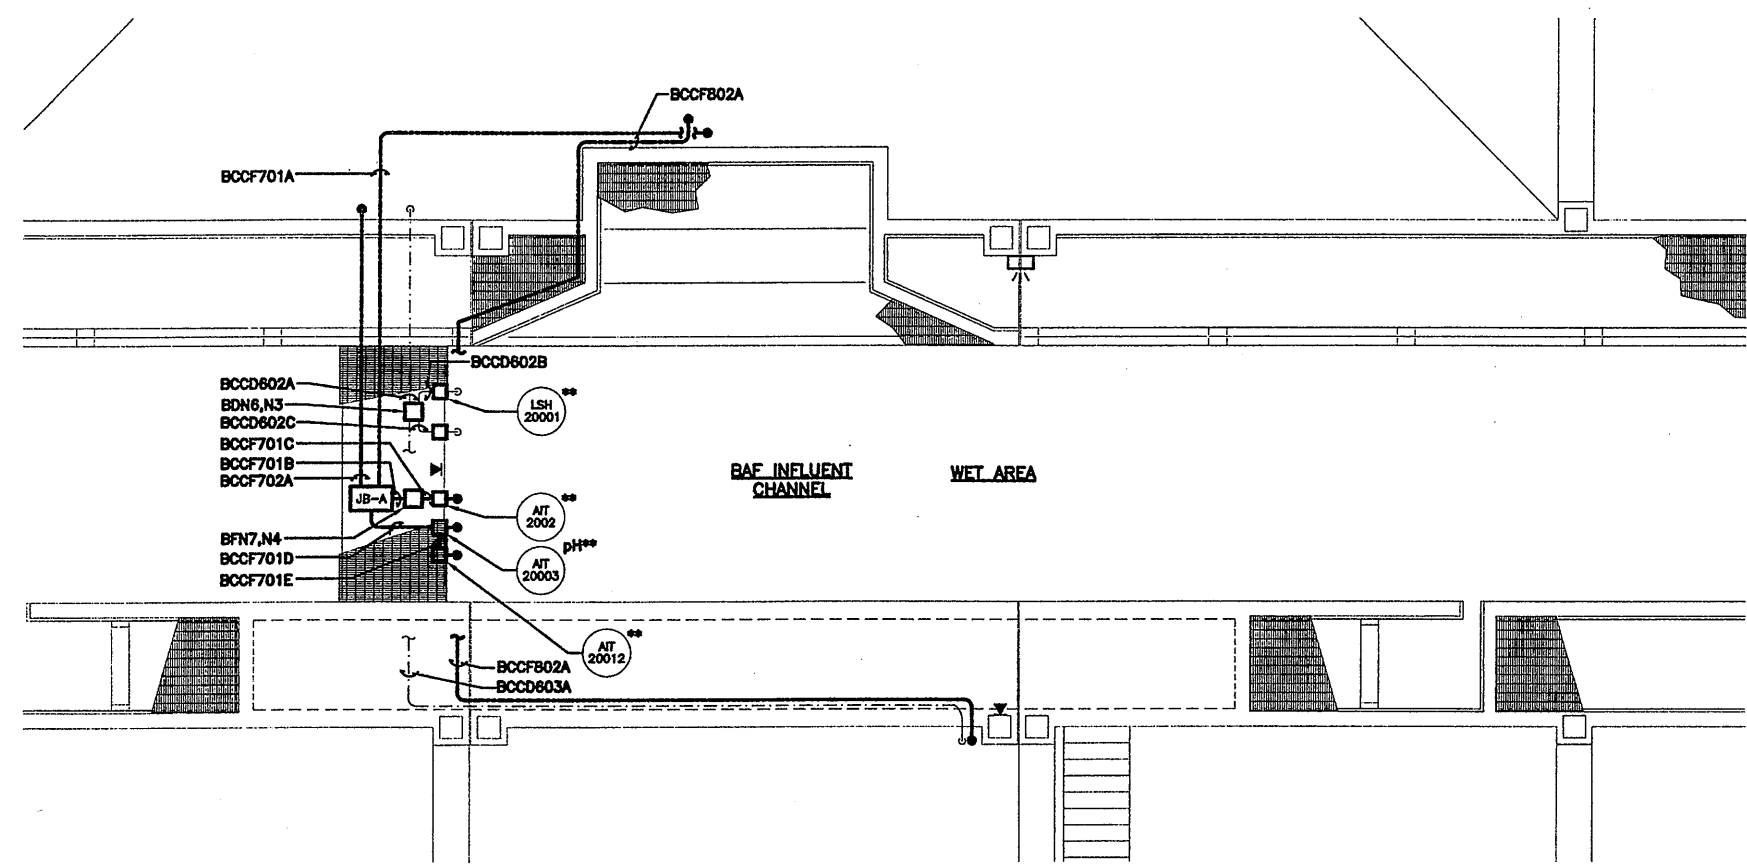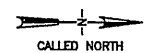

BAF UPPER LEVEL PARTIAL PLAN
SCALE: 3/16"=1'-0"

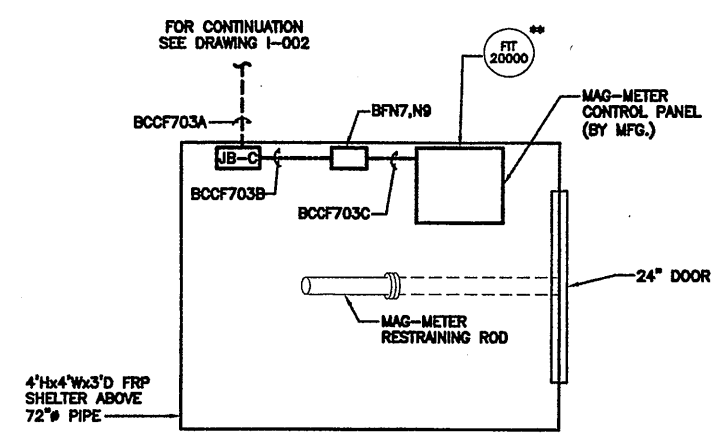

INSERTION MAG-METER SHELTER
NOT TO SCALE

- NOTE:**
1. FOR CONDUIT SCHEDULES SEE DRAWINGS 1-510, 1-511, 1-512 & 1-513.
 2. ** INDICATES AN ITEM OR ITEMS TO BE SUPPLIED BY OWNER FOR INSTALLATION BY THE CONTRACTOR.

RECORD DRAWING
THESE DRAWINGS HAVE BEEN REVIEWED TO REFLECT MAKE CHANGES, IF ANY, WHICH OCCURRED DURING CONSTRUCTION. REVISIONS ARE BASED UPON INFORMATION SUPPLIED BY CONTRACTOR.
DATE: 10/21/05 PER: [Signature]

THIS DRAWING WAS PREPARED AT THE SCALE INDICATED IN THE TITLE BLOCK. INACCURACIES IN THE STATED SCALE MAY BE INTRODUCED WHEN DRAWINGS ARE REPRODUCED BY ANY MEANS. USE THE GRAPHIC SCALE BAR IN THE TITLE BLOCK TO DETERMINE THE ACTUAL SCALE OF THIS DRAWING.

Layer: ON=*, OFF=**REF*
X: 0659X203, 212.DWG
4/10/01 BBL DCC
05503000/06591208.DWG


3/16"=1'-0"
NO ALTERATIONS PERMITTED HEREON EXCEPT AS PROVIDED UNDER SECTION 7209 SUBDIVISION 2 OF THE NEW YORK STATE EDUCATION LAW

| No. | Date | Revisions | Init |
|-----|----------|---------------------|------|
| 0 | 4/20/01 | ISSUED FOR APPROVAL | TEL |
| 1 | 7/11/01 | AS BID | |
| 2 | 10/31/05 | RECORD DRAWING | |

In charge of --- TEL ---
Designed by --- AHL ---
Drawn by --- DCC ---
Checked by --- TEL ---



ONONDAGA COUNTY • DEPARTMENT OF DRAINAGE AND SANITATION • SYRACUSE, NEW YORK
METROPOLITAN SYRACUSE WASTEWATER TREATMENT PLANT
STAGE III AMMONIA AND STAGE II PHOSPHORUS REMOVAL PROJECT
BAF COMPLEX
BAF UPPER LEVEL PARTIAL PLAN

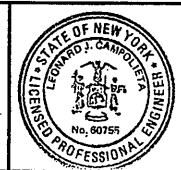


File Number
00659
Date
APRIL 2001
[Signature]

I-206

INSTRUMENTATION

ELECTRIC BAF CONTROL PANEL **

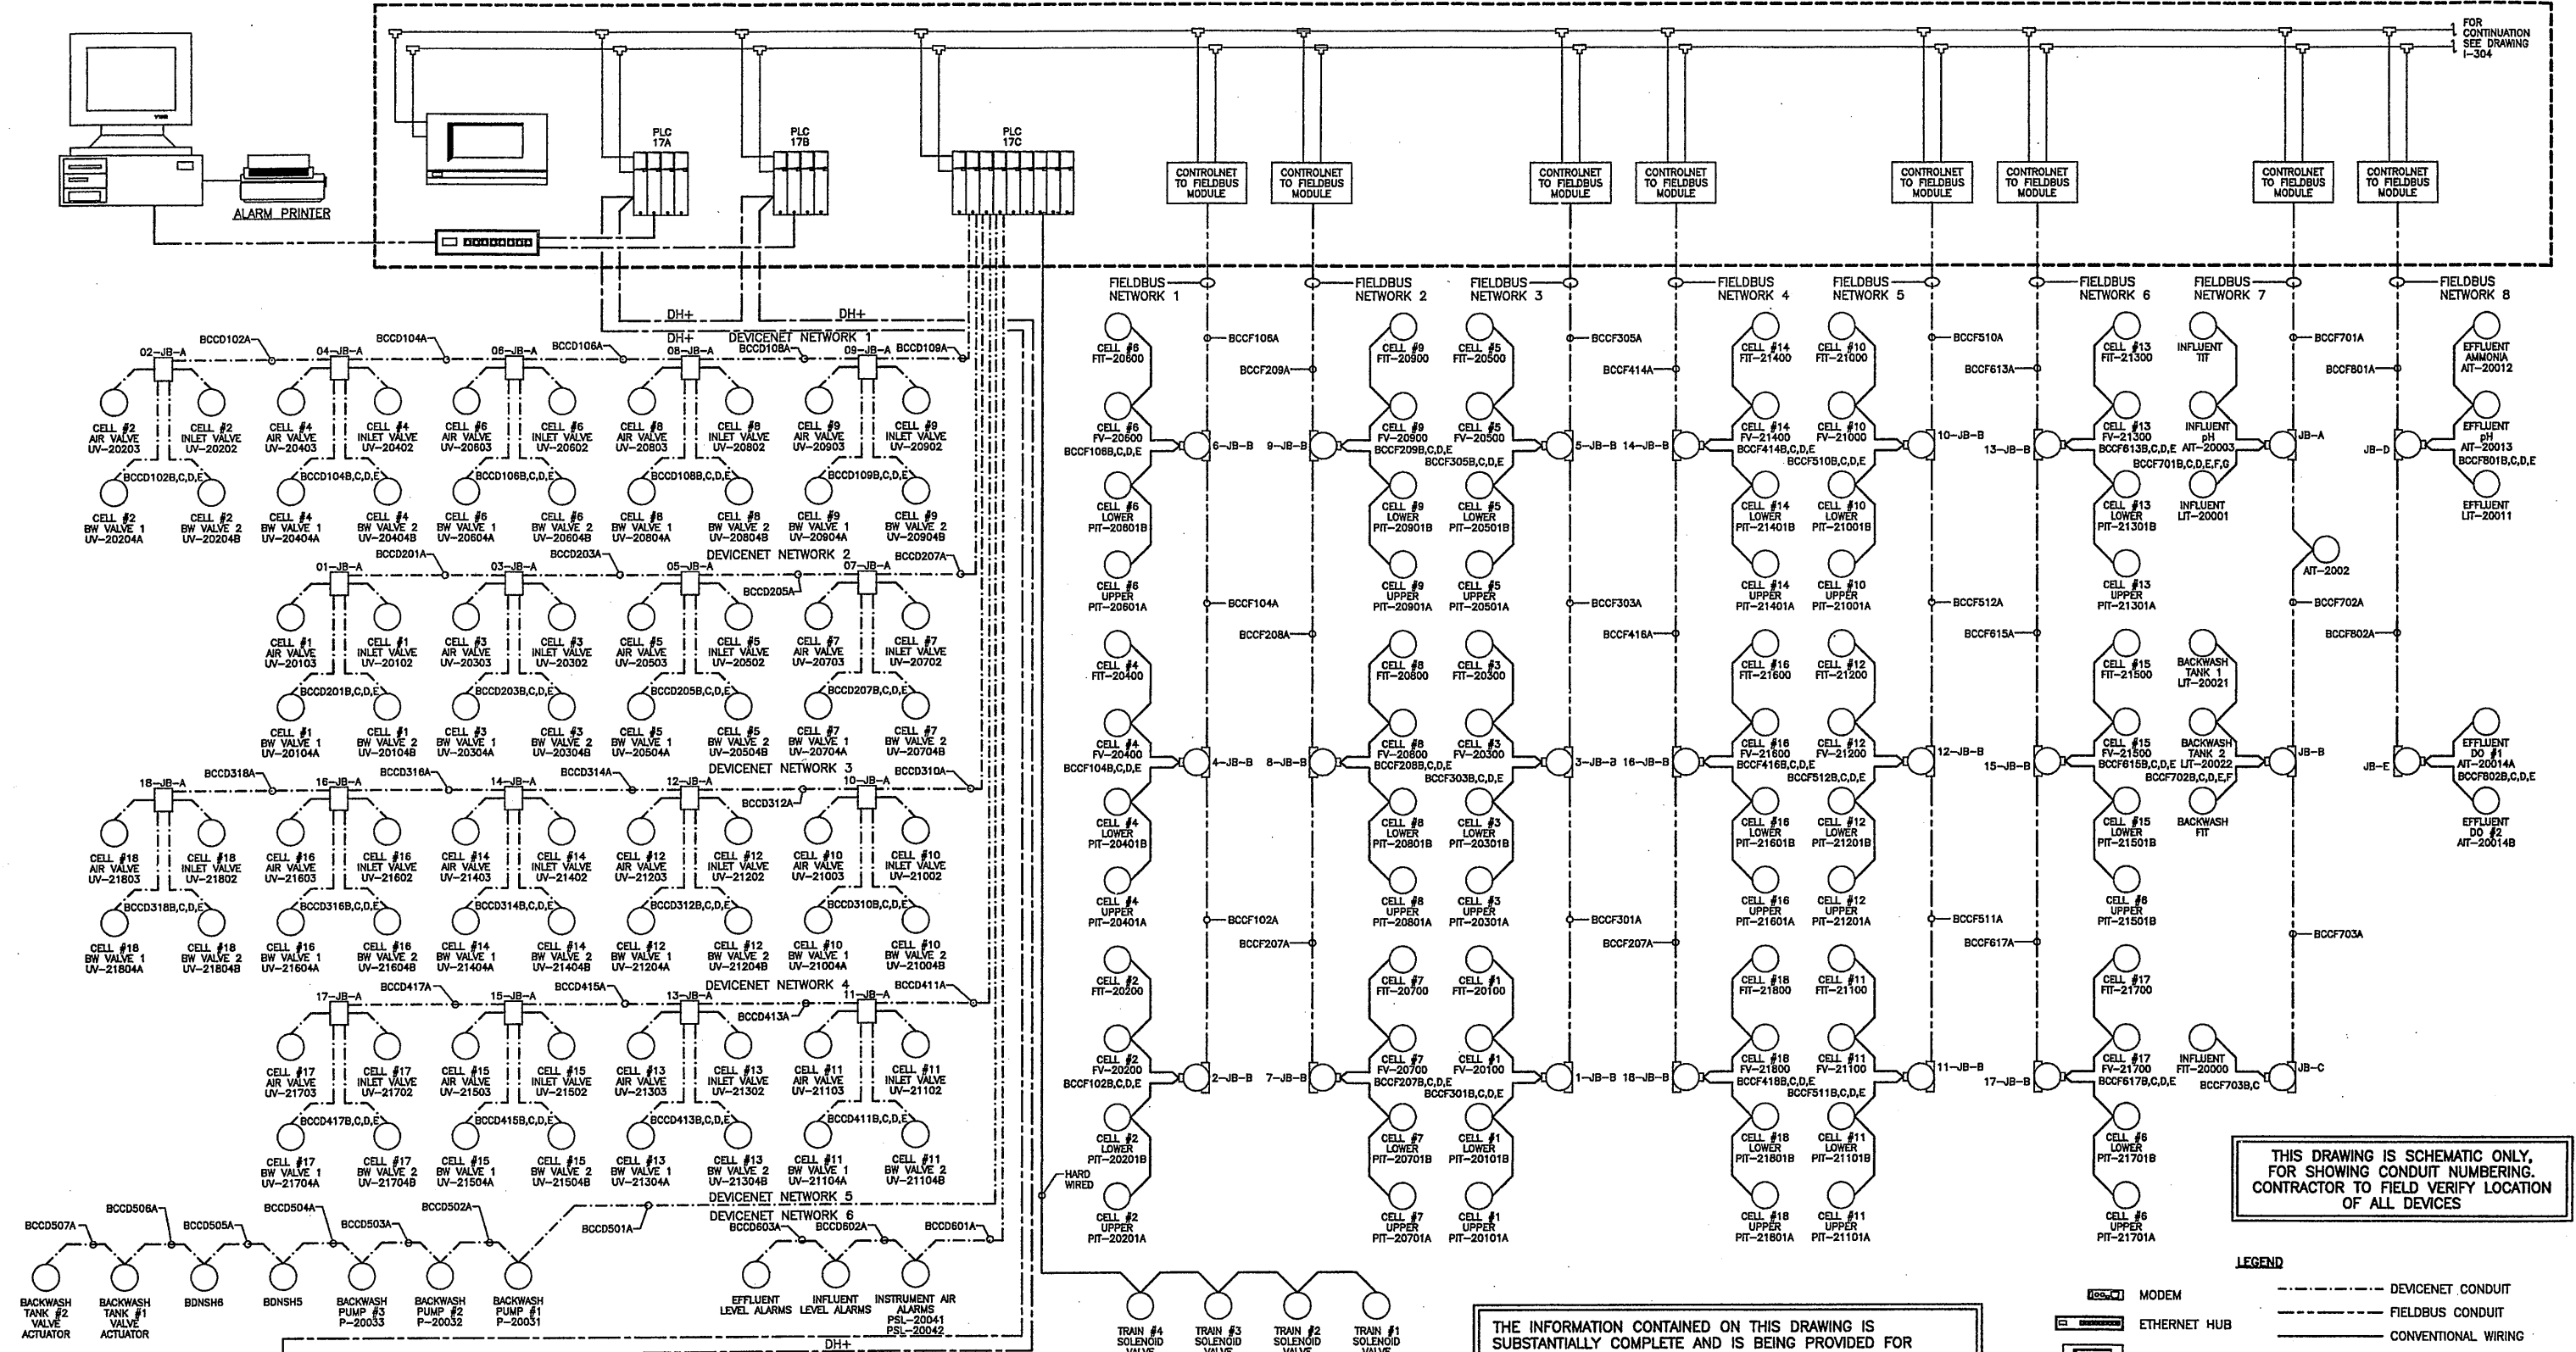

THIS DRAWING IS SCHEMATIC ONLY, FOR SHOWING CONDUIT NUMBERING. CONTRACTOR TO FIELD VERIFY LOCATION OF ALL DEVICES

THE INFORMATION CONTAINED ON THIS DRAWING IS SUBSTANTIALLY COMPLETE AND IS BEING PROVIDED FOR CONCEPT ONLY. THE CONTROL PANEL SHOWN IS BEING SUPPLIED BY THE OWNER IN ACCORDANCE WITH THE SPECIFICATIONS. THE CONTRACTOR WILL BE PROVIDED WITH A SHOP DRAWING SUBMITTAL INCLUDING FULL CONTROL PANEL DRAWINGS AND DETAILS AT THE TIME OF CONSTRUCTION. INSTALLATION CONDUIT, CABLE, DEVICES, AND TERMINATIONS SHALL BE IN ACCORDANCE WITH EQUIPMENT CONTROL PANEL DRAWINGS AND SUBMITTAL INFORMATION.

LEGEND


- DEVICENET CONDUIT
- FIELDBUS CONDUIT
- CONVENTIONAL WIRING
- DH+ CONDUIT
- RECORD DRAWING

MODEM
 ETHERNET HUB
 PANEL VIEW
 PLC

THESE DRAWINGS HAVE BEEN REVIEWED TO REFLECT MAJOR CHANGES, IF ANY, WHICH OCCURRED DURING CONSTRUCTION. REVISIONS ARE BASED UPON INFORMATION SUPPLIED BY CONTRACTOR.
 DATE: 10/15/05 FOR: Kampolot

THIS DRAWING WAS PREPARED AT THE SCALE INDICATED IN THE TITLE BLOCK. INACCURACIES IN THE STATED SCALE MAY BE INTRODUCED WHEN DRAWINGS ARE REPRODUCED BY ANY MEANS. USE THE GRAPHIC SCALE BAR IN THE TITLE BLOCK TO DETERMINE THE ACTUAL SCALE OF THIS DRAWING.

Layer: ON=*; OFF=*REF*
02/01/01 OBG JEC
EEA-VERT

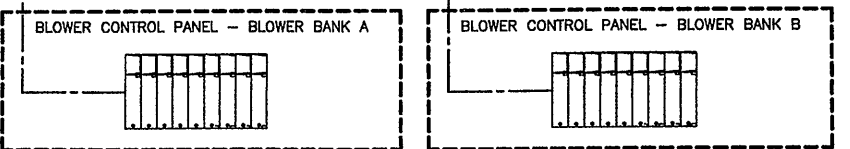

| No. | Date | Revisions | Init |
|-----|----------|---------------------|------|
| 0 | 4/20/01 | ISSUED FOR APPROVAL | PLD |
| 1 | 7/11/01 | AS BID | |
| 2 | 10/31/05 | RECORD DRAWING | |

In charge of: PLD
 Designed by: SAT
 Drawn by: JEC
 Checked by: PLD

ENVIRONMENTAL ENGINEERING ASSOCIATES, LLP
SYRACUSE, NEW YORK

ONONDAGA COUNTY • DEPARTMENT OF DRAINAGE AND SANITATION • SYRACUSE, NEW YORK
METROPOLITAN SYRACUSE WASTEWATER TREATMENT PLANT
STAGE III AMMONIA AND STAGE II PHOSPHORUS REMOVAL PROJECT
BAF (PLC M19)
INTERCONNECTION DRAWING


File Number: 00659
Date: APRIL 2001
1-207

INSTRUMENTATION

BLOWER ROOM CONTROL PANEL - BLOWER BANK "A" (PLC M21)

BLOWER ROOM CONTROL PANEL - BLOWER BANK "B" (PLC M22)

THE INFORMATION CONTAINED ON THIS DRAWING IS SUBSTANTIALLY COMPLETE AND IS BEING PROVIDED FOR CONCEPT ONLY. THE CONTROL PANEL SHOWN IS BEING SUPPLIED BY THE OWNER IN ACCORDANCE WITH THE SPECIFICATIONS. THE CONTRACTOR WILL BE PROVIDED WITH A SHOP DRAWING SUBMITTAL INCLUDING FULL CONTROL PANEL DRAWINGS AND DETAILS AT THE TIME OF CONSTRUCTION. INSTALLATION CONDUIT, CABLE, DEVICES, AND TERMINATIONS SHALL BE IN ACCORDANCE WITH EQUIPMENT CONTROL PANEL DRAWINGS AND SUBMITTAL INFORMATION.

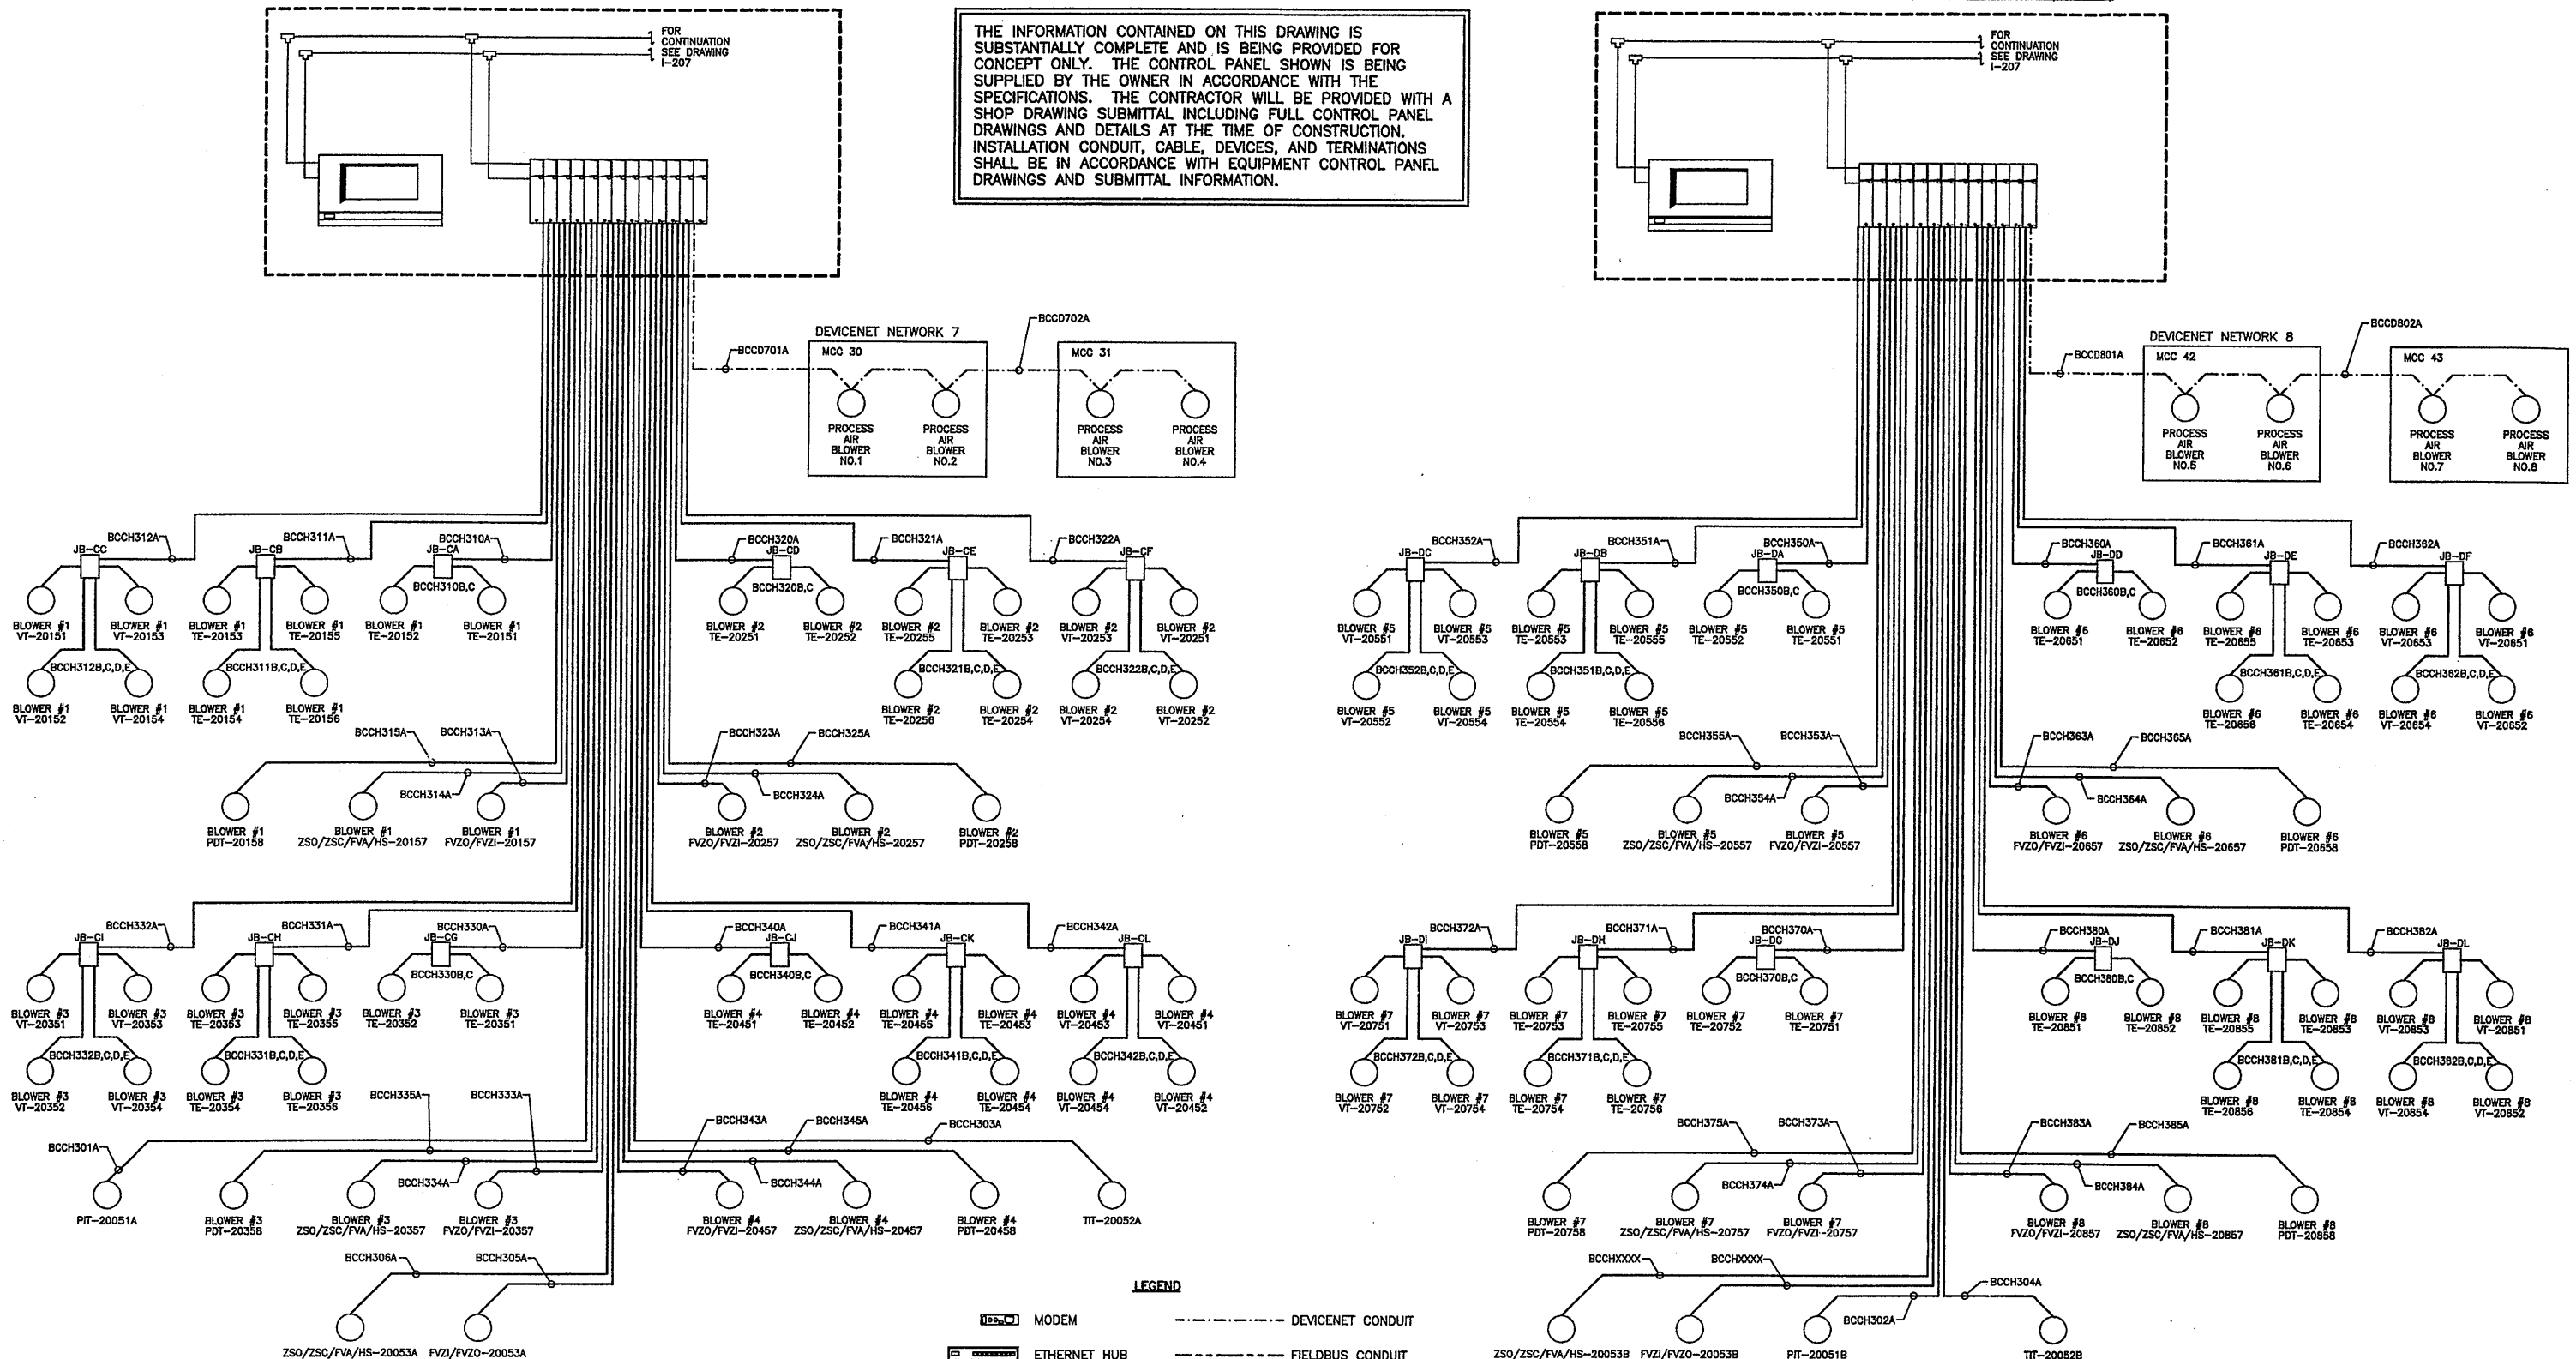

LEGEND

- MODEM
- ETHERNET HUB
- PANEL VIEW
- PLC
- DEVICENET CONDUIT
- FIELDBUS CONDUIT
- CONVENTIONAL WIRING
- DH+ CONDUIT

Layer: ON=*; OFF=*REF*
02/01/01 OBG JEC
EEA-VERT

| No. | Date | Revisions | Init |
|-----|----------|---------------------|------|
| 0 | 4/20/01 | ISSUED FOR APPROVAL | PLD |
| 1 | 7/11/01 | AS BID | SAT |
| 2 | 10/31/05 | RECORD DRAWING | JEC |

In charge of PLD
Designed by SAT
Drawn by JEC
Checked by PLD




ONONDAGA COUNTY • DEPARTMENT OF DRAINAGE AND SANITATION • SYRACUSE, NEW YORK
METROPOLITAN SYRACUSE WASTEWATER TREATMENT PLANT
STAGE III AMMONIA AND STAGE II PHOSPHORUS REMOVAL PROJECT
**BLOWER PANELS (PLC M21 & M22)
INTERCONNECTION DRAWING**



RECORD DRAWING
THESE DRAWINGS HAVE BEEN REVIEWED TO REFLECT MAJOR CHANGES, IF ANY, WHICH OCCURRED DURING CONSTRUCTION. REVISIONS ARE BASED UPON INFORMATION SUPPLIED BY CONTRACTOR.
DATE: 10/21/05 PER: *L. Gamboliet*

THIS DRAWING WAS PREPARED AT THE SCALE INDICATED IN THE TITLE BLOCK. INACCURACIES IN THE STATED SCALE MAY BE INTRODUCED WHEN DRAWINGS ARE REPRODUCED BY ANY MEANS. USE THE GRAPHIC SCALE BAR IN THE TITLE BLOCK TO DETERMINE THE ACTUAL SCALE OF THIS DRAWING.

File Number: 00659
Date: APRIL 2001
I-208

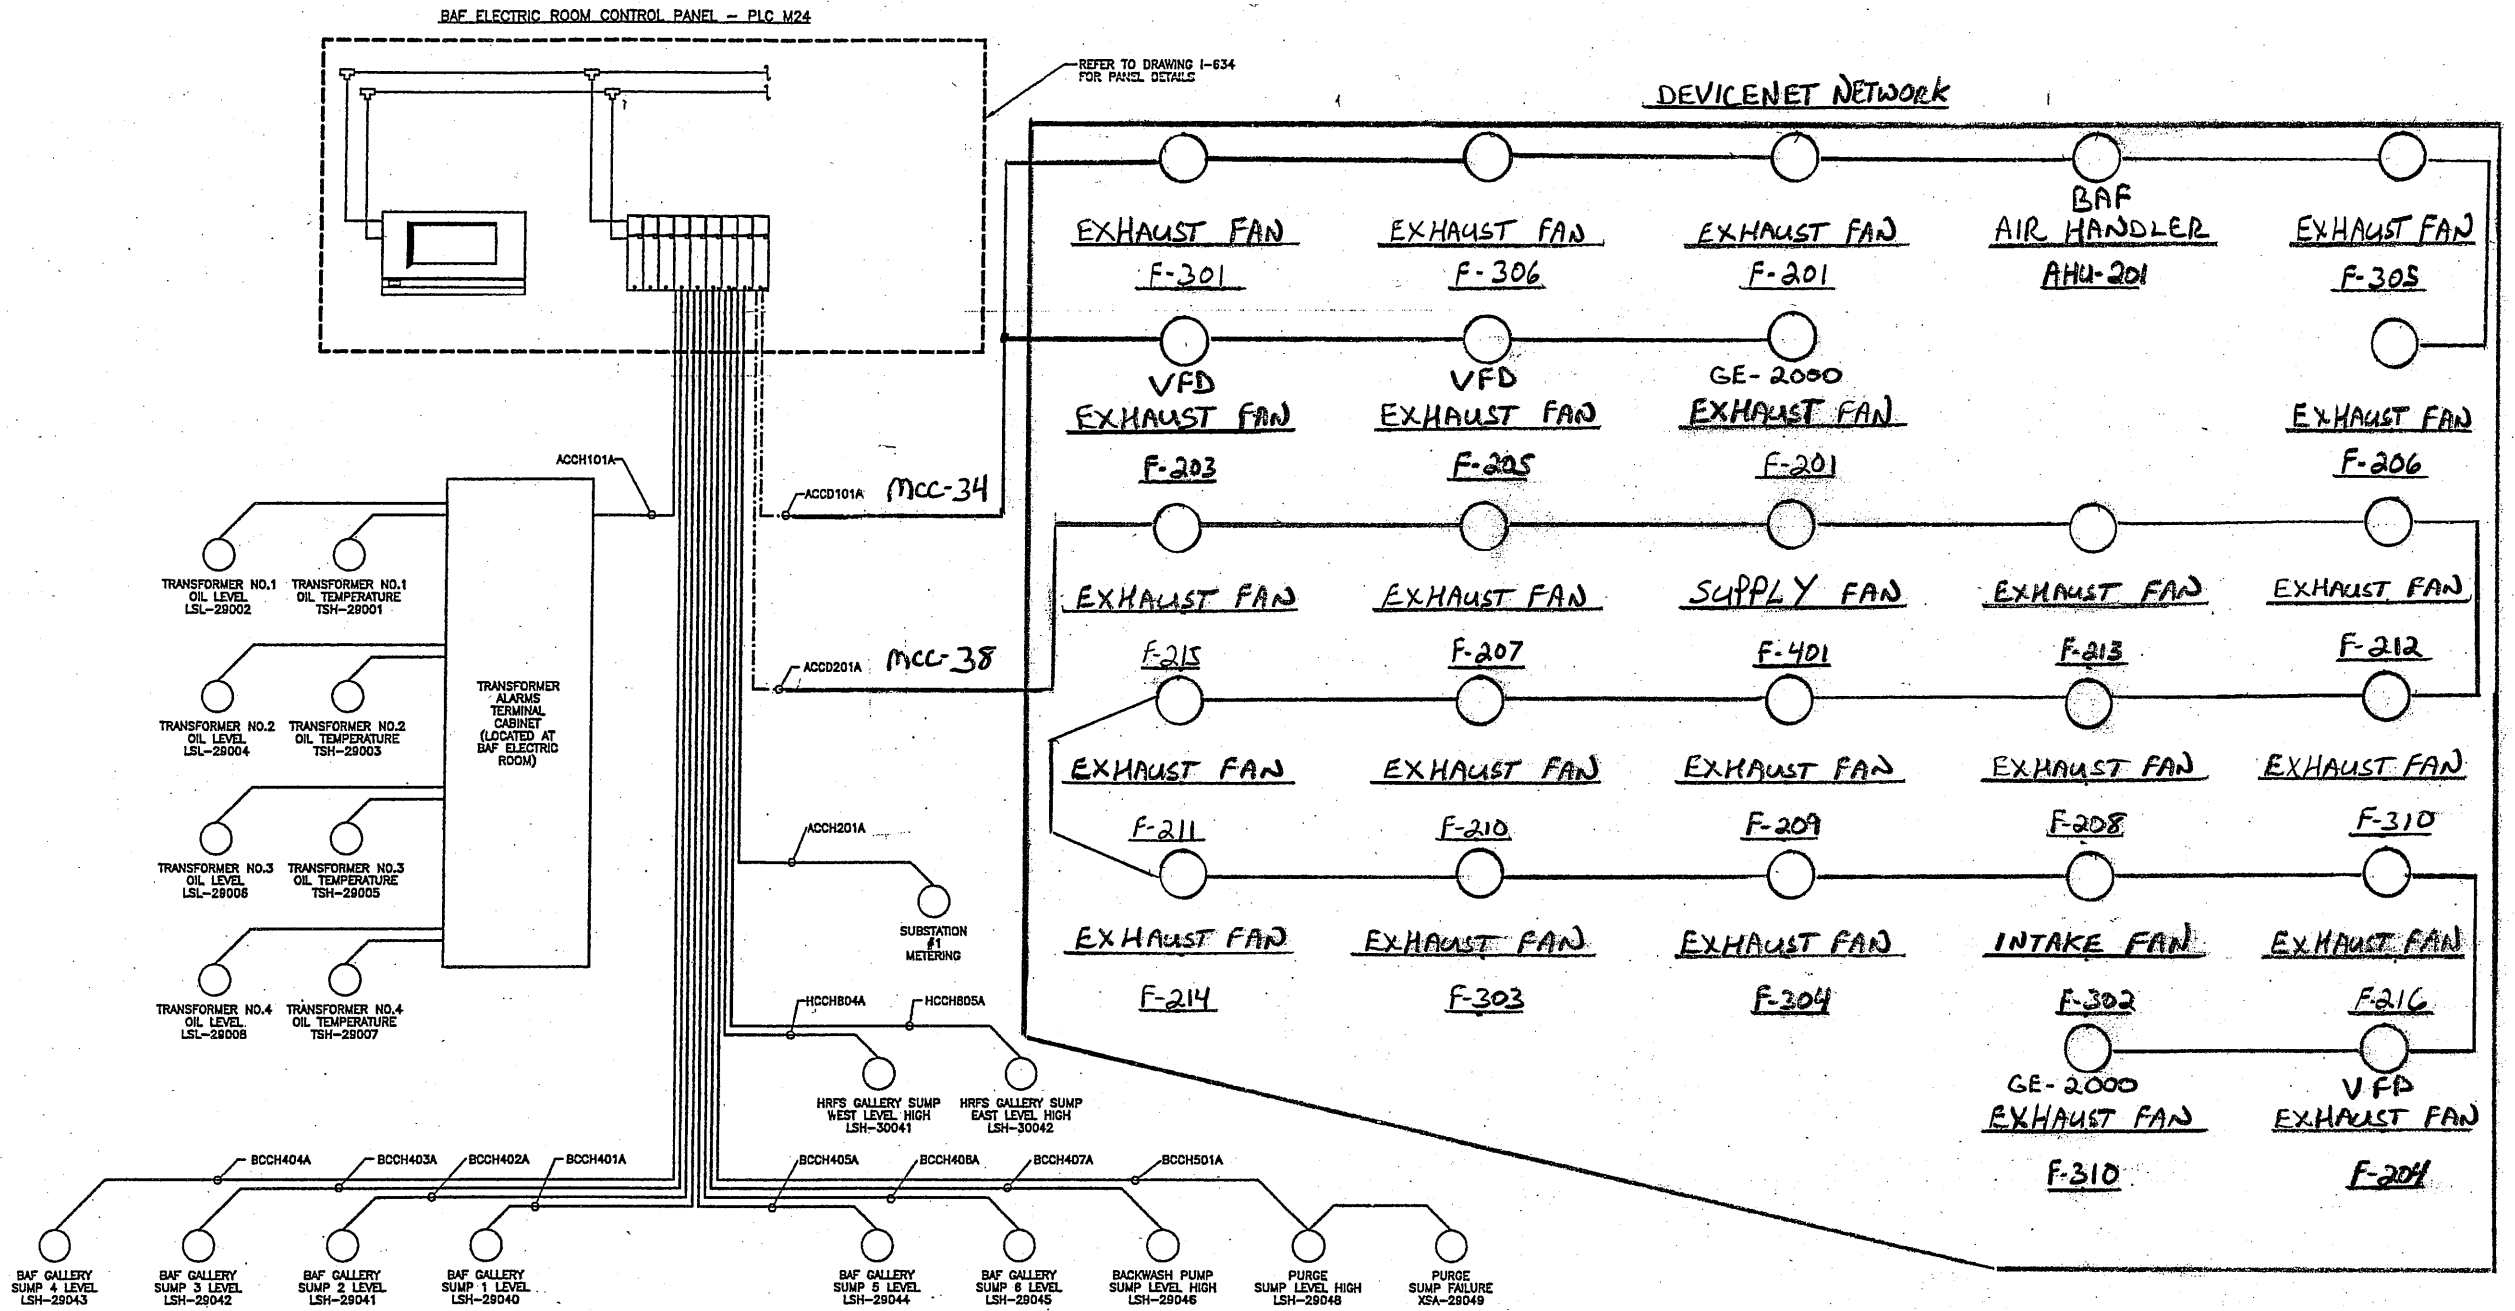

THIS DRAWING IS SCHEMATIC ONLY,
FOR SHOWING CONDUIT NUMBERING.
CONTRACTOR TO FIELD VERIFY LOCATION
OF ALL DEVICES

- LEGEND**
- MODEM
 - ETHERNET HUB
 - PANEL VIEW
 - PLC
 - DEVICENET CONDUIT
 - FIELDBUS CONDUIT
 - CONVENTIONAL WIRING
 - DH+ CONDUIT

RECORD DRAWING
 THESE DRAWINGS HAVE BEEN REVISIONED TO REFLECT
 MAJOR CHANGES OF ANY KIND WHICH OCCURRED DURING
 CONSTRUCTION. REVISIONS ARE BASED UPON
 INFORMATION SUPPLIED BY CONTRACTOR.
 DATE: 10/21/05 FOR: K&P Associates

Layer: ON=; OFF=REF
 04/10/01 OBG JEC
 EEA-VERT

| No. | Date | Revisions | Init |
|-----|----------|------------------------|------|
| 0 | 4/20/01 | ISSUED FOR APPROVAL | PLD |
| 1 | 7/11/01 | AS BID | JEC |
| 2 | 10/31/03 | RECORD DRAWING | JEC |
| 3 | 2-28-06 | REVISED FOR I/E COORD. | PLD |

In charge of: PLD
 Designed by: SAT
 Drawn by: JEC
 Checked by: PLD



ENVIRONMENTAL ENGINEERING ASSOCIATES, LLP
 SYRACUSE, NEW YORK

ONONDAGA COUNTY • DEPARTMENT OF DRAINAGE AND SANITATION • SYRACUSE, NEW YORK
 METROPOLITAN SYRACUSE WASTEWATER TREATMENT PLANT
 STAGE III AMMONIA AND STAGE II PHOSPHORUS REMOVAL PROJECT
BAF ELECTRIC ROOM (PLC M24)
INTERCONNECTION DIAGRAM



File Number: 00659
 Date: APRIL 2001
 1-209
 K&P Associates

NO ALTERATIONS PERMITTED HEREON EXCEPT
 AS PROVIDED UNDER SECTION 7209 SUBDIVISION
 2 OF THE NEW YORK STATE EDUCATION LAW

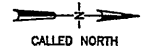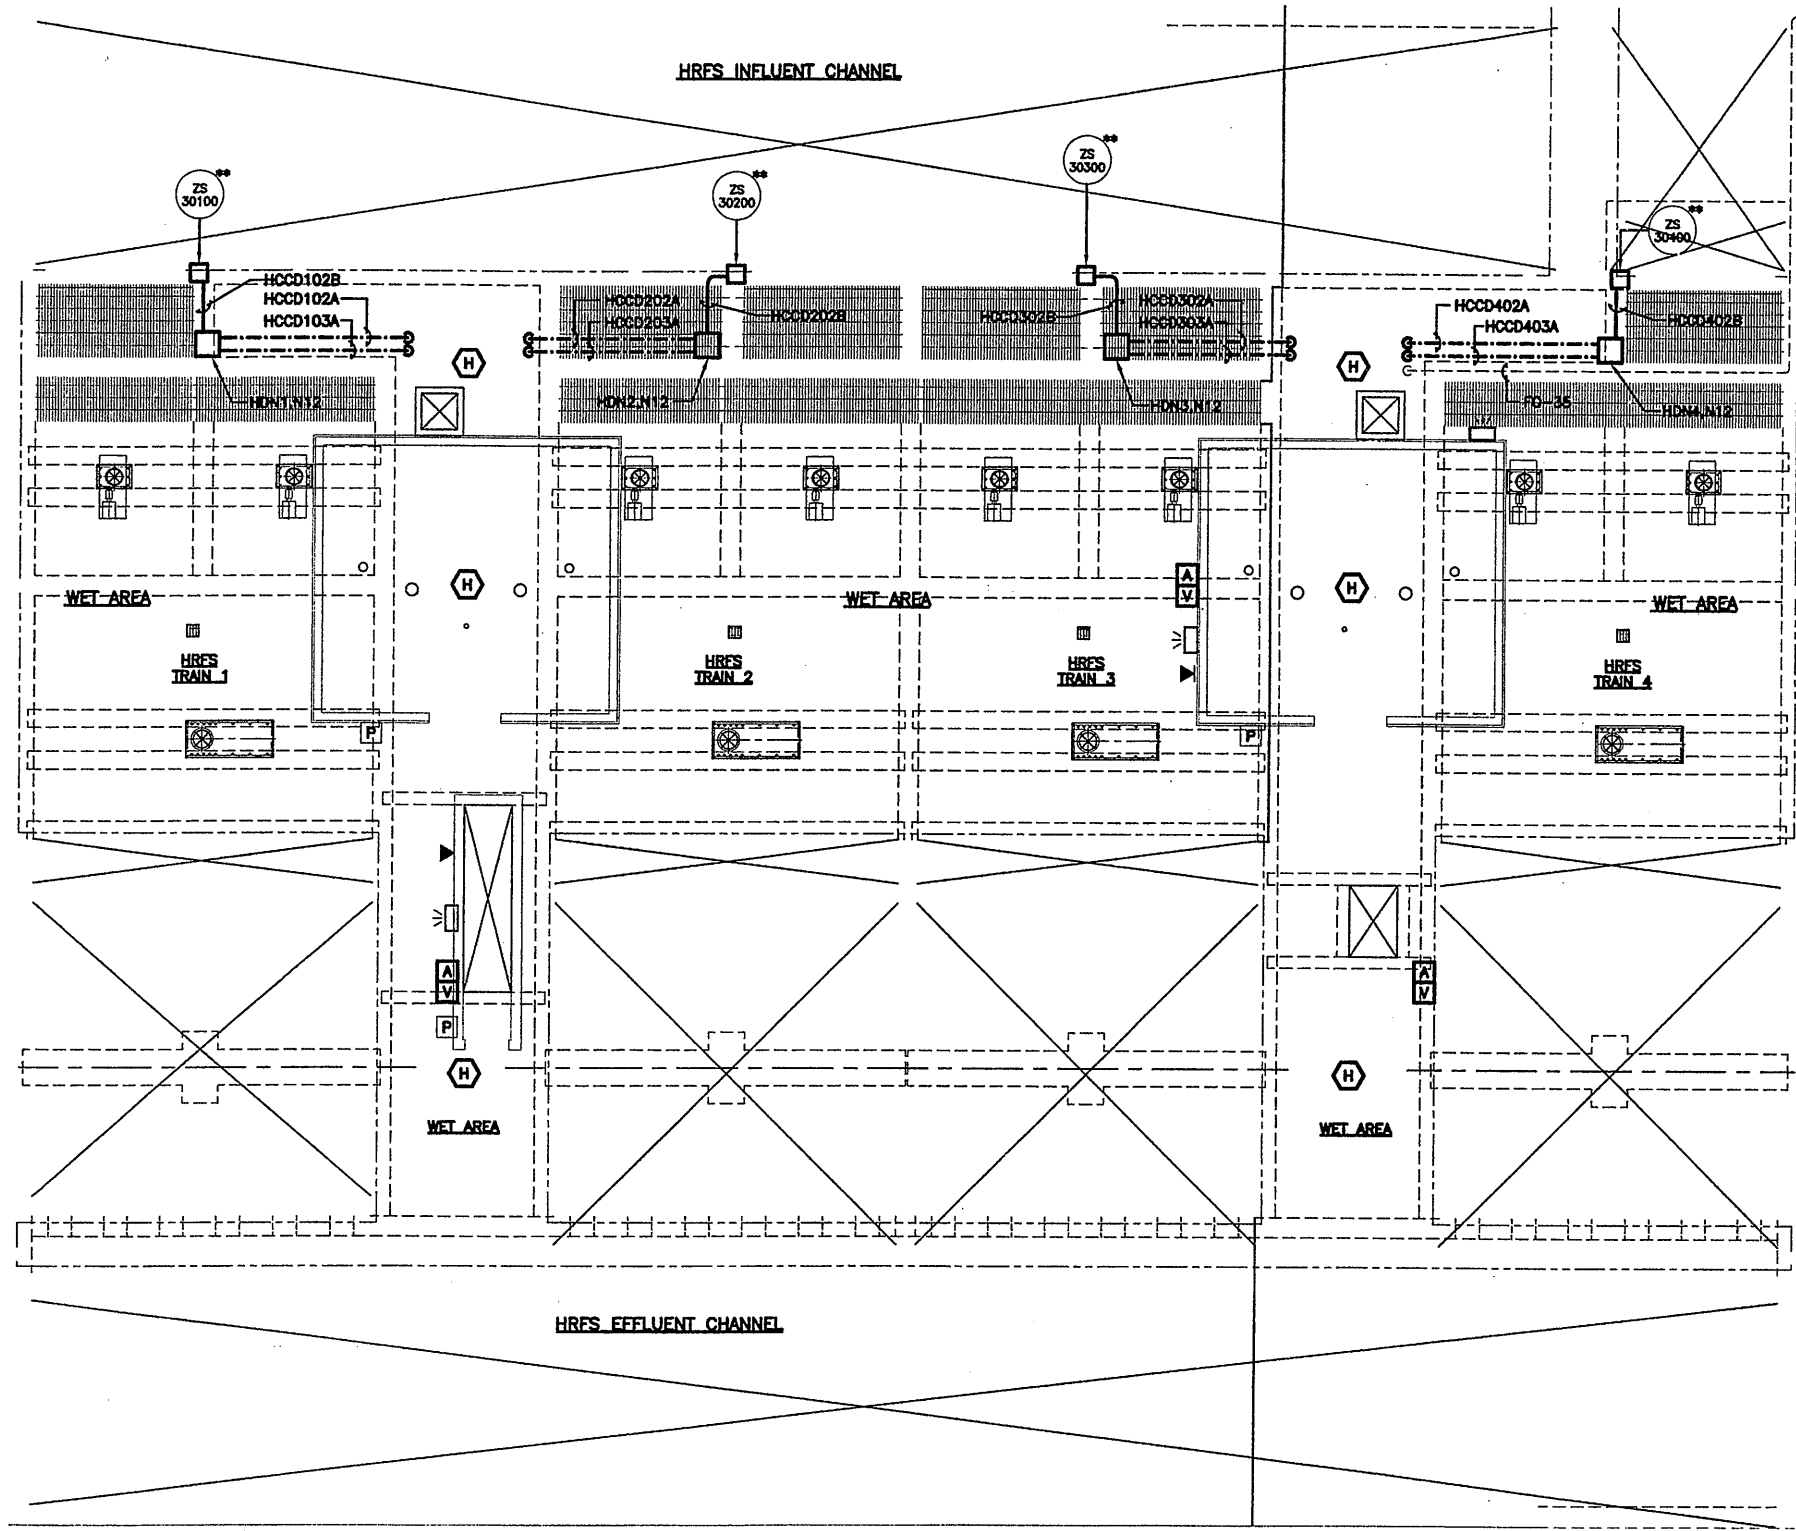

FO-35 TO SURVEILLANCE CAMERA NO. 7 (SEE DRAWING I-002)

NOTES:

1. ** INDICATES AN ITEM OR ITEMS SUPPLIED BY OWNER FOR INSTALLATION BY THE CONTRACTOR.
2. FOR CONDUIT SCHEDULES SEE DRAWINGS 1-510, 1-511, 1-512 & 1-513.
3. PROVIDE THE FOLLOWING WORK ASSOCIATED WITH HRFS SLUDGE WET WELLS NO. 1 AND 2:
 - a. COMPLETE INSTALLATION OF TWO ADDITIONAL LEVEL FLOAT SWITCHES IN HRFS SLUDGE WELL NO.1 (FURNISHED BY CONTRACT 1B). SWITCHES SHALL BE DESIGNATED LSHH-30081 AND LSL-30081. ELEVATIONS SHALL BE AS SUMMARIZED IN THE TABLE BELOW. PROVIDE CONNECTION OF EACH SWITCH TO DEVICENET INTERFACE MODULE HDN5, N3 WITH 2#14 IN 3/4" CONDUIT.
 - b. COMPLETE INSTALLATION OF FOUR LEVEL FLOAT SWITCHES IN HRFS SLUDGE WELL NO. 2 (FURNISHED BY CONTRACT 1B). SWITCHES SHALL BE DESIGNATED LSHH-30084, LSH-30084, LSL-30084 AND LSL-30084. ELEVATIONS SHALL BE AS SUMMARIZED IN THE TABLE BELOW. PROVIDE CONNECTION OF EACH SWITCH TO DEVICENET INTERFACE MODULE (ITEM 3 BELOW) WITH 2#14 IN 3/4" CONDUIT.
 - c. COMPLETE INSTALLATION OF DEVICENET INTERFACE MODULE (FURNISHED BY CONTRACT 1B) ADJACENT TO HRFS SLUDGE WELL NO. 2 IN THE HRFS NORTH GALLERY. PROVIDE CONNECTION OF MODULE TO DEVICENET NETWORK 5 DOWNSTREAM OF MODULE HDN5, N3. PROVIDE TWO BELDEN 3083A IN 1" CONDUIT ROUTED FROM HDN5, N3 TO HRFS SLUDGE WELL NO. 2 DEVICENET INTERFACE MODULE TO FACILITATE CONNECTION.
4. FLOAT LEVEL SWITCH ELEVATIONS:


| | ELEVATION |
|------------------|-----------|
| HIGH LEVEL ALARM | 381.50 |
| PUMP ON | 380.50 |
| PUMP OFF | 380.50 |
| LOW LEVEL ALARM | 379.50 |

RECORD DRAWING

THESE DRAWINGS HAVE BEEN REVISIONED TO REFLECT MAJOR CHANGES, IF ANY, WHICH OCCURRED DURING CONSTRUCTION. REVISIONS ARE BASED UPON INFORMATION SUPPLIED BY CONTRACTOR.
 DATE: 10/21/05 PER: [Signature]


HRFS UPPER LEVEL PLAN
SCALE: 1/8"=1'-0"

Layer: ON=*, OFF=*REF*
 X: 0659X302.DWG
 4/4/01 BBL DCC
 05503000/06591302.DWG

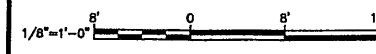

| No. | Date | Revisions | Init |
|-----|----------|---------------------|-------------|
| 0 | 4/4/01 | ISSUED FOR APPROVAL | [Signature] |
| 1 | 7/11/01 | AS BID | |
| 2 | 10/31/05 | RECORD DRAWING | |

In charge of --- TEL ---
 Designed by --- AHL ---
 Drawn by --- DCC ---
 Checked by --- TEL ---


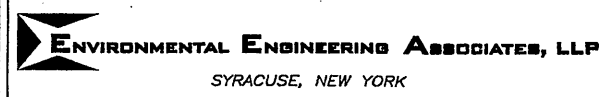


ONONDAGA COUNTY • DEPARTMENT OF DRAINAGE AND SANITATION • SYRACUSE, NEW YORK
 METROPOLITAN SYRACUSE WASTEWATER TREATMENT PLANT
 STAGE III AMMONIA AND STAGE II PHOSPHORUS REMOVAL PROJECT
HRFS COMPLEX
HRFS UPPER LEVEL PLAN




File Number
00659
 Date
APRIL 2001
 [Signature]

I-302

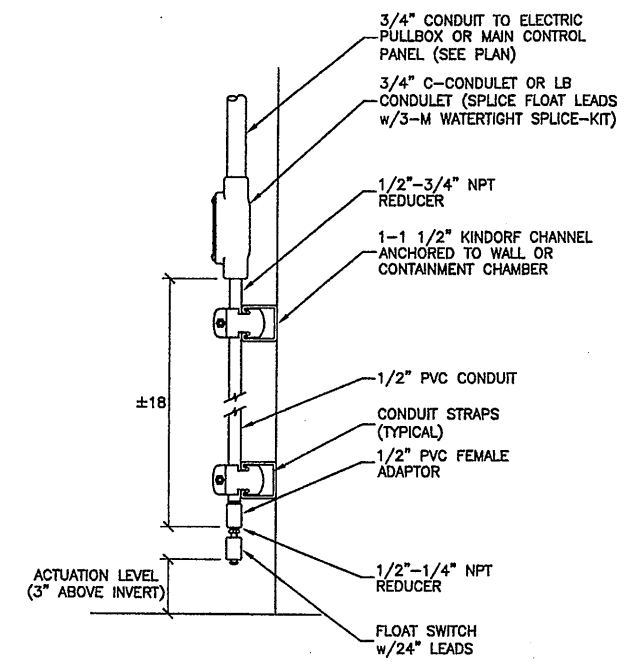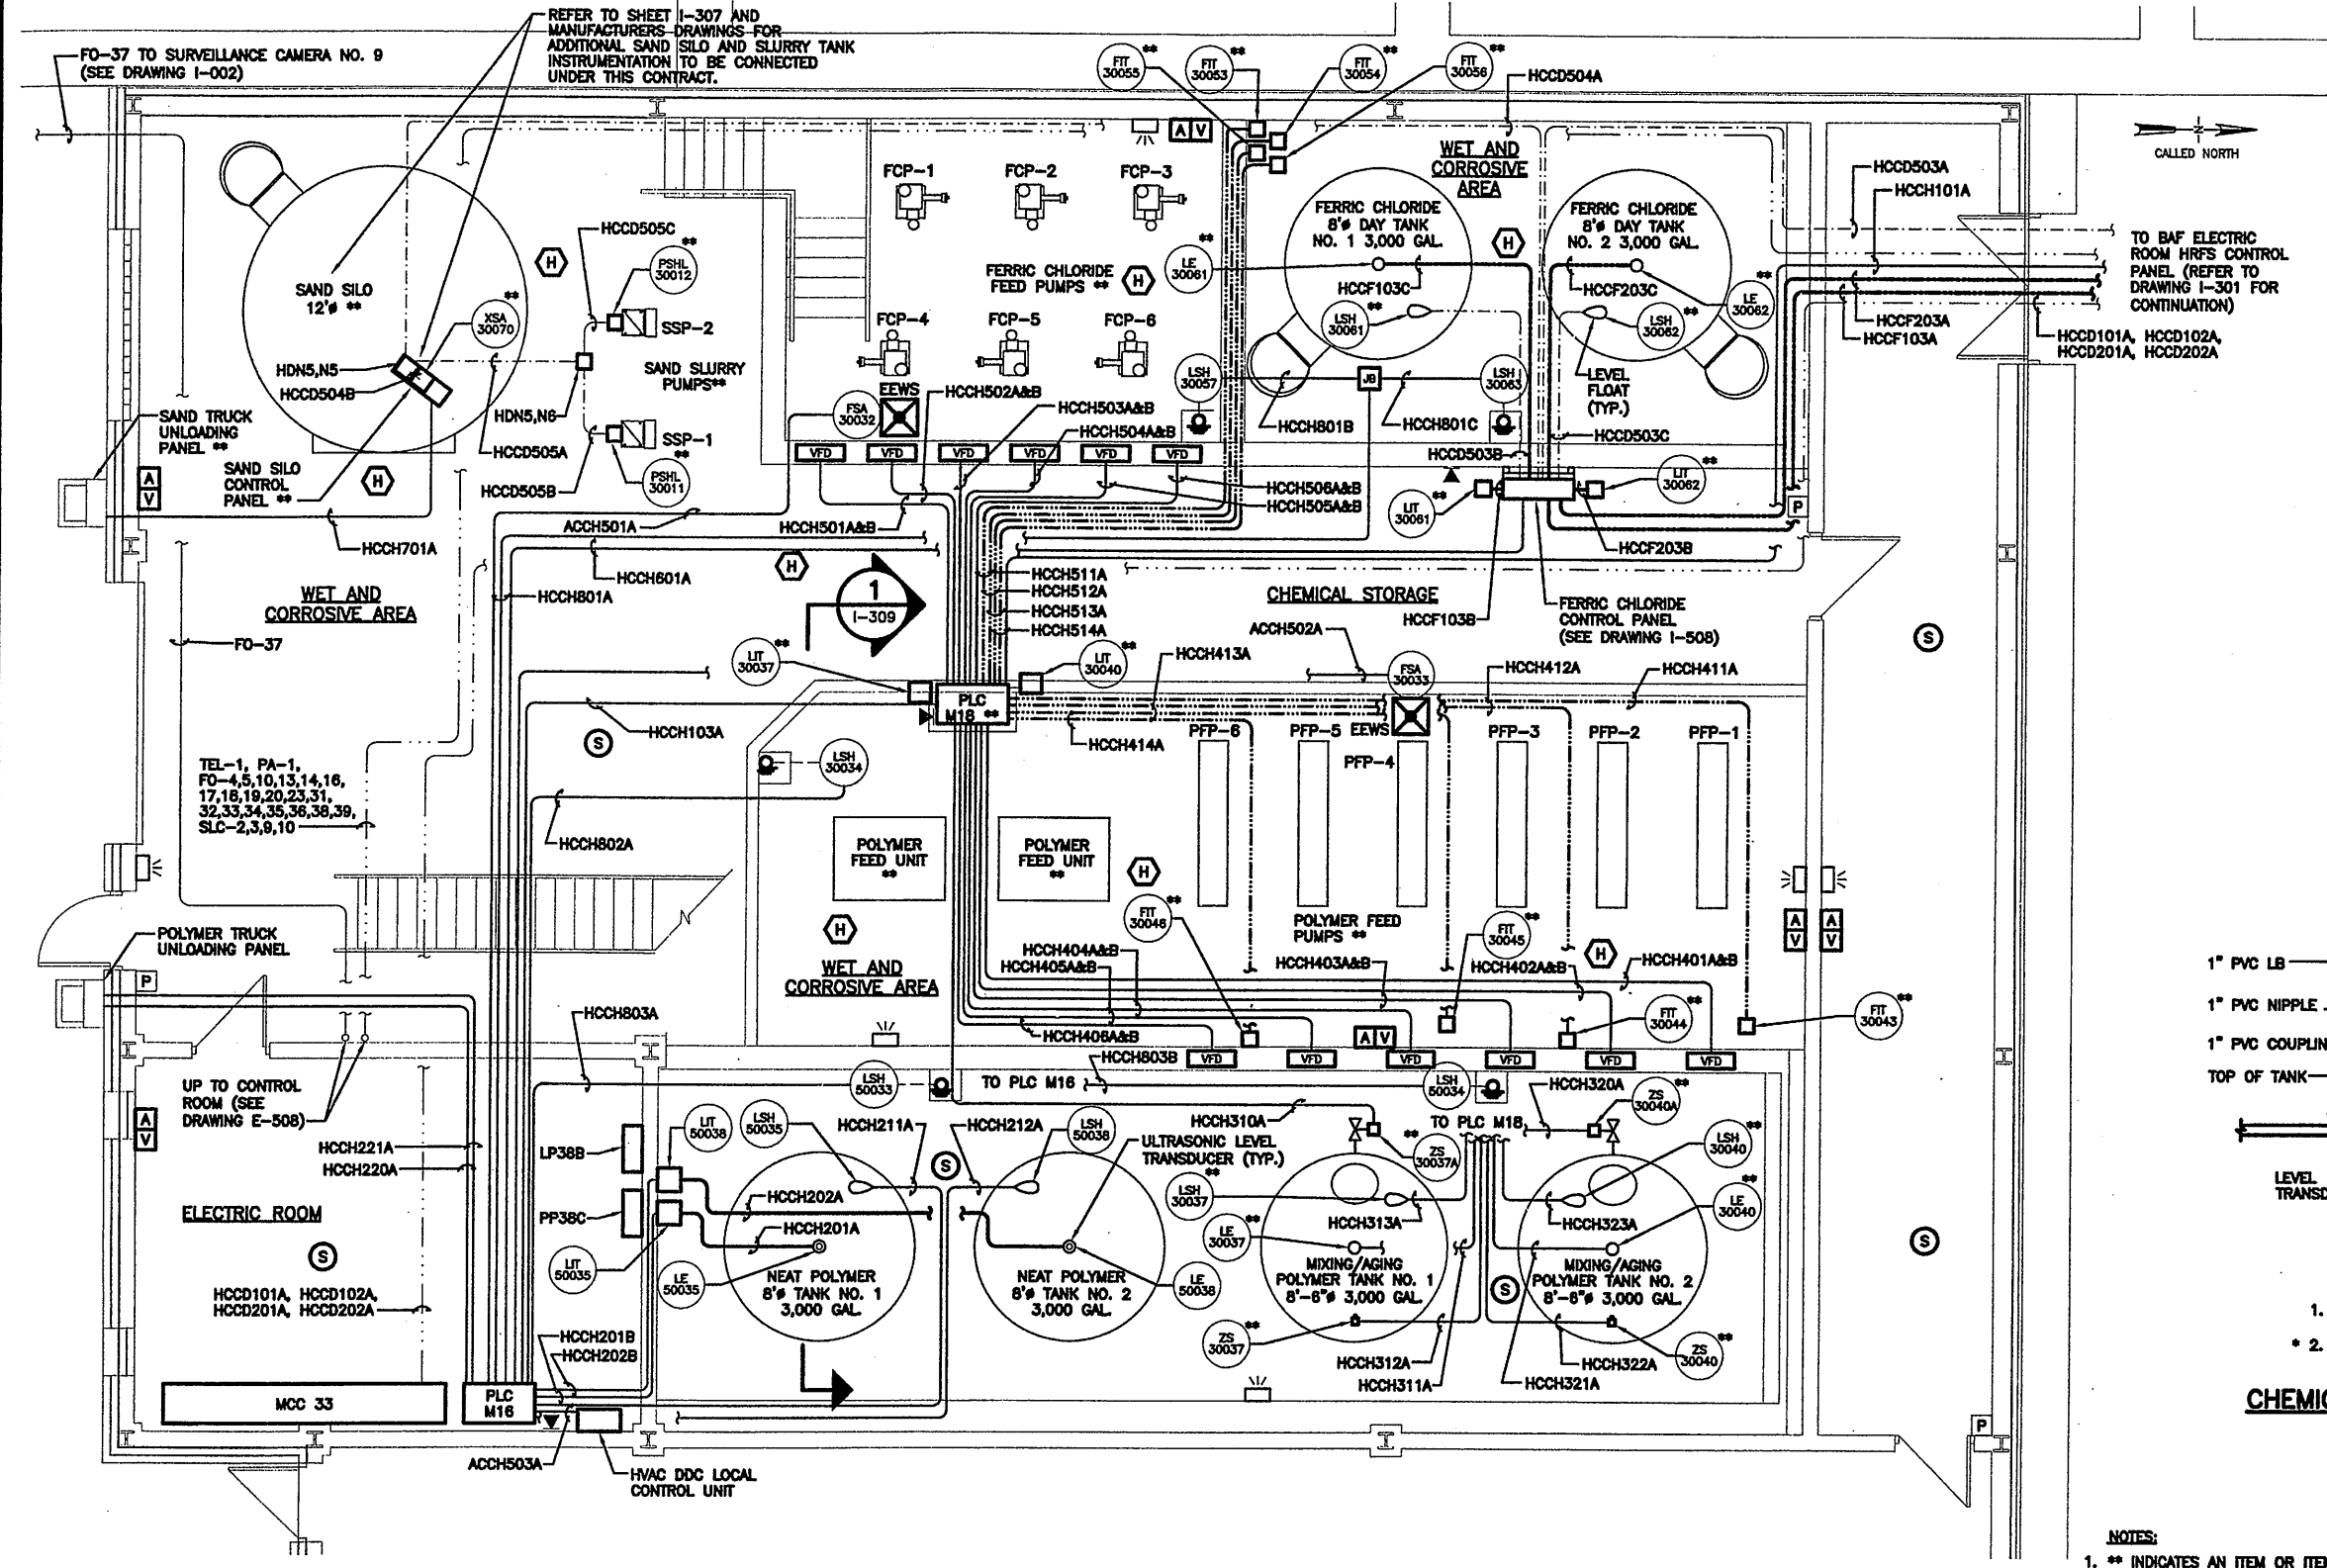

STEM TYPE FLOAT SWITCH DETAIL
 NOT TO SCALE
 TYPICAL FOR LSH-29040, LSH-29041, LSH-29042, LSH-29043, LSH-29044, LSH-29045, LSH-29046, LSH-30041, LSH-30042, LSH-30057, LSH-30063, LSH-50032, LSH-50033, LSH-50034, LSH-50106, LSH-50107

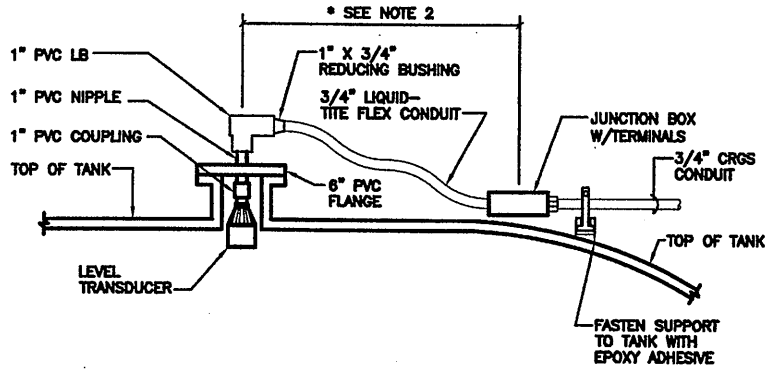

CHEMICAL STORAGE TANK LEVEL TRANSMITTER DETAIL
 NOT TO SCALE
 TYPICAL FOR LIT-30037, LIT-30040, LIT-30061, LIT-30062, LIT-50035, LIT-50038, LIT-50059A, LIT-50059B, LIT-50100, LIT-50200, LIT-50200A

CHEMICAL BUILDING C PLAN
 SCALE: 1/4"=1'-0"

- NOTES:**
- ** INDICATES AN ITEM OR ITEMS SUPPLIED BY OWNER FOR INSTALLATION BY THE CONTRACTOR.
 - FOR CONDUIT SCHEDULES SEE DRAWINGS 1-510, 1-511, 1-512 & 1-513.
 - PROVIDE 8-#14, 1-#14 GROUND IN 3/4" CONDUIT FROM PLCM18 TO FERRIC CHLORIDE PUMP DISCHARGE FLOW METERS FIT-30053, FIT-30059, FIT-30055 AND FIT-30056 (120VAC POWER).

RECORD DRAWING
 THESE DRAWINGS HAVE BEEN REVIEWED TO VERIFY MAJOR DIMENSIONS, IF ANY, WHICH OCCURRED DURING CONSTRUCTION. REVISIONS ARE BASED UPON INFORMATION SUPPLIED BY CONTRACTOR.
 DATE: 4/21/05 PER: [Signature]

THIS DRAWING WAS PREPARED AT THE SCALE INDICATED IN THE TITLE BLOCK. INACCURACIES IN THE STATED SCALE MAY BE INTRODUCED WHEN DRAWINGS ARE REPRODUCED BY ANY MEANS. USE THE GRAPHIC SCALE BAR IN THE TITLE BLOCK TO DETERMINE THE ACTUAL SCALE OF THIS DRAWING.

Layer: ON=*, OFF=**REF*
 X: 0659X501.DWG
 4/23/01 BBL DCC
 05503000/06591303.DWG

1/4"=1'-0"
 NO ALTERATIONS PERMITTED HEREON EXCEPT AS PROVIDED UNDER SECTION 7209 SUBDIVISION 2 OF THE NEW YORK STATE EDUCATION LAW


| No. | Date | Revisions | Init |
|-----|----------|---------------------|------|
| 0 | 4/20/01 | ISSUED FOR APPROVAL | TL |
| 1 | 7/11/01 | AS BID | |
| 2 | 10/31/05 | RECORD DRAWING | |

In charge of TEL
 Designed by AHL
 Drawn by DCC
 Checked by TEL

ENVIRONMENTAL ENGINEERING ASSOCIATES, LLP
 SYRACUSE, NEW YORK

ONONDAGA COUNTY • DEPARTMENT OF DRAINAGE AND SANITATION • SYRACUSE, NEW YORK
 METROPOLITAN SYRACUSE WASTEWATER TREATMENT PLANT
 STAGE III AMMONIA AND STAGE II PHOSPHORUS REMOVAL PROJECT
CHEMICAL BUILDING C
CHEMICAL BUILDING C PLAN

File Number: 00659
 Date: APRIL 2001
 I-303
 [Professional Engineer Seal]

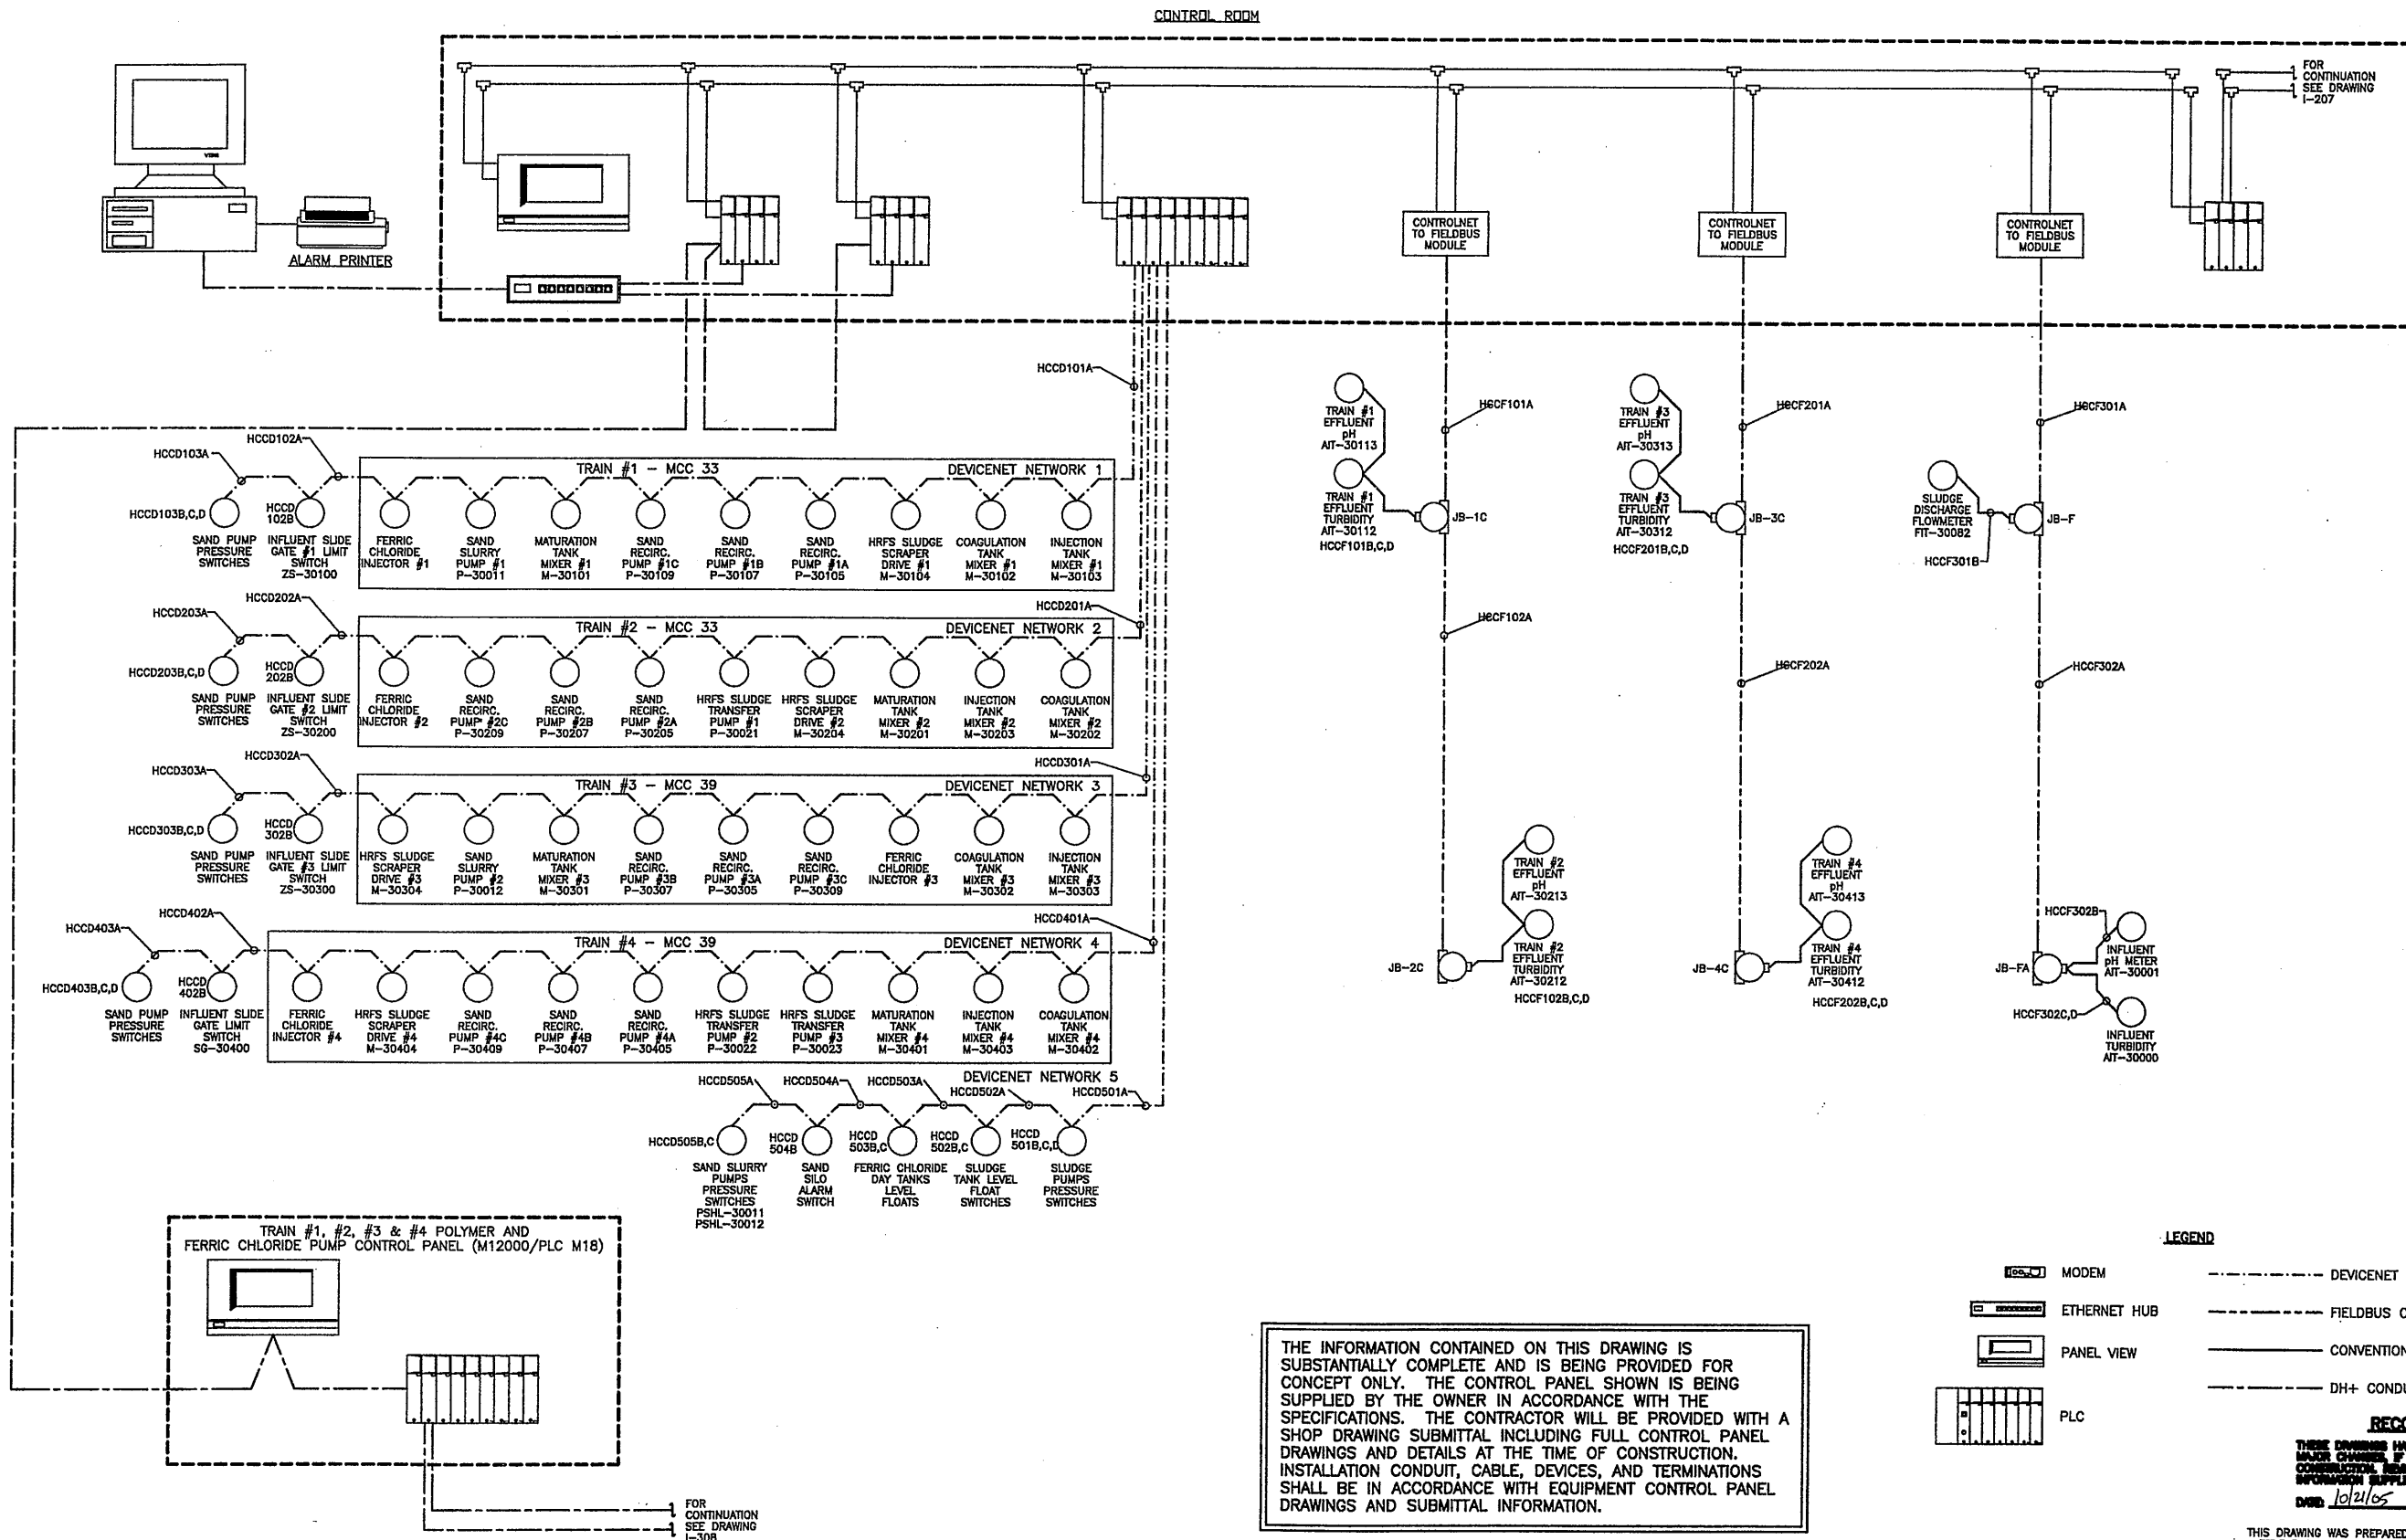

CONTROL ROOM

FOR CONTINUATION SEE DRAWING I-207

FOR CONTINUATION SEE DRAWING I-308

THE INFORMATION CONTAINED ON THIS DRAWING IS SUBSTANTIALLY COMPLETE AND IS BEING PROVIDED FOR CONCEPT ONLY. THE CONTROL PANEL SHOWN IS BEING SUPPLIED BY THE OWNER IN ACCORDANCE WITH THE SPECIFICATIONS. THE CONTRACTOR WILL BE PROVIDED WITH A SHOP DRAWING SUBMITTAL INCLUDING FULL CONTROL PANEL DRAWINGS AND DETAILS AT THE TIME OF CONSTRUCTION. INSTALLATION CONDUIT, CABLE, DEVICES, AND TERMINATIONS SHALL BE IN ACCORDANCE WITH EQUIPMENT CONTROL PANEL DRAWINGS AND SUBMITTAL INFORMATION.

- LEGEND**
- MODEM
 - ETHERNET HUB
 - PANEL VIEW
 - PLC
 - DEVICENET CONDUIT
 - FIELDBUS CONDUIT
 - CONVENTIONAL WIRING
 - DH+ CONDUIT

RECORD DRAWING
 THESE CHANGES HAVE BEEN MADE TO REFLECT MAJOR CHANGES, IF ANY, WHICH OCCURRED DURING CONSTRUCTION. REVISIONS ARE BASED UPON INFORMATION SUPPLIED BY CONTRACTOR.
 DATE 10/21/05 PER [Signature]

THIS DRAWING WAS PREPARED AT THE SCALE INDICATED IN THE TITLE BLOCK. INACCURACIES IN THE STATED SCALE MAY BE INTRODUCED WHEN DRAWINGS ARE REPRODUCED BY ANY MEANS. USE THE GRAPHIC SCALE BAR IN THE TITLE BLOCK TO DETERMINE THE ACTUAL SCALE OF THIS DRAWING.

Layer: ON=*; OFF=*REF*
 01/18/01 OBG JEC
 EEA-VERT

| No. | Date | Revisions | Init |
|-----|----------|---------------------|------|
| 0 | 4/20/01 | ISSUED FOR APPROVAL | LC |
| 1 | 7/11/01 | AS BID | |
| 2 | 10/31/05 | RECORD DRAWING | |

In charge of PLD
 Designed by SAT
 Drawn by JEC
 Checked by PLD

ENVIRONMENTAL ENGINEERING ASSOCIATES, LLP
 SYRACUSE, NEW YORK


ONONDAGA COUNTY • DEPARTMENT OF DRAINAGE AND SANITATION • SYRACUSE, NEW YORK
 METROPOLITAN SYRACUSE WASTEWATER TREATMENT PLANT
 STAGE III AMMONIA AND STAGE II PHOSPHORUS REMOVAL PROJECT
HRFS (PLC M17)
INTERCONNECTION DRAWING
 INSTRUMENTATION

File Number
00659
 Date
APRIL 2001
1-304

[Professional Engineer Seal: LEONARD J. CAMPOLIT, No. 60765, LICENSED PROFESSIONAL ENGINEER]

[Signature]

NO ALTERATIONS PERMITTED HEREON EXCEPT AS PROVIDED UNDER SECTION 7209 SUBDIVISION 2 OF THE NEW YORK STATE EDUCATION LAW

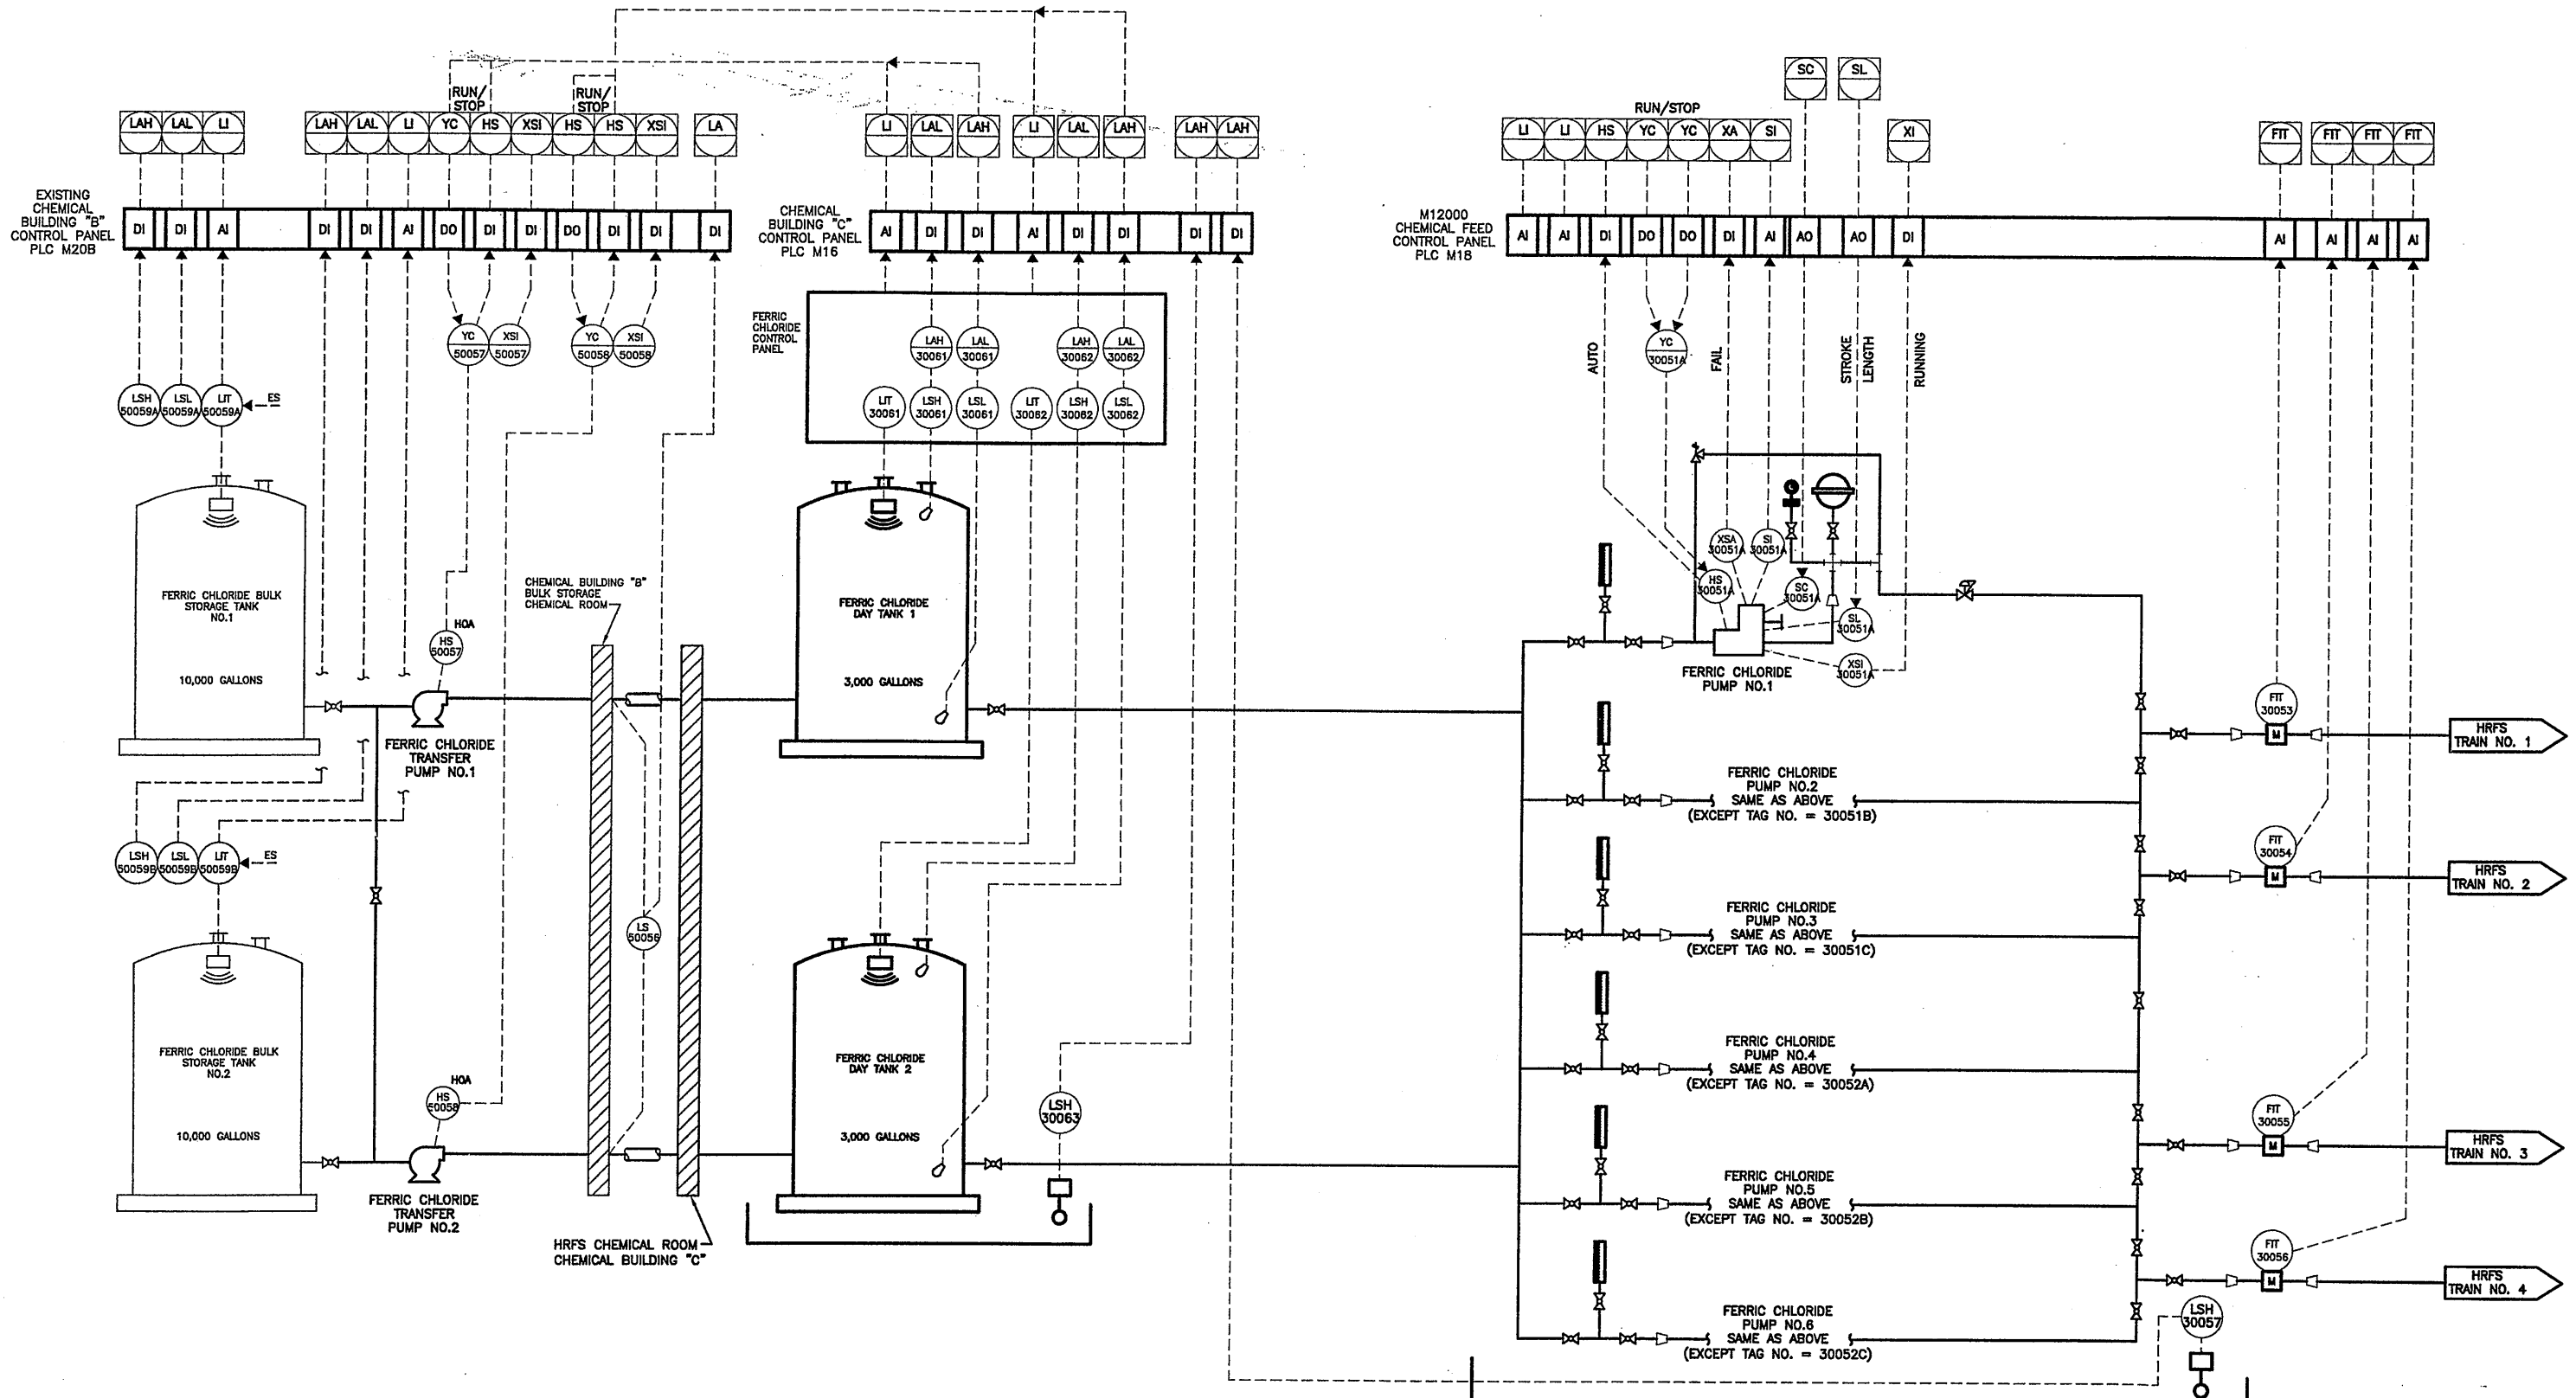

Layer: ON=""; OFF="REF"
 02/01/01 OBG JEC
 05503046/05591501.DWG

NOT TO SCALE

NO ALTERATIONS PERMITTED HEREON EXCEPT AS PROVIDED UNDER SECTION 7209 SUBDIVISION 2 OF THE NEW YORK STATE EDUCATION LAW

| No. | Date | Revisions | Init |
|-----|----------|---------------------|------|
| 0 | 4/20/01 | ISSUED FOR APPROVAL | PLD |
| 1 | 7/11/01 | ISSUED FOR BID | SAT |
| 2 | 10/31/03 | RECORD DRAWING | JEC |

In charge of PLD
 Designed by SAT
 Drawn by JEC
 Checked by PLD



ONONDAGA COUNTY • DEPARTMENT OF DRAINAGE AND SANITATION • SYRACUSE, NEW YORK
 METROPOLITAN SYRACUSE WASTEWATER TREATMENT PLANT
 STAGE III AMMONIA AND STAGE II PHOSPHORUS REMOVAL PROJECT


FERRIC CHLORIDE FEED CONTROL DIAGRAM
 INSTRUMENTATION

ONONDAGA COUNTY PROFESSIONAL ENGINEER
 LEGAL SEAL OF NEW YORK STATE
 LEONARD J. CAMPOLITO
 No. 80755

File Number 00659
 Date APRIL 2001
 1-305

RECORD DRAWING
 THESE DRAWINGS HAVE BEEN REVISIONED TO REFLECT MAJOR CHANGES, IF ANY, WHICH OCCURRED DURING CONSTRUCTION. REVISIONS ARE BASED UPON INFORMATION SUPPLIED BY CONTRACTOR.
 DATE 10/24/05 FOR Campolito

THIS DRAWING WAS PREPARED AT THE SCALE INDICATED IN THE TITLE BLOCK. INACCURACIES IN THE STATED SCALE MAY BE INTRODUCED WHEN DRAWINGS ARE REPRODUCED BY ANY MEANS. USE THE GRAPHIC SCALE BAR IN THE TITLE BLOCK TO DETERMINE THE ACTUAL SCALE OF THIS DRAWING.

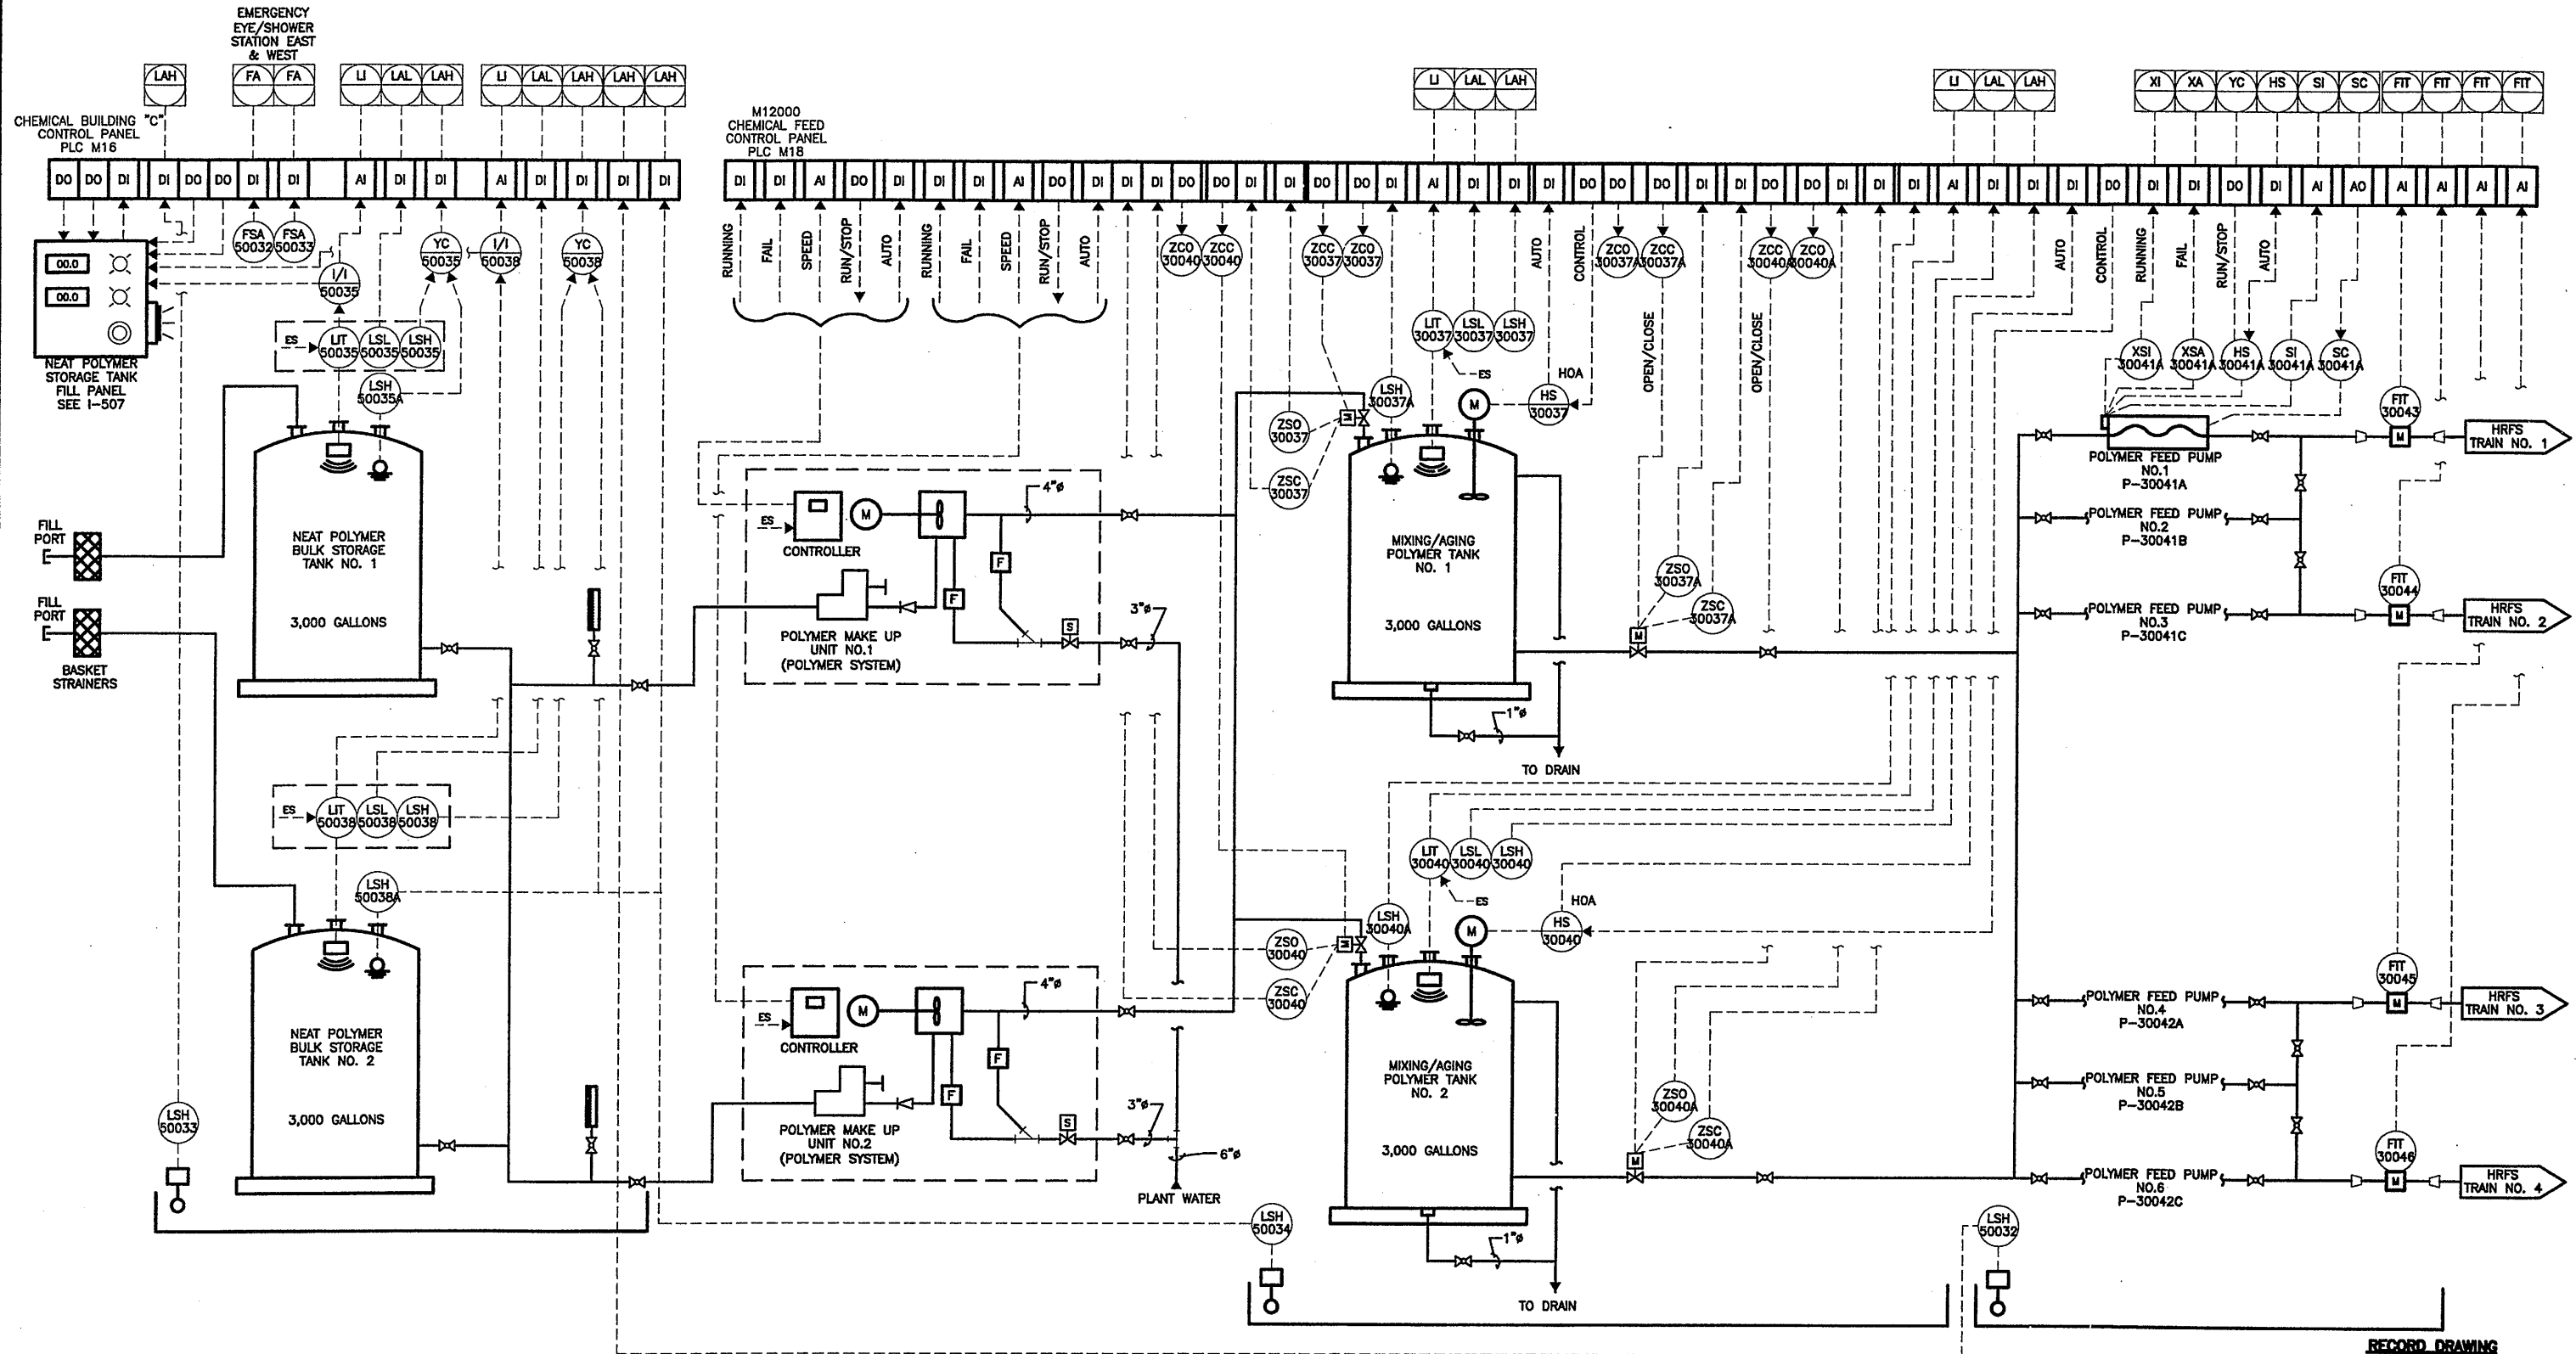

RECORD DRAWING

THIS DRAWING HAS BEEN REVISED TO REFLECT MAJOR CHANGES IF ANY, WHICH OCCURRED DURING CONSTRUCTION. REVISIONS ARE BASED UPON INFORMATION SUPPLIED BY CONTRACTOR.
 DATE: 10/21/05 FOR: [Signature]

THIS DRAWING WAS PREPARED AT THE SCALE INDICATED IN THE TITLE BLOCK. INACCURACIES IN THE STATED SCALE MAY BE INTRODUCED WHEN DRAWINGS ARE REPRODUCED BY ANY MEANS. USE THE GRAPHIC SCALE BAR IN THE TITLE BLOCK TO DETERMINE THE ACTUAL SCALE OF THIS DRAWING.

Layer: ON=*, OFF=REF*
 02/01/01 OBG JEC
 05503046/08591306.DWG

NOT TO SCALE

NO ALTERATIONS PERMITTED HEREON EXCEPT AS PROVIDED UNDER SECTION 7209 SUBDIVISION 2 OF THE NEW YORK STATE EDUCATION LAW

| No. | Date | Revisions | Init |
|-----|----------|---------------------|------|
| 0 | 4/20/01 | ISSUED FOR APPROVAL | PLD |
| 1 | 7/11/01 | AS BID | SAT |
| 2 | 10/31/05 | RECORD DRAWING | JEC |


In charge of: PLD
 Designed by: SAT
 Drawn by: JEC
 Checked by: PLD



ONONDAGA COUNTY • DEPARTMENT OF DRAINAGE AND SANITATION • SYRACUSE, NEW YORK
 METROPOLITAN SYRACUSE WASTEWATER TREATMENT PLANT
 STAGE III AMMONIA AND STAGE II PHOSPHORUS REMOVAL PROJECT

POLYMER FEED CONTROL DIAGRAM



INSTRUMENTATION

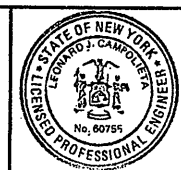

File Number: 00659
 Date: APRIL 2001
 [Signature]

CONTROL ROOM

FOR CONTINUATION
SEE DRAWING I-304

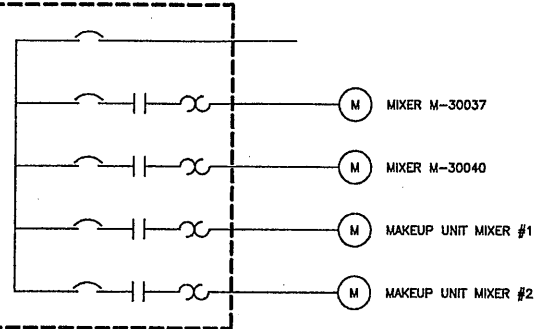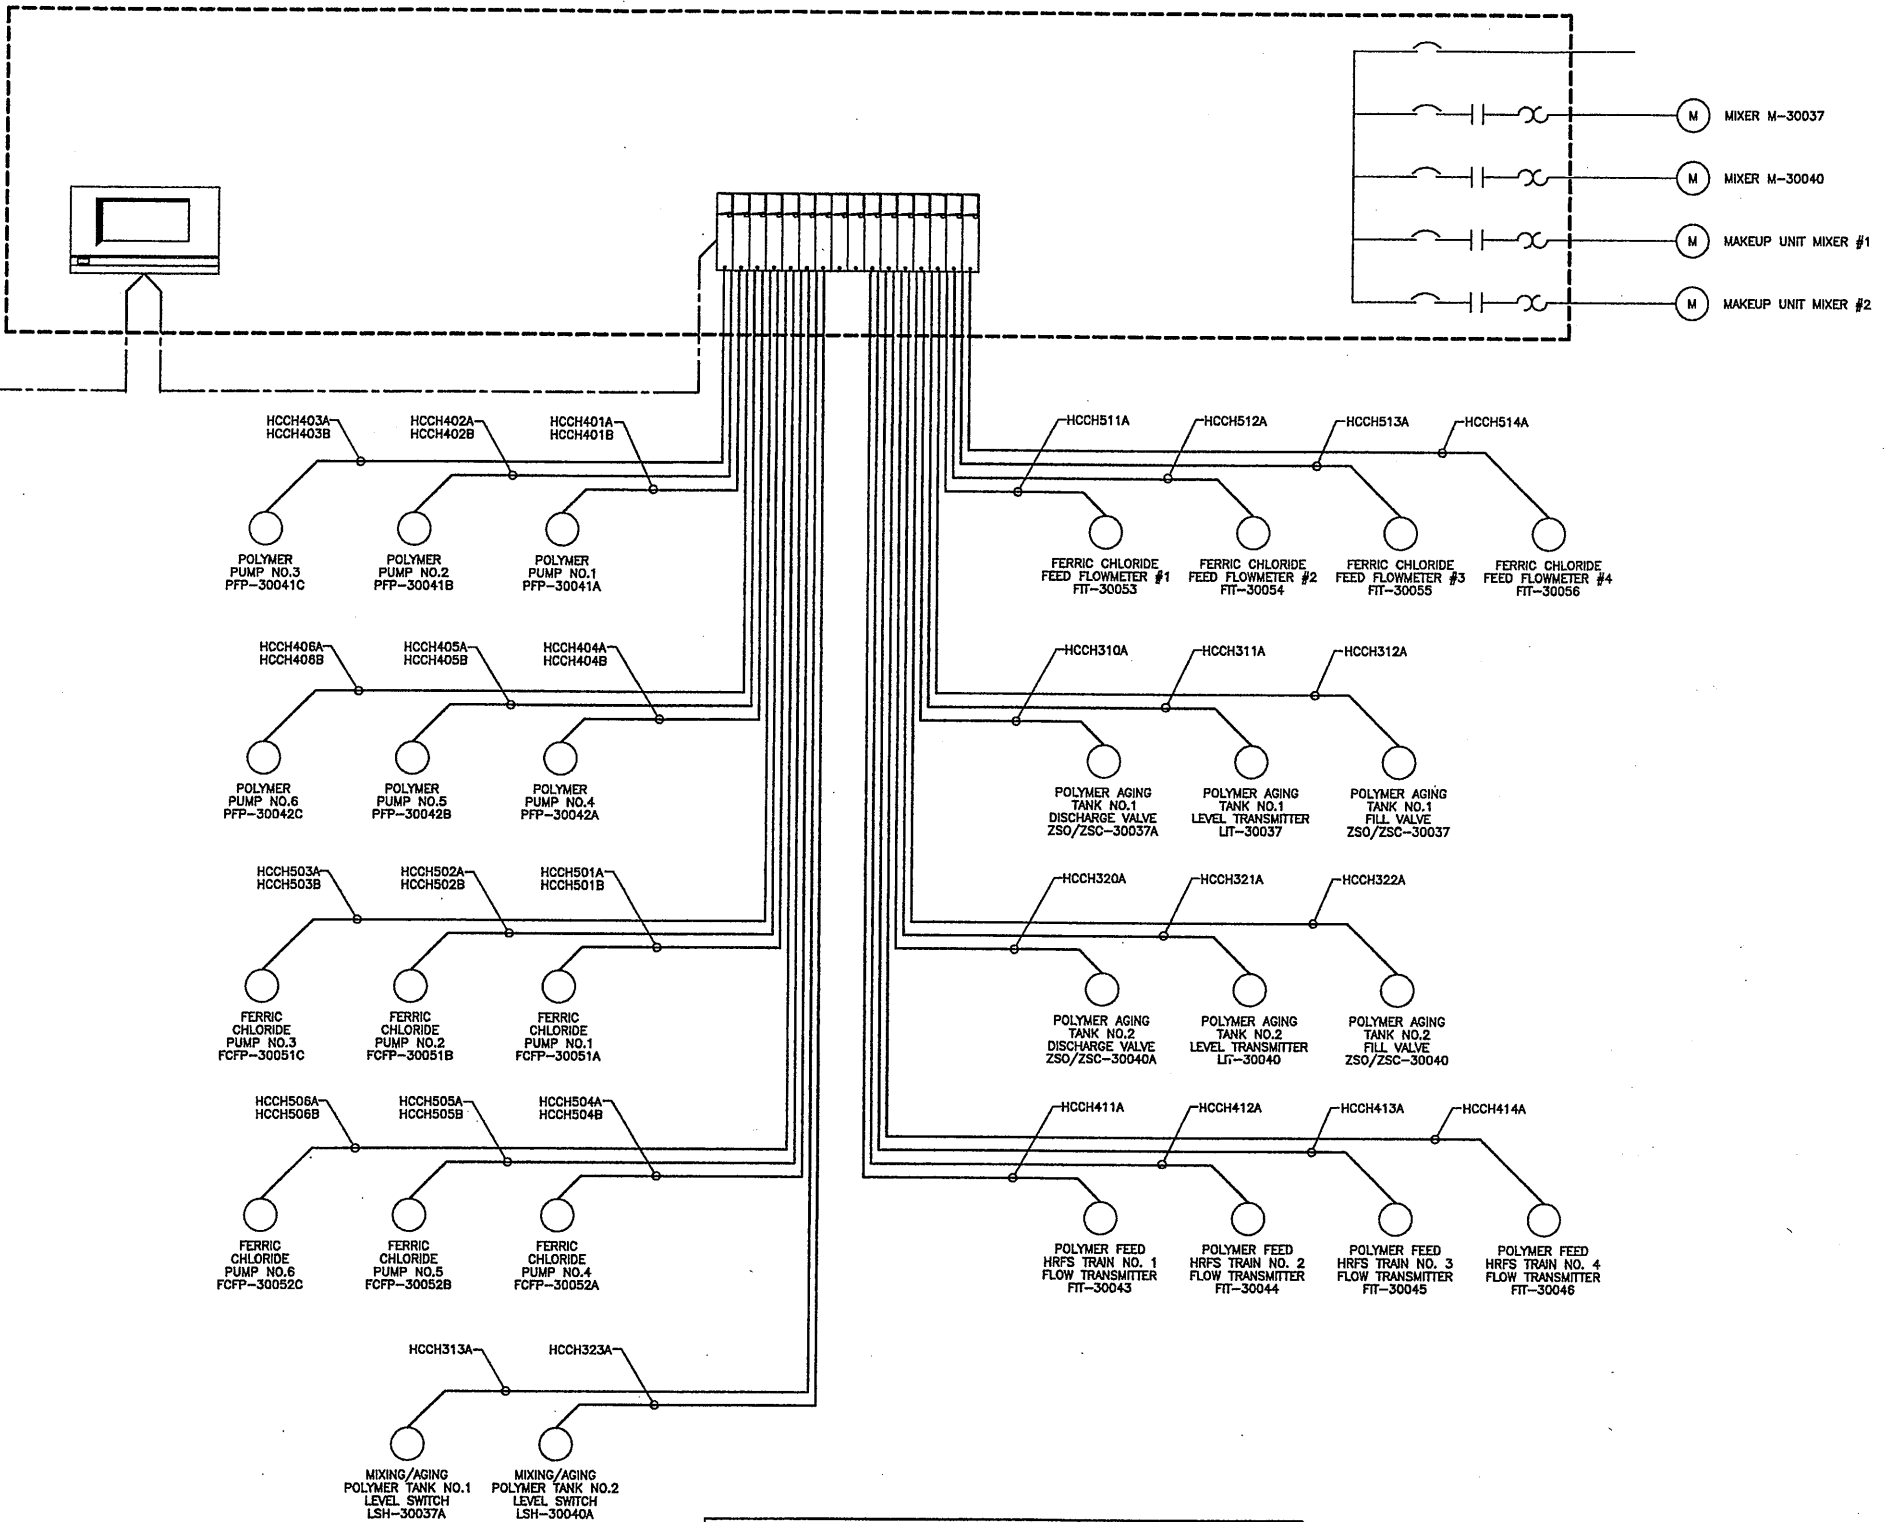

THE INFORMATION CONTAINED ON THIS DRAWING IS SUBSTANTIALLY COMPLETE AND IS BEING PROVIDED FOR CONCEPT ONLY. THE CONTROL PANEL SHOWN IS BEING SUPPLIED BY THE OWNER IN ACCORDANCE WITH THE SPECIFICATIONS. THE CONTRACTOR WILL BE PROVIDED WITH A SHOP DRAWING SUBMITTAL INCLUDING FULL CONTROL PANEL DRAWINGS AND DETAILS AT THE TIME OF CONSTRUCTION. INSTALLATION CONDUIT, CABLE, DEVICES, AND TERMINATIONS SHALL BE IN ACCORDANCE WITH EQUIPMENT CONTROL PANEL DRAWINGS AND SUBMITTAL INFORMATION.

- LEGEND**
- MODEM
 - ETHERNET HUB
 - PANEL VIEW
 - PLC
 - DEVCENET CONDUIT
 - FIELDBUS CONDUIT
 - CONVENTIONAL WIRING
 - DH+ CONDUIT

RECORD DRAWING
 THESE DRAWINGS HAVE BEEN REVISIONED TO REFLECT
 MAJOR CHANGES, IF ANY, WHICH OCCURRED DURING
 CONSTRUCTION. REVISIONS ARE BASED UPON
 INFORMATION SUPPLIED BY CONTRACTOR.
 DATE: 10/21/05 PER: J. Campoliet

THIS DRAWING WAS PREPARED AT THE SCALE INDICATED IN THE TITLE BLOCK. INACCURACIES IN THE STATED SCALE MAY BE INTRODUCED WHEN DRAWINGS ARE REPRODUCED BY ANY MEANS. USE THE GRAPHIC SCALE BAR IN THE TITLE BLOCK TO DETERMINE THE ACTUAL SCALE OF THIS DRAWING.

Layer: ON=*, OFF=*REF*
 02/01/01 OBG JEC
 EEA-VERT

| No. | Date | Revisions | Init |
|-----|----------|---------------------|------|
| 0 | 4/20/01 | ISSUED FOR APPROVAL | LE |
| 1 | 7/11/01 | AS BID | |
| 2 | 10/31/05 | RECORD DRAWING | |

In charge of... PLD
 Designed by... SAT
 Drawn by... JEC
 Checked by... PLD



ONONDAGA COUNTY • DEPARTMENT OF DRAINAGE AND SANITATION • SYRACUSE, NEW YORK
 METROPOLITAN SYRACUSE WASTEWATER TREATMENT PLANT
 STAGE III AMMONIA AND STAGE II PHOSPHORUS REMOVAL PROJECT


**M12000 HRFS CHEMICAL FEED (PLC M18)
 INTERCONNECTION DRAWING**
 INSTRUMENTATION



File Number
 00659
 Date
 APRIL 2001
 J. Campoliet

I-308


NO ALTERATIONS PERMITTED HEREON EXCEPT AS PROVIDED UNDER SECTION 7209 SUBDIVISION 2 OF THE NEW YORK STATE EDUCATION LAW

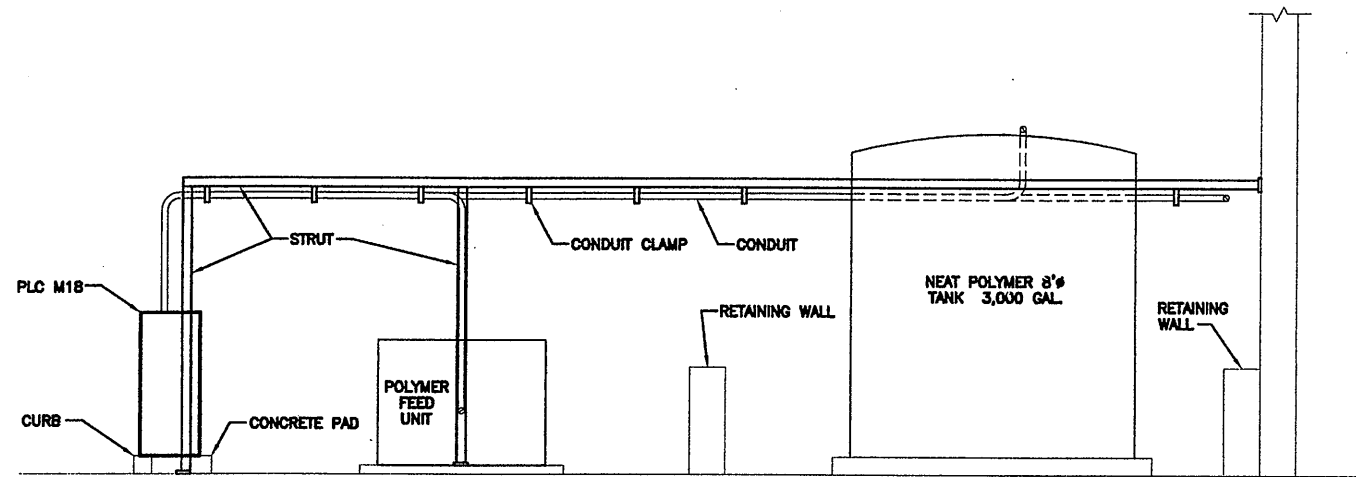

CONDUIT MOUNTING DETAIL 1
 SCALE: 3/8"=1'-0"

Layer: ON=*; OFF=*REF*

4/4/00 BBL DCC
 05503000/06591309.DWG

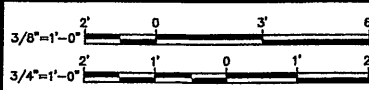

NO ALTERATIONS PERMITTED HEREON EXCEPT AS PROVIDED UNDER SECTION 7209 SUBDIVISION 2 OF THE NEW YORK STATE EDUCATION LAW

| No. | Date | Revisions | Init |
|-----|----------|---------------------|------|
| 0 | 4/20/01 | ISSUED FOR APPROVAL | TEL |
| 1 | 7/11/01 | AS BID | |
| 2 | 10/31/05 | RECORD DRAWING | |

In charge of TEL
 Designed by MEE
 Drawn by DCC
 Checked by WSH



ONONDAGA COUNTY • DEPARTMENT OF DRAINAGE AND SANITATION • SYRACUSE, NEW YORK
 METROPOLITAN SYRACUSE WASTEWATER TREATMENT PLANT
 STAGE III AMMONIA AND STAGE II PHOSPHORUS REMOVAL PROJECT
CHEMICAL BUILDING C
INSTRUMENTATION MOUNTING DETAILS

INSTRUMENTATION



File Number
00659
 Date
APRIL 2001
L. Campollet



1-309

RECORD DRAWING

THESE DRAWINGS HAVE BEEN REVISIONED TO REFLECT MAJOR CHANGES. IF ANY, WHICH OCCURRED DURING CONSTRUCTION. REVISIONS ARE BASED UPON INFORMATION SUPPLIED BY CONTRACTOR.


DATE: 10/21/05 PER: L. Campollet

THIS DRAWING WAS PREPARED AT THE SCALE INDICATED IN THE TITLE BLOCK. INACCURACIES IN THE STATED SCALE MAY BE INTRODUCED WHEN DRAWINGS ARE REPRODUCED BY ANY MEANS. USE THE GRAPHIC SCALE BAR IN THE TITLE BLOCK TO DETERMINE THE ACTUAL SCALE OF THIS DRAWING.

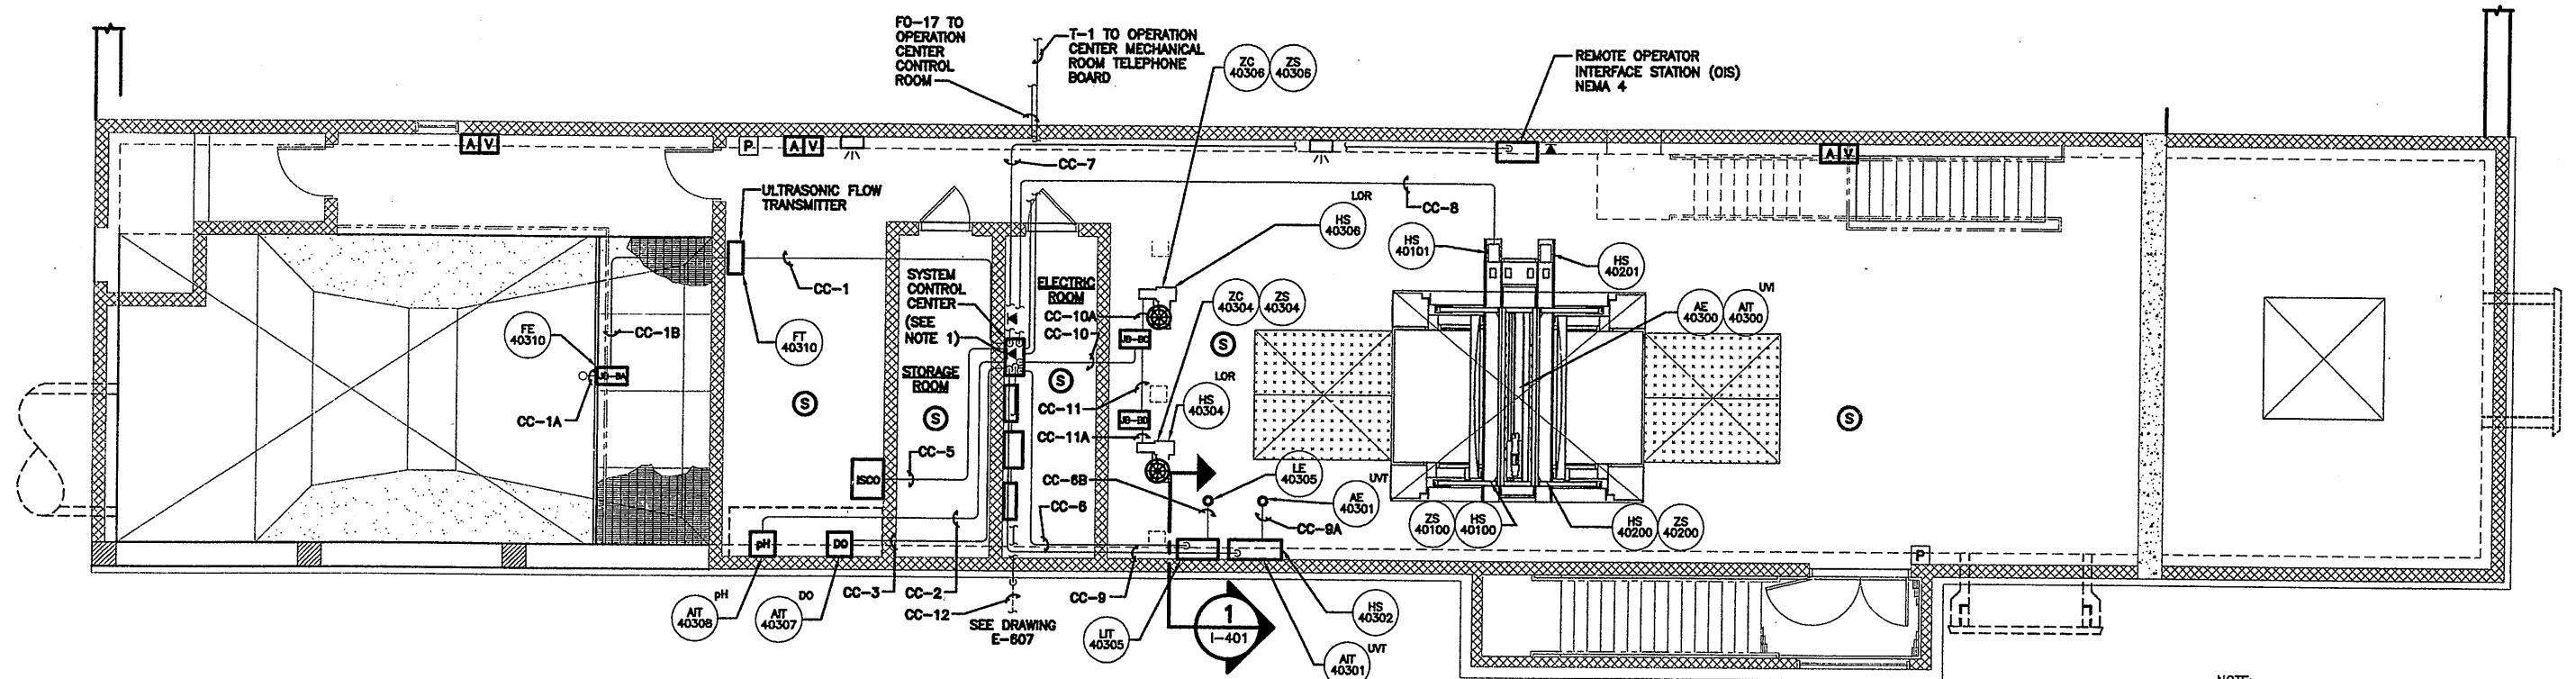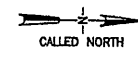

INSTRUMENTATION PLAN
SCALE: 3/16"=1'-0"

NOTE:
1. LOCATE TELEPHONE JACK WITHIN UV SYSTEM CONTROL CENTER FOR REMOTE DIAL-IN CONNECTION.

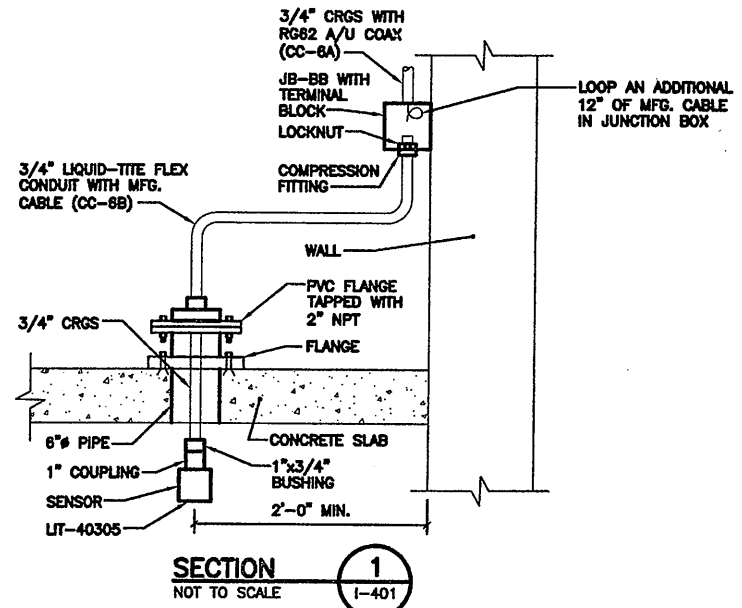


| CIRCUIT/CONDUIT SCHEDULE | | | | |
|--------------------------|------------------|---------------------|--|---|
| CKT. NO. | CONDUIT SIZE | NO./SIZE CONDUCTORS | FROM | TO |
| CC-1 | 3/4" CRGS | 1 TPS #16 | SYSTEM CONTROL CENTER (SCC) | ULTRASONIC FLOW TRANSMITTER (AIT-40310) |
| CC-1A | 3/4" CRGS | RG 62 A/U | ULTRASONIC FLOW TRANSMITTER (AIT-40310) | JB-BA ON RAILING |
| CC-1B | 3/4" LIQUID-TITE | MFG. CABLE | JB-BA ON RAILING | ULTRASONIC FLOW TRANSDUCER (AE-40310) |
| CC-2 | 3/4" CRGS | 1-16 TSP | SYSTEM CONTROL CENTER (SCC) | pH ANALYZER (AIT-40308) |
| CC-3 | 3/4" CRGS | 1-16 TSP | SYSTEM CONTROL CENTER (SCC) | DO ANALYZER (AIT-40307) |
| CC-5 | 3/4" CRGS | | SYSTEM CONTROL CENTER (SCC) | ISCO SAMPLER |
| CC-6 | 3/4" CRGS | 1 TPS #16 | SYSTEM CONTROL CENTER (SCC) | ULTRASONIC LEVEL TRANSMITTER (LIT-40305) |
| CC-8A | 3/4" CRGS | RG 62 A/U | ULTRASONIC LEVEL TRANSMITTER (LIT-40305) | JB-BB ON WALL |
| CC-8B | 3/4" LIQUID-TITE | 1 TPS #16 | JB-BB ON WALL | ULTRASONIC LEVEL TRANSDUCER (LE-40305) |
| CC-7 | 3/4" CRGS | | SYSTEM CONTROL CENTER (SCC) | REMOTE OPERATOR INTERFACE |
| CC-8 | 3/4" CRGS | 2 TPS #16 | SYSTEM CONTROL CENTER (SCC) | UV REACTOR POWER DIST. CENTER (PDC) |
| CC-8 | 3/4" CRGS | 1 TPS #16 | SYSTEM CONTROL CENTER (SCC) | ON-LINE TRANSMISSION UNIT (LVT) (AIT-40301) |
| CC-8A | 3/4" LIQUID-TITE | MFG. CABLE | LVT (AIT-40301) | LVT SENSOR (AE-40301) |
| CC-11 | 1" CRGS | 8 #14 | SYSTEM CONTROL CENTER (SCC) | JB-BC BY WEIR GATE NO. 2 |
| CC-10 | 3/4" LIQUID-TITE | 1 TPS | JB-BC BY WEIR GATE NO. 2 | WEIR GATE NO. 2 (HS-40306) |
| CC-1A | 3/4" CRGS | 8 #14 | JB-BC BY WEIR GATE NO. 2 | JB-BD BY WEIR GATE NO. 1 |
| CC-10A | 3/4" LIQUID-TITE | 1 TPS | JB-BD BY WEIR GATE NO. 1 | WEIR GATE NO. 1 (HS-40304) |
| CC-12 | 1-1/2" CRGS | 8 #14 | SYSTEM CONTROL CENTER (SCC) | GATE RECEIVER |
| T-1 | 1" CRGS | 2 #22 | SYSTEM CONTROL CENTER (SCC) | TELEPHONE BOARD/JACK |
| CC-13 | 3/4" CRGS | 4 #12, 1 #12G | SYSTEM CONTROL CENTER (SCC) | REMOTE OPERATOR INTERFACE |

RECORD DRAWING

THESE DRAWINGS HAVE BEEN REVIEWED TO REFLECT MAJOR CHANGES, IF ANY, WHICH OCCURRED DURING CONSTRUCTION. REVISIONS ARE BASED UPON INFORMATION SUPPLIED BY CONTRACTOR.
DATE: 10/11/01 PBR: [Signature]

THIS DRAWING WAS PREPARED AT THE SCALE INDICATED IN THE TITLE BLOCK. INACCURACIES IN THE STATED SCALE MAY BE INTRODUCED WHEN DRAWINGS ARE REPRODUCED BY ANY MEANS. USE THE GRAPHIC SCALE BAR IN THE TITLE BLOCK TO DETERMINE THE ACTUAL SCALE OF THIS DRAWING.

Layer: ON=*; OFF=*REF*
X: 0659X402.DWG
4/13/01 BBL DCC
06503000/0659401.DWG

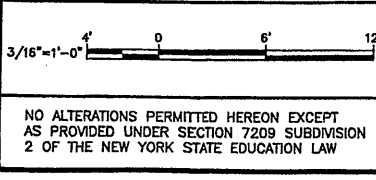

| No. | Date | Revisions | Init |
|-----|----------|---------------------|-------------|
| 0 | 4/20/01 | ISSUED FOR APPROVAL | [Signature] |
| 1 | 7/11/01 | AS BID | |
| 2 | 10/31/05 | RECORD DRAWING | |


In charge of --- TEL
Designed by --- AHL
Drawn by --- DCC
Checked by --- TEL



ONONDAGA COUNTY • DEPARTMENT OF DRAINAGE AND SANITATION • SYRACUSE, NEW YORK
METROPOLITAN SYRACUSE WASTEWATER TREATMENT PLANT
STAGE III AMMONIA AND STAGE II PHOSPHORUS REMOVAL PROJECT
UV DISINFECTION
UV DISINFECTION/PARSHALL FLUME
INSTRUMENTATION PLAN AND DETAIL
INSTRUMENTATION



File Number
00659
Date
APRIL 2001
1-401
[Signature]

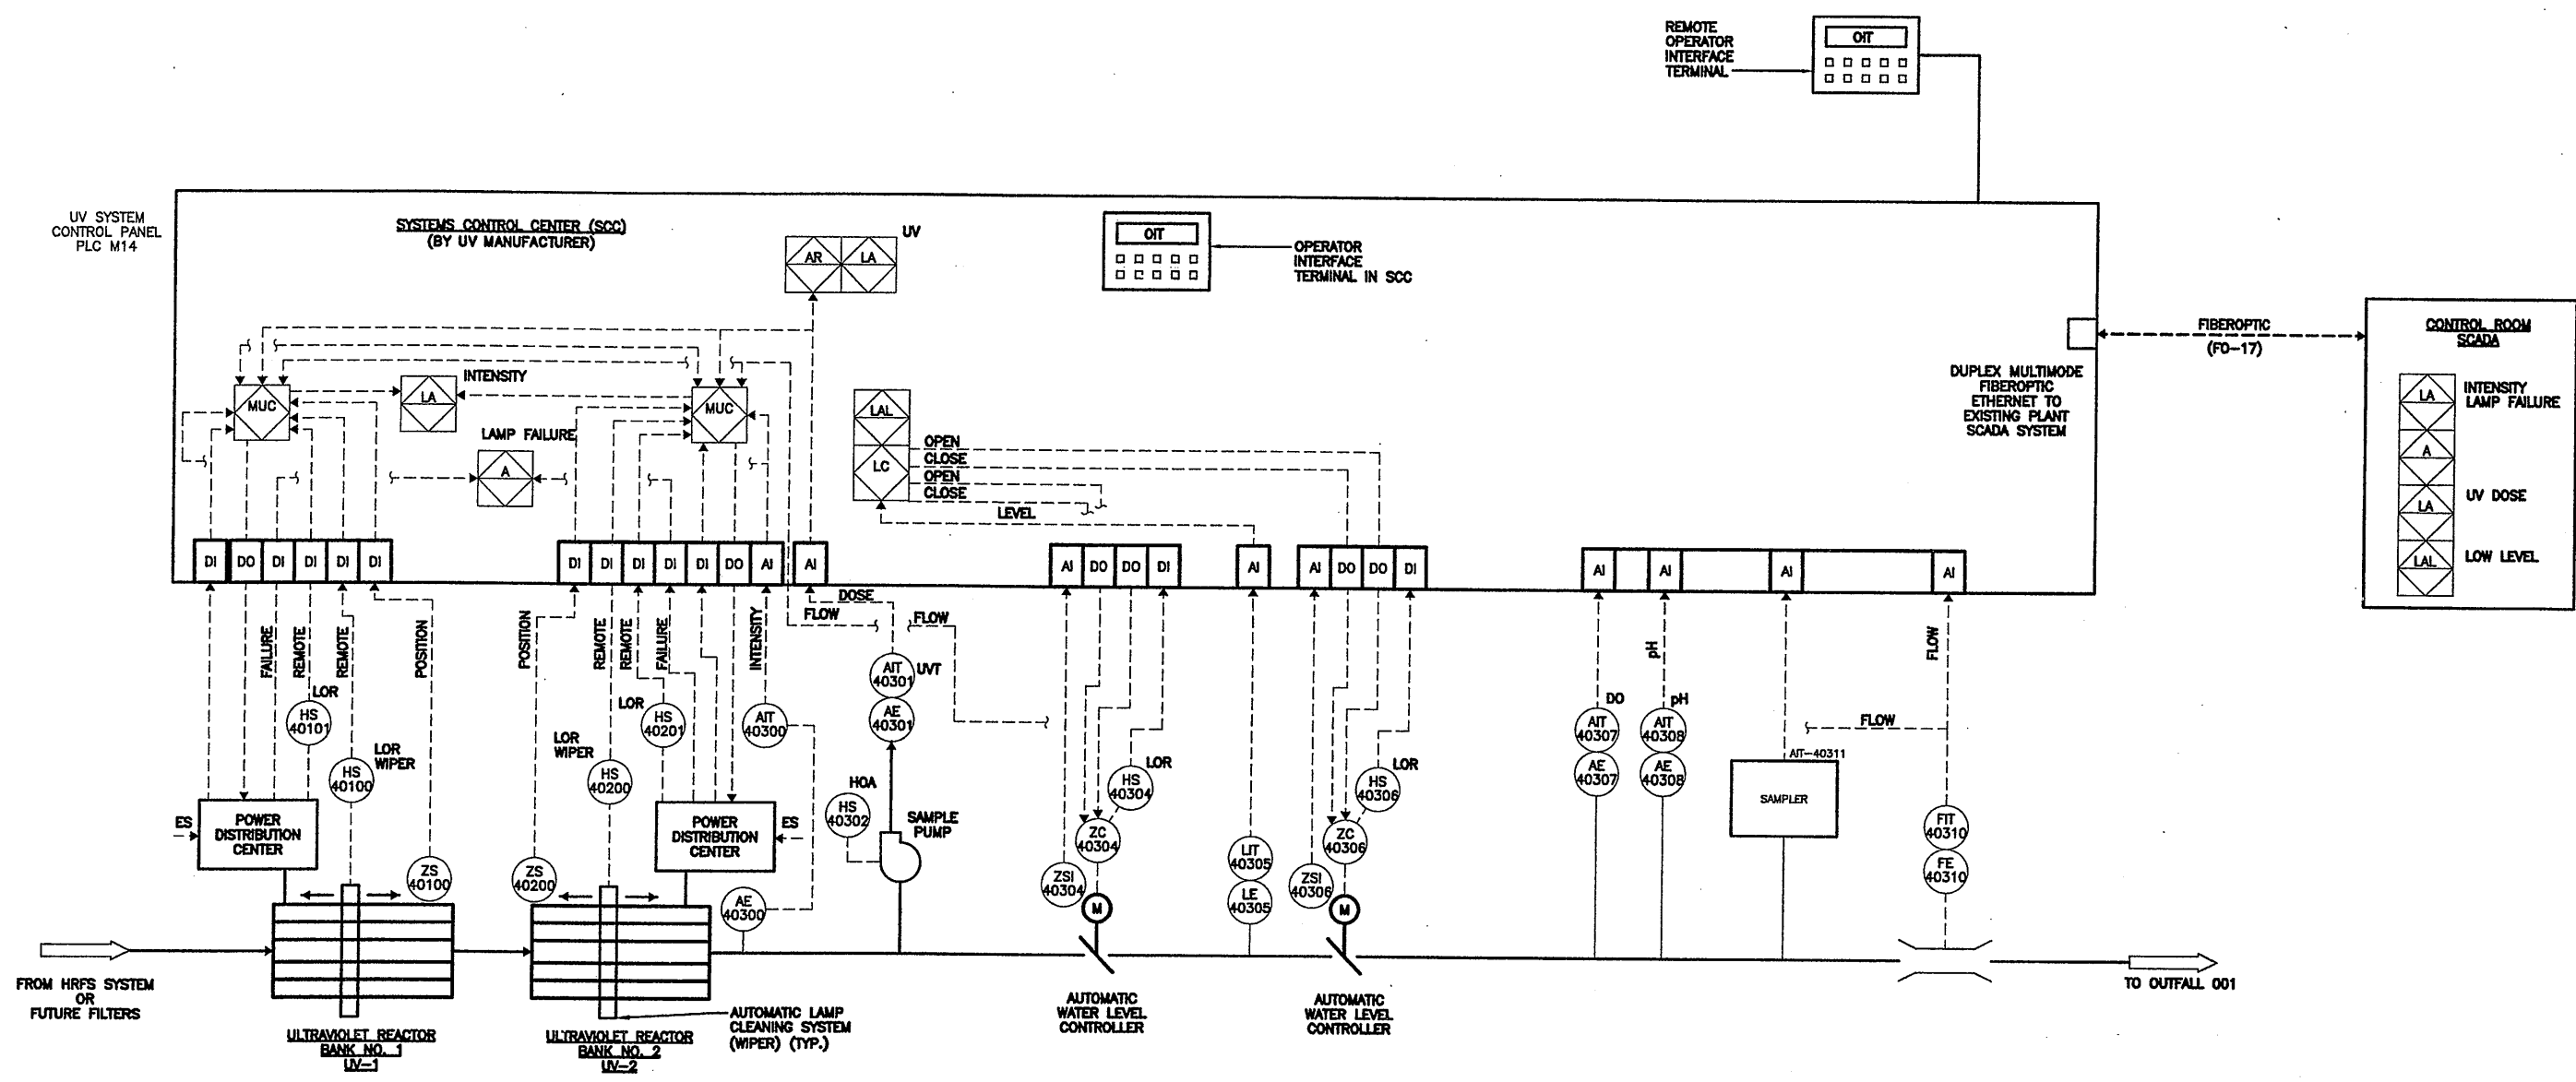

UV DISINFECTION SYSTEM CONTROL DIAGRAM
NOT TO SCALE

RECORD DRAWING

THESE DRAWINGS HAVE BEEN REVISIONED TO REFLECT MAJOR CHANGES, IF ANY, WHICH OCCURRED DURING CONSTRUCTION. REVISIONS ARE BASED UPON INFORMATION SUPPLIED BY CONTRACTOR.

DATE: _____ PER: _____

THIS DRAWING WAS PREPARED AT THE SCALE INDICATED IN THE TITLE BLOCK. INACCURACIES IN THE STATED SCALE MAY BE INTRODUCED WHEN DRAWINGS ARE REPRODUCED BY ANY MEANS. USE THE GRAPHIC SCALE BAR IN THE TITLE BLOCK TO DETERMINE THE ACTUAL SCALE OF THIS DRAWING.

Layer: ON=*; OFF=*REF*

02/01/01 086 JEC
05503000/0659/402.DWG

NOT TO SCALE

NO ALTERATIONS PERMITTED HEREON EXCEPT AS PROVIDED UNDER SECTION 7209 SUBDIVISION 2 OF THE NEW YORK STATE EDUCATION LAW

| No. | Date | Revisions | Init |
|-----|----------|---------------------|------|
| 0 | 4/20/01 | ISSUED FOR APPROVAL | TEL |
| 1 | 7/11/01 | AS BID | TEL |
| 2 | 10/31/05 | RECORD DRAWING | FKP |

In charge of --- TEL ---
Designed by --- TEL ---
Drawn by --- DCC ---
Checked by --- FKP ---



ONONDAGA COUNTY • DEPARTMENT OF DRAINAGE AND SANITATION • SYRACUSE, NEW YORK
METROPOLITAN SYRACUSE WASTEWATER TREATMENT PLANT
STAGE III AMMONIA AND STAGE II PHOSPHORUS REMOVAL PROJECT

UV DISINFECTION/FLOW MONITORING CONTROL DIAGRAM (PLC M14)


INSTRUMENTATION



File Number
00659

Date
APRIL 2001

1-402

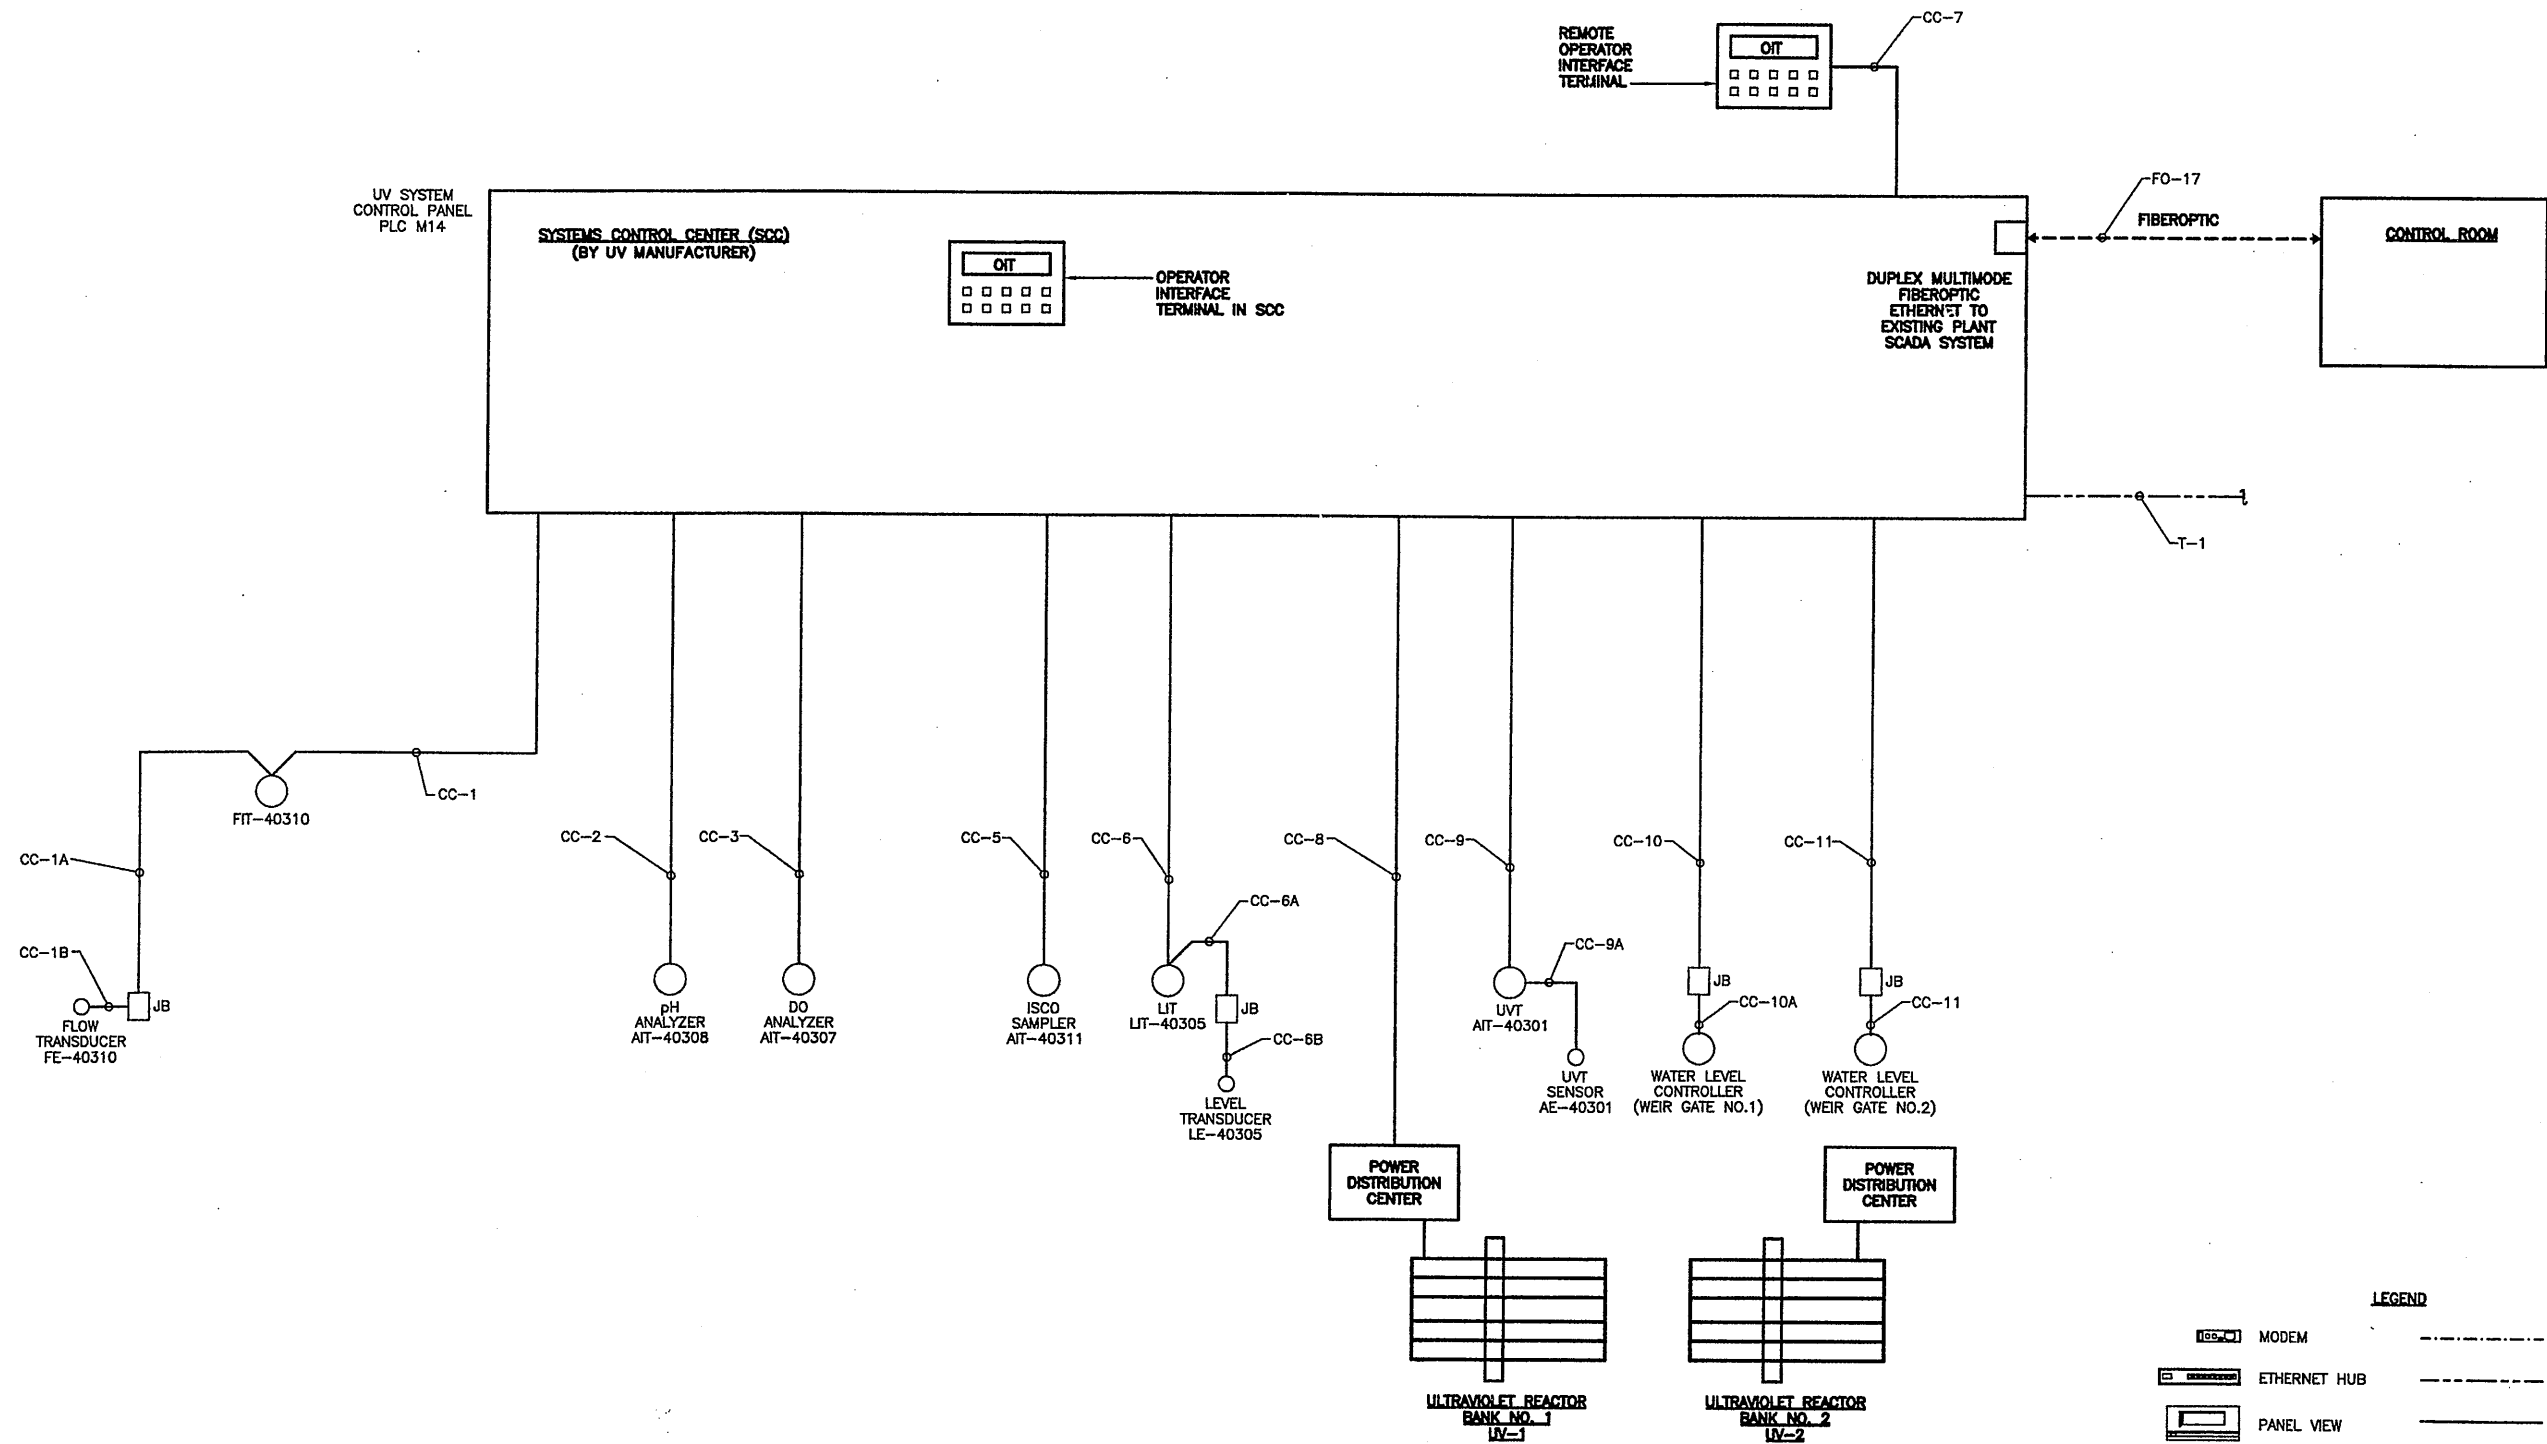

UV DISINFECTION SYSTEM
NOT TO SCALE

THIS DRAWING IS SCHEMATIC ONLY,
FOR SHOWING CONDUIT NUMBERING.
CONTRACTOR TO FIELD VERIFY LOCATION
OF ALL DEVICES

LEGEND

| | |
|--------------|---------------------------|
| MODEM | ----- DEVCENET CONDUIT |
| ETHERNET HUB | ----- FIELDBUS CONDUIT |
| PANEL VIEW | ----- CONVENTIONAL WIRING |
| PLC | ----- DH+ CONDUIT |

RECORD DRAWING
THESE DIMENSIONS HAVE BEEN DRAWN TO REFLECT
MAJOR CHANGES, IF ANY, WHICH OCCURRED DURING
CONSTRUCTION. DIMENSIONS ARE BASED UPON
INFORMATION SUPPLIED BY CONTRACTOR.
DATE: _____ FILE: _____

THIS DRAWING WAS PREPARED AT THE SCALE INDICATED IN THE
TITLE BLOCK. INACCURACIES IN THE STATED SCALE MAY BE
INTRODUCED WHEN DRAWINGS ARE REPRODUCED BY ANY MEANS.
USE THE GRAPHIC SCALE BAR IN THE TITLE BLOCK TO
DETERMINE THE ACTUAL SCALE OF THIS DRAWING.

Layer: ON=*; OFF=*REF*
02/01/01 OBG JEC
05503000/06591402.DWG

| No. | Date | Revisions | Init |
|-----|----------|---------------------|------|
| 0 | 4/20/27 | ISSUED FOR APPROVAL | JEC |
| 1 | 7/11/01 | AS BID | |
| 2 | 10/31/05 | RECORD DRAWING | |

NO ALTERATIONS PERMITTED HEREON EXCEPT AS PROVIDED UNDER SECTION 7209 SUBDIVISION 2 OF THE NEW YORK STATE EDUCATION LAW

In charge of: PLD
Designed by: SAT
Drawn by: JEC
Checked by: PLD



ONONDAGA COUNTY • DEPARTMENT OF DRAINAGE AND SANITATION • SYRACUSE, NEW YORK
METROPOLITAN SYRACUSE WASTEWATER TREATMENT PLANT
STAGE III AMMONIA AND STAGE II PHOSPHORUS REMOVAL PROJECT


**UV DISINFECTION/FLOW MONITORING
INTERCONNECT ONLINE**

INSTRUMENTATION



File Number
00659
Date
APRIL 2001

I-403

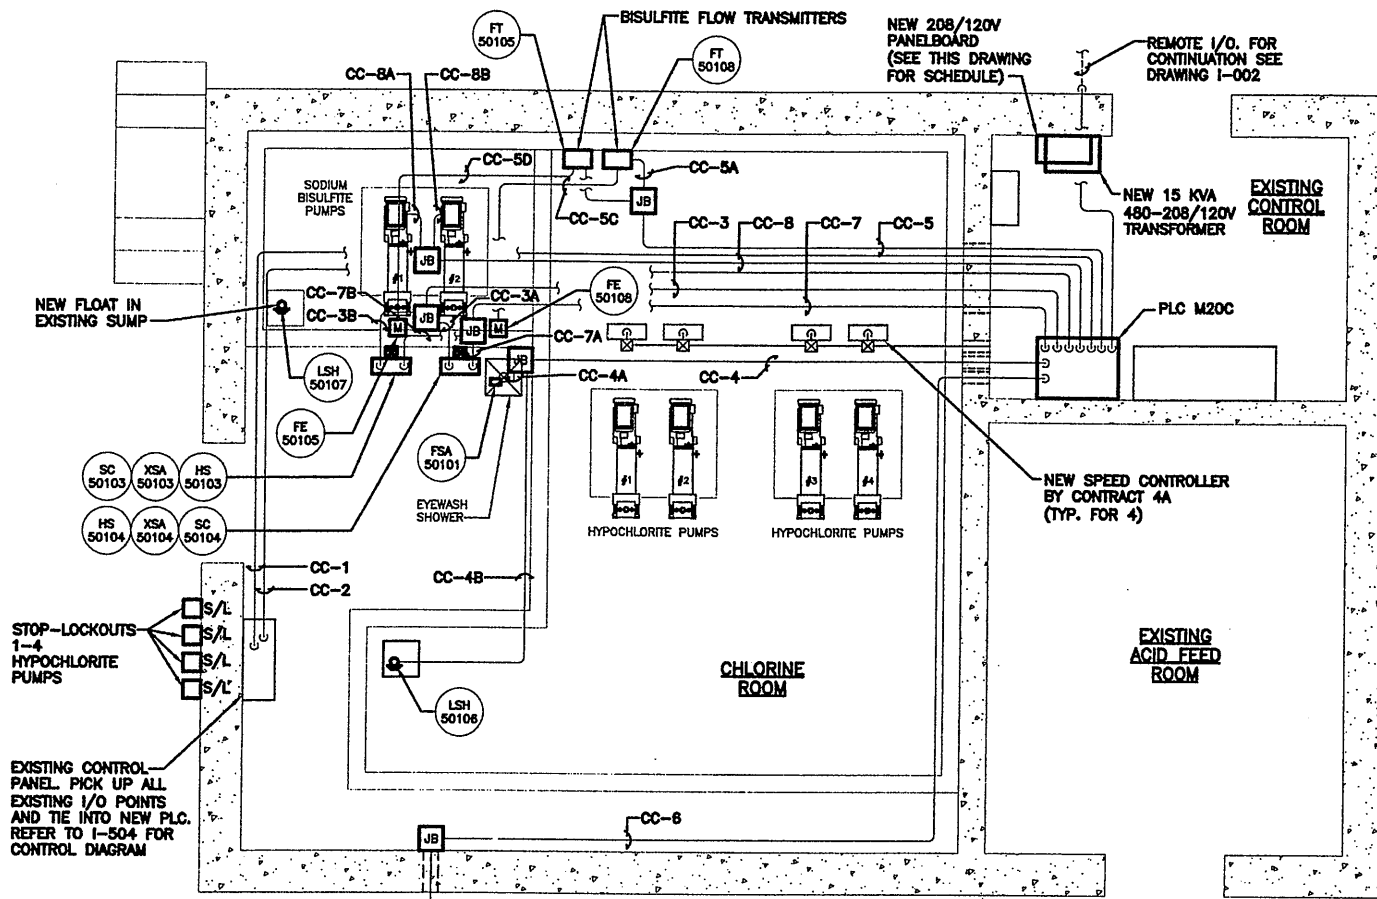



FOR CONTINUATION SEE DRAWING E-609

NOTES:

- ALL CONDUITS SHALL BE 3/4" PVC COATED RGS UNLESS INDICATED OTHERWISE.
- SEE SHEET E-608 FOR LSH-50102 AT MANHOLE.
- ELECTRICAL CONTRACTOR IS ALSO RESPONSIBLE FOR RELOCATING EXISTING INSTRUMENT LOOPS, ALTHOUGH NOT SHOWN IN DRAWING. THESE LOOPS ARE FOUND IN THE EXISTING "SODIUM HYPOCHLORITE CONTROL PANEL".

**POWER AND INSTRUMENTATION PLAN
CHEMICAL FEED BUILDING**

SCALE: 3/8"=1'-0"

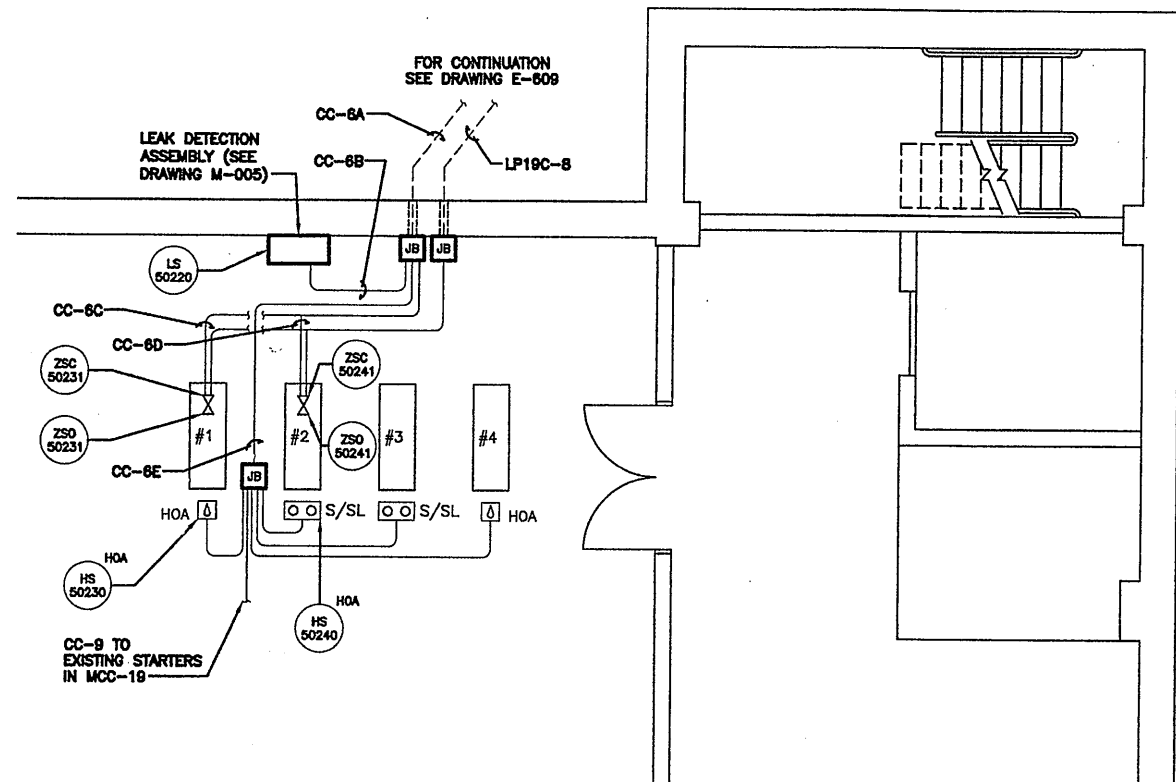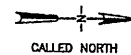

PLANT OPERATIONS BUILDING BASEMENT PARTIAL PLAN

SCALE: 1/4"=1'-0"

NOTES:

- REFER TO M-509 FOR NEW MOTORIZED BUTTERFLY VALVES AT CARRIER WATER PUMPS.
- PROVIDE 3/4" w/3-#12 & #12G FROM EACH VALVE TO LOCAL 480V PANEL. PROVIDE DISCONNECT AT VALVE OPERATORS.


| CHEMICAL FEED BUILDING A CONDUIT SCHEDULE | | | | |
|---|-----------------|---------------------|---------------------------------|---------------------------------|
| CKT. NO. | CONDUIT SIZE | NO. SIZE CONDUCTORS | FROM | TO |
| CC-1 | 3" CRGS | 11 TPS #16 | REMOTE I/O M20C | EXISTING CONTROL PANEL |
| CC-2 | 1" CRGS | 16 #14 | REMOTE I/O M20C | EXISTING CONTROL PANEL |
| CC-3 | 1-1/2" CRGS | 2 TPS #16 | REMOTE I/O M20C | JB ABOVE DECHLOR PUMP NO. 2 |
| CC-3A | 3/4" CRGS | 1 TPS #16 | JB ABOVE DECHLOR PUMP NO. 2 | VARIABLE SPEED CONTROLLER NO. 2 |
| CC-3B | 3/4" CRGS | 1 TPS #16 | JB ABOVE DECHLOR PUMP NO. 2 | VARIABLE SPEED CONTROLLER NO. 1 |
| CC-4 | 3/4" CRGS | 6 #14 | REMOTE I/O M20C | JB ABOVE EYE/SOWER STATION |
| CC-4A | 3/4" CRGS | 2 #14 | JB ABOVE EYE/SOWER STATION | EYE/SOWER STATION FLOW SWITCH |
| CC-4B | 3/4" CRGS | 2 #14 | JB ABOVE EYE/SOWER STATION | HYPOCHLORITE AREA SUMP FLOAT |
| CC-5 | 3/4" CRGS | 2 TPS #16 | REMOTE I/O M20C | JB ABOVE FLOW TRANSMITTER NO. 2 |
| CC-5A | 3/4" CRGS | 1 TPS #16 | JB ABOVE FLOW TRANSMITTER NO. 2 | FLOW TRANSMITTER NO. 2 |
| CC-5B | 3/4" CRGS | 1 TPS #16 | JB ABOVE FLOW TRANSMITTER NO. 2 | FLOW TRANSMITTER NO. 1 |
| CC-5C | 3/4" CRGS | 1 TPS #16 | FLOW TRANSMITTER NO. 2 | FLOW METER NO. 2 |
| CC-5D | 3/4" CRGS | 1 TPS #16 | FLOW TRANSMITTER NO. 1 | FLOW METER NO. 1 |
| CC-6 | 1" CRGS | 30 #14 | REMOTE I/O M20C | JB ON EAST WALL |
| CC-6A | 3/4" CRGS | 12 #14 | JB ON POB WALL | LEAK DETECTION FLOAT |
| CC-6B | 3/4" CRGS | 2 #14 | JB ON POB WALL | VALVE CARRIER PUMP NO. 1 |
| CC-6C | 3/4" CRGS | 8 #14 | JB ON POB WALL | VALVE CARRIER PUMP NO. 2 |
| CC-6D | 3/4" CRGS | 8 #14 | JB ON POB WALL | JB ABOVE CARRIER PUMPS |
| CC-6E | 3/4" CRGS | 12 #14 | JB ON POB WALL | JB ABOVE DECHLOR. PUMP NO. 2 |
| CC-7 | 3/4" CRGS | 12 #14 | REMOTE I/O M20C | VARIABLE FEED CONTROLLER NO. 1 |
| CC-7A | 3/4" CRGS | 6 #14 | JB ABOVE DECHLOR. PUMP NO. 2 | VARIABLE FEED CONTROLLER NO. 2 |
| CC-7B | 3/4" CRGS | 6 #14 | JB ABOVE DECHLOR. PUMP NO. 2 | JB BETWEEN DECHLOR. PUMPS |
| CC-8 | 3/4" CRGS | 4 #14 | REMOTE I/O M20C | PUMP NO. 1 |
| CC-8A | 3/4" LIQUIDTITE | 2 #14 | JB BETWEEN PUMPS | PUMP NO. 2 |
| CC-8B | 3/4" LIQUIDTITE | 2 #14 | JB BETWEEN PUMPS | MCC 19 |
| CC-9 | 3/4" CRGS | 8 #14 | JB BETWEEN PUMPS | HYPOCHLORITE PUMP SPEED CONTROL |
| CC-10 | 1" CRGS | 24 #14 | PLC M20C | HYPOCHLORITE PUMP SPEED CONTROL |
| CC-11 | 3/4" CRGS | 4 TPS #16 | PLC M20C | HYPOCHLORITE PUMP SPEED CONTROL |

RECORD DRAWING

THESE DRAWINGS HAVE BEEN REVIEWED TO REFLECT MAJOR CHANGES, IF ANY, WHICH OCCURRED DURING CONSTRUCTION. REVISIONS ARE BASED UPON INFORMATION SUPPLIED BY CONTRACTOR.
DATE: 10/21/05 FOR: [Signature]

THIS DRAWING WAS PREPARED AT THE SCALE INDICATED IN THE TITLE BLOCK. INACCURACIES IN THE STATED SCALE MAY BE INTRODUCED WHEN DRAWINGS ARE REPRODUCED BY ANY MEANS. USE THE GRAPHIC SCALE BAR IN THE TITLE BLOCK TO DETERMINE THE ACTUAL SCALE OF THIS DRAWING.

Layer: ON=; OFF=REF*
X: 0659X043.DWG
4/5/01 BBL DCC
05503000/0659I501.DWG

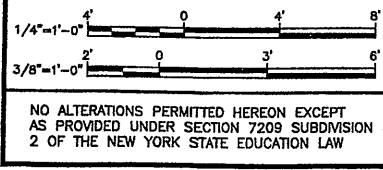



| No. | Date | Revisions | Init |
|-----|----------|---------------------|-------------|
| 0 | 4/20/01 | ISSUED FOR APPROVAL | [Signature] |
| 1 | 7/11/01 | AS BID | |
| 2 | 10/31/05 | RECORD DRAWING | |

In charge of --- TEL ---
Designed by --- MEE ---
Drawn by --- DCC ---
Checked by --- WSH ---



ONONDAGA COUNTY • DEPARTMENT OF DRAINAGE AND SANITATION • SYRACUSE, NEW YORK
METROPOLITAN SYRACUSE WASTEWATER TREATMENT PLANT
STAGE III AMMONIA AND STAGE II PHOSPHORUS REMOVAL PROJECT
**CHEMICAL BUILDING A
CHEMICAL BUILDING A AND POB
PARTIAL PLANS**
INSTRUMENTATION

File Number: 00659
Date: APRIL 2001
1-501
[Signature]

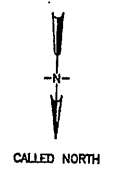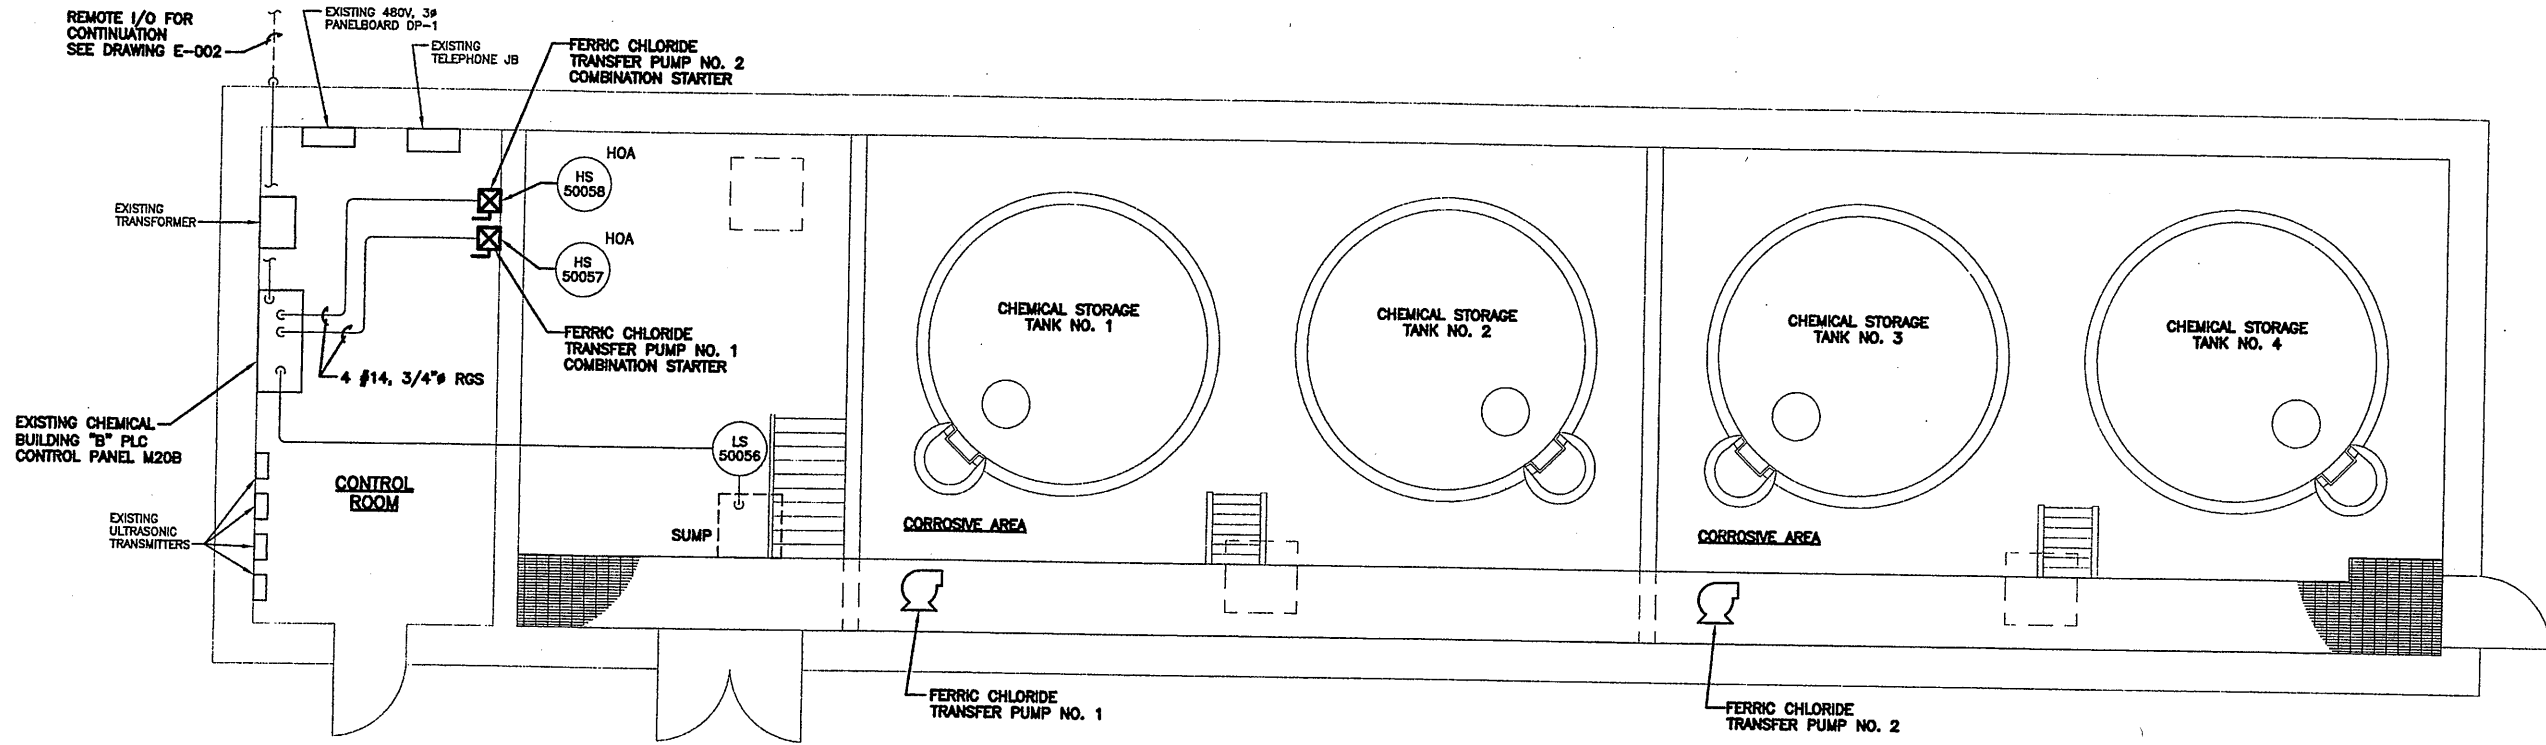

CHEMICAL BUILDING B INSTRUMENTATION PLAN
SCALE: 1/4"=1'-0"

Layer ON=*, OFF=REF
 X: 0659X051.DWG
 4/5/01 BBL DCC
 05503000/0659/502.DWG


RECORD DRAWING
 THESE DRAWINGS HAVE BEEN REVISIONED TO REFLECT
 MAKE CHANGES, IF ANY, WHICH OCCURRED DURING
 CONSTRUCTION. REVISIONS ARE BASED UPON
 INFORMATION SUPPLIED BY CONTRACTOR.
 DATE: 10/21/05 PER: [Signature]

THIS DRAWING WAS PREPARED AT THE SCALE INDICATED IN THE
 TITLE BLOCK. INACCURACIES IN THE STATED SCALE MAY BE
 INTRODUCED WHEN DRAWINGS ARE REPRODUCED BY ANY MEANS.
 USE THE GRAPHIC SCALE BAR IN THE TITLE BLOCK TO
 DETERMINE THE ACTUAL SCALE OF THIS DRAWING.

NO ALTERATIONS PERMITTED HEREON EXCEPT
 AS PROVIDED UNDER SECTION 7209 SUBDIVISION
 2 OF THE NEW YORK STATE EDUCATION LAW

| No. | Date | Revisions | Init |
|-----|----------|---------------------|-------------|
| 0 | 4/20/01 | ISSUED FOR APPROVAL | [Signature] |
| 1 | 7/11/01 | AS BID | |
| 2 | 10/31/05 | RECORD DRAWING | [Signature] |



In charge of TEL
 Designed by MEE
 Drawn by DCC
 Checked by WSH

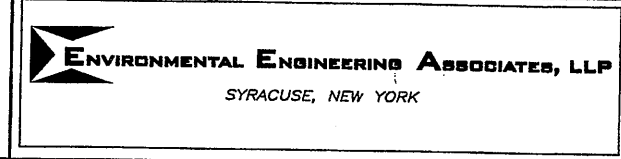

ONONDAGA COUNTY • DEPARTMENT OF DRAINAGE AND SANITATION • SYRACUSE, NEW YORK
 METROPOLITAN SYRACUSE WASTEWATER TREATMENT PLANT
 STAGE III AMMONIA AND STAGE II PHOSPHORUS REMOVAL PROJECT
CHEMICAL BUILDING B
CHEMICAL BUILDING B
INSTRUMENTATION PLAN
 INSTRUMENTATION





File Number
 00659
 Date
 APRIL 2001
 [Signature]

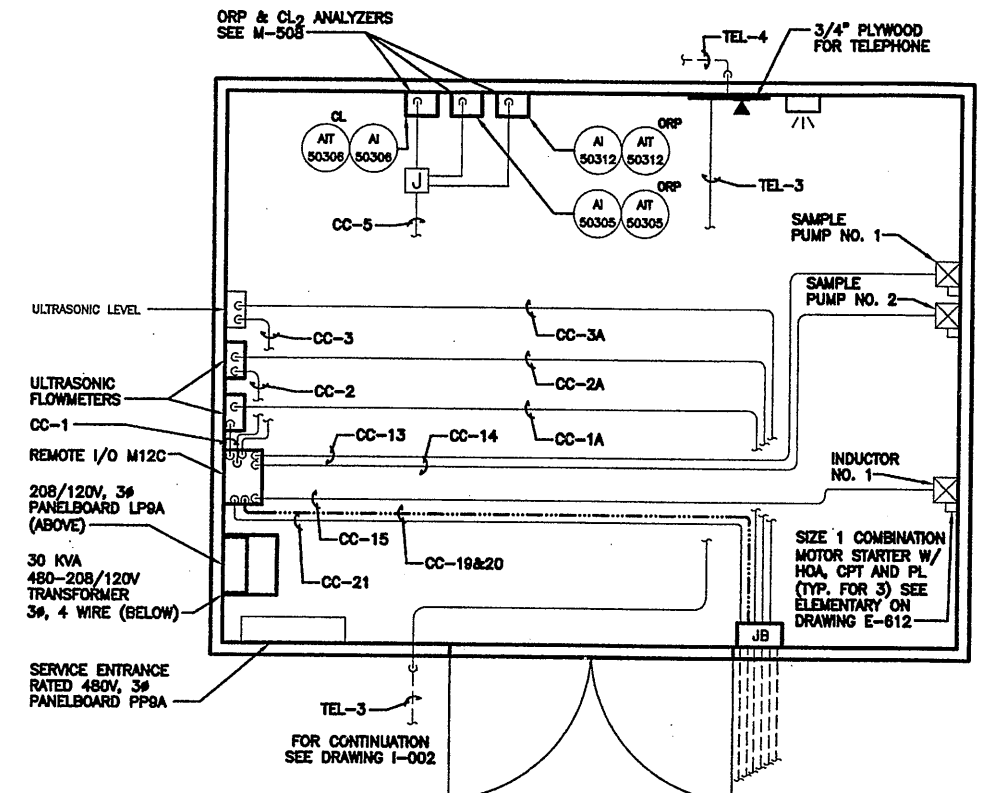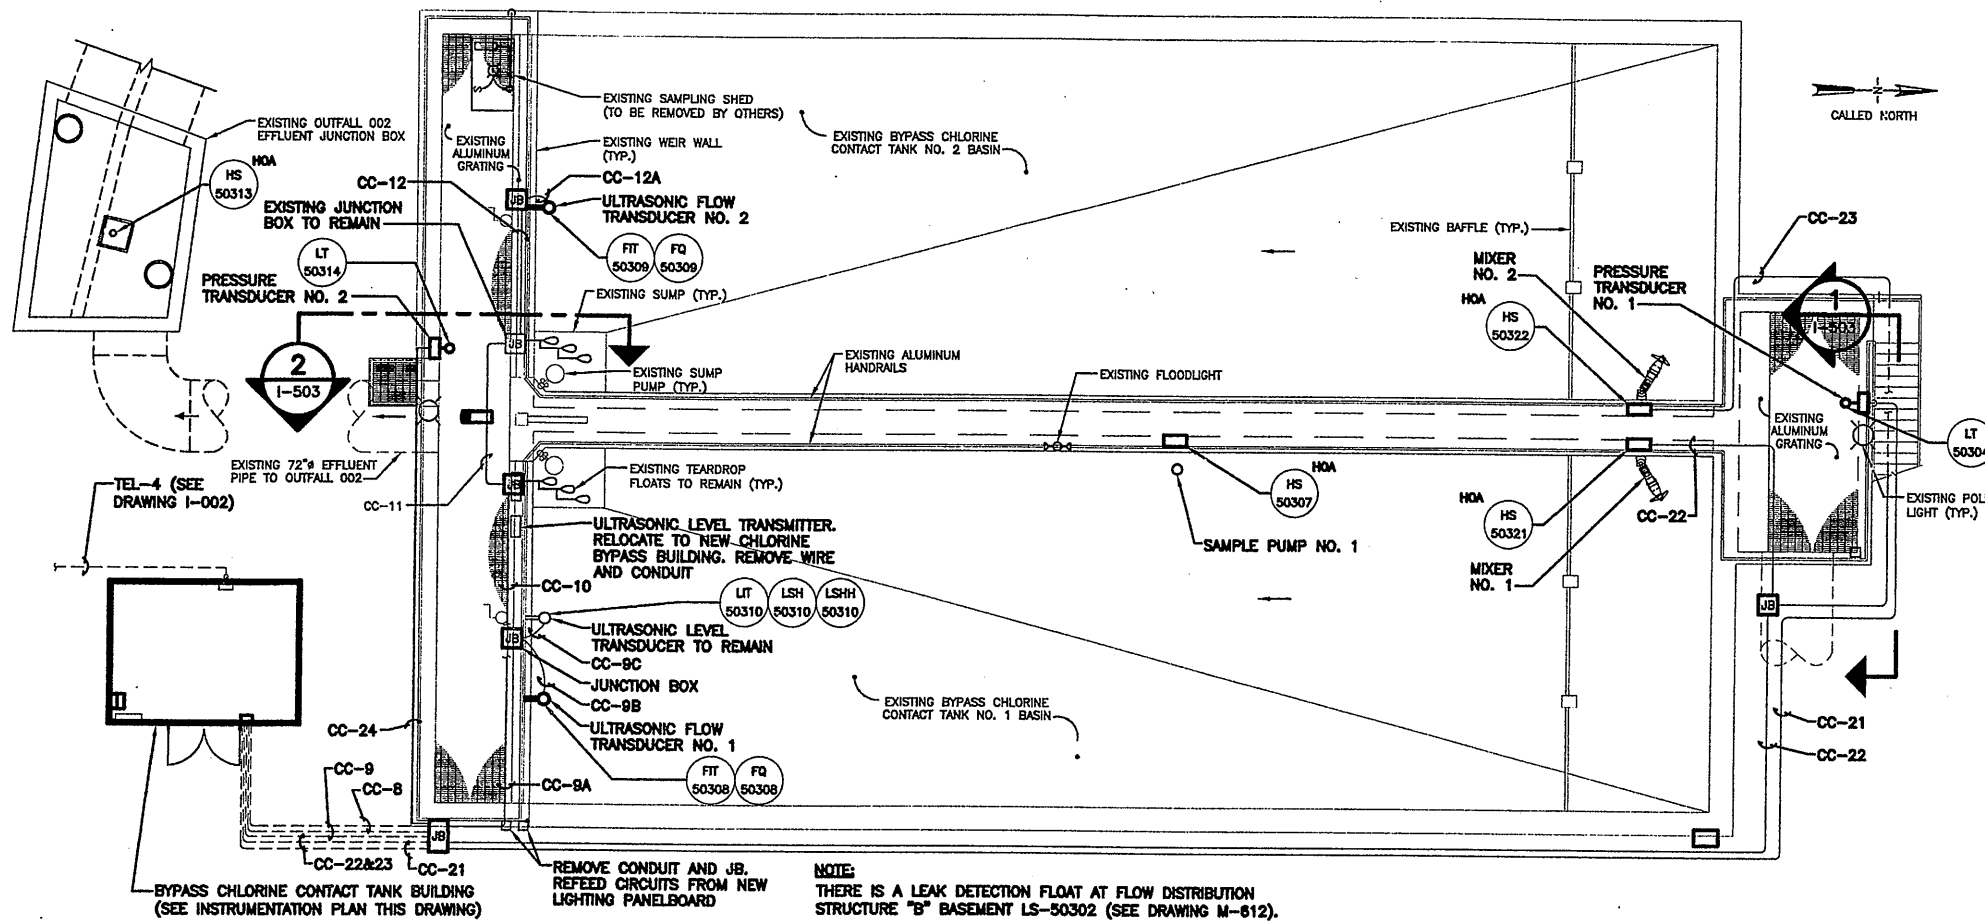

BYPASS CHLORINE CONTACT TANK PLAN
SCALE: 1/8"=1'-0"

BYPASS CHLORINE CONTACT TANK BUILDING INSTRUMENTATION PLAN
SCALE: 1/2"=1'-0"

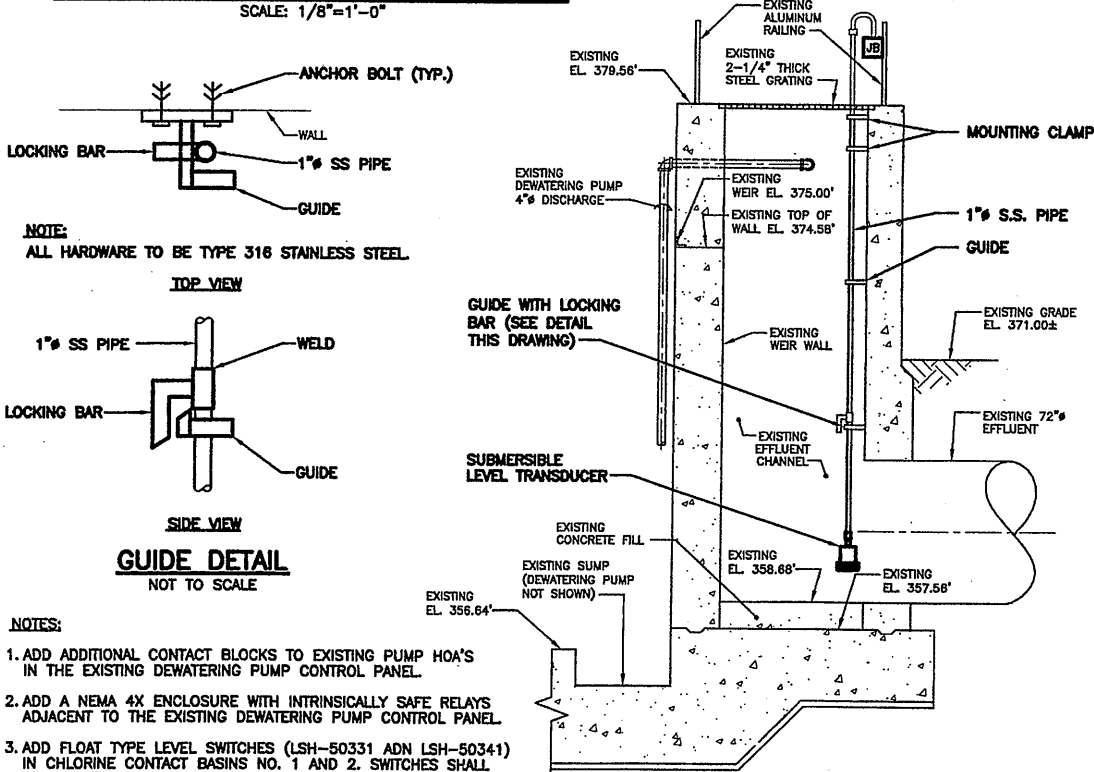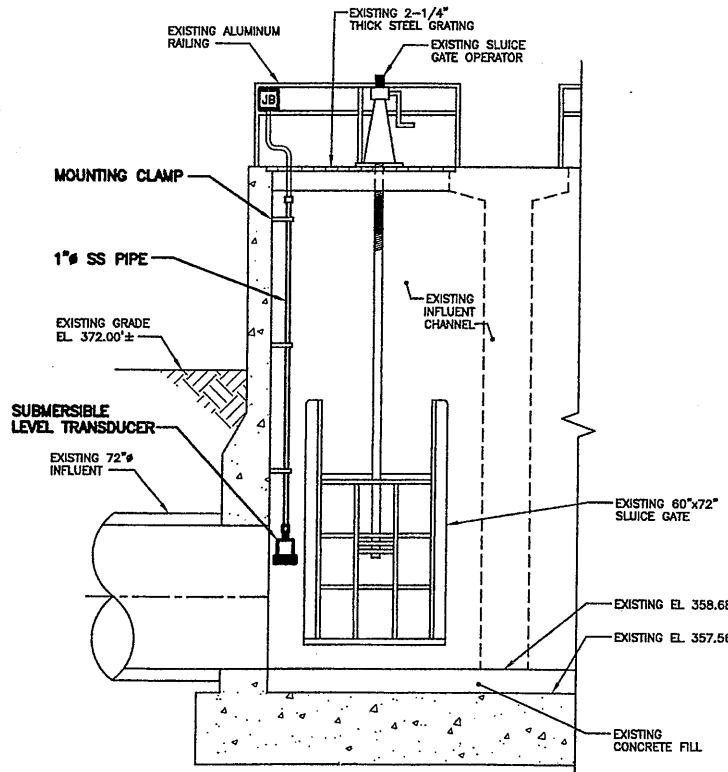

| BYPASS CHLORINE CONTACT TANK BUILDING CONDUIT SCHEDULE | | | | |
|--|------------------|---------------------|----------------------------------|-----------------------------------|
| CKT. NO. | CONDUIT SIZE | NO. SIZE CONDUCTORS | FROM | TO |
| CC-1 | 3/4" RGS | 1 TPS #16 | REMOTE I/O PANEL | ULTRASONIC FLOW TRANSMITTER NO. 1 |
| CC-1A | 3/4" RGS | 1 TPS #16 | ULTRASONIC FLOW TRANSMITTER NO.1 | CONTROL JUNCTION BOX |
| CC-2 | 3/4" RGS | 1 TPS #16 | REMOTE I/O PANEL | ULTRASONIC FLOW TRANSMITTER NO. 2 |
| CC-2A | 3/4" RGS | 1 TPS #16 | ULTRASONIC FLOW TRANSMITTER NO.2 | CONTROL JUNCTION BOX |
| CC-3 | 3/4" RGS | 1 TPS #16 | REMOTE I/O PANEL | ULTRASONIC LEVEL TRANSMITTER |
| CC-3A | 3/4" RGS | 1 TPS #16 | ULTRASONIC LEVEL TRANSMITTER | CONTROL JUNCTION BOX |
| CC-4 | 3/4" RGS | 16 #14 | REMOTE I/O PANEL | DEWATERING PUMP PANEL |
| CC-5 | 3/4" RGS | 3 TPS #16 | REMOTE I/O PANEL | ANALYZERS |
| CC-6 | 3/4" RGS | 2 #14 | REMOTE I/O PANEL | STRANTRON ANALYZER |
| CC-7 | 3/4" RGS | 4 #14 | REMOTE I/O PANEL | SAMPLE PUMP PANEL |
| CC-8 | 3/4" CRGS | 12 #14 | CONTROL JUNCTION BOX | JUNCTION BOX AT CL2 CONTACT TANK |
| CC-8A | 3/4" RGS | 12 #14 | JUNCTION BOX AT CL2 CONTACT TANK | ULTRASONIC FLOW METER JB |
| CC-9 | 1-1/2" CRGS | 4 TPS #16 | CONTROL JUNCTION BOX | JUNCTION BOX AT CL2 CONTACT TANK |
| CC-9A | 1-1/2" RGS | 3 TPS #16 | JUNCTION BOX AT CL2 CONTACT TANK | ULTRASONIC FLOW METER JB |
| CC-9B | 3/4" LIQUID TITE | 1 TPS #16 | ULTRASONIC FLOW METER JB | ULTRASONIC FLOW TRANSDUCER NO.1 |
| CC-9C | 3/4" LIQUID TITE | 1 TPS #16 | ULTRASONIC FLOW METER JB | EXISTING U-SONIC LEVEL TRANSDUCER |
| CC-10 | 1" RGS | 1 TPS #16 | ULTRASONIC FLOW METER JB | DEWATERING PUMP NO. 1 FLOATS JB |
| CC-11 | EXISTING C. | 1 TPS #16, 6 #14 | DEWATERING PUMP NO. 1 FLOATS JB | DEWATERING PUMP NO. 2 FLOATS JB |
| CC-12 | 3/4" RGS | 1 TPS #16 | DEWATERING PUMP NO. 2 FLOATS JB | ULTRASONIC FLOW METER JB |
| CC-12A | 3/4" LIQUID TITE | 1 TPS #16 | ULTRASONIC FLOW METER JB | ULTRASONIC FLOW TRANSDUCER NO.2 |
| CC-13 | 3/4" RGS | 6 #14 | REMOTE I/O PANEL | COMBINATION STARTER |
| CC-14 | 3/4" RGS | 6 #14 | REMOTE I/O PANEL | COMBINATION STARTER |
| CC-15 | 3/4" RGS | 4 #14 | REMOTE I/O PANEL | COMBINATION STARTER |
| CC-21 | 3/4" RGS | 1 TPS #16 | REMOTE I/O PANEL | PRESSURE TRANSDUCER NO. 1 |
| CC-22 | 3/4" RGS | 10 #14 | REMOTE I/O PANEL | MIXER NO. 1 |
| CC-23 | 3/4" RGS | 10 #14 | REMOTE I/O PANEL | MIXER NO. 2 |
| CC-24 | 3/4" RGS | 1 TPS #16 | REMOTE I/O PANEL | PRESSURE TRANSDUCER NO. 2 |
| CC-25 | 3/4" RGS | 2 #14 | REMOTE I/O PANEL | PLANT WATER SOLENOID VALVE |
| CC-26 | 3/4" RGS | 8 #14 | REMOTE I/O PANEL | CHLORINE ANALYZERS |

- NOTES:**
1. ADD ADDITIONAL CONTACT BLOCKS TO EXISTING PUMP HOA'S IN THE EXISTING DEWATERING PUMP CONTROL PANEL.
 2. ADD A NEMA 4X ENCLOSURE WITH INTRINSICALLY SAFE RELAYS ADJACENT TO THE EXISTING DEWATERING PUMP CONTROL PANEL.
 3. ADD FLOAT TYPE LEVEL SWITCHES (LSH-50331 ADN LSH-50341) IN CHLORINE CONTACT BASINS NO. 1 AND 2. SWITCHES SHALL BE LOCATED ADJACENT TO EXISTING LEVEL SWITCHES USED FOR DEWATERING PUMP CONTROL. ROUTE LEVEL SWITCH CORDS TO THE EXISTING DEWATERING PUMP CONTROL PANEL UTILIZING EXISTING CONDUITS. PROVIDE CONNECTION TO PLCM20D UTILIZING CONDUIT CC-4.

Layer: ON=*, OFF=*REF*
X: 0659X042.DWG
4/4/01 BBL DCC
05503000/06591503.DWG

NO ALTERATIONS PERMITTED HEREON EXCEPT AS PROVIDED UNDER SECTION 7209 SUBDIVISION 2 OF THE NEW YORK STATE EDUCATION LAW

| No. | Date | Revisions | Init |
|-----|----------|---------------------|------|
| 0 | 4/20/01 | ISSUED FOR APPROVAL | |
| 1 | 7/11/01 | AS BID | |
| 2 | 10/31/05 | RECORD DRAWING | |

In charge of TEL
Designed by AHL
Drawn by DCC
Checked by TEL




ONONDAGA COUNTY • DEPARTMENT OF DRAINAGE AND SANITATION • SYRACUSE, NEW YORK
METROPOLITAN SYRACUSE WASTEWATER TREATMENT PLANT
STAGE III AMMONIA AND STAGE II PHOSPHORUS REMOVAL PROJECT
BYPASS CHLORINE CONTACT TANK AND BUILDING PLANS
INSTRUMENTATION



File Number 00659
Date APRIL 2001
1-503
Rampollet

RECORD DRAWING
THESE CHANGES HAVE BEEN MADE TO REFLECT THE CHANGES OF ANY, WHICH OCCURRED DURING CONSTRUCTION. THESE ARE REPRODUCED BY ANY MEANS. USE THE GRAPHIC SCALE BAR IN THE TITLE BLOCK TO DETERMINE THE ACTUAL SCALE OF THIS DRAWING.

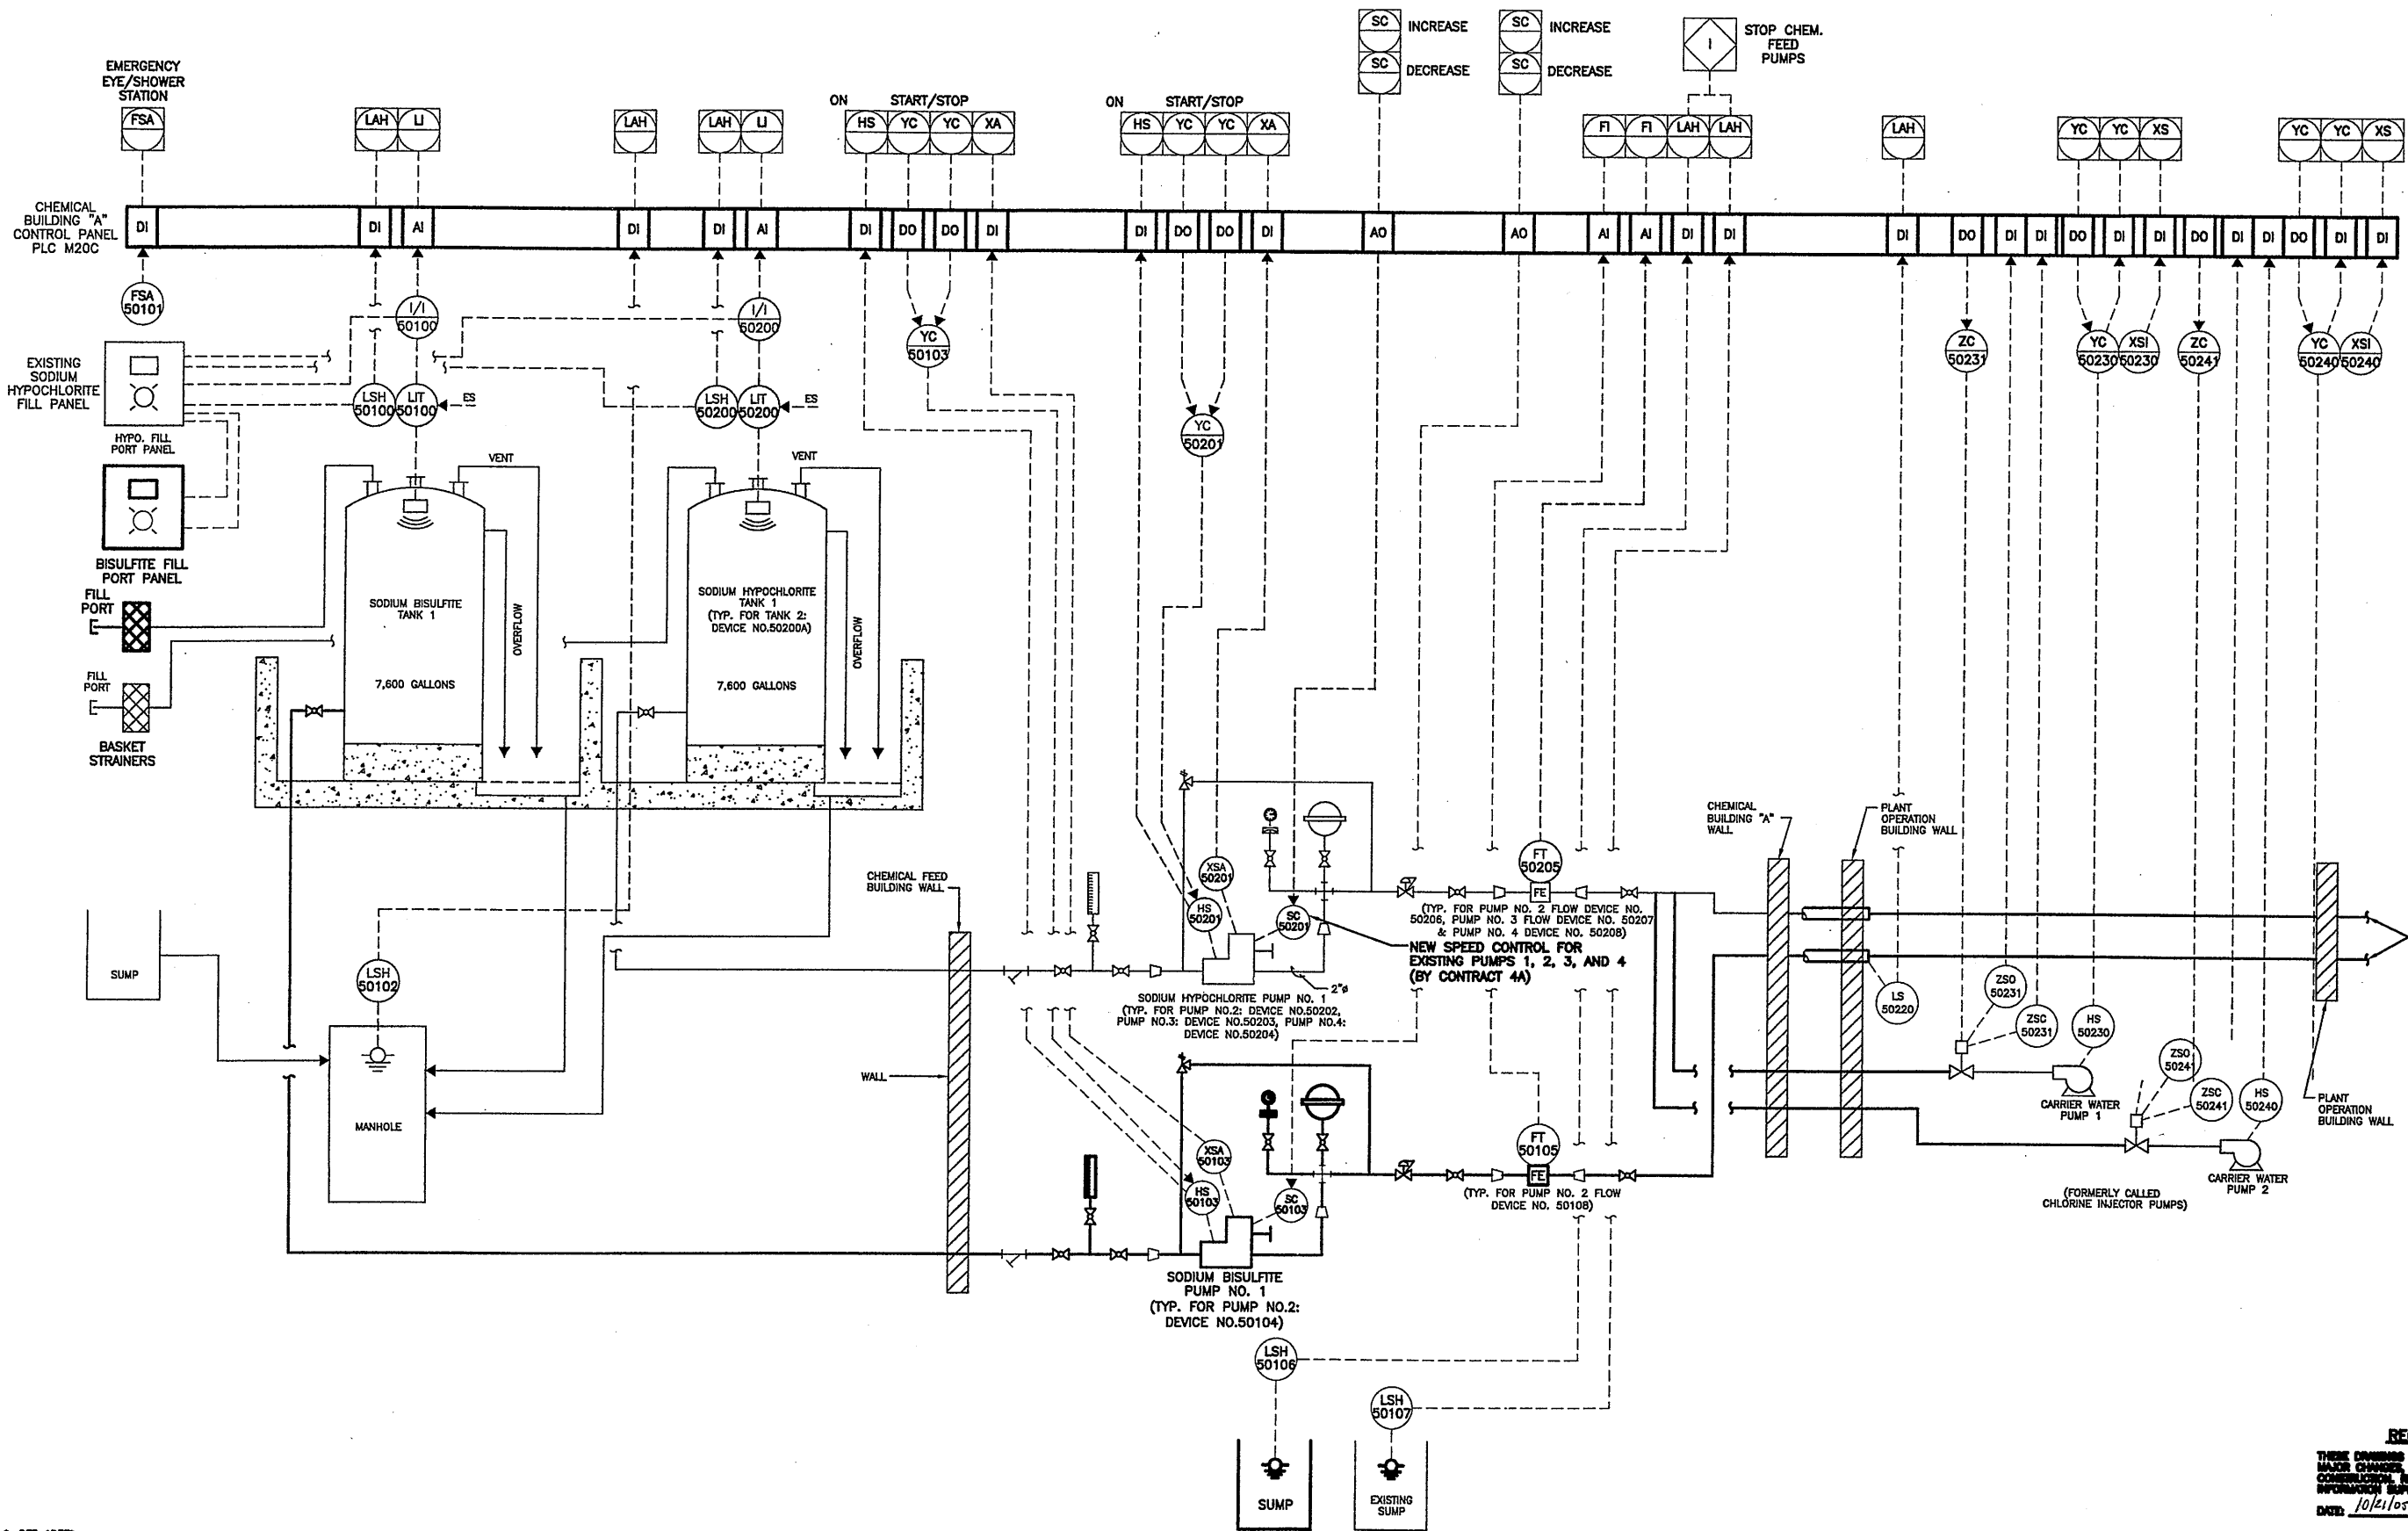

FOR CONTINUATION
SEE DRAWING I-505

RECORD DRAWING

THESE CHANGES HAVE BEEN MADE TO REFLECT
MAJOR CHANGES, IF ANY, WHICH OCCURRED DURING
CONSTRUCTION. REVISIONS ARE BASED UPON
INFORMATION SUPPLIED BY CONTRACTOR.
DATE: 10/11/05 FOR: *Blampol*

THIS DRAWING WAS PREPARED AT THE SCALE INDICATED IN THE
TITLE BLOCK. INACCURACIES IN THE STATED SCALE MAY BE
INTRODUCED WHEN DRAWINGS ARE REPRODUCED BY ANY MEANS.
USE THE GRAPHIC SCALE BAR IN THE TITLE BLOCK TO
DETERMINE THE ACTUAL SCALE OF THIS DRAWING.

Layer: ON=*, OFF=*REF*
02/01/01 OBG JEC
05503048/08591504.DWG

NOT TO SCALE

NO ALTERATIONS PERMITTED HEREON EXCEPT
AS PROVIDED UNDER SECTION 7209 SUBDIVISION
2 OF THE NEW YORK STATE EDUCATION LAW

| No. | Date | Revisions | Init |
|-----|----------|---------------------|------------|
| 0 | 4/20/01 | ISSUED FOR APPROVAL | <i>TEL</i> |
| 1 | 7/11/01 | AS BID | |
| 2 | 10/31/05 | RECORD DRAWING | |

In charge of TEL
Designed by MEE
Drawn by DCC
Checked by FKP




ONONDAGA COUNTY • DEPARTMENT OF DRAINAGE AND SANITATION • SYRACUSE, NEW YORK
METROPOLITAN SYRACUSE WASTEWATER TREATMENT PLANT
STAGE III AMMONIA AND STAGE II PHOSPHORUS REMOVAL PROJECT
**SODIUM BISULFITE (PLC M20C)
CONTROL DIAGRAM**



File Number
00659
Date
APRIL 2001
Blampol

I-504

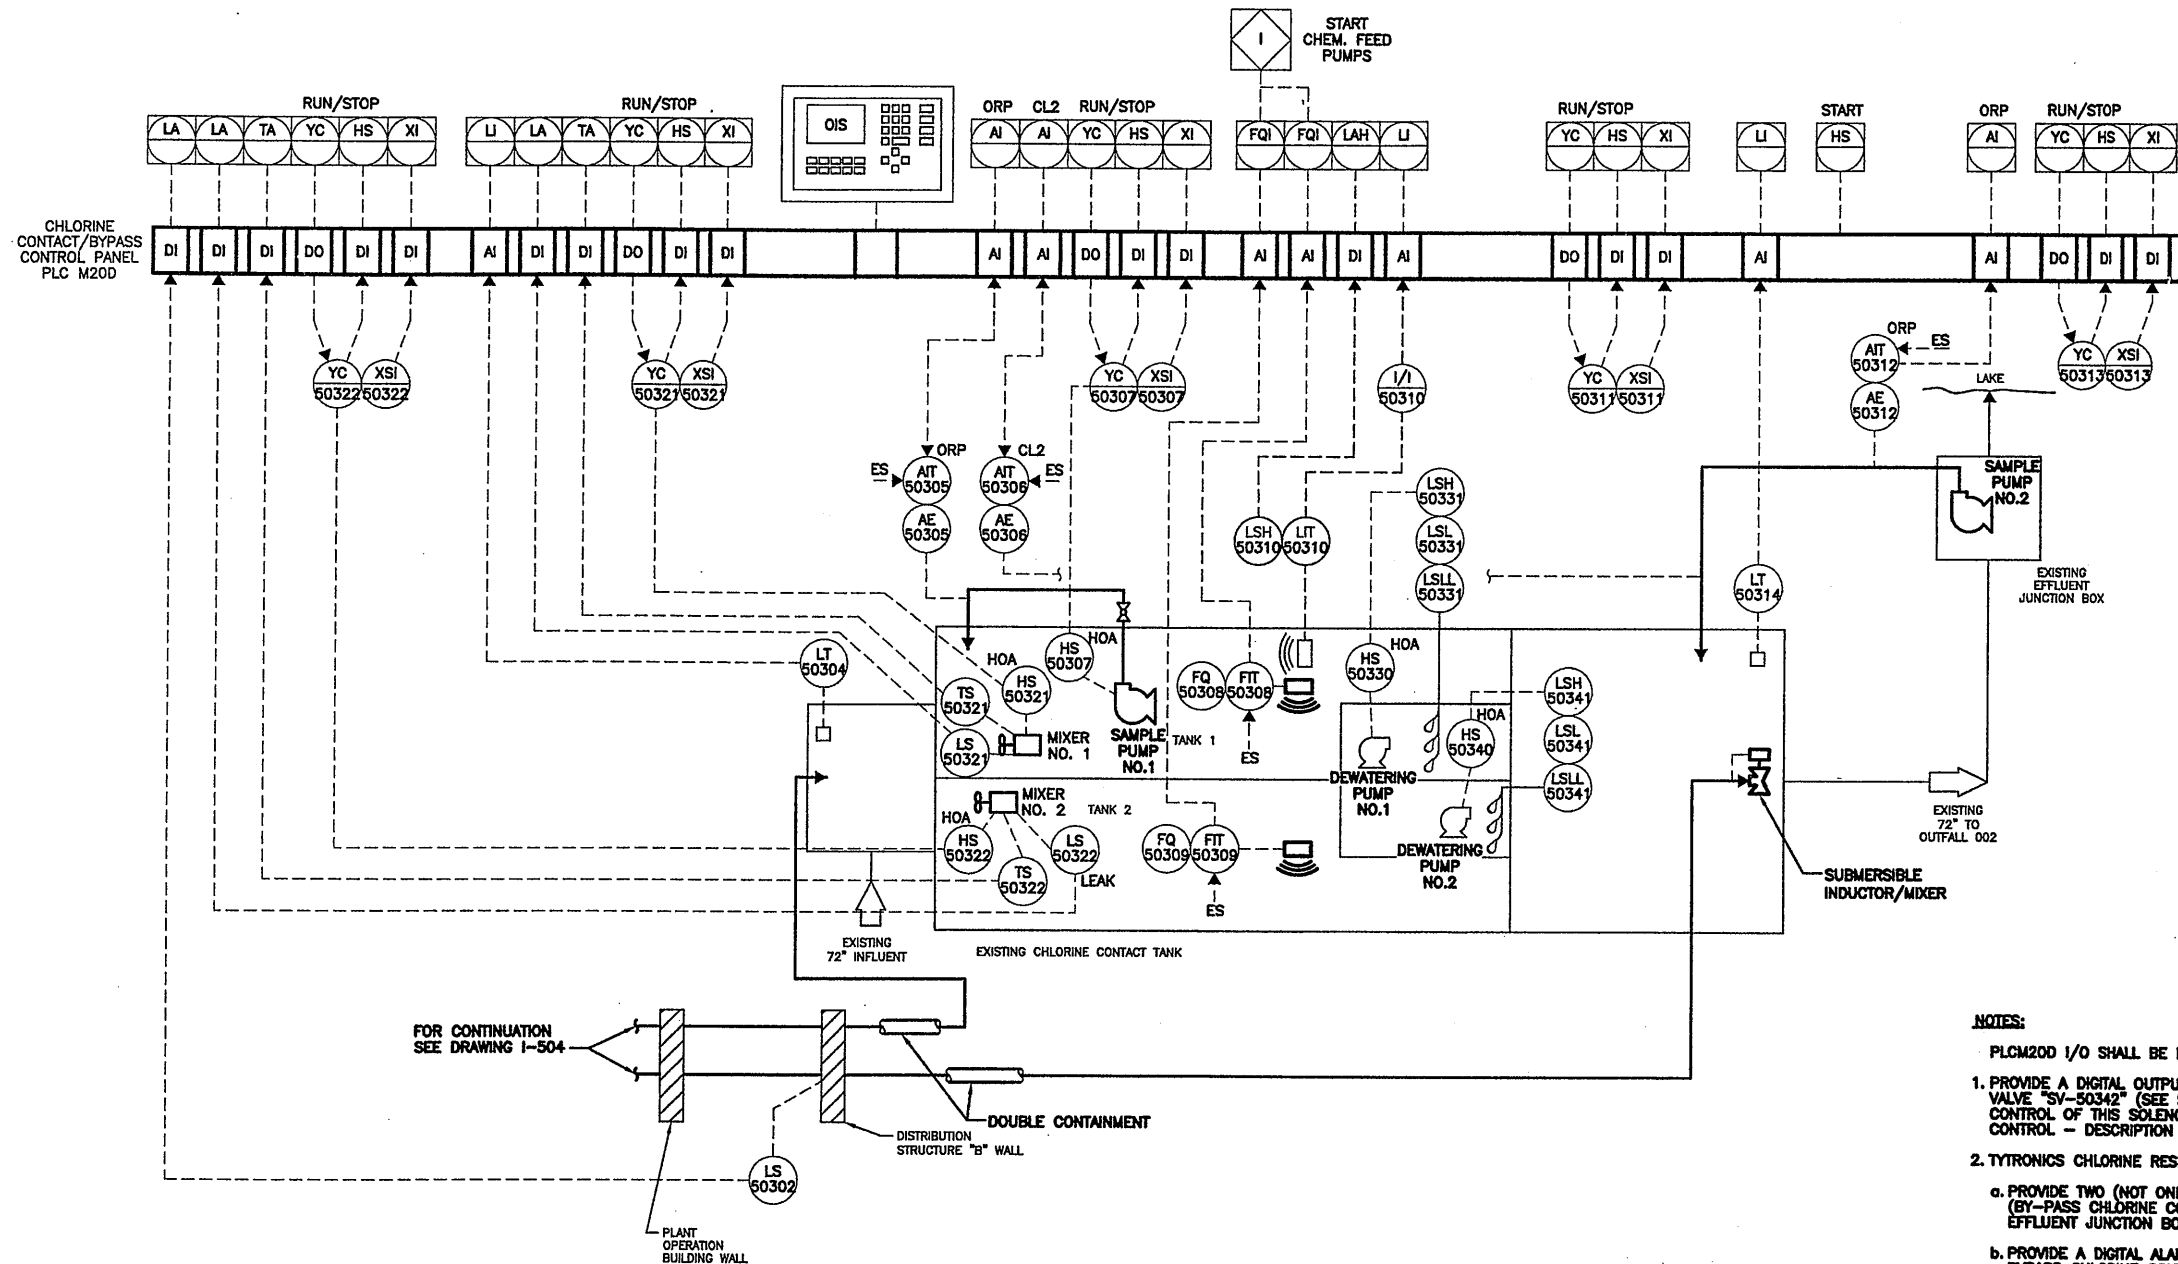

NOTES:

- PLCM20D I/O SHALL BE REVISED AS FOLLOWS USING SPARE PLC I/O:
- PROVIDE A DIGITAL OUTPUT TO THE ANALYZER WASH WATER SOLENOID VALVE "SV-50342" (SEE SPECIFICATION 17012 AND DRAWING M-508). CONTROL OF THIS SOLENOID WILL BE IN ACCORDANCE WITH THE PROCESS CONTROL - DESCRIPTION OF OPERATION.
 - TYTRONICS CHLORINE RESIDUAL ANALYZER AIT-50306.
 - PROVIDE TWO (NOT ONE AS SHOWN) ANALOG INPUTS TO THE PLCM20D (BY-PASS CHLORINE CONTACT TANK CHLORINE RESIDUAL "AIT-50306" AND EFFLUENT JUNCTION BOX CHLORINE RESIDUAL "AIT-50343").
 - PROVIDE A DIGITAL ALARM INPUT (CHLORINE ANALYZER ALARM) FOR THE BY-PASS CHLORINE CONTACT TANK CHLORINE RESIDUAL ANALYZER (YA-50306) AND THE EFFLUENT JUNCTION BOX CHLORINE RESIDUAL ANALYZER (YA-50343).
 - STRANTRON ORP CONTROLLER AIT-50305 (BY-PASS TANK ORP).
 - PROVIDE ANALOG OUTPUT FROM PLCM20D (BY-PASS TOTAL FLOW "FQ-50344B") TO AIT-50305. THIS OUTPUT SHALL BE THE TOTAL OF FIT-50308 AND FIT-50309.
 - STRANTRON ORP CONTROLLER AIT-50312 (EFFLUENT JUNCTION BOX ORP).
 - PROVIDE ANALOG OUTPUT FROM PLCM20D (BY-PASS TOTAL FLOW "FQ-50344B") TO AIT 50312. THIS OUTPUT SHALL BE THE TOTAL OF FIT-50308 AND FIT-50309.

RECORD DRAWING


THESE DRAWINGS HAVE BEEN REVISED TO REFLECT MAJOR CHANGES IF ANY, WHICH OCCURRED DURING CONSTRUCTION. REVISIONS ARE BASED UPON INFORMATION SUPPLIED BY CONTRACTOR.
DATE 10/21/05 FOR KAMPOLLET

THIS DRAWING WAS PREPARED AT THE SCALE INDICATED IN THE TITLE BLOCK. INACCURACIES IN THE STATED SCALE MAY BE INTRODUCED WHEN DRAWINGS ARE REPRODUCED BY ANY MEANS. USE THE GRAPHIC SCALE BAR IN THE TITLE BLOCK TO DETERMINE THE ACTUAL SCALE OF THIS DRAWING.

Layer: ON=*; OFF=*REF*
02/01/01 OBG JEC
05503046/06591509.DWG

| No. | Date | Revisions | Init |
|-----|----------|---------------------|------|
| 0 | 4/20/01 | ISSUED FOR APPROVAL | JEC |
| 1 | 7/11/01 | AS BID | |
| 2 | 10/31/05 | RECORD DRAWING | |

In charge of PLD
Designed by SAT
Drawn by JEC
Checked by PLD




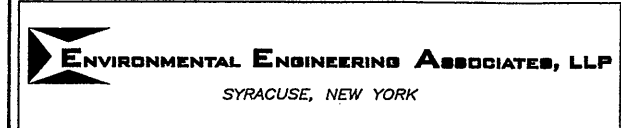


ONONDAGA COUNTY • DEPARTMENT OF DRAINAGE AND SANITATION • SYRACUSE, NEW YORK
METROPOLITAN SYRACUSE WASTEWATER TREATMENT PLANT
STAGE III AMMONIA AND STAGE II PHOSPHORUS REMOVAL PROJECT
BYPASS CHLORINE CONTACT/OUTFALL 002 PLAN
(PLC M20D)
CONTROL DIAGRAM
INSTRUMENTATION



File Number 00659
Date APRIL 2001
Kampollet

I-505

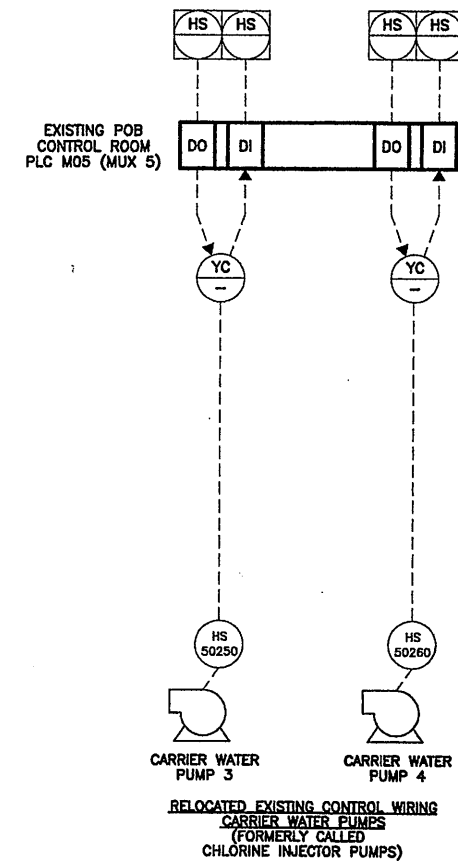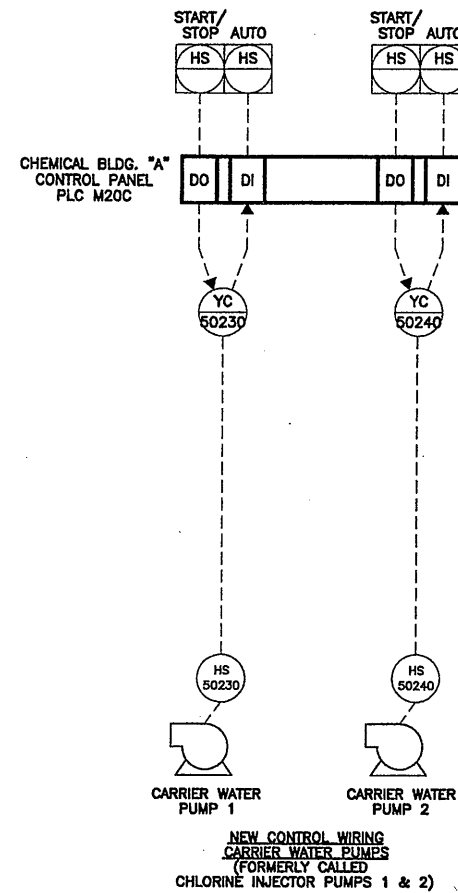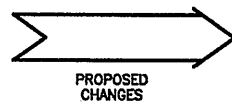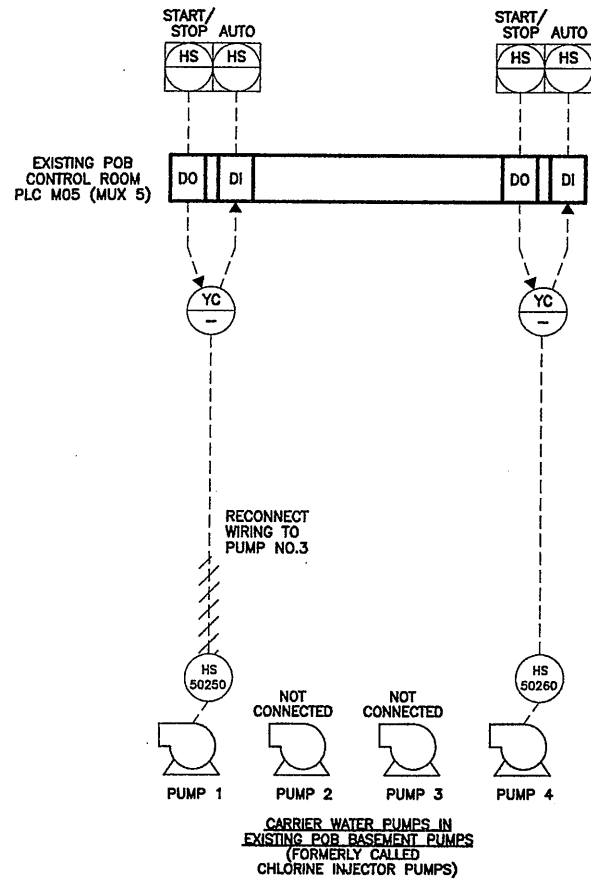

Layer: ON=*; OFF=*REF*

02/01/01 OBG JEC
05503046/06591506.DWG

RECORD DRAWING

THESE DRAWINGS HAVE BEEN REVIEWED TO REFLECT
MAJOR CHANGES, IF ANY, WHICH OCCURRED DURING
CONSTRUCTION. REVISIONS ARE BASED UPON
INFORMATION SUPPLIED BY CONTRACTOR.

DATE: 10/26/05 PER: [Signature]

THIS DRAWING WAS PREPARED AT THE SCALE INDICATED IN THE
TITLE BLOCK. INACCURACIES IN THE STATED SCALE MAY BE
INTRODUCED WHEN DRAWINGS ARE REPRODUCED BY ANY MEANS.
USE THE GRAPHIC SCALE BAR IN THE TITLE BLOCK TO
DETERMINE THE ACTUAL SCALE OF THIS DRAWING.

NOT TO SCALE

| No. | Date | Revisions | Init |
|-----|----------|---------------------|-------------|
| 0 | 4/20/01 | ISSUED FOR APPROVAL | [Signature] |
| 1 | 7/11/01 | AS BID | [Signature] |
| 2 | 10/31/05 | RECORD DRAWING | [Signature] |

In charge of --- PLD ---
Designed by --- SAT ---
Drawn by --- JEC ---
Checked by --- PLD ---



ONONDAGA COUNTY • DEPARTMENT OF DRAINAGE AND SANITATION • SYRACUSE, NEW YORK
METROPOLITAN SYRACUSE WASTEWATER TREATMENT PLANT
STAGE III AMMONIA AND STAGE II PHOSPHORUS REMOVAL PROJECT


**CONTROL MODIFICATIONS TO
EXISTING CHLORINE INJECTOR PUMPS**
INSTRUMENTATION




File Number
00659
Date
APRIL 2001
[Signature]

I-506


NO ALTERATIONS PERMITTED HEREON EXCEPT
AS PROVIDED UNDER SECTION 7209 SUBDIVISION
2 OF THE NEW YORK STATE EDUCATION LAW

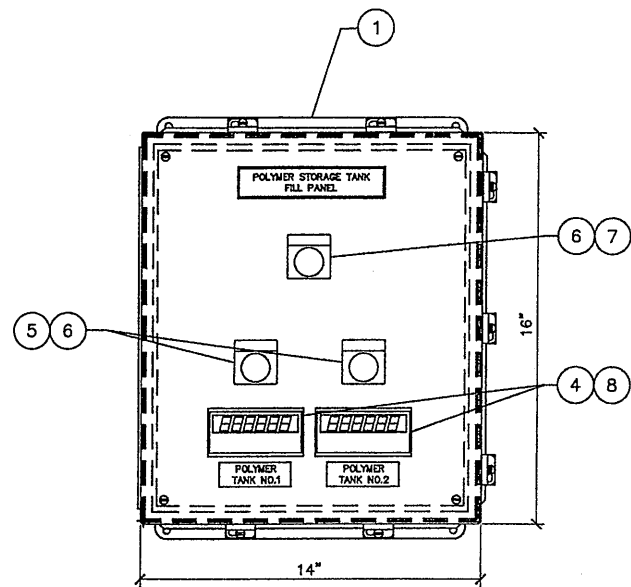

CONTROL PANEL FRONT VIEW

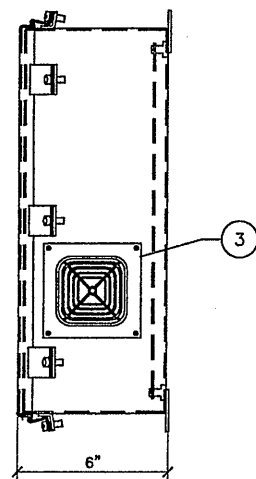


SIDE VIEW

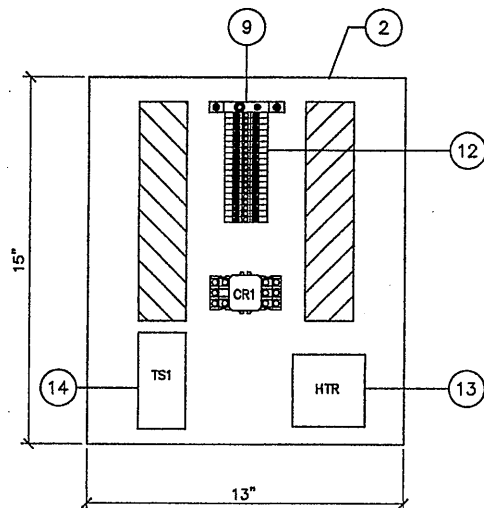


CONTROL PANEL INTERIOR VIEW

= AC WIREWAY
 = DC WIREWAY


POLYMER STORAGE TANK FILL PANEL DETAIL

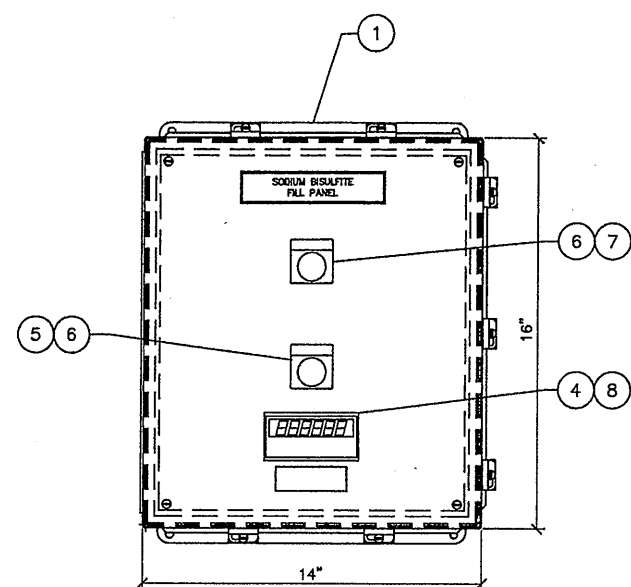

CONTROL PANEL FRONT VIEW

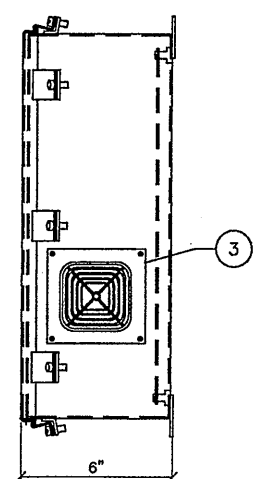

SIDE VIEW

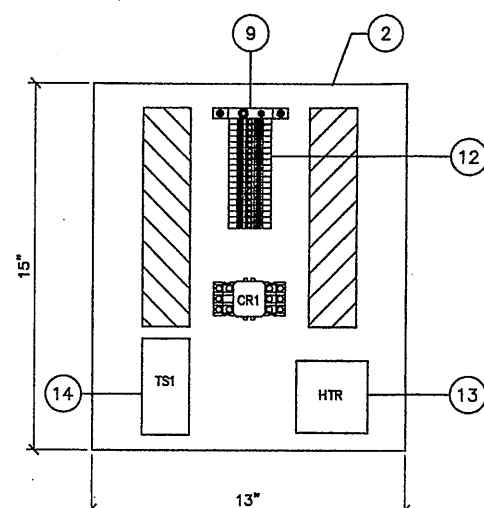

CONTROL PANEL INTERIOR VIEW

= AC WIREWAY
 = DC WIREWAY

SODIUM BISULFITE FILL PANEL DETAIL

BILL OF MATERIALS

| SYMBOL | QUANTITY | MODEL NUMBER | MANUFACTURER | DESCRIPTION |
|--------|----------|--------------------|---------------|----------------------------|
| 1 | A/R | SEE SPECIFICATIONS | Hoffman | NEMA 4X Enclosure |
| 2 | A/R | SEE SPECIFICATIONS | Hoffman | Sub-panel |
| 3 | A/R | SEE SPECIFICATIONS | Federal | Alarm Horn |
| 4 | A/R | SEE SPECIFICATIONS | Red Lion | Process Meter, MA |
| 5 | A/R | SEE SPECIFICATIONS | Allen-Bradley | Indicating Light |
| 6 | A/R | SEE SPECIFICATIONS | Allen-Bradley | Engraved Legend Nameplate |
| 7 | A/R | SEE SPECIFICATIONS | Allen-Bradley | Momentary Pushbutton |
| 8 | A/R | SEE SPECIFICATIONS | Red Lion | Process Meter Power Supply |
| 9 | A/R | SEE SPECIFICATIONS | - | Circuit Breaker |
| 10 | A/R | SEE SPECIFICATIONS | P&B | Relay, 24dc Coil |
| 11 | A/R | SEE SPECIFICATIONS | Allen-Bradley | Relay base, Din Rail |
| 12 | A/R | SEE SPECIFICATIONS | - | Terminal Block |
| 13 | A/R | SEE SPECIFICATIONS | Chromalox | Heater |
| 14 | A/R | SEE SPECIFICATIONS | Chromalox | Thermostat |


Layer: ON=*, OFF=REF*
01/25/01 OBG JEC
05503048/05591510.DWG

NOT TO SCALE

NO ALTERATIONS PERMITTED HEREON EXCEPT AS PROVIDED UNDER SECTION 7209 SUBDIVISION 2 OF THE NEW YORK STATE EDUCATION LAW

| No. | Date | Revisions | Init |
|-----|----------|---------------------|------|
| 0 | 4/20/01 | ISSUED FOR APPROVAL | PLD |
| 1 | 7/11/01 | AS BID | SAT |
| 2 | 10/31/05 | RECORD DRAWING | JEC |

In charge of PLD
Designed by SAT
Drawn by JEC
Checked by PLD

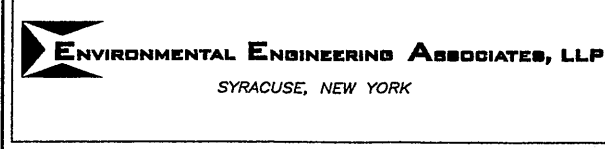

ONONDAGA COUNTY • DEPARTMENT OF DRAINAGE AND SANITATION • SYRACUSE, NEW YORK
METROPOLITAN SYRACUSE WASTEWATER TREATMENT PLANT
STAGE III AMMONIA AND STAGE II PHOSPHORUS REMOVAL PROJECT

INSTRUMENTATION CONTROL PANELS LAYOUT
INSTRUMENTATION


RECORD DRAWING

THESE DRAWINGS HAVE BEEN REVISED TO REFLECT MAJOR CHANGES, IF ANY, WHICH OCCURRED DURING CONSTRUCTION. REVISIONS ARE BASED UPON INFORMATION SUPPLIED BY CONTRACTOR.


DATE: 10/21/05 PER: [Signature]

THIS DRAWING WAS PREPARED AT THE SCALE INDICATED IN THE TITLE BLOCK. INACCURACIES IN THE STATED SCALE MAY BE INTRODUCED WHEN DRAWINGS ARE REPRODUCED BY ANY MEANS. USE THE GRAPHIC SCALE BAR IN THE TITLE BLOCK TO DETERMINE THE ACTUAL SCALE OF THIS DRAWING.


File Number: 00659
Date: APRIL 2001
I-507

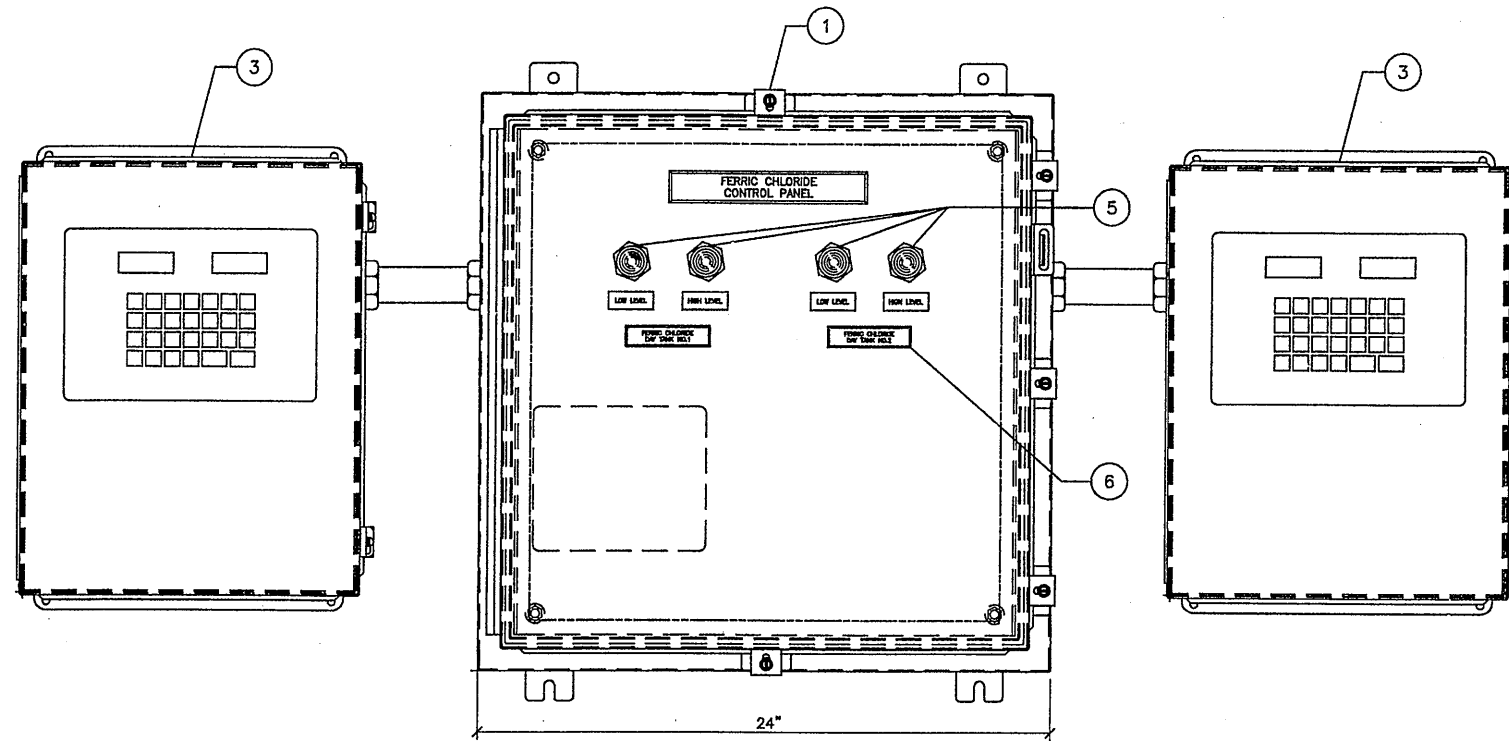

CONTROL PANEL FRONT VIEW

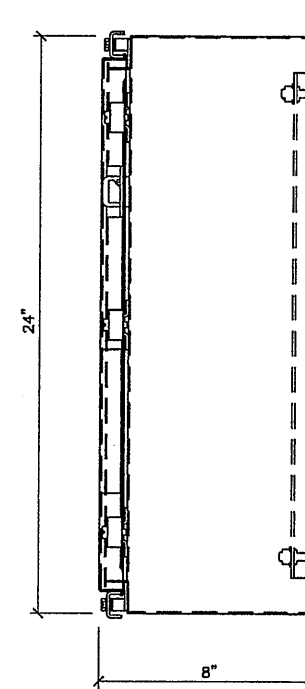

SIDE VIEW

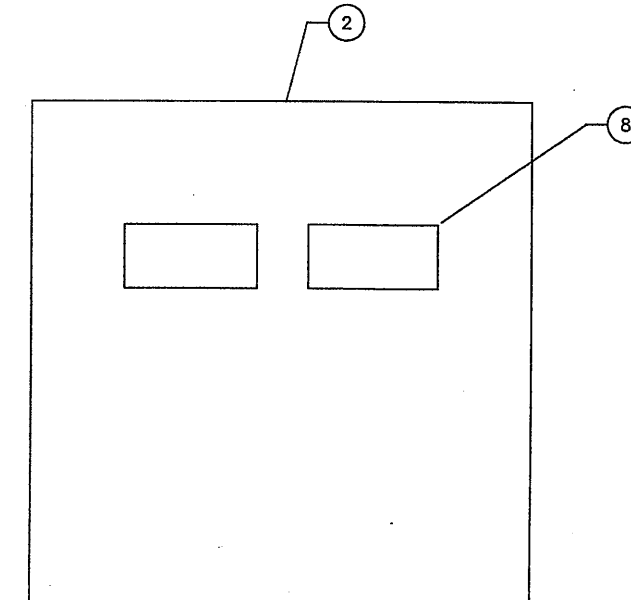

CONTROL PANEL INTERIOR VIEW

BILL OF MATERIALS

| SYMBOL | QUANTITY | MODEL NUMBER | MANUFACTURER | DESCRIPTION |
|--------|----------|--------------------|----------------|-----------------------------|
| 1 | A/R | SEE SPECIFICATIONS | Hoffman | NEMA 4X Enclosure |
| 2 | A/R | SEE SPECIFICATIONS | Hoffman | Sub-panel |
| 3 | A/R | SEE SPECIFICATIONS | By Contract 1B | Level Indicating Controller |
| 4 | - | - | - | - |
| 5 | A/R | SEE SPECIFICATIONS | Allen-Bradley | Indicating Light |
| 6 | A/R | SEE SPECIFICATIONS | - | Engraved Legend Nameplate |
| 7 | - | - | - | - |
| 8 | A/R | SEE SPECIFICATIONS | - | I/I Isolators |
| 9 | A/R | SEE SPECIFICATIONS | - | - |
| 10 | A/R | SEE SPECIFICATIONS | - | - |
| 11 | A/R | SEE SPECIFICATIONS | - | - |
| 12 | A/R | SEE SPECIFICATIONS | - | - |
| 13 | A/R | SEE SPECIFICATIONS | - | - |
| 14 | A/R | SEE SPECIFICATIONS | - | - |

FERRIC CHLORIDE CONTROL PANEL DETAIL

Layer: ON=*, OFF=*REF*

01/25/01 DBG JEC
05503046/06591511.DWG

NOT TO SCALE

| No. | Date | Revisions | Init |
|-----|----------|---------------------|------|
| 0 | 4/20/01 | ISSUED FOR APPROVAL | PLD |
| 1 | 7/11/01 | AS BID | JEC |
| 2 | 10/31/05 | RECORD DRAWING | PLD |

In charge of --- PLD
Designed by --- SAT
Drawn by --- JEC
Checked by --- PLD

ENVIRONMENTAL ENGINEERING ASSOCIATES, LLP
SYRACUSE, NEW YORK

ONONDAGA COUNTY • DEPARTMENT OF DRAINAGE AND SANITATION • SYRACUSE, NEW YORK
METROPOLITAN SYRACUSE WASTEWATER TREATMENT PLANT
STAGE III AMMONIA AND STAGE II PHOSPHORUS REMOVAL PROJECT

INSTRUMENTATION CONTROL PANELS LAYOUT
INSTRUMENTATION




File Number
00659
Date
APRIL 2001
Ed Campolongo

1-508

RECORD DRAWING

THESE DIMENSIONS HAVE BEEN REVIEWED TO REFLECT
MAJOR CHANGES, IF ANY, WHICH OCCURRED DURING
CONSTRUCTION. REVISIONS ARE BASED UPON
INFORMATION SUPPLIED BY CONTRACTOR.
DATE: 10/21/05 FOR: *Ed Campolongo*

THIS DRAWING WAS PREPARED AT THE SCALE INDICATED IN THE
TITLE BLOCK. INACCURACIES IN THE STATED SCALE MAY BE
INTRODUCED WHEN DRAWINGS ARE REPRODUCED BY ANY MEANS.
USE THE GRAPHIC SCALE BAR IN THE TITLE BLOCK TO
DETERMINE THE ACTUAL SCALE OF THIS DRAWING.

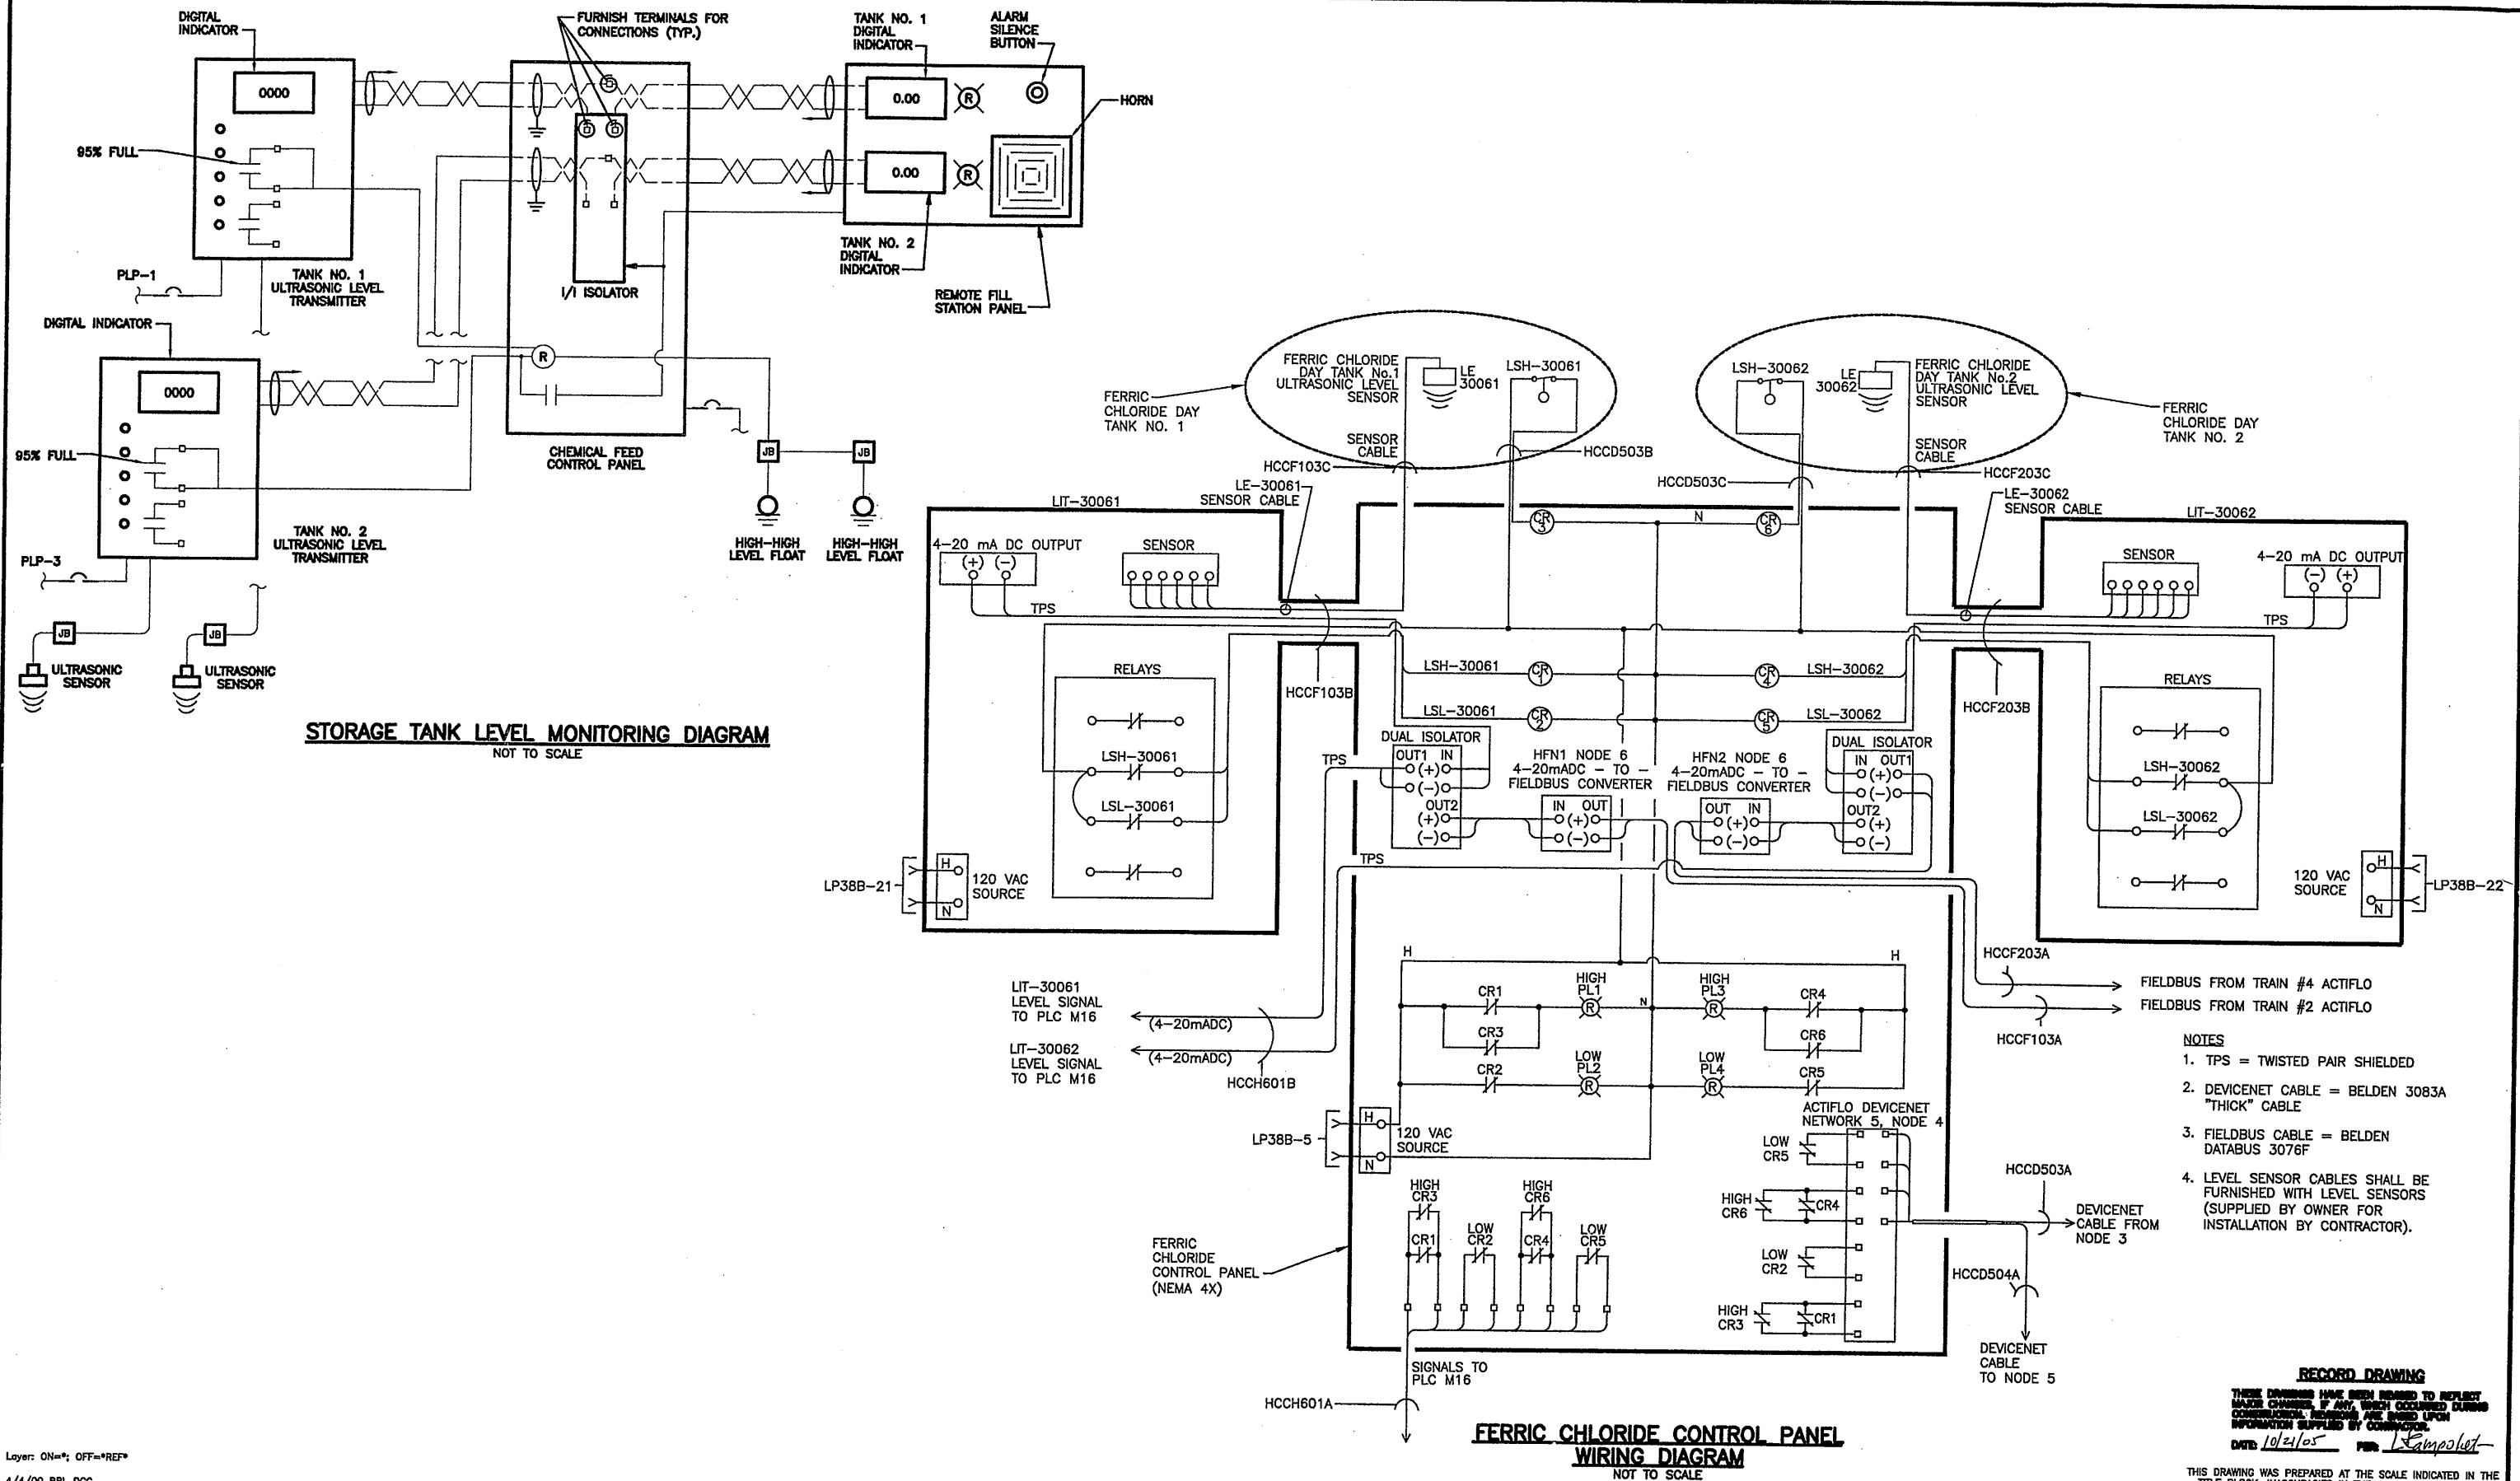

STORAGE TANK LEVEL MONITORING DIAGRAM
NOT TO SCALE

FERRIC CHLORIDE CONTROL PANEL WIRING DIAGRAM
NOT TO SCALE

- NOTES**
1. TPS = TWISTED PAIR SHIELDED
 2. DEVICENET CABLE = BELDEN 3083A "THICK" CABLE
 3. FIELDBUS CABLE = BELDEN DATABUS 3076F
 4. LEVEL SENSOR CABLES SHALL BE FURNISHED WITH LEVEL SENSORS (SUPPLIED BY OWNER FOR INSTALLATION BY CONTRACTOR).

RECORD DRAWING
 THESE DRAWINGS HAVE BEEN REVISIONED TO REFLECT MAJOR CHANGES, IF ANY, WHICH OCCURRED DURING CONSTRUCTION. REVISIONS ARE BASED UPON INFORMATION SUPPLIED BY CONTRACTOR.
 DATE: 10/21/05 FOR: *L. Campoliti*

THIS DRAWING WAS PREPARED AT THE SCALE INDICATED IN THE TITLE BLOCK. INACCURACIES IN THE STATED SCALE MAY BE INTRODUCED WHEN DRAWINGS ARE REPRODUCED BY ANY MEANS. USE THE GRAPHIC SCALE BAR IN THE TITLE BLOCK TO DETERMINE THE ACTUAL SCALE OF THIS DRAWING.

Layer: ON=*, OFF=*REF*
 4/4/00 BBL DCC
 05503000/06591509.DWG

| No. | Date | Revisions | Init |
|-----|----------|---------------------|------|
| 0 | 3/30/01 | ISSUED FOR APPROVAL | |
| 1 | 7/11/01 | AS BID | |
| 2 | 10/31/05 | RECORD DRAWING | |

NO ALTERATIONS PERMITTED HEREON EXCEPT AS PROVIDED UNDER SECTION 7209 SUBDIVISION 2 OF THE NEW YORK STATE EDUCATION LAW

In charge of **TEL**
 Designed by **MEE**
 Drawn by **DCC**
 Checked by **FKP**



ONONDAGA COUNTY • DEPARTMENT OF DRAINAGE AND SANITATION • SYRACUSE, NEW YORK
 METROPOLITAN SYRACUSE WASTEWATER TREATMENT PLANT
 STAGE III AMMONIA AND STAGE II PHOSPHORUS REMOVAL PROJECT

LOOP WIRING DIAGRAMS

INSTRUMENTATION



File Number **00659**
 Date **APRIL 2001**
L. Campoliti

I-509

| CONDUIT NO. | CONDUIT SIZE | NO./SIZE CONDUCTORS | FROM | TO |
|-------------|--------------|---------------------|------------------------------|---|
| ACCD101A | 3/4" CRGS | 1 BELDEN 3083A | PLC M24 | MCC 34 |
| ACCD201A | 3/4" CRGS | 1 BELDEN 3083A | PLC M24 | MCC 38 |
| ACCD301A | 3/4" CRGS | | ADN3, N1 | ADN3, N1 |
| ACCD301B | 3/4" CRGS | TPS #16 | ADN3, N1 | EMP-1 MOTOR OVERLOAD |
| ACCD301C | 3/4" CRGS | TPS #16 | ADN3, N1 | EMP-2 MOTOR OVERLOAD |
| ACCD301D | 3/4" CRGS | TPS #16 | ADN3, N1 | EMP-1 RUN STATUS |
| ACCD301E | 3/4" CRGS | TPS #16 | ADN3, N1 | EMP-2 RUN STATUS |
| ACCD302A | 3/4" CRGS | 1 BELDEN 3083A | ADN3, N1 | ADN3, N2 |
| ACCD302B | 3/4" CRGS | TPS #16 | ADN3, N2 | EMP-3 MOTOR OVERLOAD |
| ACCD302C | 3/4" CRGS | TPS #16 | ADN3, N2 | EMP-3 RUN STATUS |
| ACCD302D | 3/4" CRGS | TPS #16 | ADN3, N2 | CLOGGED STRAINER ALARM |
| ACCD302E | 3/4" CRGS | TPS #16 | ADN3, N2 | LOSS OF SYSTEM PRESSURE ALARM |
| ACCH101A | 3/4" CRGS | 16 #14 | PLC M24 | TRANSFORMER ALARM PANEL |
| ACCE201A | 3/4" CRGS | CAT 5E | PLC M24 | UNIT SUBSTATION #1 |
| ACCH201B | 3/4" CRGS | GE CABLE | UNIT SUBSTATION #1 | UNIT SUBSTATION #2 |
| ACCH401A | 3/4" CRGS | TPS #16 | GAS DETECTION PANEL | AIT-70012, GAS DETECTOR |
| ACCH401B | 3/4" CRGS | 4 #14 | PLC IN LOW LIFT PUMP STATION | GAS DETECTION PANEL |
| ACCH402A | 2" CRGS | 11 TPS #16 | GAS DETECTION PANEL | JB-701 |
| ACCH402B | 3/4" CRGS | TPS #16 | JB-701 | AIT-70011, GAS DETECTOR |
| ACCH403A | 1-1/2" CRGS | 10 TPS #16 | JB-701 | JB-702 |
| ACCH403B | 3/4" CRGS | TPS #16 | JB-702 | AIT-70010, GAS DETECTOR |
| ACCH404A | 1-1/2" CRGS | 9 TPS #16 | JB-702 | JB-703 |
| ACCH404B | 3/4" CRGS | TPS #16 | JB-703 | AIT-70009, GAS DETECTOR |
| ACCH405A | 1-1/2" CRGS | 8 TPS #16 | JB-703 | JB-704 |
| ACCH405B | 3/4" CRGS | TPS #16 | JB-704 | AIT-70008, GAS DETECTOR |
| ACCH406A | 1-1/4" CRGS | 7 TPS #16 | JB-704 | JB-705 |
| ACCH406B | 3/4" CRGS | TPS #16 | JB-705 | AIT-70007, GAS DETECTOR |
| ACCH407A | 1-1/4" CRGS | 6 TPS #16 | JB-705 | JB-706 |
| ACCH407B | 3/4" CRGS | TPS #16 | JB-706 | AIT-70006, GAS DETECTOR |
| ACCH408A | 1-1/4" CRGS | 5 TPS #16 | JB-706 | JB-707 |
| ACCH408B | 3/4" CRGS | TPS #16 | JB-707 | AIT-70005, GAS DETECTOR |
| ACCH409A | 1" CRGS | 4 TPS #16 | JB-707 | JB-708 |
| ACCH409B | 3/4" CRGS | TPS #16 | JB-708 | AIT-70004, GAS DETECTOR |
| ACCH410A | 1" CRGS | 3 TPS #16 | JB-708 | JB-709 |
| ACCH410B | 3/4" CRGS | TPS #16 | JB-709 | AIT-70003, GAS DETECTOR |
| ACCH411A | 3/4" CRGS | 2 TPS #16 | JB-709 | JB-710 |
| ACCH411B | 3/4" CRGS | TPS #16 | JB-710 | AIT-70002, GAS DETECTOR |
| ACCH411C | 3/4" CRGS | TPS #16 | JB-710 | AIT-70001, GAS DETECTOR |
| ACCH501A | 3/4" CRGS | 2 #14 | PLC M16 | FSA-50032, EAST EWES FLOW SWITCH, CHEM BLDG C |
| ACCH502A | 3/4" CRGS | 2 #14 | PLC M16 | FSA-50033, WEST EWES FLOW SWITCH, CHEM BLDG C |
| ACCH503A | CRGS | 80 #14 | PLC M16 | HVAC DDC LOCAL CONTROL UNIT |
| ACCH801A | 3/4" CRGS | TPS #16 | STRAINER CONTROL PANEL | EFFLUENT WATER CONTROL PANEL |

| CONDUIT NO. | CONDUIT SIZE | NO./SIZE CONDUCTORS | FROM | TO |
|-------------|------------------|---------------------|--|--|
| BCCD310B | 3/4" CRGS | 1 BELDEN 3085A | JB-10A | JB-10A |
| BCCD310C | 3/4" CRGS | 1 BELDEN 3085A | JB-10A | JB-10A |
| BCCD310D | 3/4" CRGS | 1 BELDEN 3085A | JB-10A | JB-10A |
| BCCD310E | 3/4" CRGS | 1 BELDEN 3085A | JB-10A | JB-10A |
| BCCD312A | 3/4" CRGS | 1 BELDEN 3085A | JB-10A | JB-10A |
| BCCD312B | 3/4" CRGS | 1 BELDEN 3085A | JB-12A | JB-12A |
| BCCD312C | 3/4" CRGS | 1 BELDEN 3085A | JB-12A | JB-12A |
| BCCD312D | 3/4" CRGS | 1 BELDEN 3085A | JB-12A | JB-12A |
| BCCD312E | 3/4" CRGS | 1 BELDEN 3085A | JB-12A | JB-12A |
| BCCD314A | 3/4" CRGS | 1 BELDEN 3085A | JB-12A | JB-12A |
| BCCD314B | 3/4" CRGS | 1 BELDEN 3085A | JB-14A | JB-14A |
| BCCD314C | 3/4" CRGS | 1 BELDEN 3085A | JB-14A | JB-14A |
| BCCD417B | 3/4" CRGS | 1 BELDEN 3085A | JB-17A | JB-17A |
| BCCD417C | 3/4" CRGS | 1 BELDEN 3085A | JB-17A | JB-17A |
| BCCD417D | 3/4" CRGS | 1 BELDEN 3085A | JB-17A | JB-17A |
| BCCD417E | 3/4" CRGS | 1 BELDEN 3085A | JB-17A | JB-17A |
| BCCD501A | 3/4" CRGS | 1 BELDEN 3083A | PLC M19 | MCC 31, BUCKET 1D (BWP-20031) |
| BCCD502A | 3/4" CRGS | 1 BELDEN 3083A | MCC 31, BUCKET 1D (BWP-20031) | MCC 42, BUCKET 1D (BWP-20032) |
| BCCD503A | 3/4" CRGS | 1 BELDEN 3083A | MCC 42, BUCKET 1D (BWP-20032) | MCC 43, BUCKET 1D (BWP-20033) |
| BCCD504A | 3/4" CRGS | 1 BELDEN 3083A | MCC 43, BUCKET 1D (BWP-20033) | LSH-20021, BACKWASH TANK #1 HIGH LEVEL |
| BCCD504B | 3/4" LIQUID-TITE | TPS #16 | BNDS, NODE 5 - BACKWASH TANK #1 LEVEL ALARMS | LSL-20021, BACKWASH TANK #1 LOW LEVEL |
| BCCD504C | 3/4" LIQUID-TITE | TPS #16 | BNDS, NODE 5 - BACKWASH TANK #1 LEVEL ALARMS | LSL-20021, BACKWASH TANK #1 LOW LEVEL |
| BCCD505A | 3/4" CRGS | 1 BELDEN 3083A | BNDS, NODE 5 - BACKWASH TANK #1 LEVEL ALARMS | LSH-20022, BACKWASH TANK #2 HIGH LEVEL |
| BCCD505B | 3/4" LIQUID-TITE | TPS #16 | BNDS, NODE 6 - BACKWASH TANK #2 LEVEL ALARMS | LSL-20022, BACKWASH TANK #2 LOW LEVEL |
| BCCD505C | 3/4" LIQUID-TITE | TPS #16 | BNDS, NODE 6 - BACKWASH TANK #2 LEVEL ALARMS | LSL-20022, BACKWASH TANK #2 LOW LEVEL |
| BCCD506A | 3/4" CRGS | 1 BELDEN 3083A | BNDS, NODE 6 - BACKWASH TANK #2 LEVEL ALARMS | UV-20022, BACKWASH TANK #2 VALVE ACTUATOR |
| BCCD507A | 3/4" CRGS | 1 BELDEN 3083A | UV-20022, BACKWASH TANK #2 VALVE ACTUATOR | UV-20021, BACKWASH TANK #1 VALVE ACTUATOR |
| BCCD601A | 3/4" CRGS | 1 BELDEN 3083A | PLC M19 | BDN6, NODE 2 - INSTRUMENT AIR ALARMS |
| BCCD601B | 3/4" LIQUID-TITE | TPS #16 | BDN6, NODE 2 - INSTRUMENT AIR ALARMS | PSL-20041, INSTRUMENT AIR LOW PRESSURE #1 |
| BCCD601C | 3/4" LIQUID-TITE | TPS #16 | BDN6, NODE 2 - INSTRUMENT AIR ALARMS | PSL-20042, INSTRUMENT AIR LOW PRESSURE #2 |
| BCCD602A | 3/4" CRGS | 1 BELDEN 3083A | BDN6, NODE 2 - INSTRUMENT AIR ALARMS | BDN6, NODE 3 - INFLUENT LEVEL ALARMS |
| BCCD602B | 3/4" LIQUID-TITE | TPS #16 | BDN6, NODE 3 - INFLUENT LEVEL ALARMS | LSH-20001, BAF INFLUENT CHANNEL HIGH LEVEL |
| BCCD602C | NOT USED | | | |
| BCCD603A | 3/4" CRGS | 1 BELDEN 3083A | BDN6, NODE 3 - INFLUENT LEVEL ALARMS | BDN6, NODE 4 - EFFLUENT LEVEL ALARMS |
| BCCD603B | 3/4" LIQUID-TITE | TPS #16 | BDN6, NODE 4 - EFFLUENT LEVEL ALARMS | LSL-20011, BAF EFFLUENT CHANNEL LOW LEVEL |
| BCCD701A | 3/4" CRGS | 1 BELDEN 3083A | PLC M21 | MCC 30 |
| BCCD702A | 3/4" CRGS | 1 BELDEN 3083A | MCC 30 | MCC 31 |
| BCCD703A | 3/4" CRGS | 1 BELDEN 3083A | MCC 31 | BLOW OFF VALVE CONTROL PANEL |
| BCCD801A | 3/4" CRGS | 1 BELDEN 3083A | PLC M22 | MCC 42 |
| BCCD802A | 3/4" CRGS | 1 BELDEN 3083A | MCC 42 | MCC 43 |
| BCCD803A | 3/4" CRGS | 1 BELDEN 3083A | MCC 43 | BLOW OFF VALVE CONTROL PANEL |
| BCCF102A | 3/4" CRGS | 1 BELDEN 3078F | JB-4B | JB-2B |
| BCCF102B | 3/4" CRGS | 1 BELDEN 3078F | JB-2B | FIT-20200, BAF CELL #2 AIR FLOW |
| BCCF102C | 3/4" CRGS | 1 BELDEN 3078F | FIT-20200, BAF CELL #2 AIR FLOW | FV-20200, BAF CELL #2 AIR FLOW CONTROL VALVE |
| BCCF102D | 3/4" CRGS | 1 BELDEN 3078F | JB-2B | PIT-20201B, BAF CELL #2 LOWER PRESSURE |
| BCCF102E | 3/4" CRGS | 1 BELDEN 3078F | PIT-20201B, BAF CELL #2 LOWER PRESSURE | PIT-20201A, BAF CELL #2 UPPER PRESSURE |
| BCCF104A | 3/4" CRGS | 1 BELDEN 3078F | JB-6B | JB-4B |
| BCCF104B | 3/4" CRGS | 1 BELDEN 3078F | JB-4B | FIT-20400, BAF CELL #4 AIR FLOW |
| BCCF104C | 3/4" CRGS | 1 BELDEN 3078F | FIT-20400, BAF CELL #4 AIR FLOW | FV-20400, BAF CELL #4 AIR FLOW CONTROL VALVE |
| BCCF104D | 3/4" CRGS | 1 BELDEN 3078F | JB-4B | PIT-20401B, BAF CELL #4 LOWER PRESSURE |
| BCCF104E | 3/4" CRGS | 1 BELDEN 3078F | PIT-20401B, BAF CELL #4 LOWER PRESSURE | PIT-20401A, BAF CELL #4 UPPER PRESSURE |
| BCCF106A | 3/4" CRGS | 1 BELDEN 3078F | PLC M19 | JB-6B |
| BCCF106B | 3/4" CRGS | 1 BELDEN 3078F | JB-6B | FIT-20600, BAF CELL #6 AIR FLOW |
| BCCF106C | 3/4" CRGS | 1 BELDEN 3078F | FIT-20600, BAF CELL #6 AIR FLOW | FV-20600, BAF CELL #6 AIR FLOW CONTROL VALVE |
| BCCF106D | 3/4" CRGS | 1 BELDEN 3078F | JB-6B | PIT-20601B, BAF CELL #6 LOWER PRESSURE |
| BCCF106E | 3/4" CRGS | 1 BELDEN 3078F | PIT-20601B, BAF CELL #6 LOWER PRESSURE | PIT-20601A, BAF CELL #6 UPPER PRESSURE |
| BCCF207A | 3/4" CRGS | 1 BELDEN 3078F | JB-7B | JB-7B |
| BCCF207B | 3/4" CRGS | 1 BELDEN 3078F | JB-7B | FIT-20700, BAF CELL #7 AIR FLOW |
| BCCF207C | 3/4" CRGS | 1 BELDEN 3078F | FIT-20700, BAF CELL #7 AIR FLOW | FV-20700, BAF CELL #7 AIR FLOW CONTROL VALVE |
| BCCF207D | 3/4" CRGS | 1 BELDEN 3078F | JB-7B | PIT-20701B, BAF CELL #7 LOWER PRESSURE |
| BCCF207E | 3/4" CRGS | 1 BELDEN 3078F | PIT-20701B, BAF CELL #7 LOWER PRESSURE | PIT-20701A, BAF CELL #7 UPPER PRESSURE |
| BCCF208A | 3/4" CRGS | 1 BELDEN 3078F | JB-8B | JB-8B |

Layer: ON=; OFF=REF*
4/24/01 BBL DCC
05503000/06591510.DWG

NOT TO SCALE

NO ALTERATIONS PERMITTED HEREON EXCEPT AS PROVIDED UNDER SECTION 7209 SUBDIVISION 2 OF THE NEW YORK STATE EDUCATION LAW

| No. | Date | Revisions | Init |
|-----|----------|---------------------|------|
| 0 | 4/20/01 | ISSUED FOR APPROVAL | JK |
| 1 | 7/11/01 | AS BID | |
| 2 | 10/31/05 | RECORD DRAWING | |

In charge of _ TEL _ _ _
Designed by _ AHL _ _ _
Drawn by _ DCC _ _ _
Checked by _ FKP _ _ _



ONONDAGA COUNTY • DEPARTMENT OF DRAINAGE AND SANITATION • SYRACUSE, NEW YORK
METROPOLITAN SYRACUSE WASTEWATER TREATMENT PLANT
STAGE III AMMONIA AND STAGE II PHOSPHORUS REMOVAL PROJECT

CONDUIT SCHEDULE

INSTRUMENTATION

RECORD DRAWING

THIS DRAWING HAS BEEN REVISIONED TO REFLECT CHANGES BY ANY, WHICH OCCURRED DURING CONSTRUCTION. REVISIONS ARE BASED UPON INFORMATION SUPPLIED BY CONTRACTOR.

DATE 10/1/05 FOR K. Lampoliet

THIS DRAWING WAS PREPARED AT THE SCALE INDICATED IN THE TITLE BLOCK. INACCURACIES IN THE STATED SCALE MAY BE INTRODUCED WHEN DRAWINGS ARE REPRODUCED BY ANY MEANS. USE THE GRAPHIC SCALE BAR IN THE TITLE BLOCK TO DETERMINE THE ACTUAL SCALE OF THIS DRAWING.

File Number 00659
Date APRIL 2001
I-510
K. Lampoliet

| CONDUIT NO. | CONDUIT SIZE | NO./SIZE CONDUCTORS | FROM | TO |
|-------------|------------------|---------------------|---|--|
| BCCF208B | 3/4" CRGS | 1 BELDEN 3078F | JB-8B | FT-20800, BAF CELL #8 AIR FLOW |
| BCCF208C | 3/4" CRGS | 1 BELDEN 3078F | FT-20800, BAF CELL #8 AIR FLOW | FV-20800, BAF CELL #8 AIR FLOW CONTROL VALVE |
| BCCF208D | 3/4" CRGS | 1 BELDEN 3078F | JB-8B | PIT-20801B, BAF CELL #8 LOWER PRESSURE |
| BCCF208E | 3/4" CRGS | 1 BELDEN 3078F | PIT-20801B, BAF CELL #8 LOWER PRESSURE | PIT-20801A, BAF CELL #8 UPPER PRESSURE |
| BCCF209A | 3/4" CRGS | 1 BELDEN 3078F | PLC M19 | JB-9B |
| BCCF209B | 3/4" CRGS | 1 BELDEN 3078F | JB-9B | FT-20900, BAF CELL #9 AIR FLOW |
| BCCF209C | 3/4" CRGS | 1 BELDEN 3078F | FT-20900, BAF CELL #9 AIR FLOW | FV-20900, BAF CELL #9 AIR FLOW CONTROL VALVE |
| BCCF209D | 3/4" CRGS | 1 BELDEN 3078F | JB-9B | PIT-20901B, BAF CELL #9 LOWER PRESSURE |
| BCCF209E | 3/4" CRGS | 1 BELDEN 3078F | PIT-20901B, BAF CELL #9 LOWER PRESSURE | PIT-20901A, BAF CELL #9 UPPER PRESSURE |
| BCCF301A | 3/4" CRGS | 1 BELDEN 3078F | JB-3B | JB-1B |
| BCCF301B | 3/4" CRGS | 1 BELDEN 3078F | JB-1B | FT-20100, BAF CELL #1 AIR FLOW |
| BCCF301C | 3/4" CRGS | 1 BELDEN 3078F | FT-20100, BAF CELL #1 AIR FLOW | FV-20100, BAF CELL #1 AIR FLOW CONTROL VALVE |
| BCCF301D | 3/4" CRGS | 1 BELDEN 3078F | JB-1B | PIT-20101B, BAF CELL #1 LOWER PRESSURE |
| BCCF301E | 3/4" CRGS | 1 BELDEN 3078F | PIT-20101B, BAF CELL #1 LOWER PRESSURE | PIT-20101A, BAF CELL #1 UPPER PRESSURE |
| BCCF303A | 3/4" CRGS | 1 BELDEN 3078F | JB-5B | JB-3B |
| BCCF303B | 3/4" CRGS | 1 BELDEN 3078F | JB-3B | FT-20300, BAF CELL #3 AIR FLOW |
| BCCF303C | 3/4" CRGS | 1 BELDEN 3078F | FT-20300, BAF CELL #3 AIR FLOW | FV-20300, BAF CELL #3 AIR FLOW CONTROL VALVE |
| BCCF303D | 3/4" CRGS | 1 BELDEN 3078F | JB-3B | PIT-20301B, BAF CELL #3 LOWER PRESSURE |
| BCCF303E | 3/4" CRGS | 1 BELDEN 3078F | PIT-20301B, BAF CELL #3 LOWER PRESSURE | PIT-20301A, BAF CELL #3 UPPER PRESSURE |
| BCCF305A | 3/4" CRGS | 1 BELDEN 3078F | PLC M19 | JB-5B |
| BCCF305B | 3/4" CRGS | 1 BELDEN 3078F | JB-5B | FT-20500, BAF CELL #5 AIR FLOW |
| BCCF305C | 3/4" CRGS | 1 BELDEN 3078F | FT-20500, BAF CELL #5 AIR FLOW | FV-20500, BAF CELL #5 AIR FLOW CONTROL VALVE |
| BCCF305D | 3/4" CRGS | 1 BELDEN 3078F | JB-5B | PIT-20501B, BAF CELL #5 LOWER PRESSURE |
| BCCF305E | 3/4" CRGS | 1 BELDEN 3078F | PIT-20501B, BAF CELL #5 LOWER PRESSURE | PIT-20501A, BAF CELL #5 UPPER PRESSURE |
| BCCF414A | 3/4" CRGS | 1 BELDEN 3078F | PLC M19 | JB-14B |
| BCCF414B | 3/4" CRGS | 1 BELDEN 3078F | JB-14B | FT-21400, BAF CELL #14 AIR FLOW |
| BCCF414C | 3/4" CRGS | 1 BELDEN 3078F | FT-21400, BAF CELL #14 AIR FLOW | FV-21400, BAF CELL #14 AIR FLOW CONTROL VALVE |
| BCCF414D | 3/4" CRGS | 1 BELDEN 3078F | JB-14B | PIT-21401B, BAF CELL #14 LOWER PRESSURE |
| BCCF414E | 3/4" CRGS | 1 BELDEN 3078F | PIT-21401B, BAF CELL #14 LOWER PRESSURE | PIT-21401A, BAF CELL #14 UPPER PRESSURE |
| BCCF416A | 3/4" CRGS | 1 BELDEN 3078F | JB-16B | JB-16B |
| BCCF416B | 3/4" CRGS | 1 BELDEN 3078F | JB-16B | FT-21600, BAF CELL #16 AIR FLOW |
| BCCF416C | 3/4" CRGS | 1 BELDEN 3078F | FT-21600, BAF CELL #16 AIR FLOW | FV-21600, BAF CELL #16 AIR FLOW CONTROL VALVE |
| BCCF416D | 3/4" CRGS | 1 BELDEN 3078F | JB-16B | PIT-21601B, BAF CELL #16 LOWER PRESSURE |
| BCCF416E | 3/4" CRGS | 1 BELDEN 3078F | PIT-21601B, BAF CELL #16 LOWER PRESSURE | PIT-21601A, BAF CELL #16 UPPER PRESSURE |
| BCCF418A | 3/4" CRGS | 1 BELDEN 3078F | JB-18B | JB-18B |
| BCCF418B | 3/4" CRGS | 1 BELDEN 3078F | JB-18B | FT-21800, BAF CELL #18 AIR FLOW |
| BCCF418C | 3/4" CRGS | 1 BELDEN 3078F | FT-21800, BAF CELL #18 AIR FLOW | FV-21800, BAF CELL #18 AIR FLOW CONTROL VALVE |
| BCCF418D | 3/4" CRGS | 1 BELDEN 3078F | JB-18B | PIT-21801B, BAF CELL #18 LOWER PRESSURE |
| BCCF418E | 3/4" CRGS | 1 BELDEN 3078F | PIT-21801B, BAF CELL #18 LOWER PRESSURE | PIT-21801A, BAF CELL #18 UPPER PRESSURE |
| BCCF510A | 3/4" CRGS | 1 BELDEN 3078F | PLC M19 | JB-10B |
| BCCF510B | 3/4" CRGS | 1 BELDEN 3078F | JB-10B | FT-21000, BAF CELL #10 AIR FLOW |
| BCCF510C | 3/4" CRGS | 1 BELDEN 3078F | FT-21000, BAF CELL #10 AIR FLOW | FV-21000, BAF CELL #10 AIR FLOW CONTROL VALVE |
| BCCF510D | 3/4" CRGS | 1 BELDEN 3078F | JB-10B | PIT-21001B, BAF CELL #10 LOWER PRESSURE |
| BCCF510E | 3/4" CRGS | 1 BELDEN 3078F | PIT-21001B, BAF CELL #10 LOWER PRESSURE | PIT-21001A, BAF CELL #10 UPPER PRESSURE |
| BCCF511A | 3/4" CRGS | 1 BELDEN 3078F | JB-11B | JB-11B |
| BCCF511B | 3/4" CRGS | 1 BELDEN 3078F | JB-11B | FT-21100, BAF CELL #11 AIR FLOW |
| BCCF511C | 3/4" CRGS | 1 BELDEN 3078F | FT-21100, BAF CELL #11 AIR FLOW | FV-21100, BAF CELL #11 AIR FLOW CONTROL VALVE |
| BCCF511D | 3/4" CRGS | 1 BELDEN 3078F | JB-11B | PIT-21101B, BAF CELL #11 LOWER PRESSURE |
| BCCF511E | 3/4" CRGS | 1 BELDEN 3078F | PIT-21101B, BAF CELL #11 LOWER PRESSURE | PIT-21101A, BAF CELL #11 UPPER PRESSURE |
| BCCF512A | 3/4" CRGS | 1 BELDEN 3078F | JB-12B | JB-12B |
| BCCF512B | 3/4" CRGS | 1 BELDEN 3078F | JB-12B | FT-21200, BAF CELL #12 AIR FLOW |
| BCCF512C | 3/4" CRGS | 1 BELDEN 3078F | FT-21200, BAF CELL #12 AIR FLOW | FV-21200, BAF CELL #12 AIR FLOW CONTROL VALVE |
| BCCF512D | 3/4" CRGS | 1 BELDEN 3078F | JB-12B | PIT-21201B, BAF CELL #12 LOWER PRESSURE |
| BCCF512E | 3/4" CRGS | 1 BELDEN 3078F | PIT-21201B, BAF CELL #12 LOWER PRESSURE | PIT-21201A, BAF CELL #12 UPPER PRESSURE |
| BCCF613A | 3/4" CRGS | 1 BELDEN 3078F | PLC M19 | JB-13B |
| BCCF613B | 3/4" CRGS | 1 BELDEN 3078F | JB-13B | FT-21300, BAF CELL #13 AIR FLOW |
| BCCF613C | 3/4" CRGS | 1 BELDEN 3078F | FT-21300, BAF CELL #13 AIR FLOW | FV-21300, BAF CELL #13 AIR FLOW CONTROL VALVE |
| BCCF613D | 3/4" CRGS | 1 BELDEN 3078F | JB-13B | PIT-21301B, BAF CELL #13 LOWER PRESSURE |
| BCCF613E | 3/4" CRGS | 1 BELDEN 3078F | PIT-21301B, BAF CELL #13 LOWER PRESSURE | PIT-21301A, BAF CELL #13 UPPER PRESSURE |
| BCCF615A | 3/4" CRGS | 1 BELDEN 3078F | JB-15B | JB-15B |
| BCCF615B | 3/4" CRGS | 1 BELDEN 3078F | JB-15B | FT-21500, BAF CELL #15 AIR FLOW |
| BCCF615C | 3/4" CRGS | 1 BELDEN 3078F | FT-21500, BAF CELL #15 AIR FLOW | FV-21500, BAF CELL #15 AIR FLOW CONTROL VALVE |
| BCCF615D | 3/4" CRGS | 1 BELDEN 3078F | JB-15B | PIT-21501B, BAF CELL #15 LOWER PRESSURE |
| BCCF615E | 3/4" CRGS | 1 BELDEN 3078F | PIT-21501B, BAF CELL #15 LOWER PRESSURE | PIT-21501A, BAF CELL #15 UPPER PRESSURE |
| BCCF617A | 3/4" CRGS | 1 BELDEN 3078F | JB-17B | JB-17B |
| BCCF617B | 3/4" CRGS | 1 BELDEN 3078F | JB-17B | FT-21700, BAF CELL #17 AIR FLOW |
| BCCF617C | 3/4" CRGS | 1 BELDEN 3078F | FT-21700, BAF CELL #17 AIR FLOW | FV-21700, BAF CELL #17 AIR FLOW CONTROL VALVE |
| BCCF617D | 3/4" CRGS | 1 BELDEN 3078F | JB-17B | PIT-21701B, BAF CELL #17 LOWER PRESSURE |
| BCCF617E | 3/4" CRGS | 1 BELDEN 3078F | PIT-21701B, BAF CELL #17 LOWER PRESSURE | PIT-21701A, BAF CELL #17 UPPER PRESSURE |
| BCCF701A | 3/4" CRGS | 1 BELDEN 3078F | PLC M19 | JB-A |
| BCCF701B | 3/4" CRGS | 1 BELDEN 3078F | JB-A | BFN7, NODE 4 - CONVERTER |
| BCCF701C | 3/4" LIQUID-TITE | TPS #16 | BFN7, NODE 4 - CONVERTER | LT-20001, BAF EFFLUENT LEVEL TRANSMITTER |
| BCCF701D | 3/4" CRGS | 1 BELDEN 3078F | JB-A | AIT-20003, BAF INFLUENT PH |
| BCCF701E | 3/4" CRGS | 1 BELDEN 3078F | AIT-20003, BAF INFLUENT PH | TT-20004, BAF INFLUENT TEMPERATURE |
| BCCF702A | 3/4" CRGS | 1 BELDEN 3078F | JB-B | JB-B |
| BCCF702B | 3/4" CRGS | 1 BELDEN 3078F | JB-B | FT-20020, USED BACKWASH FLOW |
| BCCF702C | 3/4" CRGS | 1 BELDEN 3078F | JB-B | BFN7, NODE 7 - CONVERTER |
| BCCF702D | 3/4" LIQUID-TITE | TPS #16 | BFN7, NODE 7 - CONVERTER | LT-20021, BACKWASH TANK #1 LEVEL TRANSMITTER |
| BCCF702E | 3/4" CRGS | 1 BELDEN 3078F | BFN7, NODE 7 - CONVERTER | BFN7, NODE 8 - CONVERTER |
| BCCF702F | 3/4" LIQUID-TITE | TPS #16 | BFN7, NODE 8 - CONVERTER | LT-20022, BACKWASH TANK #2 LEVEL TRANSMITTER |
| BCCF703A | 3/4" CRGS | 1 BELDEN 3078F | JB-B | JB-C |
| BCCF703B | 3/4" CRGS | 1 BELDEN 3078F | JB-C | BFN7, NODE 9 - CONVERTER |
| BCCF703C | 3/4" LIQUID-TITE | TPS #16 | BFN7, NODE 9 - CONVERTER | FT-20000, BAF INFLUENT FLOW |
| BCCF801A | 3/4" CRGS | 1 BELDEN 3078F | PLC M19 | JB-D |
| BCCF801B | 3/4" CRGS | 1 BELDEN 3078F | JB-D | BFN8, NODE 5 - CONVERTER |
| BCCF801C | 3/4" LIQUID-TITE | TPS #16 | BFN8, NODE 5 - CONVERTER | AIT-20002, BAF INFLUENT NH3 |
| BCCF801D | 3/4" CRGS | 1 BELDEN 3078F | JB-D | BFN8, NODE 4 - CONVERTER |
| BCCF801E | 3/4" LIQUID-TITE | TPS #16 | BFN8, NODE 4 - CONVERTER | AIT-20012, BAF EFFLUENT NH3 |
| BCCF802A | 3/4" CRGS | 1 BELDEN 3078F | JB-E | JB-E |
| BCCF802B | 3/4" CRGS | 1 BELDEN 3078F | JB-E | LT-20011, BAF EFFLUENT CHANNEL LEVEL TRANSMITTER |


| CONDUIT NO. | CONDUIT SIZE | NO./SIZE CONDUCTORS | FROM | TO |
|-------------|------------------|---------------------|--|---|
| BCCF802C | 3/4" CRGS | 1 BELDEN 3078F | LT-20011, BAF EFFLUENT CHANNEL LEVEL TRANSMITTER | AIT-20013, BAF EFFLUENT PH |
| BCCF802D | 3/4" CRGS | 1 BELDEN 3078F | JB-E | BFN8, NODE 6 - CONVERTER |
| BCCF802E | 3/4" LIQUID-TITE | TPS #16 | BFN8, NODE 6 - CONVERTER | AIT-20014A, BAF EFFLUENT DO #1 |
| BCCF802F | 3/4" CRGS | 1 BELDEN 3078F | BFN8, NODE 6 - CONVERTER | BFN8, NODE 5 - CONVERTER |
| BCCF802G | 3/4" LIQUID-TITE | TPS #16 | BFN8, NODE 5 - CONVERTER | AIT-20014B, BAF EFFLUENT DO #2 |
| BCCH101A | 3/4" CRGS | 1 BELDEN 9463 | PLC M19 | PLC M21 |
| BCCH201A | 3/4" CRGS | 1 BELDEN 9463 | PLC M19 | PLC M22 |
| BCCH301A | 3/4" CRGS | TPS #16 | PLC M21 | PIT-20051A, BLOWER HEADER PRESSURE A |
| BCCH302A | 3/4" CRGS | TPS #16 | PLC M22 | PIT-20051B, BLOWER HEADER PRESSURE B |
| BCCH303A | 3/4" CRGS | TPS #16 (3 COND.) | PLC M22 | TIT-20052A, BLOWER HEADER TEMPERATURE A |
| BCCH304A | 3/4" CRGS | TPS #16 (3 COND.) | PLC M22 | TIT-20052B, BLOWER HEADER TEMPERATURE B |
| BCCH305A | 3/4" CRGS | 2 TPS #16 | BLOW OFF VALVE CONTROL PANEL | FVZ/FVZO-20053A, BLOWER HEADER BLOW-OFF VALVE A |
| BCCH306A | 3/4" CRGS | 8 #14 | BLOW OFF VALVE CONTROL PANEL | ZSO/ZSC/FVA/HS-20053A, BLOWER BLOW-OFF VALVE A |
| BCCH307A | 3/4" CRGS | 2 TPS #16 | BLOW OFF VALVE CONTROL PANEL | FVZ/FVZO-20053B, BLOWER HEADER BLOW-OFF VALVE B |
| BCCH308A | 3/4" CRGS | 8 #14 | BLOW OFF VALVE CONTROL PANEL | ZSO/ZSC/FVA/HS-20053B, BLOWER BLOW-OFF VALVE B |
| BCCH310A | 3/4" CRGS | 2 TPS #16 (3 COND.) | PLC M21 | JB-CA |
| BCCH310B | 3/4" LIQUID-TITE | TPS #16 (3 COND.) | JB-CA | TE-20152, BLOWER #1 OUTLET TEMPERATURE |
| BCCH310C | 3/4" LIQUID-TITE | TPS #16 (3 COND.) | JB-CA | TE-20151, BLOWER #1 INLET TEMPERATURE |
| BCCH311A | 1-1/4" CRGS | 4 TPS #16 (3 COND.) | PLC M21 | JB-CB |
| BCCH311B | 3/4" LIQUID-TITE | TPS #16 (3 COND.) | JB-CB | TE-20154, MOTOR #1 NON-SHAFT END TEMP. |
| BCCH311C | 3/4" LIQUID-TITE | TPS #16 (3 COND.) | JB-CB | TE-20153, BLOWER #1 BLOWER INBOARD TEMP. |
| BCCH311D | 3/4" LIQUID-TITE | TPS #16 (3 COND.) | JB-CB | TE-20156, MOTOR #1 SHAFT END TEMP. |
| BCCH311E | 3/4" LIQUID-TITE | TPS #16 (3 COND.) | JB-CB | TE-20155, BLOWER #1 OUTBOARD TEMP. |
| BCCH312A | 1" CRGS | 4 TPS #16 | PLC M21 | JB-CC |
| BCCH312B | 3/4" LIQUID-TITE | TPS #16 | JB-CC | VT-20152, BLOWER #1 OUTBOARD VIBRATION |
| BCCH312C | 3/4" LIQUID-TITE | TPS #16 | JB-CC | VT-20151, BLOWER #1 INBOARD VIBRATION |
| BCCH312D | 3/4" LIQUID-TITE | TPS #16 | JB-CC | VT-20154, MOTOR #1 SHAFT END VIBRATION |
| BCCH312E | 3/4" LIQUID-TITE | TPS #16 | JB-CC | VT-20153, MOTOR #1 NON-SHAFT END VIBRATION |
| BCCH313A | 3/4" CRGS | 2 TPS #16 | PLC M21 | FVZO/FVZI-20157, BLOWER #1 INLET VALVE |
| BCCH314A | 3/4" CRGS | 8 #14 | PLC M21 | ZSO/ZSC/FVA/HS-20157, BLOWER #1 INLET VALVE |
| BCCH315A | 3/4" CRGS | TPS #16 | PLC M21 | PDT-20158, BLOWER #1 INLET FILTER |
| BCCH320A | 3/4" CRGS | 2 TPS #16 (3 COND.) | PLC M21 | JB-CD |
| BCCH320B | 3/4" LIQUID-TITE | TPS #16 (3 COND.) | JB-CD | TE-20252, BLOWER #2 OUTLET TEMPERATURE |
| BCCH320C | 3/4" LIQUID-TITE | TPS #16 (3 COND.) | JB-CD | TE-20251, BLOWER #2 INLET TEMPERATURE |
| BCCH321A | 1-1/4" CRGS | 4 TPS #16 (3 COND.) | PLC M21 | JB-CE |
| BCCH321B | 3/4" LIQUID-TITE | TPS #16 (3 COND.) | JB-CE | TE-20254, MOTOR #2 NON-SHAFT END TEMP. |
| BCCH321C | 3/4" LIQUID-TITE | TPS #16 (3 COND.) | JB-CE | TE-20253, BLOWER #2 BLOWER INBOARD TEMP. |
| BCCH321D | 3/4" LIQUID-TITE | TPS #16 (3 COND.) | JB-CE | TE-20256, MOTOR #2 SHAFT END TEMP. |
| BCCH321E | 3/4" LIQUID-TITE | TPS #16 (3 COND.) | JB-CE | TE-20255, BLOWER #2 OUTBOARD TEMP. |
| BCCH322A | 1" CRGS | 4 TPS #16 | PLC M21 | JB-CF |
| BCCH322B | 3/4" LIQUID-TITE | TPS #16 | JB-CF | VT-20252, BLOWER #2 OUTBOARD VIBRATION |
| BCCH322C | 3/4" LIQUID-TITE | TPS #16 | JB-CF | VT-20251, BLOWER #2 INBOARD VIBRATION |
| BCCH322D | 3/4" LIQUID-TITE | TPS #16 | JB-CF | VT-20254, MOTOR #2 SHAFT END VIBRATION |
| BCCH322E | 3/4" LIQUID-TITE | TPS #16 | JB-CF | VT-20253, MOTOR #2 NON-SHAFT END VIBRATION |
| BCCH323A | 3/4" CRGS | 2 TPS #16 | PLC M21 | FVZO/FVZI-20257, BLOWER #2 INLET VALVE |
| BCCH324A | 3/4" CRGS | 8 #14 | PLC M21 | ZSO/ZSC/FVA/HS-20257, BLOWER #2 INLET VALVE |
| BCCH325A | 3/4" CRGS | TPS #16 | PLC M21 | PDT-20258, BLOWER #2 INLET FILTER |
| BCCH330A | 3/4" CRGS | 2 TPS #16 (3 COND.) | PLC M21 | JB-CG |
| BCCH330B | 3/4" LIQUID-TITE | TPS #16 (3 COND.) | JB-CG | TE-20352, BLOWER #3 OUTLET TEMPERATURE |
| BCCH330C | 3/4" LIQUID-TITE | TPS #16 (3 COND.) | JB-CG | TE-20351, BLOWER #3 INLET TEMPERATURE |
| BCCH331A | 1-1/4" CRGS | 4 TPS #16 (3 COND.) | PLC M21 | JB-CH |
| BCCH331B | 3/4" LIQUID-TITE | TPS #16 (3 COND.) | JB-CH | TE-20354, MOTOR #3 NON-SHAFT END TEMP. |
| BCCH331C | 3/4" LIQUID-TITE | TPS #16 (3 COND.) | JB-CH | TE-20353, BLOWER #3 BLOWER INBOARD TEMP. |
| BCCH331D | 3/4" LIQUID-TITE | TPS #16 (3 COND.) | JB-CH | TE-20356, MOTOR #3 SHAFT END TEMP. |
| BCCH331E | 3/4" LIQUID-TITE | TPS #16 (3 COND.) | JB-CH | TE-20355, BLOWER #3 OUTBOARD TEMP. |
| BCCH332A | 1" CRGS | 4 TPS #16 | PLC M21 | JB-CI |
| BCCH332B | 3/4" LIQUID-TITE | TPS #16 | JB-CI | VT-20352, BLOWER #3 OUTBOARD VIBRATION |
| BCCH332C | 3/4" LIQUID-TITE | TPS #16 | JB-CI | VT-20351, BLOWER #3 INBOARD VIBRATION |
| BCCH332D | 3/4" LIQUID-TITE | TPS #16 | JB-CI | VT-20354, MOTOR #3 SHAFT END VIBRATION |
| BCCH332E | 3/4" LIQUID-TITE | TPS #16 | JB-CI | VT-20353, MOTOR #3 NON-SHAFT END VIBRATION |
| BCCH333A | 3/4" CRGS | 2 TPS #16 | PLC M21 | FVZO/FVZI-20357, BLOWER #3 INLET VALVE |
| BCCH334A | 3/4" CRGS | 8 #14 | PLC M21 | ZSO/ZSC/FVA/HS-20357, BLOWER #3 INLET VALVE |
| BCCH335A | 3/4" CRGS | TPS #16 | PLC M21 | PDT-20358, BLOWER #3 INLET FILTER |
| BCCH340A | 3/4" CRGS | 2 TPS #16 (3 COND.) | PLC M21</ | |

| CONDUIT NO. | CONDUIT SIZE | NO./SIZE CONDUCTORS | FROM | TO |
|-------------|------------------|---------------------|--|---|
| BCCH352D | 3/4" LIQUID-TITE | TPS #16 | JB-DC | VT-20554, MOTOR #5 SHAFT END VIBRATION |
| BCCH352E | 3/4" LIQUID-TITE | TPS #16 | JB-DC | VT-20553, MOTOR #5 NON-SHAFT END VIBRATION |
| BCCH353A | 3/4" CRGS | 2 TPS #16 | PLC M22 | FVZO/FVZI-20557, BLOWER #5 INLET VALVE |
| BCCH354A | 3/4" CRGS | 8 #14 | PLC M22 | ZSO/ZSC/FVA/HS-20557, BLOWER #5 INLET VALVE |
| BCCH355A | 3/4" CRGS | TPS #16 | PLC M22 | PDT-20558, BLOWER #5 INLET FILTER |
| BCCH360A | 3/4" CRGS | 2 TPS #16 (3 COND.) | PLC M22 | JB-DD |
| BCCH360B | 3/4" LIQUID-TITE | TPS #16 (3 COND.) | JB-DD | TE-20652, BLOWER #6 OUTLET TEMPERATURE |
| BCCH360C | 3/4" LIQUID-TITE | TPS #16 (3 COND.) | JB-DD | TE-20651, BLOWER #6 INLET TEMPERATURE |
| BCCH361A | 1-1/4" CRGS | 4 TPS #16 (3 COND.) | PLC M22 | JB-DE |
| BCCH361B | 3/4" LIQUID-TITE | TPS #16 (3 COND.) | JB-DE | TE-20654, MOTOR #6 NON-SHAFT END TEMP. |
| BCCH361C | 3/4" LIQUID-TITE | TPS #16 (3 COND.) | JB-DE | TE-20653, BLOWER #6 BLOWER INBOARD TEMP. |
| BCCH361D | 3/4" LIQUID-TITE | TPS #16 (3 COND.) | JB-DE | TE-20656, MOTOR #6 SHAFT END TEMP. |
| BCCH361E | 3/4" LIQUID-TITE | TPS #16 (3 COND.) | JB-DE | TE-20655, BLOWER #6 OUTBOARD TEMP. |
| BCCH362A | 1" CRGS | 4 TPS #16 | PLC M22 | JB-DF |
| BCCH362B | 3/4" LIQUID-TITE | TPS #16 | JB-DF | VT-20652, BLOWER #6 OUTBOARD VIBRATION |
| BCCH362C | 3/4" LIQUID-TITE | TPS #16 | JB-DF | VT-20651, BLOWER #6 INBOARD VIBRATION |
| BCCH362D | 3/4" LIQUID-TITE | TPS #16 | JB-DF | VT-20654, MOTOR #6 SHAFT END VIBRATION |
| BCCH362E | 3/4" LIQUID-TITE | TPS #16 | JB-DF | VT-20653, MOTOR #6 NON-SHAFT END VIBRATION |
| BCCH363A | 3/4" CRGS | 2 TPS #16 | PLC M22 | FVZO/FVZI-20657, BLOWER #6 INLET VALVE |
| BCCH364A | 3/4" CRGS | 8 #14 | PLC M22 | ZSO/ZSC/FVA/HS-20657, BLOWER #6 INLET VALVE |
| BCCH365A | 3/4" CRGS | TPS #16 | PLC M22 | PDT-20658, BLOWER #6 INLET FILTER |
| BCCH370A | 3/4" CRGS | 2 TPS #16 (3 COND.) | PLC M22 | JB-DG |
| BCCH370B | 3/4" LIQUID-TITE | TPS #16 (3 COND.) | JB-DG | TE-20752, BLOWER #7 OUTLET TEMPERATURE |
| BCCH370C | 3/4" LIQUID-TITE | TPS #16 (3 COND.) | JB-DG | TE-20751, BLOWER #7 INLET TEMPERATURE |
| BCCH371A | 1-1/4" CRGS | 4 TPS #16 (3 COND.) | PLC M22 | JB-DH |
| BCCH371B | 3/4" LIQUID-TITE | TPS #16 (3 COND.) | JB-DH | TE-20754, MOTOR #7 NON-SHAFT END TEMP. |
| BCCH371C | 3/4" LIQUID-TITE | TPS #16 (3 COND.) | JB-DH | TE-20753, BLOWER #7 BLOWER INBOARD TEMP. |
| BCCH371D | 3/4" LIQUID-TITE | TPS #16 (3 COND.) | JB-DH | TE-20756, MOTOR #7 SHAFT END TEMP. |
| BCCH371E | 3/4" LIQUID-TITE | TPS #16 (3 COND.) | JB-DH | TE-20755, BLOWER #7 OUTBOARD TEMP. |
| BCCH372A | 1" CRGS | 4 TPS #16 | PLC M22 | JB-DI |
| BCCH372B | 3/4" LIQUID-TITE | TPS #16 | JB-DI | VT-20752, BLOWER #7 OUTBOARD VIBRATION |
| BCCH372C | 3/4" LIQUID-TITE | TPS #16 | JB-DI | VT-20751, BLOWER #7 INBOARD VIBRATION |
| BCCH372D | 3/4" LIQUID-TITE | TPS #16 | JB-DI | VT-20754, MOTOR #7 SHAFT END VIBRATION |
| BCCH372E | 3/4" LIQUID-TITE | TPS #16 | JB-DI | VT-20753, MOTOR #7 NON-SHAFT END VIBRATION |
| BCCH373A | 3/4" CRGS | 2 TPS #16 | PLC M22 | FVZO/FVZI-20757, BLOWER #7 INLET VALVE |
| BCCH374A | 3/4" CRGS | 8 #14 | PLC M22 | ZSO/ZSC/FVA/HS-20757, BLOWER #7 INLET VALVE |
| BCCH375A | 3/4" CRGS | TPS #16 | PLC M22 | PDT-20758, BLOWER #7 INLET FILTER |
| BCCH380A | 3/4" CRGS | 2 TPS #16 (3 COND.) | PLC M22 | JB-DJ |
| BCCH380B | 3/4" LIQUID-TITE | TPS #16 (3 COND.) | JB-DJ | TE-20852, BLOWER #8 OUTLET TEMPERATURE |
| BCCH380C | 3/4" LIQUID-TITE | TPS #16 (3 COND.) | JB-DJ | TE-20851, BLOWER #8 INLET TEMPERATURE |
| BCCH381A | 1-1/4" CRGS | 4 TPS #16 (3 COND.) | PLC M22 | JB-DK |
| BCCH381B | 3/4" LIQUID-TITE | TPS #16 (3 COND.) | JB-DK | TE-20854, MOTOR #8 NON-SHAFT END TEMP. |
| BCCH381C | 3/4" LIQUID-TITE | TPS #16 (3 COND.) | JB-DK | TE-20853, BLOWER #8 BLOWER INBOARD TEMP. |
| BCCH381D | 3/4" LIQUID-TITE | TPS #16 (3 COND.) | JB-DK | TE-20856, MOTOR #8 SHAFT END TEMP. |
| BCCH381E | 3/4" LIQUID-TITE | TPS #16 (3 COND.) | JB-DK | TE-20855, BLOWER #8 OUTBOARD TEMP. |
| BCCH382A | 1" CRGS | 4 TPS #16 | PLC M22 | JB-DL |
| BCCH382B | 3/4" LIQUID-TITE | TPS #16 | JB-DL | VT-20852, BLOWER #8 OUTBOARD VIBRATION |
| BCCH382C | 3/4" LIQUID-TITE | TPS #16 | JB-DL | VT-20851, BLOWER #8 INBOARD VIBRATION |
| BCCH382D | 3/4" LIQUID-TITE | TPS #16 | JB-DL | VT-20854, MOTOR #8 SHAFT END VIBRATION |
| BCCH382E | 3/4" LIQUID-TITE | TPS #16 | JB-DL | VT-20853, MOTOR #8 NON-SHAFT END VIBRATION |
| BCCH383A | 3/4" CRGS | 2 TPS #16 | PLC M22 | FVZO/FVZI-20857, BLOWER #8 INLET VALVE |
| BCCH384A | 3/4" CRGS | 8 #14 | PLC M22 | ZSO/ZSC/FVA/HS-20857, BLOWER #8 INLET VALVE |
| BCCH385A | 3/4" CRGS | TPS #16 | PLC M22 | PDT-20858, BLOWER #8 INLET FILTER |
| BCCH401A | 3/4" CRGS | 2 #14 | PLC M24 | LSH-29040, BAF GALLERY SUMP #1 |
| BCCH402A | 3/4" CRGS | 2 #14 | PLC M24 | LSH-29041, BAF GALLERY SUMP #2 |
| BCCH403A | 3/4" CRGS | 2 #14 | PLC M24 | LSH-29042, BAF GALLERY SUMP #3 |
| BCCH404A | 3/4" CRGS | 2 #14 | PLC M24 | LSH-29043, BAF GALLERY SUMP #4 |
| BCCH405A | 3/4" CRGS | 2 #14 | PLC M24 | LSH-29044, BAF GALLERY SUMP #5 |
| BCCH406A | 3/4" CRGS | 2 #14 | PLC M24 | LSH-29045, BAF GALLERY SUMP #6 |
| BCCH407A | 3/4" CRGS | 2 #14 | PLC M24 | LSH-29046, BACKWASH SUMP |
| BCCH408A | 3/4" CRGS | 4 #14 | PLC M24 | BAF SUMP CONTROL PANEL |
| BCCH409A | 3/4" CRGS | 1 BELDEN 3083A | PLC M17 | MCC 33 |
| HCCD101A | 3/4" CRGS | 1 BELDEN 3083A | MCC 33 | HDN1, NODE 12 - TRAIN #1 INFLUENT SLIDE GATE |
| HCCD102A | 3/4" CRGS | 1 BELDEN 3083A | MCC 33 | ZS-30100, HRFS TRAIN #1 SLIDE GATE LIMIT SWITCH |
| HCCD102B | 3/4" LIQUID-TITE | TPS #16 | HDN1, NODE 12 - TRAIN #1 INFLUENT SLIDE GATE | HDN1, NODE 12 - TRAIN #1 INFLUENT SLIDE GATE |
| HCCD103A | 3/4" CRGS | 1 BELDEN 3083A | HDN1, NODE 12 - TRAIN #1 INFLUENT SLIDE GATE | HDN1, NODE 12 - TRAIN #1 INFLUENT SLIDE GATE |
| HCCD103B | 3/4" LIQUID-TITE | 4 #14 | HDN1, NODE 11 - TRAIN #1 SAND PUMP PRESSURE SWITCHES | PSHL-30107, HRFS TRAIN #1 SAND PUMP #1A |
| HCCD103C | 3/4" LIQUID-TITE | 4 #14 | HDN1, NODE 11 - TRAIN #1 SAND PUMP PRESSURE SWITCHES | PSHL-30109, HRFS TRAIN #1 SAND PUMP #1B |
| HCCD103D | 3/4" LIQUID-TITE | 4 #14 | HDN1, NODE 11 - TRAIN #1 SAND PUMP PRESSURE SWITCHES | PSHL-30111, HRFS TRAIN #1 SAND PUMP #1C |
| HCCD201A | 3/4" CRGS | 1 BELDEN 3083A | PLC M17 | MCC 33 |
| HCCD202A | 3/4" CRGS | 1 BELDEN 3083A | MCC 33 | HDN2, NODE 12 - TRAIN #2 INFLUENT SLIDE GATE |
| HCCD202B | 3/4" LIQUID-TITE | TPS #16 | HDN2, NODE 12 - TRAIN #2 INFLUENT SLIDE GATE | HDN2, NODE 12 - TRAIN #2 INFLUENT SLIDE GATE |
| HCCD203A | 3/4" CRGS | 1 BELDEN 3083A | HDN2, NODE 12 - TRAIN #2 INFLUENT SLIDE GATE | HDN2, NODE 12 - TRAIN #2 INFLUENT SLIDE GATE |
| HCCD203B | 3/4" LIQUID-TITE | 4 #14 | HDN2, NODE 11 - TRAIN #2 SAND PUMP PRESSURE SWITCHES | PSHL-30207, HRFS TRAIN #2 SAND PUMP #2A |
| HCCD203C | 3/4" LIQUID-TITE | 4 #14 | HDN2, NODE 11 - TRAIN #2 SAND PUMP PRESSURE SWITCHES | PSHL-30209, HRFS TRAIN #2 SAND PUMP #2B |
| HCCD203D | 3/4" LIQUID-TITE | 4 #14 | HDN2, NODE 11 - TRAIN #2 SAND PUMP PRESSURE SWITCHES | PSHL-30211, HRFS TRAIN #2 SAND PUMP #2C |
| HCCD301A | 3/4" CRGS | 1 BELDEN 3083A | PLC M17 | MCC 39 |
| HCCD302A | 3/4" CRGS | 1 BELDEN 3083A | MCC 39 | HDN3, NODE 12 - TRAIN #3 INFLUENT SLIDE GATE |
| HCCD302B | 3/4" LIQUID-TITE | TPS #16 | HDN3, NODE 12 - TRAIN #3 INFLUENT SLIDE GATE | HDN3, NODE 12 - TRAIN #3 INFLUENT SLIDE GATE |
| HCCD303A | 3/4" CRGS | 1 BELDEN 3083A | HDN3, NODE 12 - TRAIN #3 INFLUENT SLIDE GATE | HDN3, NODE 12 - TRAIN #3 INFLUENT SLIDE GATE |
| HCCD303B | 3/4" LIQUID-TITE | 4 #14 | HDN3, NODE 11 - TRAIN #3 SAND PUMP PRESSURE SWITCHES | PSHL-30307, HRFS TRAIN #3 SAND PUMP #3A |
| HCCD303C | 3/4" LIQUID-TITE | 4 #14 | HDN3, NODE 11 - TRAIN #3 SAND PUMP PRESSURE SWITCHES | PSHL-30309, HRFS TRAIN #3 SAND PUMP #3B |
| HCCD303D | 3/4" LIQUID-TITE | 4 #14 | HDN3, NODE 11 - TRAIN #3 SAND PUMP PRESSURE SWITCHES | PSHL-30311, HRFS TRAIN #3 SAND PUMP #3C |
| HCCD401A | 3/4" CRGS | 1 BELDEN 3083A | PLC M17 | MCC 39 |
| HCCD402A | 3/4" CRGS | 1 BELDEN 3083A | MCC 39 | HDN4, NODE 12 - TRAIN #4 INFLUENT SLIDE GATE |
| HCCD402B | 3/4" LIQUID-TITE | TPS #16 | HDN4, NODE 12 - TRAIN #4 INFLUENT SLIDE GATE | HDN4, NODE 12 - TRAIN #4 INFLUENT SLIDE GATE |
| HCCD403A | 3/4" CRGS | 1 BELDEN 3083A | HDN4, NODE 12 - TRAIN #4 INFLUENT SLIDE GATE | HDN4, NODE 12 - TRAIN #4 INFLUENT SLIDE GATE |
| HCCD403B | 3/4" LIQUID-TITE | 4 #14 | HDN4, NODE 11 - TRAIN #4 SAND PUMP PRESSURE SWITCHES | PSHL-30407, HRFS TRAIN #4 SAND PUMP #4A |
| HCCD403C | 3/4" LIQUID-TITE | 4 #14 | HDN4, NODE 11 - TRAIN #4 SAND PUMP PRESSURE SWITCHES | PSHL-30409, HRFS TRAIN #4 SAND PUMP #4B |
| HCCD403D | 3/4" LIQUID-TITE | 4 #14 | HDN4, NODE 11 - TRAIN #4 SAND PUMP PRESSURE SWITCHES | PSHL-30411, HRFS TRAIN #4 SAND PUMP #4C |
| HCCD501A | 3/4" CRGS | 1 BELDEN 3083A | PLC M17 | HDN5, NODE 2 |

| CONDUIT NO. | CONDUIT SIZE | NO./SIZE CONDUCTORS | FROM | TO |
|-------------|------------------|---------------------|---------------------------------------|--|
| HCCD501B | 3/4" LIQUID-TITE | 4 #14 | HDN5, NODE 2 | PSHL-30083A, SLUDGE TRANSFER PUMP #1 PRESSURE SWITCH |
| HCCD501C | 3/4" LIQUID-TITE | 4 #14 | HDN5, NODE 2 | PSHL-30083B, SLUDGE TRANSFER PUMP #2 PRESSURE SWITCH |
| HCCD501D | 3/4" LIQUID-TITE | 4 #14 | HDN5, NODE 2 | PSHL-30083C, SLUDGE TRANSFER PUMP #3 PRESSURE SWITCH |
| HCCD502A | 3/4" CRGS | 1 BELDEN 3083A | HDN5, NODE 2 | HDN5, NODE 3 |
| HCCD502B | 3/4" LIQUID-TITE | TPS #16 | HDN5, NODE 3 | LSH-30081, HRFS SLUDGE TANK HIGH LEVEL |
| HCCD502C | 3/4" LIQUID-TITE | TPS #16 | HDN5, NODE 3 | LSL-30081, HRFS SLUDGE TANK LOW LEVEL |
| HCCD503A | 3/4" CRGS | 1 BELDEN 3083A | HDN5, NODE 3 | HDN5, NODE 4 |
| HCCD503B | 3/4" LIQUID-TITE | 2 #14 | HDN5, NODE 3 | CR3F.CHLORIDE CP |
| HCCD503C | 3/4" LIQUID-TITE | 2 #14 | HDN5, NODE 3 | CRG.FERRIC CHLORIDE CP |
| HCCD504A | 3/4" CRGS | 1 BELDEN 3083A | HDN5, NODE 4 | HDN5, NODE 5 |
| HCCD504B | 3/4" LIQUID-TITE | TPS #16 | HDN5, NODE 5 | XSA-30070, SAND SILO ALARM |
| HCCD505A | 3/4" CRGS | 1 BELDEN 3083A | HDN5, NODE 5 | HDN5, NODE 6 |
| HCCD505B | 3/4" LIQUID-TITE | 4 #14 | HDN5, NODE 6 | PSHL-30071, SAND SLURRY PUMP #1 |
| HCCD505C | 3/4" LIQUID-TITE | 4 #14 | HDN5, NODE 6 | PSHL-30072, SAND SLURRY PUMP #2 |
| HCCF101A | 3/4" CRGS | 1 BELDEN 3076F | PLC M17 | JB-1C |
| HCCF101B | 3/4" CRGS | 1 BELDEN 3076F | JB-1C | HFN1, NODE 2 - CONVERTER |
| HCCF101C | 3/4" LIQUID-TITE | TPS #16 | HFN1, NODE 2 - CONVERTER | AIT-30112, HRFS TRAIN #1 EFFLUENT TURBIDITY |
| HCCF101D | 3/4" CRGS | 1 BELDEN 3076F | HFN1, NODE 2 - CONVERTER | AIT-30113, HRFS TRAIN #1 EFFLUENT PH |
| HCCF102A | 3/4" CRGS | 1 BELDEN 3076F | JB-1C | JB-2C |
| HCCF102B | 3/4" CRGS | 1 BELDEN 3076F | JB-2C | HFN1, NODE 5 - CONVERTER |
| HCCF102C | 3/4" LIQUID-TITE | TPS #16 | HFN1, NODE 5 - CONVERTER | AIT-30212, HRFS TRAIN #2 EFFLUENT TURBIDITY |
| HCCF102D | 3/4" LIQUID-TITE | TPS #16 | HFN1, NODE 5 - CONVERTER | AIT-30213, HRFS TRAIN #2 EFFLUENT PH |
| HCCF103A | 3/4" CRGS | 1 BELDEN 3076F | JB-2C | HFN1, NODE 6 - CONVERTER FERRIC CHLORIDE CP |
| HCCF103B | 3/4" CRGS | 1-16 TPS + 3 #14 | PLC M17 | LIT-30061 |
| HCCF103C | 3/4" LIQUID-TITE | TPS #16 | LIT-30061, FC DAY TANK #1 LEVEL | LE-30061, FERRIC CHLORIDE DAY TANK #1 LEVEL |
| HCCF201A | 3/4" CRGS | 1 BELDEN 3076F | PLC M17 | JB-3C |
| HCCF201B | 3/4" CRGS | 1 BELDEN 3076F | JB-3C | HFN2, NODE 2 - CONVERTER |
| HCCF201C | 3/4" LIQUID-TITE | TPS #16 | HFN2, NODE 2 - CONVERTER | AIT-30312, HRFS TRAIN #3 EFFLUENT TURBIDITY |
| HCCF201D | 3/4" LIQUID-TITE | TPS #16 | HFN2, NODE 2 - CONVERTER | AIT-30313, HRFS TRAIN #3 EFFLUENT PH |
| HCCF202A | 3/4" CRGS | 1 BELDEN 3076F | JB-4C | JB-4C |
| HCCF202B | 3/4" CRGS | 1 BELDEN 3076F | JB-4C | HFN2, NODE 5 - CONVERTER |
| HCCF202C | 3/4" LIQUID-TITE | TPS #16 | HFN2, NODE 5 - CONVERTER | AIT-30412, HRFS TRAIN #4 EFFLUENT TURBIDITY |
| HCCF202D | 3/4" CRGS | 1 BELDEN 3076F | HFN2, NODE 5 - CONVERTER | AIT-30413, HRFS TRAIN #4 EFFLUENT PH |
| HCCF203A | 3/4" CRGS | 1 BELDEN 3076F | JB-4C | HFN2, NODE 8 - CONVERTER FERRIC CHLORIDE CP |
| HCCF203B | 3/4" CRGS | 1-16 TPS + 3 #14 | HFN2, NODE 8 - CONVERTER | LIT-30062, FERRIC CHLORIDE DAY TANK #2 LEVEL |
| HCCF203C | 3/4" LIQUID-TITE | TPS #16 | LIT-30062 | LIT-30062 |
| HCCF301A | 3/4" CRGS | 1 BELDEN 3076F | PLC M17 | JB-F |
| HCCF301B | 3/4" LIQUID-TITE | TPS #16 | JB-F | FIT-30082, HRFS SLUDGE DISCHARGE FLOW |
| HCCF302A | 3/4" CRGS | 1 BELDEN 3076F | JB-F | JB-FA |
| HCCF302B | 3/4" CRGS | 1 BELDEN 3076F | JB-FA | AIT-30001, HRFS INFLUENT PH |
| HCCF302C | 3/4" CRGS | 1 BELDEN 3076F | JB-FA | HFN3, NODE 2 - CONVERTER |
| HCCF302D | 3/4" LIQUID-TITE | TPS #16 | HFN3, NODE 2 - CONVERTER | AIT-30000, HRFS INFLUENT TURBIDITY |
| HCH101A | 3/4" CRGS | 1 BELDEN 9483 | PLC M17, NODE 11 | PLC M18 |
| HCH103A | 3/4" CRGS | 1 BELDEN 9483 | PLC M18 | PLC M18 |
| HCH201A | 3/4" CRGS | MFR. CABLE | LE-50035, NEAT POLYMER TANK #1 LEVEL | LIT-50035, NEAT POLYMER TANK #1 LEVEL |
| HCH201B | 3/4" CRGS | 1 TPS #16 | LIT-50035, NEAT POLYMER TANK #1 LEVEL | LIT-50035, NEAT POLYMER TANK #1 LEVEL |
| HCH202A | 3/4" CRGS | MFR. CABLE | LE-50038, NEAT POLYMER TANK #2 LEVEL | LIT-50038, NEAT POLYMER TANK #2 LEVEL |
| HCH202B | 3/4" CRGS | 1 TPS #16 | LIT-50038, NEAT POLYMER TANK #2 LEVEL | LIT-50038, NEAT POLYMER TANK #2 LEVEL |
| HCH211A | 3/4" CRGS | 2 #14 | PLC M18 | LSH-50035, NEAT POLYMER TANK #1 LEVEL FLOAT |
| HCH212A | 3/4" CRGS | 2 #14 | PLC M18 | LSH-50038, NEAT POLYMER TANK #2 LEVEL FLOAT |
| HCH220A | 3/4" CRGS | 8 #14, 3 #12 | PLC M18 | POLYMER TRUCK UNLOADING PANEL |
| HCH221A | 3/4" CRGS | 2 TPS #16 | PLC M18 | POLYMER TRUCK UNLOADING PANEL |
| HCH310A | 3/4" CRGS | 6 #14 | PLC M18 | ZS-30037, POLYMER MIXING/AGING TANK #1 INLET VALVE |
| HCH311A | 3/4" CRGS | TPS #16 | LE-30037 | LIT-30037, POLYMER MIXING/AGING TANK #1 LEVEL |
| HCH312A | 3/4" CRGS | 8 #14 | PLC M18 | ZS-30037A, POLYMER MIXING/AGING TANK #1 DISCH. VALVE |
| HCH313A | 3/4" CRGS | 7 #14 | PLC M18 | LSH-30037, POLYMER MIXING/AGING TANK #1 LEVEL FLOAT |
| HCH320A | 3/4" CRGS | 6 #14 | PLC M18 | ZS-30040A, POLYMER MIXING/AGING TANK #2 DISCH. VALVE |
| HCH321A | 3/4" CRGS | TPS #16 | LE-30040 | LIT-30040, POLYMER MIXING/AGING TANK #2 LEVEL |
| HCH322A | 3/4" CRGS | 8 #14 | PLC M18 | ZS-30040, POLYMER MIXING/AGING TANK #2 INLET VALVE |
| HCH323A | 3/4" CRGS | 7 #14 | PLC M18 | LSH-30040, POLYMER MIXING/AGING TANK #2 LEVEL FLOAT |
| HCH401A | 3/4" CRGS | 8 #14 | PLC M18 | PPF-30041A, POLYMER FEED PUMP #1 |
| HCH401B | 3/4" CRGS | 2 TPS #16 | PLC M18 | PPF-30041A, POLYMER FEED PUMP #1 |
| HCH402A | 3/4" CRGS | 8 #14 | PLC M18 | PPF-30041B, POLYMER FEED |

| CONDUIT NO. | CONDUIT SIZE | NO./SIZE CONDUCTORS | FROM | TO |
|-------------|------------------|---------------------|------------------------------|---|
| HCCH513A | 3/4" CRGS | TPS #16 + 8 #14 | PLC M18 | FT-30055, FERRIC CHLORIDE TO TRAIN #3 |
| HCCH514A | 3/4" CRGS | TPS #16 + 8 #14 | PLC M18 | FT-30056, FERRIC CHLORIDE TO TRAIN #4 |
| HCCH801A | 3/4" CRGS | 8 #14 | PLC M16 | FERRIC CHLORIDE CONTROL PANEL |
| HCCH701A | 3/4" CRGS | 4 #14 | SAND SILO CONTROL PANEL | SAND TRUCK UNLOADING PANEL |
| HCCH801A | 3/4" CRGS | 2 #14 | PLC M16 | JB-G |
| HCCH801B | 3/4" CRGS | 2 #14 | JB-G | LSH-30057, FERRIC CHLORIDE PUMPS SUMP |
| HCCH801C | 3/4" CRGS | 2 #14 | JB-G | LSH-30063, FERRIC CHLORIDE DAY TANKS SUMP |
| HCCH802A | 3/4" CRGS | 2 #14 | PLC M16 | LSH-50032, POLYMER PUMPS SUMP |
| HCCH803A | 3/4" CRGS | 2 #14 | PLC M16 | LSH-50033, POLYMER NEAT TANKS SUMP |
| HCCH803B | 3/4" CRGS | 2 #14 | PLC M16 | LSH-50034, POLYMER MIXING/AGING TANKS SUMP |
| HCCH804A | 3/4" CRGS | 2 #14 | PLC M24 | LSH-30041, WEST HRFS GALLERY SUMP |
| HCCH805A | 3/4" CRGS | 2 #14 | PLC M24 | LSH-30042, EAST HRFS GALLERY SUMP |
| SCCH101A | 3/4" CRGS | 1 BELDEN 3083A | PLC M13 | WCC 44 |
| SCCH001A | 1" CRGS | 3 TPS #16 | PLC M13 | SECONDARY EFFLUENT PUMP #1 VFD |
| SCCH001B | 3/4" CRGS | 10 #14 | PLC M13 | SECONDARY EFFLUENT PUMP #1 VFD |
| SCCH002A | 1" CRGS | 3 TPS #16 | PLC M13 | SECONDARY EFFLUENT PUMP #2 VFD |
| SCCH002B | 3/4" CRGS | 10 #14 | PLC M13 | SECONDARY EFFLUENT PUMP #2 VFD |
| SCCH003A | 1" CRGS | 3 TPS #16 | PLC M13 | SECONDARY EFFLUENT PUMP #3 VFD |
| SCCH003B | 3/4" CRGS | 10 #14 | PLC M13 | SECONDARY EFFLUENT PUMP #3 VFD |
| SCCH004A | 1" CRGS | 3 TPS #16 | PLC M13 | SECONDARY EFFLUENT PUMP #4 VFD |
| SCCH004B | 3/4" CRGS | 10 #14 | PLC M13 | SECONDARY EFFLUENT PUMP #4 VFD |
| SCCH101A | 1" CRGS | 3 TPS #16 | PLC M13 | JB-AA |
| SCCH101C | 3/4" LIQUID-TITE | TPS #16 | JB-AA | TT-10102A, SEC. EFF. PUMP #1 TEMP. A |
| SCCH101D | 3/4" LIQUID-TITE | TPS #16 | JB-AA | |
| SCCH102A | 1" CRGS | 3 TPS #16 | PLC M13 | JB-AB |
| SCCH102C | 3/4" LIQUID-TITE | TPS #16 | JB-AB | TT-10202A, SEC. EFF. PUMP #2 TEMP. A |
| SCCH102D | 3/4" LIQUID-TITE | TPS #16 | JB-AB | |
| SCCH103A | 1" CRGS | 3 TPS #16 | PLC M13 | JB-AC |
| SCCH103C | 3/4" LIQUID-TITE | TPS #16 | JB-AC | TT-10302A, SEC. EFF. PUMP #3 TEMP. A |
| SCCH103D | 3/4" LIQUID-TITE | TPS #16 | JB-AC | |
| SCCH104A | 1" CRGS | 3 TPS #16 | PLC M13 | JB-AD |
| SCCH104C | 3/4" LIQUID-TITE | TPS #16 | JB-AD | TT-10402A, SEC. EFF. PUMP #4 TEMP. A |
| SCCH104D | 3/4" LIQUID-TITE | TPS #16 | JB-AD | |
| SCCH201A | 1" CRGS | 4 TPS #16 | PLC M13 | JB-AE |
| SCCH201B | 3/4" LIQUID-TITE | TPS #16 | JB-AE | VT-10101, SEC. EFF. PUMP #1 VIBRATION |
| SCCH202A | 1" CRGS | 3 TPS #16 | JB-AE | JB-AF |
| SCCH202B | 3/4" LIQUID-TITE | TPS #16 | JB-AF | VT-10201, SEC. EFF. PUMP #2 VIBRATION |
| SCCH203A | 3/4" CRGS | 2 TPS #16 | JB-AF | JB-AG |
| SCCH203B | 3/4" LIQUID-TITE | TPS #16 | JB-AG | VT-10301, SEC. EFF. PUMP #3 VIBRATION |
| SCCH204A | 3/4" LIQUID-TITE | TPS #16 | JB-AG | VT-10401, SEC. EFF. PUMP #4 VIBRATION |
| SCCH301A | 3/4" CRGS | TPS #16 | PLC M13 | LIT-10500, WET WELL LEVEL #1 |
| SCCH301B | 3/4" CRGS | MFG. CABLE | LIT-10500, WET WELL LEVEL #1 | LE-10500, WET WELL LEVEL #1 |
| SCCH302A | 3/4" CRGS | TPS #16 | PLC M13 | LIT-10501, WET WELL LEVEL #2 |
| SCCH302B | 3/4" CRGS | MFG. CABLE | LIT-10501, WET WELL LEVEL #2 | LE-10501, WET WELL LEVEL #2 |
| SCCH401A | 3/4" CRGS | 8 #14 | PLC M13 | ZSC/ZSO-10104, PUMP #1 AUTO DISCHARGE VALVE |
| SCCH401B | 3/4" CRGS | 4 #14 | PLC M13 | ZSC/ZSO-10105, PUMP #1 MANUAL DISCHARGE VALVE |
| SCCH402A | 3/4" CRGS | 8 #14 | PLC M13 | ZSC/ZSO-10204, PUMP #2 AUTO DISCHARGE VALVE |
| SCCH402B | 3/4" CRGS | 4 #14 | PLC M13 | ZSC/ZSO-10205, PUMP #2 MANUAL DISCHARGE VALVE |
| SCCH403A | 3/4" CRGS | 8 #14 | PLC M13 | ZSC/ZSO-10304, PUMP #3 AUTO DISCHARGE VALVE |
| SCCH403B | 3/4" CRGS | 4 #14 | PLC M13 | ZSC/ZSO-10305, PUMP #3 MANUAL DISCHARGE VALVE |
| SCCH404A | 3/4" CRGS | 8 #14 | PLC M13 | ZSC/ZSO-10404, PUMP #4 AUTO DISCHARGE VALVE |
| SCCH404B | 3/4" CRGS | 4 #14 | PLC M13 | ZSC/ZSO-10405, PUMP #4 MANUAL DISCHARGE VALVE |
| SCCH501A | 3/4" CRGS | 2 #14 | PLC M13 | FS-10106, PUMP #1 SEAL WATER FLOW |
| SCCH501B | 3/4" CRGS | 2 #14 | PLC M13 | SV-10107, PUMP #1 SEAL WATER SOLENOID |
| SCCH502A | 3/4" CRGS | 2 #14 | PLC M13 | FS-10206, PUMP #2 SEAL WATER FLOW |
| SCCH502B | 3/4" CRGS | 2 #14 | PLC M13 | SV-10207, PUMP #2 SEAL WATER SOLENOID |
| SCCH503A | 3/4" CRGS | 2 #14 | PLC M13 | FS-10306, PUMP #3 SEAL WATER FLOW |
| SCCH503B | 3/4" CRGS | 2 #14 | PLC M13 | SV-10307, PUMP #3 SEAL WATER SOLENOID |
| SCCH504A | 3/4" CRGS | 2 #14 | PLC M13 | FS-10406, PUMP #4 SEAL WATER FLOW |
| SCCH504B | 3/4" CRGS | 2 #14 | PLC M13 | SV-10407, PUMP #4 SEAL WATER SOLENOID |
| SCCH601A | 3/4" CRGS | 2 #14 | PLC M13 | TT-10602, ELECTRIC ROOM TEMPERATURE |
| SCCH602A | 3/4" CRGS | 2 #14 | PLC M13 | TT-10603, PUMP ROOM TEMPERATURE |
| HCCH801B | 3/4" CRGS | 2 TPS #16 | PLC M16 | FERRIC CHLORIDE CP |

CONTROL CONDUIT NUMBER DESCRIPTION

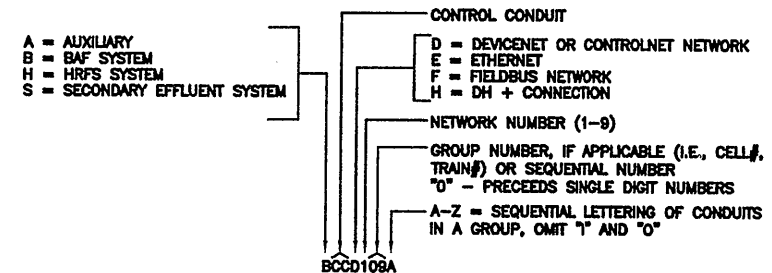

Loyer: ON=*, OFF=REF*
4/23/01 BBL DCC
05503000/08591513.DWG

RECORD DRAWING

THESE DRAWINGS HAVE BEEN REVIEWED TO REFLECT MAJOR CHANGES, IF ANY, WHICH OCCURRED DURING CONSTRUCTION. REVISIONS ARE BASED UPON INFORMATION SUPPLIED BY CONTRACTOR.

DATE 10/21/05 FOR [Signature]

THIS DRAWING WAS PREPARED AT THE SCALE INDICATED IN THE TITLE BLOCK. INACCURACIES IN THE STATED SCALE MAY BE INTRODUCED WHEN DRAWINGS ARE REPRODUCED BY ANY MEANS. USE THE GRAPHIC SCALE BAR IN THE TITLE BLOCK TO DETERMINE THE ACTUAL SCALE OF THIS DRAWING.

NOT TO SCALE

| No. | Date | Revisions | Init |
|-----|----------|---------------------|-------------|
| 0 | 4/20/01 | ISSUED FOR APPROVAL | [Signature] |
| 1 | 7/11/01 | AS BID | [Signature] |
| 2 | 10/31/03 | RECORD DRAWING | [Signature] |

In charge of --- TEL ---
Designed by --- AHL ---
Drawn by --- DCC ---
Checked by --- FKP ---



ONONDAGA COUNTY • DEPARTMENT OF DRAINAGE AND SANITATION • SYRACUSE, NEW YORK
METROPOLITAN SYRACUSE WASTEWATER TREATMENT PLANT
STAGE III AMMONIA AND STAGE II PHOSPHORUS REMOVAL PROJECT

CONDUIT SCHEDULE (CONTINUED)

INSTRUMENTATION




File Number
00659



Date
APRIL 2001

I-513

NO ALTERATIONS PERMITTED HEREON EXCEPT AS PROVIDED UNDER SECTION 7209 SUBDIVISION 2 OF THE NEW YORK STATE EDUCATION LAW

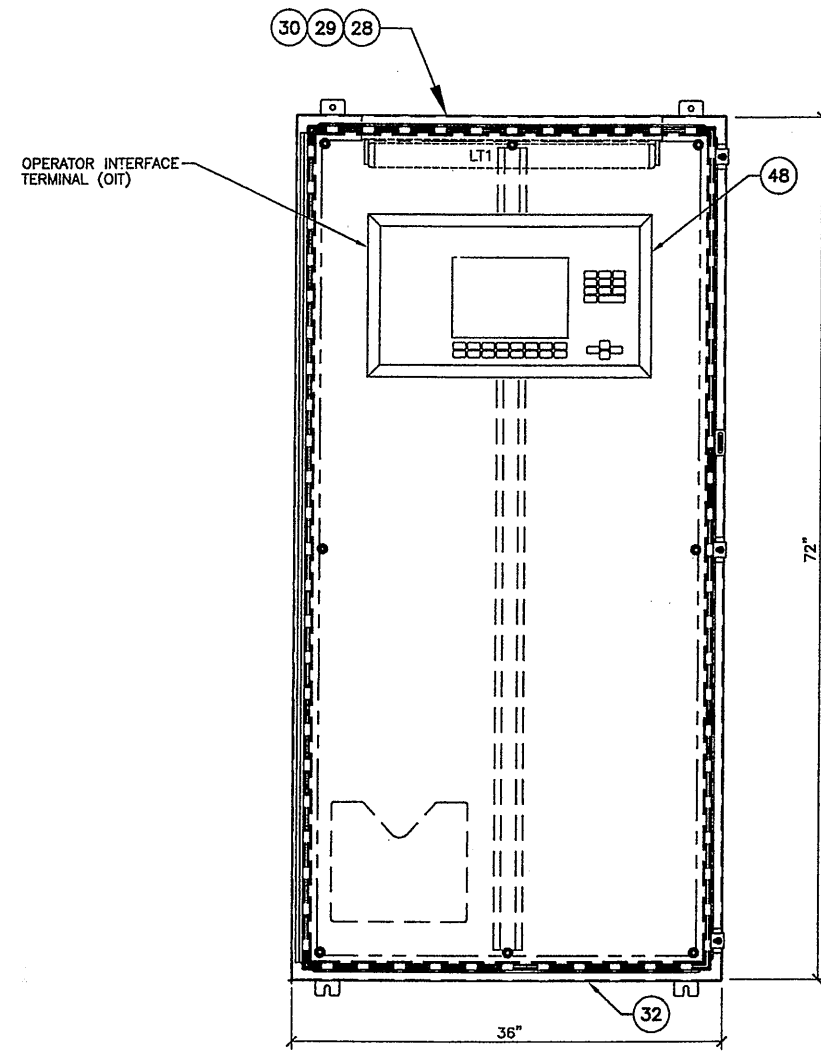

CONTROL PANEL FRONT VIEW

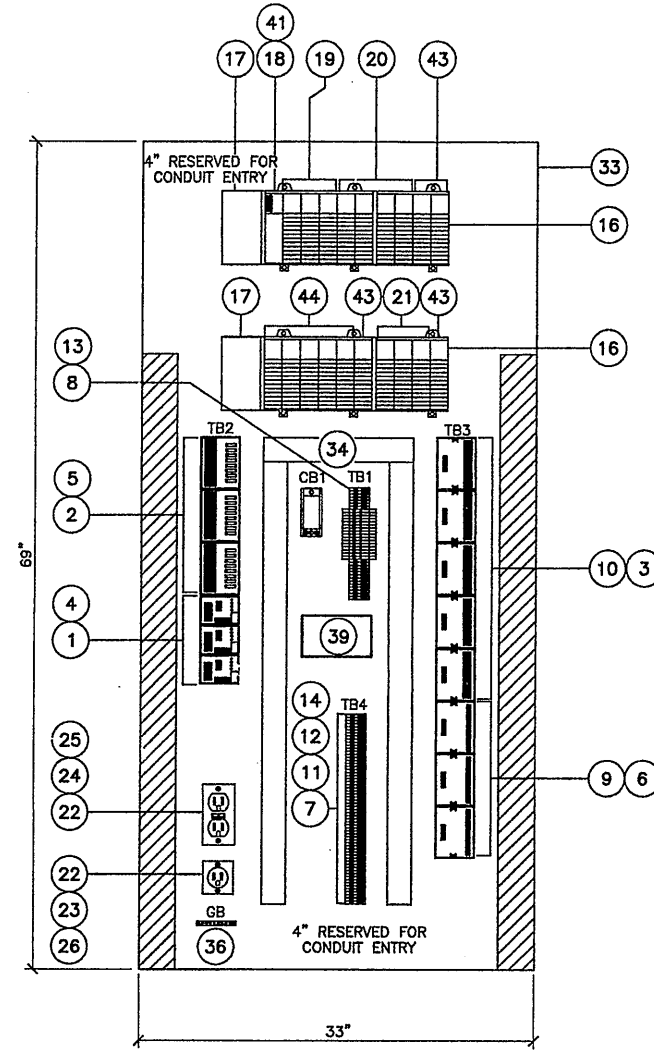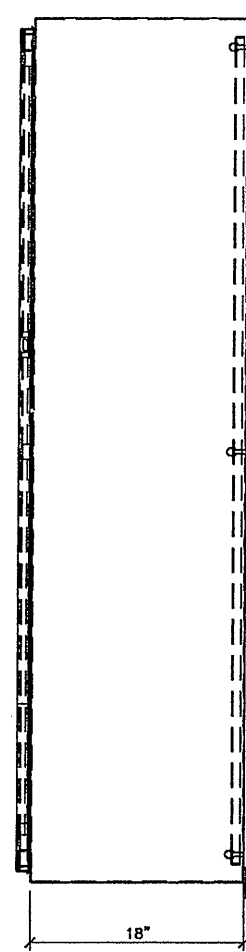



CONTROL PANEL INTERIOR VIEW

NOTES:

- LAYOUT SHOWN IS FOR CONCEPT ONLY. CONTRACTOR SHALL PROVIDE ALL NECESSARY APPURTENANCES REQUIRED FOR A COMPLETE AND OPERATIONAL SYSTEM.
- PANEL SIZE IS APPROXIMATE ONLY. CONTRACTOR SHALL PROVIDE ENCLOSURE SIZE AS REQUIRED FOR EQUIPMENT.

▨ = ALL FIELD WIRES

CHEMICAL BUILDING "A" CONTROL PANEL

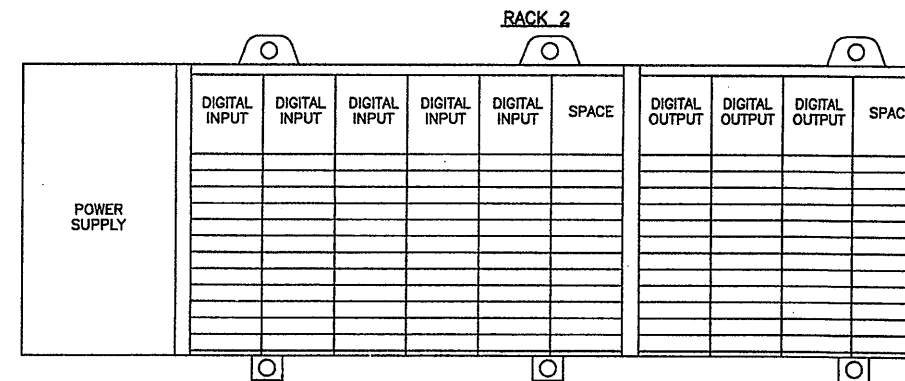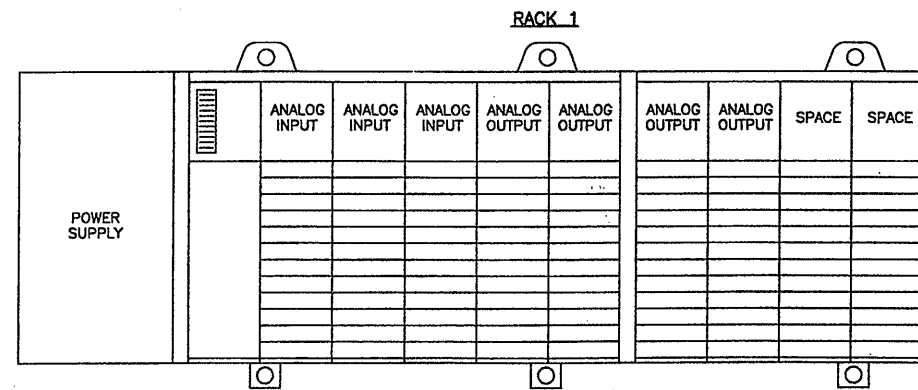

PLC MODULE LAYOUT

RECORD DRAWING

THIS DRAWING HAS BEEN REVIEWED TO REFLECT MAJOR CHANGES, IF ANY, WHICH OCCURRED DURING CONSTRUCTION. REVISIONS ARE BASED UPON INFORMATION SUPPLIED BY CONTRACTOR.
DATE 10/21/05 PER J. Campolucci

THIS DRAWING WAS PREPARED AT THE SCALE INDICATED IN THE TITLE BLOCK. INACCURACIES IN THE STATED SCALE MAY BE INTRODUCED WHEN DRAWINGS ARE REPRODUCED BY ANY MEANS. USE THE GRAPHIC SCALE BAR IN THE TITLE BLOCK TO DETERMINE THE ACTUAL SCALE OF THIS DRAWING.

02/02/01 OBG JEC

| No. | Date | Revisions | Init |
|-----|----------|---------------------|------|
| 0 | 4/20/01 | ISSUED FOR APPROVAL | PLD |
| 1 | 7/11/01 | AS BID | SAT |
| 2 | 10/31/05 | RECORD DRAWING | JEC |

In charge of PLD
 Designed by SAT
 Drawn by JEC
 Checked by PLD



ONONDAGA COUNTY • DEPARTMENT OF DRAINAGE AND SANITATION • SYRACUSE, NEW YORK
 METROPOLITAN SYRACUSE WASTEWATER TREATMENT PLANT
 STAGE III AMMONIA AND STAGE II PHOSPHORUS REMOVAL PROJECT
**CHEMICAL BUILDING "A" (PLC M20C)
 CONTROL PANEL LAYOUT**



File Number
00659
Date
APRIL 2001
J. Campolucci

I-601

| BILL OF MATERIALS | | | | |
|-------------------|----------|--------------------|---------------|---|
| SYMBOL | QUANTITY | MODEL NUMBER | MANUFACTURER | DESCRIPTION |
| 1 | A/R | SEE SPECIFICATIONS | Allen-Bradley | Analog Output Interface Module |
| 2 | A/R | SEE SPECIFICATIONS | Allen-Bradley | Analog Input Interface Module |
| 3 | A/R | SEE SPECIFICATIONS | Allen-Bradley | Digital Input Interface Cable - 1 meter |
| 4 | A/R | SEE SPECIFICATIONS | Allen-Bradley | Analog Output Interface Cable - 2.5 meter |
| 5 | A/R | SEE SPECIFICATIONS | Allen-Bradley | Analog Input Interface Cable - 1 meter |
| 6 | A/R | SEE SPECIFICATIONS | Allen-Bradley | Relay Output Interface Cable - 0.5 meter |
| 7 | A/R | SEE SPECIFICATIONS | Allen-Bradley | High Density Terminal Block |
| 8 | A/R | SEE SPECIFICATIONS | Allen-Bradley | Fusible Switch |
| 9 | A/R | SEE SPECIFICATIONS | Allen-Bradley | Relay Output Interface Module |
| 10 | A/R | SEE SPECIFICATIONS | Allen-Bradley | Digital Input Interface Module |
| 11 | A/R | SEE SPECIFICATIONS | Allen-Bradley | End Anchor |
| 12 | A/R | SEE SPECIFICATIONS | Allen-Bradley | High Density Terminal Block End Barrier |
| 13 | A/R | SEE SPECIFICATIONS | Allen-Bradley | Fusible Switch End Barrier |
| 14 | A/R | SEE SPECIFICATIONS | Allen-Bradley | High Density Jumper |
| 15 | A/R | SEE SPECIFICATIONS | | |
| 16 | A/R | SEE SPECIFICATIONS | Allen-Bradley | 13 Slot I/O Chassis |
| 17 | A/R | SEE SPECIFICATIONS | Allen-Bradley | I/O Chassis Power Supply |
| 18 | A/R | SEE SPECIFICATIONS | Allen-Bradley | Remote I/O Adapter |
| 19 | A/R | SEE SPECIFICATIONS | Allen-Bradley | Analog Input - 8 point |
| 20 | A/R | SEE SPECIFICATIONS | Allen-Bradley | Analog Output - 4 point |
| 21 | A/R | SEE SPECIFICATIONS | Allen-Bradley | Relay Output - 8 point |
| 22 | A/R | SEE SPECIFICATIONS | RACO | Box |
| 23 | A/R | SEE SPECIFICATIONS | RACO | Cover - single 15 amp |
| 24 | A/R | SEE SPECIFICATIONS | RACO | Cover - duplex 15 amp |
| 25 | A/R | SEE SPECIFICATIONS | Hubbell | 15A Duplex receptacle |
| 26 | A/R | SEE SPECIFICATIONS | Hubbell | 15A Single receptacle |
| 27 | A/R | SEE SPECIFICATIONS | | |
| 28 | A/R | SEE SPECIFICATIONS | Hoffman | Mounting bracket for light |
| 29 | A/R | SEE SPECIFICATIONS | Hoffman | 2' light |
| 30 | A/R | SEE SPECIFICATIONS | Hoffman | Door Switch for light |
| 31 | A/R | SEE SPECIFICATIONS | | |
| 32 | A/R | SEE SPECIFICATIONS | Hoffman | Nema 12 Enclosure |
| 33 | A/R | SEE SPECIFICATIONS | Hoffman | Sub-Panel |
| 34 | A/R | SEE SPECIFICATIONS | Panduit | 3"W x 3"D Slotted Wiring Duct |
| 35 | A/R | SEE SPECIFICATIONS | Panduit | 2"W x 3"D Slotted Wiring Duct |
| 36 | A/R | SEE SPECIFICATIONS | Square D | Ground Bar |
| 37 | A/R | SEE SPECIFICATIONS | Allen-Bradley | 20 amp Circuit Breaker, single pole |
| 38 | A/R | SEE SPECIFICATIONS | Best Power | Uninterruptible Power Supply |
| 39 | A/R | SEE SPECIFICATIONS | Power One | DC Power Supply 24 Vdc Output |
| 40 | A/R | SEE SPECIFICATIONS | TBD | Fuses |
| 41 | | | | |
| 42 | A/R | SEE SPECIFICATIONS | - | - |
| 43 | A/R | SEE SPECIFICATIONS | Allen-Bradley | Blank Slot Filler Module |
| 44 | A/R | SEE SPECIFICATIONS | Allen-Bradley | Discrete Input - 8 point |
| 45 | A/R | SEE SPECIFICATIONS | - | - |
| 46 | A/R | SEE SPECIFICATIONS | - | - |
| 47 | | | | |
| 48 | A/R | SEE SPECIFICATIONS | Allen-Bradley | Operator Interface |

Layer: ON=*; OFF=*REF*
01/12/01 OBG JEC

RECORD DRAWING
 THESE DRAWINGS HAVE BEEN REVISED TO REFLECT
 MAJOR CHANGES, IF ANY, WHICH OCCURRED DURING
 CONSTRUCTION. REVISIONS ARE BASED UPON
 INFORMATION SUPPLIED BY CONTRACTOR.
 DATE: 10/21/05 FOR: Kampschulte

THIS DRAWING WAS PREPARED AT THE SCALE INDICATED IN THE
 TITLE BLOCK. INACCURACIES IN THE STATED SCALE MAY BE
 INTRODUCED WHEN DRAWINGS ARE REPRODUCED BY ANY MEANS.
 USE THE GRAPHIC SCALE BAR IN THE TITLE BLOCK TO
 DETERMINE THE ACTUAL SCALE OF THIS DRAWING.

| No. | Date | Revisions | Init |
|-----|----------|---------------------|------|
| 0 | 4/01/01 | ISSUED FOR APPROVAL | PLD |
| 1 | 7/11/01 | AS BID | SAT |
| 2 | 10/31/05 | RECORD DRAWING | JEC |
| | | | |
| | | | |

NO ALTERATIONS PERMITTED HEREON EXCEPT
 AS PROVIDED UNDER SECTION 7209 SUBDIVISION
 2 OF THE NEW YORK STATE EDUCATION LAW

In charge of ___ PLD ___
 Designed by ___ SAT ___
 Drawn by ___ JEC ___
 Checked by ___ PLD ___




ONONDAGA COUNTY • DEPARTMENT OF DRAINAGE AND SANITATION • SYRACUSE, NEW YORK
 METROPOLITAN SYRACUSE WASTEWATER TREATMENT PLANT
 STAGE III AMMONIA AND STAGE II PHOSPHORUS REMOVAL PROJECT
 CHEMICAL BUILDING "A" (PLC M20C)
BILL OF MATERIALS



File Number
00659
Date
APRIL 2001
Kampschulte

1-602

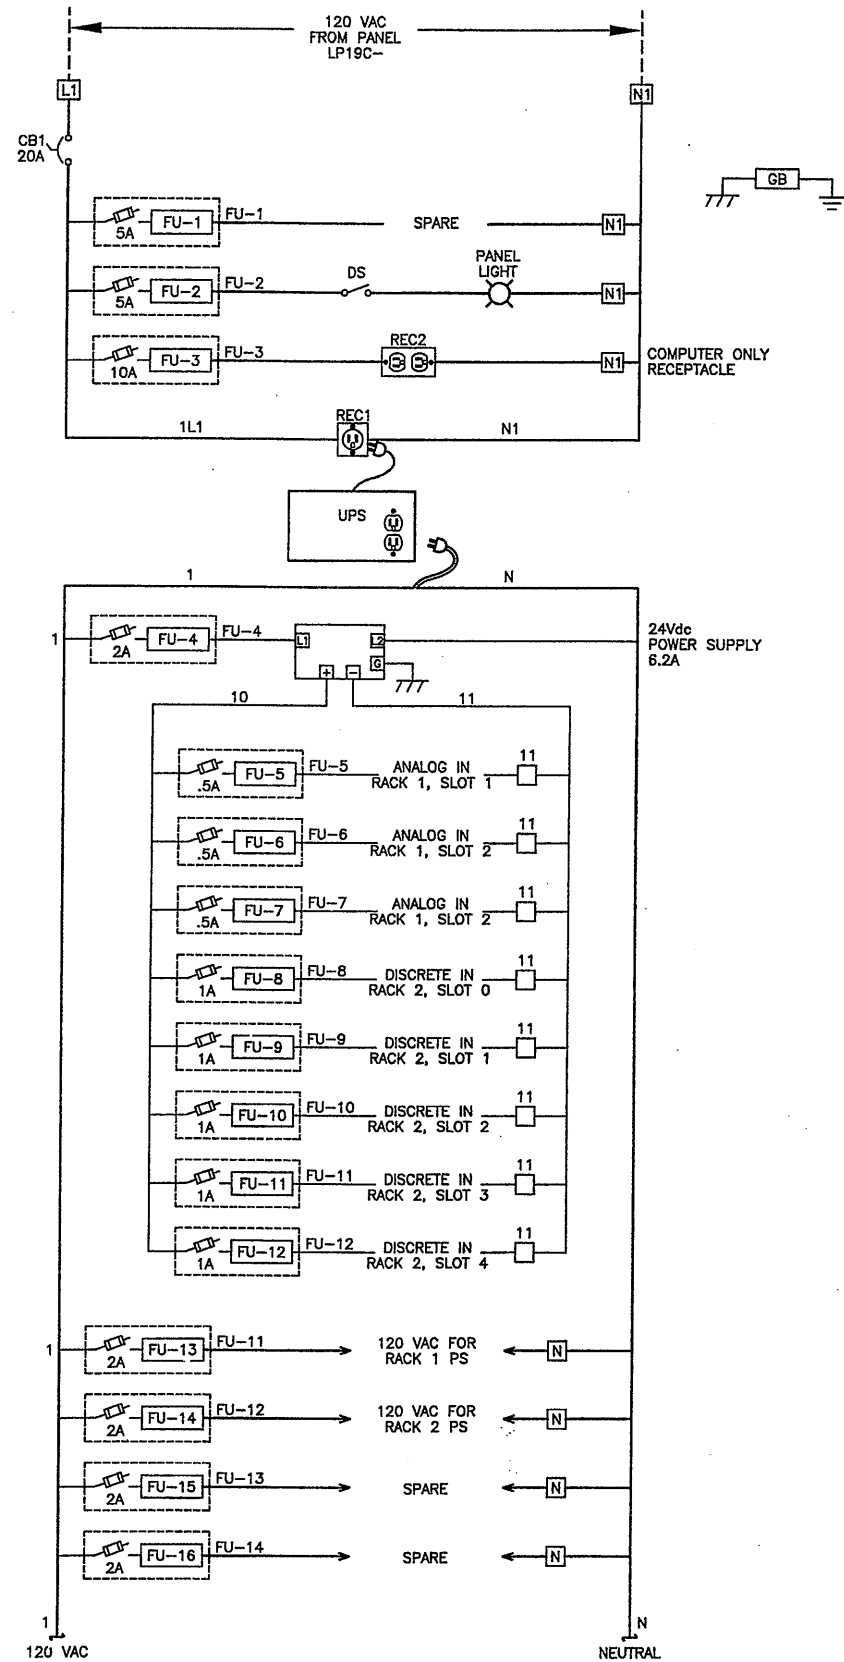

Layer: ON=*, OFF=REF*
07/17/00 OBG JEC

RECORD DRAWING
 THESE DRAWINGS HAVE BEEN REVISED TO REFLECT
 MAJOR CHANGES, IF ANY, WHICH OCCURRED DURING
 CONSTRUCTION. REVISIONS ARE BASED UPON
 INFORMATION SUPPLIED BY CONTRACTOR.
 DATE: 6/21/05 PER: [Signature]

THIS DRAWING WAS PREPARED AT THE SCALE INDICATED IN THE
 TITLE BLOCK. INACCURACIES IN THE STATED SCALE MAY BE
 INTRODUCED WHEN DRAWINGS ARE REPRODUCED BY ANY MEANS.
 USE THE GRAPHIC SCALE BAR IN THE TITLE BLOCK TO
 DETERMINE THE ACTUAL SCALE OF THIS DRAWING.

| No. | Date | Revisions | Init |
|-----|----------|---------------------|------|
| 0 | 3/30/01 | ISSUED FOR APPROVAL | JEC |
| 1 | 7/11/01 | AS BID | |
| 2 | 10/31/03 | RECORD DRAWING | |

In charge of 4/20/01
 Designed by SAT
 Drawn by JEC
 Checked by PLD

ENVIRONMENTAL ENGINEERING ASSOCIATES, LLP
 SYRACUSE, NEW YORK

ONONDAGA COUNTY • DEPARTMENT OF DRAINAGE AND SANITATION • SYRACUSE, NEW YORK
 METROPOLITAN SYRACUSE WASTEWATER TREATMENT PLANT
 STAGE III AMMONIA AND STAGE II PHOSPHORUS REMOVAL PROJECT
CHEMICAL BUILDING "A" (PLC M20C)
CONTROL CIRCUIT WIRING



File Number
00659


Date
APRIL 2001

1-603


[Signature]

INSTRUMENTATION


TB1

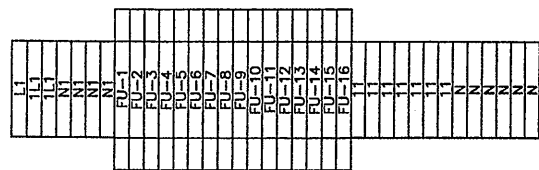


TB2 (ANALOG)

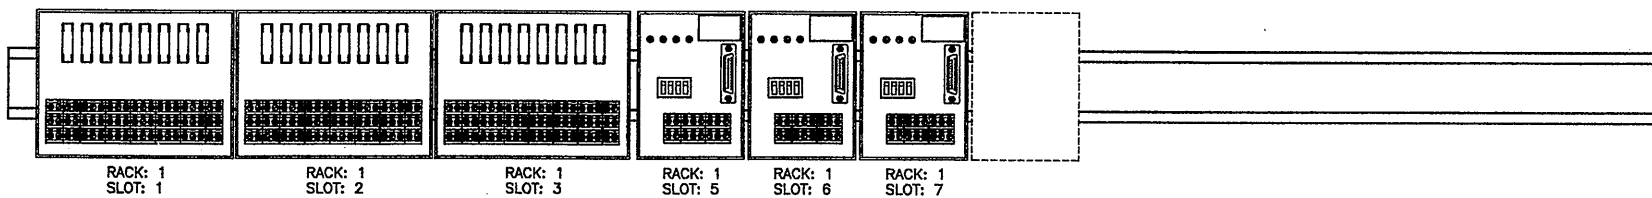

TB3 (DIGITAL)

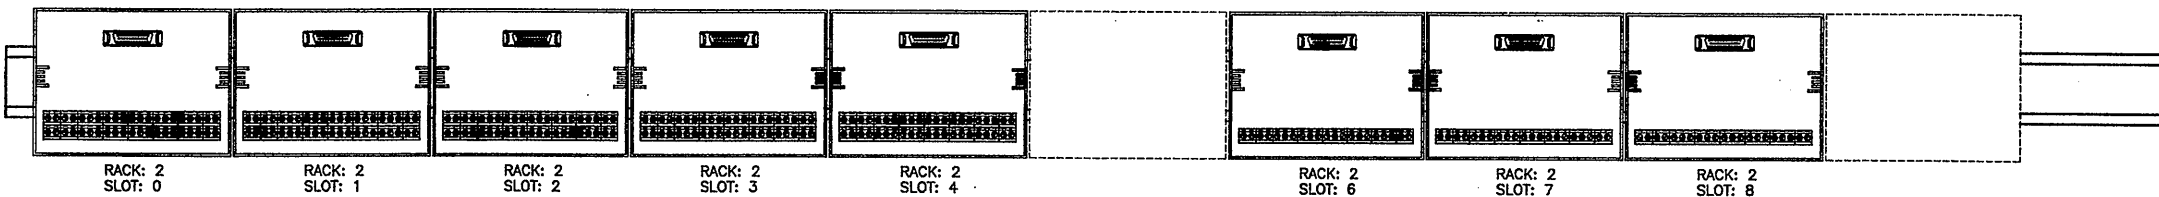

TB4 (24Vdc DI)

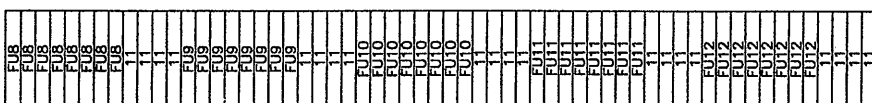

Layer: ON=*; OFF=*REF*
11/27/00 OBG JEC


RECORD DRAWING
THESE DRAWINGS HAVE BEEN REVISIONED TO REFLECT MAJOR CHANGES, IF ANY, WHICH OCCURRED DURING CONSTRUCTION. ISSUANCES ARE BASED UPON INFORMATION SUPPLIED BY CONTRACTORS.
DATE: 10/26/05 FOR: L. KAMPFERT

THIS DRAWING WAS PREPARED AT THE SCALE INDICATED IN THE TITLE BLOCK. INACCURACIES IN THE STATED SCALE MAY BE INTRODUCED WHEN DRAWINGS ARE REPRODUCED BY ANY MEANS. USE THE GRAPHIC SCALE BAR IN THE TITLE BLOCK TO DETERMINE THE ACTUAL SCALE OF THIS DRAWING.

| No. | Date | Revisions | Init |
|-----|----------|---------------------|------|
| 0 | 4/20/01 | ISSUED FOR APPROVAL | PLD |
| 1 | 7/11/01 | AS BID | |
| 2 | 10/31/05 | RECORD DRAWING | JEC |

NO ALTERATIONS PERMITTED HEREON EXCEPT AS PROVIDED UNDER SECTION 7209 SUBDIVISION 2 OF THE NEW YORK STATE EDUCATION LAW


In charge of PLD
Designed by SAT
Drawn by JEC
Checked by PLD

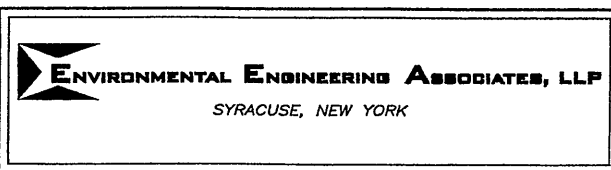

ONONDAGA COUNTY • DEPARTMENT OF DRAINAGE AND SANITATION • SYRACUSE, NEW YORK
METROPOLITAN SYRACUSE WASTEWATER TREATMENT PLANT
STAGE III AMMONIA AND STAGE II PHOSPHORUS REMOVAL PROJECT
CHEMICAL BUILDING "A" (PLC M20C)
TERMINAL BLOCK LAYOUT
INSTRUMENTATION

File Number: 00659
Date: APRIL 2001
1-604
L. KAMPFERT

8 POINT ANALOG INPUT MODULE
(AB 1746-N18)

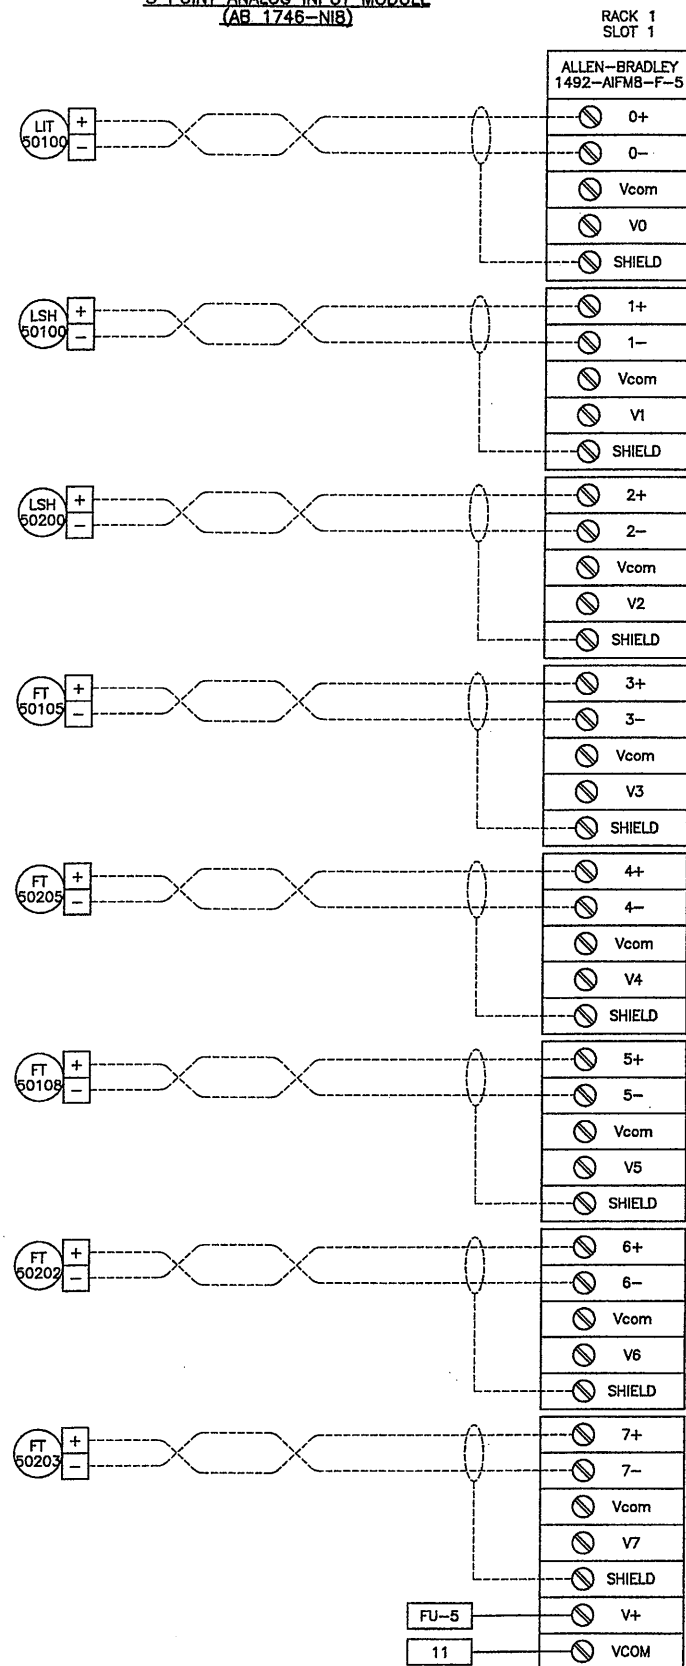

SODIUM BISULFITE TANK NO.1
LEVEL
0-XX FT.

SODIUM HYPOCHLORITE TANK NO.1
LEVEL
0-XX FT.

SODIUM HYPOCHLORITE TANK NO.2
LEVEL
0-XX FT.

SODIUM BISULFITE
PUMP NO. 1 FLOW
0-XX GPD


SODIUM HYPOCHLORITE
PUMP NO. 1 FLOW
0-XX GPD

SODIUM BISULFITE
PUMP #2 FLOW
0-XX GPD

SODIUM HYPOCHLORITE
PUMP #2 FLOW
0-XX GPD

SODIUM HYPOCHLORITE
PUMP #3 FLOW
0-XX GPD

8 POINT ANALOG INPUT MODULE
(AB 1746-N18)

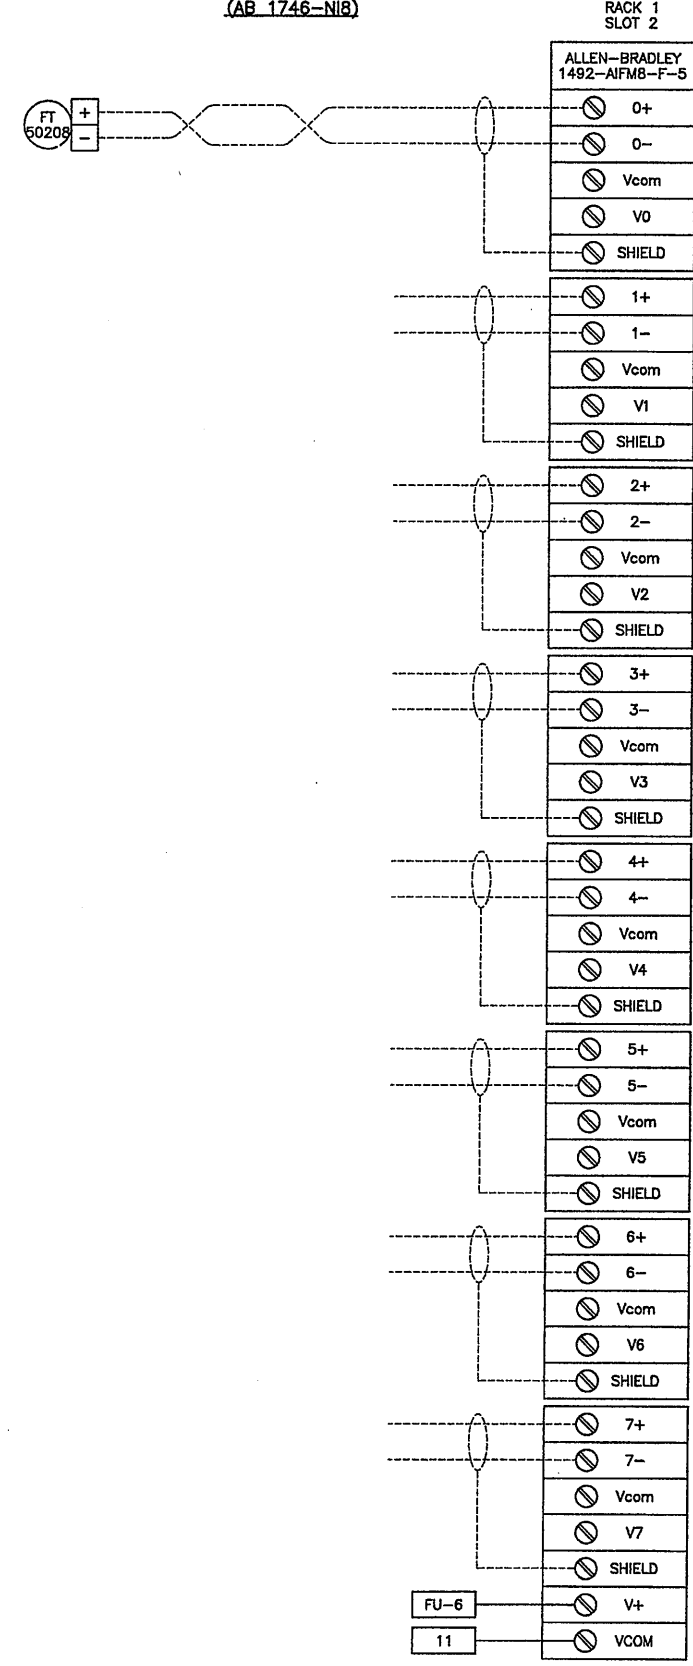

SODIUM HYPOCHLORITE
PUMP #4 FLOW
0-XX GPD

SPARE

SPARE

RECORD DRAWING

THESE CHANGES HAVE BEEN MADE TO REFLECT
MAJOR CHANGES, IF ANY, WHICH OCCURRED DURING
CONSTRUCTION. REVISIONS ARE BASED UPON
INFORMATION SUPPLIED BY CONTRACTOR.
DATE: 10/21/01 PER: L. Karpolitz

THIS DRAWING WAS PREPARED AT THE SCALE INDICATED IN THE
TITLE BLOCK. INACCURACIES IN THE STATED SCALE MAY BE
INTRODUCED WHEN DRAWINGS ARE REPRODUCED BY ANY MEANS.
USE THE GRAPHIC SCALE BAR IN THE TITLE BLOCK TO
DETERMINE THE ACTUAL SCALE OF THIS DRAWING.


Layer: ON=*; OFF=*REF*
01/09/01 OBG JEC
EEA-VERT

| No. | Date | Revisions | Init |
|-----|----------|---------------------|------|
| 0 | 4/20/01 | ISSUED FOR APPROVAL | PLD |
| 1 | 7/11/01 | AS BID | |
| 2 | 10/31/03 | RECORD DRAWING | |

In charge of -- PLD --
Designed by -- SAT --
Drawn by -- JEC --
Checked by -- PLD --

ENVIRONMENTAL ENGINEERING ASSOCIATES, LLP
SYRACUSE, NEW YORK

ONONDAGA COUNTY • DEPARTMENT OF DRAINAGE AND SANITATION • SYRACUSE, NEW YORK
METROPOLITAN SYRACUSE WASTEWATER TREATMENT PLANT
STAGE III AMMONIA AND STAGE II PHOSPHORUS REMOVAL PROJECT
CHEMICAL BUILDING "A" (PLC M20C)
ANALOG INPUT MODULES

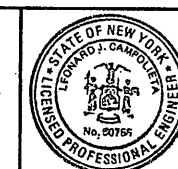


File Number
00659
Date
APRIL 2001
1-605
L. Karpolitz

NO ALTERATIONS PERMITTED HEREON EXCEPT
AS PROVIDED UNDER SECTION 7209 SUBDIVISION
2 OF THE NEW YORK STATE EDUCATION LAW

INSTRUMENTATION

8 POINT ANALOG INPUT MODULE
(AB 1746-NIB)

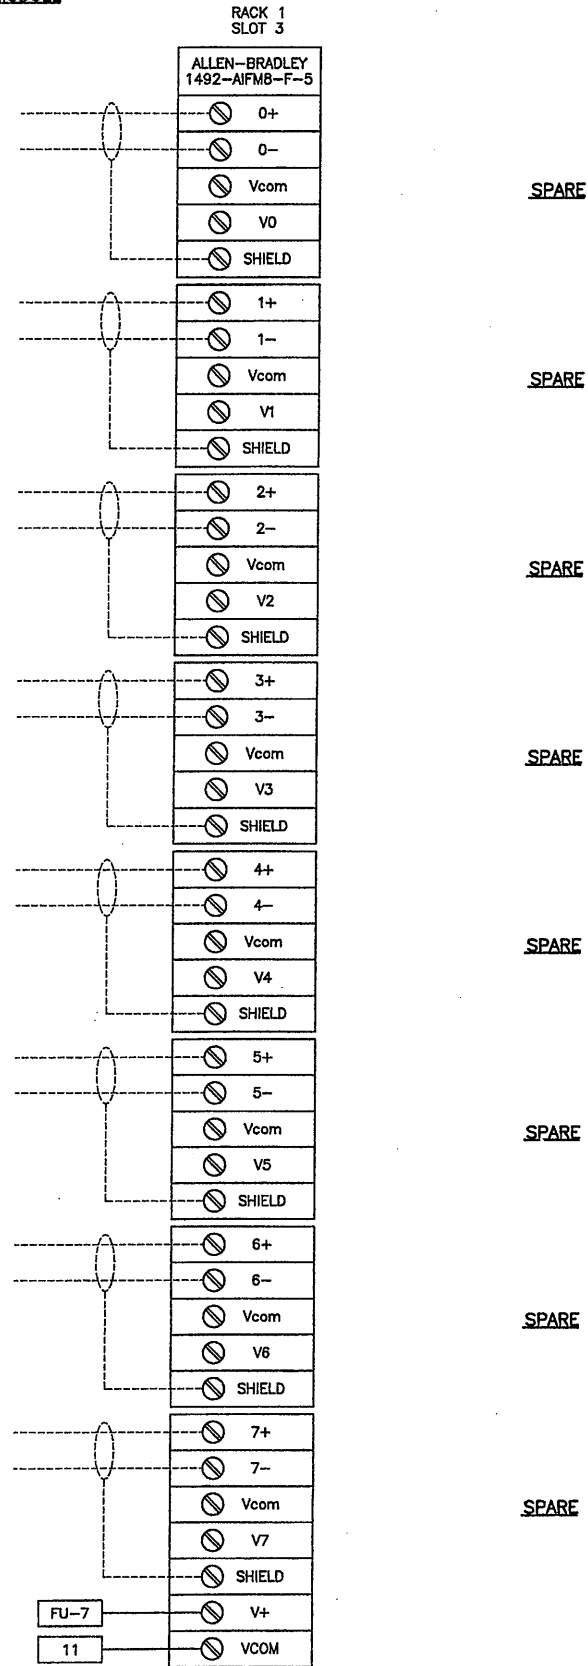

Layer: ON=*; OFF=*REF*
01/09/01 OBG JEC
EEA-VERT

RECORD DRAWING
THESE CHANGES HAVE BEEN REQUIRED TO REFLECT
MAJOR CHANGES OF ANY, WHICH OCCURRED DURING
CONSTRUCTION. REVISIONS ARE BASED UPON
INFORMATION SUPPLIED BY CONTRACTOR.
DATE: 10/21/05 PER: L. Stampel

THIS DRAWING WAS PREPARED AT THE SCALE INDICATED IN THE
TITLE BLOCK. INACCURACIES IN THE STATED SCALE MAY BE
INTRODUCED WHEN DRAWINGS ARE REPRODUCED BY ANY MEANS.
USE THE GRAPHIC SCALE BAR IN THE TITLE BLOCK TO
DETERMINE THE ACTUAL SCALE OF THIS DRAWING.

NO ALTERATIONS PERMITTED HEREON EXCEPT
AS PROVIDED UNDER SECTION 7209 SUBDIVISION
2 OF THE NEW YORK STATE EDUCATION LAW

| No. | Date | Revisions | Init |
|-----|----------|---------------------|------|
| 0 | 4/20/01 | ISSUED FOR APPROVAL | LJE |
| 1 | 7/11/01 | AS BID | |
| 2 | 10/31/05 | RECORD DRAWING | |



In charge of PLD
Designed by SAT
Drawn by JEC
Checked by PLD

ENVIRONMENTAL ENGINEERING ASSOCIATES, LLP
SYRACUSE, NEW YORK

ONONDAGA COUNTY • DEPARTMENT OF DRAINAGE AND SANITATION • SYRACUSE, NEW YORK
METROPOLITAN SYRACUSE WASTEWATER TREATMENT PLANT
STAGE III AMMONIA AND STAGE II PHOSPHORUS REMOVAL PROJECT
CHEMICAL BUILDING "A" (PLC M20C)
ANALOG INPUT MODULES
INSTRUMENTATION

File Number
00659
Date
APRIL 2001
L. Stampel

1-606

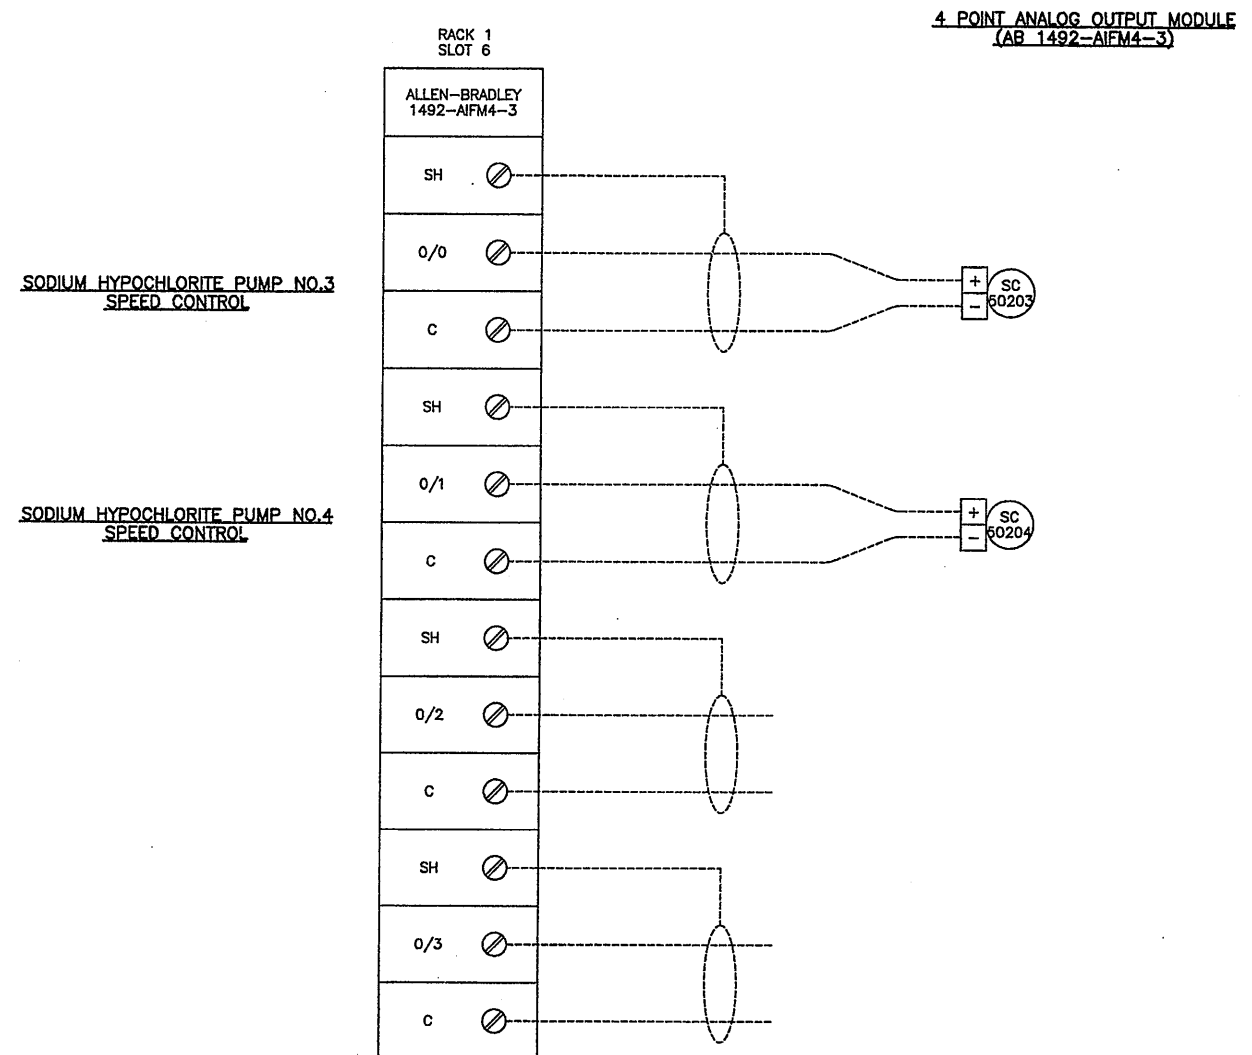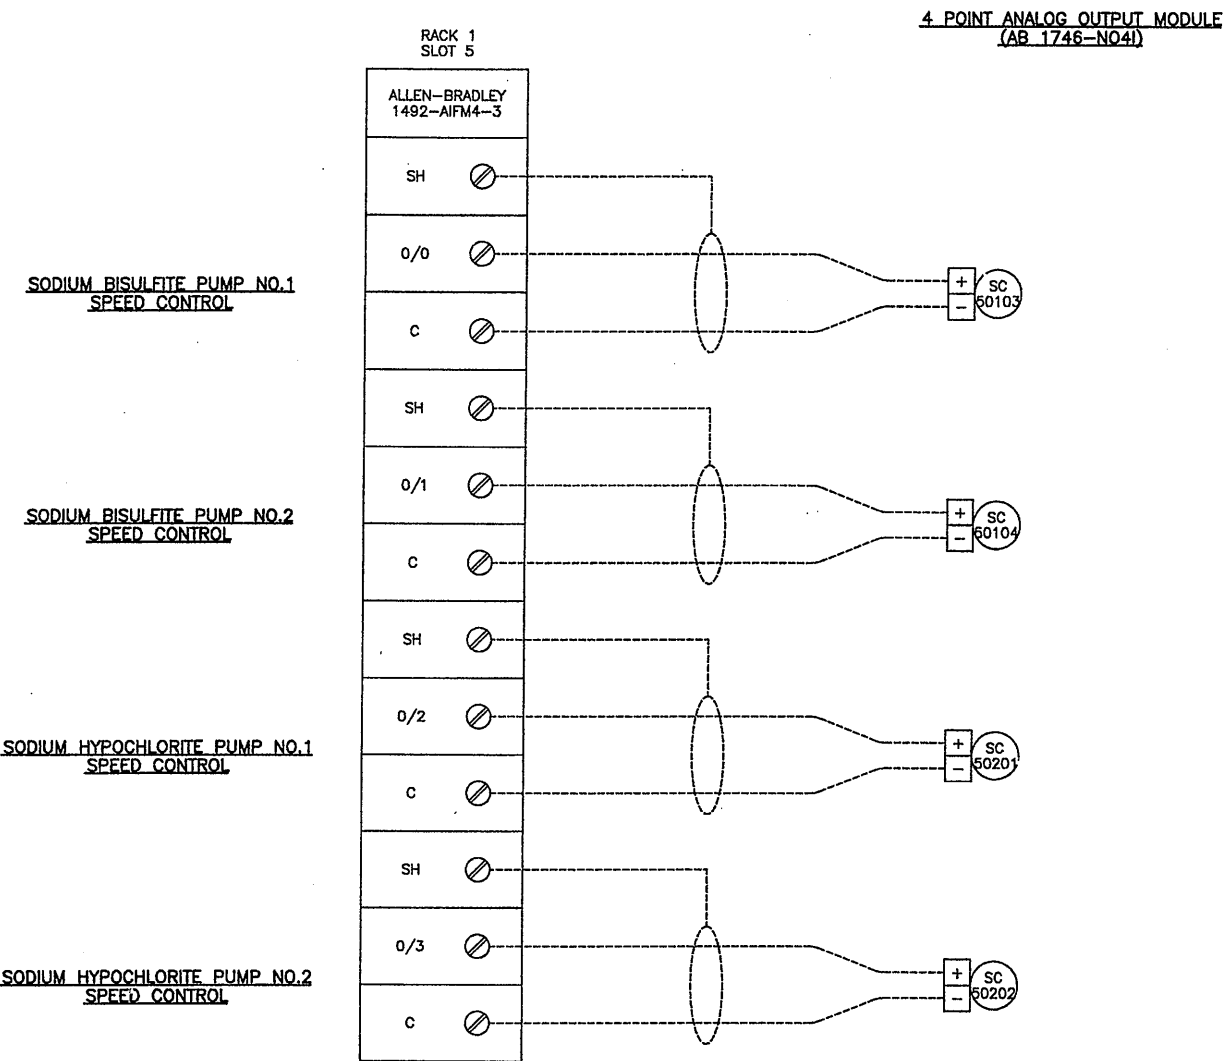

Layer: ON=*, OFF=*REF*
01/09/00 OBG JEC
EEA-VERT

| No. | Date | Revisions | Init |
|-----|----------|---------------------|------|
| 0 | 4/20/01 | ISSUED FOR APPROVAL | PLD |
| 1 | 7/11/01 | AS BID | |
| 2 | 10/31/05 | RECORD DRAWING | |

In charge of PLD
Designed by SAT
Drawn by JEC
Checked by PLD

ENVIRONMENTAL ENGINEERING ASSOCIATES, LLP
SYRACUSE, NEW YORK

ONONDAGA COUNTY • DEPARTMENT OF DRAINAGE AND SANITATION • SYRACUSE, NEW YORK
METROPOLITAN SYRACUSE WASTEWATER TREATMENT PLANT
STAGE III AMMONIA AND STAGE II PHOSPHORUS REMOVAL PROJECT
**CHEMICAL BUILDING "A" (PLC M20C)
ANALOG OUTPUT MODULES**



File Number
00659
Date
APRIL 2001
Ed Campollet

1-607


INSTRUMENTATION

RECORD DRAWING

THESE DRAWINGS HAVE BEEN REVISIONED TO REFLECT
MAJOR CHANGES, IF ANY, WHICH OCCURRED DURING
CONSTRUCTION. REVISIONS ARE BASED UPON
INFORMATION SUPPLIED BY CONTRACTOR.
DATE: 10/21/05 FOR: *Ed Campollet*

THIS DRAWING WAS PREPARED AT THE SCALE INDICATED IN THE
TITLE BLOCK. INACCURACIES IN THE STATED SCALE MAY BE
INTRODUCED WHEN DRAWINGS ARE REPRODUCED BY ANY MEANS.
USE THE GRAPHIC SCALE BAR IN THE TITLE BLOCK TO
DETERMINE THE ACTUAL SCALE OF THIS DRAWING.

4 POINT ANALOG OUTPUT MODULE
(AB 1746-NO4)

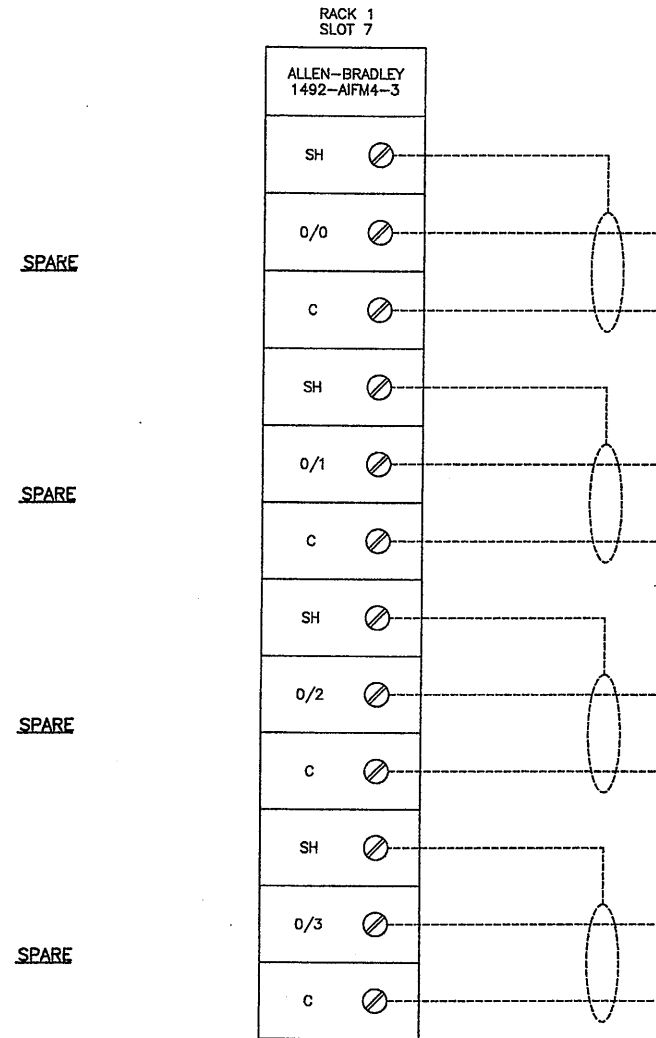

Layer: ON=*; OFF=*REF*

01/09/00 OBG JEC
EEA-VERT

| No. | Date | Revisions | Init |
|-----|----------|---------------------|------|
| 0 | 4/20/01 | ISSUED FOR APPROVAL | PLD |
| 1 | 7/11/01 | AS BID | |
| 2 | 10/31/05 | RECORD DRAWING | |

NO ALTERATIONS PERMITTED HEREON EXCEPT
AS PROVIDED UNDER SECTION 7209 SUBDIVISION
2 OF THE NEW YORK STATE EDUCATION LAW

In charge of PLD
Designed by SAT
Drawn by JEC
Checked by PLD

ENVIRONMENTAL ENGINEERING ASSOCIATES, LLP
SYRACUSE, NEW YORK

ONONDAGA COUNTY • DEPARTMENT OF DRAINAGE AND SANITATION • SYRACUSE, NEW YORK
METROPOLITAN SYRACUSE WASTEWATER TREATMENT PLANT
STAGE III AMMONIA AND STAGE II PHOSPHORUS REMOVAL PROJECT
CHEMICAL BUILDING "A" (PLC M20C)
ANALOG OUTPUT MODULES

INSTRUMENTATION




File Number
00659
Date
APRIL 2001
L. Campollet

1-608

RECORD DRAWING

THESE CHANGES HAVE BEEN MADE TO REFLECT
MAJOR CHANGES, IF ANY, WHICH OCCURRED DURING
CONSTRUCTION. REVISIONS ARE BASED UPON
INFORMATION SUPPLIED BY CONTRACTOR.
DATE 10/21/05 FOR L. Campollet

THIS DRAWING WAS PREPARED AT THE SCALE INDICATED IN THE
TITLE BLOCK. INACCURACIES IN THE STATED SCALE MAY BE
INTRODUCED WHEN DRAWINGS ARE REPRODUCED BY ANY MEANS.
USE THE GRAPHIC SCALE BAR IN THE TITLE BLOCK TO
DETERMINE THE ACTUAL SCALE OF THIS DRAWING.

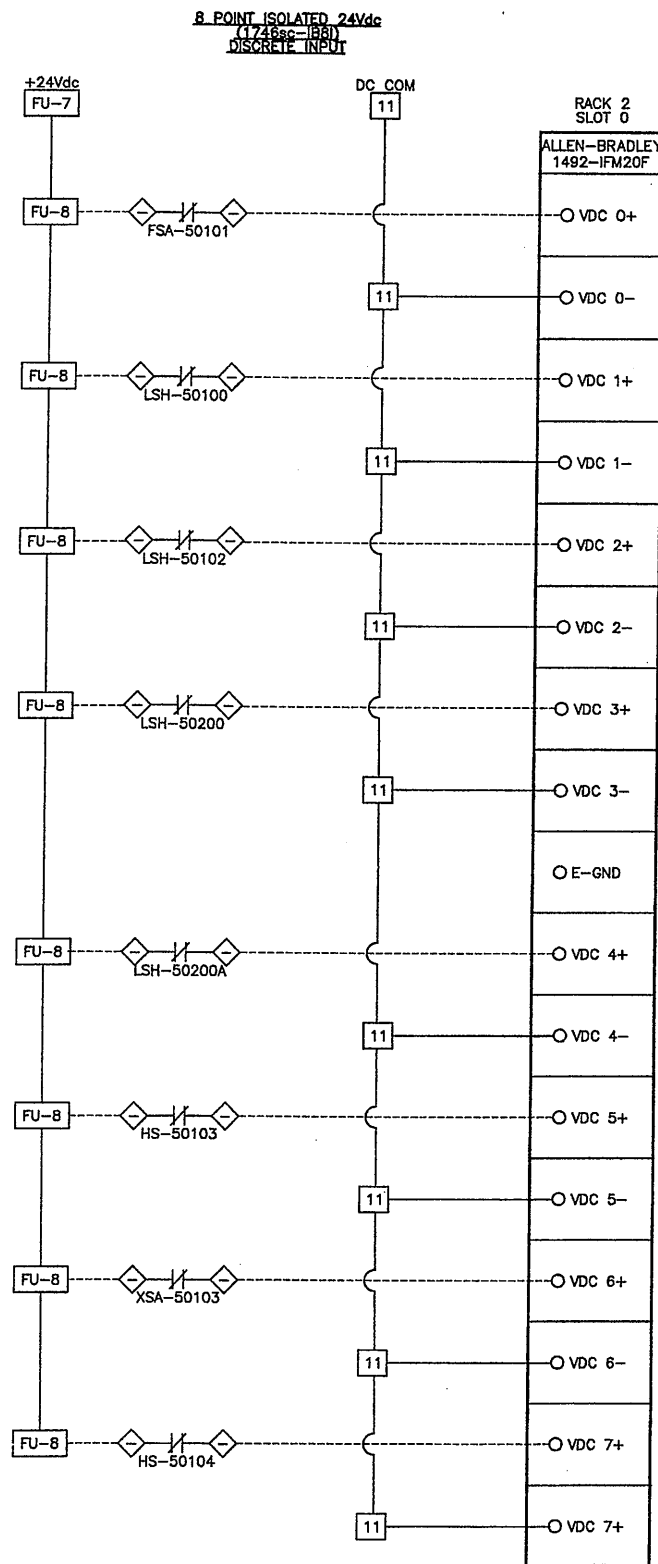

EMERGENCY EYEWASH/SHOWER
FLOW

SODIUM BISULFITE TANK NO.1
LEVEL HIGH

MANHOLE
LEVEL HIGH


SODIUM HYPOCHLORITE TANK NO.1
LEVEL HIGH

SODIUM HYPOCHLORITE TANK NO.2
LEVEL HIGH

SODIUM BISULFITE
PUMP NO.1 AUTO

SODIUM BISULFITE
PUMP NO.1 FAIL

SODIUM BISULFITE
PUMP NO.2 AUTO

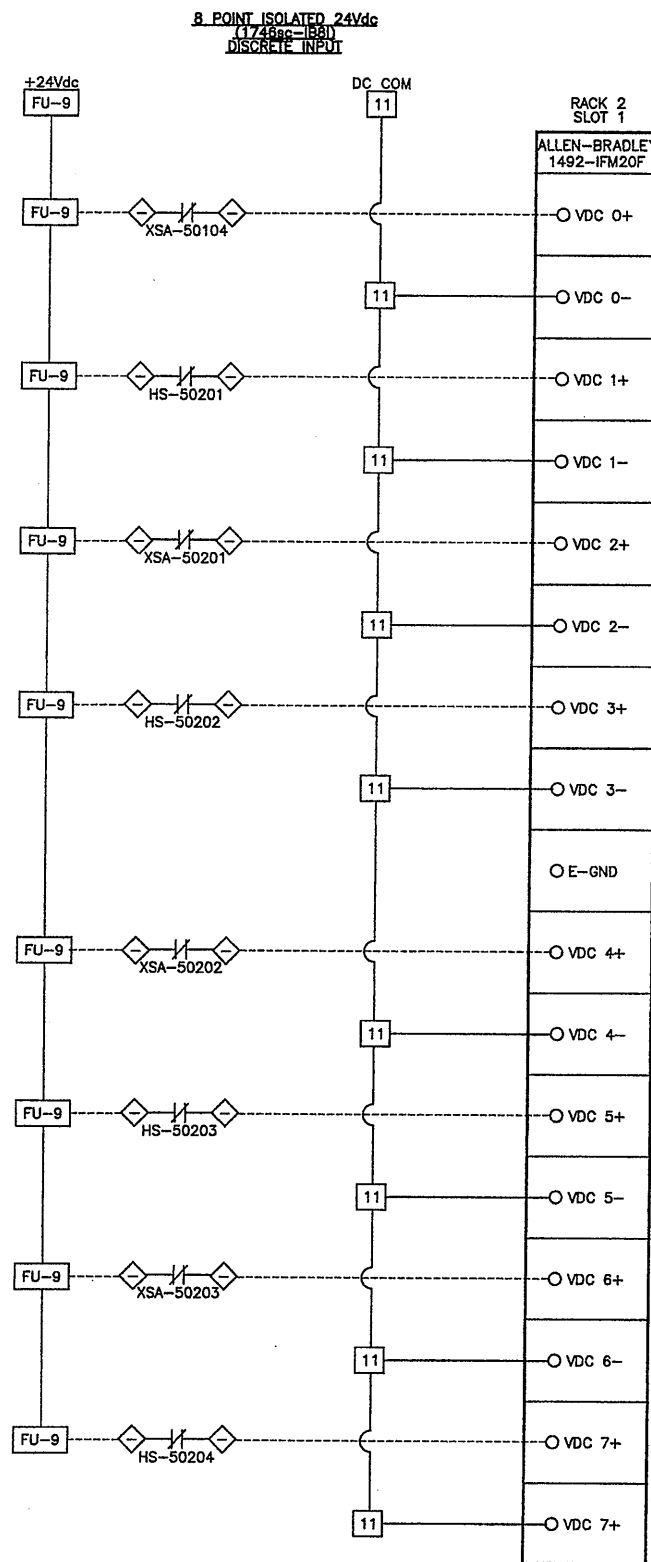

SODIUM BISULFITE
PUMP NO.2 FAIL

SODIUM HYPOCHLORITE
PUMP NO.1 AUTO

SODIUM HYPOCHLORITE
PUMP NO.2 AUTO

SODIUM HYPOCHLORITE
PUMP NO.3 AUTO

SODIUM HYPOCHLORITE
PUMP NO.4 AUTO

Layer: ON=*; OFF=*REF*

01/12/01 OBG JEC
EEA-VERT

| No. | Date | Revisions | Init |
|-----|----------|---------------------|------|
| 0 | 4/20/01 | ISSUED FOR APPROVAL | PLD |
| 1 | 7/11/01 | AS BID | |
| 2 | 10/31/01 | RECORD DRAWING | |

In charge of -- PLD
Designed by -- SAT
Drawn by -- JEC
Checked by -- PLD

ENVIRONMENTAL ENGINEERING ASSOCIATES, LLP
SYRACUSE, NEW YORK

ONONDAGA COUNTY • DEPARTMENT OF DRAINAGE AND SANITATION • SYRACUSE, NEW YORK
METROPOLITAN SYRACUSE WASTEWATER TREATMENT PLANT
STAGE III AMMONIA AND STAGE II PHOSPHORUS REMOVAL PROJECT
CHEMICAL BUILDING "A" (PLC M20C)
DIGITAL INPUT MODULES

INSTRUMENTATION



RECORD DRAWING

THESE DRAWINGS HAVE BEEN REVISIONED TO REFLECT
MAJOR CHANGES IF ANY, WHICH OCCURRED DURING
CONSTRUCTION. REVISIONS ARE BASED UPON
INFORMATION SUPPLIED BY CONTRACTOR.

DATE: 10/21/01 FOR: PLD

THIS DRAWING WAS PREPARED AT THE SCALE INDICATED IN THE
TITLE BLOCK. INACCURACIES IN THE STATED SCALE MAY BE
INTRODUCED WHEN DRAWINGS ARE REPRODUCED BY ANY MEANS.
USE THE GRAPHIC SCALE BAR IN THE TITLE BLOCK TO
DETERMINE THE ACTUAL SCALE OF THIS DRAWING.


File Number
00659

Date
APRIL 2001

1-609

PLD

NO ALTERATIONS PERMITTED HEREON EXCEPT
AS PROVIDED UNDER SECTION 7209 SUBDIVISION
2 OF THE NEW YORK STATE EDUCATION LAW

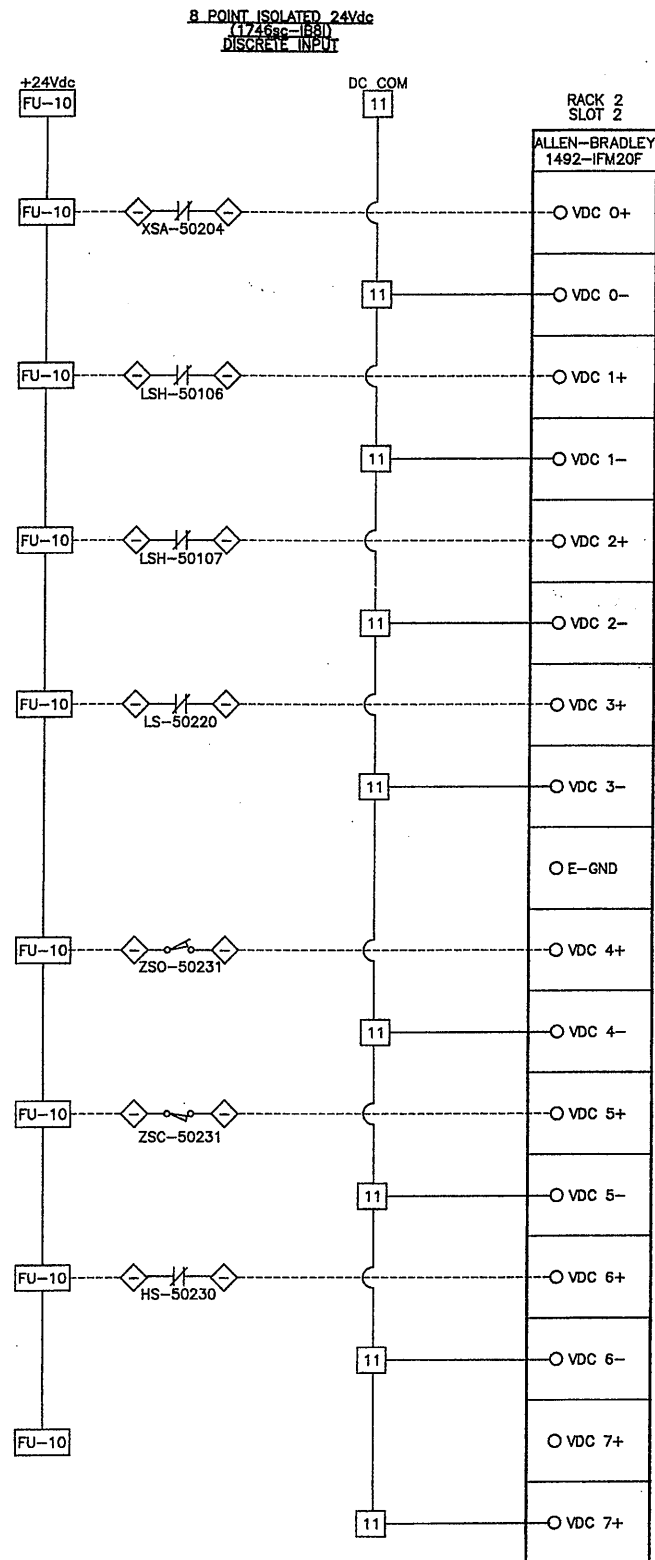

SODIUM HYPOCHLORITE SUMP LEVEL HIGH

SODIUM BISULFITE SUMP LEVEL HIGH


SODIUM BISULFITE TRANSFER PIPE LEAK

CARRIER WATER PUMP 1 DISCHARGE VALVE FULLY OPEN

CARRIER WATER PUMP 1 DISCHARGE VALVE FULLY CLOSED

CARRIER WATER PUMP 1 AUTO

SPARE

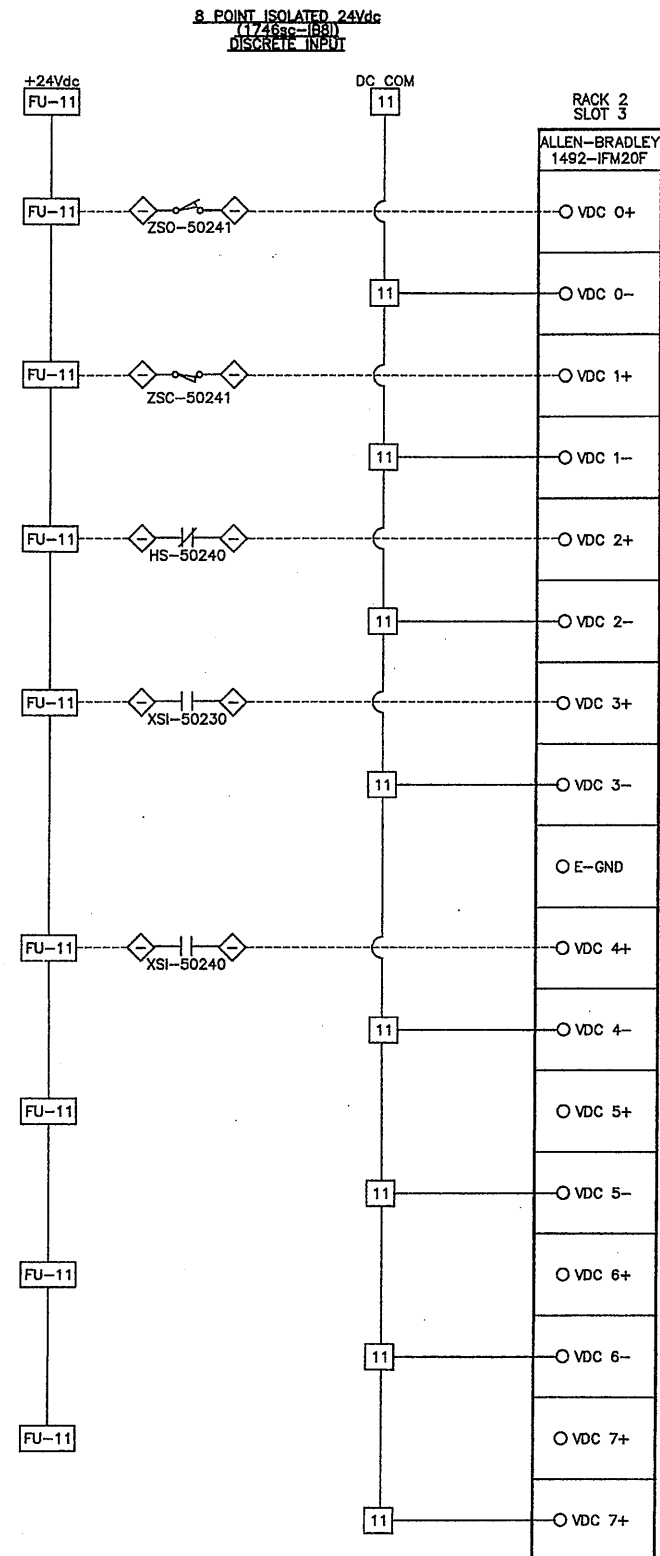

CARRIER WATER PUMP 2 DISCHARGE VALVE FULLY OPEN

CARRIER WATER PUMP 2 DISCHARGE VALVE FULLY CLOSED

CARRIER WATER PUMP 2 AUTO

CARRIER WATER PUMP 1 RUNNING

CARRIER WATER PUMP 2 RUNNING

SPARE

SPARE

SPARE

Layer: ON=*; OFF=*REF*
01/12/01 OBS JEC
EEA-VERT

| No. | Date | Revisions | Init |
|-----|----------|---------------------|------|
| 0 | 4/20/01 | ISSUED FOR APPROVAL | PLD |
| 1 | 7/11/01 | AS BID | |
| 2 | 10/31/05 | RECORD DRAWING | |

In charge of PLD
Designed by SAT
Drawn by JEC
Checked by PLD

ENVIRONMENTAL ENGINEERING ASSOCIATES, LLP
SYRACUSE, NEW YORK

ONONDAGA COUNTY • DEPARTMENT OF DRAINAGE AND SANITATION • SYRACUSE, NEW YORK
METROPOLITAN SYRACUSE WASTEWATER TREATMENT PLANT
STAGE III AMMONIA AND STAGE II PHOSPHORUS REMOVAL PROJECT
CHEMICAL BUILDING "A" (PLC M20C)
DIGITAL INPUT MODULES



File Number
00659
Date
APRIL 2001
Campolieti

I-610


RECORD DRAWING

THIS DRAWING HAS BEEN REVISIONED TO REFLECT
MAJOR CHANGES, IF ANY, WHICH OCCURRED DURING
CONSTRUCTION. REVISIONS ARE BASED UPON
INFORMATION SUPPLIED BY CONTRACTOR.

DATE: 10/21/05 FOR: *Campolieti*

THIS DRAWING WAS PREPARED AT THE SCALE INDICATED IN THE
TITLE BLOCK. INACCURACIES IN THE STATED SCALE MAY BE
INTRODUCED WHEN DRAWINGS ARE REPRODUCED BY ANY MEANS.
USE THE GRAPHIC SCALE BAR IN THE TITLE BLOCK TO
DETERMINE THE ACTUAL SCALE OF THIS DRAWING.

8 POINT ISOLATED 24Vdc
(17468g-1B8)
DISCRETE INPUT

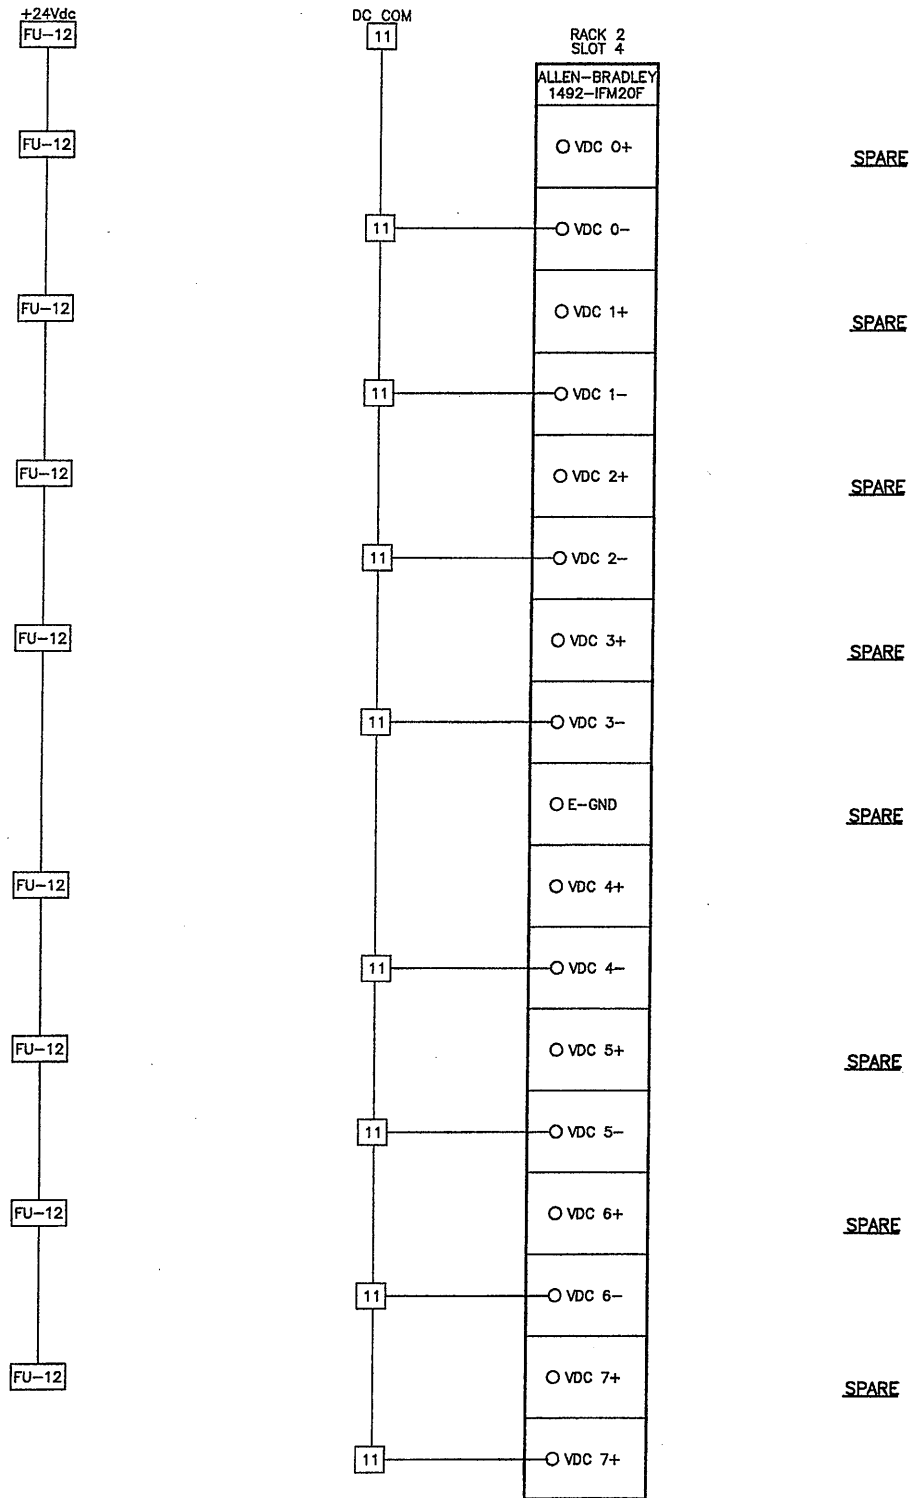

Layer: ON=*; OFF=*REF*
01/12/01 OBG JEC
EEA-VERT

RECORD DRAWING

THESE DRAWINGS HAVE BEEN REVISIONED TO REFLECT
MAJOR CHANGES, IF ANY, WHICH OCCURRED DURING
CONSTRUCTION. REVISIONS ARE BASED UPON
INFORMATION SUPPLIED BY CONTRACTOR.
DATE: 10/21/05 FOR: [Signature]

THIS DRAWING WAS PREPARED AT THE SCALE INDICATED IN THE
TITLE BLOCK. INACCURACIES IN THE STATED SCALE MAY BE
INTRODUCED WHEN DRAWINGS ARE REPRODUCED BY ANY MEANS.
USE THE GRAPHIC SCALE BAR IN THE TITLE BLOCK TO
DETERMINE THE ACTUAL SCALE OF THIS DRAWING.

| No. | Date | Revisions | Init |
|-----|----------|---------------------|------|
| 0 | 4/20/01 | ISSUED FOR APPROVAL | PLD |
| 1 | 7/11/01 | AS BID | |
| 2 | 10/31/05 | RECORD DRAWING | |

In charge of --- PLD ---
Designed by --- SAT ---
Drawn by --- JEC ---
Checked by --- PLD ---

ENVIRONMENTAL ENGINEERING ASSOCIATES, LLP
SYRACUSE, NEW YORK

ONONDAGA COUNTY • DEPARTMENT OF DRAINAGE AND SANITATION • SYRACUSE, NEW YORK
METROPOLITAN SYRACUSE WASTEWATER TREATMENT PLANT
STAGE III AMMONIA AND STAGE II PHOSPHORUS REMOVAL PROJECT
CHEMICAL BUILDING "A" (PLC M20C)
DIGITAL INPUT MODULES




File Number
00659
Date
APRIL 2001
[Signature]

I-611


RACK 2
SLOT 6
ALLEN-BRADLEY
1492-IFM20F-FS-2

**8 POINT ISOLATED RELAY OUTPUT
(AB 1746-OX8)**

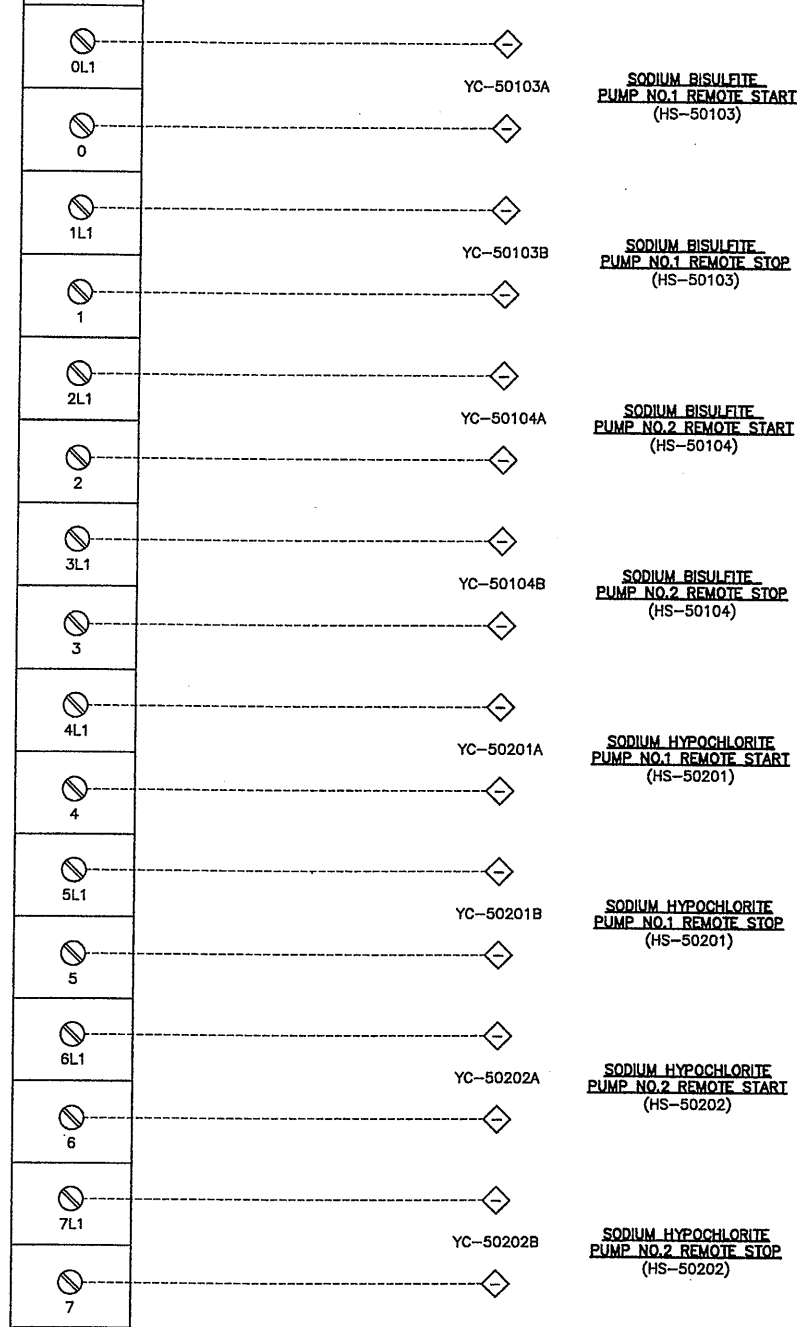

RACK 2
SLOT 7
ALLEN-BRADLEY
1492-IFM20F-FS-2

**8 POINT ISOLATED RELAY OUTPUT
(AB 1746-OX8)**

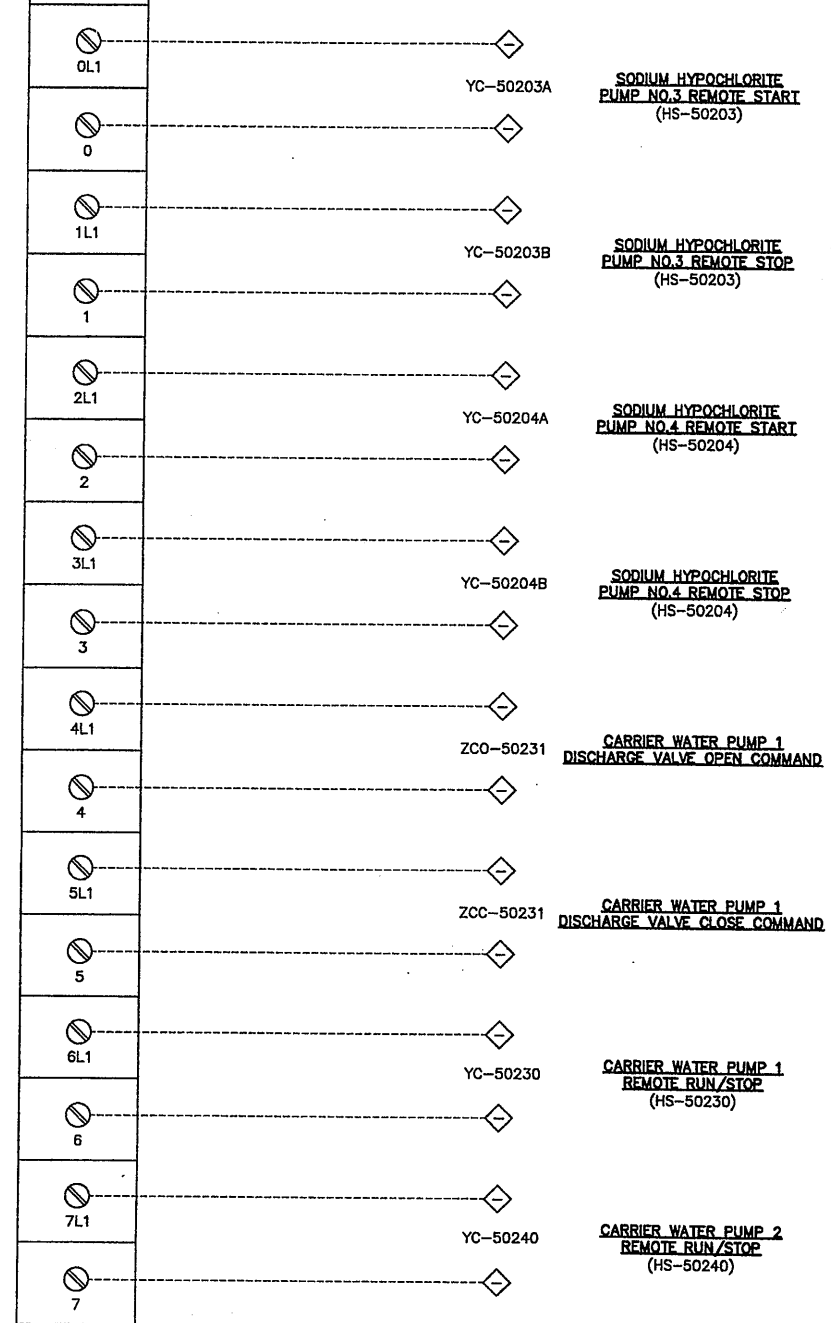

Layer: ON=*; OFF=*REF*

11/27/00 OBG JEC
EEA-VERT

| No. | Date | Revisions | Init |
|-----|----------|---------------------|------|
| 0 | 4/20/01 | ISSUED FOR APPROVAL | PLD |
| 1 | 7/11/01 | AS BID | SAT |
| 2 | 10/31/05 | RECORD DRAWING | PLD |

In charge of PLD
Designed by SAT
Drawn by JEC
Checked by PLD

ENVIRONMENTAL ENGINEERING ASSOCIATES, LLP
SYRACUSE, NEW YORK

ONONDAGA COUNTY • DEPARTMENT OF DRAINAGE AND SANITATION • SYRACUSE, NEW YORK
METROPOLITAN SYRACUSE WASTEWATER TREATMENT PLANT
STAGE III AMMONIA AND STAGE II PHOSPHORUS REMOVAL PROJECT
CHEMICAL BUILDING "A" (PLC M20C)
DIGITAL OUTPUT MODULES

INSTRUMENTATION



File Number
00659
Date
APRIL 2001
Signature: *L. Gambolita*

1-612


RECORD DRAWING

THESE CHANGES HAVE BEEN MADE TO REFLECT MAJOR CHANGES OF ANY KIND OCCURRED DURING CONSTRUCTION. REVISIONS ARE BASED UPON INFORMATION SUPPLIED BY CONTRACTOR.

DATE: 10/21/05 PER: L. Gambolita

THIS DRAWING WAS PREPARED AT THE SCALE INDICATED IN THE TITLE BLOCK. INACCURACIES IN THE STATED SCALE MAY BE INTRODUCED WHEN DRAWINGS ARE REPRODUCED BY ANY MEANS. USE THE GRAPHIC SCALE BAR IN THE TITLE BLOCK TO DETERMINE THE ACTUAL SCALE OF THIS DRAWING.

NO ALTERATIONS PERMITTED HEREON EXCEPT AS PROVIDED UNDER SECTION 7209 SUBDIVISION 2 OF THE NEW YORK STATE EDUCATION LAW

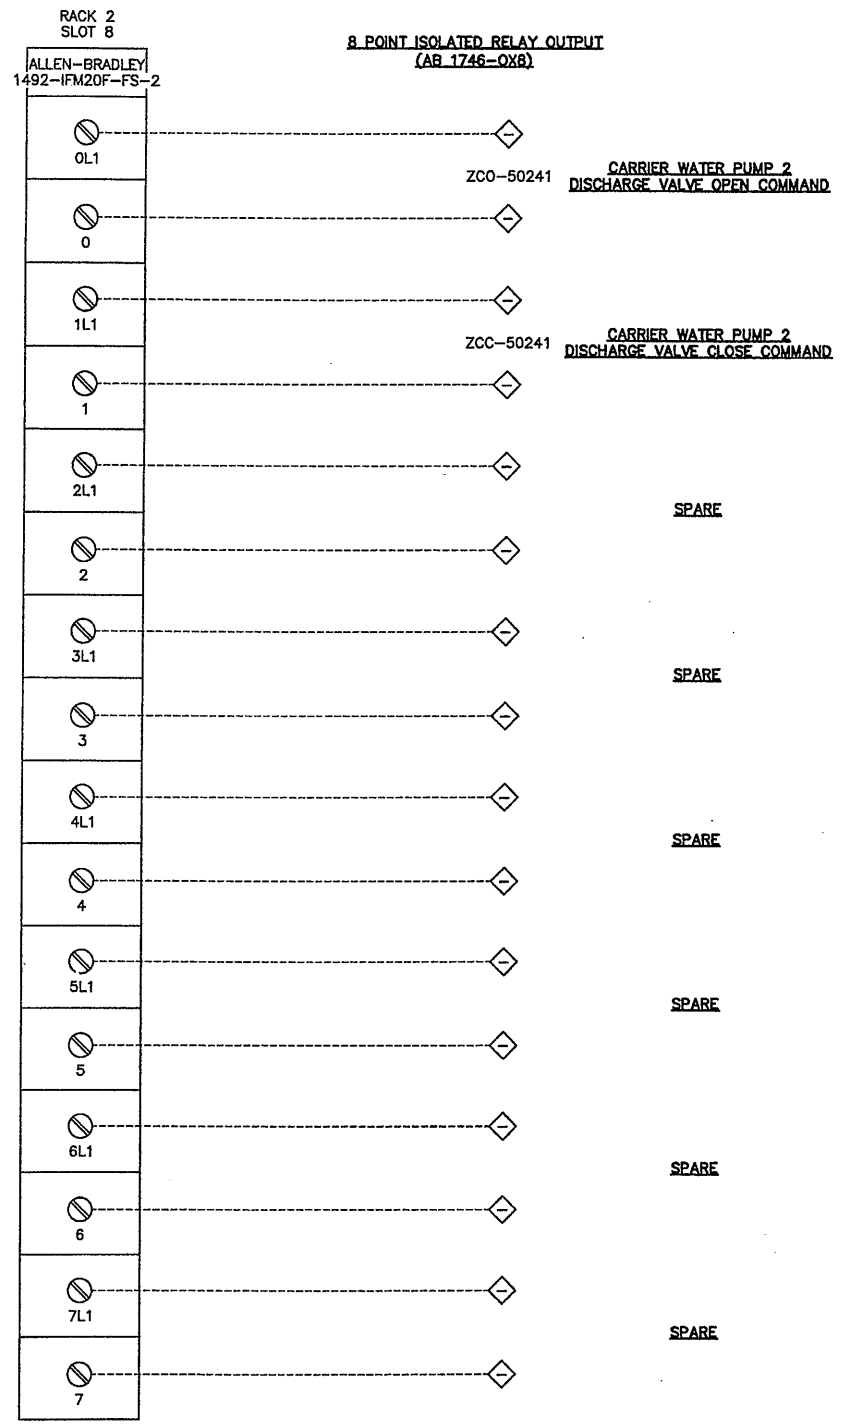

Layer: ON=*; OFF=*REF*
11/27/00 DBG JEC
EEA-VERT

RECORD DRAWING
THESE CHANGES HAVE BEEN MADE TO REFLECT
LATER CHANGES, IF ANY, WHICH OCCURRED DURING
CONSTRUCTION. REVISIONS ARE BASED UPON
INFORMATION SUPPLIED BY CONTRACTOR.
DATE: 10/21/01 FOR: L. Sampson

THIS DRAWING WAS PREPARED AT THE SCALE INDICATED IN THE
TITLE BLOCK. INACCURACIES IN THE STATED SCALE MAY BE
INTRODUCED WHEN DRAWINGS ARE REPRODUCED BY ANY MEANS.
USE THE GRAPHIC SCALE BAR IN THE TITLE BLOCK TO
DETERMINE THE ACTUAL SCALE OF THIS DRAWING.


NO ALTERATIONS PERMITTED HEREON EXCEPT
AS PROVIDED UNDER SECTION 7209 SUBDIVISION
2 OF THE NEW YORK STATE EDUCATION LAW

| No. | Date | Revisions | Init |
|-----|----------|---------------------|------|
| 0 | 4/20/01 | ISSUED FOR APPROVAL | JEC |
| 1 | 7/11/01 | AS BID | |
| 2 | 10/31/05 | RECORD DRAWING | |

In charge of PLD
Designed by SAT
Drawn by JEC
Checked by PLD


ENVIRONMENTAL ENGINEERING ASSOCIATES, LLP
SYRACUSE, NEW YORK

ONONDAGA COUNTY • DEPARTMENT OF DRAINAGE AND SANITATION • SYRACUSE, NEW YORK
METROPOLITAN SYRACUSE WASTEWATER TREATMENT PLANT
STAGE III AMMONIA AND STAGE II PHOSPHORUS REMOVAL PROJECT
CHEMICAL BUILDING "A" (PLC M20C)
DIGITAL OUTPUT MODULES
INSTRUMENTATION

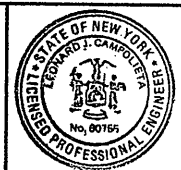


File Number
00659
Date
APRIL 2001
L. Sampson


1-613

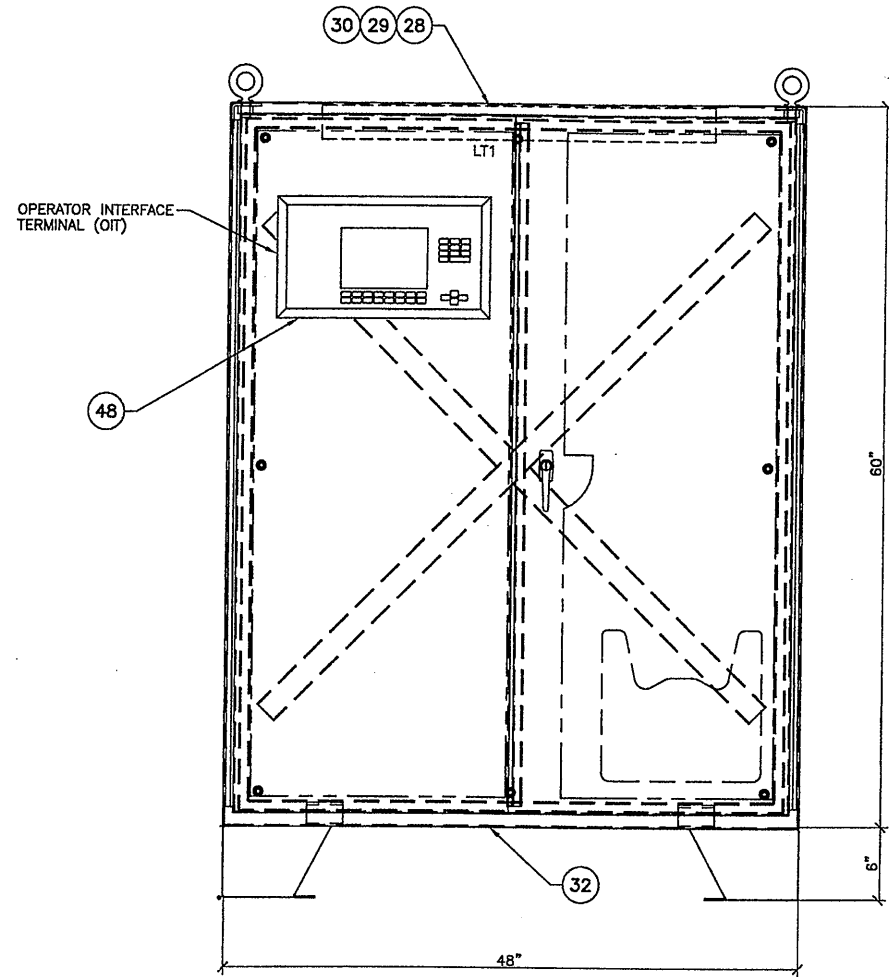

CONTROL PANEL FRONT VIEW

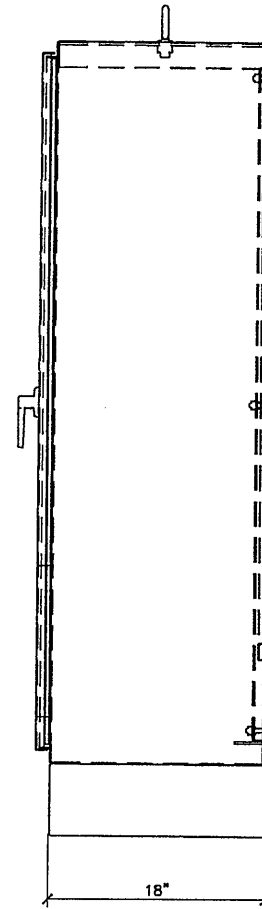

CHLORINE BYPASS BLDG. CONTROL PANEL

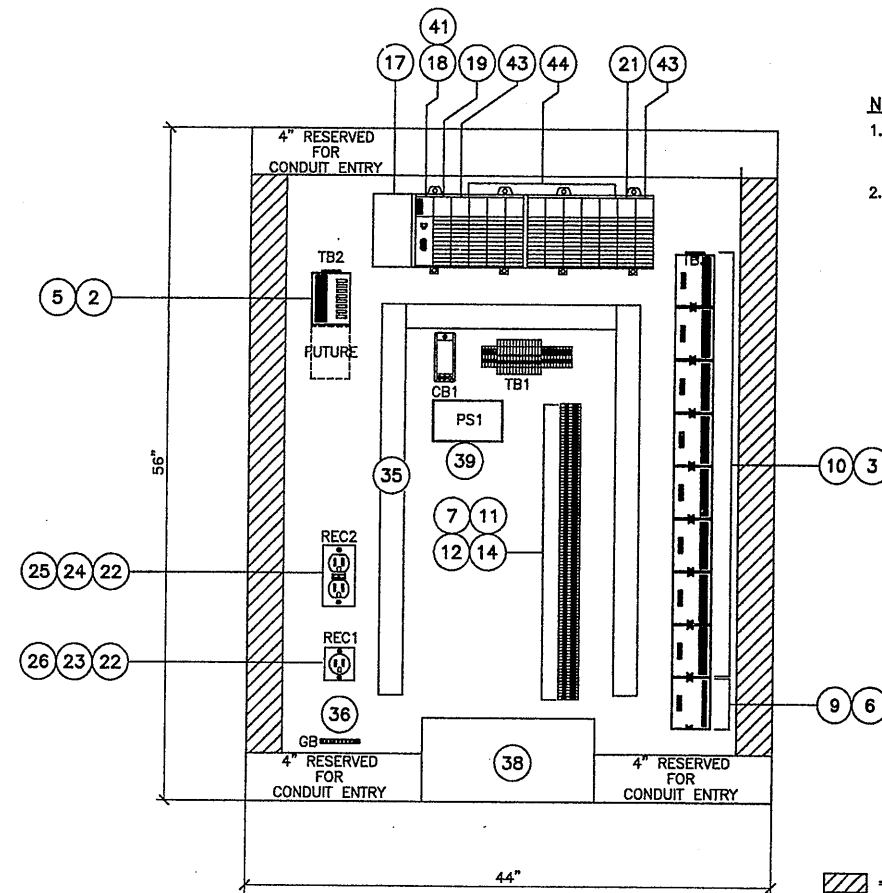


CONTROL PANEL INTERIOR VIEW

NOTES:

- LAYOUT SHOWN IS FOR CONCEPT ONLY. CONTRACTOR SHALL PROVIDE ALL NECESSARY APPURTENANCES REQUIRED FOR A COMPLETE AND OPERATIONAL SYSTEM.
- PANEL SIZE IS APPROXIMATE ONLY. CONTRACTOR SHALL PROVIDE ENCLOSURE SIZE AS REQUIRED FOR EQUIPMENT.

▨ = ALL FIELD WIRES

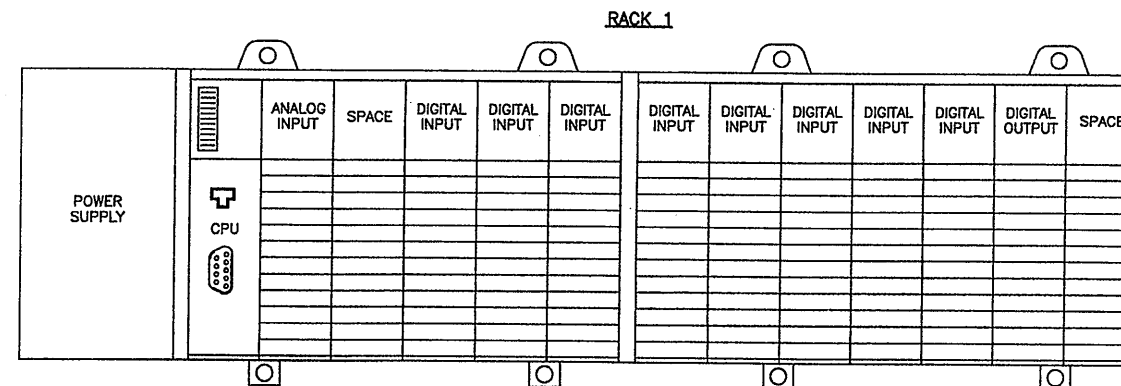

PLC MODULE LAYOUT

RECORD DRAWING

THESE DRAWINGS HAVE BEEN REVISIONED TO REFLECT MAJOR CHANGES, IF ANY, WHICH OCCURRED DURING CONSTRUCTION. REVISIONS ARE BASED UPON INFORMATION SUPPLIED BY CONTRACTOR.
DATE: 10/24/05 FOR: K. Campbell

THIS DRAWING WAS PREPARED AT THE SCALE INDICATED IN THE TITLE BLOCK. INACCURACIES IN THE STATED SCALE MAY BE INTRODUCED WHEN DRAWINGS ARE REPRODUCED BY ANY MEANS. USE THE GRAPHIC SCALE BAR IN THE TITLE BLOCK TO DETERMINE THE ACTUAL SCALE OF THIS DRAWING.

01/12/01 OBG JEC

| No. | Date | Revisions | Init |
|-----|----------|---------------------|------|
| 0 | 4/20/01 | ISSUED FOR APPROVAL | PLD |
| 1 | 7/11/01 | AS BID | SAT |
| 2 | 10/31/05 | RECORD DRAWING | JEC |

In charge of -- PLD
Designed by -- SAT
Drawn by -- JEC
Checked by -- PLD

ENVIRONMENTAL ENGINEERING ASSOCIATES, LLP
SYRACUSE, NEW YORK

ONONDAGA COUNTY • DEPARTMENT OF DRAINAGE AND SANITATION • SYRACUSE, NEW YORK
METROPOLITAN SYRACUSE WASTEWATER TREATMENT PLANT
STAGE III AMMONIA AND STAGE II PHOSPHORUS REMOVAL PROJECT
CHEMICAL BUILDING "C" (PLC M16)
CONTROL PANEL LAYOUT




File Number
00659
Date
APRIL 2001
K. Campbell

I-614

NO ALTERATIONS PERMITTED HEREON EXCEPT AS PROVIDED UNDER SECTION 7209 SUBDIVISION 2 OF THE NEW YORK STATE EDUCATION LAW

INSTRUMENTATION

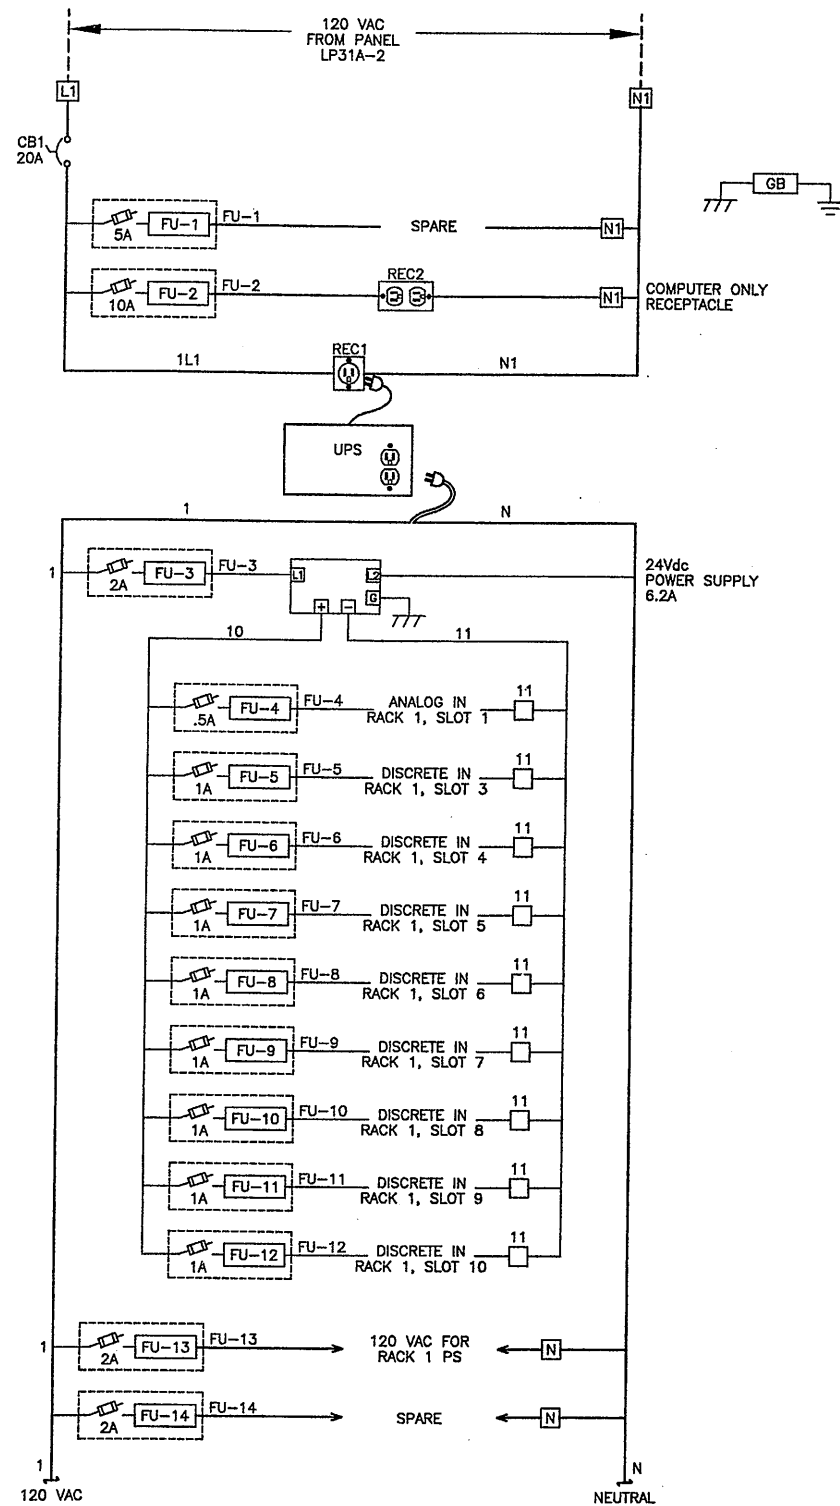

| BILL OF MATERIALS | | | | |
|-------------------|----------|--------------------|---------------|--|
| SYMBOL | QUANTITY | MODEL NUMBER | MANUFACTURER | DESCRIPTION |
| 1 | | | | |
| 2 | A/R | SEE SPECIFICATIONS | Allen-Bradley | Analog Input Interface Module |
| 3 | A/R | SEE SPECIFICATIONS | Allen-Bradley | Digital Input Interface Cable - 1 meter |
| 4 | | | | |
| 5 | A/R | SEE SPECIFICATIONS | Allen-Bradley | Analog Input Interface Cable - 1 meter |
| 6 | A/R | SEE SPECIFICATIONS | Allen-Bradley | Relay Output Interface Cable - 0.5 meter |
| 7 | A/R | SEE SPECIFICATIONS | Allen-Bradley | High Density Terminal Block |
| 8 | A/R | SEE SPECIFICATIONS | Allen-Bradley | Fusible Switch |
| 9 | A/R | SEE SPECIFICATIONS | Allen-Bradley | Relay Output Interface Module |
| 10 | A/R | SEE SPECIFICATIONS | Allen-Bradley | Digital Input Interface Module |
| 11 | A/R | SEE SPECIFICATIONS | Allen-Bradley | End Anchor |
| 12 | A/R | SEE SPECIFICATIONS | Allen-Bradley | High Density Terminal Block End Barrier |
| 13 | A/R | SEE SPECIFICATIONS | Allen-Bradley | Fusible Switch End Barrier |
| 14 | A/R | SEE SPECIFICATIONS | Allen-Bradley | High Density Jumper |
| 15 | | | | |
| 16 | A/R | SEE SPECIFICATIONS | Allen-Bradley | 13 Slot I/O Chassis |
| 17 | A/R | SEE SPECIFICATIONS | Allen-Bradley | I/O Chassis Power Supply |
| 18 | A/R | SEE SPECIFICATIONS | Allen-Bradley | CPU |
| 19 | A/R | SEE SPECIFICATIONS | Allen-Bradley | Analog Input - 8 point |
| 20 | | | | |
| 21 | A/R | SEE SPECIFICATIONS | Allen-Bradley | Relay Output - 8 point |
| 22 | A/R | SEE SPECIFICATIONS | RACO | Box |
| 23 | A/R | SEE SPECIFICATIONS | RACO | Cover - single 15 amp |
| 24 | A/R | SEE SPECIFICATIONS | RACO | Cover - duplex 15 amp |
| 25 | A/R | SEE SPECIFICATIONS | Hubbell | 15A Duplex receptacle |
| 26 | A/R | SEE SPECIFICATIONS | Hubbell | 15A Single receptacle |
| 27 | | | | |
| 28 | | | | |
| 29 | | | | |
| 30 | | | | |
| 31 | | | | |
| 32 | A/R | SEE SPECIFICATIONS | Hoffman | Nema 12 Enclosure |
| 33 | A/R | SEE SPECIFICATIONS | Hoffman | Sub-Panel |
| 34 | A/R | SEE SPECIFICATIONS | Panduit | 3"W x 3"D Slotted Wiring Duct |
| 35 | A/R | SEE SPECIFICATIONS | Panduit | 2"W x 3"D Slotted Wiring Duct |
| 36 | A/R | SEE SPECIFICATIONS | Square D | Ground Bar |
| 37 | A/R | SEE SPECIFICATIONS | Allen-Bradley | 20 amp Circuit Breaker, single pole |
| 38 | A/R | SEE SPECIFICATIONS | Best Power | Uninterruptible Power Supply |
| 39 | A/R | SEE SPECIFICATIONS | Power One | DC Power Supply 24 Vdc Output |
| 40 | A/R | SEE SPECIFICATIONS | TBD | Fuses |
| 41 | A/R | SEE SPECIFICATIONS | Allen-Bradley | Flash EEprom Memory for CPU |
| 42 | A/R | SEE SPECIFICATIONS | - | - |
| 43 | A/R | SEE SPECIFICATIONS | Allen-Bradley | Blank Slot Filler Module |
| 44 | A/R | SEE SPECIFICATIONS | Allen-Bradley | Discrete Input - 8 point |
| 45 | | | | |
| 46 | | | | |
| 47 | | | | |
| 48 | A/R | SEE SPECIFICATIONS | Allen-Bradley | Operator Interface Terminal (OIT) |


Layer: ON=*; OFF=*REF*
07/17/00 OBG JEC

| No. | Date | Revisions | Init |
|-----|----------|---------------------|------|
| 0 | 4/20/01 | ISSUED FOR APPROVAL | JEC |
| 1 | 7/11/01 | AS BID | |
| 2 | 10/31/05 | RECORD DRAWING | |

In charge of PLD
Designed by SAT
Drawn by JEC
Checked by PLD



ONONDAGA COUNTY • DEPARTMENT OF DRAINAGE AND SANITATION • SYRACUSE, NEW YORK
METROPOLITAN SYRACUSE WASTEWATER TREATMENT PLANT
STAGE III AMMONIA AND STAGE II PHOSPHORUS REMOVAL PROJECT
CHEMICAL BUILDING "C" (PLC M16)
CONTROL CIRCUIT WIRING

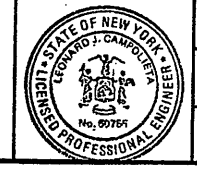


File Number 00659
Date APRIL 2001
I-615


RECORD DRAWING
THIS DRAWING HAS BEEN REVIEWED TO REFLECT MAJOR CHANGES, IF ANY, WHICH OCCURRED DURING CONSTRUCTION. REVISIONS ARE BASED UPON INFORMATION SUPPLIED BY CONTRACTOR.
DATE: 10/21/05 FOR: Stamplet

THIS DRAWING WAS PREPARED AT THE SCALE INDICATED IN THE TITLE BLOCK. INACCURACIES IN THE STATED SCALE MAY BE INTRODUCED WHEN DRAWINGS ARE REPRODUCED BY ANY MEANS. USE THE GRAPHIC SCALE BAR IN THE TITLE BLOCK TO DETERMINE THE ACTUAL SCALE OF THIS DRAWING.


TB1

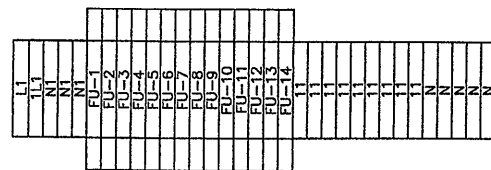


TB2 (ANALOG)

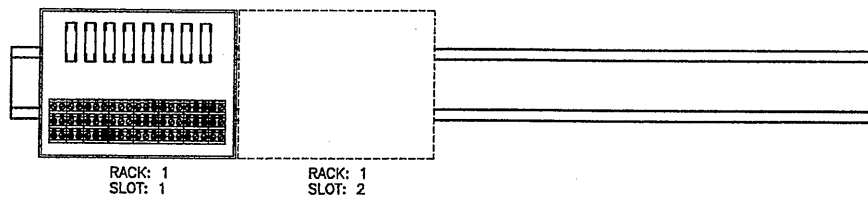

TB3 (DIGITAL)

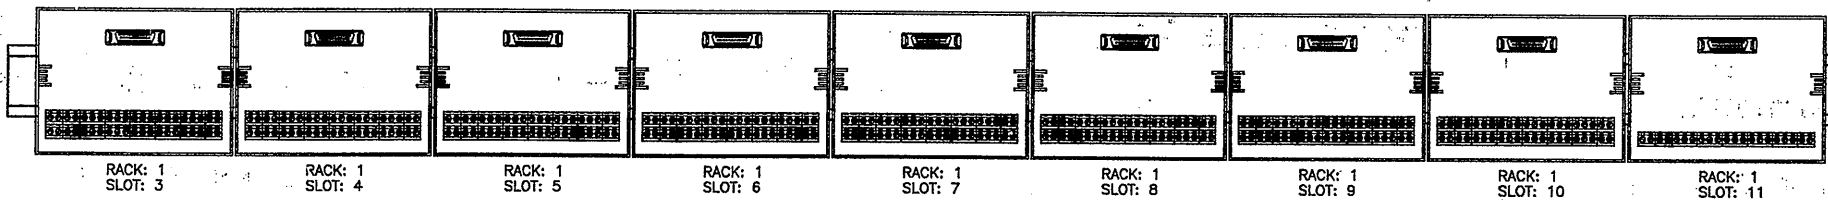

TB4 (24Vdc DI)

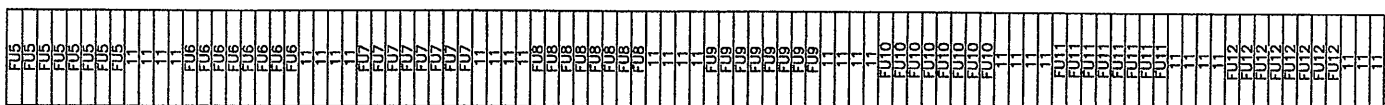

Layer: ON=*; OFF=*REF*
11/27/00 DBG JEC

RECORD DRAWING

THESE DRAWINGS HAVE BEEN REVISIONED TO REFLECT MAKE CHANGES, IF ANY, WHICH OCCURRED DURING CONSTRUCTION. REVISIONS ARE BASED UPON INFORMATION SUPPLIED BY CONTRACTOR.
DATE: 10/21/05 FOR: K. Karpoluk

THIS DRAWING WAS PREPARED AT THE SCALE INDICATED IN THE TITLE BLOCK. INACCURACIES IN THE STATED SCALE MAY BE INTRODUCED WHEN DRAWINGS ARE REPRODUCED BY ANY MEANS. USE THE GRAPHIC SCALE BAR IN THE TITLE BLOCK TO DETERMINE THE ACTUAL SCALE OF THIS DRAWING.

NO ALTERATIONS PERMITTED HEREON EXCEPT AS PROVIDED UNDER SECTION 7209 SUBDIVISION 2 OF THE NEW YORK STATE EDUCATION LAW

| No. | Date | Revisions | Init |
|-----|----------|---------------------|------|
| 0 | 4/20/01 | ISSUED FOR APPROVAL | PLD |
| 1 | 7/11/01 | AS BID | |
| 2 | 10/31/05 | RECORD DRAWING | |

In charge of PLD
Designed by SAT
Drawn by JEC
Checked by PLD

ENVIRONMENTAL ENGINEERING ASSOCIATES, LLP
SYRACUSE, NEW YORK

ONONDAGA COUNTY • DEPARTMENT OF DRAINAGE AND SANITATION • SYRACUSE, NEW YORK
METROPOLITAN SYRACUSE WASTEWATER TREATMENT PLANT
STAGE III AMMONIA AND STAGE II PHOSPHORUS REMOVAL PROJECT
CHEMICAL BUILDING "C" (PLC M16)
TERMINAL BLOCK LAYOUT


INSTRUMENTATION



File Number
00659
Date
APRIL 2001
K. Karpoluk

I-616

8 POINT ANALOG INPUT MODULE
(AB 1746-NIB)

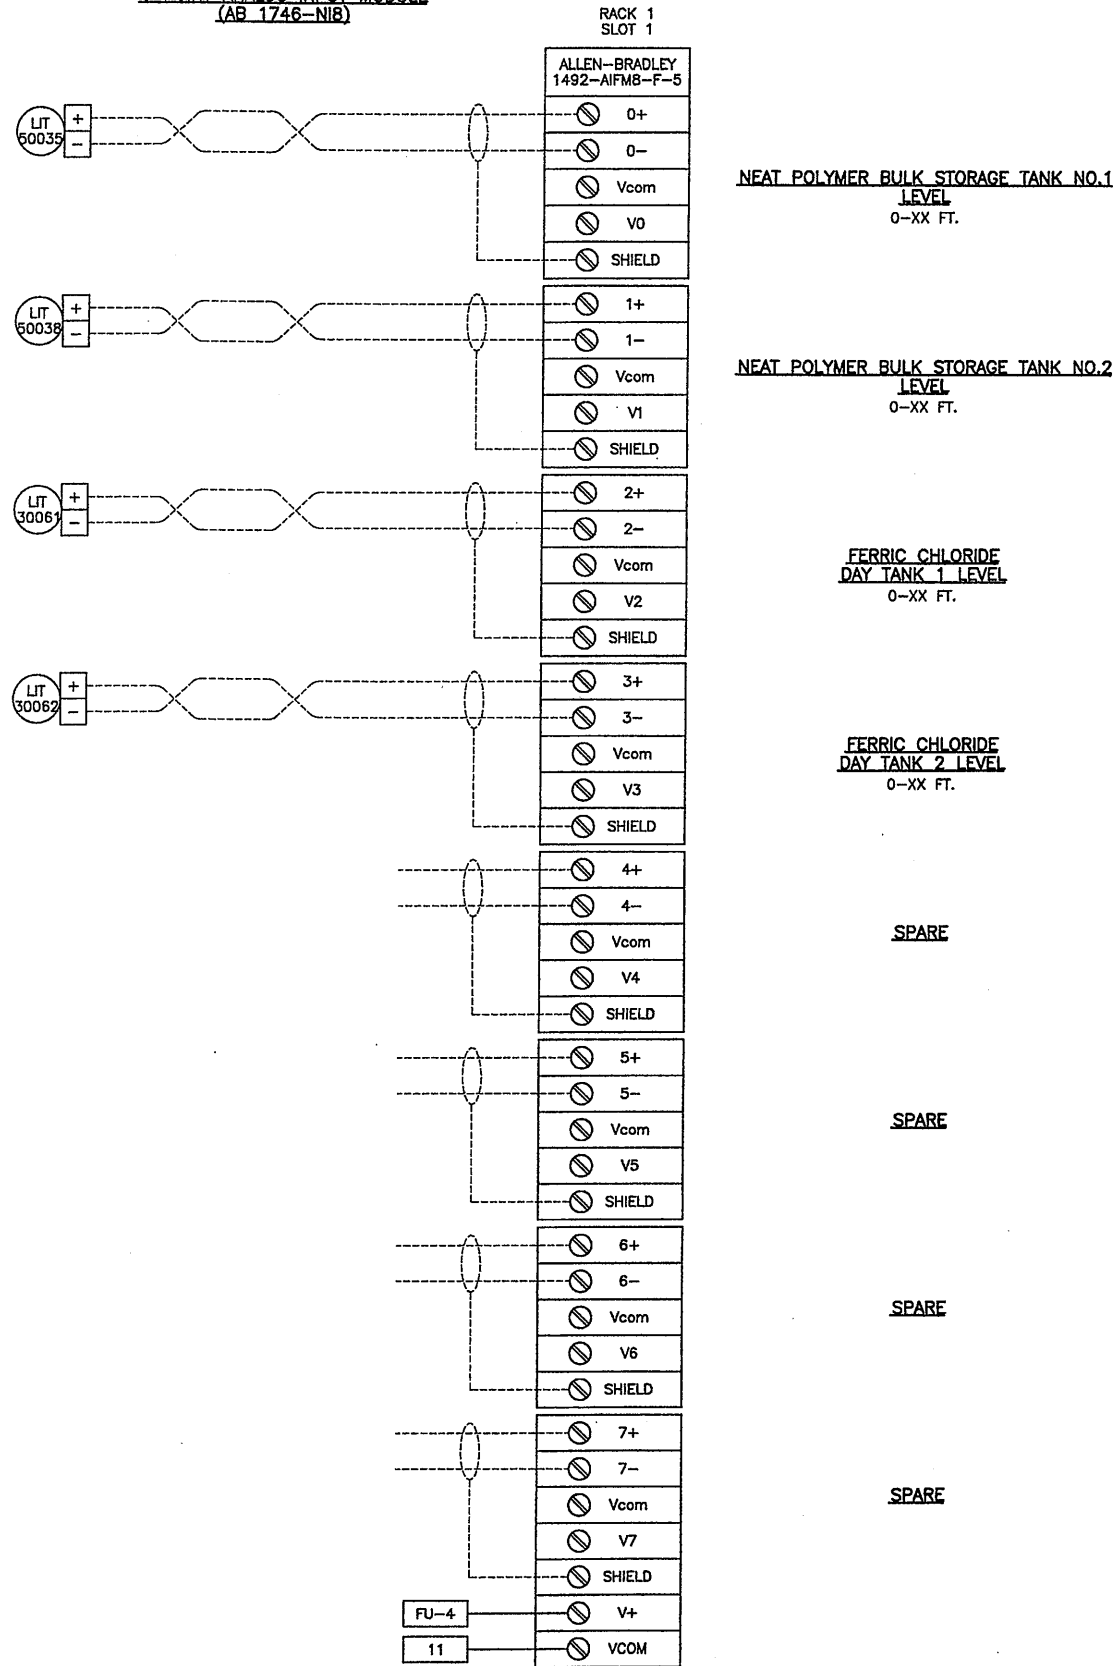

Layer: ON=*; OFF=*REF*

01/09/01 OBG JEC
EEA-VERT

| No. | Date | Revisions | Init |
|-----|----------|---------------------|------|
| 0 | 4/20/01 | ISSUED FOR APPROVAL | JE |
| 1 | 7/11/01 | AS BID | |
| 2 | 10/31/05 | RECORD DRAWING | |

In charge of PLD
Designed by SAT
Drawn by JEC
Checked by PLD

ENVIRONMENTAL ENGINEERING ASSOCIATES, LLP
SYRACUSE, NEW YORK

ONONDAGA COUNTY • DEPARTMENT OF DRAINAGE AND SANITATION • SYRACUSE, NEW YORK
METROPOLITAN SYRACUSE WASTEWATER TREATMENT PLANT
STAGE III AMMONIA AND STAGE II PHOSPHORUS REMOVAL PROJECT
CHEMICAL BUILDING "C" (PLC M16)
ANALOG INPUT MODULES



File Number
00659
Date
APRIL 2001
R. Kampel

I-617


INSTRUMENTATION

RECORD DRAWING

THESE DRAWINGS HAVE BEEN DRAWN TO REFLECT
MAJOR CHANGES, IF ANY, WHICH OCCURRED DURING
CONSTRUCTION. REVISIONS ARE BASED UPON
INFORMATION SUPPLIED BY CONTRACTOR.

DATE: 10/21/05 FOR: *R. Kampel*

THIS DRAWING WAS PREPARED AT THE SCALE INDICATED IN THE
TITLE BLOCK. INACCURACIES IN THE STATED SCALE MAY BE
INTRODUCED WHEN DRAWINGS ARE REPRODUCED BY ANY MEANS.
USE THE GRAPHIC SCALE BAR IN THE TITLE BLOCK TO
DETERMINE THE ACTUAL SCALE OF THIS DRAWING.

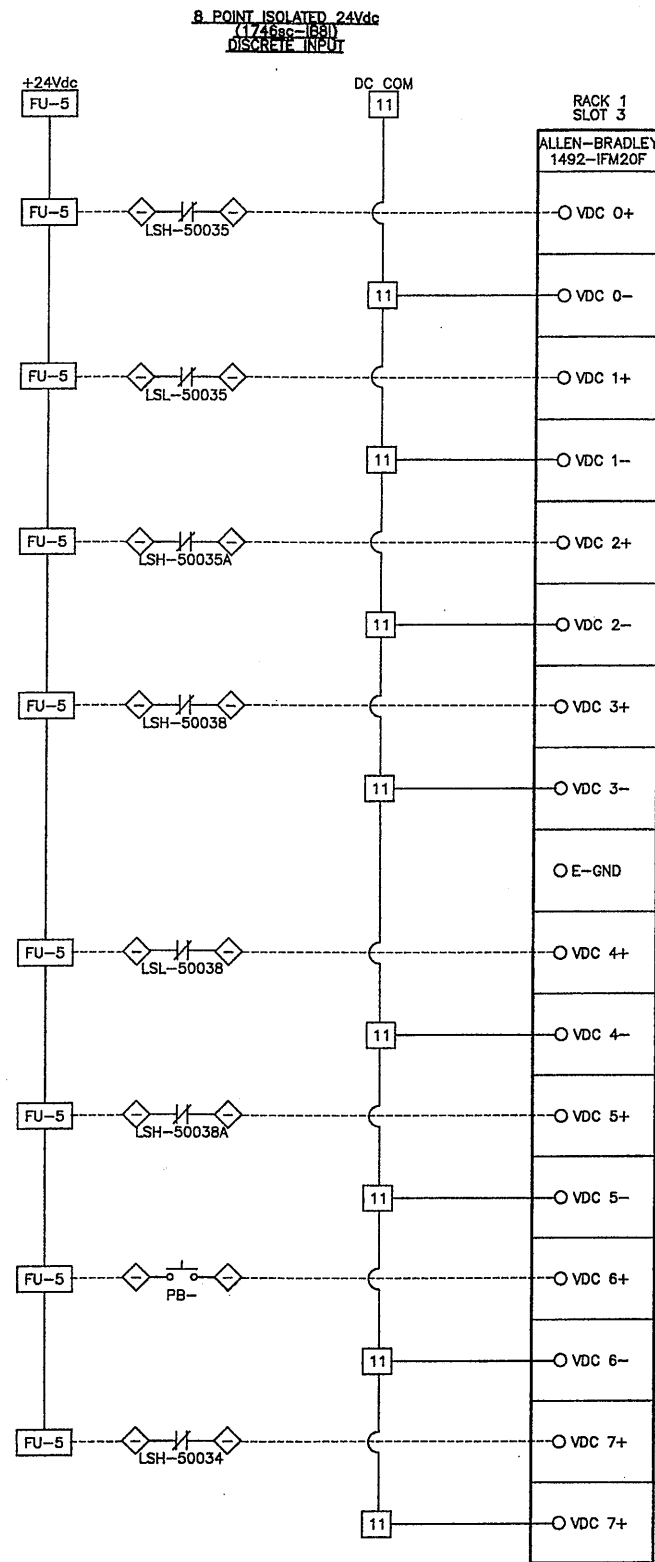

NEAT POLYMER BULK STORAGE TANK NO.1
LEVEL HIGH

NEAT POLYMER BULK STORAGE TANK NO.1
LEVEL LOW

NEAT POLYMER BULK STORAGE TANK NO.1
LEVEL HIGH

NEAT POLYMER BULK STORAGE TANK NO.2
LEVEL HIGH


NEAT POLYMER BULK STORAGE TANK NO.2
LEVEL HIGH

NEAT POLYMER BULK STORAGE TANK NO.2
LEVEL LOW

NEAT POLYMER BULK STORAGE TANK NO.2
LEVEL HIGH

POLYMER STORAGE TANK
FILL PANEL ALARM ACKNOWLEDGE

MIXING/AGING POLYMER TANKS 1 & 2
CONTAINMENT HIGH LEVEL

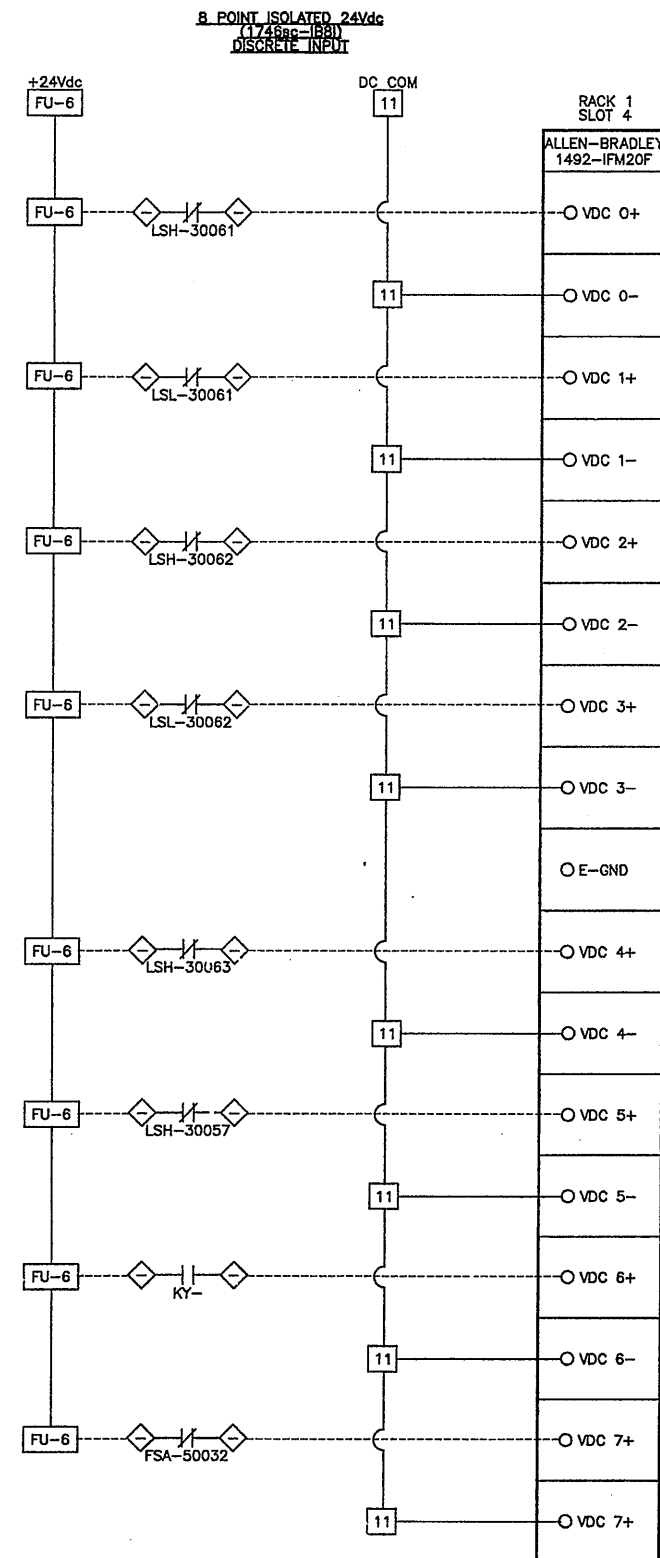

FERRIC CHLORIDE
DAY TANK 1 LEVEL HIGH

FERRIC CHLORIDE
DAY TANK 1 LEVEL LOW

FERRIC CHLORIDE
DAY TANK 2 LEVEL HIGH

FERRIC CHLORIDE
DAY TANK 2 LEVEL LOW

FERRIC CHLORIDE DAY TANKS 1 & 2
CONTAINMENT LEVEL HIGH

FERRIC CHLORIDE FEED PUMPS
CONTAINMENT LEVEL HIGH

KEY BOXED
ACCESSED

EMERGENCY EYEWASH
SHOWER FLOW SWITCH (EAST)


Layer: ON=*, OFF=*REF*
01/12/01 OBG JEC
EEA-VERT

| No. | Date | Revisions | Init |
|-----|----------|---------------------|------|
| 0 | 4/20/01 | ISSUED FOR APPROVAL | JEC |
| 1 | 7/11/01 | ISSUED FOR BID | JEC |
| 2 | 10/31/05 | RECORD DRAWING | PLD |

In charge of --- PLD ---
Designed by --- SAT ---
Drawn by --- JEC ---
Checked by --- PLD ---



ONONDAGA COUNTY • DEPARTMENT OF DRAINAGE AND SANITATION • SYRACUSE, NEW YORK
METROPOLITAN SYRACUSE WASTEWATER TREATMENT PLANT
STAGE III AMMONIA AND STAGE II PHOSPHORUS REMOVAL PROJECT
CHEMICAL BUILDING "C" (PLC M16)
DIGITAL INPUT MODULES

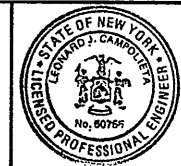

File Number
00659
Date
APRIL 2001


I-618

RECORD DRAWING
THESE CHANGES HAVE BEEN MADE TO REFLECT
FIELD CHANGES, IF ANY, WHICH OCCURRED DURING
CONSTRUCTION. REVISIONS ARE LISTED UPON
INFORMATION SUPPLIED BY CONTRACTOR.
DATE: 10/21/05 BY: JEC/PLD

THIS DRAWING WAS PREPARED AT THE SCALE INDICATED IN THE
TITLE BLOCK. INACCURACIES IN THE STATED SCALE MAY BE
INTRODUCED WHEN DRAWINGS ARE REPRODUCED BY ANY MEANS.
USE THE GRAPHIC SCALE BAR IN THE TITLE BLOCK TO
DETERMINE THE ACTUAL SCALE OF THIS DRAWING.

INSTRUMENTATION

8 POINT ISOLATED 24Vdc
(17489c-188)
DISCRETE INPUT

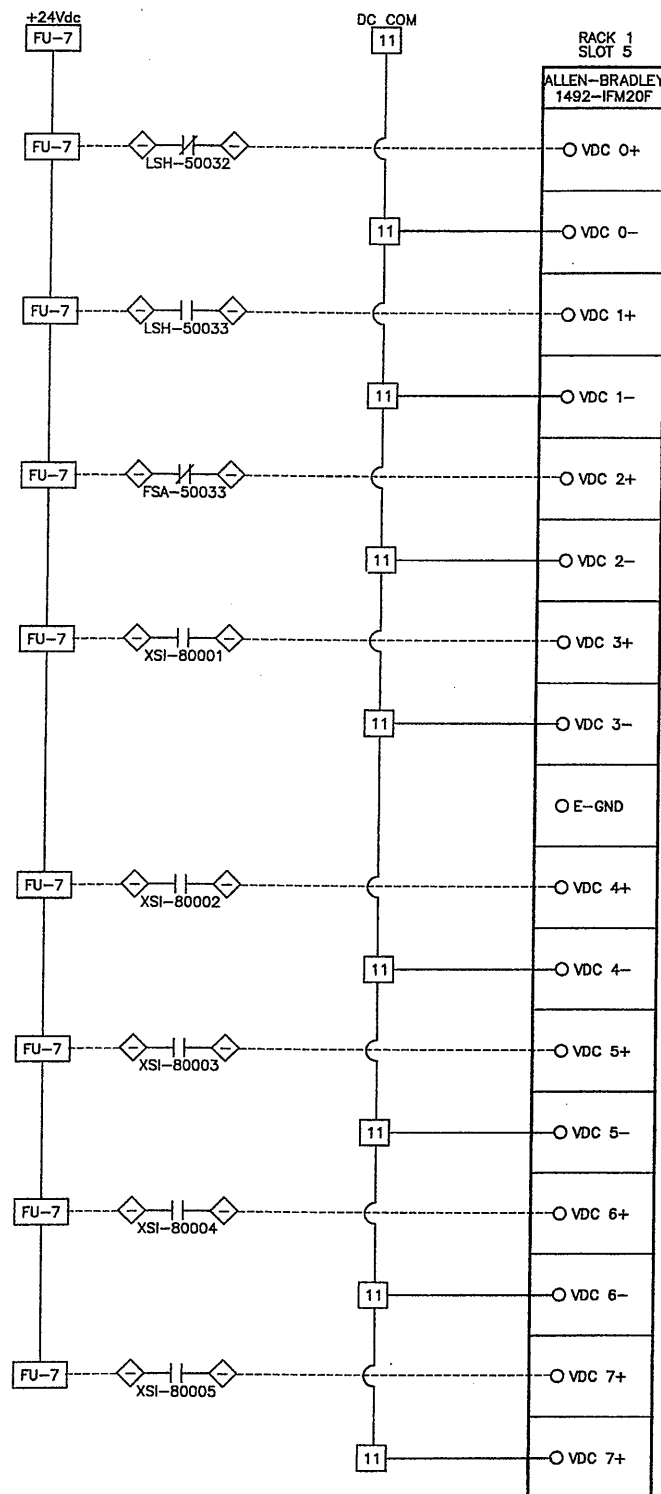


POLYMER PUMPS
SUMP LEVEL HIGH

NEAT POLYMER STORAGE
SUMP LEVEL HIGH

EMERGENCY EYEWASH
SHOWER FLOW SWITCH (WEST)

DDC (HVAC SYSTEM)
STATUS & ALARM POINTS

8 POINT ISOLATED 24Vdc
(17489c-188)
DISCRETE INPUT

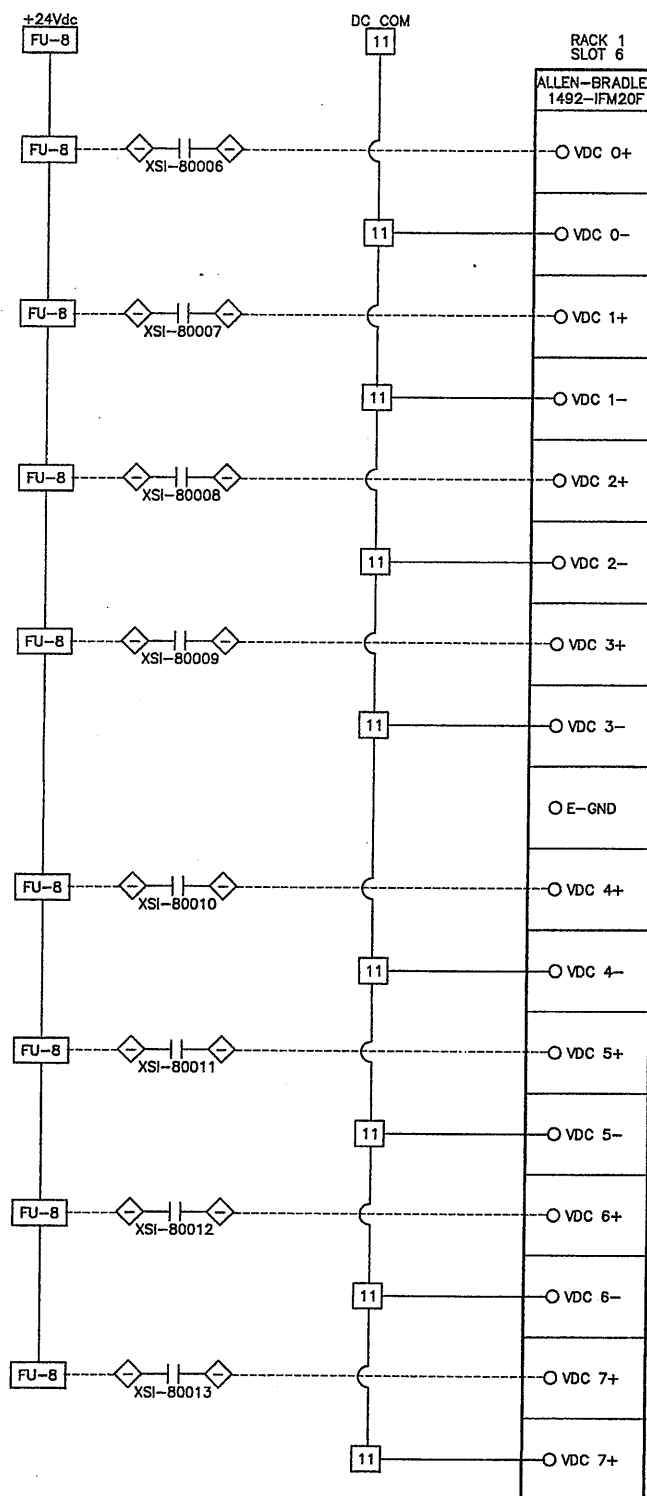

DDC (HVAC SYSTEM)
STATUS & ALARM POINTS


Layer: ON=*; OFF=*REF*
01/12/01 OBG JEC
EEA-VERT

| No. | Date | Revisions | Init |
|-----|----------|---------------------|------|
| 0 | 4/20/01 | ISSUED FOR APPROVAL | LC |
| 1 | 7/11/01 | AS BID | |
| 2 | 10/31/03 | RECORD DRAWING | |

In charge of PLD
Designed by SAT
Drawn by JEC
Checked by PLD

ENVIRONMENTAL ENGINEERING ASSOCIATES, LLP
SYRACUSE, NEW YORK

ONONDAGA COUNTY • DEPARTMENT OF DRAINAGE AND SANITATION • SYRACUSE, NEW YORK
METROPOLITAN SYRACUSE WASTEWATER TREATMENT PLANT
STAGE III AMMONIA AND STAGE II PHOSPHORUS REMOVAL PROJECT
CHEMICAL BUILDING "C" (PLC M16)
DIGITAL INPUT MODULES

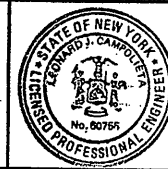

File Number
00659
Date
APRIL 2001



I-619

RECORD DRAWING

THESE CHANGES HAVE BEEN MADE TO REFLECT
MAJOR CHANGES IF ANY, WHICH OCCURRED DURING
CONSTRUCTION. REVISIONS ARE BASED UPON
INFORMATION SUPPLIED BY CONTRACTOR.

DATE 10/21/03 PER *Kampel*

THIS DRAWING WAS PREPARED AT THE SCALE INDICATED IN THE
TITLE BLOCK. INACCURACIES IN THE STATED SCALE MAY BE
INTRODUCED WHEN DRAWINGS ARE REPRODUCED BY ANY MEANS.
USE THE GRAPHIC SCALE BAR IN THE TITLE BLOCK TO
DETERMINE THE ACTUAL SCALE OF THIS DRAWING.

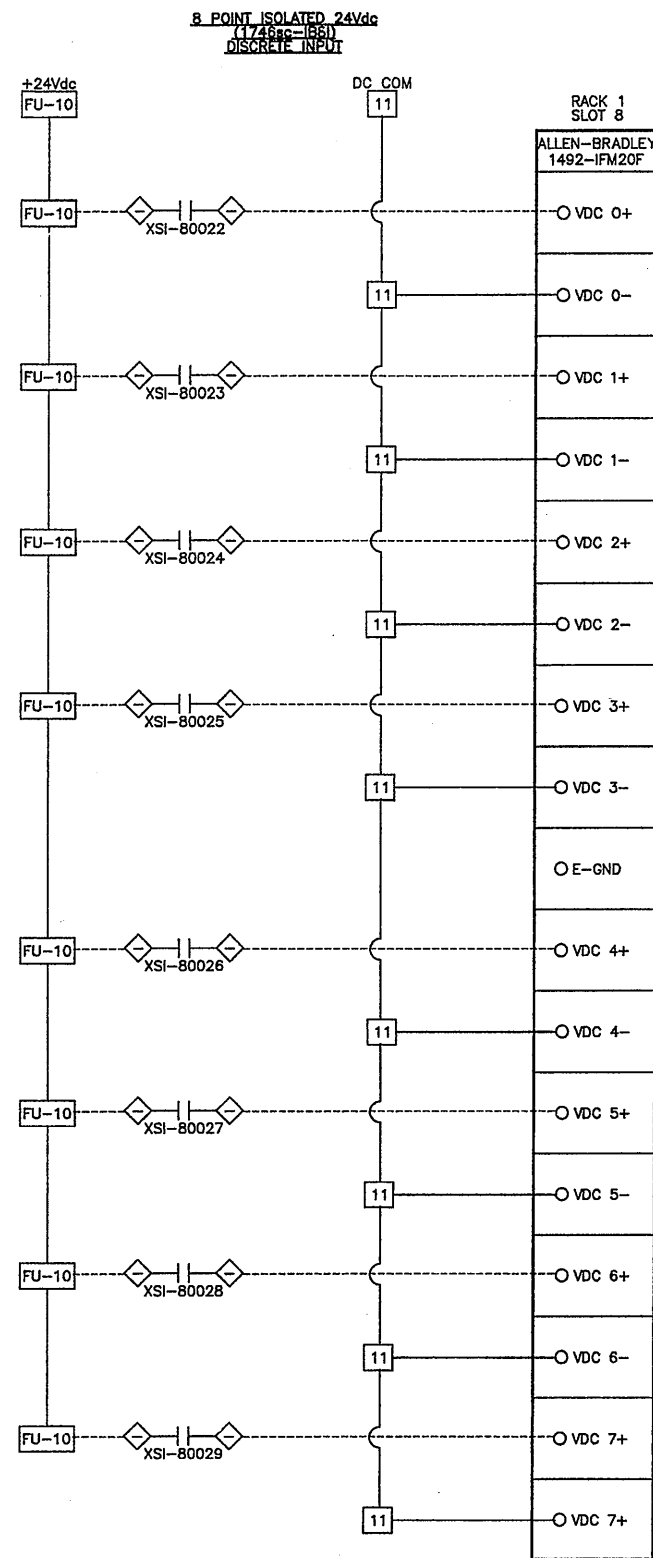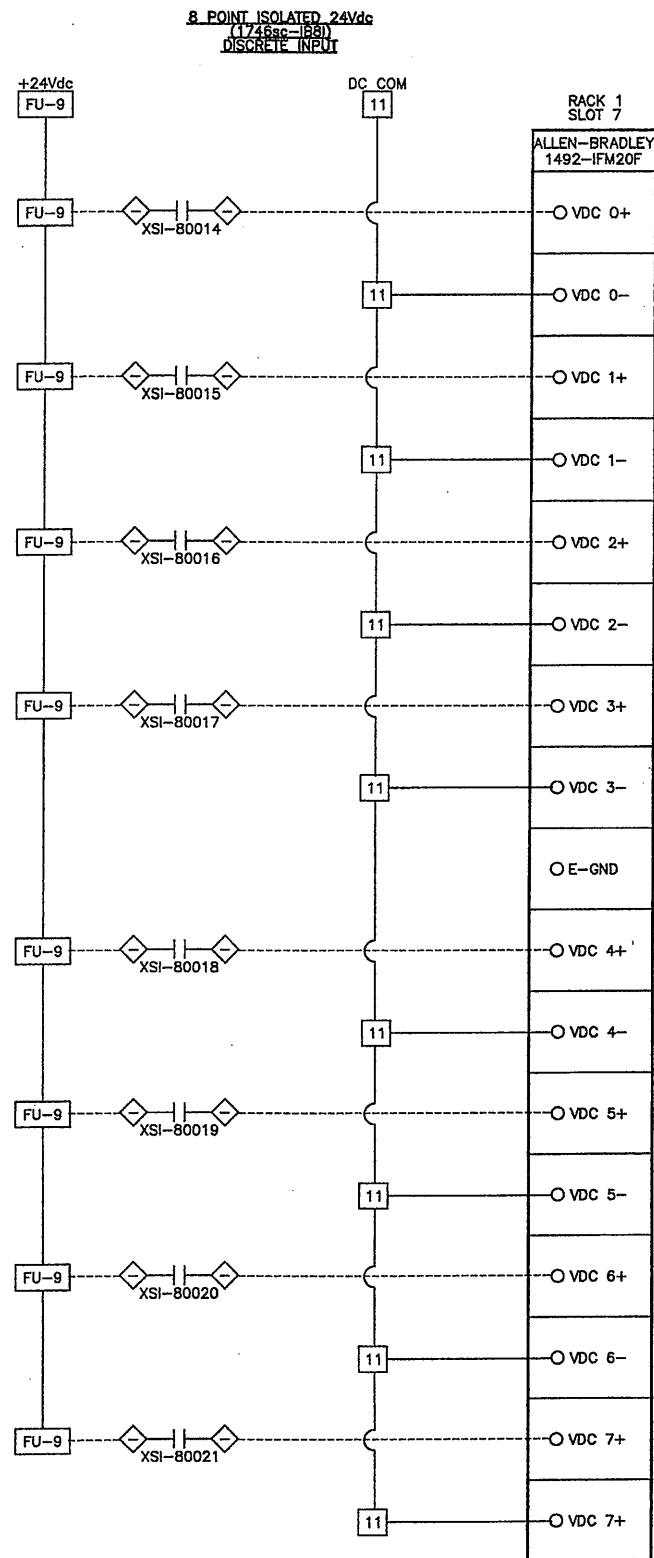

Layer: ON=*; OFF=*REF*
01/12/01 OBG JEC
EEA-VERT

RECORD DRAWING
THESE CHANGES HAVE BEEN REQUIRED TO REFLECT
FIELD CHANGES, IF ANY, WHICH OCCURRED DURING
CONSTRUCTION. REVISIONS ARE BASED UPON
INFORMATION SUPPLIED BY CONTRACTOR.
DATE: 10/21/05 FOR: [Signature]

THIS DRAWING WAS PREPARED AT THE SCALE INDICATED IN THE
TITLE BLOCK. INACCURACIES IN THE STATED SCALE MAY BE
INTRODUCED WHEN DRAWINGS ARE REPRODUCED BY ANY MEANS.
USE THE GRAPHIC SCALE BAR IN THE TITLE BLOCK TO
DETERMINE THE ACTUAL SCALE OF THIS DRAWING.

| No. | Date | Revisions | Init |
|-----|----------|---------------------|-------------|
| 0 | 4/20/01 | ISSUED FOR APPROVAL | [Signature] |
| 1 | 7/11/01 | AS BID | |
| 2 | 10/31/05 | RECORD DRAWING | |

In charge of --- PLD ---
Designed by --- SAT ---
Drawn by --- JEC ---
Checked by --- PLD ---




ONONDAGA COUNTY • DEPARTMENT OF DRAINAGE AND SANITATION • SYRACUSE, NEW YORK
METROPOLITAN SYRACUSE WASTEWATER TREATMENT PLANT
STAGE III AMMONIA AND STAGE II PHOSPHORUS REMOVAL PROJECT
CHEMICAL BUILDING "C" (PLC M16)
DIGITAL INPUT MODULES




File Number
00659
Date
APRIL 2001
[Signature]

I-620

INSTRUMENTATION

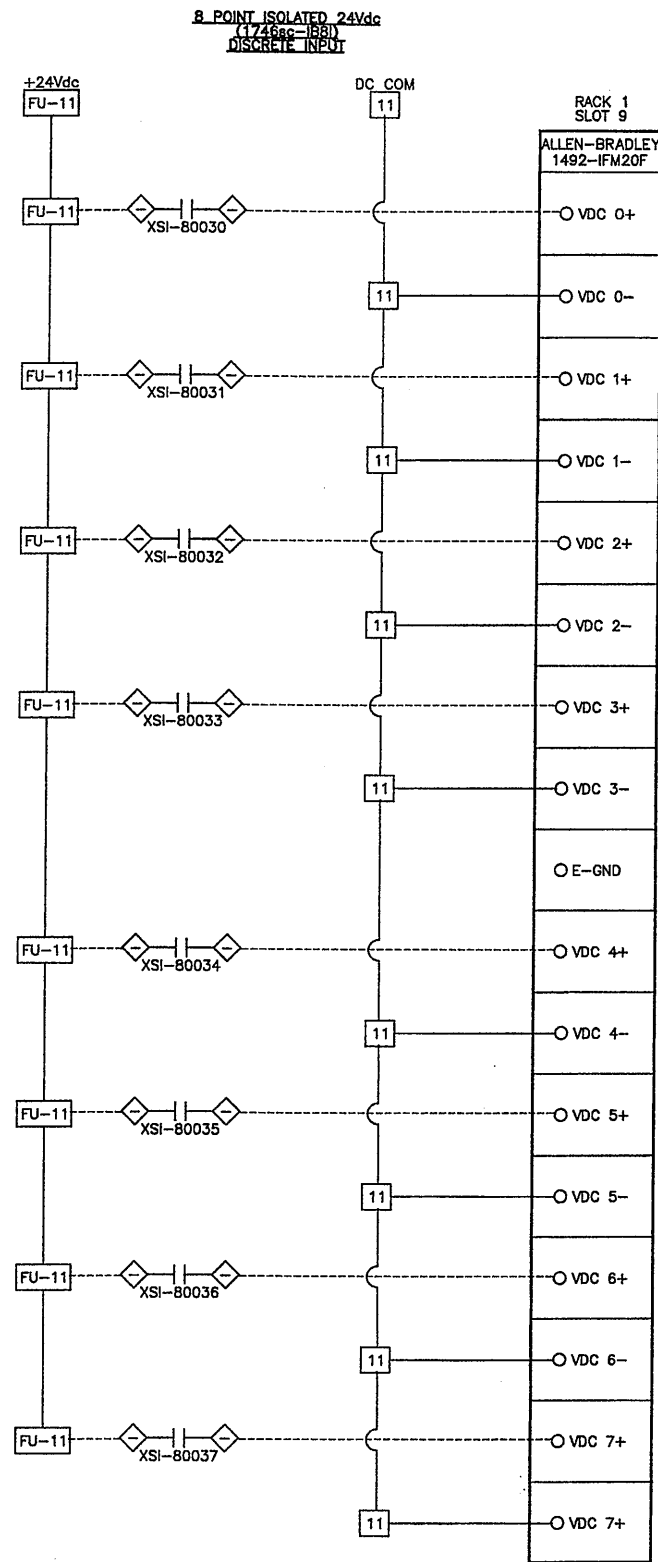

DDC (HVAC SYSTEM)
STATUS & ALARM POINTS

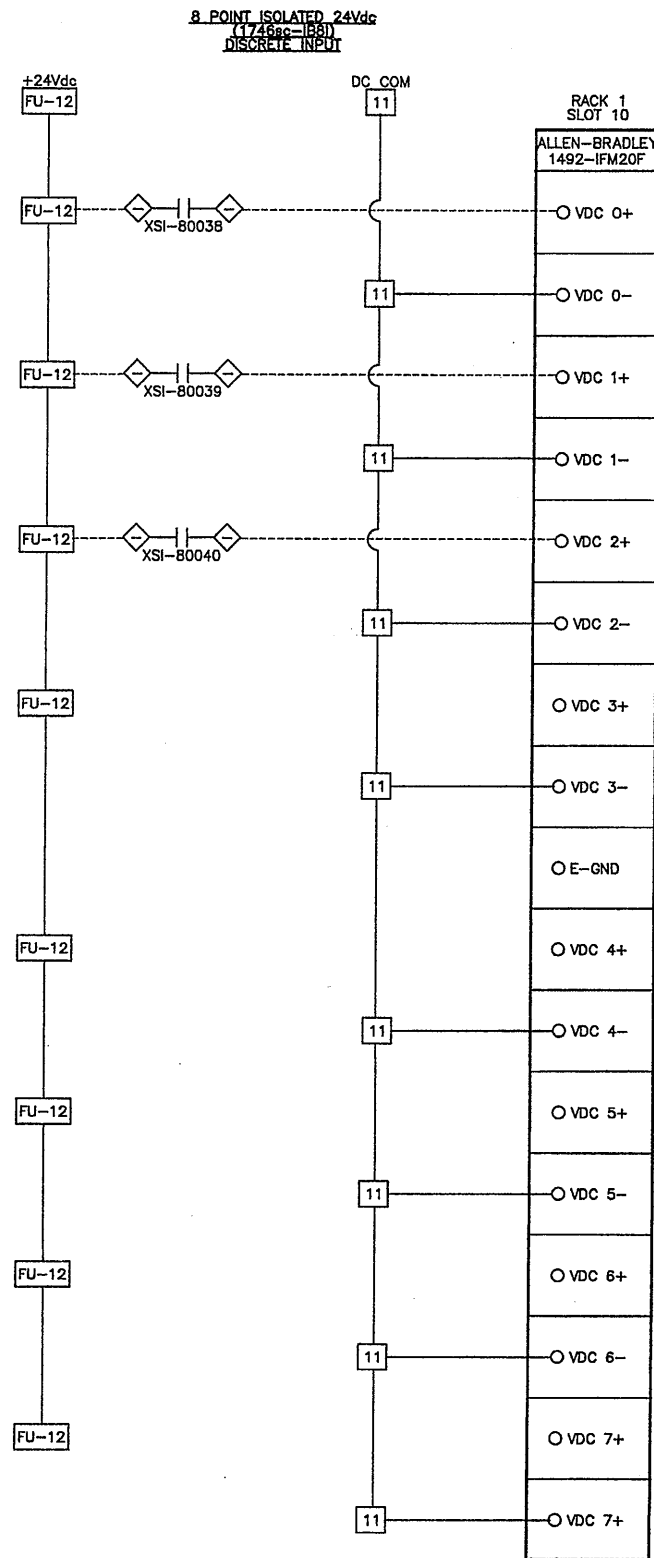

DDC (HVAC SYSTEM)
STATUS & ALARM POINTS

SPARE

SPARE

Layer: ON=*; OFF=*REF*

01/12/01 OBG JEC
EEA-VERT

| No. | Date | Revisions | Init |
|-----|----------|---------------------|------|
| 0 | 4/20/01 | ISSUED FOR APPROVAL | JEC |
| 1 | 7/11/01 | AS BID | |
| 2 | 10/31/05 | RECORD DRAWING | |

In charge of PLD
Designed by SAT
Drawn by JEC
Checked by PLD

ENVIRONMENTAL ENGINEERING ASSOCIATES, LLP
SYRACUSE, NEW YORK

ONONDAGA COUNTY • DEPARTMENT OF DRAINAGE AND SANITATION • SYRACUSE, NEW YORK
METROPOLITAN SYRACUSE WASTEWATER TREATMENT PLANT
STAGE III AMMONIA AND STAGE II PHOSPHORUS REMOVAL PROJECT
CHEMICAL BUILDING "C" (PLC M16)
DIGITAL INPUT MODULES



File Number
00659
Date
APRIL 2001
L. Kampol

I-621

INSTRUMENTATION

RECORD DRAWING


THESE DRAWINGS HAVE BEEN REVIEWED TO REFLECT
MAJOR CHANGES, IF ANY, WHICH OCCURRED DURING
CONSTRUCTION. REVISIONS ARE BASED UPON
INFORMATION SUPPLIED BY CONTRACTORS.

DATE: 10/21/05 FOR: L. Kampol

THIS DRAWING WAS PREPARED AT THE SCALE INDICATED IN THE
TITLE BLOCK. INACCURACIES IN THE STATED SCALE MAY BE
INTRODUCED WHEN DRAWINGS ARE REPRODUCED BY ANY MEANS.
USE THE GRAPHIC SCALE BAR IN THE TITLE BLOCK TO
DETERMINE THE ACTUAL SCALE OF THIS DRAWING.

RACK 2
SLOT 11
ALLEN-BRADLEY
1492-IFM20F-FS-2

8 POINT ISOLATED RELAY OUTPUT
(AB 1746-OX8)

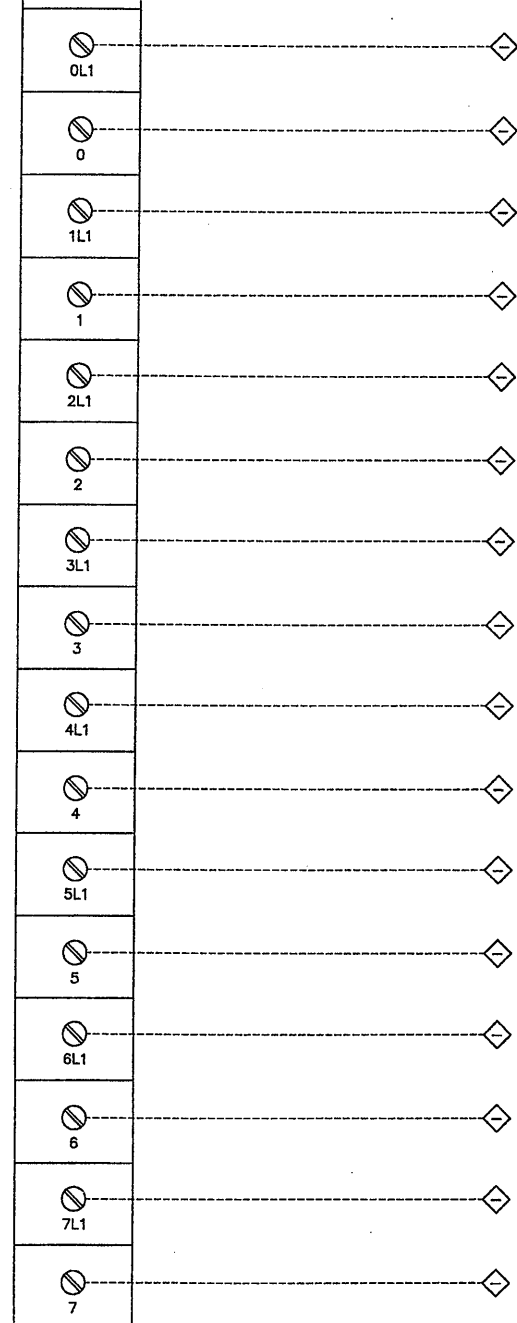

POLYMER BULK STORAGE TANK NO.1
HIGH LEVEL INDICATING LIGHT

POLYMER BULK STORAGE TANK NO.2
HIGH LEVEL INDICATING LIGHT

SPARE

SPARE

SPARE

Layer: ON=*; OFF=*REF*
11/27/00 DBG JEC
EEA-VERT

RECORD DRAWING
THESE CHANGES HAVE BEEN REQUIRED TO REFLECT
MAY BE CHANGED, IF ANY, WHICH OCCURRED DURING
CONSTRUCTION. REVISIONS ARE BASED UPON
INFORMATION SUPPLIED BY CONTRACTOR.
DATE: 10/21/05 PER: *Wampole*


THIS DRAWING WAS PREPARED AT THE SCALE INDICATED IN THE
TITLE BLOCK. INACCURACIES IN THE STATED SCALE MAY BE
INTRODUCED WHEN DRAWINGS ARE REPRODUCED BY ANY MEANS.
USE THE GRAPHIC SCALE BAR IN THE TITLE BLOCK TO
DETERMINE THE ACTUAL SCALE OF THIS DRAWING.

| No. | Date | Revisions | Init |
|-----|----------|---------------------|-----------|
| 0 | 4/20/01 | ISSUED FOR APPROVAL | <i>JK</i> |
| 1 | 7/11/01 | AS BID | |
| 2 | 10/31/05 | RECORD DRAWING | |

In charge of --- PLD
Designed by --- SAT
Drawn by --- JEC
Checked by --- PLD



ONONDAGA COUNTY • DEPARTMENT OF DRAINAGE AND SANITATION • SYRACUSE, NEW YORK
METROPOLITAN SYRACUSE WASTEWATER TREATMENT PLANT
STAGE III AMMONIA AND STAGE II PHOSPHORUS REMOVAL PROJECT
CHEMICAL BUILDING "C" (PLC M16)
DIGITAL OUTPUT MODULE

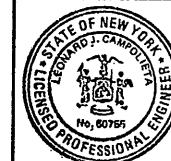

File Number
00659
Date
APRIL 2001
Wampole


1-622

INSTRUMENTATION



NO ALTERATIONS PERMITTED HEREON EXCEPT
AS PROVIDED UNDER SECTION 7209 SUBDIVISION
2 OF THE NEW YORK STATE EDUCATION LAW

NOTES:

- LAYOUT SHOWN IS FOR CONCEPT ONLY. CONTRACTOR SHALL PROVIDE ALL NECESSARY APPURTENANCES REQUIRED FOR A COMPLETE AND OPERATIONAL SYSTEM.
- PANEL SIZE IS APPROXIMATE ONLY. CONTRACTOR SHALL PROVIDE ENCLOSURE SIZE AS REQUIRED FOR EQUIPMENT.

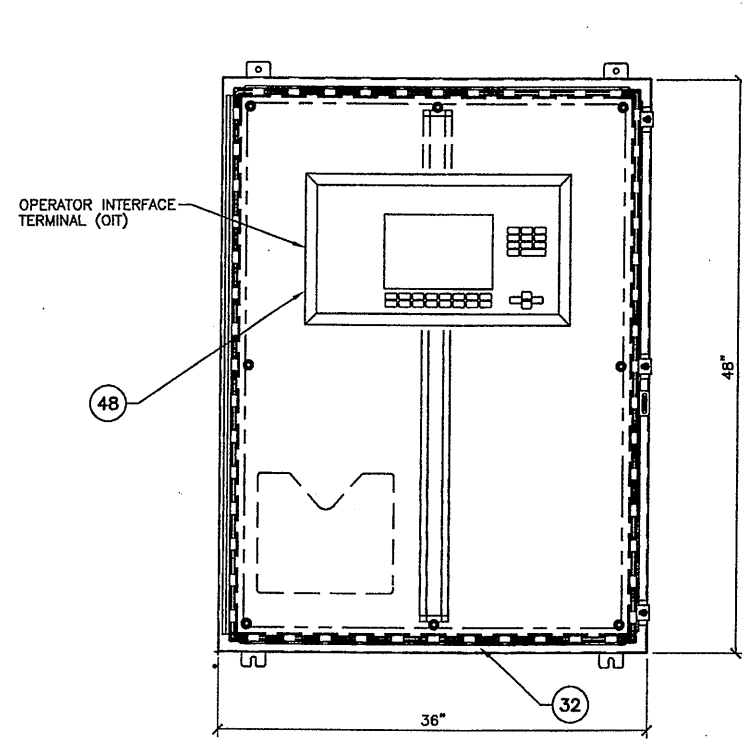


CONTROL PANEL FRONT VIEW

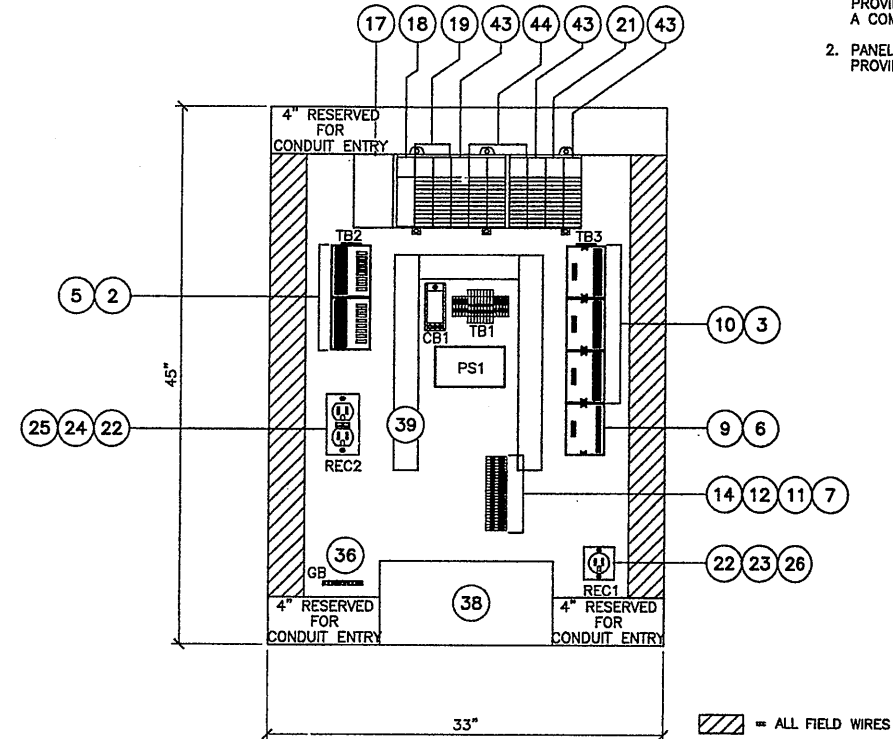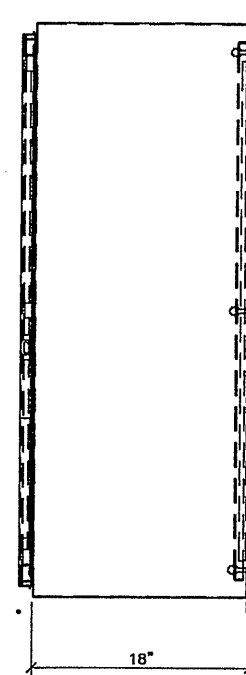

CONTROL PANEL INTERIOR VIEW

CHLORINE BYPASS BLDG. CONTROL PANEL

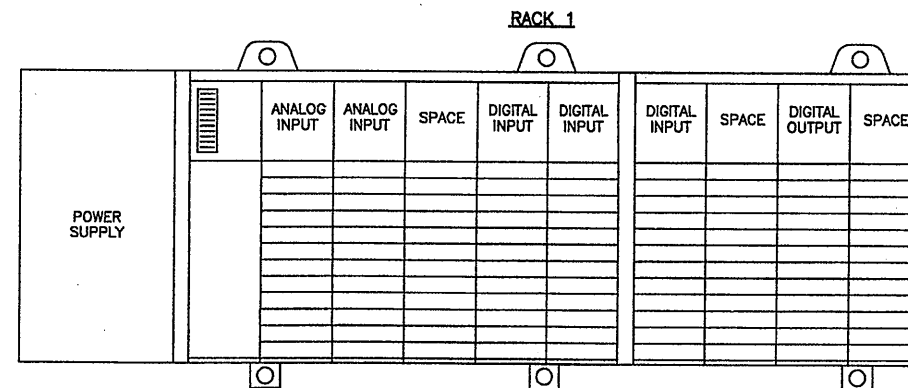

PLC MODULE LAYOUT

RECORD DRAWING

THESE DRAWINGS HAVE BEEN REVIEWED TO REFLECT MAJOR CHANGES, IF ANY, WHICH OCCURRED DURING CONSULTATION. REVISIONS ARE BASED UPON INFORMATION SUPPLIED BY CONTRACTOR.
 DATE: 10/21/01 FOR: [Signature]

THIS DRAWING WAS PREPARED AT THE SCALE INDICATED IN THE TITLE BLOCK. INACCURACIES IN THE STATED SCALE MAY BE INTRODUCED WHEN DRAWINGS ARE REPRODUCED BY ANY MEANS. USE THE GRAPHIC SCALE BAR IN THE TITLE BLOCK TO DETERMINE THE ACTUAL SCALE OF THIS DRAWING.


01/12/01 DBG JEC

| No. | Date | Revisions | Init |
|-----|----------|---------------------|-------------|
| 0 | 4/20/01 | ISSUED FOR APPROVAL | [Signature] |
| 1 | 7/11/01 | AS BID | |
| 2 | 10/31/05 | RECORD DRAWING | |

In charge of **PLD**
 Designed by **SAT**
 Drawn by **JEC**
 Checked by **PLD**

ENVIRONMENTAL ENGINEERING ASSOCIATES, LLP
 SYRACUSE, NEW YORK

ONONDAGA COUNTY • DEPARTMENT OF DRAINAGE AND SANITATION • SYRACUSE, NEW YORK
 METROPOLITAN SYRACUSE WASTEWATER TREATMENT PLANT
 STAGE III AMMONIA AND STAGE II PHOSPHORUS REMOVAL PROJECT
CHLORINE BYPASS BLDG. (PLC M20D)
CONTROL PANEL LAYOUT

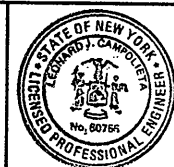


File Number
00659
 Date
APRIL 2001

1-623

NO ALTERATIONS PERMITTED HEREON EXCEPT AS PROVIDED UNDER SECTION 7209 SUBDIVISION 2 OF THE NEW YORK STATE EDUCATION LAW

INSTRUMENTATION

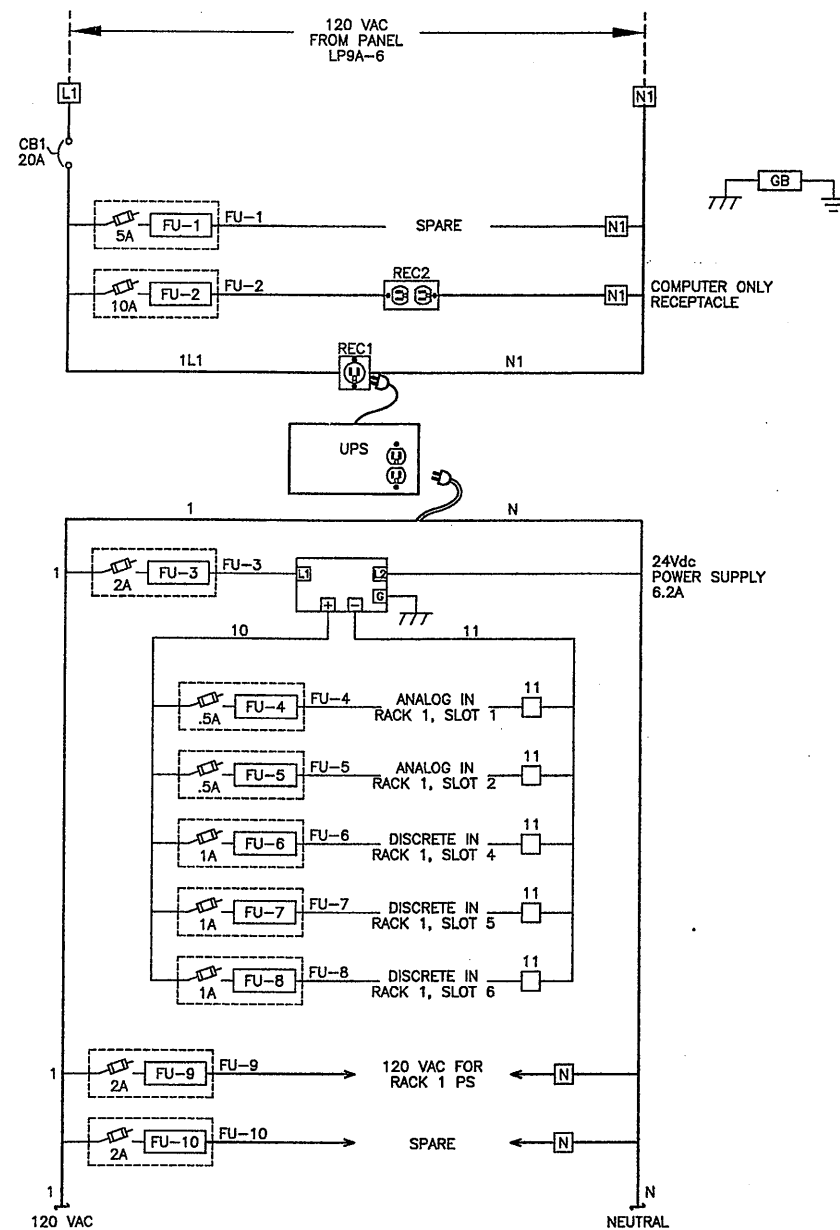

| BILL OF MATERIALS | | | | |
|-------------------|----------|--------------------|---------------|--|
| SYMBOL | QUANTITY | MODEL NUMBER | MANUFACTURER | DESCRIPTION |
| 1 | | | | |
| 2 | A/R | SEE SPECIFICATIONS | Allen-Bradley | Analog Input Interface Module |
| 3 | A/R | SEE SPECIFICATIONS | Allen-Bradley | Digital Input Interface Cable - 1 meter |
| 4 | | | | |
| 5 | A/R | SEE SPECIFICATIONS | Allen-Bradley | Analog Input Interface Cable - 1 meter |
| 6 | A/R | SEE SPECIFICATIONS | Allen-Bradley | Relay Output Interface Cable - 0.5 meter |
| 7 | A/R | SEE SPECIFICATIONS | Allen-Bradley | High Density Terminal Block |
| 8 | A/R | SEE SPECIFICATIONS | Allen-Bradley | Fusible Switch |
| 9 | A/R | SEE SPECIFICATIONS | Allen-Bradley | Relay Output Interface Module |
| 10 | A/R | SEE SPECIFICATIONS | Allen-Bradley | Digital Input Interface Module |
| 11 | A/R | SEE SPECIFICATIONS | Allen-Bradley | End Anchor |
| 12 | A/R | SEE SPECIFICATIONS | Allen-Bradley | High Density Terminal Block End Barrier |
| 13 | A/R | SEE SPECIFICATIONS | Allen-Bradley | Fusible Switch End Barrier |
| 14 | A/R | SEE SPECIFICATIONS | Allen-Bradley | High Density Jumper |
| 15 | | | | |
| 16 | A/R | SEE SPECIFICATIONS | Allen-Bradley | 13 Slot I/O Chassis |
| 17 | A/R | SEE SPECIFICATIONS | Allen-Bradley | I/O Chassis Power Supply |
| 18 | A/R | SEE SPECIFICATIONS | Allen-Bradley | Remote I/O Adapter |
| 19 | A/R | SEE SPECIFICATIONS | Allen-Bradley | Analog Input - 8 point |
| 20 | | | | |
| 21 | A/R | SEE SPECIFICATIONS | Allen-Bradley | Relay Output - 8 point |
| 22 | A/R | SEE SPECIFICATIONS | RACO | Box |
| 23 | A/R | SEE SPECIFICATIONS | RACO | Cover - single 15 amp |
| 24 | A/R | SEE SPECIFICATIONS | RACO | Cover - duplex 15 amp |
| 25 | A/R | SEE SPECIFICATIONS | Hubbell | 15A Duplex receptacle |
| 26 | A/R | SEE SPECIFICATIONS | Hubbell | 15A Single receptacle |
| 27 | | | | |
| 28 | | | | |
| 29 | | | | |
| 30 | | | | |
| 31 | | | | |
| 32 | A/R | SEE SPECIFICATIONS | Hoffman | Nema 12 Enclosure |
| 33 | A/R | SEE SPECIFICATIONS | Hoffman | Sub-Panel |
| 34 | A/R | SEE SPECIFICATIONS | Panduit | 3"W x 3"D Slotted Wiring Duct |
| 35 | A/R | SEE SPECIFICATIONS | Panduit | 2"W x 3"D Slotted Wiring Duct |
| 36 | A/R | SEE SPECIFICATIONS | Square D | Ground Bar |
| 37 | A/R | SEE SPECIFICATIONS | Allen-Bradley | 20 amp Circuit Breaker, single pole |
| 38 | A/R | SEE SPECIFICATIONS | Best Power | Uninterruptible Power Supply |
| 39 | A/R | SEE SPECIFICATIONS | Power One | DC Power Supply 24 Vdc Output |
| 40 | A/R | SEE SPECIFICATIONS | TBD | Fuses |
| 41 | | | | |
| 42 | A/R | SEE SPECIFICATIONS | - | - |
| 43 | A/R | SEE SPECIFICATIONS | Allen-Bradley | Blank Slot Filler Module |
| 44 | A/R | SEE SPECIFICATIONS | Allen-Bradley | Discrete Input - 8 point |
| 45 | | | | |
| 46 | | | | |
| 47 | | | | |
| 48 | A/R | SEE SPECIFICATIONS | Allen-Bradley | Operator Interface Terminal (OIT) |


Layer: ON=*, OFF=REF*
07/17/00 OBG JEC

| No. | Date | Revisions | Init |
|-----|----------|---------------------|------|
| 0 | 4/20/01 | ISSUED FOR APPROVAL | PLD |
| 1 | 7/11/01 | AS BID | SAT |
| 2 | 10/31/03 | RECORD DRAWING | JEC |

In charge of PLD
Designed by SAT
Drawn by JEC
Checked by PLD



ONONDAGA COUNTY • DEPARTMENT OF DRAINAGE AND SANITATION • SYRACUSE, NEW YORK
METROPOLITAN SYRACUSE WASTEWATER TREATMENT PLANT
STAGE III AMMONIA AND STAGE II PHOSPHORUS REMOVAL PROJECT
CHLORINE BYPASS BLDG. (PLC M20D)
CONTROL CIRCUIT WIRING

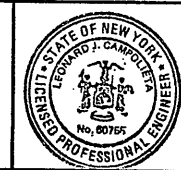

File Number
00659
Date
APRIL 2001
Kampel

I-624


RECORD DRAWING
THESE CHANGES HAVE BEEN MADE TO REFLECT
WORK CHANGES, IF ANY, WHICH OCCURRED DURING
CONSTRUCTION. REVISIONS ARE BASED UPON
INFORMATION SUPPLIED BY CONTRACTOR.
DATE 10/21/05 PER J. Kampel

THIS DRAWING WAS PREPARED AT THE SCALE INDICATED IN THE
TITLE BLOCK. INACCURACIES IN THE STATED SCALE MAY BE
INTRODUCED WHEN DRAWINGS ARE REPRODUCED BY ANY MEANS.
USE THE GRAPHIC SCALE BAR IN THE TITLE BLOCK TO
DETERMINE THE ACTUAL SCALE OF THIS DRAWING.


NO ALTERATIONS PERMITTED HEREON EXCEPT
AS PROVIDED UNDER SECTION 7209 SUBDIVISION
2 OF THE NEW YORK STATE EDUCATION LAW

INSTRUMENTATION


TB1

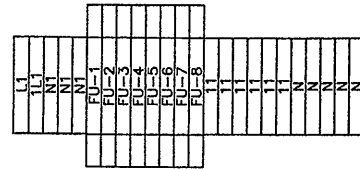


TB2 (ANALOG)

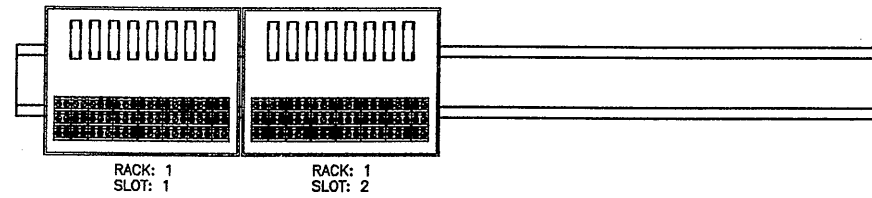

TB3 (DIGITAL)

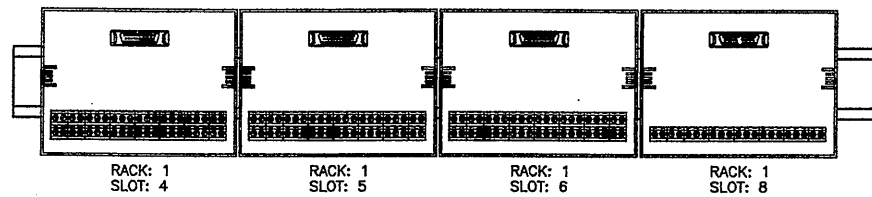

TB4 (24Vdc DI)

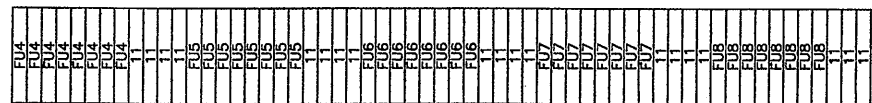

Layer: ON=*, OFF=*REF*
11/27/00 OBG JEC

RECORD DRAWING

THESE DRAWINGS HAVE BEEN REVISIONED TO REFLECT
MAJOR CHANGES, IF ANY, WHICH OCCURRED DURING
CONSTRUCTION. REVISIONS ARE BASED UPON
INFORMATION SUPPLIED BY CONTRACTOR.

DATE: 10/21/05 FOR: Klamahet

THIS DRAWING WAS PREPARED AT THE SCALE INDICATED IN THE
TITLE BLOCK. INACCURACIES IN THE STATED SCALE MAY BE
INTRODUCED WHEN DRAWINGS ARE REPRODUCED BY ANY MEANS.
USE THE GRAPHIC SCALE BAR IN THE TITLE BLOCK TO
DETERMINE THE ACTUAL SCALE OF THIS DRAWING.


NO ALTERATIONS PERMITTED HEREON EXCEPT
AS PROVIDED UNDER SECTION 7209 SUBDIVISION
2 OF THE NEW YORK STATE EDUCATION LAW

| No. | Date | Revisions | Init |
|-----|----------|---------------------|------|
| 0 | 4/20/01 | ISSUED FOR APPROVAL | PLD |
| 1 | 7/11/01 | AS BID | |
| 2 | 10/31/05 | RECORD DRAWING | |

In charge of --- PLD ---
Designed by --- SAT ---
Drawn by --- JEC ---
Checked by --- PLD ---

ENVIRONMENTAL ENGINEERING ASSOCIATES, LLP
SYRACUSE, NEW YORK


ONONDAGA COUNTY • DEPARTMENT OF DRAINAGE AND SANITATION • SYRACUSE, NEW YORK
METROPOLITAN SYRACUSE WASTEWATER TREATMENT PLANT
STAGE III AMMONIA AND STAGE II PHOSPHORUS REMOVAL PROJECT
CHLORINE BYPASS BLDG. (PLC M20D)
TERMINAL BLOCK LAYOUT

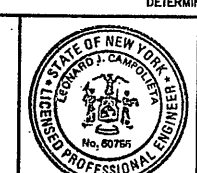

File Number
00659
Date
APRIL 2001
Klamahet

1-625

8 POINT ANALOG INPUT MODULE
(AB 1746-N18)

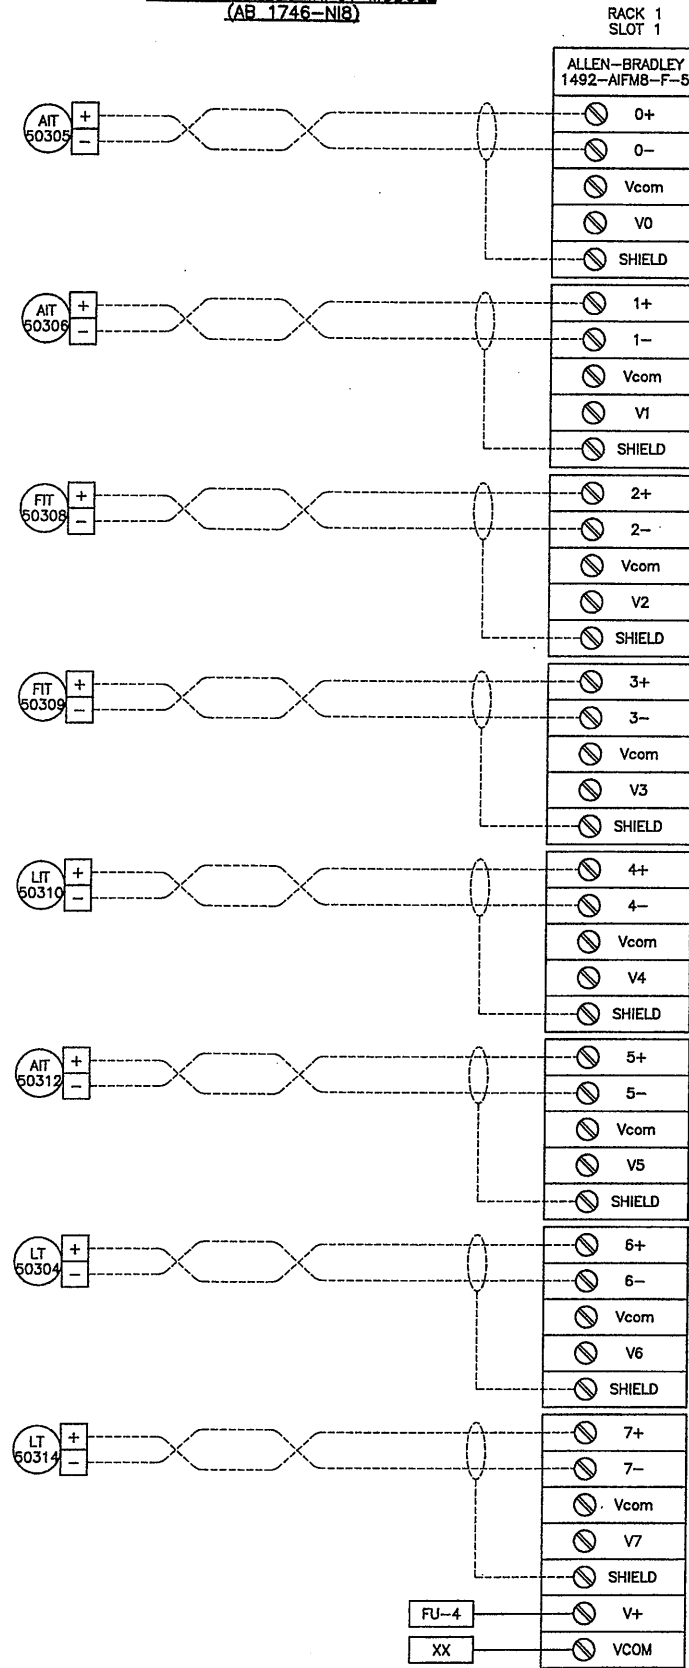

CHLORINE CONTACT TANK
ORP DISINFECTION

CHLORINE CONTACT TANK
RESIDUAL

BYPASS
CHLORINE CONTACT TANK NO.1
FLOW
0-XXX GPD

BYPASS
CHLORINE CONTACT TANK NO.2
FLOW
0-XXX GPD


BYPASS
CHLORINE CONTACT TANK NO.1
LEVEL
0-XX FT.

CHLORINE CONTACT TANK
72" OUTFALL
ORP

CHLORINE CONTACT TANK
72" INFLUENT
LEVEL

BYPASS
CHLORINE CONTACT TANK
72" EFFLUENT
LEVEL

8 POINT ANALOG INPUT MODULE
(AB 1746-N18)

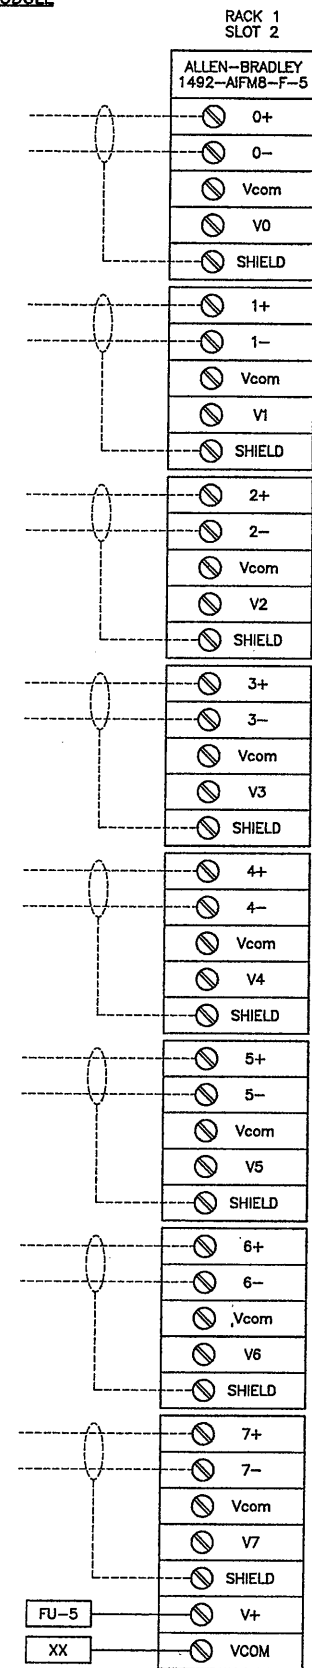

SPARE

SPARE

Layer: ON=*, OFF=*REF*
01/09/01 OBG JEC
EEA-VERT

| No. | Date | Revisions | Init |
|-----|----------|---------------------|------|
| 0 | 4/20/01 | ISSUED FOR APPROVAL | PLD |
| 1 | 7/11/01 | AS BID | |
| 2 | 10/31/05 | RECORD DRAWING | |

In charge of PLD
Designed by SAT
Drawn by JEC
Checked by PLD



ONONDAGA COUNTY • DEPARTMENT OF DRAINAGE AND SANITATION • SYRACUSE, NEW YORK
METROPOLITAN SYRACUSE WASTEWATER TREATMENT PLANT
STAGE III AMMONIA AND STAGE II PHOSPHORUS REMOVAL PROJECT
CHLORINE BYPASS BLDG. (PLC M20D)
ANALOG INPUT MODULES

INSTRUMENTATION




File Number
00659
Date
APRIL 2001
Kampker

1-626

RECORD DRAWING
THESE DRAWINGS HAVE BEEN REVISED TO REFLECT
MAJOR CHANGES, IF ANY, WHICH OCCURRED DURING
CONSTRUCTION. REVISIONS ARE BASED UPON
INFORMATION SUPPLIED BY CONTRACTOR.
DATE 10/21/05 FOR *Kampker*
THIS DRAWING WAS PREPARED AT THE SCALE INDICATED IN THE
TITLE BLOCK. INACCURACIES IN THE STATED SCALE MAY BE
INTRODUCED WHEN DRAWINGS ARE REPRODUCED BY ANY MEANS.
USE THE GRAPHIC SCALE BAR IN THE TITLE BLOCK TO
DETERMINE THE ACTUAL SCALE OF THIS DRAWING.

NO ALTERATIONS PERMITTED HEREON EXCEPT
AS PROVIDED UNDER SECTION 7209 SUBDIVISION
2 OF THE NEW YORK STATE EDUCATION LAW

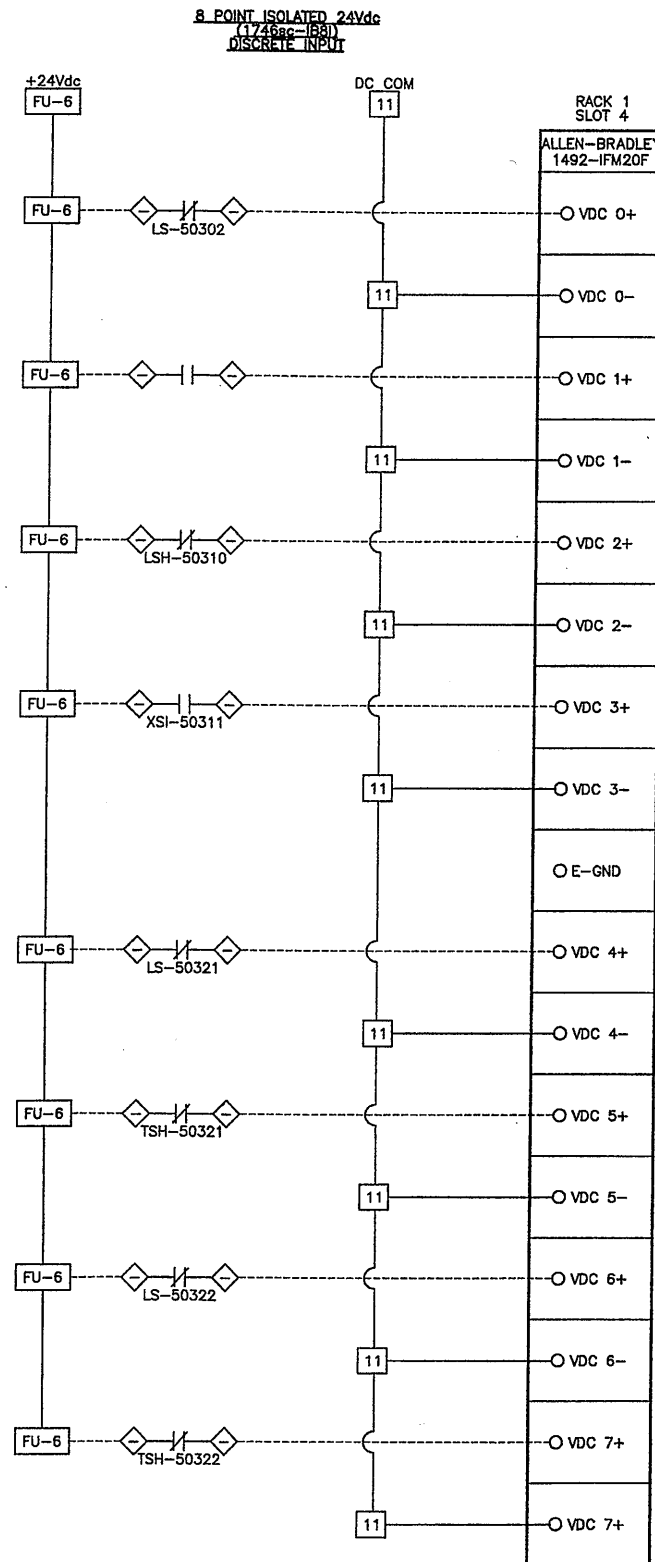

DISTRIBUTION STRUCTURE "B"
WALL LEAK (BISULFITE)

BYPASS
CHLORINE CONTACT TANK 1
LEVEL HIGH


SUBMERSIBLE
INDUCTOR/MIXER RUNNING

BYPASS CHLORINE CONTACT TANK
MIXER NO.1
LEAK SENSOR

BYPASS CHLORINE CONTACT TANK
MIXER NO.1
TEMPERATURE HIGH

BYPASS CHLORINE CONTACT TANK
MIXER NO.2
LEAK SENSOR

BYPASS CHLORINE CONTACT TANK
MIXER NO.2
TEMPERATURE HIGH

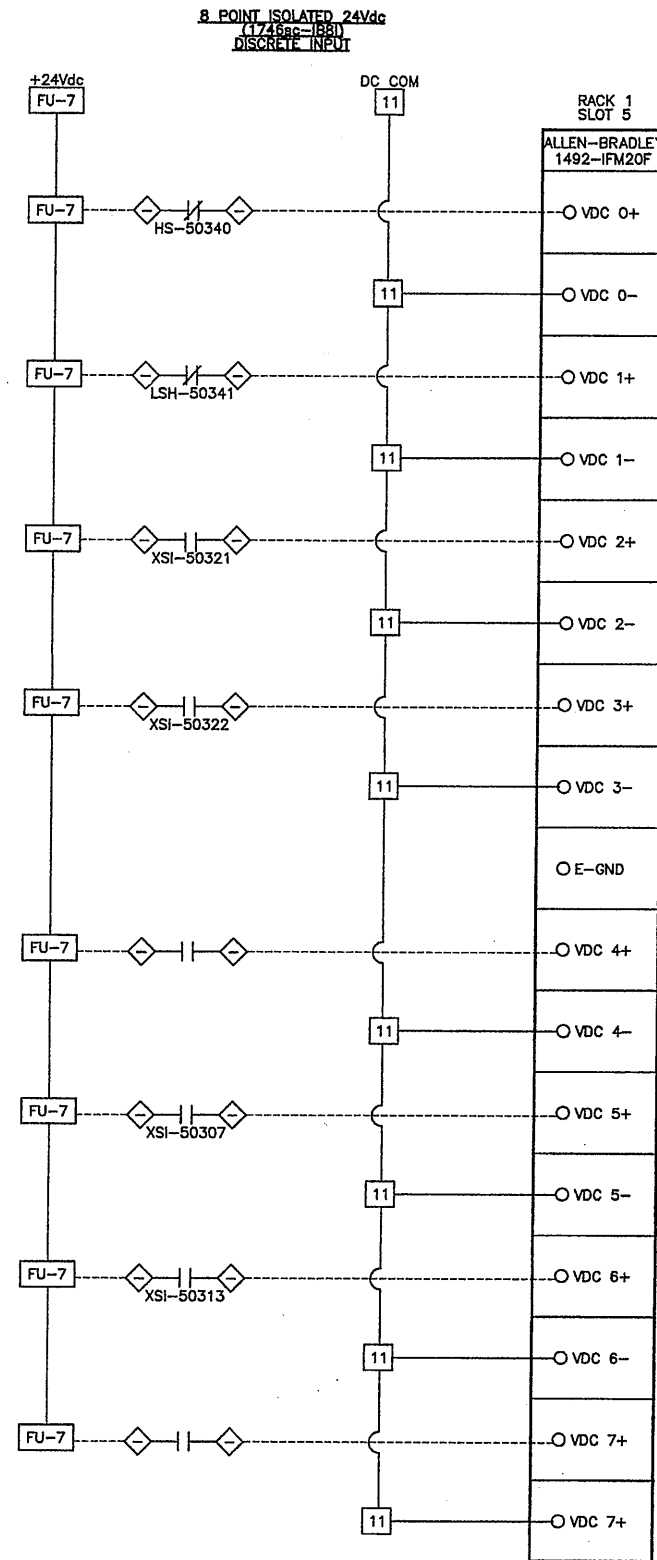

BYPASS CHLORINE CONTACT TANK #2
DEWATERING PUMP #1
AUTO

BYPASS CHLORINE CONTACT TANK #2
DEWATERING
LEVEL HIGH

BYPASS CHLORINE CONTACT TANK
MIXER NO.1
RUNNING

BYPASS CHLORINE CONTACT TANK
MIXER NO.2
RUNNING

BYPASS
CHLORINE CONTACT TANK
SAMPLE PUMP 1 RUNNING

BYPASS
CHLORINE CONTACT TANK
SAMPLE PUMP 2 RUNNING

Layer: ON=*; OFF=*REF*
01/12/01 DBG JEC
EEA-VERT

| No. | Date | Revisions | Init |
|-----|----------|---------------------|------|
| 0 | 4/20/01 | ISSUED FOR APPROVAL | PLD |
| 1 | 7/11/01 | AS BID | JEC |
| 2 | 10/31/05 | RECORD DRAWING | PLD |

In charge of PLD
Designed by SAT
Drawn by JEC
Checked by PLD

ENVIRONMENTAL ENGINEERING ASSOCIATES, LLP
SYRACUSE, NEW YORK

ONONDAGA COUNTY • DEPARTMENT OF DRAINAGE AND SANITATION • SYRACUSE, NEW YORK
METROPOLITAN SYRACUSE WASTEWATER TREATMENT PLANT
STAGE III AMMONIA AND STAGE II PHOSPHORUS REMOVAL PROJECT
CHLORINE BYPASS BLDG. (PLC M20D)
DIGITAL INPUT MODULES




File Number
00659
Date
APRIL 2001
L. Campolita

1-627

INSTRUMENTATION

RECORD DRAWING
THESE DRAWINGS HAVE BEEN REVISIONED TO REFLECT
MAJOR CHANGES, IF ANY, WHICH OCCURRED DURING
CONSTRUCTION. REVISIONS ARE BASED UPON
INFORMATION SUPPLIED BY CONTRACTOR.
DATE: 10/21/05 PER: L. Campolita

THIS DRAWING WAS PREPARED AT THE SCALE INDICATED IN THE
TITLE BLOCK. INACCURACIES IN THE STATED SCALE MAY BE
INTRODUCED WHEN DRAWINGS ARE REPRODUCED BY ANY MEANS.
USE THE GRAPHIC SCALE BAR IN THE TITLE BLOCK TO
DETERMINE THE ACTUAL SCALE OF THIS DRAWING.

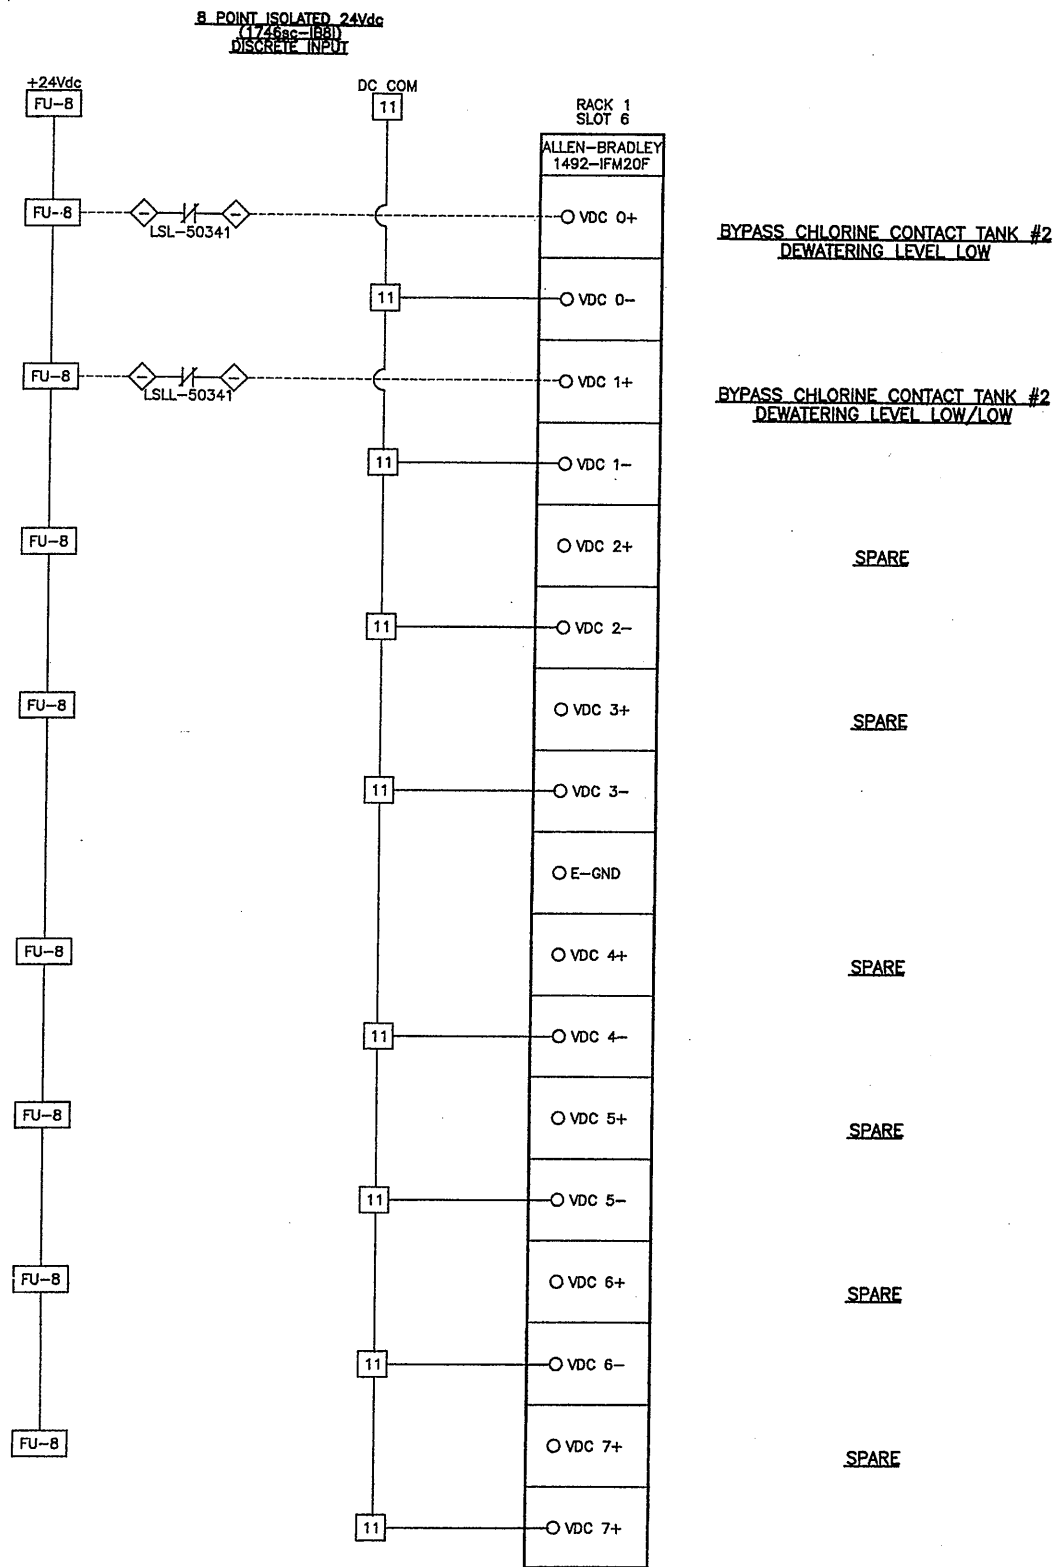

BYPASS CHLORINE CONTACT TANK #2
DEWATERING LEVEL LOW

BYPASS CHLORINE CONTACT TANK #2
DEWATERING LEVEL LOW/LOW

SPARE

SPARE

Layer: ON=*, OFF=*REF*

01/12/01 OBG JEC
EEA-VERT

| No. | Date | Revisions | Init |
|-----|----------|---------------------|------|
| 0 | 4/20/01 | ISSUED FOR APPROVAL | PLD |
| 1 | 7/11/01 | AS BID | |
| 2 | 10/31/03 | RECORD DRAWING | |

In charge of PLD
Designed by SAT
Drawn by JEC
Checked by PLD

ENVIRONMENTAL ENGINEERING ASSOCIATES, LLP
SYRACUSE, NEW YORK

ONONDAGA COUNTY • DEPARTMENT OF DRAINAGE AND SANITATION • SYRACUSE, NEW YORK
METROPOLITAN SYRACUSE WASTEWATER TREATMENT PLANT
STAGE III AMMONIA AND STAGE II PHOSPHORUS REMOVAL PROJECT
CHLORINE BYPASS BLDG. (PLC M20D)
DIGITAL INPUT MODULES



File Number
00659

Date
APRIL 2001

Campollet

1-628


NO ALTERATIONS PERMITTED HEREON EXCEPT
AS PROVIDED UNDER SECTION 7209 SUBDIVISION
2 OF THE NEW YORK STATE EDUCATION LAW

INSTRUMENTATION

RECORD DRAWING
THESE DRAWINGS HAVE BEEN REVISED TO REFLECT
MAJOR CHANGES, IF ANY, WHICH OCCURRED DURING
CONSTRUCTION. REVISIONS ARE BASED UPON
INFORMATION SUPPLIED BY CONTRACTOR.
DATE: *Walter* PER: *Campollet*
THIS DRAWING WAS PREPARED AT THE SCALE INDICATED IN THE
TITLE BLOCK. INACCURACIES IN THE STATED SCALE MAY BE
INTRODUCED WHEN DRAWINGS ARE REPRODUCED BY ANY MEANS.
USE THE GRAPHIC SCALE BAR IN THE TITLE BLOCK TO
DETERMINE THE ACTUAL SCALE OF THIS DRAWING.

RACK 1
SLOT 8
ALLEN-BRADLEY
1492-IFM20F-FS-2

8 POINT ISOLATED RELAY OUTPUT
(AB 1746-OXR)

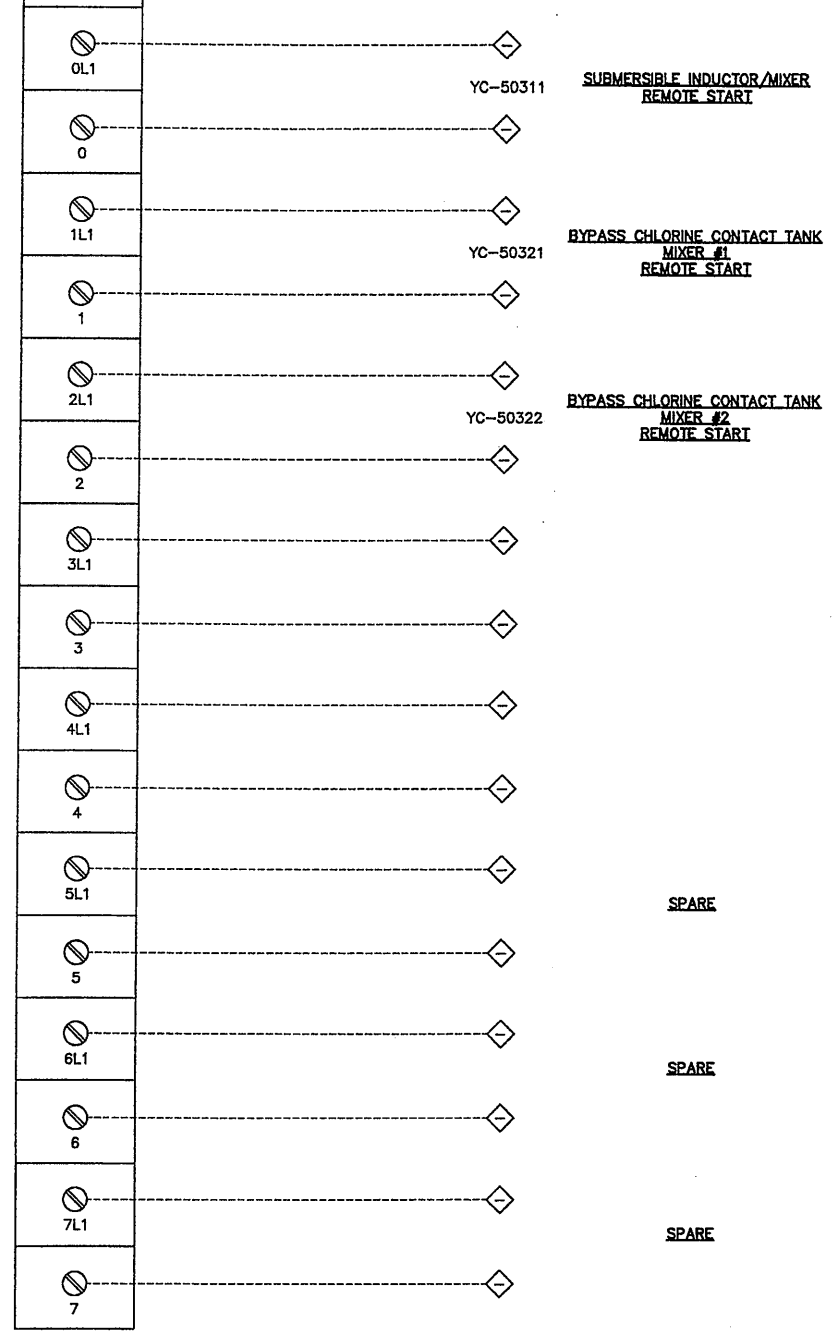

Layer: ON=*; OFF=*REF*
11/27/00 OBG JEC
EEA-VERT

RECORD DRAWING
THIS DRAWING HAS BEEN REVISED TO REFLECT MAJOR CHANGES IF ANY, WHICH OCCURRED DURING CONSTRUCTION. REVISIONS ARE BASED UPON INFORMATION SUPPLIED BY CONTRACTOR.
DATE: 10/21/01 FOR: K Campollet

THIS DRAWING WAS PREPARED AT THE SCALE INDICATED IN THE TITLE BLOCK. INACCURACIES IN THE STATED SCALE MAY BE INTRODUCED WHEN DRAWINGS ARE REPRODUCED BY ANY MEANS. USE THE GRAPHIC SCALE BAR IN THE TITLE BLOCK TO DETERMINE THE ACTUAL SCALE OF THIS DRAWING.

| No. | Date | Revisions | Init |
|-----|----------|---------------------|------|
| 0 | 4/20/01 | ISSUED FOR APPROVAL | PLD |
| 1 | 7/11/01 | AS BID | |
| 2 | 10/31/05 | RECORD DRAWING | |

In charge of --- PLD ---
Designed by --- SAT ---
Drawn by --- JEC ---
Checked by --- PLD ---




ONONDAGA COUNTY • DEPARTMENT OF DRAINAGE AND SANITATION • SYRACUSE, NEW YORK
METROPOLITAN SYRACUSE WASTEWATER TREATMENT PLANT
STAGE III AMMONIA AND STAGE II PHOSPHORUS REMOVAL PROJECT
CHLORINE BYPASS BLDG. (PLC M20D)
DIGITAL OUTPUT MODULES



File Number
00659
Date
APRIL 2001
K Campollet

1-629

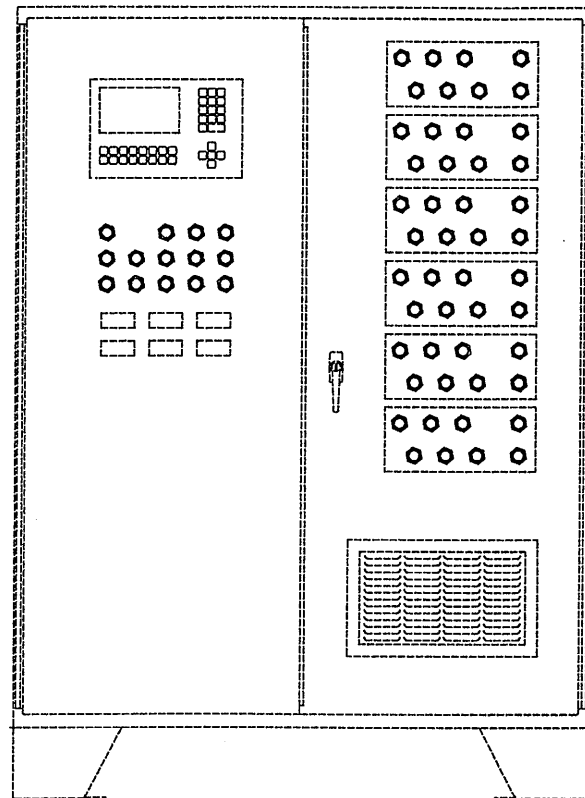

CONTROL PANEL FRONT VIEW

NOTES:

1. PANEL IS EXISTING AND WAS CONSTRUCTED BY ENVIROMATION INC., SYRACUSE, NEW YORK. UPON AWARD OF CONTRACT, CONTRACTOR WILL RECEIVE A COPY OF PANEL AS-BUILT DRAWINGS.

01/12/01 086 JEC

RECORD DRAWING

THESE CHANGES HAVE BEEN MADE TO REFLECT MAJOR CHANGES, IF ANY, WHICH OCCURRED DURING CONSTRUCTION. REVISIONS ARE BASED UPON INFORMATION SUPPLIED BY CONTRACTOR.
 DATE: 10/24/01 PER: *Blampiet*

THIS DRAWING WAS PREPARED AT THE SCALE INDICATED IN THE TITLE BLOCK. INACCURACIES IN THE STATED SCALE MAY BE INTRODUCED WHEN DRAWINGS ARE REPRODUCED BY ANY MEANS. USE THE GRAPHIC SCALE BAR IN THE TITLE BLOCK TO DETERMINE THE ACTUAL SCALE OF THIS DRAWING.

NO ALTERATIONS PERMITTED HEREON EXCEPT AS PROVIDED UNDER SECTION 7209 SUBDIVISION 2 OF THE NEW YORK STATE EDUCATION LAW

| No. | Date | Revisions | Init |
|-----|----------|---------------------|------------|
| 0 | 4/20/01 | ISSUED FOR APPROVAL | <i>PLD</i> |
| 1 | 7/11/01 | AS BID | |
| 2 | 10/31/03 | RECORD DRAWING | |

In charge of PLD
 Designed by SAT
 Drawn by JEC
 Checked by PLD

ENVIRONMENTAL ENGINEERING ASSOCIATES, LLP
 SYRACUSE, NEW YORK

ONONDAGA COUNTY • DEPARTMENT OF DRAINAGE AND SANITATION • SYRACUSE, NEW YORK
 METROPOLITAN SYRACUSE WASTEWATER TREATMENT PLANT
 STAGE III AMMONIA AND STAGE II PHOSPHORUS REMOVAL PROJECT
CHEMICAL BUILDING "B" (PLC M20B)
CONTROL PANEL LAYOUT
 INSTRUMENTATION


STATE OF NEW YORK
 LICENSED PROFESSIONAL ENGINEER
 No. 00754

File Number
 00659

Date
 APRIL 2001

Blampiet

1-630

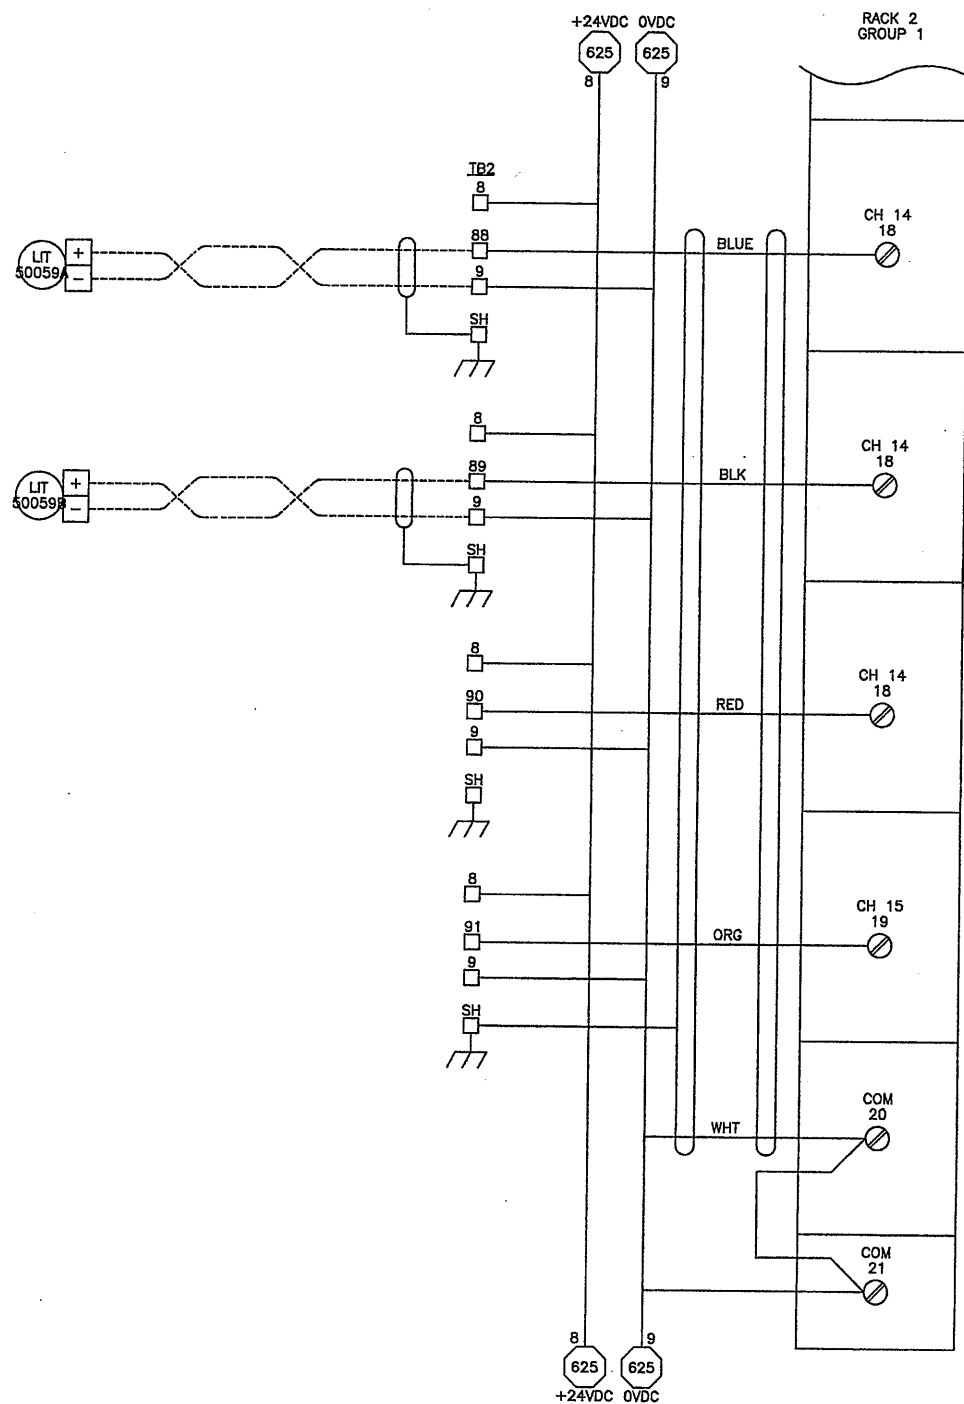

FECL3 BULK STORAGE TANK NO.1
LEVEL
0-XX FT.

FECL3 BULK STORAGE TANK NO.2
LEVEL
0-XX FT.

SPARE

SPARE

NOTE:

CONTRACTOR SHALL UTILIZE EXISTING ANALOG INPUT SPARES LOCATED ON RACK 2, GROUP 1 AT THE CHEMICAL BUILDING "B" CONTROL PANEL. (REFER TO ENVIROMATION INC. FILE 99210E16, DWG. 99210-1, SHEET 6 OF 17, WHICH WILL BE AVAILABLE TO CONTRACTOR UPON AWARD OF CONTRACT)

RECORD DRAWING

THESE CHANGES HAVE BEEN MADE TO REFLECT MAJOR CHANGES IF ANY, WHICH OCCURRED DURING CONSTRUCTION. REVISIONS ARE BASED UPON INFORMATION SUPPLIED BY CONTRACTOR.

DATE: 10/21/01 PER: K. Rampal

THIS DRAWING WAS PREPARED AT THE SCALE INDICATED IN THE TITLE BLOCK. INACCURACIES IN THE STATED SCALE MAY BE INTRODUCED WHEN DRAWINGS ARE REPRODUCED BY ANY MEANS. USE THE GRAPHIC SCALE BAR IN THE TITLE BLOCK TO DETERMINE THE ACTUAL SCALE OF THIS DRAWING.

Layer: ON=*; OFF=*REF*

02/02/01 OBG JEC
EEA-VERT

| No. | Date | Revisions | Init |
|-----|----------|---------------------|------|
| 0 | 4/20/01 | ISSUED FOR APPROVAL | JK |
| 1 | 7/11/01 | AS BID | |
| 2 | 10/31/05 | RECORD DRAWING | |

In charge of --- PLD
Designed by --- SAT
Drawn by --- JEC
Checked by --- PLD



ONONDAGA COUNTY • DEPARTMENT OF DRAINAGE AND SANITATION • SYRACUSE, NEW YORK
METROPOLITAN SYRACUSE WASTEWATER TREATMENT PLANT
STAGE III AMMONIA AND STAGE II PHOSPHORUS REMOVAL PROJECT
CHEMICAL BUILDING "B" (PLC 20B)
ANALOG INPUT MODULE



File Number
00659


Date
APRIL 2001

Signature: K. Rampal

I-631

INSTRUMENTATION

NO ALTERATIONS PERMITTED HEREON EXCEPT AS PROVIDED UNDER SECTION 7209 SUBDIVISION 2 OF THE NEW YORK STATE EDUCATION LAW

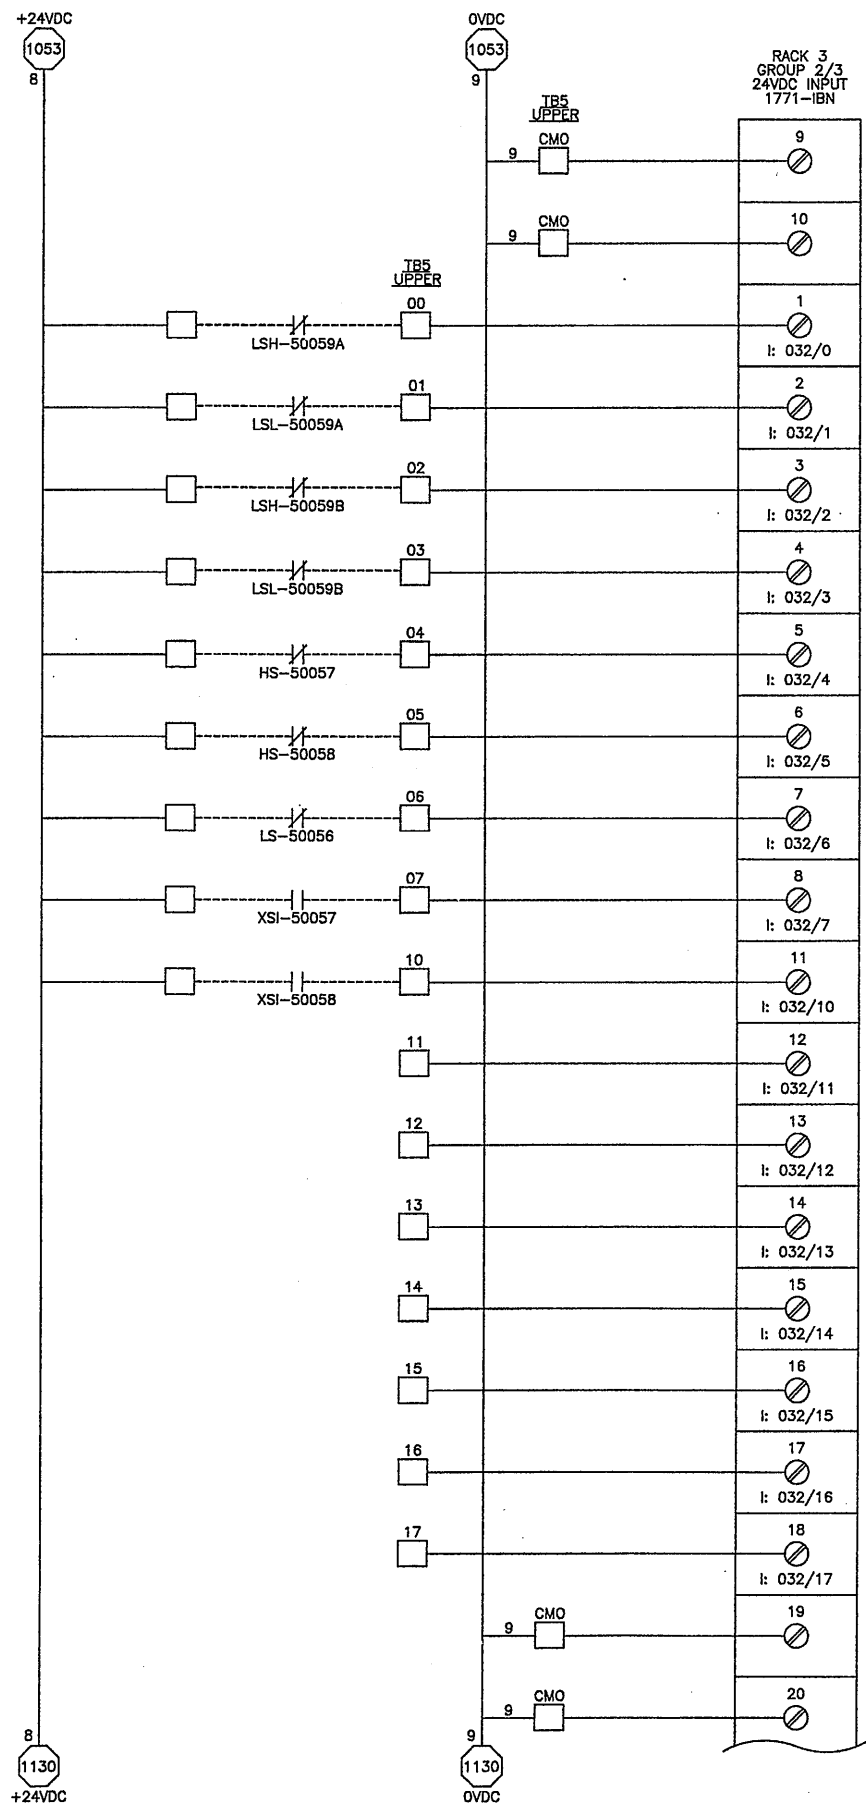

- FECL3 BULK STORAGE TANK NO.1
LEVEL HIGH
- FECL3 BULK STORAGE TANK NO.1
LEVEL LOW
- FECL3 BULK STORAGE TANK NO.2
LEVEL HIGH
- FECL3 BULK STORAGE TANK NO.2
LEVEL LOW
- FERRIC CHLORIDE TRANSFER PUMP NO. 1
AUTO
- FERRIC CHLORIDE TRANSFER PUMP NO. 2
AUTO
- FERRIC CHLORIDE
DISCHARGE PIPING LEAK
- FERRIC CHLORIDE
TRANSFER PUMP #1 RUNNING
- FERRIC CHLORIDE
TRANSFER PUMP #2 RUNNING

NOTE:
 CONTRACTOR SHALL UTILIZE EXISTING DISCRETE INPUTS SPARES LOCATED ON RACK 3, GROUP 2/3 AT THE CHEMICAL BUILDING "B" CONTROL PANEL (REFER TO ENVIROMATION INC. FILE 99210E1B, DWG. 99210-1, SHEET 11 OF 17, WHICH WILL BE AVAILABLE TO CONTRACTOR UPON AWARD OF CONTRACT)


RECORD DRAWING
 THESE DRAWINGS HAVE BEEN REVISIONED TO REFLECT MAJOR CHANGES, IF ANY, WHICH OCCURRED DURING CONSTRUCTION. REVISIONS ARE BASED UPON INFORMATION SUPPLIED BY CONTRACTOR.
 DATE: 10/21/01 PER: [Signature]

THIS DRAWING WAS PREPARED AT THE SCALE INDICATED IN THE TITLE BLOCK. INACCURACIES IN THE STATED SCALE MAY BE INTRODUCED WHEN DRAWINGS ARE REPRODUCED BY ANY MEANS. USE THE GRAPHIC SCALE BAR IN THE TITLE BLOCK TO DETERMINE THE ACTUAL SCALE OF THIS DRAWING.

Layer: ON=*; OFF=*REF*
 02/02/01 OBG JEC
 EEA-VERT

| No. | Date | Revisions | Init |
|-----|----------|---------------------|-------------|
| 0 | 4/20/01 | ISSUED FOR APPROVAL | [Signature] |
| 1 | 7/11/01 | AS BID | |
| 2 | 10/31/01 | RECORD DRAWING | |

In charge of PLD
 Designed by SAT
 Drawn by JEC
 Checked by PLD

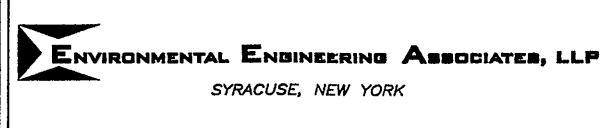

ONONDAGA COUNTY • DEPARTMENT OF DRAINAGE AND SANITATION • SYRACUSE, NEW YORK
 METROPOLITAN SYRACUSE WASTEWATER TREATMENT PLANT
 STAGE III AMMONIA AND STAGE II PHOSPHORUS REMOVAL PROJECT
CHEMICAL BUILDING "B" (PLC 20B)
DISCRETE INPUT MODULE




File Number: 00659
 Date: APRIL 2001
 [Signature]

1-632

NO ALTERATIONS PERMITTED HEREON EXCEPT AS PROVIDED UNDER SECTION 7209 SUBDIVISION 2 OF THE NEW YORK STATE EDUCATION LAW

INSTRUMENTATION

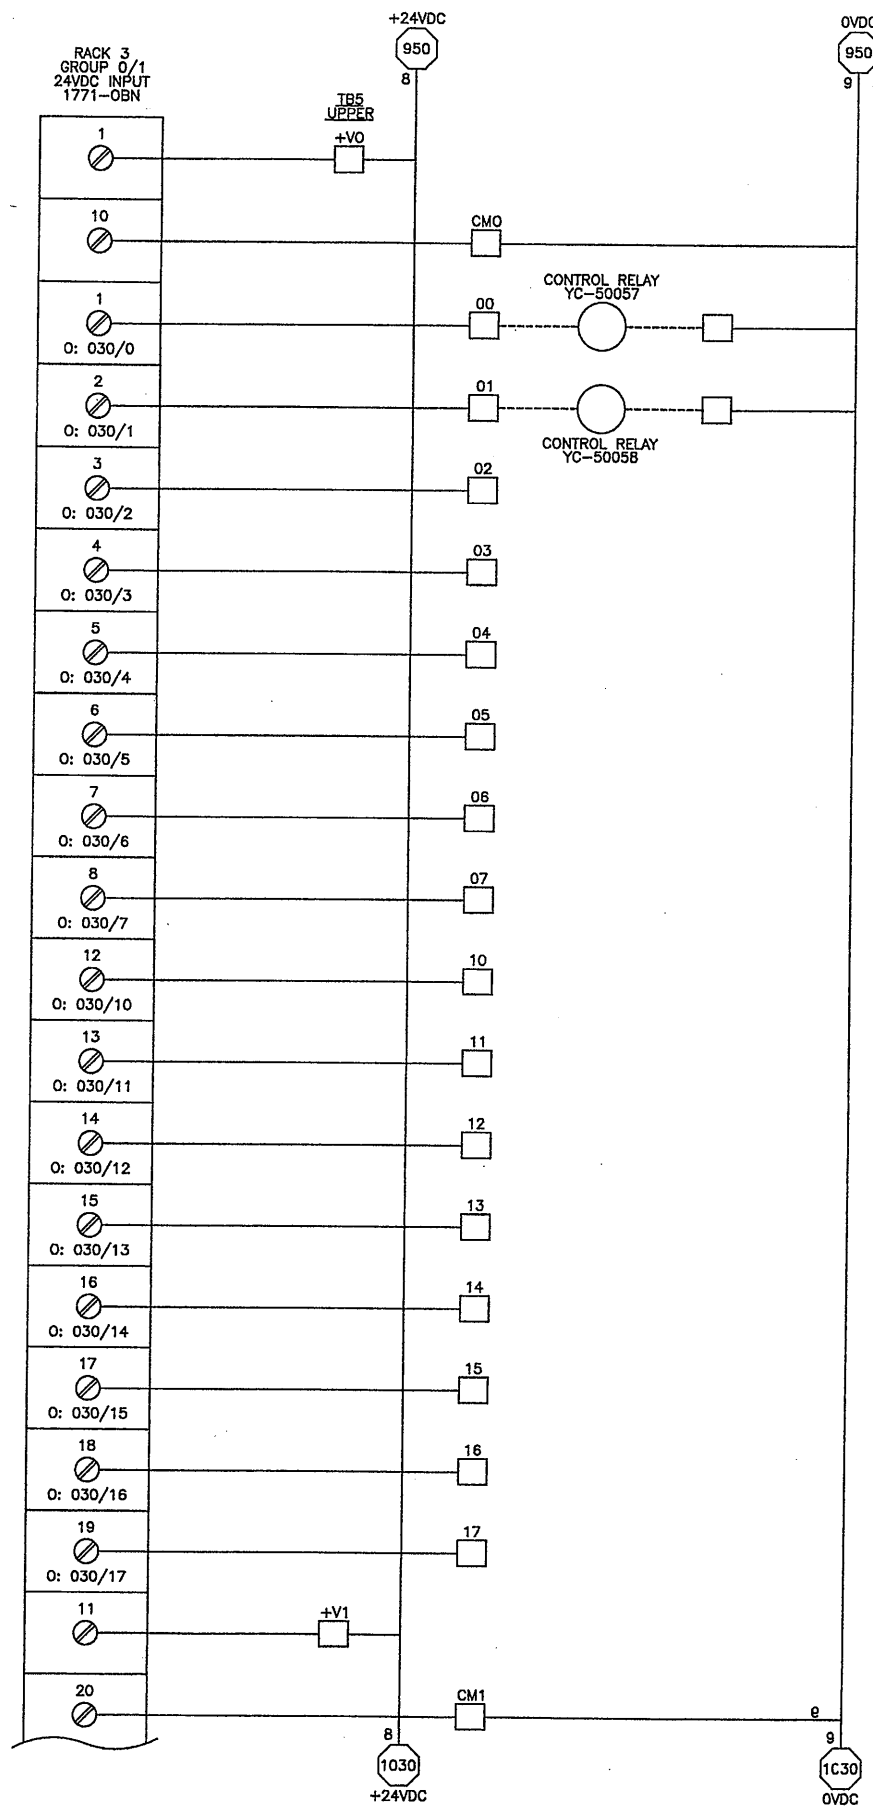

FECL3 TRANSFER PUMP NO.1
REMOTE START

YC-50057 → TO FECL3
TRANSFER PUMP NO. 1
HOA AUTO MODE
(LOCATED IN PUMP
COMBINATION STARTER)

FECL3 TRANSFER PUMP NO.2
REMOTE START

YC-50058 → TO FECL3
TRANSFER PUMP NO. 2
HOA AUTO MODE
(LOCATED IN PUMP
COMBINATION STARTER)

SPARE

SPARE

NOTE:

CONTRACTOR SHALL UTILIZE EXISTING DISCRETE OUTPUTS SPARES LOCATED ON RACK 3, GROUP 0/1 AT THE CHEMICAL BUILDING "B" CONTROL PANEL. (REFER TO ENVIROMATION INC. FILE 99210E1D, DWG. 99210-1, SHEET 13 OF 17, WHICH WILL BE AVAILABLE TO CONTRACTOR UPON AWARD OF CONTRACT)

RECORD DRAWING

THESE CHANGES HAVE BEEN MADE TO REFLECT MAJOR CHANGES IF ANY, WHICH OCCURRED DURING CONSTRUCTION. REVISIONS ARE BASED UPON INFORMATION SUPPLIED BY CONTRACTOR.

DATE: 4/20/01 PER: J. Campbell

THIS DRAWING WAS PREPARED AT THE SCALE INDICATED IN THE TITLE BLOCK. INACCURACIES IN THE STATED SCALE MAY BE INTRODUCED WHEN DRAWINGS ARE REPRODUCED, BY ANY MEANS. USE THE GRAPHIC SCALE BAR IN THE TITLE BLOCK TO DETERMINE THE ACTUAL SCALE OF THIS DRAWING.

Layer: ON=*, OFF=*REF*


02/02/01 OBG JEC
EEA-VERT

| No. | Date | Revisions | Init |
|-----|----------|---------------------|------|
| 0 | 4/20/01 | ISSUED FOR APPROVAL | PLD |
| 1 | 7/11/01 | AS BID | |
| 2 | 10/31/03 | RECORD DRAWING | |

In charge of PLD
Designed by SAT
Drawn by JEC
Checked by PLD

ENVIRONMENTAL ENGINEERING ASSOCIATES, LLP
SYRACUSE, NEW YORK

ONONDAGA COUNTY • DEPARTMENT OF DRAINAGE AND SANITATION • SYRACUSE, NEW YORK
METROPOLITAN SYRACUSE WASTEWATER TREATMENT PLANT
STAGE III AMMONIA AND STAGE II PHOSPHORUS REMOVAL PROJECT
CHEMICAL BUILDING "B" (PLC 20B)
DISCRETE OUTPUT MODULE

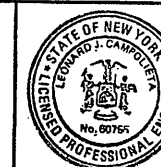


File Number
00659

Date
APRIL 2001



1-633

NO ALTERATIONS PERMITTED HEREON EXCEPT AS PROVIDED UNDER SECTION 7209 SUBDIVISION 2 OF THE NEW YORK STATE EDUCATION LAW

INSTRUMENTATION

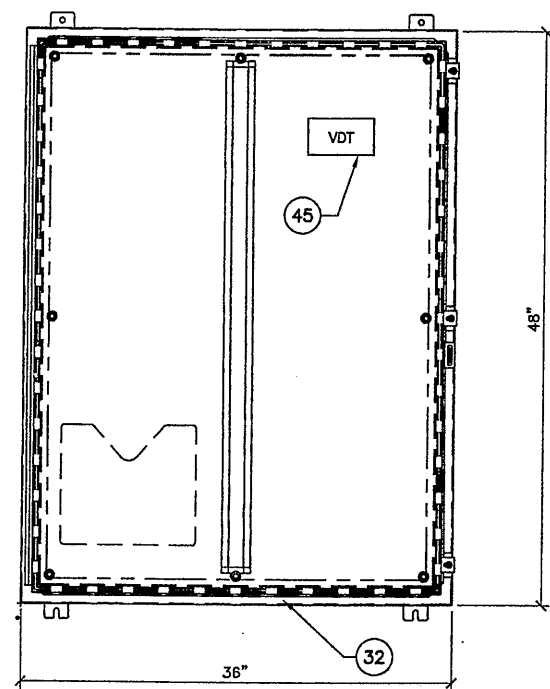

CONTROL PANEL FRONT VIEW

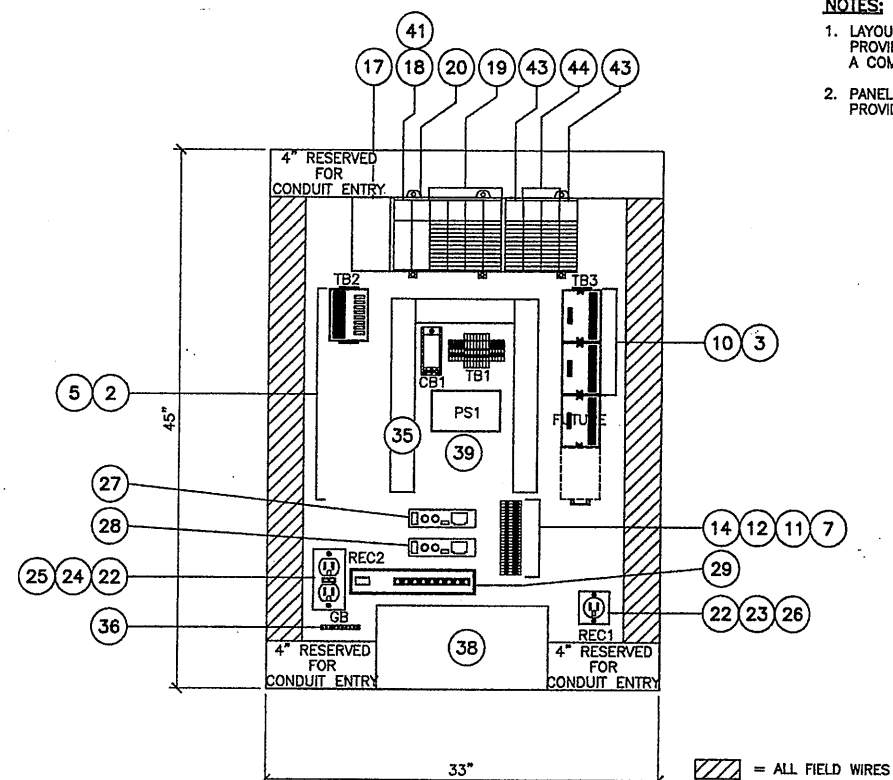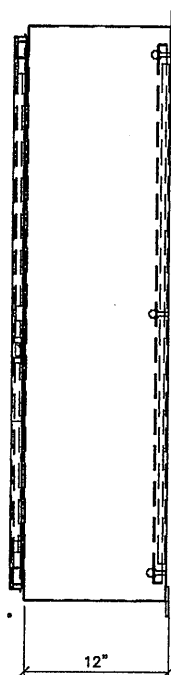


CONTROL PANEL INTERIOR VIEW

NOTES:

- LAYOUT SHOWN IS FOR CONCEPT ONLY. CONTRACTOR SHALL PROVIDE ALL NECESSARY APPURTENANCES REQUIRED FOR A COMPLETE AND OPERATIONAL SYSTEM.
- PANEL SIZE IS APPROXIMATE ONLY. CONTRACTOR SHALL PROVIDE ENCLOSURE SIZE AS REQUIRED FOR EQUIPMENT.

BAF ELECTRIC ROOM CONTROL PANEL

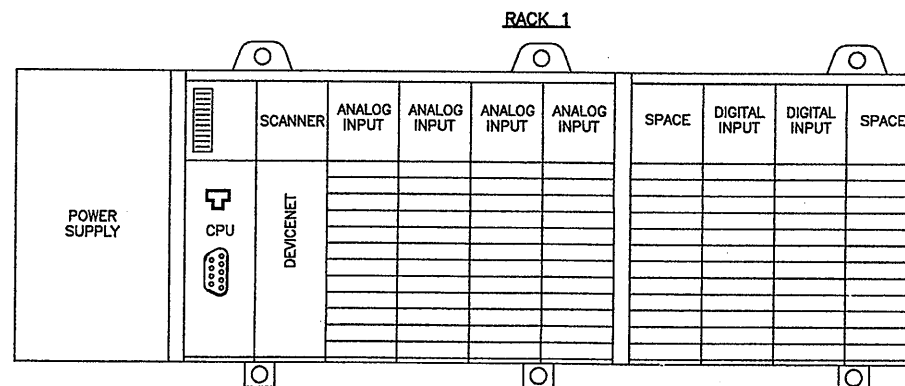

PLC MODULE LAYOUT

RECORD DRAWING

THESE DRAWINGS HAVE BEEN REVISIONED TO REFLECT MAJOR CHANGES, IF ANY, WHICH OCCURRED DURING CONSTRUCTION. REVISIONS ARE BASED UPON INFORMATION SUPPLIED BY CONTRACTOR.
DATE: 10/21/05 FOR: Kamplet

THIS DRAWING WAS PREPARED AT THE SCALE INDICATED IN THE TITLE BLOCK. INACCURACIES IN THE STATED SCALE MAY BE INTRODUCED WHEN DRAWINGS ARE REPRODUCED BY ANY MEANS. USE THE GRAPHIC SCALE BAR IN THE TITLE BLOCK TO DETERMINE THE ACTUAL SCALE OF THIS DRAWING.


01/12/01 OBG JEC

| No. | Date | Revisions | Init |
|-----|----------|---------------------|------|
| 0 | 4/20/01 | ISSUED FOR APPROVAL | |
| 1 | 7/11/01 | AS BID | |
| 2 | 10/31/05 | RECORD DRAWING | |

In charge of --- PLD
 Designed by --- SAT
 Drawn by --- JEC
 Checked by --- PLD




ONONDAGA COUNTY • DEPARTMENT OF DRAINAGE AND SANITATION • SYRACUSE, NEW YORK
 METROPOLITAN SYRACUSE WASTEWATER TREATMENT PLANT
 STAGE III AMMONIA AND STAGE II PHOSPHORUS REMOVAL PROJECT
**BAF ELECTRIC ROOM (PLC M24)
 CONTROL PANEL LAYOUT**

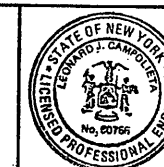

File Number
00659
 Date
APRIL 2001
 I-634
 Kamplet

NO ALTERATIONS PERMITTED HEREON EXCEPT AS PROVIDED UNDER SECTION 7209 SUBDIVISION 2 OF THE NEW YORK STATE EDUCATION LAW

INSTRUMENTATION

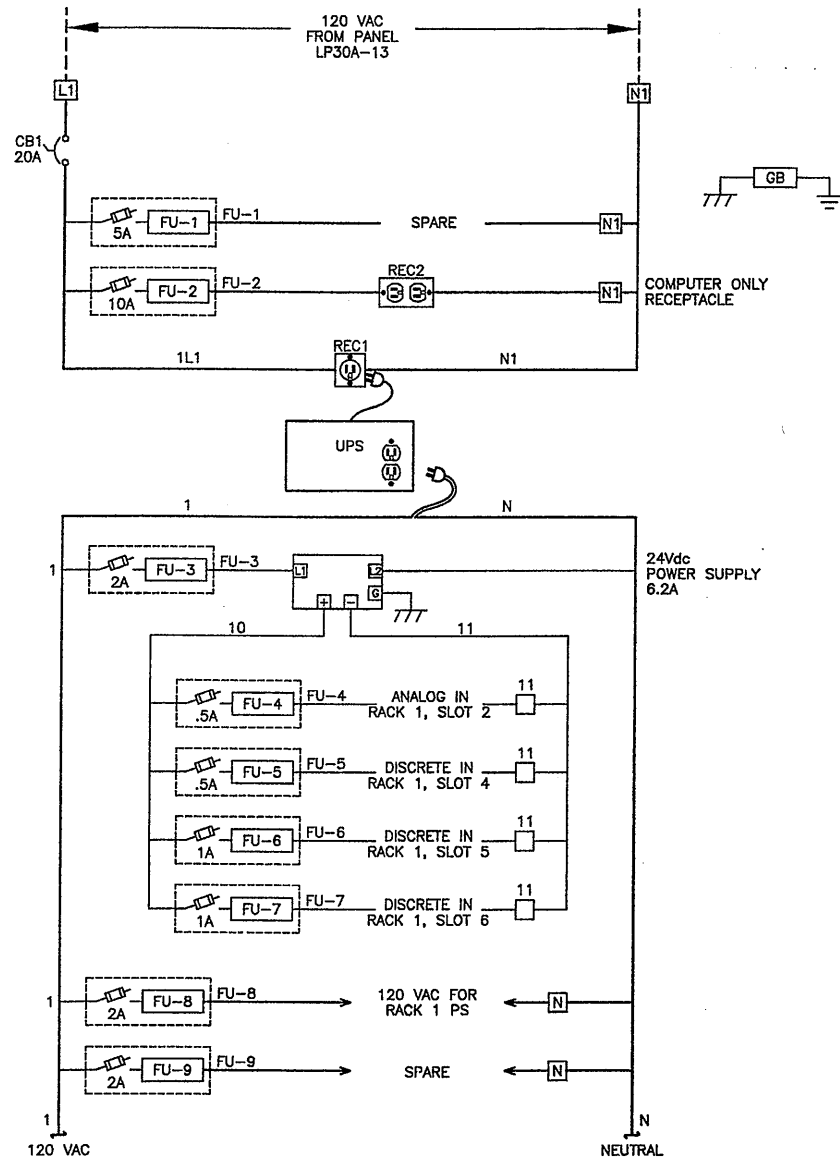

| BILL OF MATERIALS | | | | |
|-------------------|----------|--------------------|---------------|---|
| SYMBOL | QUANTITY | MODEL NUMBER | MANUFACTURER | DESCRIPTION |
| 1 | | | | |
| 2 | A/R | SEE SPECIFICATIONS | Allen-Bradley | Analog Input Interface Module |
| 3 | A/R | SEE SPECIFICATIONS | Allen-Bradley | Digital Input Interface Cable - 1 meter |
| 4 | | | | |
| 5 | A/R | SEE SPECIFICATIONS | Allen-Bradley | Analog Input Interface Cable - 1 meter |
| 6 | | | | |
| 7 | A/R | SEE SPECIFICATIONS | Allen-Bradley | High Density Terminal Block |
| 8 | A/R | SEE SPECIFICATIONS | Allen-Bradley | Fusible Switch |
| 9 | | | | |
| 10 | A/R | SEE SPECIFICATIONS | Allen-Bradley | Digital Input Interface Module |
| 11 | A/R | SEE SPECIFICATIONS | Allen-Bradley | End Anchor |
| 12 | A/R | SEE SPECIFICATIONS | Allen-Bradley | High Density Terminal Block End Barrier |
| 13 | A/R | SEE SPECIFICATIONS | Allen-Bradley | Fusible Switch End Barrier |
| 14 | A/R | SEE SPECIFICATIONS | Allen-Bradley | High Density Jumper |
| 15 | | | | |
| 16 | A/R | SEE SPECIFICATIONS | Allen-Bradley | 10 Slot I/O Chassis |
| 17 | A/R | SEE SPECIFICATIONS | Allen-Bradley | I/O Chassis Power Supply |
| 18 | A/R | SEE SPECIFICATIONS | Allen-Bradley | CPU |
| 19 | A/R | SEE SPECIFICATIONS | Allen-Bradley | Analog Input - 8 point |
| 20 | A/R | SEE SPECIFICATIONS | Allen-Bradley | Devicenet Scanner Module |
| 21 | | | | |
| 22 | A/R | SEE SPECIFICATIONS | RACO | Box |
| 23 | A/R | SEE SPECIFICATIONS | RACO | Cover - single 15 amp |
| 24 | A/R | SEE SPECIFICATIONS | RACO | Cover - duplex 15 amp |
| 25 | A/R | SEE SPECIFICATIONS | Hubbell | 15A Duplex receptacle |
| 26 | A/R | SEE SPECIFICATIONS | Hubbell | 15A Single receptacle |
| 27 | A/R | SEE SPECIFICATIONS | - | Hub |
| 28 | A/R | SEE SPECIFICATIONS | - | Fiber/Twist Media Converter |
| 29 | A/R | SEE SPECIFICATIONS | - | RS-485-Ethernet Gateway |
| 30 | | | | |
| 31 | | | | |
| 32 | A/R | SEE SPECIFICATIONS | Hoffman | Nema 12 Enclosure |
| 33 | A/R | SEE SPECIFICATIONS | Hoffman | Sub-Panel |
| 34 | A/R | SEE SPECIFICATIONS | Panduit | 3"W x 3"D Slotted Wiring Duct |
| 35 | A/R | SEE SPECIFICATIONS | Panduit | 2"W x 3"D Slotted Wiring Duct |
| 36 | A/R | SEE SPECIFICATIONS | Square D | Ground Bar |
| 37 | A/R | SEE SPECIFICATIONS | Allen-Bradley | 20 amp Circuit Breaker, single pole |
| 38 | A/R | SEE SPECIFICATIONS | Best Power | Uninterruptible Power Supply |
| 39 | A/R | SEE SPECIFICATIONS | Power One | DC Power Supply 24 Vdc Output |
| 40 | A/R | SEE SPECIFICATIONS | TBD | Fuses |
| 41 | A/R | SEE SPECIFICATIONS | Allen-Bradley | Flash EEprom Memory for CPU |
| 42 | | | | |
| 43 | A/R | SEE SPECIFICATIONS | Allen-Bradley | Blank Slot Filler Module |
| 44 | A/R | SEE SPECIFICATIONS | Allen-Bradley | Discrete Input - 8 point |
| 45 | A/R | SEE SPECIFICATIONS | Allen-Bradley | VDT |
| 46 | | | | |
| 47 | | | | |
| 48 | | | | |

Layer: ON=*; OFF=*REF*
07/17/00 OBG JEC

| No. | Date | Revisions | Init |
|-----|----------|---------------------|------|
| 0 | 4/20/01 | ISSUED FOR APPROVAL | PLD |
| 1 | 7/11/01 | AS BID | SAT |
| 2 | 10/31/05 | RECORD DRAWING | JEC |

In charge of PLD
Designed by SAT
Drawn by JEC
Checked by PLD



ONONDAGA COUNTY • DEPARTMENT OF DRAINAGE AND SANITATION • SYRACUSE, NEW YORK
METROPOLITAN SYRACUSE WASTEWATER TREATMENT PLANT
STAGE III AMMONIA AND STAGE II PHOSPHORUS REMOVAL PROJECT
BAF ELECTRIC ROOM (PLC M24)
CONTROL CIRCUIT WIRING




File Number 00659
Date APRIL 2001
1-635
Signature: *Leonard J. Campora*


RECORD DRAWING
THESE DRAWINGS HAVE BEEN REVIEWED TO REFLECT MAJOR CHANGES, IF ANY, WHICH OCCURRED DURING CONSTRUCTION. REVISIONS ARE BASED UPON INFORMATION SUPPLIED BY CONTRACTOR.
DATE: 10/11/05 FOR: J. Campora

THIS DRAWING WAS PREPARED AT THE SCALE INDICATED IN THE TITLE BLOCK. INACCURACIES IN THE STATED SCALE MAY BE INTRODUCED WHEN DRAWINGS ARE REPRODUCED BY ANY MEANS. USE THE GRAPHIC SCALE BAR IN THE TITLE BLOCK TO DETERMINE THE ACTUAL SCALE OF THIS DRAWING.

TB1

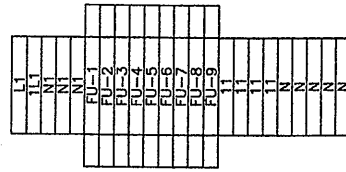


TB2 (ANALOG)

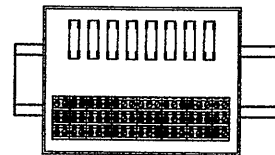

RACK: 1
SLOT: 2

TB3 (DIGITAL)

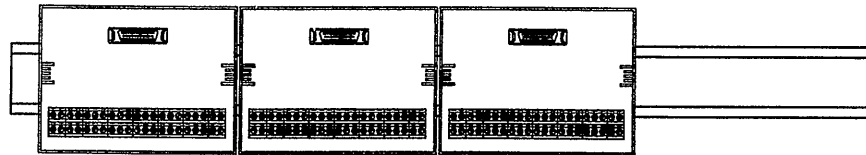


RACK: 1
SLOT: 4

RACK: 1
SLOT: 5

RACK: 1
SLOT: 6

TB4 (24Vdc DI)

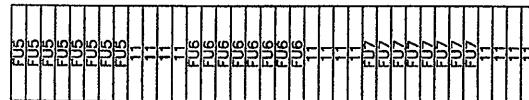

Layer: ON=*; OFF=*REF*

11/27/00 OBG JEC

RECORD DRAWING

THESE CHANGES HAVE BEEN MADE TO REFLECT
MAJOR CHANGES, IF ANY, WHICH OCCURRED DURING
CONSTRUCTION. REVISIONS ARE BASED UPON
INFORMATION SUPPLIED BY CONTRACTOR.
DATE: 10/21/01 FOR: Rampollet

THIS DRAWING WAS PREPARED AT THE SCALE INDICATED IN THE
TITLE BLOCK. INACCURACIES IN THE STATED SCALE MAY BE
INTRODUCED WHEN DRAWINGS ARE REPRODUCED BY ANY MEANS.
USE THE GRAPHIC SCALE BAR IN THE TITLE BLOCK TO
DETERMINE THE ACTUAL SCALE OF THIS DRAWING.


NO ALTERATIONS PERMITTED HEREON EXCEPT
AS PROVIDED UNDER SECTION 7209 SUBDIVISION
2 OF THE NEW YORK STATE EDUCATION LAW

| No. | Date | Revisions | Init |
|-----|----------|---------------------|------|
| 0 | 4/20/01 | ISSUED FOR APPROVAL | PLD |
| 1 | 7/11/01 | AS BID | |
| 2 | 10/31/05 | RECORD DRAWING | |

In charge of PLD
Designed by SAT
Drawn by JEC
Checked by PLD


ENVIRONMENTAL ENGINEERING ASSOCIATES, LLP
SYRACUSE, NEW YORK

ONONDAGA COUNTY • DEPARTMENT OF DRAINAGE AND SANITATION • SYRACUSE, NEW YORK
METROPOLITAN SYRACUSE WASTEWATER TREATMENT PLANT
STAGE III AMMONIA AND STAGE II PHOSPHORUS REMOVAL PROJECT
BAF ELECTRIC ROOM (PLC M24)
TERMINAL BLOCK LAYOUT
INSTRUMENTATION

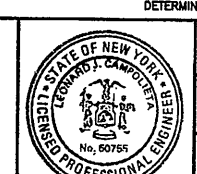

File Number
00659
Date
APRIL 2001
1-636
Rampollet

8 POINT ANALOG INPUT MODULE
(AB 1746-NIB)

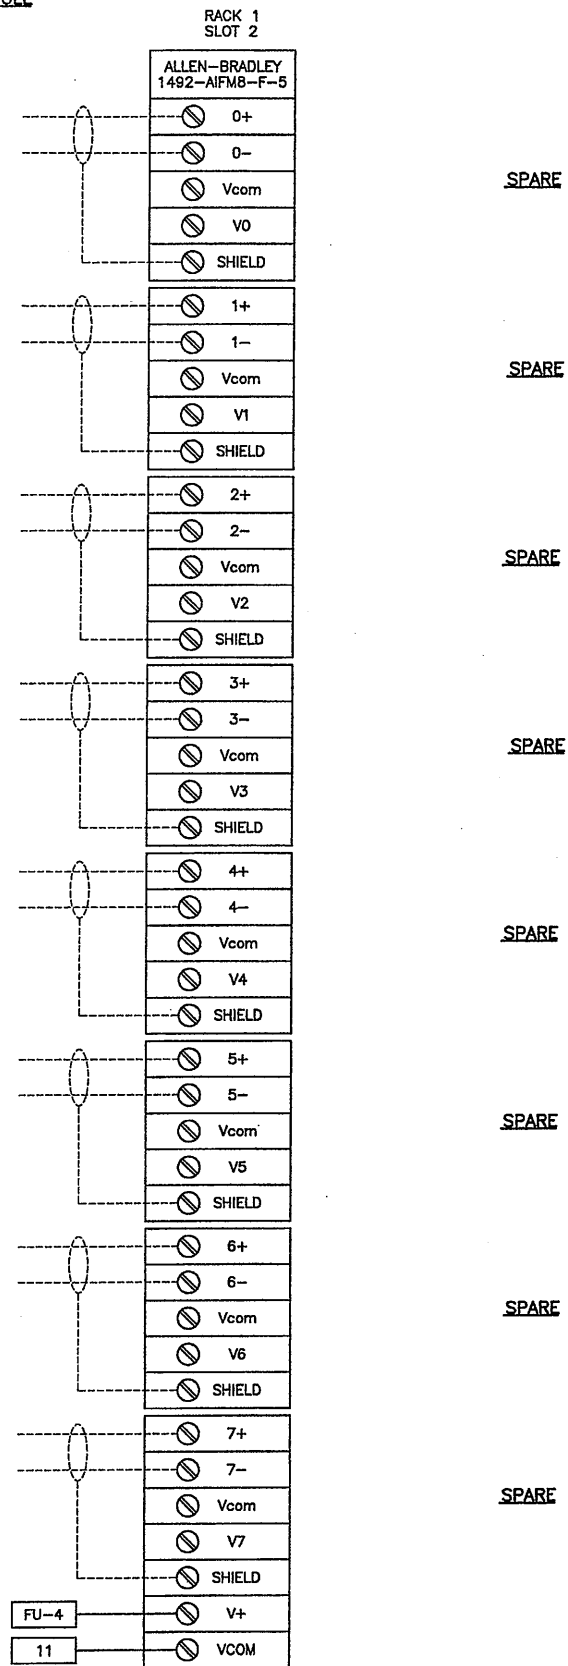

Layer: ON=*; OFF=*REF*
01/09/01 OBG JEC
EEA-VERT

RECORD DRAWING

THIS DRAWING HAS BEEN REVISED TO REFLECT
MADE CHANGES, IF ANY, WHICH OCCURRED DURING
CONSTRUCTION. REVISIONS ARE BASED UPON
INFORMATION SUPPLIED BY CONTRACTOR.

DATE 10/26/05 FOR 10/26/05

THIS DRAWING WAS PREPARED AT THE SCALE INDICATED IN THE
TITLE BLOCK. INACCURACIES IN THE STATED SCALE MAY BE
INTRODUCED WHEN DRAWINGS ARE REPRODUCED BY ANY MEANS.
USE THE GRAPHIC SCALE BAR IN THE TITLE BLOCK TO
DETERMINE THE ACTUAL SCALE OF THIS DRAWING.

| No. | Date | Revisions | Init |
|-----|----------|---------------------|------|
| 0 | 4/20/01 | ISSUED FOR APPROVAL | LJK |
| 1 | 7/11/01 | AS BID | |
| 2 | 10/31/05 | RECORD DRAWING | |

In charge of PLD
Designed by SAT
Drawn by JEC
Checked by PLD


ENVIRONMENTAL ENGINEERING ASSOCIATES, LLP
SYRACUSE, NEW YORK

ONONDAGA COUNTY • DEPARTMENT OF DRAINAGE AND SANITATION • SYRACUSE, NEW YORK
METROPOLITAN SYRACUSE WASTEWATER TREATMENT PLANT
STAGE III AMMONIA AND STAGE II PHOSPHORUS REMOVAL PROJECT
BAF ELECTRIC ROOM (PLC M24)
ANALOG INPUT MODULES



File Number
00659
Date
APRIL 2001
1-637

8 POINT ISOLATED 24Vdc
(1746ac-1B8)
DISCRETE INPUT

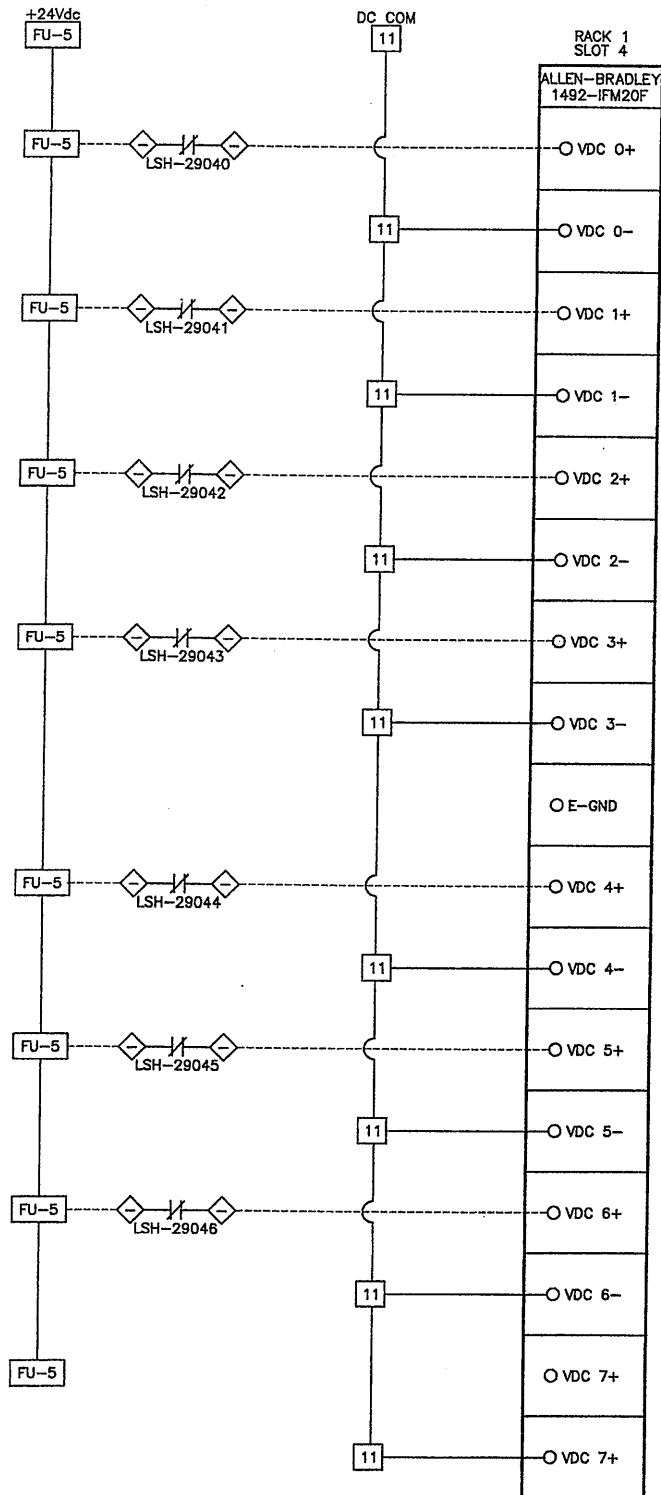

BAF GALLERY SUMP 1
LEVEL HIGH

BAF GALLERY SUMP 2
LEVEL HIGH

BAF GALLERY SUMP 3
LEVEL HIGH

BAF GALLERY SUMP 4
LEVEL HIGH


BAF GALLERY SUMP 5
LEVEL HIGH

BAF GALLERY SUMP 6
LEVEL HIGH

BACKWASH PUMP SUMP
LEVEL HIGH

SPARE

8 POINT ISOLATED 24Vdc
(1746ac-1B8)
DISCRETE INPUT

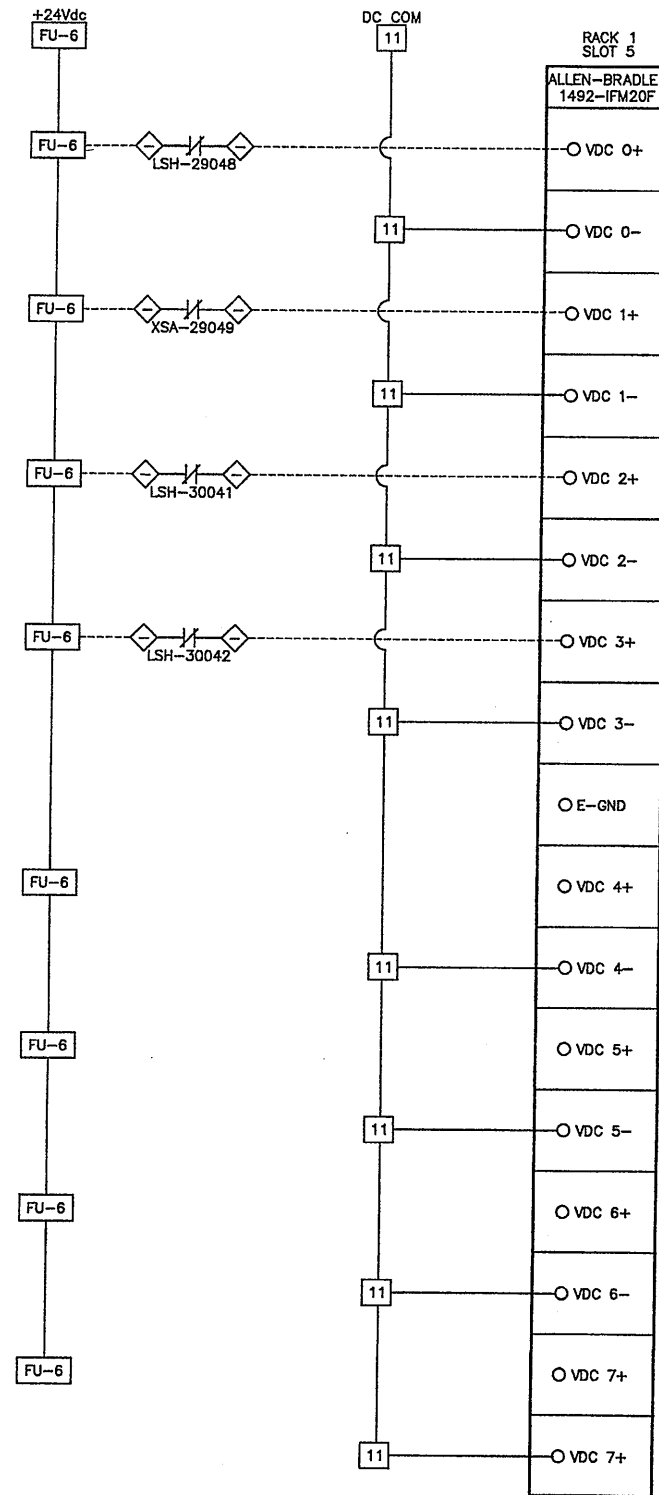

PURGE SUMP
LEVEL HIGH

PURGE SUMP
FAILURE

HRFS GALLERY
SUMP WEST LEVEL HIGH

HRFS GALLERY
SUMP EAST HIGH LEVEL

SPARE

SPARE

SPARE

SPARE

Layer: ON=*; OFF=*REF*

01/09/01 OBG JEC
EEA-VERT

| No. | Date | Revisions | Init |
|-----|----------|---------------------|------|
| 0 | 4/20/01 | ISSUED FOR APPROVAL | PLD |
| 1 | 7/11/01 | AS BID | SAT |
| 2 | 10/31/05 | RECORD DRAWING | JEC |

In charge of --- PLD
Designed by --- SAT
Drawn by --- JEC
Checked by --- PLD

ENVIRONMENTAL ENGINEERING ASSOCIATES, LLP
SYRACUSE, NEW YORK

ONONDAGA COUNTY • DEPARTMENT OF DRAINAGE AND SANITATION • SYRACUSE, NEW YORK
METROPOLITAN SYRACUSE WASTEWATER TREATMENT PLANT
STAGE III AMMONIA AND STAGE II PHOSPHORUS REMOVAL PROJECT
**BAF ELECTRIC ROOM (PLC M24)
DIGITAL INPUT MODULES**



File Number
00659

Date
APRIL 2001

Signature

I-638


NO ALTERATIONS PERMITTED HEREON EXCEPT
AS PROVIDED UNDER SECTION 7209 SUBDIVISION
2 OF THE NEW YORK STATE EDUCATION LAW

RECORD DRAWING
THESE DRAWINGS HAVE BEEN REVIEWED TO REFLECT
MAJOR CHANGES IF ANY, WHICH OCCURRED DURING
CONSTRUCTION. REVISIONS ARE BASED UPON
INFORMATION SUPPLIED BY CONSTRUCTION.
DATE: 10/21/01 FOR: *Signature*

THIS DRAWING WAS PREPARED AT THE SCALE INDICATED IN THE
TITLE BLOCK. INACCURACIES IN THE STATED SCALE MAY BE
INTRODUCED WHEN DRAWINGS ARE REPRODUCED BY ANY MEANS.
USE THE GRAPHIC SCALE BAR IN THE TITLE BLOCK TO
DETERMINE THE ACTUAL SCALE OF THIS DRAWING.

INSTRUMENTATION

B POINT ISOLATED 24Vdc
(1746ac-188)
DISCRETE INPUT

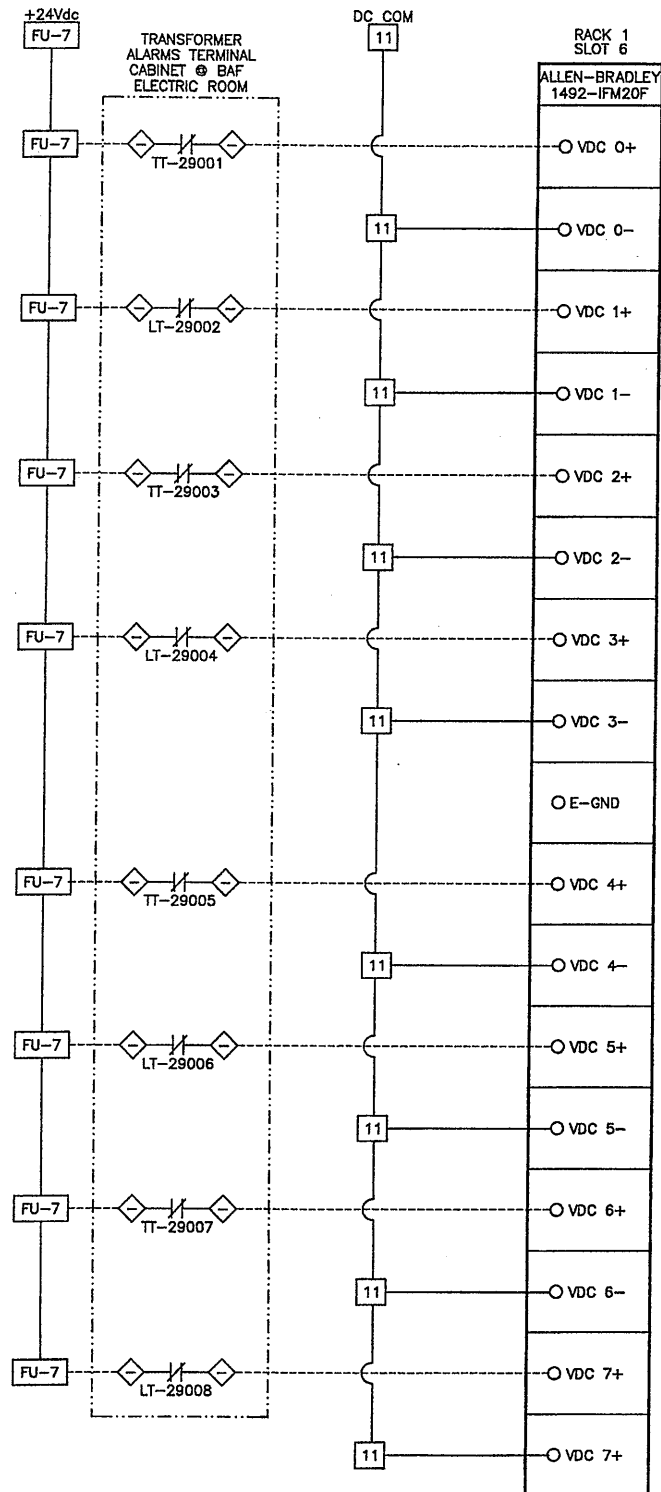

TRANSFORMER NO.1
OIL TEMPERATURE

TRANSFORMER NO.1
OIL LEVEL

TRANSFORMER NO.2
OIL TEMPERATURE

TRANSFORMER NO.2
OIL LEVEL

TRANSFORMER NO.3
OIL TEMPERATURE

TRANSFORMER NO.3
OIL LEVEL

TRANSFORMER NO.4
OIL TEMPERATURE

TRANSFORMER NO.4
OIL LEVEL

Layer: ON=*; OFF=*REF*

01/12/01 OBG JEC
EEA-VERT

| No. | Date | Revisions | Init |
|-----|----------|---------------------|------|
| 0 | 4/20/01 | ISSUED FOR APPROVAL | PLD |
| 1 | 7/11/01 | AS BID | JEC |
| 2 | 10/31/03 | RECORD DRAWING | PLD |

In charge of --- PLD
Designed by --- SAT
Drawn by --- JEC
Checked by --- PLD



ONONDAGA COUNTY • DEPARTMENT OF DRAINAGE AND SANITATION • SYRACUSE, NEW YORK
METROPOLITAN SYRACUSE WASTEWATER TREATMENT PLANT
STAGE III AMMONIA AND STAGE II PHOSPHORUS REMOVAL PROJECT
BAF ELECTRIC ROOM (PLC M24)
DIGITAL INPUT MODULES




File Number
00659
Date
APRIL 2001
1-639

RECORD DRAWING

THESE DRAWINGS HAVE BEEN REVISIONED TO REFLECT
MAJOR CHANGES, IF ANY, WHICH OCCURRED DURING
CONSTRUCTION. REVISIONS ARE BASED UPON
INFORMATION SUPPLIED BY CONTRACTOR.

DATE 10/21/01 PER [Signature]


THIS DRAWING WAS PREPARED AT THE SCALE INDICATED IN THE
TITLE BLOCK. INACCURACIES IN THE STATED SCALE MAY BE
INTRODUCED WHEN DRAWINGS ARE REPRODUCED BY ANY MEANS.
USE THE GRAPHIC SCALE BAR IN THE TITLE BLOCK TO
DETERMINE THE ACTUAL SCALE OF THIS DRAWING.

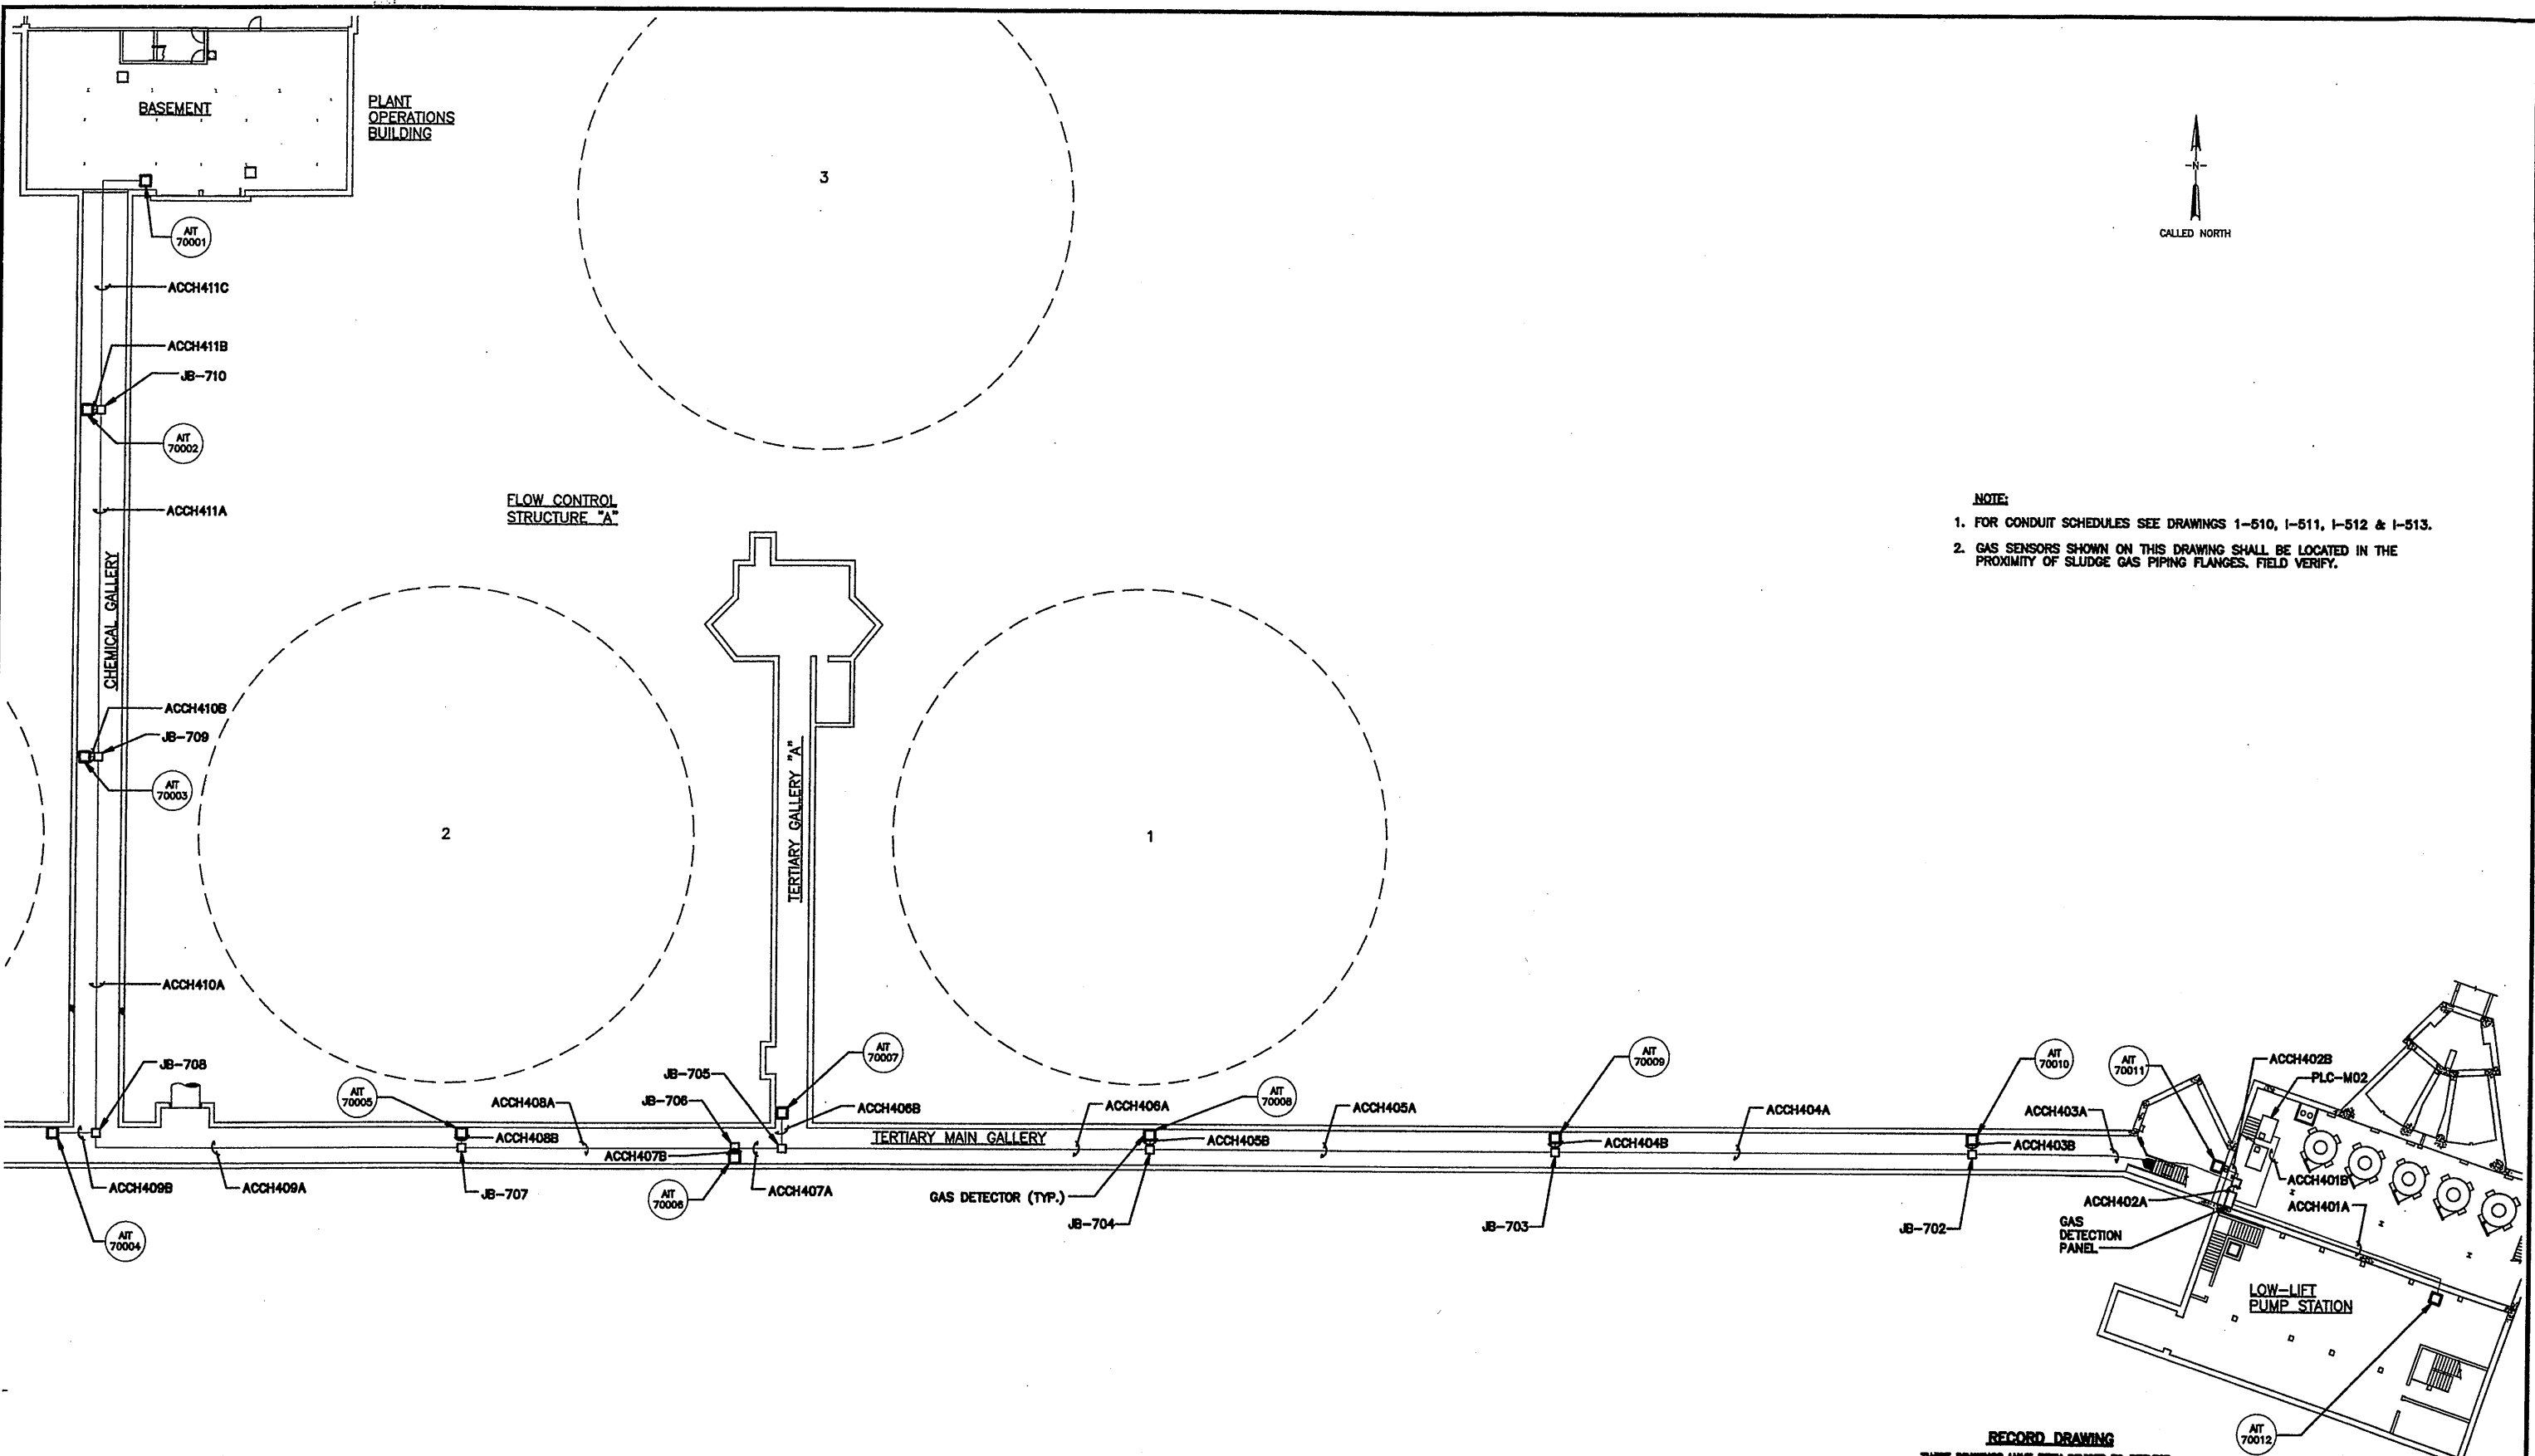

- NOTE:**
1. FOR CONDUIT SCHEDULES SEE DRAWINGS 1-510, 1-511, 1-512 & 1-513.
 2. GAS SENSORS SHOWN ON THIS DRAWING SHALL BE LOCATED IN THE PROXIMITY OF SLUDGE GAS PIPING FLANGES. FIELD VERIFY.

Layer: ON=*, OFF=*REF*
 4/11/01 BBL DCC
 05503000/055031701.dwg

RECORD DRAWING
 THESE DRAWINGS HAVE BEEN REVIEWED TO REFLECT
 MAKE CHANGES, IF ANY, WHICH OCCURRED DURING
 CONSTRUCTION. REVISIONS ARE BASED UPON
 INFORMATION SUPPLIED BY CONTRACTOR.
 DWG: *Wzlor* PER: *Rampollet*
 THIS DRAWING WAS PREPARED AT THE SCALE INDICATED IN THE
 TITLE BLOCK. INACCURACIES IN THE STATED SCALE MAY BE
 INTRODUCED WHEN DRAWINGS ARE REPRODUCED BY ANY MEANS.
 USE THE GRAPHIC SCALE BAR IN THE TITLE BLOCK TO
 DETERMINE THE ACTUAL SCALE OF THIS DRAWING.

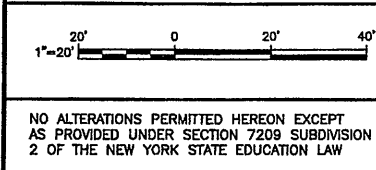

| No. | Date | Revisions | Init |
|-----|----------|---------------------|-----------|
| 0 | 4/20/01 | ISSUED FOR APPROVAL | <i>TL</i> |
| 1 | 7/11/01 | AS BID | |
| 2 | 10/31/05 | RECORD DRAWING | |

In charge of TEL
 Designed by AHL
 Drawn by DCC
 Checked by TEL

ENVIRONMENTAL ENGINEERING ASSOCIATES, LLP
 SYRACUSE, NEW YORK

ONONDAGA COUNTY • DEPARTMENT OF DRAINAGE AND SANITATION • SYRACUSE, NEW YORK
 METROPOLITAN SYRACUSE WASTEWATER TREATMENT PLANT
 STAGE III AMMONIA AND STAGE II PHOSPHORUS REMOVAL PROJECT
GALLERY GAS DETECTION SYSTEM
 INSTRUMENTATION

STATE OF NEW YORK
 LEONARD J. CAMPOLLET
 LICENSED PROFESSIONAL ENGINEER
 No. 80785

File Number
 00659
 Date
 APRIL 2001
Rampollet

1-701

LEGEND:

Layer: ON=*, OFF=REF

4/23/01 BBL DCC
05503000/0659E001.DWG

NOT TO SCALE

| No. | Date | Revisions | Init |
|-----|----------|---------------------|------|
| 0 | 4/20/01 | ISSUED FOR APPROVAL | LJC |
| 1 | | AS BID | |
| 2 | 10/31/05 | RECORD DRAWING | |

In charge of TEL
 Designed by TEL, AHL
 Drawn by DCC
 Checked by WFH

ENVIRONMENTAL ENGINEERING ASSOCIATES, LLP
 SYRACUSE, NEW YORK




ONONDAGA COUNTY • DEPARTMENT OF DRAINAGE AND SANITATION • SYRACUSE, NEW YORK
 METROPOLITAN SYRACUSE WASTEWATER TREATMENT PLANT
 STAGE III AMMONIA AND STAGE II PHOSPHORUS REMOVAL PROJECT

GENERAL NOTES, LEGEND & ABBREVIATIONS
 ELECTRICAL

RECORD DRAWING
 THESE DRAWINGS HAVE BEEN REVIEWED TO REFLECT MAJOR CHANGES IF ANY, WHICH OCCURRED DURING CONSTRUCTION. REVISIONS ARE BASED UPON INFORMATION SUPPLIED BY CONTRACTOR.
 DATE: 10/21/05 FOR: Kampalet

THIS DRAWING WAS PREPARED AT THE SCALE INDICATED IN THE TITLE BLOCK. INACCURACIES IN THE STATED SCALE MAY BE INTRODUCED WHEN DRAWINGS ARE REPRODUCED BY ANY MEANS. USE THE GRAPHIC SCALE BAR IN THE TITLE BLOCK TO DETERMINE THE ACTUAL SCALE OF THIS DRAWING.

File Number: 00659
 Date: APRIL 2001
 E-001

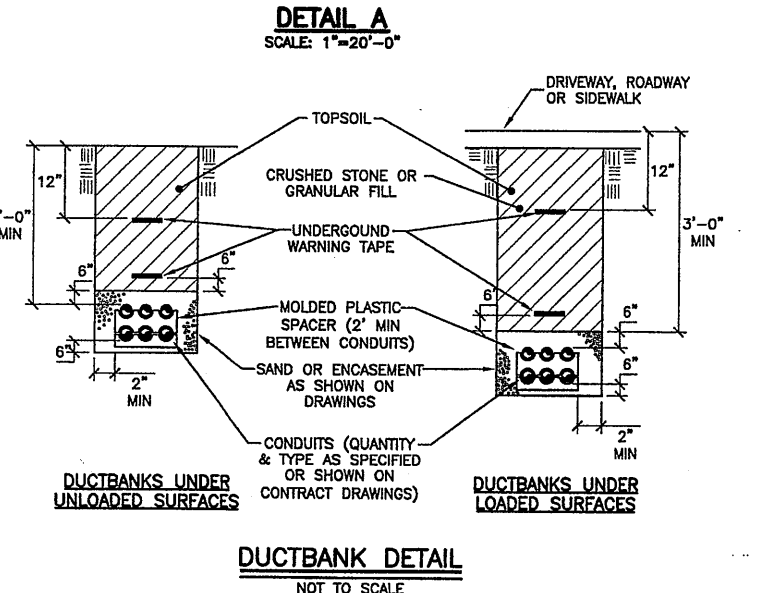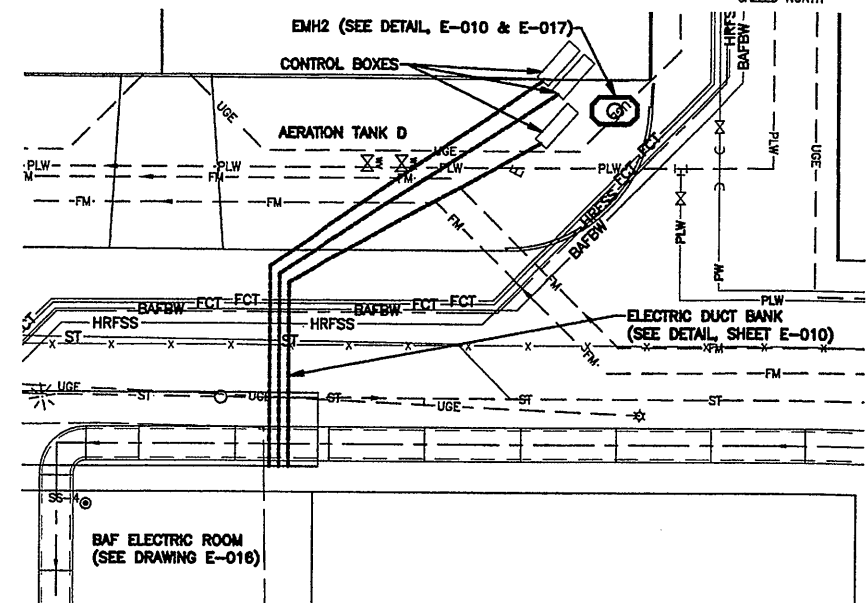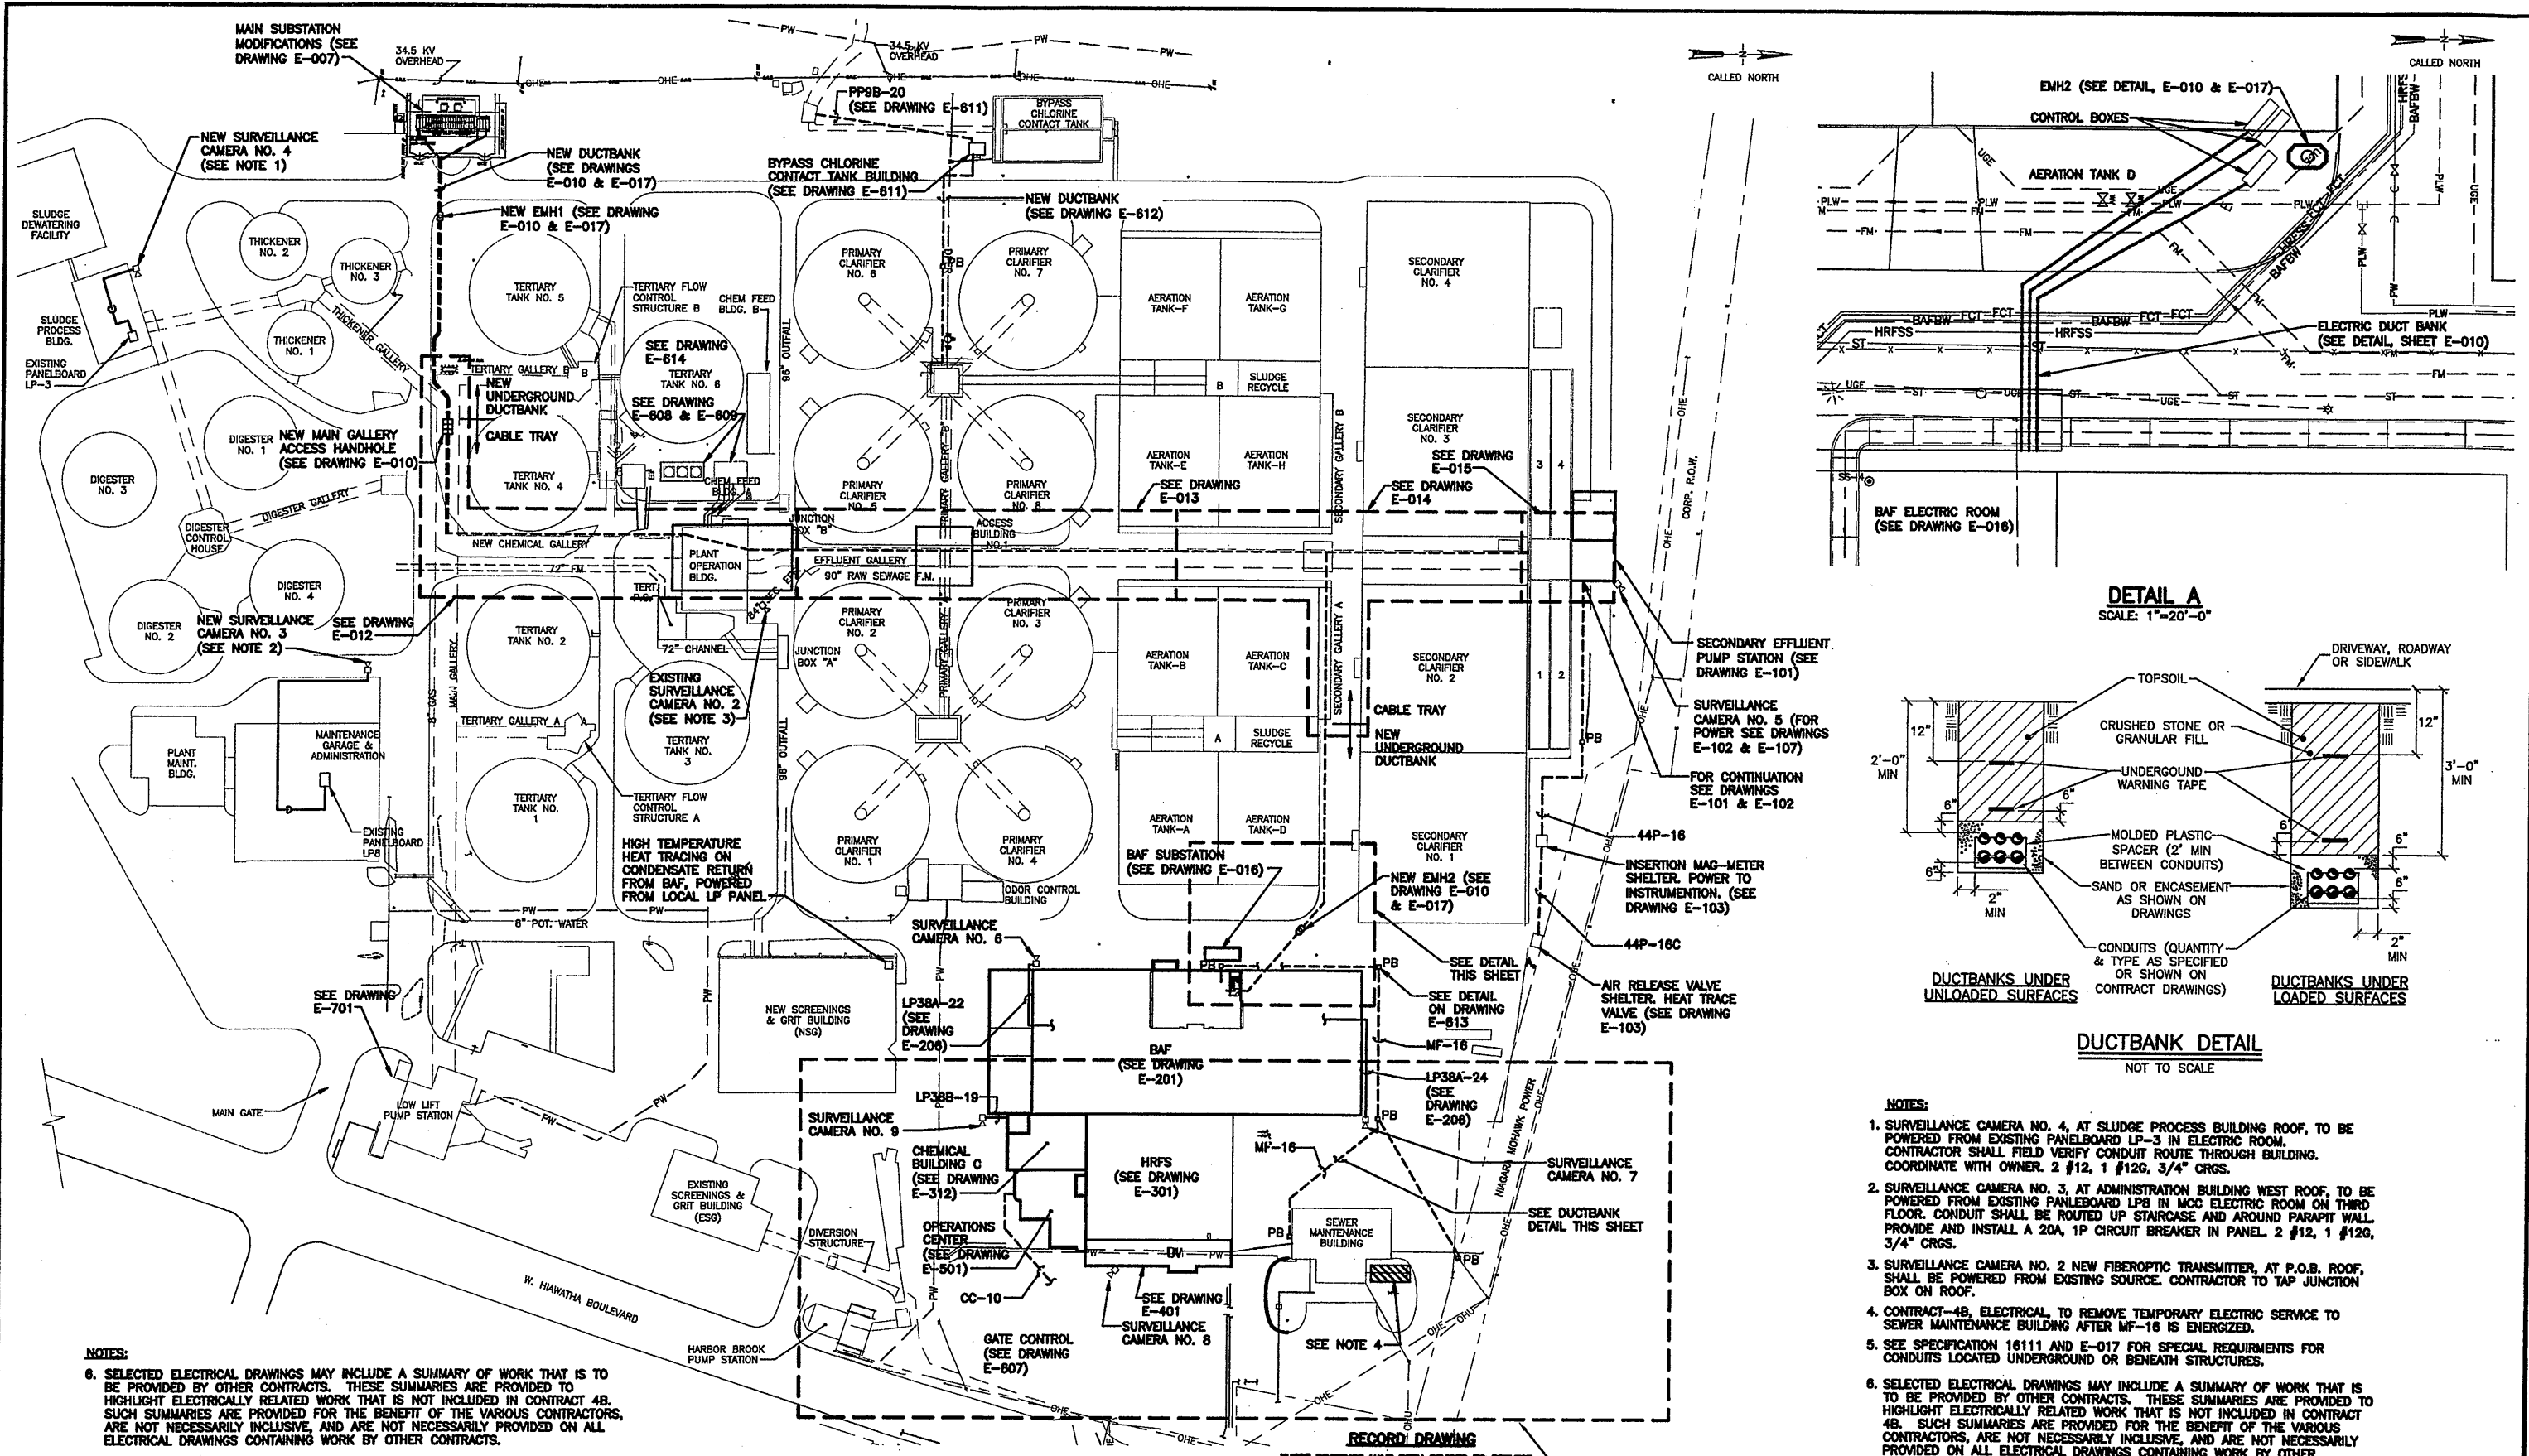

- NOTES:**
- SURVEILLANCE CAMERA NO. 4, AT SLUDGE PROCESS BUILDING ROOF, TO BE POWERED FROM EXISTING PANELBOARD LP-3 IN ELECTRIC ROOM. CONTRACTOR SHALL FIELD VERIFY CONDUIT ROUTE THROUGH BUILDING. COORDINATE WITH OWNER. 2 #12, 1 #12G, 3/4" CRGS.
 - SURVEILLANCE CAMERA NO. 3, AT ADMINISTRATION BUILDING WEST ROOF, TO BE POWERED FROM EXISTING PANELBOARD LP8 IN MCC ELECTRIC ROOM ON THIRD FLOOR. CONDUIT SHALL BE ROUTED UP STAIRCASE AND AROUND PARAPET WALL. PROVIDE AND INSTALL A 20A, 1P CIRCUIT BREAKER IN PANEL 2 #12, 1 #12G, 3/4" CRGS.
 - SURVEILLANCE CAMERA NO. 2 NEW FIBEROPTIC TRANSMITTER, AT P.O.B. ROOF, SHALL BE POWERED FROM EXISTING SOURCE. CONTRACTOR TO TAP JUNCTION BOX ON POWER.
 - CONTRACT-4B, ELECTRICAL TO REMOVE TEMPORARY ELECTRIC SERVICE TO SEWER MAINTENANCE BUILDING AFTER MF-16 IS ENERGIZED.
 - SEE SPECIFICATION 18111 AND E-017 FOR SPECIAL REQUIREMENTS FOR CONDUITS LOCATED UNDERGROUND OR BENEATH STRUCTURES.
 - SELECTED ELECTRICAL DRAWINGS MAY INCLUDE A SUMMARY OF WORK THAT IS TO BE PROVIDED BY OTHER CONTRACTS. THESE SUMMARIES ARE PROVIDED TO HIGHLIGHT ELECTRICALLY RELATED WORK THAT IS NOT INCLUDED IN CONTRACT 4B. SUCH SUMMARIES ARE PROVIDED FOR THE BENEFIT OF THE VARIOUS CONTRACTORS, ARE NOT NECESSARILY INCLUSIVE, AND ARE NOT NECESSARILY PROVIDED ON ALL ELECTRICAL DRAWINGS CONTAINING WORK BY OTHER CONTRACTS.

NOTES:

6. SELECTED ELECTRICAL DRAWINGS MAY INCLUDE A SUMMARY OF WORK THAT IS TO BE PROVIDED BY OTHER CONTRACTS. THESE SUMMARIES ARE PROVIDED TO HIGHLIGHT ELECTRICALLY RELATED WORK THAT IS NOT INCLUDED IN CONTRACT 4B. SUCH SUMMARIES ARE PROVIDED FOR THE BENEFIT OF THE VARIOUS CONTRACTORS, ARE NOT NECESSARILY INCLUSIVE, AND ARE NOT NECESSARILY PROVIDED ON ALL ELECTRICAL DRAWINGS CONTAINING WORK BY OTHER CONTRACTS.

SITE PLAN
SCALE: 1"=80'-0"

RECORD DRAWING
THESE CHANGES HAVE BEEN MADE TO REFLECT MAJOR CHANGES, IF ANY, WHICH OCCURRED DURING COMMERCIAL REVIEW. ARE BASED UPON INFORMATION SUPPLIED BY CONTRACTOR.
DATE: 10/21/05 FOR: Skampolot

Layer: ON=*, OFF=*REF*
X: 0659X048, FOOTPRINT1.DWG
4/10/00 BBL DCC
05503000/0659E002.DWG

| | | | |
|--------|---|-----|------|
| 1"=80' | 0 | 80' | 160' |
|--------|---|-----|------|

NO ALTERATIONS PERMITTED HEREON EXCEPT AS PROVIDED UNDER SECTION 7209 SUBDIVISION 2 OF THE NEW YORK STATE EDUCATION LAW

| No. | Date | Revisions | Init |
|-----|----------|---------------------|------|
| 0 | 3/30/01 | ISSUED FOR APPROVAL | LP |
| 1 | | AS BID | |
| 2 | 10/31/05 | RECORD DRAWING | |

In charge of TEL
Designed by TEL
Drawn by DCC
Checked by WFH



ENVIRONMENTAL ENGINEERING ASSOCIATES, LLP
SYRACUSE, NEW YORK

ONONDAGA COUNTY • DEPARTMENT OF DRAINAGE AND SANITATION • SYRACUSE, NEW YORK
METROPOLITAN SYRACUSE WASTEWATER TREATMENT PLANT
STAGE III AMMONIA AND STAGE II PHOSPHORUS REMOVAL PROJECT

ELECTRICAL SITE PLAN
ELECTRICAL

File Number 00659
Date APRIL 2001
E-002

Seal of the State of New York Professional Engineer License No. 60765

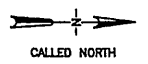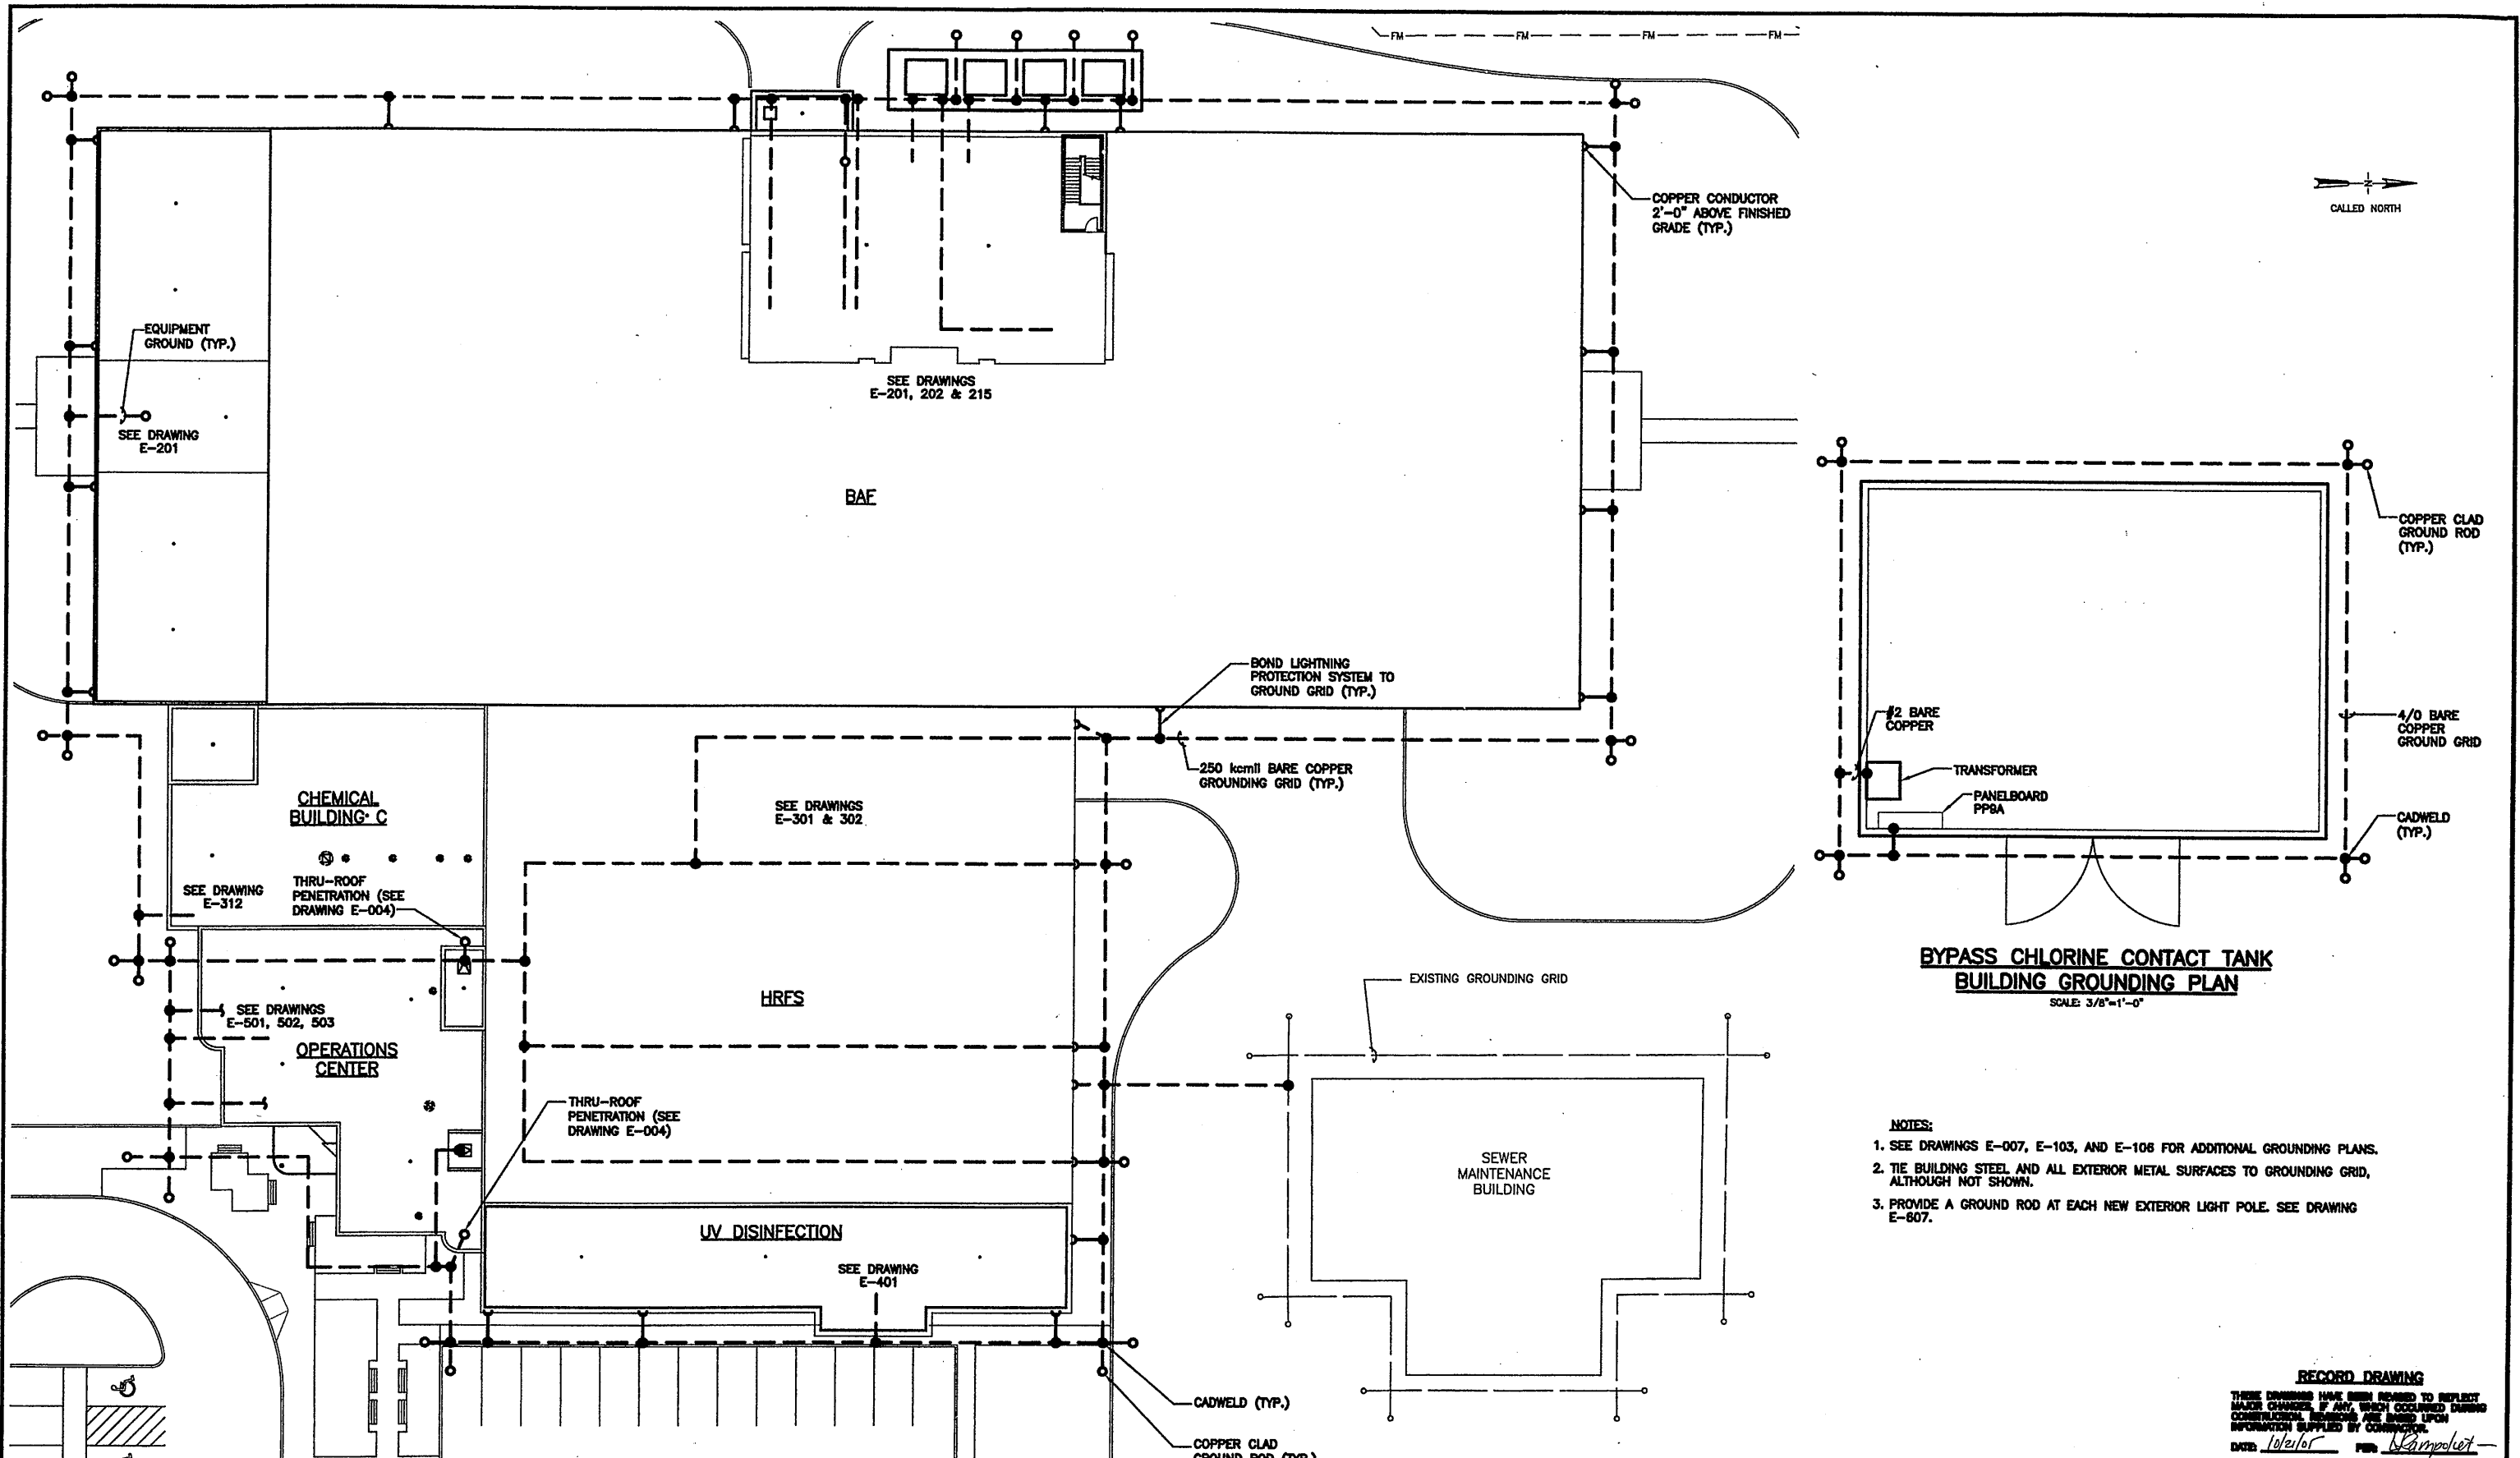

BYPASS CHLORINE CONTACT TANK BUILDING GROUNDING PLAN
SCALE: 3/8"=1'-0"


- NOTES:**
1. SEE DRAWINGS E-007, E-103, AND E-106 FOR ADDITIONAL GROUNDING PLANS.
 2. TIE BUILDING STEEL AND ALL EXTERIOR METAL SURFACES TO GROUNDING GRID, ALTHOUGH NOT SHOWN.
 3. PROVIDE A GROUND ROD AT EACH NEW EXTERIOR LIGHT POLE. SEE DRAWING E-607.

RECORD DRAWING
 THESE DRAWINGS HAVE BEEN REVISIONED TO REFLECT MAJOR CHANGES, IF ANY, WHICH OCCURRED DURING CONSTRUCTION. REVISIONS ARE BASED UPON INFORMATION SUPPLIED BY CONTRACTOR.
 DATE: 10/26/01 FOR: Kampalet

THIS DRAWING WAS PREPARED AT THE SCALE INDICATED IN THE TITLE BLOCK. INACCURACIES IN THE STATED SCALE MAY BE INTRODUCED WHEN DRAWINGS ARE REPRODUCED BY ANY MEANS. USE THE GRAPHIC SCALE BAR IN THE TITLE BLOCK TO DETERMINE THE ACTUAL SCALE OF THIS DRAWING.

L: ON=*, OFF=REF*
 X: 0659X02, 0659X048.DWG
 5/30/01 BBL DCC
 05503000/0659ED03.DWG

GROUNDING PLAN
SCALE: 1"=20'-0"

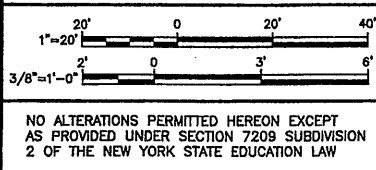

| No. | Date | Revisions | Init |
|-----|---------|---------------------|------|
| 0 | 4/20/01 | ISSUED FOR APPROVAL | TEL |
| 1 | | AS BID | |
| 2 | 0/31/08 | RECORD DRAWING | |

In charge of TEL
 Designed by MEE
 Drawn by DCC
 Checked by WFH





ONONDAGA COUNTY • DEPARTMENT OF DRAINAGE AND SANITATION • SYRACUSE, NEW YORK
 METROPOLITAN SYRACUSE WASTEWATER TREATMENT PLANT
 STAGE III AMMONIA AND STAGE II PHOSPHORUS REMOVAL PROJECT

GROUNDING PLAN

ELECTRICAL



File Number
00659
 Date
APRIL 2001
E-003

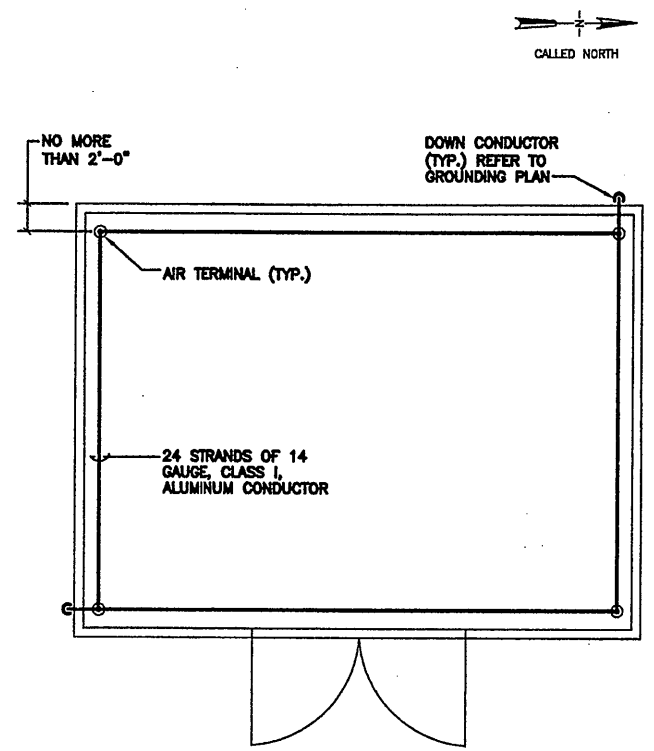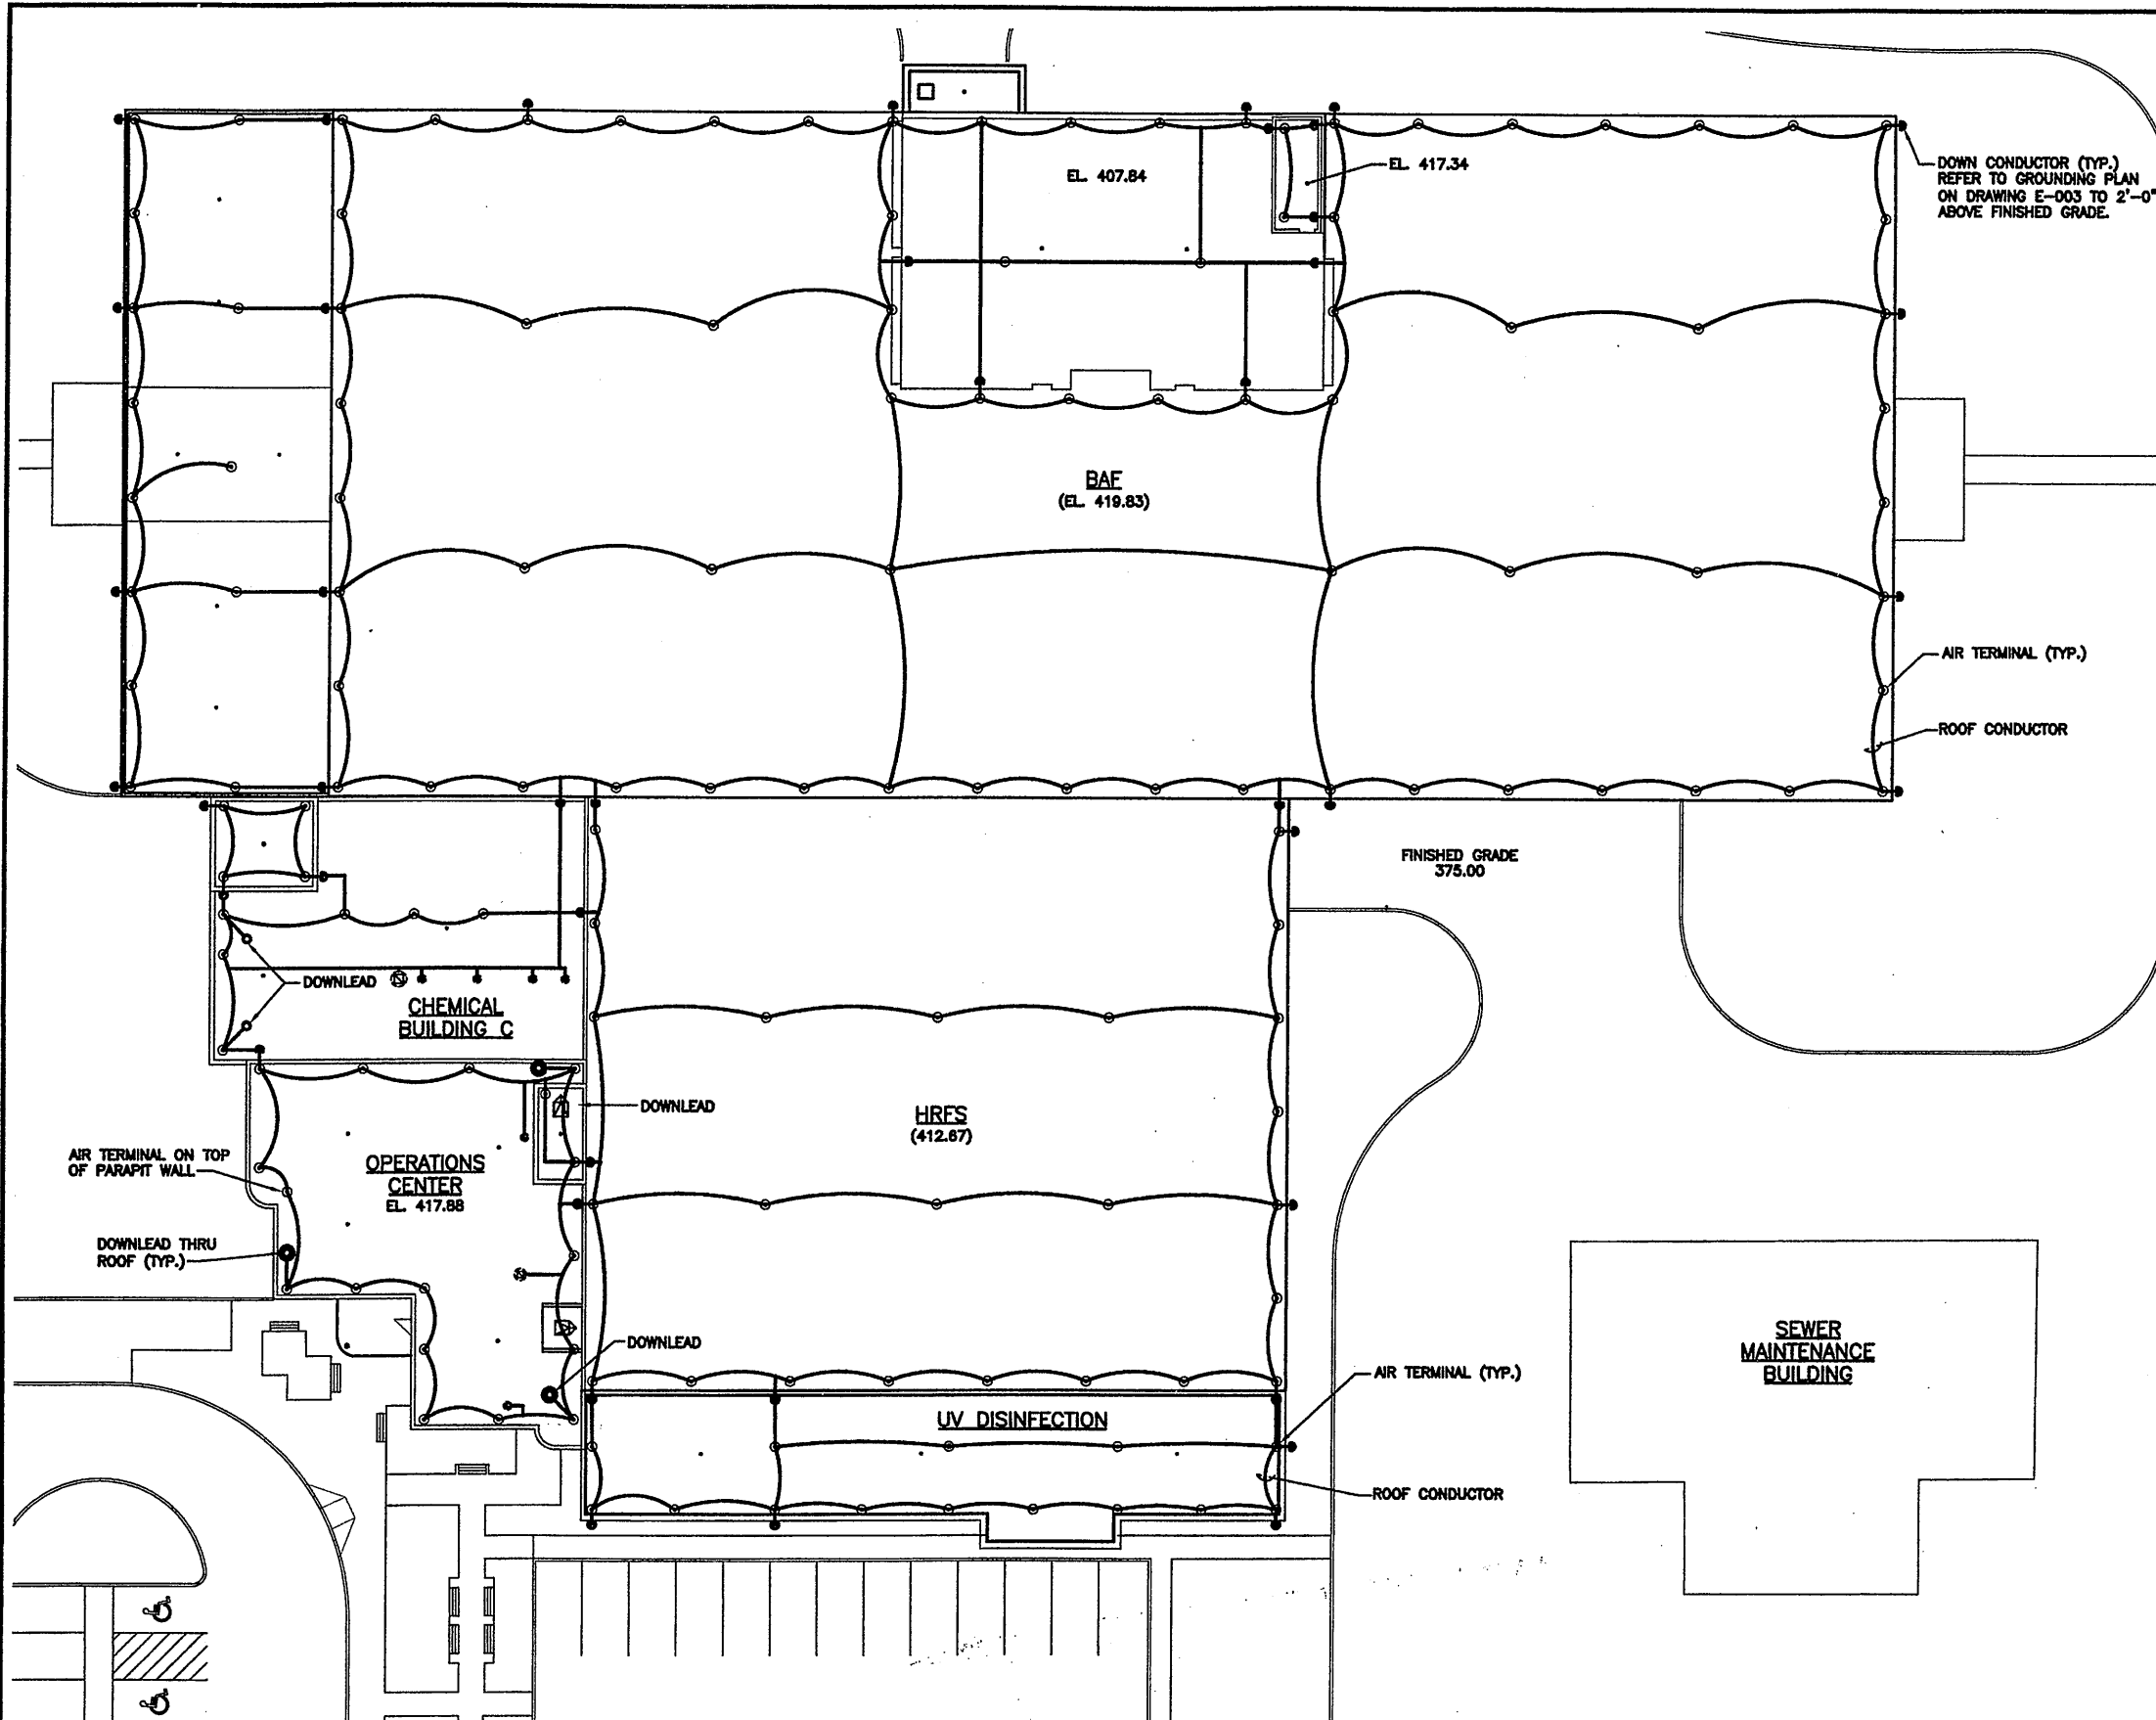

**BYPASS CHLORINE CONTACT TANK BUILDING
LIGHTNING PROTECTION PLAN**
SCALE: 3/8"=1'-0"

- NOTES:**
- SEE DRAWING E-103 FOR ADDITIONAL LIGHTNING PROTECTION.
 - BOND NEW FANS ON P.O.B. ROOF TO EXISTING LIGHTNING PROTECTION SYSTEM, SEE DRAWING E-701.
 - GROUNDING SHALL BE IN ACCORDANCE WITH THE NATIONAL ELECTRICAL CODE.
 - LIGHTNING PROTECTION SYSTEM SHALL BE IN CONFORMANCE WITH THE FOLLOWING CODES AND STANDARDS. WHERE CONFLICTS OCCUR, THE MOST STRINGENT REQUIREMENTS SHALL APPLY:
 - NFPA 780 LIGHTNING PROTECTION CODE.
 - UL98A INSTALLATION REQUIREMENTS FOR LIGHTNING PROTECTION SYSTEMS.
 - LP1-175 LIGHTNING PROTECTION INSTITUTE
 - COMPLETED LIGHTNING PROTECTION SYSTEM SHALL BEAR THE MASTER LABEL OF UNDERWRITERS LABORATORY INCORPORATED.
 - COORDINATE INSTALLATION OF GROUNDING SYSTEM WITH ALL UNDERGROUND UTILITIES, PIPING AND STRUCTURES.
 - ALL GROUND CONDUCTORS PASSING THROUGH FLOOR SLABS OR OTHER CONCRETE SHALL BE SLEEVED IN RIGID STEEL OR PVC CONDUIT. WHERE RIGID STEEL CONDUIT IS USED, CONDUCTORS SHALL BE BONDED TO SLEEVE AT EACH END.
 - ALL GROUND CONNECTIONS SUBJECT TO PHYSICAL DAMAGE SHALL BE PROTECTED BY RIGID STEEL CONDUIT BONDED TO GROUND CONDUCTOR ON EACH END.
 - CONTRACTOR SHALL BOND ALL HANDRAILS AND EXPOSED METAL FRAMEWORK IN A CONCEALED MANNER AND PROVIDE JUMPERS WHERE REQUIRED TO PROVIDE A CONTINUOUS GROUNDING SYSTEM.
 - ALL ROOF MOUNTED EQUIPMENT, HATCHES, VENT, ETC. SHALL BE CONNECTED TO LIGHTNING PROTECTION SYSTEM CONDUCTOR.
 - BOND RADIO ANTENNA (FURNISHED & INSTALLED BY OWNER) TO LIGHTNING PROTECTION SYSTEM. SEE DRAWING E-503 FOR ANTENNA LOCATION.

RECORD DRAWING
THESE CHANGES HAVE BEEN MADE TO REFLECT
MAJOR CHANGES, IF ANY, WHICH OCCURRED DURING
CONSTRUCTION. REVISIONS ARE BOUND UPON
INFORMATION SUPPLIED BY CONTRACTOR.
DATE: 10/21/05 FOR: W. Campbell

THIS DRAWING WAS PREPARED AT THE SCALE INDICATED IN THE
TITLE BLOCK. INACCURACIES IN THE STATED SCALE MAY BE
INTRODUCED WHEN DRAWINGS ARE REPRODUCED BY ANY MEANS.
USE THE GRAPHIC SCALE BAR IN THE TITLE BLOCK TO
DETERMINE THE ACTUAL SCALE OF THIS DRAWING.

LIGHTNING PROTECTION PLAN
SCALE: 1"=20'-0"

L: ON=*, OFF=REF*
X: 0658GX02, 0659X048.DWG
5/30/01 BBL DCC
05503000/0659E004.DWG

1"=20'
3/8"=1'-0"

NO ALTERATIONS PERMITTED HEREON EXCEPT
AS PROVIDED UNDER SECTION 7209 SUBDIVISION
2 OF THE NEW YORK STATE EDUCATION LAW

| No. | Date | Revisions | Init |
|-----|----------|---------------------|------|
| 0 | 4/20/01 | ISSUED FOR APPROVAL | TEL |
| 1 | | AS BID | |
| 2 | 10/31/05 | RECORD DRAWING | |

In charge of TEL
Designed by MEE
Drawn by DCC
Checked by WFH



ONONDAGA COUNTY • DEPARTMENT OF DRAINAGE AND SANITATION • SYRACUSE, NEW YORK
METROPOLITAN SYRACUSE WASTEWATER TREATMENT PLANT
STAGE III AMMONIA AND STAGE II PHOSPHORUS REMOVAL PROJECT


LIGHTNING PROTECTION PLAN

ELECTRICAL




File Number
00659
Date
APRIL 2001

E-004

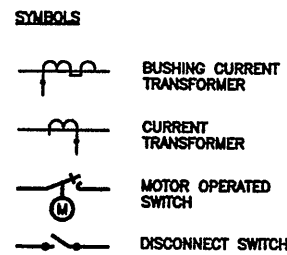

- LEGEND**
- 50 INSTANTANEOUS OVERCURRENT RELAY
 - 51 AC TIME OVERCURRENT RELAY
 - 52 POWER CIRCUIT BREAKER
 - 67 AC DIRECTIONAL OVERCURRENT RELAY
 - 86 LOCKOUT RELAY
 - 87 DIFFERENTIAL PROTECTIVE RELAY
 - 89 LINE SWITCH
 - A AMMETER
 - AS AMMETER SWITCH
 - BT BUS TIE
 - G GROUND
 - K KEY INTERLOCK
 - LTC LOAD TAP CHANGER
 - M METER, MULTIPURPOSE INCLUDING AMPS, VOLTS, WATTS, VARS, POWER FACTORS, WATTHOURS, PEAK AMPS AND PEAK WATTS
 - N NEUTRAL
 - O OPERATE COIL
 - PD POWER DISTRIBUTION FEEDER
 - PF POWER FACTOR METER
 - POL POLARIZING COIL
 - R RELAY, MULTIPURPOSE, WITH FUNCTIONS 50, 51, 50N AND 51N
 - T1 TRANSFORMER #1
 - T2 TRANSFORMER #2
 - V VOLTS
 - VS VOLT METER SWITCH
 - VAR VARMETER
- 52-1, 52-2 OIL CIRCUIT BREAKER 34.5KV, 1200A
- 52-3, 52-4, 52BT GE VERTICAL LIFT, 4.16KV, 1200A, 250MVA MAGNEBLAST BREAKERS
- PD1 - PD6 GE VERTICAL LIFT, 4.16KV, 1200A, 250MVA MAGNEBLAST BREAKERS
- PD7, PD8, GE LOAD BREAK FUSED SWITCH, DRAWOUT
- /// WORK/CHANGES THIS CONTRACT

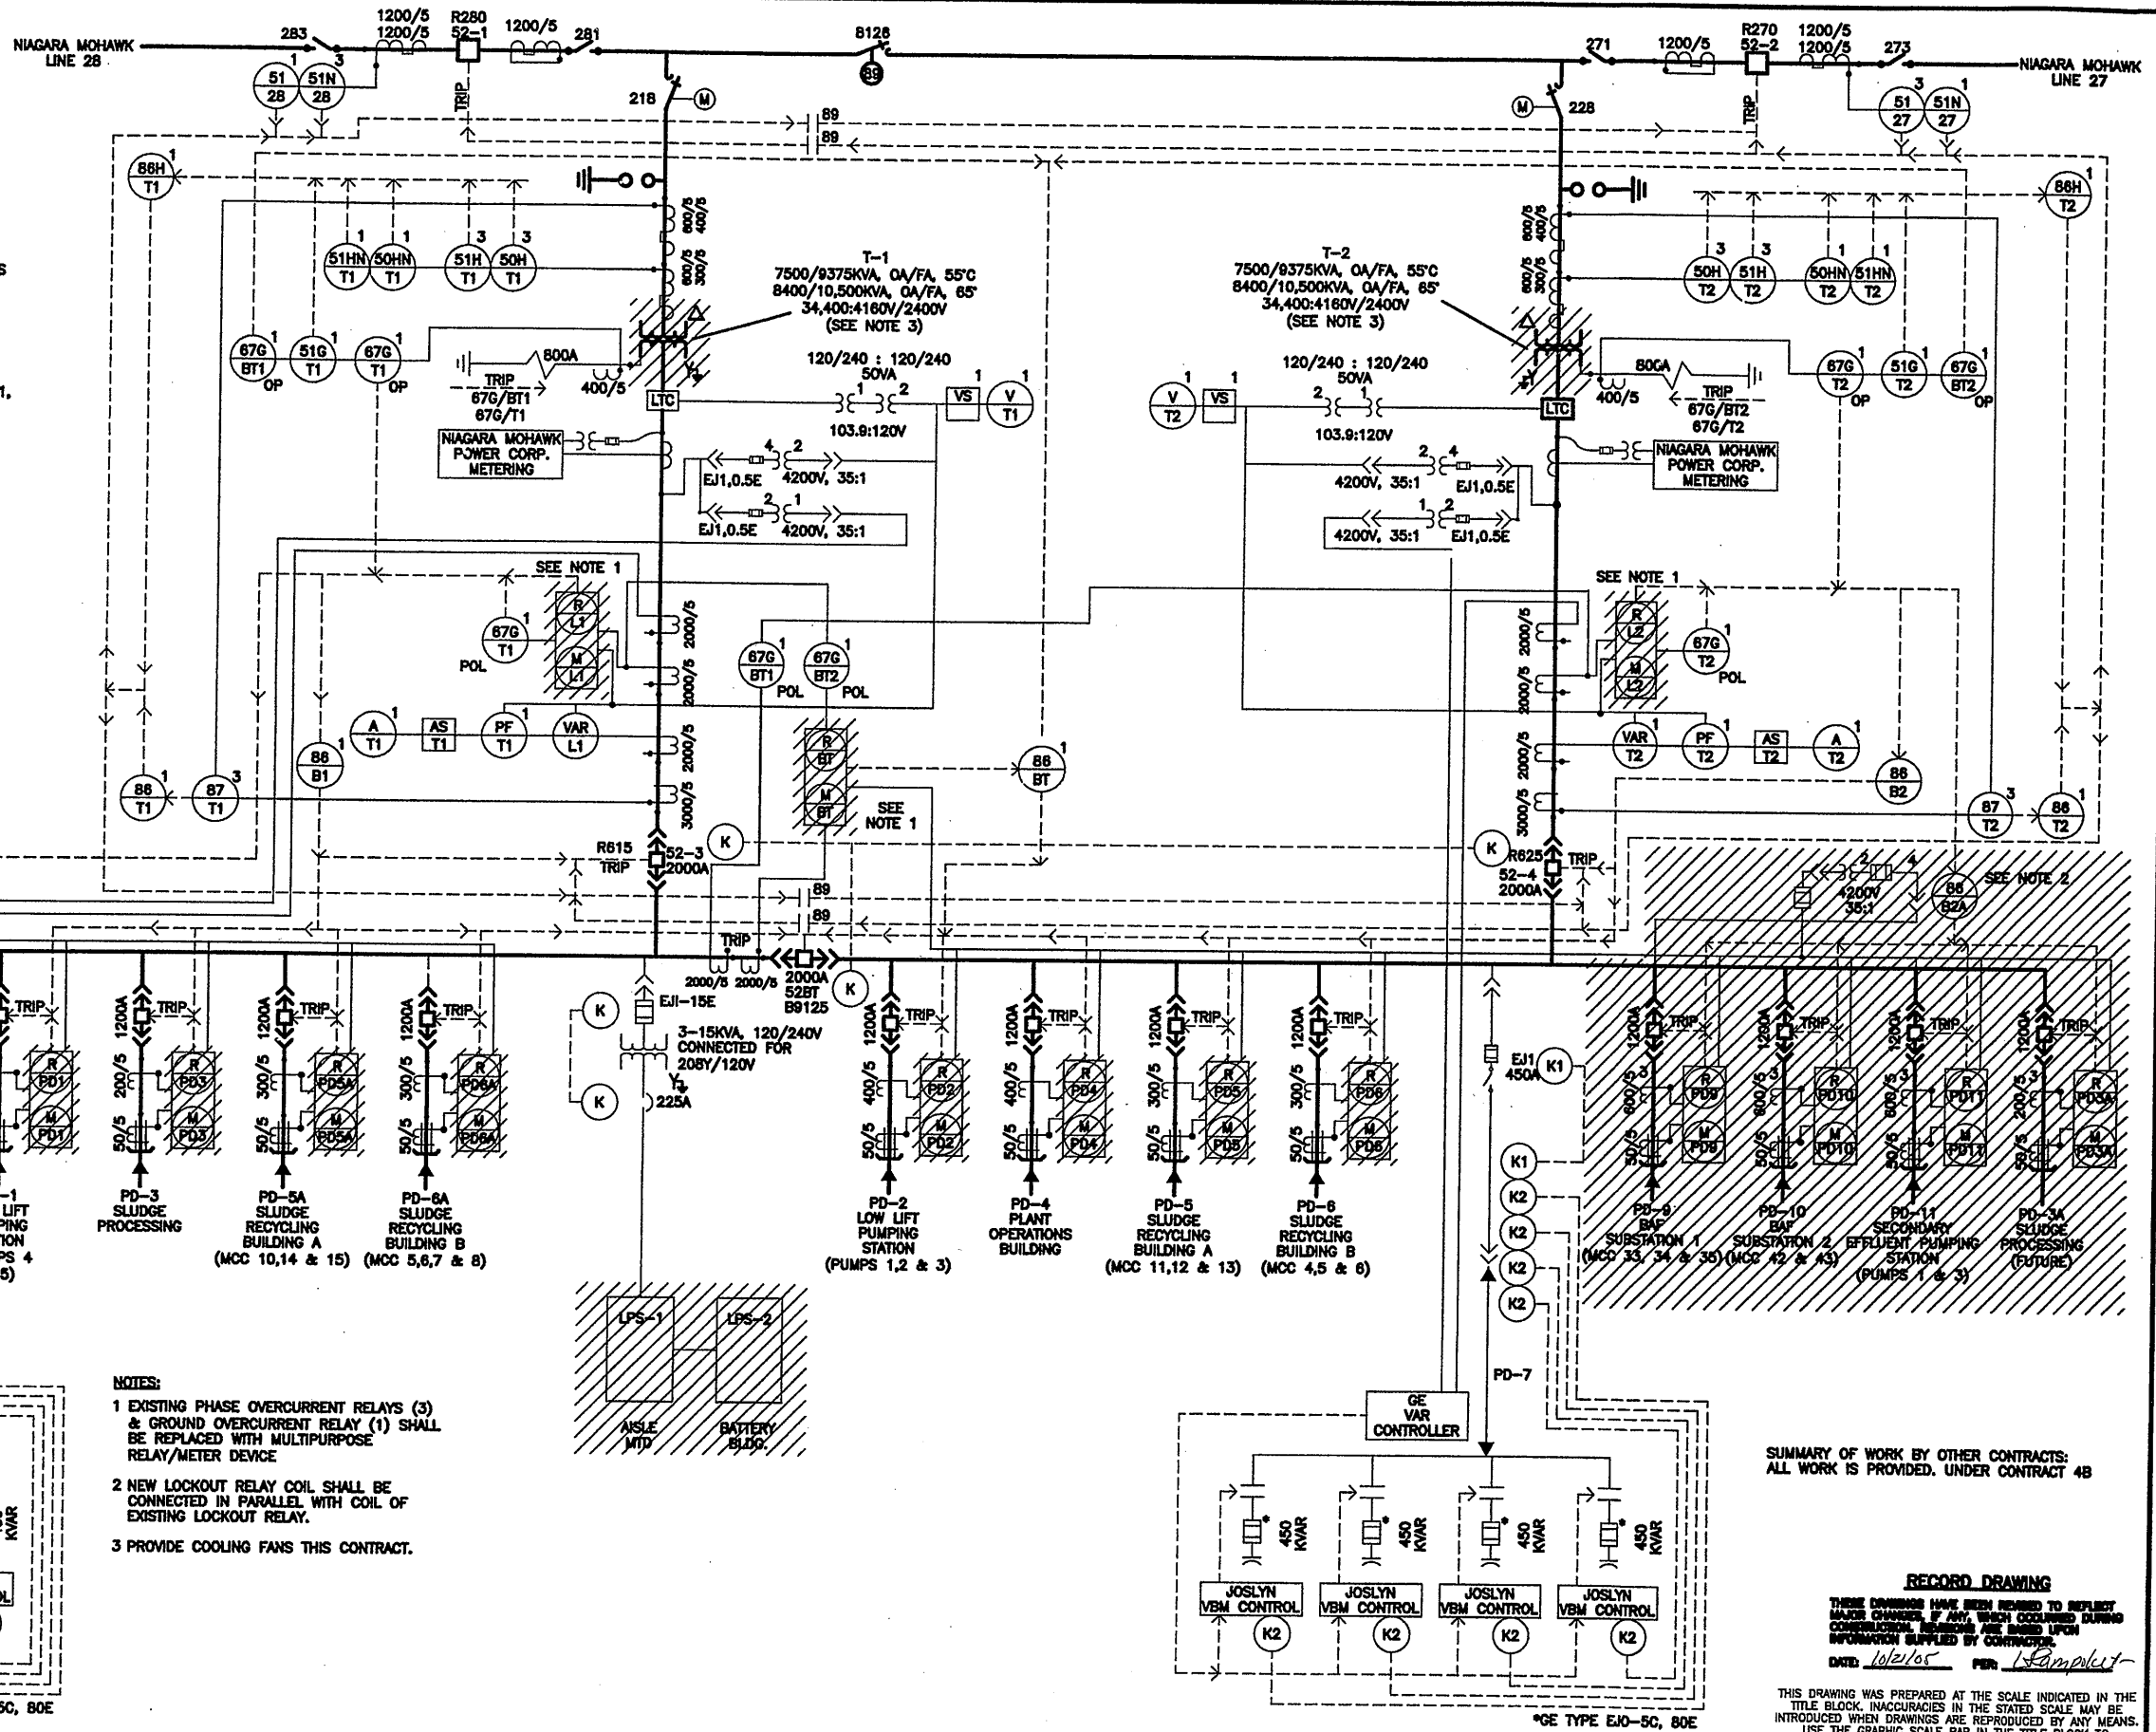

03/20/01 OBG CRV
0659E005

NO SCALE

NO ALTERATIONS PERMITTED HEREON EXCEPT AS PROVIDED UNDER SECTION 7209 SUBDIVISION 2 OF THE NEW YORK STATE EDUCATION LAW

| No. | Date | Revisions | Init |
|-----|----------|---------------------|------|
| 0 | 4/20/01 | ISSUED FOR APPROVAL | |
| 1 | | AS BID | |
| 2 | 10/31/05 | RECORD DRAWING | |


In charge of ___ TEL ___
Designed by ___ RAC ___
Drawn by ___ CRV ___
Checked by ___ WFH ___




ONONDAGA COUNTY • DEPARTMENT OF DRAINAGE AND SANITATION • SYRACUSE, NEW YORK
METROPOLITAN SYRACUSE WASTEWATER TREATMENT PLANT
STAGE III AMMONIA AND STAGE II PHOSPHORUS REMOVAL PROJECT

**ONE-LINE
MAIN SUBSTATION**

ELECTRICAL

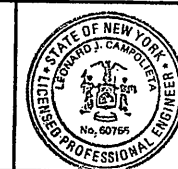

File Number
00659E005
Date
APRIL 2001
E-005
[Signature]

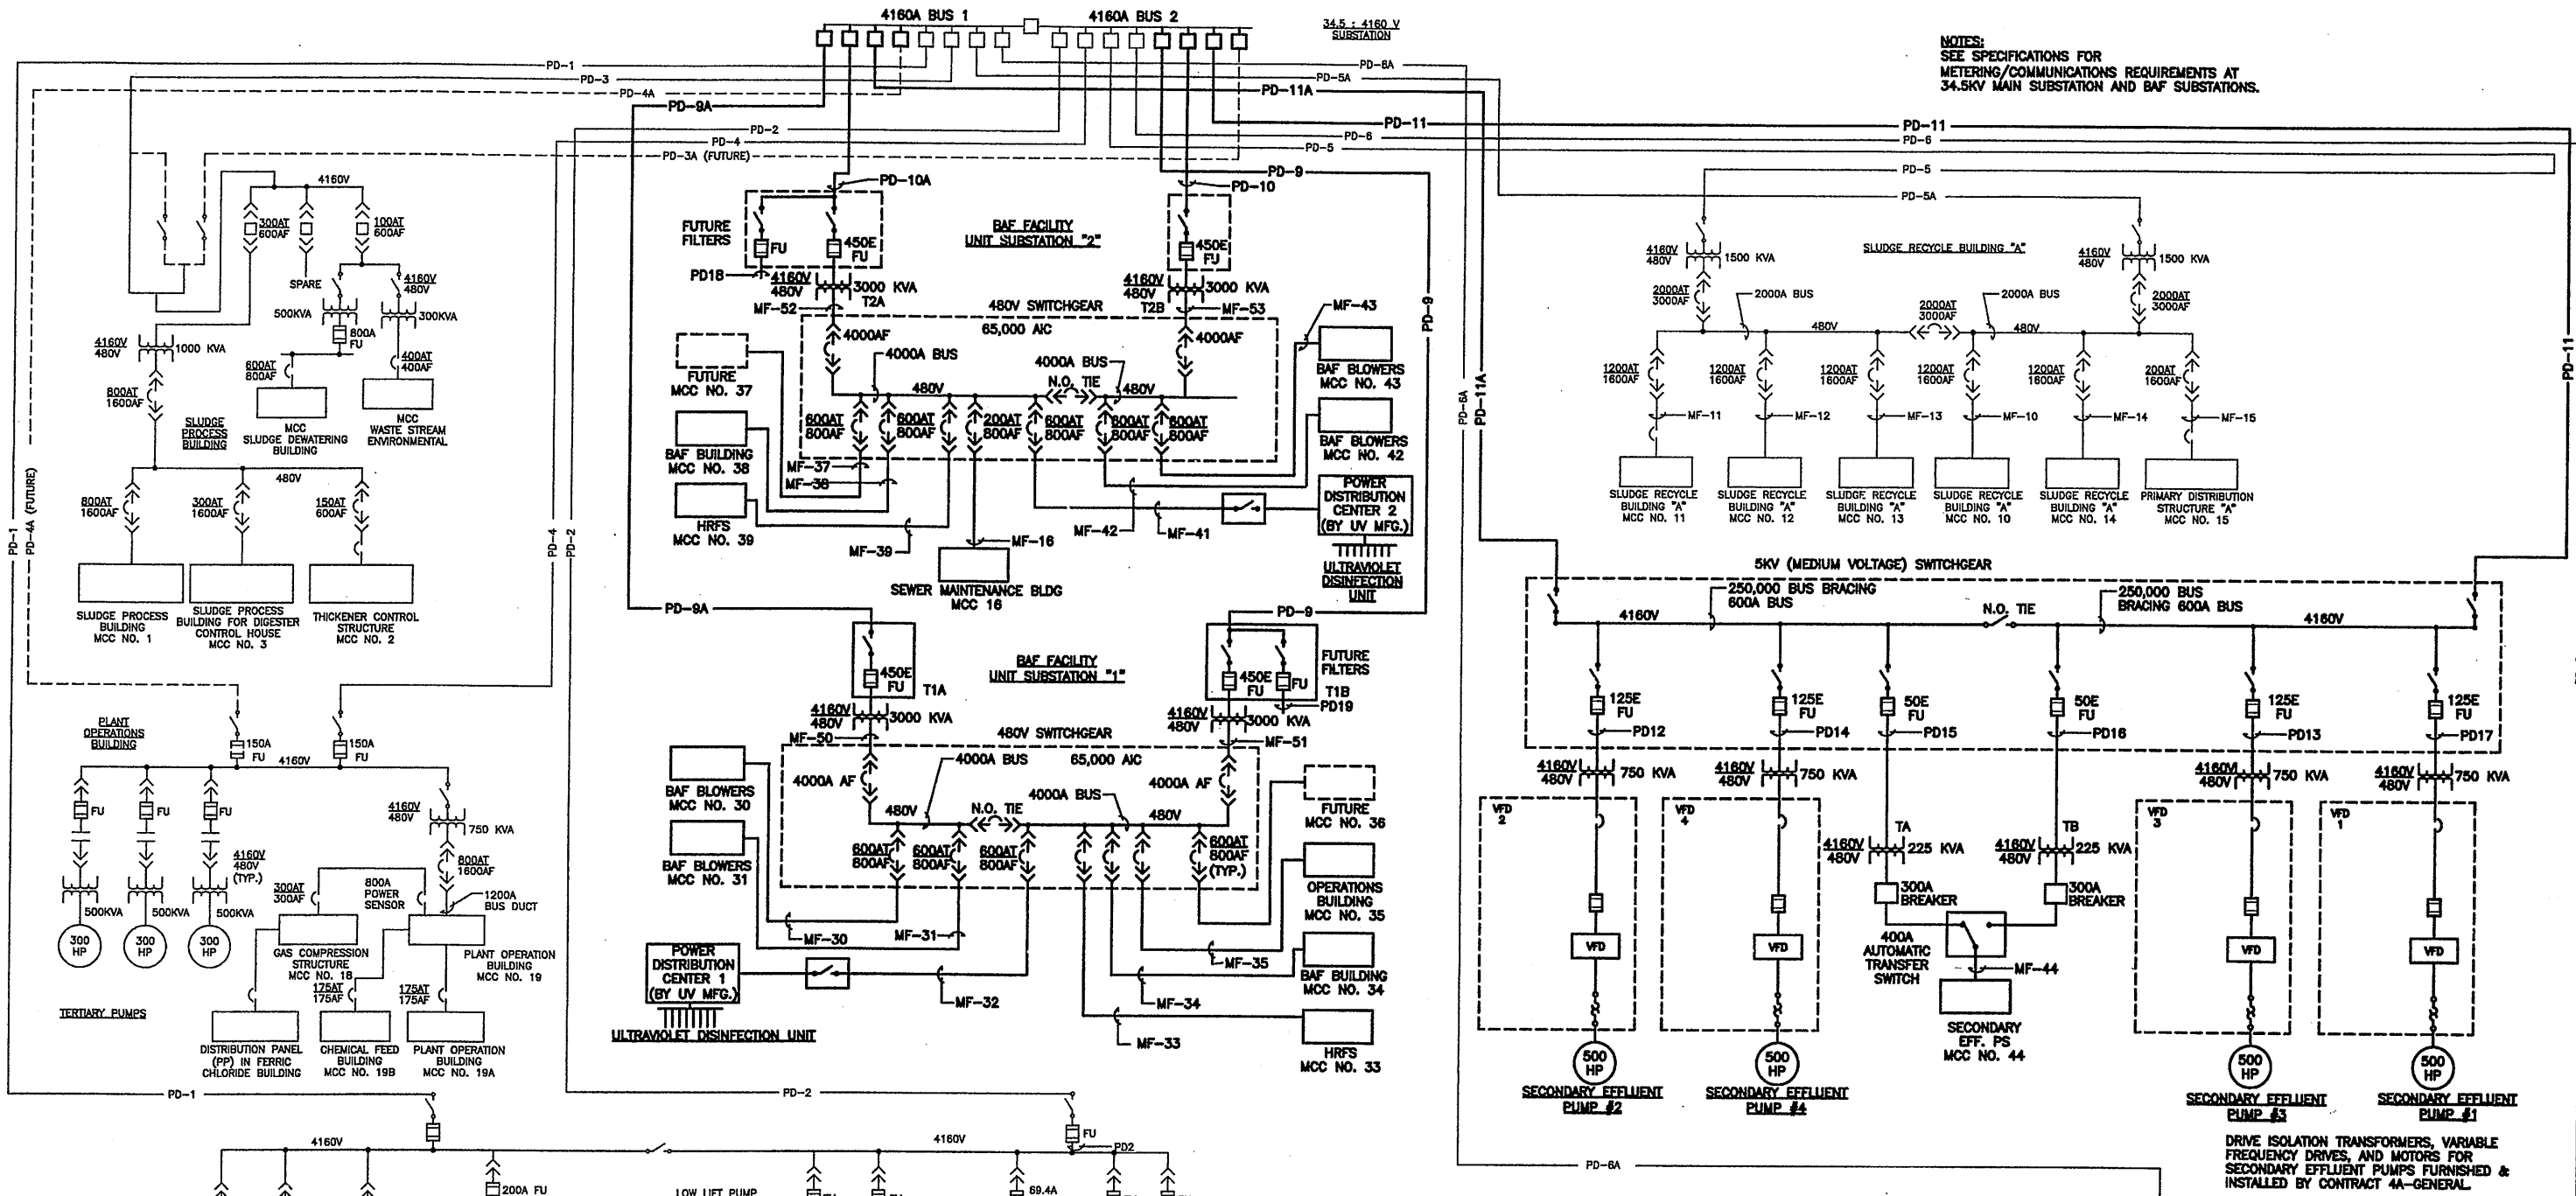

NOTES:
SEE SPECIFICATIONS FOR
METERING/COMMUNICATIONS REQUIREMENTS AT
34.5KV MAIN SUBSTATION AND BAF SUBSTATIONS.

DRIVE ISOLATION TRANSFORMERS, VARIABLE
FREQUENCY DRIVES, AND MOTORS FOR
SECONDARY EFFLUENT PUMPS FURNISHED &
INSTALLED BY CONTRACT 4A-GENERAL.

SUMMARY OF WORK BY OTHER CONTRACTS:
SEE PLAN DRAWINGS FOR WORK PERFORMED
BY OTHER CONTRACTS

RECORD DRAWING

THESE DRAWINGS HAVE BEEN REVISIONED TO REFLECT
CHANGES WHICH OCCURRED DURING
CONSTRUCTION. REVISIONS ARE BASED UPON
INFORMATION SUPPLIED BY CONTRACTOR.

DATE: 10/21/05 PER: [Signature]

THIS DRAWING WAS PREPARED AT THE SCALE INDICATED IN THE
TITLE BLOCK. INACCURACIES IN THE STATED SCALE MAY BE
INTRODUCED WHEN DRAWINGS ARE REPRODUCED BY ANY MEANS.
USE THE GRAPHIC SCALE BAR IN THE TITLE BLOCK TO
DETERMINE THE ACTUAL SCALE OF THIS DRAWING.

03/20/01 086 CRV
0659

NOT TO SCALE

NO ALTERATIONS PERMITTED HEREON EXCEPT
AS PROVIDED UNDER SECTION 7209 SUBDIVISION
2 OF THE NEW YORK STATE EDUCATION LAW

| No. | Date | Revisions | Init |
|-----|----------|---------------------|-------------|
| 0 | 4/20/01 | ISSUED FOR APPROVAL | [Signature] |
| 1 | | AS BID | |
| 2 | 10/31/05 | RECORD DRAWING | |

In charge of: TEL
Designed by: RAC
Drawn by: CRV
Checked by: WFH

ENVIRONMENTAL ENGINEERING ASSOCIATES, LLP
SYRACUSE, NEW YORK

ONONDAGA COUNTY • DEPARTMENT OF DRAINAGE AND SANITATION • SYRACUSE, NEW YORK
METROPOLITAN SYRACUSE WASTEWATER TREATMENT PLANT
STAGE III AMMONIA AND STAGE II PHOSPHORUS REMOVAL PROJECT

**ONE-LINE
5KV DISTRIBUTION SYSTEM**


ELECTRICAL

File Number
00659E006

Date
APRIL 2001

E-006

[Professional Engineer Seal]

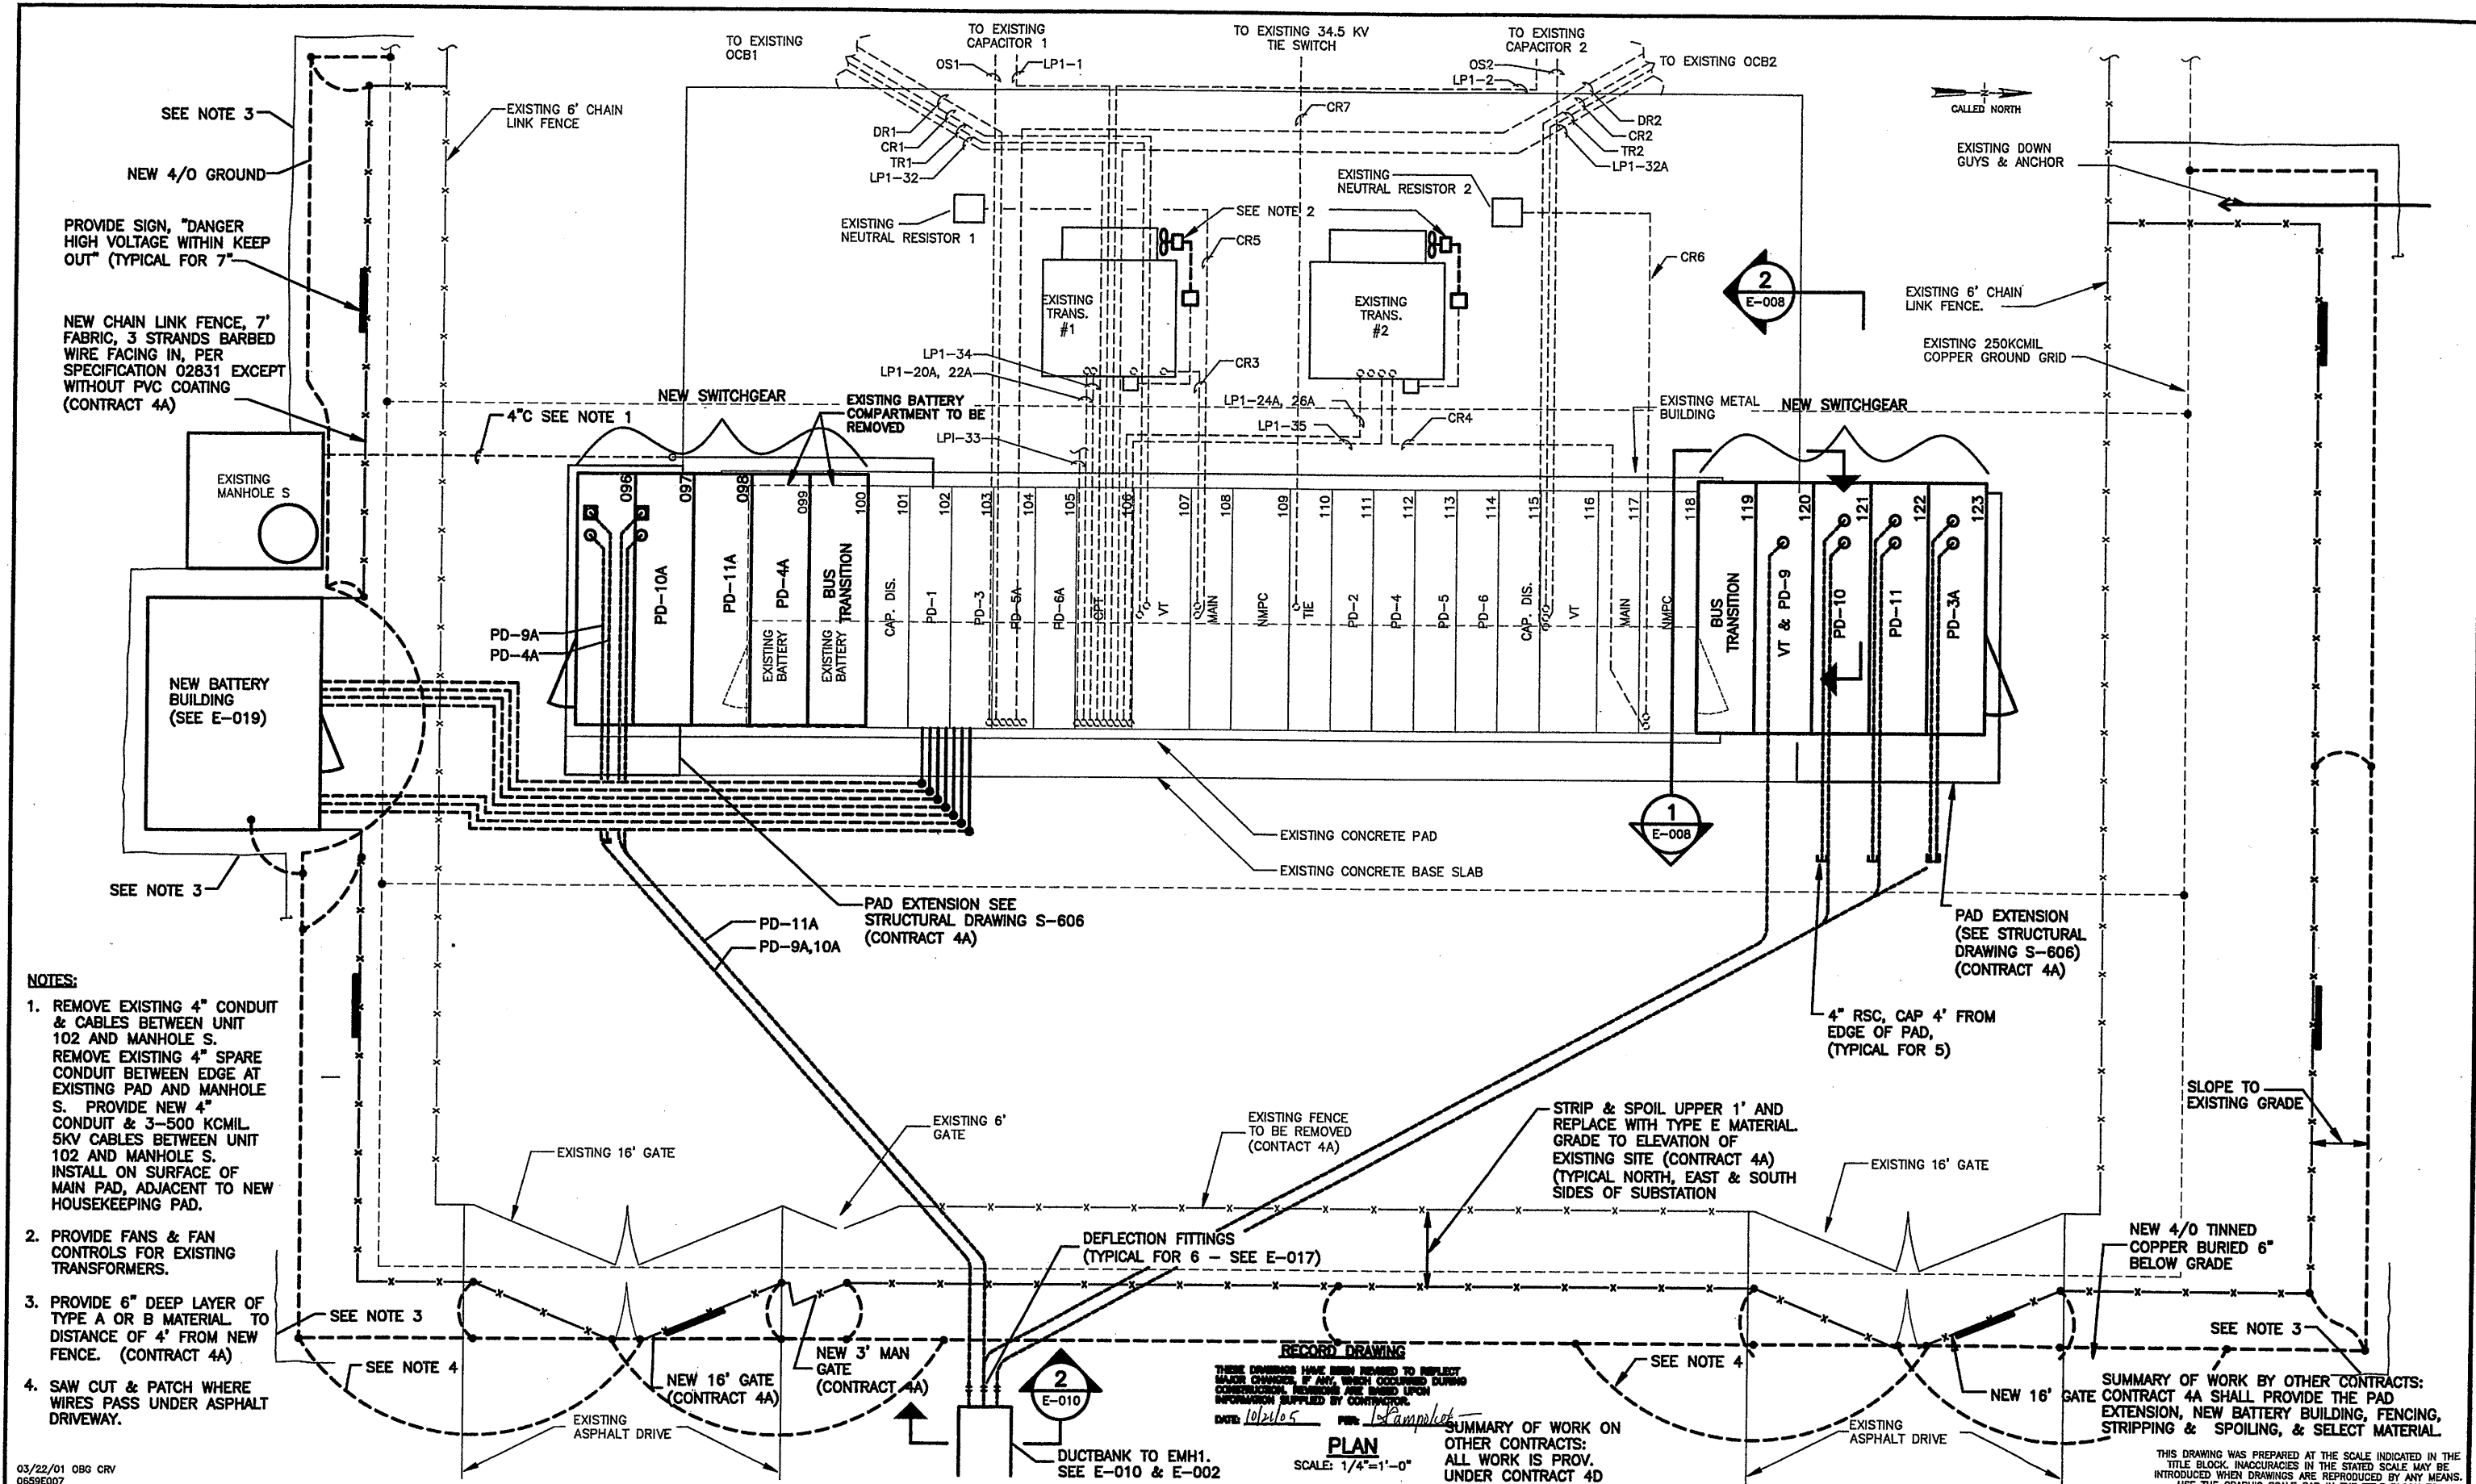

- NOTES:**
1. REMOVE EXISTING 4" CONDUIT & CABLES BETWEEN UNIT 102 AND MANHOLE S. REMOVE EXISTING 4" SPARE CONDUIT BETWEEN EDGE AT EXISTING PAD AND MANHOLE S. PROVIDE NEW 4" CONDUIT & 3-500 KCMIL 5KV CABLES BETWEEN UNIT 102 AND MANHOLE S. INSTALL ON SURFACE OF MAIN PAD, ADJACENT TO NEW HOUSEKEEPING PAD.
 2. PROVIDE FANS & FAN CONTROLS FOR EXISTING TRANSFORMERS.
 3. PROVIDE 6" DEEP LAYER OF TYPE A OR B MATERIAL TO DISTANCE OF 4' FROM NEW FENCE. (CONTRACT 4A)
 4. SAW CUT & PATCH WHERE WIRES PASS UNDER ASPHALT DRIVEWAY.

03/22/01 OBG CRV
0659E007

1/4"=1'-0"

NO ALTERATIONS PERMITTED HEREON EXCEPT AS PROVIDED UNDER SECTION 7209 SUBDIVISION 2 OF THE NEW YORK STATE EDUCATION LAW

| No. | Date | Revisions | Init |
|-----|----------|---------------------|------|
| 0 | 4/20/01 | ISSUED FOR APPROVAL | TEL |
| 1 | | AS BID | |
| 2 | 10/31/05 | RECORD DRAWING | |

In charge of TEL
Designed by RAC
Drawn by CRV
Checked by WFH

ENVIRONMENTAL ENGINEERING ASSOCIATES, LLP
SYRACUSE, NEW YORK

RECORD DRAWING
THESE CHANGES HAVE BEEN MADE TO REFLECT MAJOR CHANGES IF ANY, WHICH OCCURRED DURING CONSTRUCTION. REVISIONS ARE BASED UPON INFORMATION SUPPLIED BY CONTRACTOR.
DATE 10/21/05 FOR [Signature]

SUMMARY OF WORK ON OTHER CONTRACTS:
ALL WORK IS PROV. UNDER CONTRACT 4D

ONONDAGA COUNTY • DEPARTMENT OF DRAINAGE AND SANITATION • SYRACUSE, NEW YORK
METROPOLITAN SYRACUSE WASTEWATER TREATMENT PLANT
STAGE III AMMONIA AND STAGE II PHOSPHORUS REMOVAL PROJECT

MAIN SUBSTATION PLAN


ELECTRICAL

SUMMARY OF WORK BY OTHER CONTRACTS:
CONTRACT 4A SHALL PROVIDE THE PAD EXTENSION, NEW BATTERY BUILDING, FENCING, STRIPPING & SPOILING, & SELECT MATERIAL


THIS DRAWING WAS PREPARED AT THE SCALE INDICATED IN THE TITLE BLOCK. INACCURACIES IN THE STATED SCALE MAY BE INTRODUCED WHEN DRAWINGS ARE REPRODUCED BY ANY MEANS. USE THE GRAPHIC SCALE BAR IN THE TITLE BLOCK TO DETERMINE THE ACTUAL SCALE OF THIS DRAWING.

File Number 00659
Date APRIL 2001
[Signature]


E-007

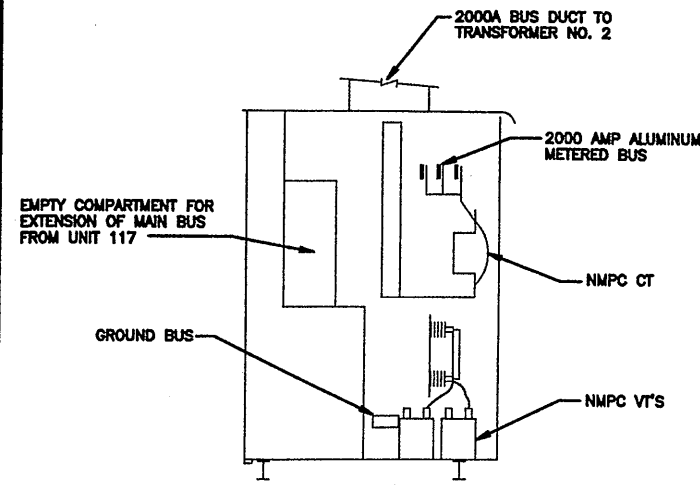


SECTION VIEW
NMPC METERING - UNIT 118
NOT TO SCALE

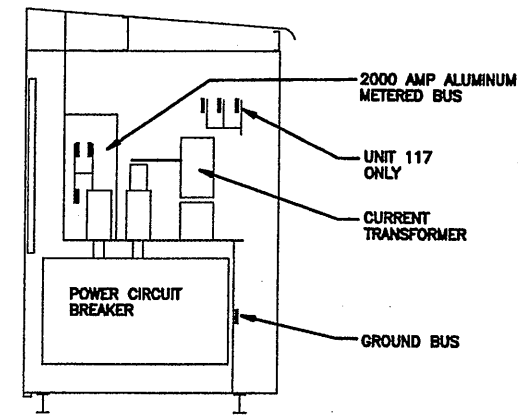


SECTION VIEW
EXISTING UNITS 101, 117
NOT TO SCALE

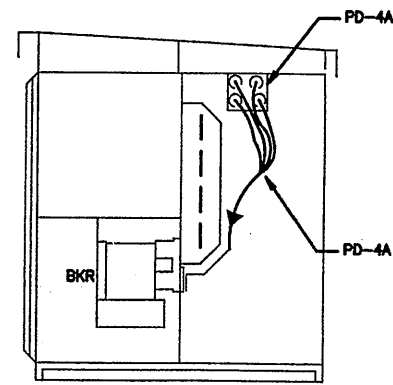


SECTION VIEW
NEW UNIT 099
NOT TO SCALE

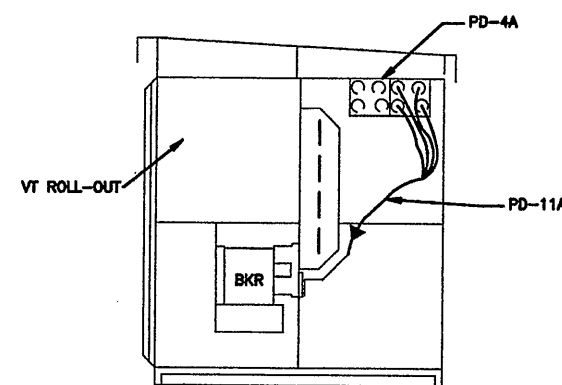


SECTION VIEW
NEW UNIT 098
NOT TO SCALE

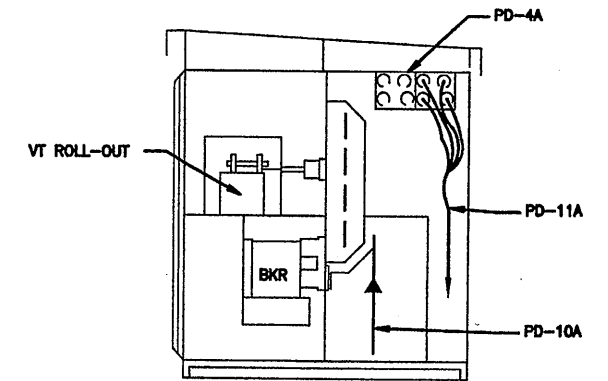


SECTION VIEW
UNIT 097
NOT TO SCALE

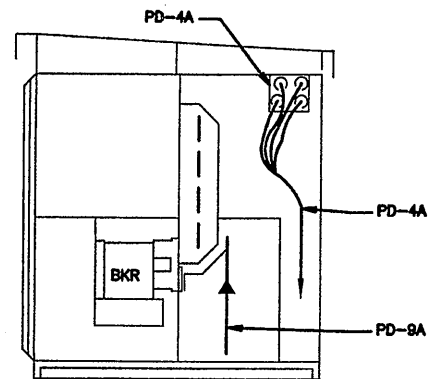

SECTION VIEW
UNIT 096
NOT TO SCALE

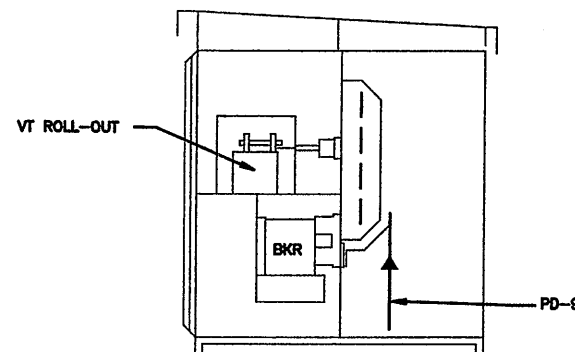


SECTION VIEW
UNIT 120
NOT TO SCALE

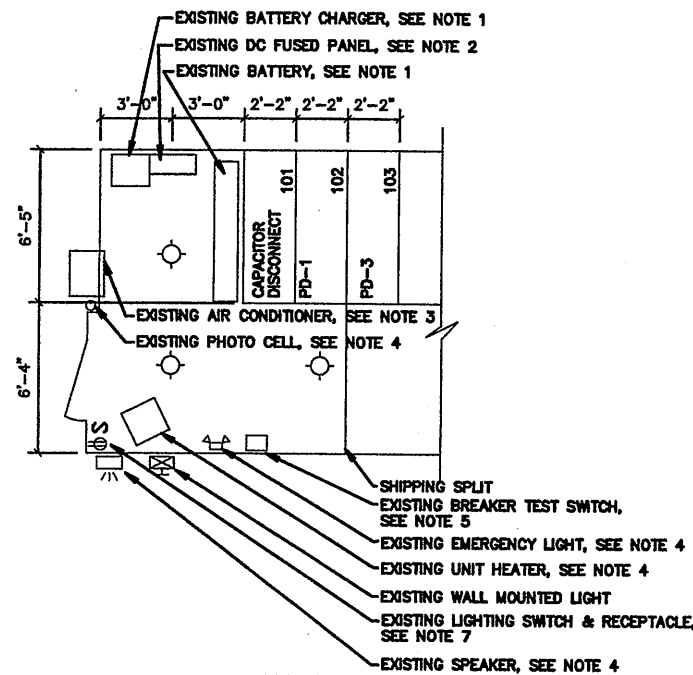


PLAN VIEW
EXISTING SWITCHGEAR BATTERY COMPT
SCALE: 1/4" = 1'-0"

NOTES:

- EXISTING EQUIPMENT SHALL BE REMOVED AND REINSTALLED IN NEW BATTERY BUILDING.
- EXISTING DC PANEL AND FUSE BLOCKS SHALL BE REMOVED AND DISPOSED OF.
- EXISTING AIR CONDITIONER SHALL BE REMOVED AND DELIVERED TO OWNER.
- EXISTING EQUIPMENT SHALL BE REMOVED AND REINSTALLED IN NEW SHELTERED AISLE, AT APPROXIMATELY THE SAME LOCATION.
- RECONNECT BREAKER TEST SWITCH 125VDC SUPPLY TO FUSED TAP IN NEW SWITCHGEAR.
- EXISTING BATTERY COMPARTMENT, INCLUDING END PANELS, FLOOR, ROOF AND OTHER STRUCTURAL COMPONENTS SHALL BE REMOVED AND DISPOSED OF.
- PROVIDE NEW TWO WAY SWITCHES & DUPLEX RECEPTACLES IN END PANELS OF NEW SWITCHGEAR. CONNECT NEW & EXISTING SWITCHGEAR LIGHTS TO NEW SWITCH, AND EXISTING BREAKER LPS1-33. CONNECT RECEPTACLES TO BREAKER LPS1-4.

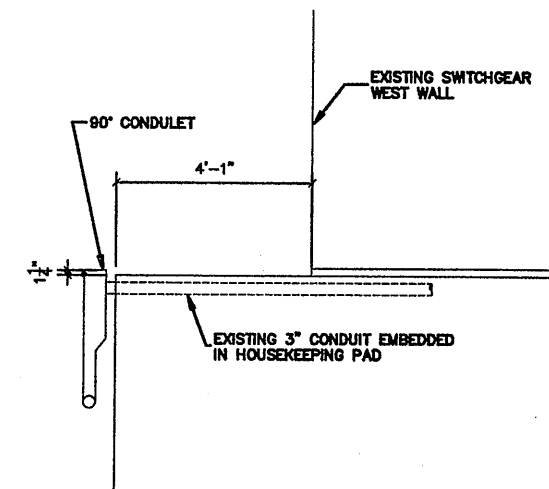

SECTION 1
1/2" = 1'-0" E-007

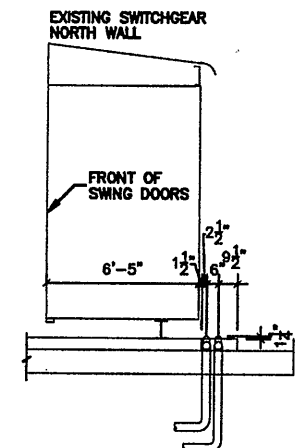

SECTION VIEW
SWITCH GEAR NORTH WALL
SECTION 2
1/4" = 1'-0" E-007

NOTES:

- REAR BASE CHANNEL OF NEW SWITCHGEAR SHALL BE LOCATED 6'-5" OR LESS FROM FRONT OF SWING DOORS. NEW SWITCHGEAR MAY OVERHANG CONDUIT BUT SHALL NOT OTHERWISE PREVENT ACCESS TO CONDUIT.

RECORD DRAWING

THESE CHANGES HAVE BEEN MADE TO REFLECT MAJOR CHANGES IF ANY, WHICH OCCURRED DURING CONSTRUCTION. REVISIONS ARE BASED UPON INFORMATION SUPPLIED BY CONTRACTOR.

DATE: 10/11/05 FOR: Lampert

SUMMARY OF WORK BY OTHER CONTRACTS:
ALL WORK IS PROVIDED UNDER CONTRACT 4B

THIS DRAWING WAS PREPARED AT THE SCALE INDICATED IN THE TITLE BLOCK. INACCURACIES IN THE STATED SCALE MAY BE INTRODUCED WHEN DRAWINGS ARE REPRODUCED BY ANY MEANS. USE THE GRAPHIC SCALE BAR IN THE TITLE BLOCK TO DETERMINE THE ACTUAL SCALE OF THIS DRAWING.

02/20/01 OBG CRV
0659

| | |
|--------------|-------|
| 1/4" = 1'-0" | 0 4 8 |
| 1/2" = 1'-0" | 0 2 4 |

NO ALTERATIONS PERMITTED HEREON EXCEPT AS PROVIDED UNDER SECTION 7209 SUBDIVISION 2 OF THE NEW YORK STATE EDUCATION LAW

| No. | Date | Revisions | Init |
|-----|----------|---------------------|------|
| 0 | 4/20/01 | ISSUED FOR APPROVAL | LC |
| 1 | | AS BID | |
| 2 | 10/31/05 | RECORD DRAWING | |

| | |
|--------------|-----|
| In charge of | TEL |
| Designed by | RAC |
| Drawn by | CRV |
| Checked by | WFH |

ENVIRONMENTAL ENGINEERING ASSOCIATES, LLP
SYRACUSE, NEW YORK


ONONDAGA COUNTY • DEPARTMENT OF DRAINAGE AND SANITATION • SYRACUSE, NEW YORK
METROPOLITAN SYRACUSE WASTEWATER TREATMENT PLANT
STAGE III AMMONIA AND STAGE II PHOSPHORUS REMOVAL PROJECT
MAIN SUBSTATION SWITCHGEAR DETAILS

STATE OF NEW YORK
LICENSED PROFESSIONAL ENGINEER
No. 60755

File Number
00659E008
Date
APRIL 2001
E-008

NAMEPLATE SCHEDULE

- 1 FEEDER PD8A/BAF SUBSTATION 1/MCC 30 & 31
- 1A UNIT 96
- 2 FEEDER PD10A/BAF SUBSTATION 2/MCC 37, 38, & 39
- 2A UNIT 97
- 3 FEEDER PD11A/SECONDARY EFFLUENT P.S./PUMPS 2 & 4
- 3A UNIT 98
- 4 FEEDER PD4A/PLANT OPERATIONS BLDG/(FUTURE)
- 4A UNIT 99
- 5 UNIT 100/BUS TRANSITION/AUXILIARY
- 6 BUS TIE
- 7 MAIN/T-1 SECONDARY
- 8 FEEDER PD6A/SLUDGE RECYCLING/BLDG B
- 9 FEEDER PD5A/SLUDGE RECYCLING/BLDG A
- 10 FEEDER PD3/SLUDGE PROCESSING
- 11 FEEDER PD1/LOW LIFT PUMPING STA/PUMPS 4 & 5
- 12 UNIT 119/BUS TRANSITION/AUXILIARY
- 13 MAIN/T-2 SECONDARY
- 14 FEEDER PD2/LOW LIFT PUMPING STA/ PUMPS 1, 2, & 3
- 15 FEEDER PD4/PLANT OPERATIONS BLDG
- 16 FEEDER PD5/SLUDGE RECYCLING/BLDG A
- 17 FEEDER PD6/SLUDGE RECYCLING/BLDG B
- 18 LOCKOUT RELAY/BUS OVERCURRENT/8881A
- 19 LOCKOUT RELAY/BUS OVERCURRENT/8882A
- 20 FEEDER PD9/BAF SUBSTATION 1/MCC 33, 34 & 35
- 20A UNIT 120
- 21 FEEDER PD10/BAF SUBSTATION 2/MCC 42 & 43
- 21A UNIT 21
- 22 FEEDER PD11/SECONDARY EFFLUENT P.S./PUMPS 1 & 3
- 22A UNIT 122
- 23 FEEDER PD3A/SLUDGE PROCESSING/(FUTURE)
- 23A UNIT 123

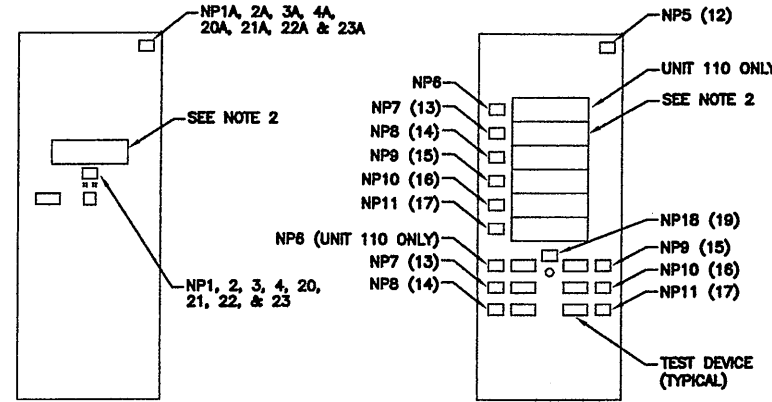


SWINGING PANEL

UNITS 96, 97, 98, 99, 120, 121, 122 & 123
SCALE: 1/2"=1'-0"

SWINGING PANEL

UNITS 100 & (119)
SCALE: 1/2"=1'-0"

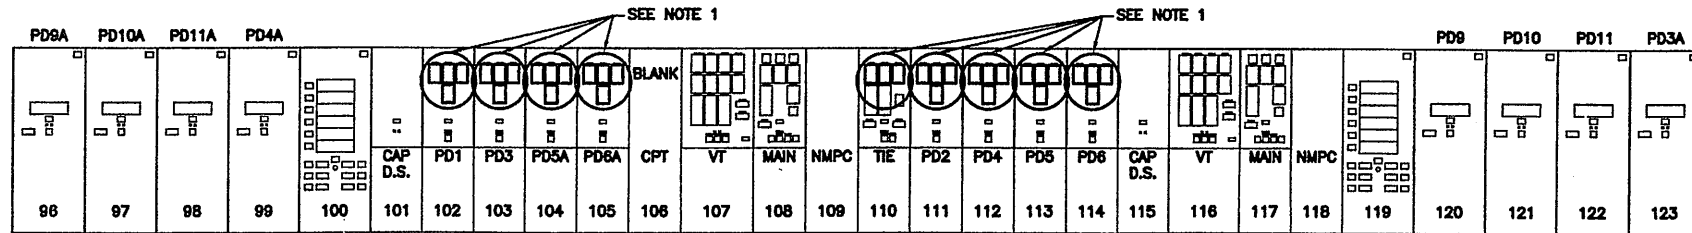

SWITCHGEAR INTERIOR ELEVATION

SCALE: 1/4"=1'-0"

NOTES:

- 1. REMOVE EXISTING RELAYS AND PROVIDE COVER PLATES, PAINTED TO MATCH EXISTING PANELS.
- 2. MULTI-PURPOSE RELAY/METER IN 19" RACK STYLE CASE

| MEDIUM VOLTAGE CABLE SCHEDULE | | | | | | |
|-------------------------------|----------------------------------|----------------------------------|---------------------|-------------|--------------------|-------------------|
| CONDUIT NUMBER | FROM | TO | CONDUCTOR QTY.-SIZE | INSULATION | CONDUIT/CABLE TRAY | NOTES |
| PD3A | 34.5 MAIN SUBSTATION | - | - | - | 4"C | CAPPED |
| PD4A | 34.5 MAIN SUBSTATION | - | - | - | 4"C | CAPPED |
| PD9 | 34.5 KV MAIN SUBSTATION | MAIN GALLERY ACCESS HANDHOLE | 3-750 1-1/0 | 5KV 600V | 5"C | |
| | MAIN GALLERY ACCESS HANDHOLE | SEC GALLERY A | 1-500 | 5KV | CABLE TRAY | METAL-CLAD CABLE |
| | SEC GALLERY A | BAF 5KV SWITCHGEAR | 3-750 1-1/0 | 5KV 600V | 5"C | |
| | BAF 5 KV SWITCHGEAR | TRANSFORMER T1B | 3-750 1-1/0 | 5KV 600V | 2-5"C | (1 SPARE CONDUIT) |
| PD9A | 34.5 KV MAIN SUBSTATION | MAIN GALLERY ACCESS HANDHOLE | 3-750 1-1/0 | 5KV 600V | 5"C | |
| | MAIN GALLERY ACCESS HANDHOLE | SEC GALLERY A | 1-500 | 5KV | CABLE TRAY | METAL-CLAD CABLE |
| | SEC GALLERY A | BAF 5KV SWITCHGEAR | 3-750 1-1/0 | 5KV 600V | 5"C | |
| | BAF 5 KV SWITCHGEAR | TRANSFORMER T1A | 3-750 1-1/0 | 5KV 600V | 2-5"C | (1 SPARE CONDUIT) |
| PD10 | 34.5 KV MAIN SUBSTATION | MAIN GALLERY ACCESS HANDHOLE | 3-750 1-1/0 | 5KV 600V | 5"C | |
| | MAIN GALLERY ACCESS HANDHOLE | SEC GALLERY A | 1-500 | 5KV | CABLE TRAY | METAL-CLAD CABLE |
| | SEC GALLERY A | BAF 5KV SWITCHGEAR | 3-750 1-1/0 | 5KV 600V | 5"C | |
| | BAF 5 KV SWITCHGEAR | TRANSFORMER T2B | 3-750 1-1/0 | 5KV 600V | 2-5"C | (1 SPARE CONDUIT) |
| PD10A | 34.5 KV MAIN SUBSTATION | MAIN GALLERY ACCESS HANDHOLE | 3-750 1-1/0 | 5KV 600V | 5"C | |
| | MAIN GALLERY ACCESS HANDHOLE | SEC GALLERY A | 1-500 | 5KV | CABLE TRAY | METAL-CLAD CABLE |
| | SEC GALLERY A | BAF 5KV SWITCHGEAR | 3-750 1-1/0 | 5KV 600V | 5"C | |
| | BAF 5 KV SWITCHGEAR | TRANSFORMER T2A | 3-750 1-1/0 | 5KV 600V | 2-5"C | (1 SPARE CONDUIT) |
| PD11 | 34.5KV MAIN SUBSTATION | MAIN GALLERY ACCESS HANDHOLE | 3-250 1-1/0 | 5KV 600V | 4"C | |
| | MAIN GALLERY ACCESS HANDHOLE | EFFLUENT GALLERY | 1-250 | 5KV | CABLE TRAY | METAL CLAD CABLE |
| | EFFLUENT GALLERY | SEC EFFLUENT P.S. 5KV SWITCHGEAR | 3-250 1-1/0 | 5KV 600V | 4"C | |
| PD11A | 34.5KV MAIN SUBSTATION | MAIN GALLERY ACCESS HANDHOLE | 3-250 1-1/0 | 5KV 600V | 4"C | |
| | MAIN GALLERY ACCESS HANDHOLE | EFFLUENT GALLERY | 1-250 | 5KV | CABLE TRAY | METAL CLAD CABLE |
| | EFFLUENT GALLERY | SEC EFFLUENT P.S. 5KV SWITCHGEAR | 3-250 1-1/0 | 5KV 600V | 4"C | |
| PD12 | SEC EFFLUENT P.S. 5KV SWITCHGEAR | PUMP 2 TRANSFORMER | 1#2 | 5KV | CABLE TRAY | METAL-CLAD CABLE |
| PD13 | SEC EFFLUENT P.S. 5KV SWITCHGEAR | PUMP 3 TRANSFORMER | 1#2 | 5KV | CABLE TRAY | METAL-CLAD CABLE |
| PD14 | SEC EFFLUENT P.S. 5KV SWITCHGEAR | PUMP 4 TRANSFORMER | 1#2 | 5KV | CABLE TRAY | METAL-CLAD CABLE |
| PD15 | SEC EFFLUENT P.S. 5KV SWITCHGEAR | MCC 44 TRANSFORMER A | 1#2 | 5KV | CABLE TRAY | METAL-CLAD CABLE |
| PD16 | SEC EFFLUENT P.S. 5KV SWITCHGEAR | MCC 44 TRANSFORMER B | 1#2 | 5KV | CABLE TRAY | METAL-CLAD CABLE |
| PD17 | SEC EFFLUENT P.S. 5KV SWITCHGEAR | PUMP 1 TRANSFORMER | 1#2 | 5KV | CABLE TRAY | METAL-CLAD CABLE |
| PD18 | BAF 5KV SWITCHGEAR | EMH2 | - | - | 4"C | FOR FUTURE FILTER |
| PD19 | BAF 5KV SWITCHGEAR | EMH2 | - | - | 4"C | FOR FUTURE FILTER |
| PD20 | BAF ELECTRIC ROOM | EMH2 | - | - | 4"C | SPARE |
| PD21 | BAF ELECTRIC ROOM | EMH2 | - | - | 4"C | SPARE |

NOTES:

- 1. EACH METAL-CLAD CABLE INCLUDES 3 PHASE CONDUCTORS & 1 GROUND CONDUCTOR.


SUMMARY OF WORK BY OTHER CONTRACTS:
ALL WORK IS PROVIDED UNDER CONTRACT 48

RECORD DRAWING

THESE DRAWINGS HAVE BEEN REVIEWED TO REFLECT MAJOR CHANGES, IF ANY, WHICH OCCURRED DURING CONSTRUCTION. REVISIONS ARE BASED UPON INFORMATION SUPPLIED BY CONTRACTOR.
DATE: 10/2/05 PBR: [Signature]

THIS DRAWING WAS PREPARED AT THE SCALE INDICATED IN THE TITLE BLOCK. INACCURACIES IN THE STATED SCALE MAY BE INTRODUCED WHEN DRAWINGS ARE REPRODUCED BY ANY MEANS. USE THE GRAPHIC SCALE BAR IN THE TITLE BLOCK TO DETERMINE THE ACTUAL SCALE OF THIS DRAWING.

03/20/01 OBG CRV
0859

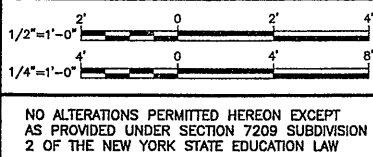

| No. | Date | Revisions | Init |
|-----|----------|---------------------|-------------|
| 0 | 4/20/01 | ISSUED FOR APPROVAL | [Signature] |
| 1 | | AS BID | |
| 2 | 10/31/05 | RECORD DRAWING | |

In charge of ___ TEL ___
Designed by ___ RAC ___
Drawn by ___ CRV ___
Checked by ___ WFH ___

ENVIRONMENTAL ENGINEERING ASSOCIATES, LLP
SYRACUSE, NEW YORK

ONONDAGA COUNTY • DEPARTMENT OF DRAINAGE AND SANITATION • SYRACUSE, NEW YORK
METROPOLITAN SYRACUSE WASTEWATER TREATMENT PLANT
STAGE III AMMONIA AND STAGE II PHOSPHORUS REMOVAL PROJECT

MAIN SUBSTATION MODIFICATIONS





ELECTRICAL




File Number
00659E009
Date
APRIL 2001
[Signature]

E-009


34.5 KV SUBSTATION (SEE E-007)

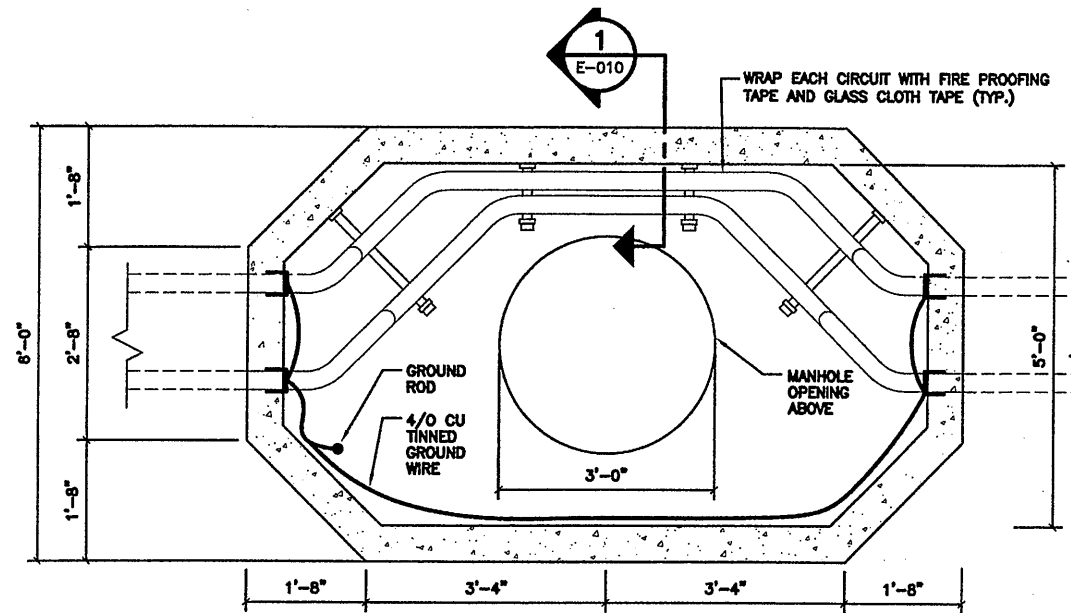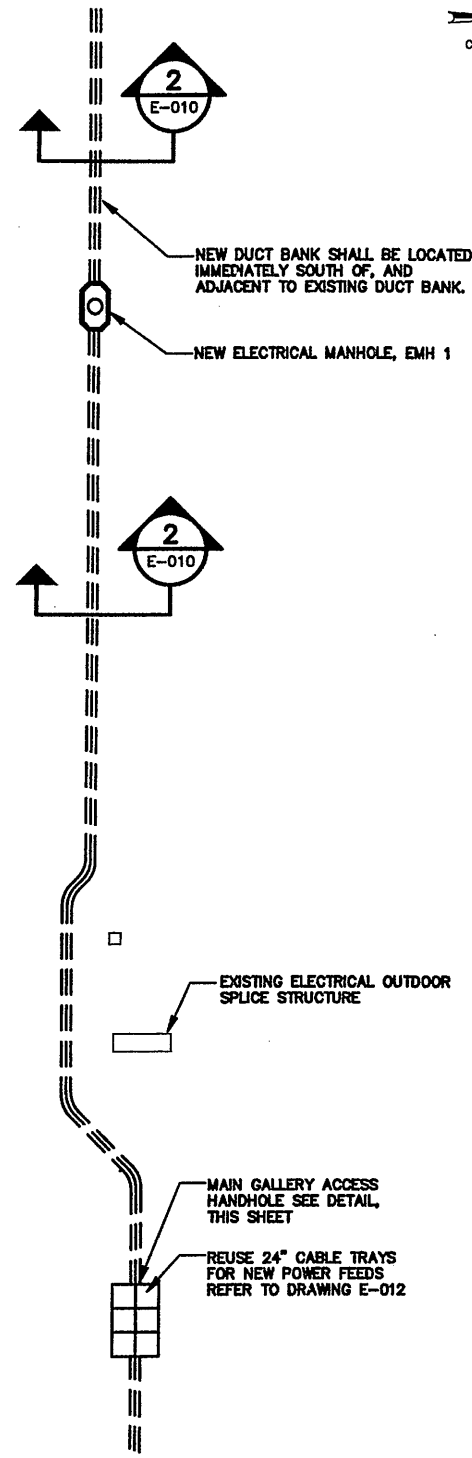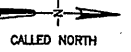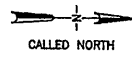


ELECTRICAL MANHOLE (TYPICAL FOR EMH1, EMH2)
SEE ADDITIONAL INSTALLATION DETAILS ON E-017
SCALE: 3/4"=1'-0"

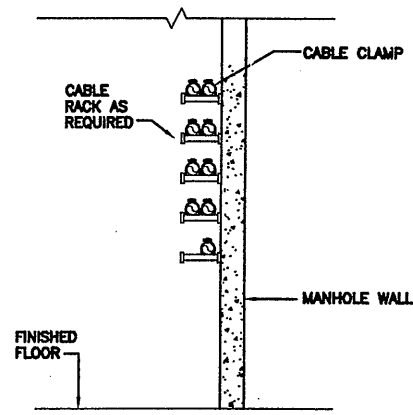


SECTION 1
NOT TO SCALE
E-010

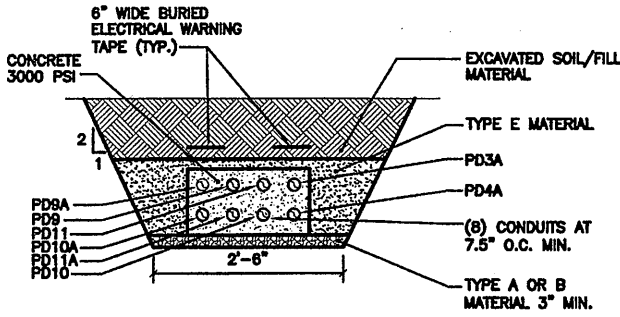

SECTION 2
NOT TO SCALE
E-010 E-007

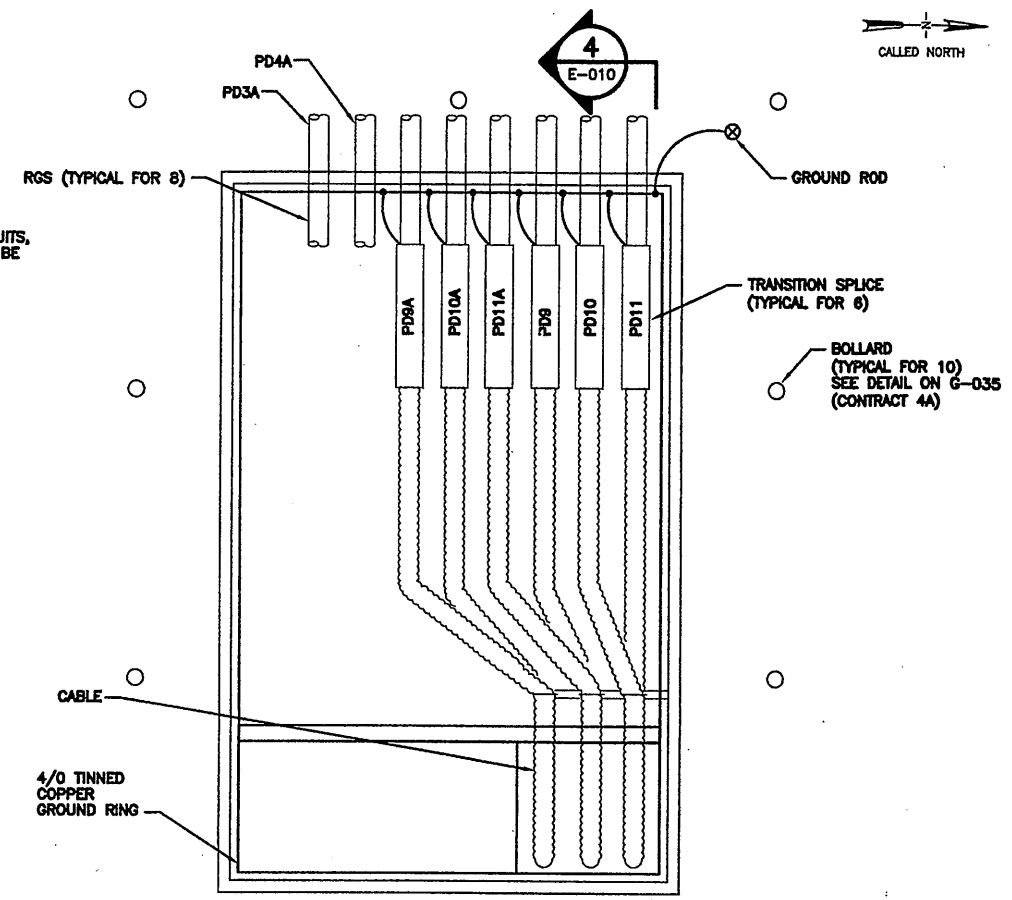

MAIN GALLERY ACCESS HANDHOLE
SCALE: 1/2"=1'-0"

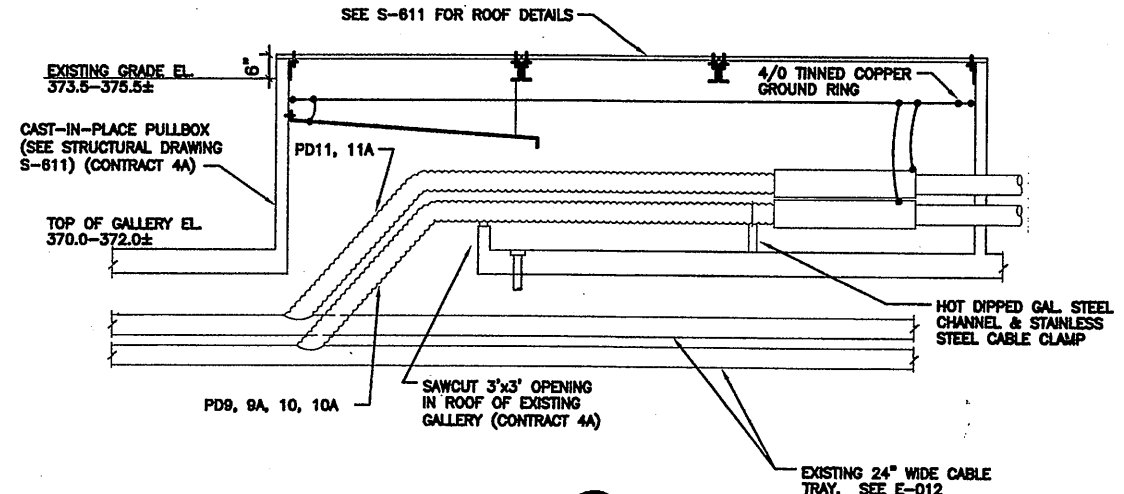


SECTION 4
1/2"=1'-0"
E-010

- NOTES:**
- SCALE AND FEATURES APPROXIMATE ONLY, BASED ON EXISTING DRAWINGS.
 - PROVIDE 2" CONDUIT ROUTED FROM SUBSTATION TO GALLERY FOR TELEPHONE, PA AND FIBER OPTIC CABLES.
 - PROVIDE 1" SPARE CONDUIT ROUTED FROM SUBSTATION TO GALLERY.

PLAN
SCALE: 1"=20'-0"

0659x001
03/22/01 OBG CRV
0659e010

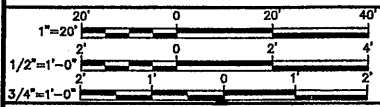

| No. | Date | Revisions | Init |
|-----|---------|---------------------|------|
| 0 | 4/20/01 | ISSUED FOR APPROVAL | TEL |
| 1 | | AS BID | |
| 2 | 0/31/05 | RECORD DRAWING | |

In charge of --- TEL ---
Designed by --- RAC ---
Drawn by --- CRV ---
Checked by --- WFH ---



ONONDAGA COUNTY • DEPARTMENT OF DRAINAGE AND SANITATION • SYRACUSE, NEW YORK
METROPOLITAN SYRACUSE WASTEWATER TREATMENT PLANT
STAGE III AMMONIA AND STAGE II PHOSPHORUS REMOVAL PROJECT

5KV DUCTBANK PLAN AND SECTIONS


ELECTRICAL




File Number
00659
Date
APRIL 2001
E-010

RECORD DRAWING
THESE DRAWINGS HAVE BEEN REVISIONED TO REFLECT MAJOR CHANGES, IF ANY, WHICH OCCURRED DURING CONSTRUCTION. REVISIONS ARE BASED UPON INFORMATION SUPPLIED BY CONTRACTOR.
DATE: 10/2/05 FOR: [Signature]

THIS DRAWING WAS PREPARED AT THE SCALE INDICATED IN THE TITLE BLOCK. INACCURACIES IN THE STATED SCALE MAY BE INTRODUCED WHEN DRAWINGS ARE REPRODUCED BY ANY MEANS. USE THE GRAPHIC SCALE BAR IN THE TITLE BLOCK TO DETERMINE THE ACTUAL SCALE OF THIS DRAWING.

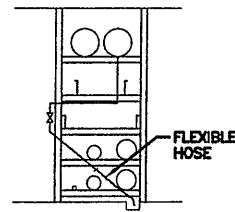

SECTION 3
SCALE: 1/4"=1'-0" E-012

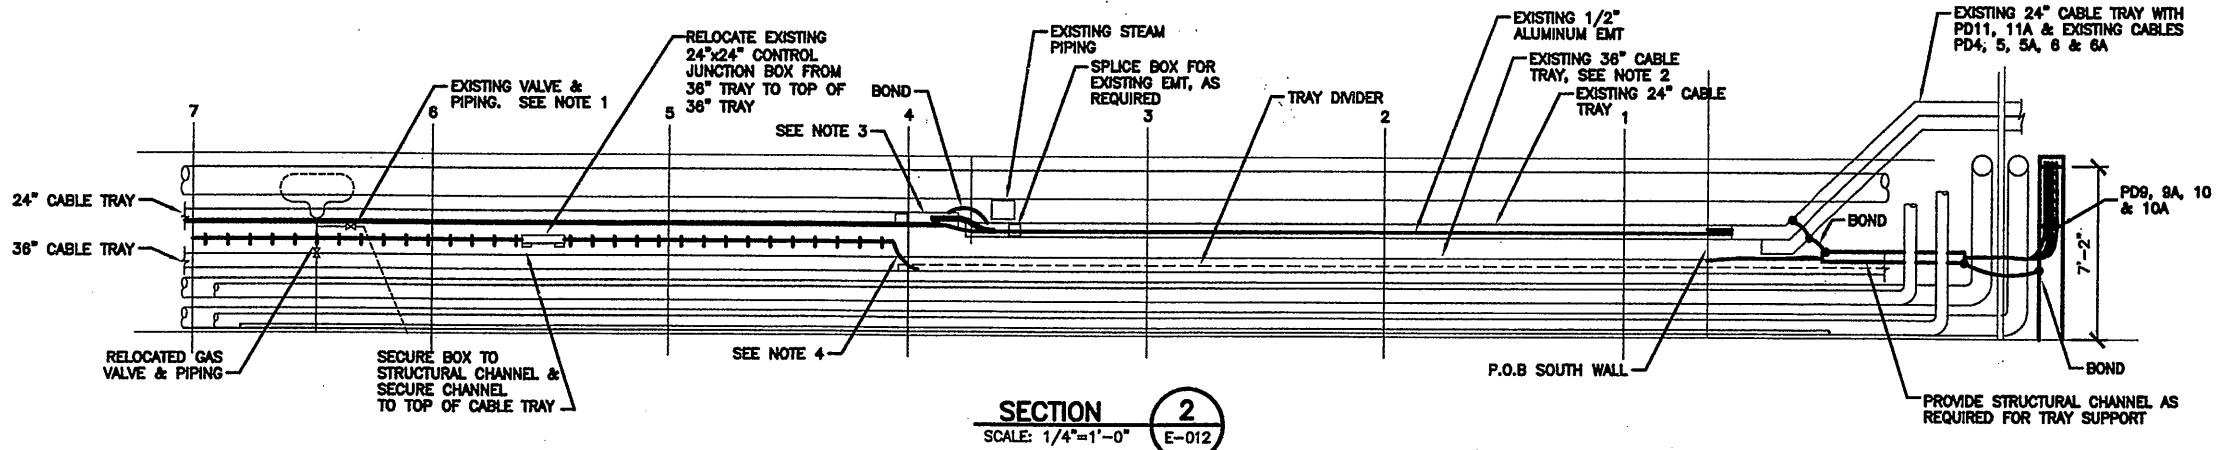


SECTION 2
SCALE: 1/4"=1'-0" E-012


- CONTRACT 4A SHALL MODIFY EXISTING GAS VALVE & PIPING
- CONTRACT 4A SHALL PROVIDE BOLLARDS FOR ELECTRICAL EQUIPMENT IN ACCORDANCE WITH DETAIL ON THIS SHEET AND SPECIFICATION 02B40

- NOTES:**
- REMOVE EXISTING 1" GAS VALVE AND 1" PIPING. PROVIDE NEW 1" PIPE AND FLEXIBLE HOSE AS REQUIRED AND REINSTALL VALVE ON EAST SIDE OF PIPE RACK. (BY CONTRACT 4A-GENERAL)
 - PROVIDE 3" DIVIDER IN EXISTING 36" CABLE TRAY, BETWEEN CHANNEL 4 & PLANT OPERATIONS BUILDING. PLACE CONTROL & COMMUNICATIONS IN WEST SIDE OF TRAY, & 4160V POWER IN EAST SIDE.
 - MOVE EXISTING TRAY, TRAY SUPPORTS, AND EXISTING 1/2" EMT UP APPROXIMATELY 5", TO PROVIDE APPROXIMATELY 10" BETWEEN TOP OF 36" TRAY AND BOTTOM OF 24" TRAY.
 - RELOCATE EXISTING COMMUNICATIONS & CONTROL CABLES TO NEW ONE TIER, 3" LOAD DEPTH 9" RAIL TYPE RACK, FROM CHANNEL 4, IN CHEMICAL GALLERY, TO CHANNEL 9 IN MAIN GALLERY.


RELOCATE EXISTING CONTROL & COMMUNICATIONS CABLES TO ONE TIER, 3" LOAD DEPTH, 9" WIDE, RAIL TYPE RACK. (TYPICAL FROM THIS POINT TO ACCESS HANDHOLE.)

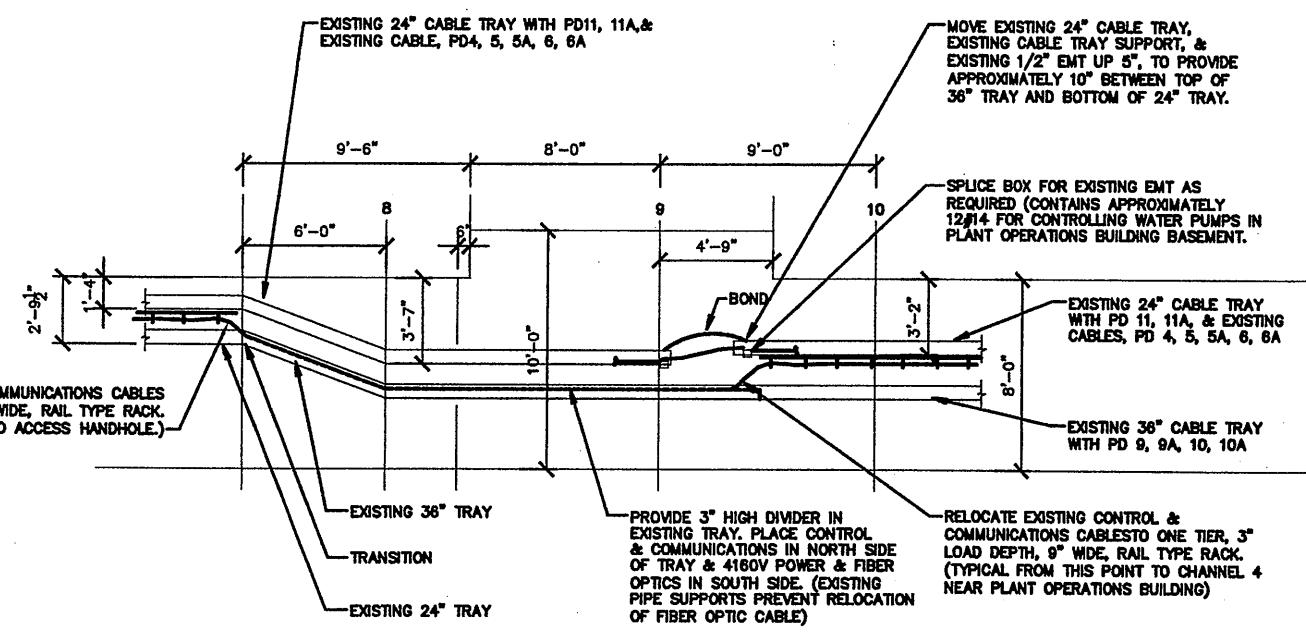

SECTION 10
SCALE: 1/4"=1'-0" E-012

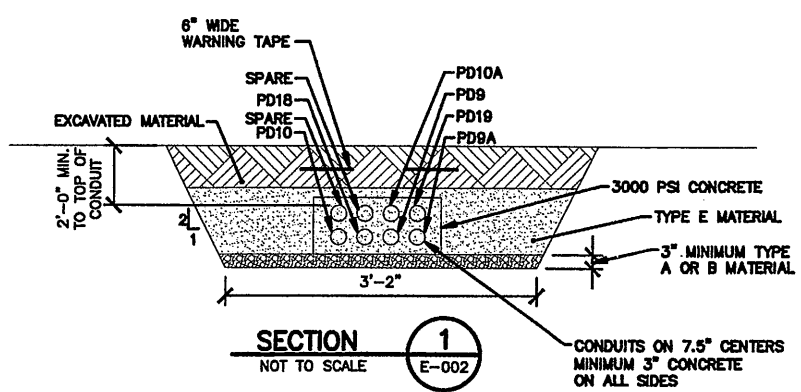

SECTION 1
NOT TO SCALE E-002

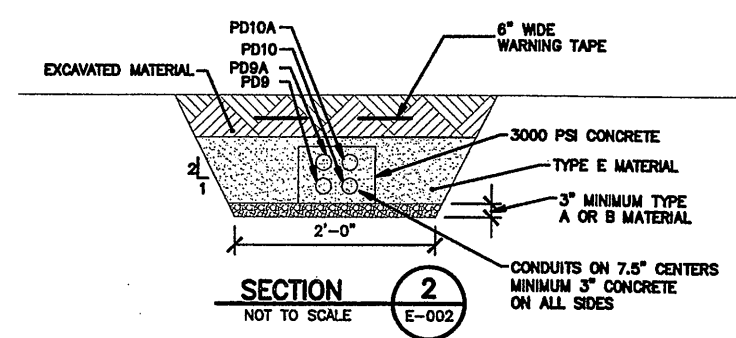

SECTION 2
NOT TO SCALE E-002

SUMMARY OF WORK BY OTHER CONTRACTS:
1. CONTRACT 4A SHALL MODIFY EXISTING GAS VALVE & PIPING

RECORD DRAWING
THESE DRAWINGS HAVE BEEN REVISIONED TO REFLECT MAJOR CHANGES, IF ANY, WHICH OCCURRED DURING CONSTRUCTION. REVISIONS ARE BASED UPON INFORMATION SUPPLIED BY CONTRACTOR.
DATE: 10/21/01 FOR: K&P Associates

THIS DRAWING WAS PREPARED AT THE SCALE INDICATED IN THE TITLE BLOCK. INACCURACIES IN THE STATED SCALE MAY BE INTRODUCED WHEN DRAWINGS ARE REPRODUCED BY ANY MEANS. USE THE GRAPHIC SCALE BAR IN THE TITLE BLOCK TO DETERMINE THE ACTUAL SCALE OF THIS DRAWING.

03/21/01 OBG CRV
0659#011

| No. | Date | Revisions | Init |
|-----|----------|---------------------|------|
| 0 | 4/20/01 | ISSUED FOR APPROVAL | TEL |
| 1 | | AS BID | |
| 2 | 10/31/01 | RECORD DRAWING | |

| | |
|--------------|-----|
| In charge of | TEL |
| Designed by | RAC |
| Drawn by | CRV |
| Checked by | WFH |

ENVIRONMENTAL ENGINEERING ASSOCIATES, LLP
SYRACUSE, NEW YORK

ONONDAGA COUNTY • DEPARTMENT OF DRAINAGE AND SANITATION • SYRACUSE, NEW YORK
METROPOLITAN SYRACUSE WASTEWATER TREATMENT PLANT
STAGE III AMMONIA AND STAGE II PHOSPHORUS REMOVAL PROJECT


5 KV CABLE TRAY PLAN AND SECTIONS

ELECTRICAL



File Number
00659
Date
APRIL 2001

E-011

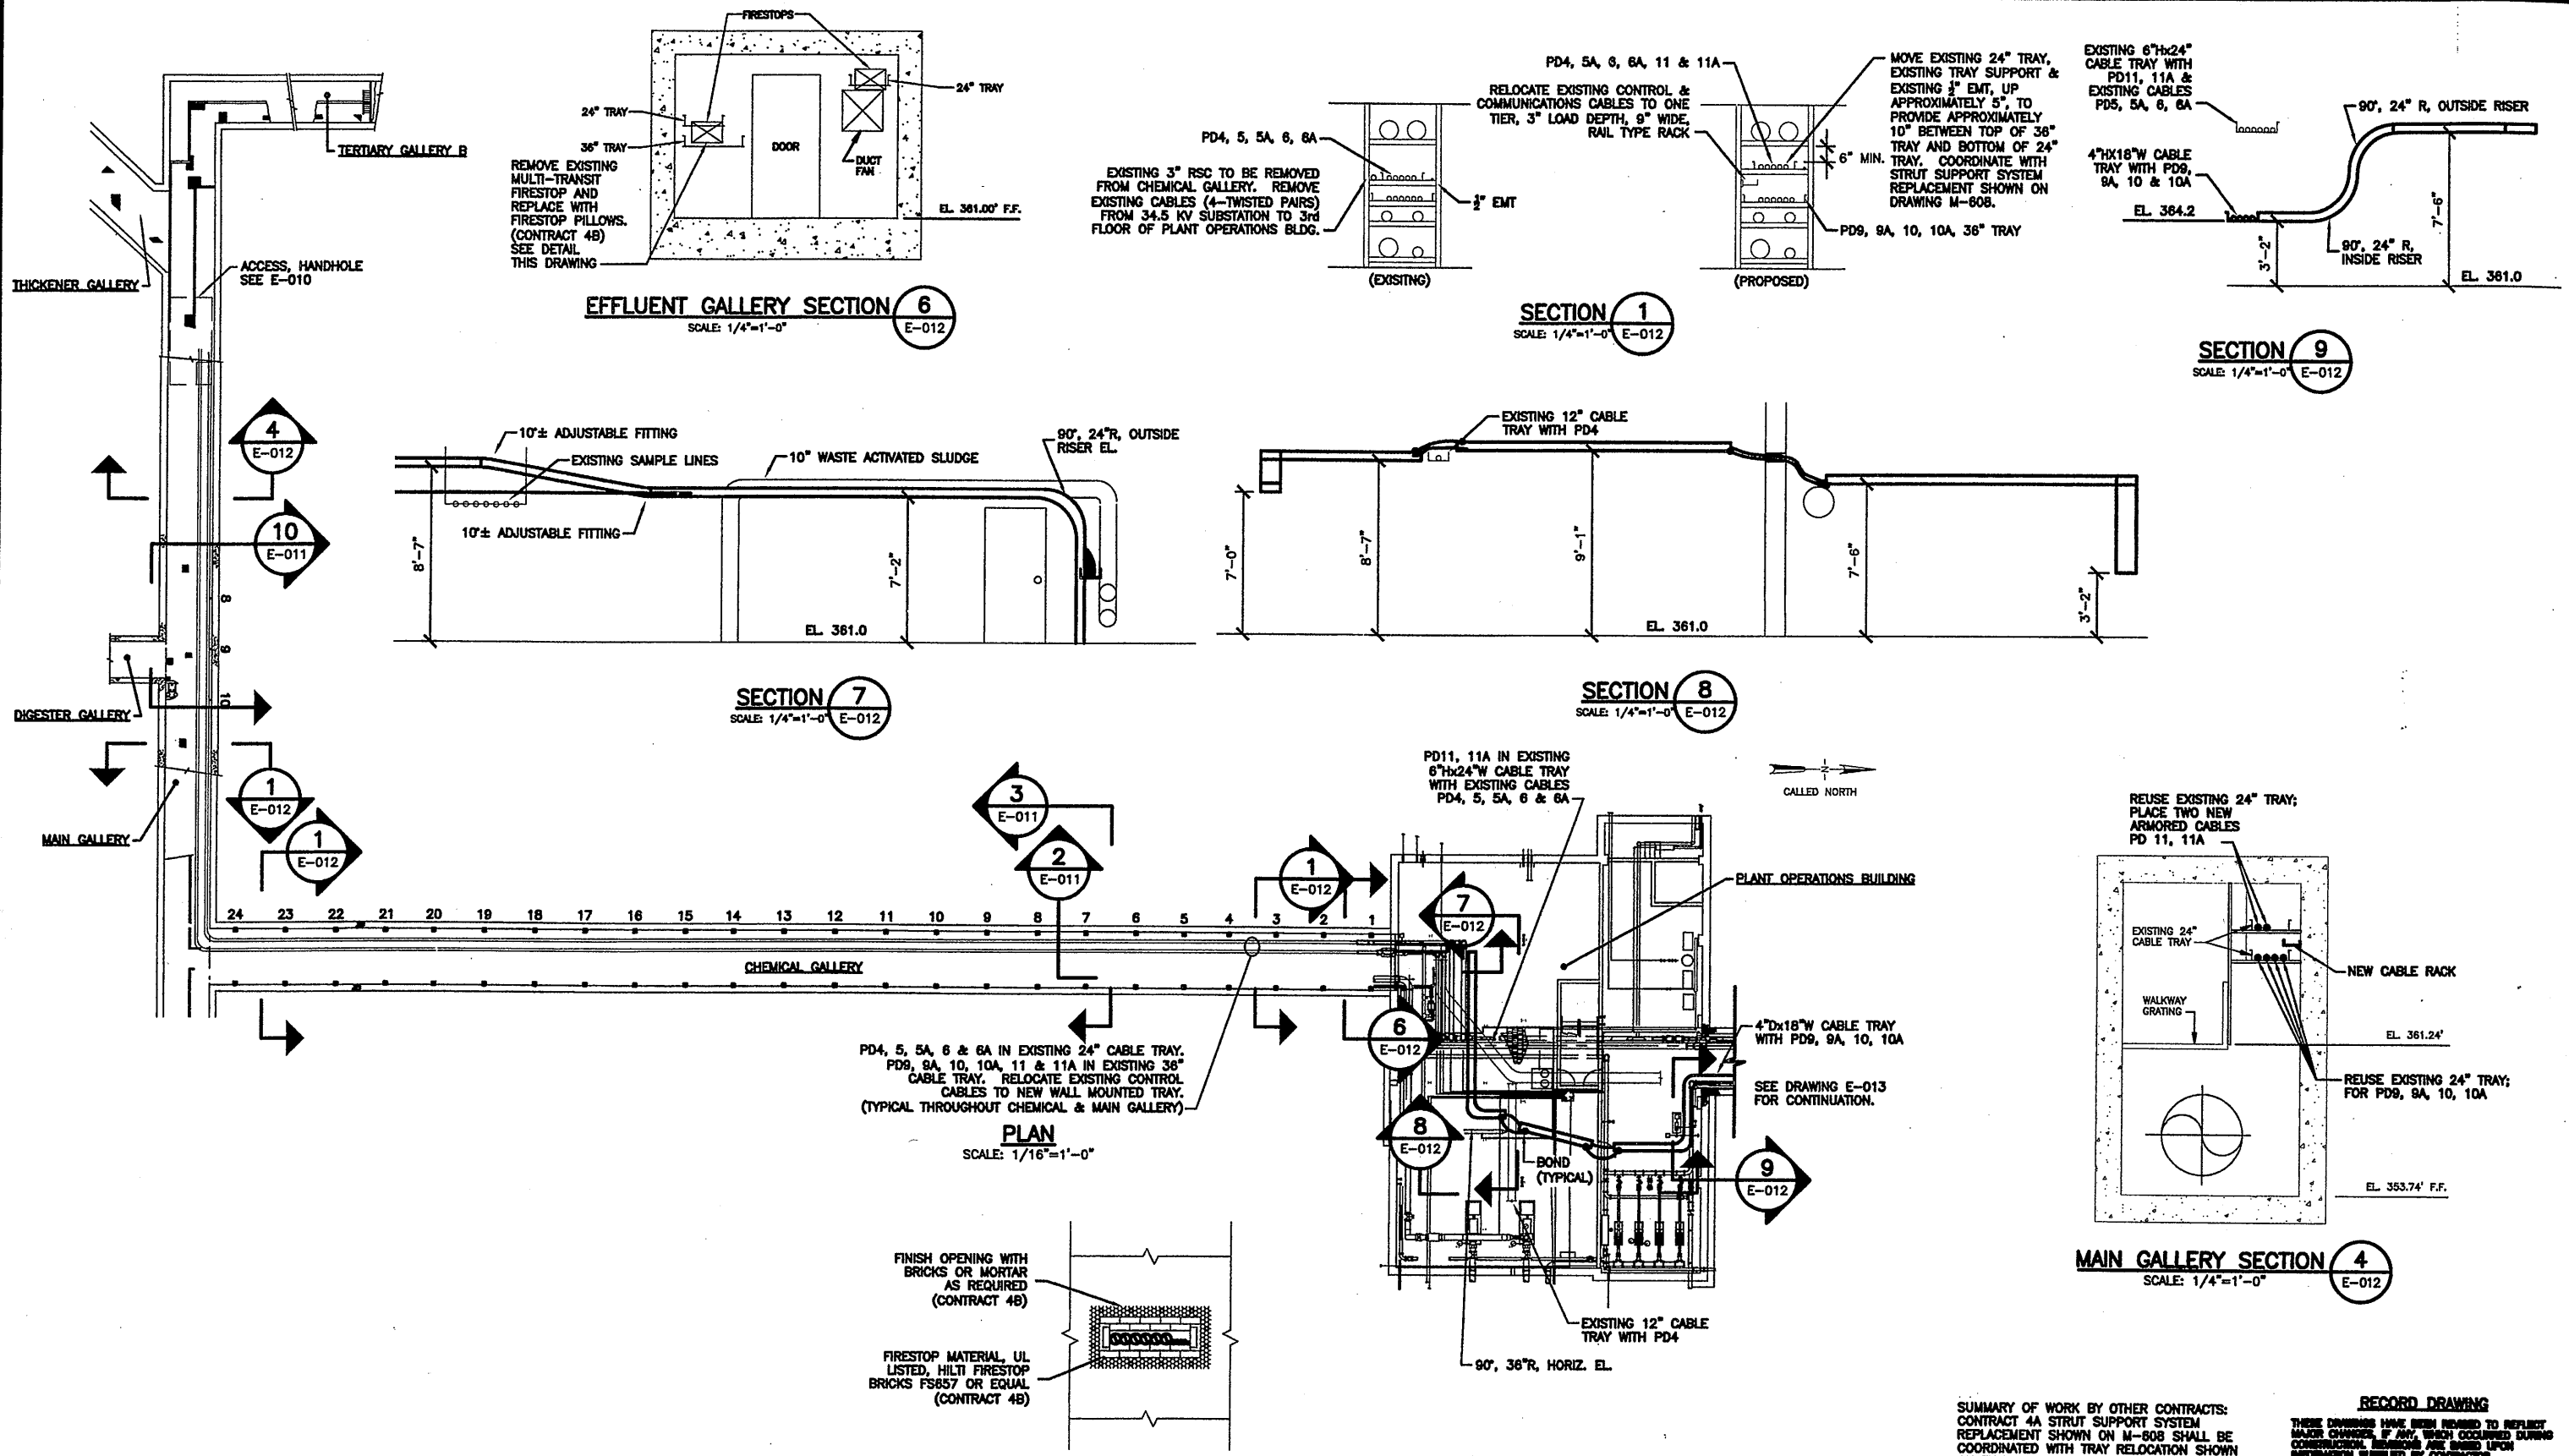

RECORD DRAWING
 THESE DRAWINGS HAVE BEEN REVIEWED TO REFLECT MAJOR CHANGES, IF ANY, WHICH OCCURRED DURING CONSTRUCTION. REVISIONS ARE BASED UPON INFORMATION SUPPLIED BY CONTRACTOR.
 DATE: 10/21/05 PER: [Signature]

THIS DRAWING WAS PREPARED AT THE SCALE INDICATED IN THE TITLE BLOCK. INACCURACIES IN THE STATED SCALE MAY BE INTRODUCED WHEN DRAWINGS ARE REPRODUCED BY ANY MEANS. USE THE GRAPHIC SCALE BAR IN THE TITLE BLOCK TO DETERMINE THE ACTUAL SCALE OF THIS DRAWING.

03/21/01 OBG CRV
0659e12

NO ALTERATIONS PERMITTED HEREON EXCEPT AS PROVIDED UNDER SECTION 7209 SUBDIVISION 2 OF THE NEW YORK STATE EDUCATION LAW

| No. | Date | Revisions | Init |
|-----|---------|---------------------|-------------|
| 0 | 4/20/01 | ISSUED FOR APPROVAL | [Signature] |
| 1 | | AS BID | |
| 2 | 0/31/05 | RECORD DRAWING | |

In charge of TEL
 Designed by RAC
 Drawn by CRV
 Checked by WFH




ONONDAGA COUNTY • DEPARTMENT OF DRAINAGE AND SANITATION • SYRACUSE, NEW YORK
 METROPOLITAN SYRACUSE WASTEWATER TREATMENT PLANT
 STAGE III AMMONIA AND STAGE II PHOSPHORUS REMOVAL PROJECT
ELECTRICAL
5KV CABLE TRAY PLAN & SECTIONS


File Number
00659

Date
APRIL 2001


E-012

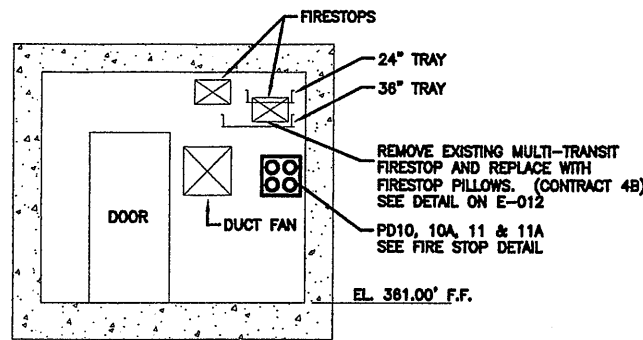


EFLUENT GALLERY SECTION 2
SCALE: 1/4"=1'-0"
E-013

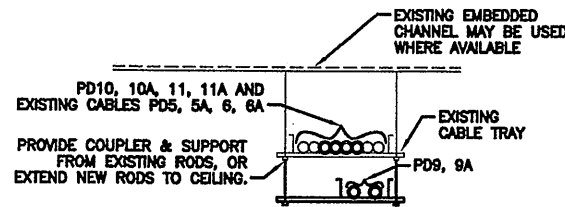


SECTION 5
SCALE: 1/2"=1'-0"
E-013

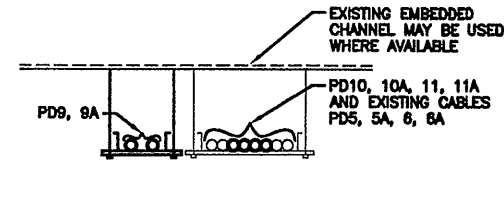


SECTION 7
SCALE: 1/2"=1'-0"
E-013

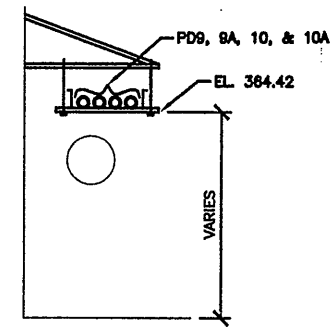


SECTION 1
SCALE: 1/2"=1'-0"
E-013

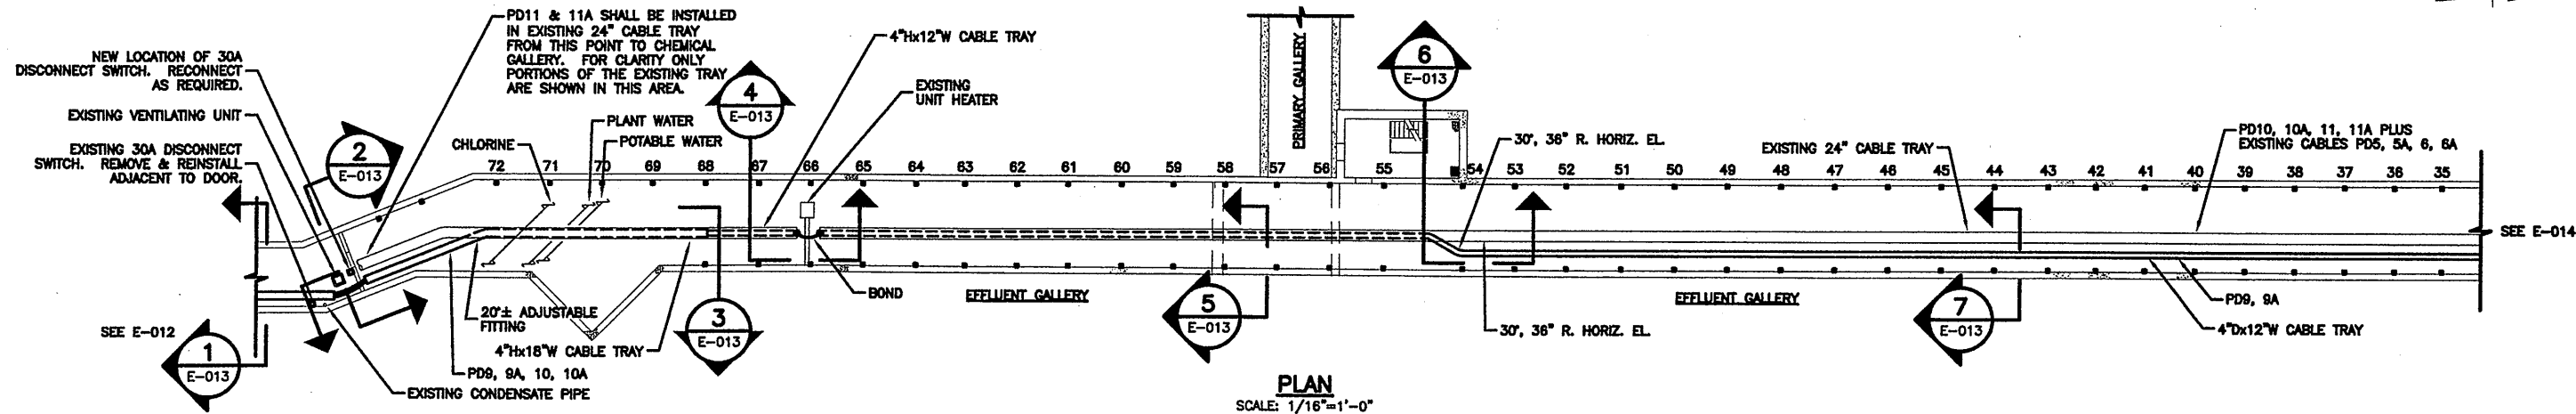


PLAN
SCALE: 1/16"=1'-0"

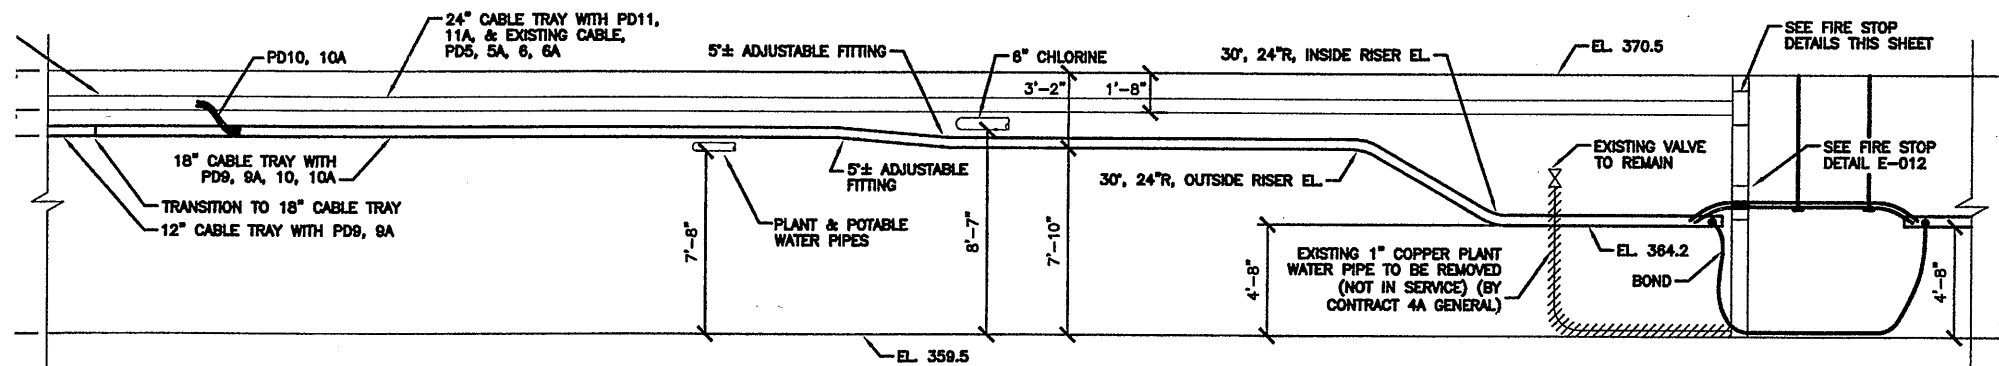

SECTION 3
SCALE: 1/4"=1'-0"
E-013

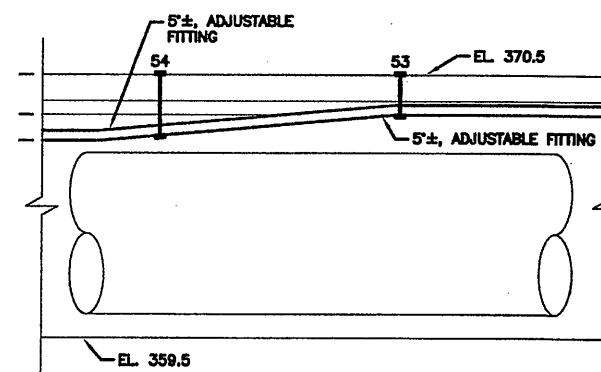

SECTION 6
SCALE: 1/4"=1'-0"
E-013

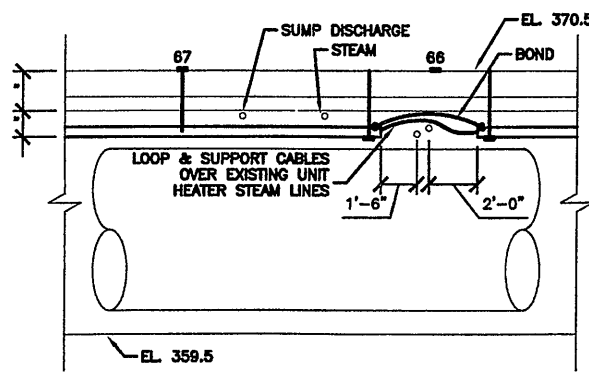

SECTION 4
SCALE: 1/4"=1'-0"
E-013

SUMMARY OF WORK BY OTHER CONTRACTS:
CONTRACT 4A SHALL REMOVE EXISTING COPPER WATER PIPE

RECORD DRAWING

THESE DRAWINGS HAVE BEEN REVISIONED TO REFLECT MAJOR CHANGES, IF ANY, WHICH OCCURRED DURING CONSTRUCTION. REVISIONS ARE BASED UPON INFORMATION SUPPLIED BY CONTRACTOR.
DATE: 10/21/05 PER: [Signature]

THIS DRAWING WAS PREPARED AT THE SCALE INDICATED IN THE TITLE BLOCK. INACCURACIES IN THE STATED SCALE MAY BE INTRODUCED WHEN DRAWINGS ARE REPRODUCED BY ANY MEANS. USE THE GRAPHIC SCALE BAR IN THE TITLE BLOCK TO DETERMINE THE ACTUAL SCALE OF THIS DRAWING.

03/20/01 OBG CRV
0659

| | | | |
|-------------|---|----|----|
| 1/2"=1'-0" | 0 | 2 | 4 |
| 1/4"=1'-0" | 0 | 4 | 8 |
| 1/16"=1'-0" | 0 | 16 | 32 |

| No. | Date | Revisions | Init |
|-----|---------|---------------------|------|
| 0 | 4/20/01 | ISSUED FOR APPROVAL | TEL |
| 1 | | AS BID | |
| 2 | 0/31/05 | RECORD DRAWING | |

In charge of: TEL
Designed by: RAC
Drawn by: CRV
Checked by: WFH





ONONDAGA COUNTY • DEPARTMENT OF DRAINAGE AND SANITATION • SYRACUSE, NEW YORK
METROPOLITAN SYRACUSE WASTEWATER TREATMENT PLANT
STAGE III AMMONIA AND STAGE II PHOSPHORUS REMOVAL PROJECT
ELECTRICAL
5 KV CABLE TRAY PLAN & SECTIONS



File Number: 00659E013
Date: APRIL 2001
E-013
[Signature]

NO ALTERATIONS PERMITTED HEREON EXCEPT AS PROVIDED UNDER SECTION 7209 SUBDIVISION 2 OF THE NEW YORK STATE EDUCATION LAW

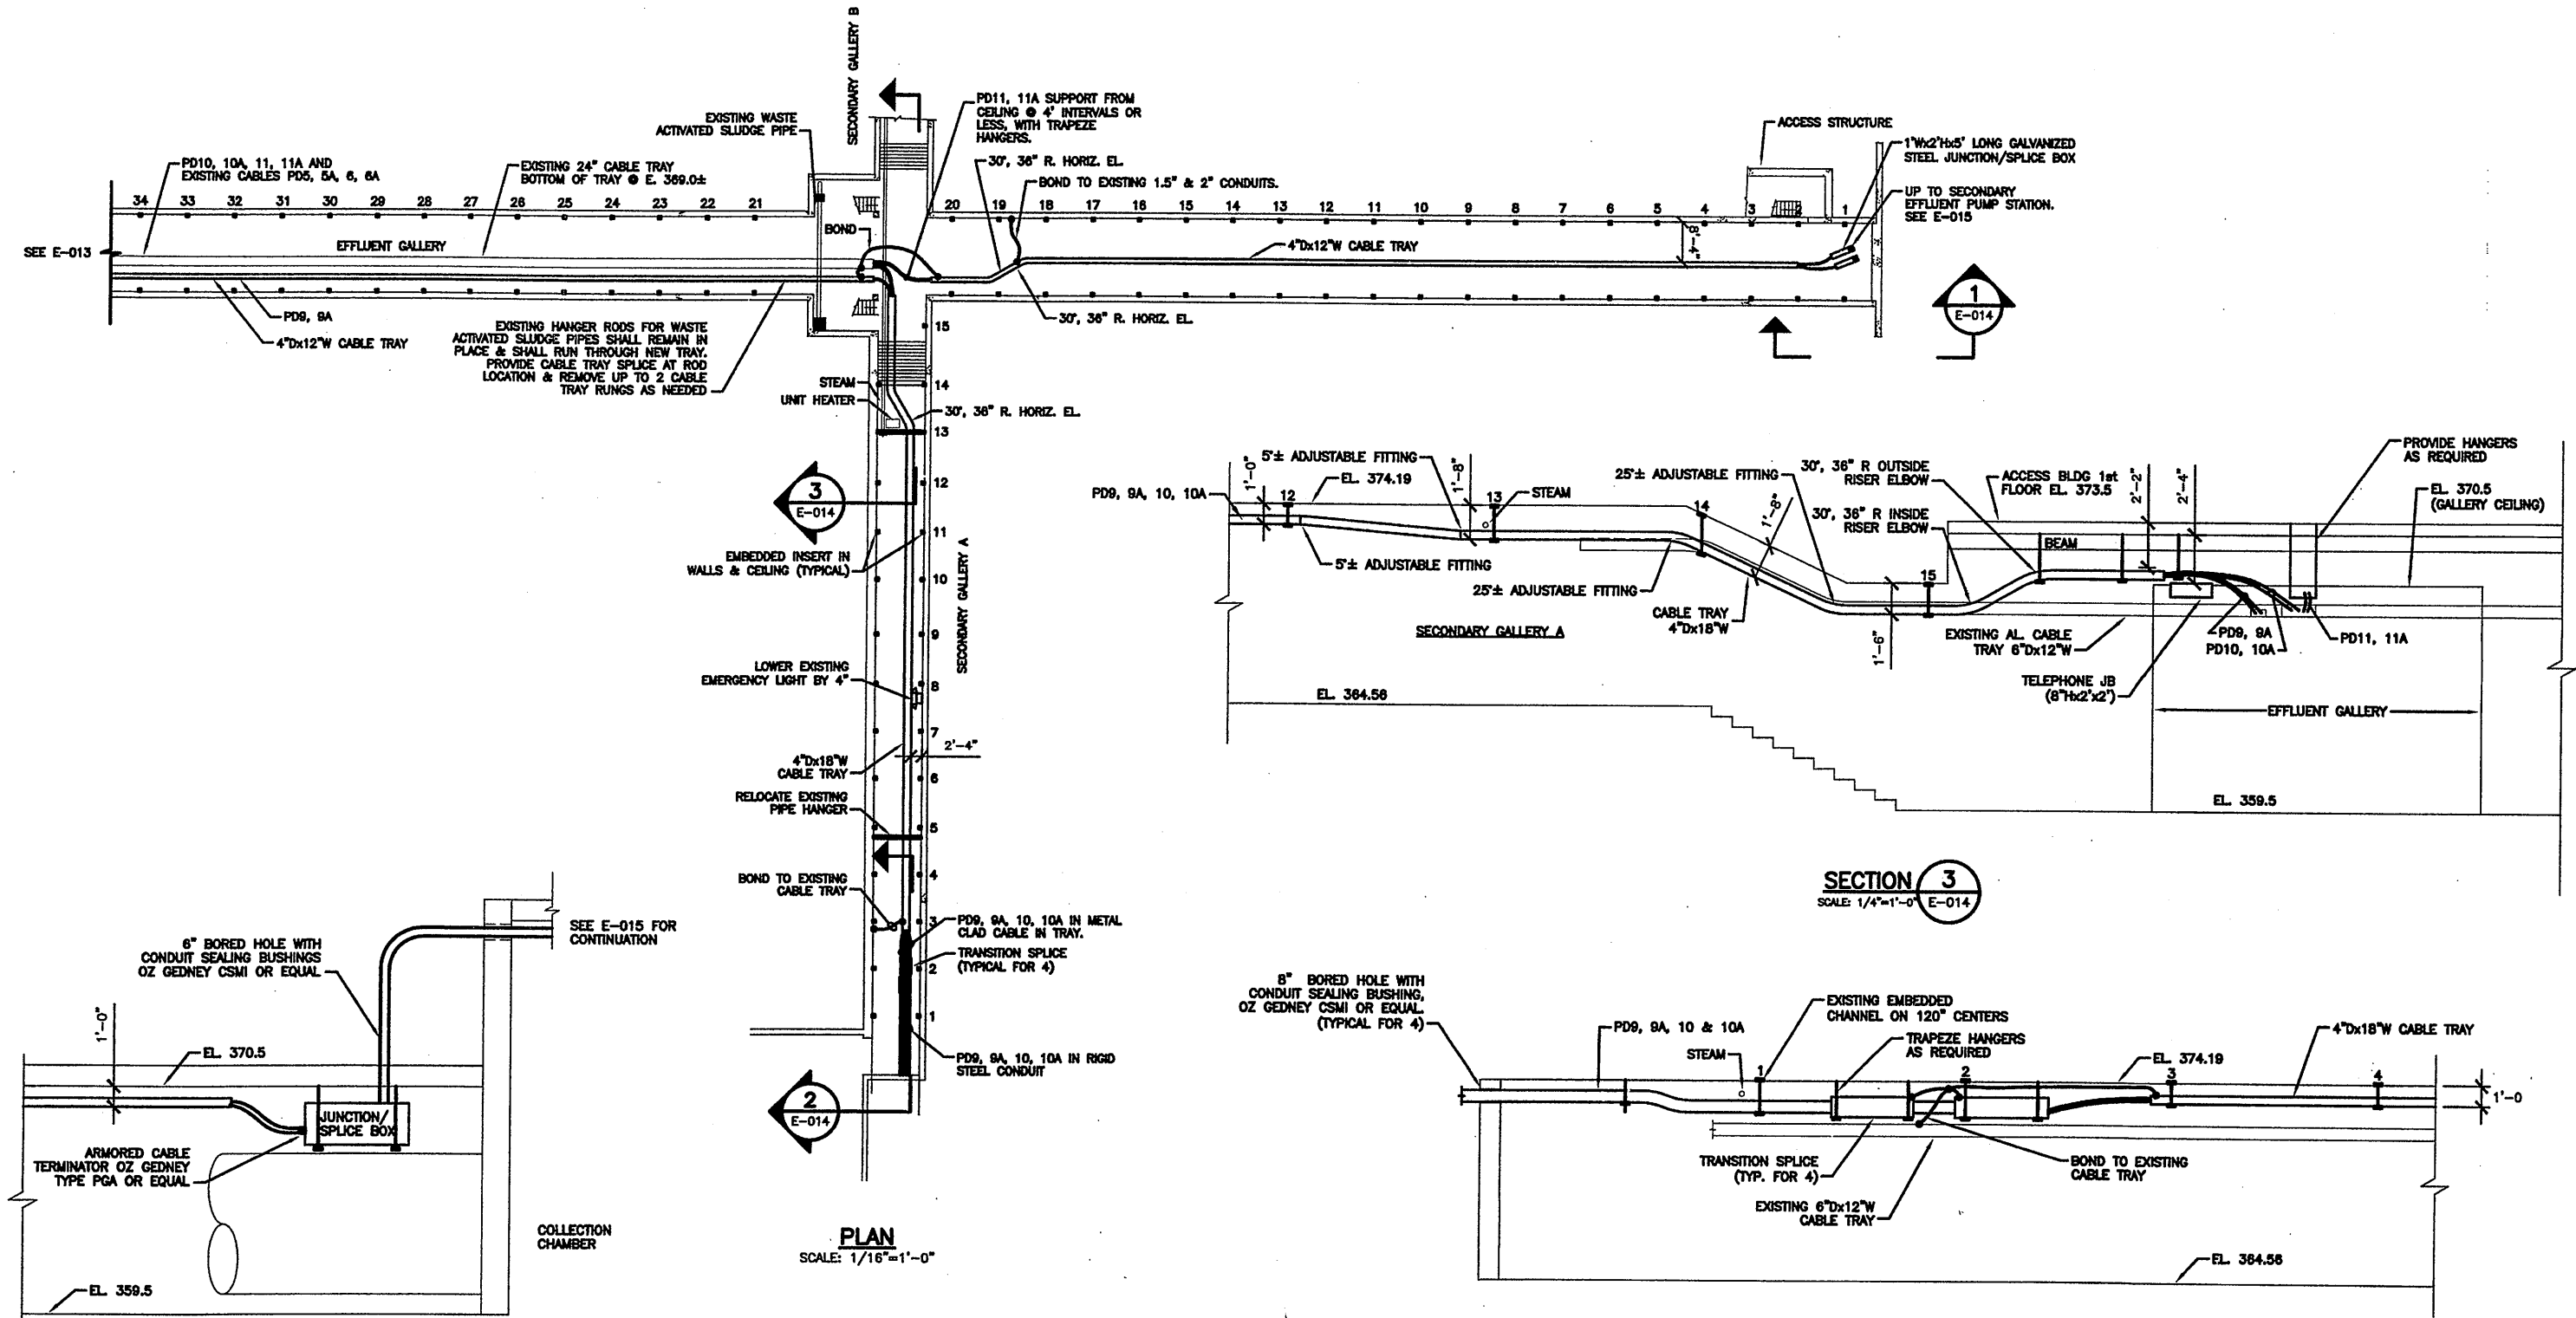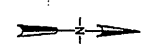

SECTION 1
SCALE: 1/4"=1'-0" E-014

SECTION 2
SCALE: 1/4"=1'-0" E-014

SECTION 3
SCALE: 1/4"=1'-0" E-014

PLAN
SCALE: 1/16"=1'-0"

RECORD DRAWING
THESE DRAWINGS HAVE BEEN REVISIONED TO REFLECT
ALL CHANGES OF ANY KIND OCCURRED DURING
CONSTRUCTION. REVISIONS ARE BASED UPON
INFORMATION SUPPLIED BY CONTRACTOR.
DATE: 10/21/01 PER: [Signature]

SUMMARY OF WORK BY OTHER CONTRACTS:
ALL WORK IS PROVIDED UNDER CONTRACT 4B

THIS DRAWING WAS PREPARED AT THE SCALE INDICATED IN THE
TITLE BLOCK. INACCURACIES IN THE STATED SCALE MAY BE
INTRODUCED WHEN DRAWINGS ARE REPRODUCED BY ANY MEANS.
USE THE GRAPHIC SCALE BAR IN THE TITLE BLOCK TO
DETERMINE THE ACTUAL SCALE OF THIS DRAWING.

03/20/01 OBG CRV

1/4"=1'-0"
1/16"=1'-0"
NO ALTERATIONS PERMITTED HEREON EXCEPT
AS PROVIDED UNDER SECTION 7209 SUBDIVISION
2 OF THE NEW YORK STATE EDUCATION LAW

| No. | Date | Revisions | Init |
|-----|----------|---------------------|-------------|
| 0 | 4/20/01 | ISSUED FOR APPROVAL | [Signature] |
| 1 | | AS BID | |
| 2 | 10/31/05 | RECORD DRAWING | |

In charge of... TEL
Designed by... RAC
Drawn by... CRV
Checked by... WFH


ENVIRONMENTAL ENGINEERING ASSOCIATES, LLP
SYRACUSE, NEW YORK

ONONDAGA COUNTY • DEPARTMENT OF DRAINAGE AND SANITATION • SYRACUSE, NEW YORK
METROPOLITAN SYRACUSE WASTEWATER TREATMENT PLANT
STAGE III AMMONIA AND STAGE II PHOSPHORUS REMOVAL PROJECT
ELECTRICAL
5KV CABLE TRAY PLAN & SECTIONS




File Number
00659
Date
APRIL 2001
E-014


BEAM CLAMP 4 PER SUPPORT, WITH MINIMUM DESIGN LOAD RATING 1200 LBS. (DESIGN LOAD SHALL INCLUDE A SAFETY FACTOR OF 5)

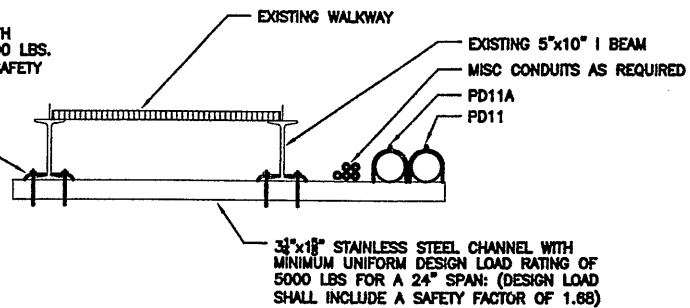

SECTION 1
SCALE: 3/4"=1'-0" E-015

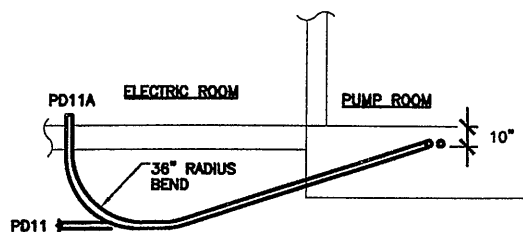

SECTION 2
SCALE: 1/4"=1'-0" E-015

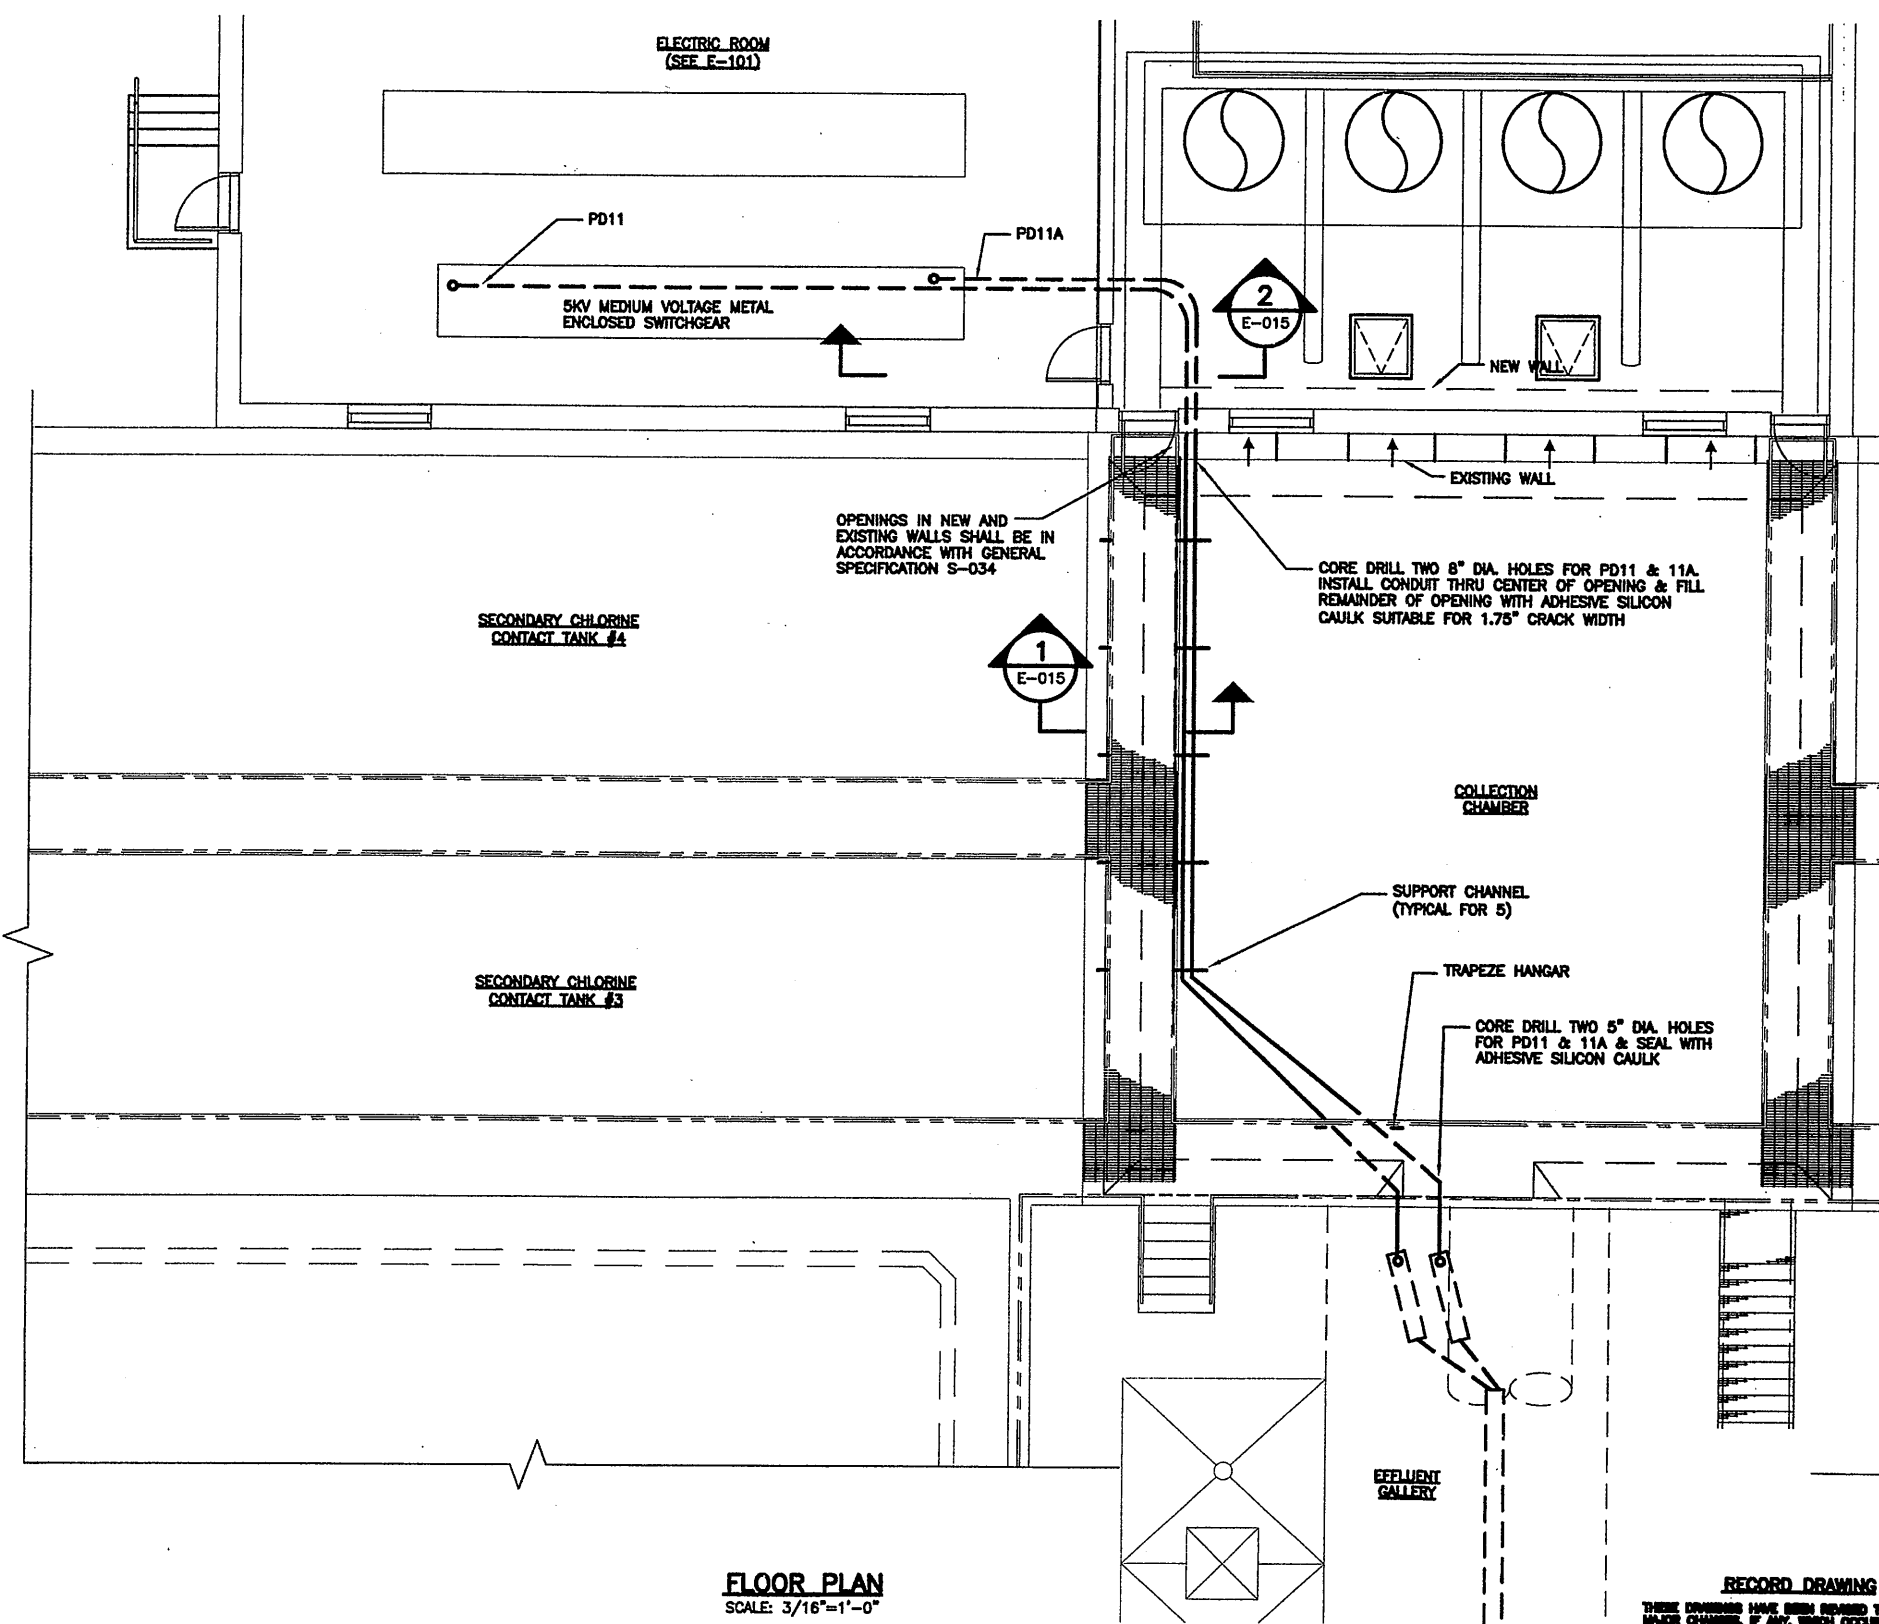

FLOOR PLAN
SCALE: 3/16"=1'-0"


RECORD DRAWING

THESE DRAWINGS HAVE BEEN REVISIONED TO REFLECT MAJOR CHANGES, IF ANY, WHICH OCCURRED DURING CONSTRUCTION. REVISIONS ARE BASED UPON INFORMATION SUPPLIED BY CONTRACTOR.
DATE: 10/21/05 FOR: W&P/let

SUMMARY OF WORK BY OTHER CONTRACTS:
ALL WORK IS PROV. UNDER CONTRACT 48


THIS DRAWING WAS PREPARED AT THE SCALE INDICATED IN THE TITLE BLOCK. INACCURACIES IN THE STATED SCALE MAY BE INTRODUCED WHEN DRAWINGS ARE REPRODUCED BY ANY MEANS. USE THE GRAPHIC SCALE BAR IN THE TITLE BLOCK TO DETERMINE THE ACTUAL SCALE OF THIS DRAWING.

0659X101
03/20/01 OBG CRV
0659E015

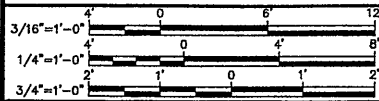


| No. | Date | Revisions | Init |
|-----|----------|---------------------|------|
| 0 | 4/20/01 | ISSUED FOR APPROVAL | TEL |
| 1 | | AS BID | |
| 2 | 10/31/05 | RECORD DRAWING | |

In charge of --- TEL ---
Designed by --- RAC ---
Drawn by --- CRV ---
Checked by --- WFH ---

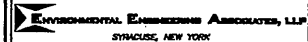

ONONDAGA COUNTY • DEPARTMENT OF DRAINAGE AND SANITATION • SYRACUSE, NEW YORK
METROPOLITAN SYRACUSE WASTEWATER TREATMENT PLANT
STAGE III AMMONIA AND STAGE II PHOSPHORUS REMOVAL PROJECT

**5 KV SECONDARY EFFLUENT PS
PLANS & SECTIONS**
ELECTRICAL


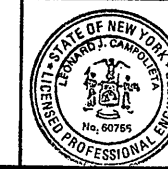


File Number
00659

Date
APRIL 2001

E-015

W&P/let

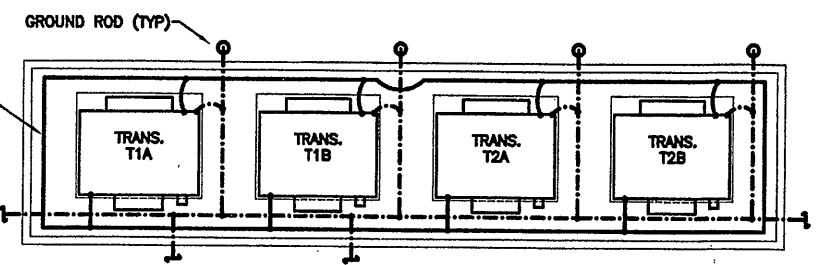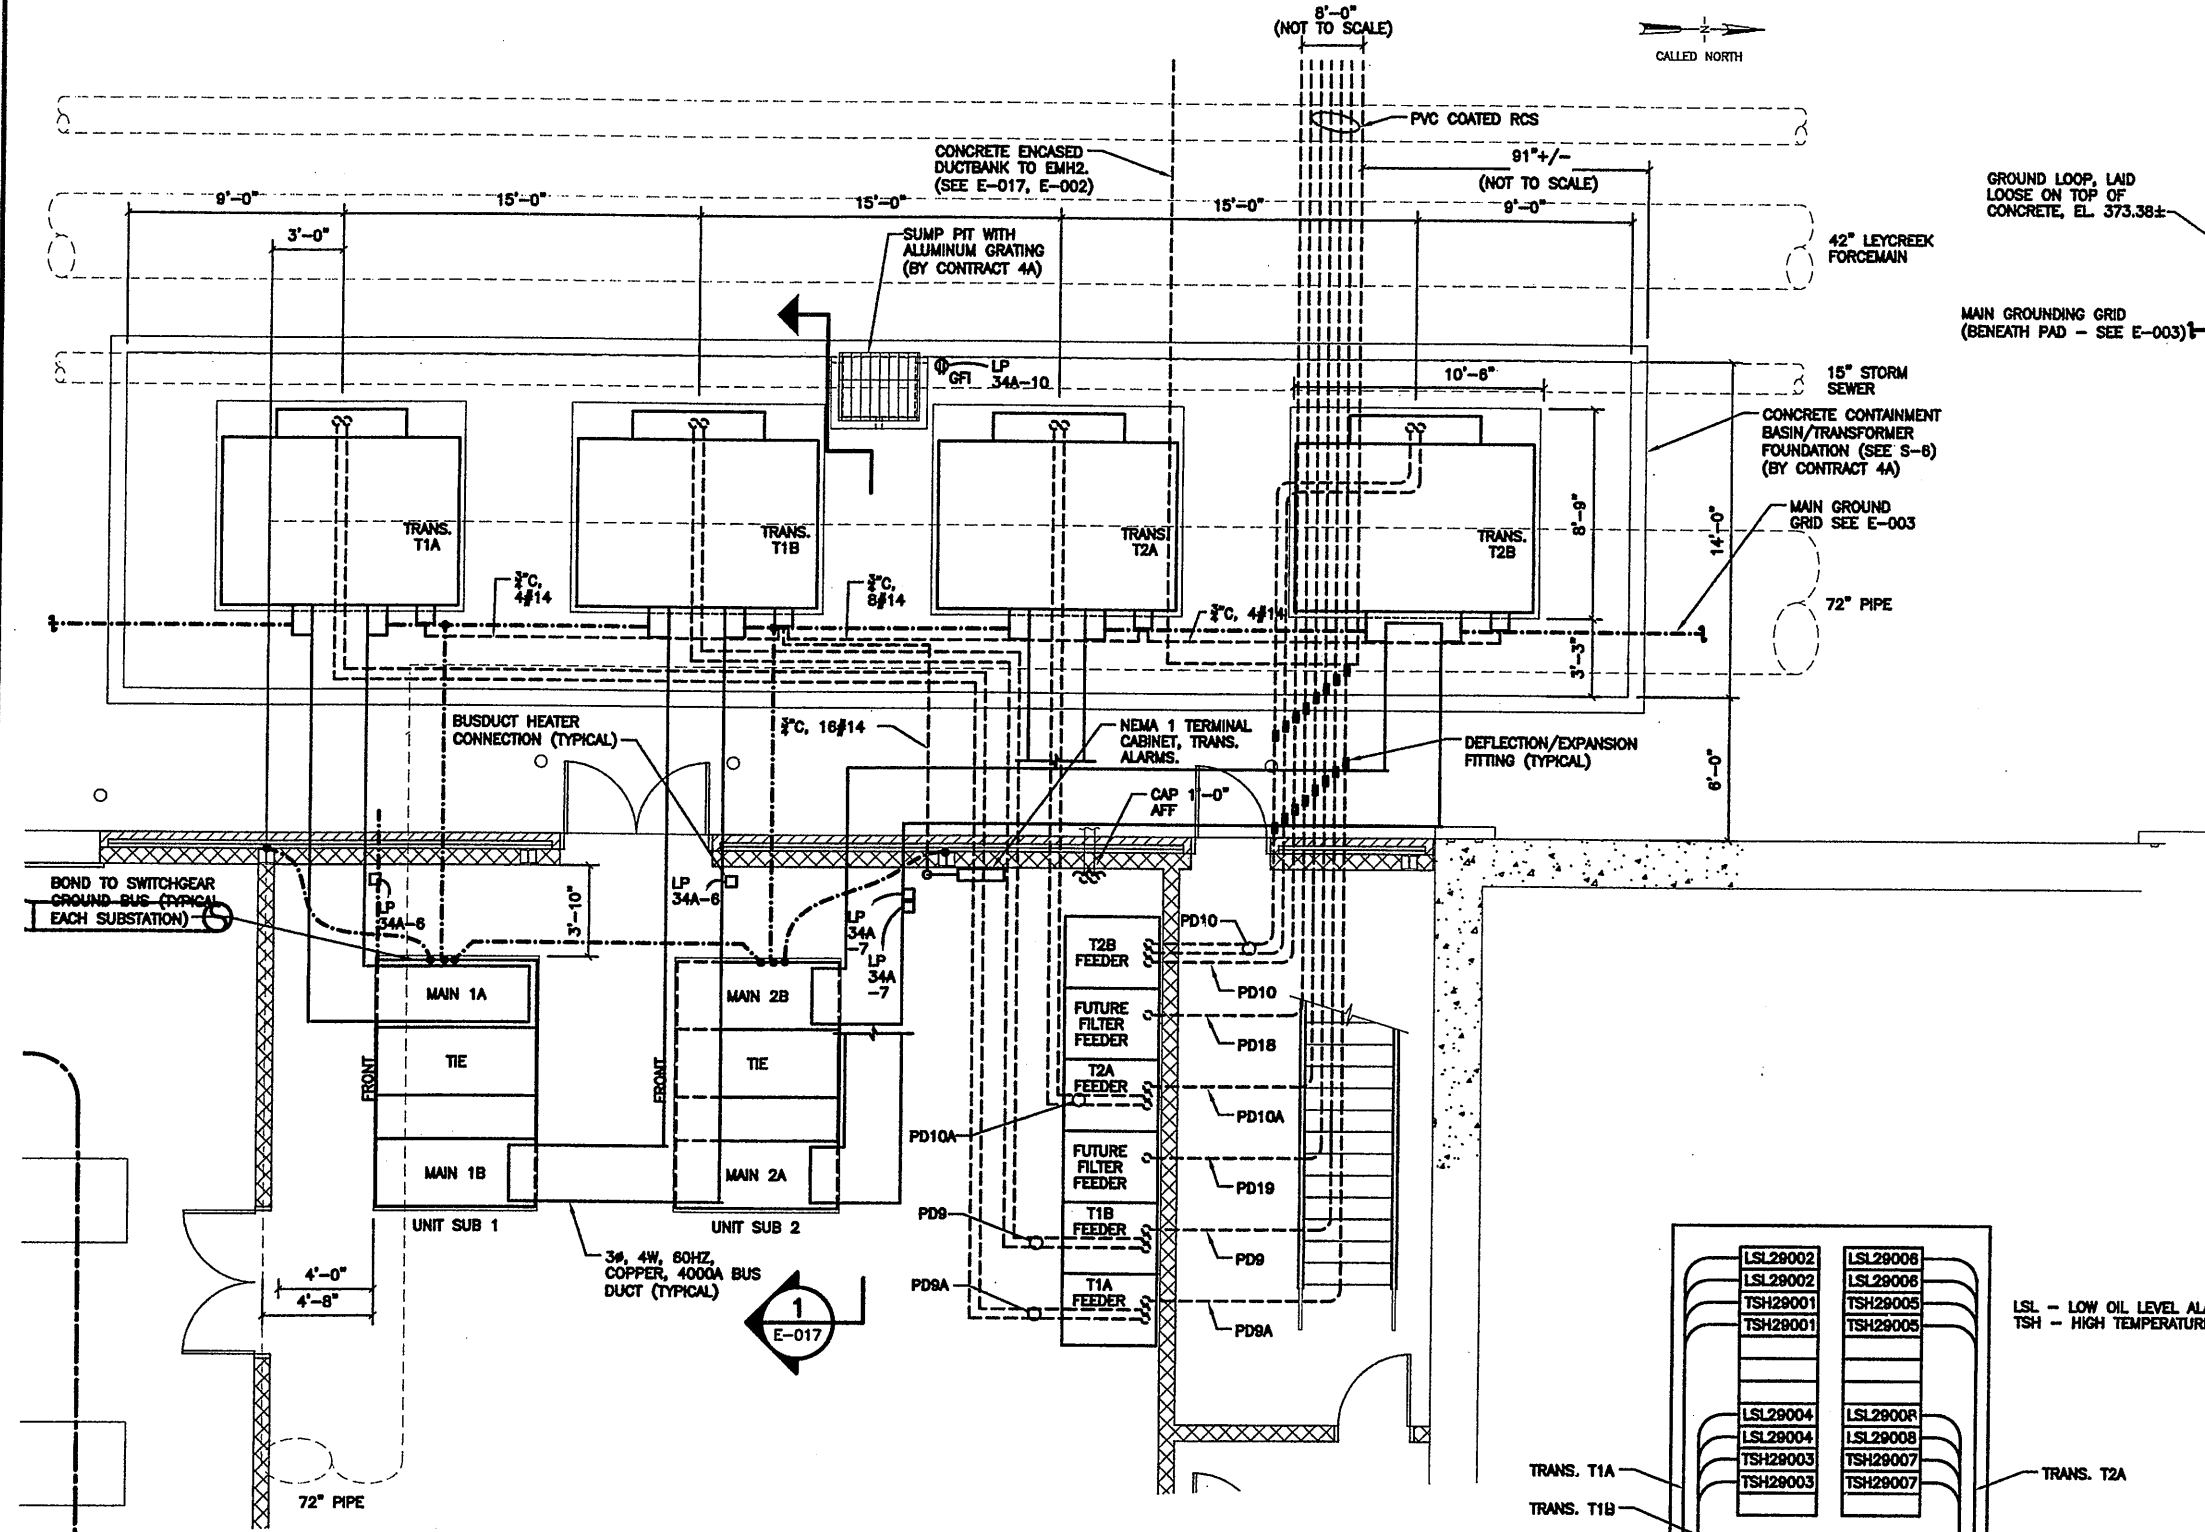


GROUNDING PLAN
SCALE: 1/8"=1'-0"

| VT/CT | SPACE | FEEDER | VT/CT |
|-----------------------|-----------------------|----------------------------------|---------------|
| 1A | 2A | FEEDER HRFS MCC 33 800A 3A | 4A |
| MAIN 1A 4000A | TIE 4000A | FEEDER MCC 34 800A 3B | MAIN 1B 4000A |
| | | FEEDER OPS BLDG MCC 35 800A 3C | |
| 1B/C | 2B/C | FEEDER FUTURE MCC 36 800A 3D | 4B/4C |
| FEEDER MCC 30 800A 1D | FEEDER MCC 31 800A 2D | FEEDER ULTRAVIOLET PDC#1 800A 4D | |

UNIT SUBSTATION 1
SCALE: NOT TO SCALE

| VT/CT | SPACE | FEEDER | VT/CT |
|-----------------------|-----------------------|---|---------------|
| 1A | 2A | FEEDER HRFS MCC 38 800A 3A | 4A |
| MAIN 2B 4000A | TIE 4000A | FEEDER MCC 39 800A 3B | MAIN 2A 4000A |
| | | FEEDER FUTURE MCC 37 800A 3C | |
| 1B/C | 2B/C | FEEDER MCC 16 SEWER MAINTENANCE 200A 3D | 4B/4C |
| FEEDER MCC 42 800A 1D | FEEDER MCC 43 800A 2D | FEEDER ULTRAVIOLET PDC#2 800A 4D | |

UNIT SUBSTATION 2
SCALE: NOT TO SCALE

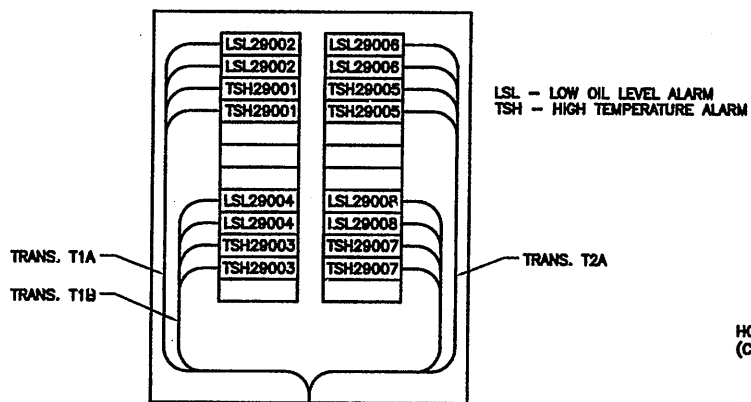

TERMINAL CABINET TRANSFORMER ALARMS
SCALE: NOT TO SCALE

ELECTRICAL ROOM
F.F. EL. 375.39
SCALE: 1/4"=1'-0"
SEE E-202 FOR LOW VOLTAGE POWER PLAN

RECORD DRAWING

THESE DRAWINGS HAVE BEEN REVIEWED TO REFLECT MAJOR CHANGES, IF ANY, WHICH OCCURRED DURING CONSTRUCTION. REVISIONS ARE BASED UPON INFORMATION SUPPLIED BY CONTRACTOR.
DATE: 10/16/05 PER: [Signature]

SUMMARY OF WORK BY OTHER CONTRACTS:
CONTRACT 4A SHALL PROVIDE CONCRETE CONTAINMENT BASIN/TRANSFORMER FOUNDATION & HOUSE KEEPING PADS.

THIS DRAWING WAS PREPARED AT THE SCALE INDICATED IN THE TITLE BLOCK. INACCURACIES IN THE STATED SCALE MAY BE INTRODUCED WHEN DRAWINGS ARE REPRODUCED BY ANY MEANS. USE THE GRAPHIC SCALE BAR IN THE TITLE BLOCK TO DETERMINE THE ACTUAL SCALE OF THIS DRAWING.

0659x201
03/21/01 OBG CRV
0859E018


| No. | Date | Revisions | Init |
|-----|----------|---------------------|------|
| 0 | 4/20/01 | ISSUED FOR APPROVAL | LJC |
| 1 | | AS BID | |
| 2 | 10/31/05 | RECORD DRAWING | |

In charge of TEL
Designed by RAC
Drawn by CRV
Checked by WFH




ONONDAGA COUNTY • DEPARTMENT OF DRAINAGE AND SANITATION • SYRACUSE, NEW YORK
METROPOLITAN SYRACUSE WASTEWATER TREATMENT PLANT
STAGE III AMMONIA AND STAGE II PHOSPHORUS REMOVAL PROJECT

BAF FIRST FLOOR ELECTRICAL PLAN


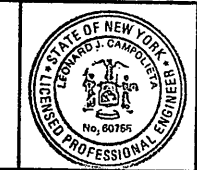


File Number 00659
Date APRIL 2001
E-016


NO ALTERATIONS PERMITTED HEREON EXCEPT AS PROVIDED UNDER SECTION 7209 SUBDIVISION 2 OF THE NEW YORK STATE EDUCATION LAW

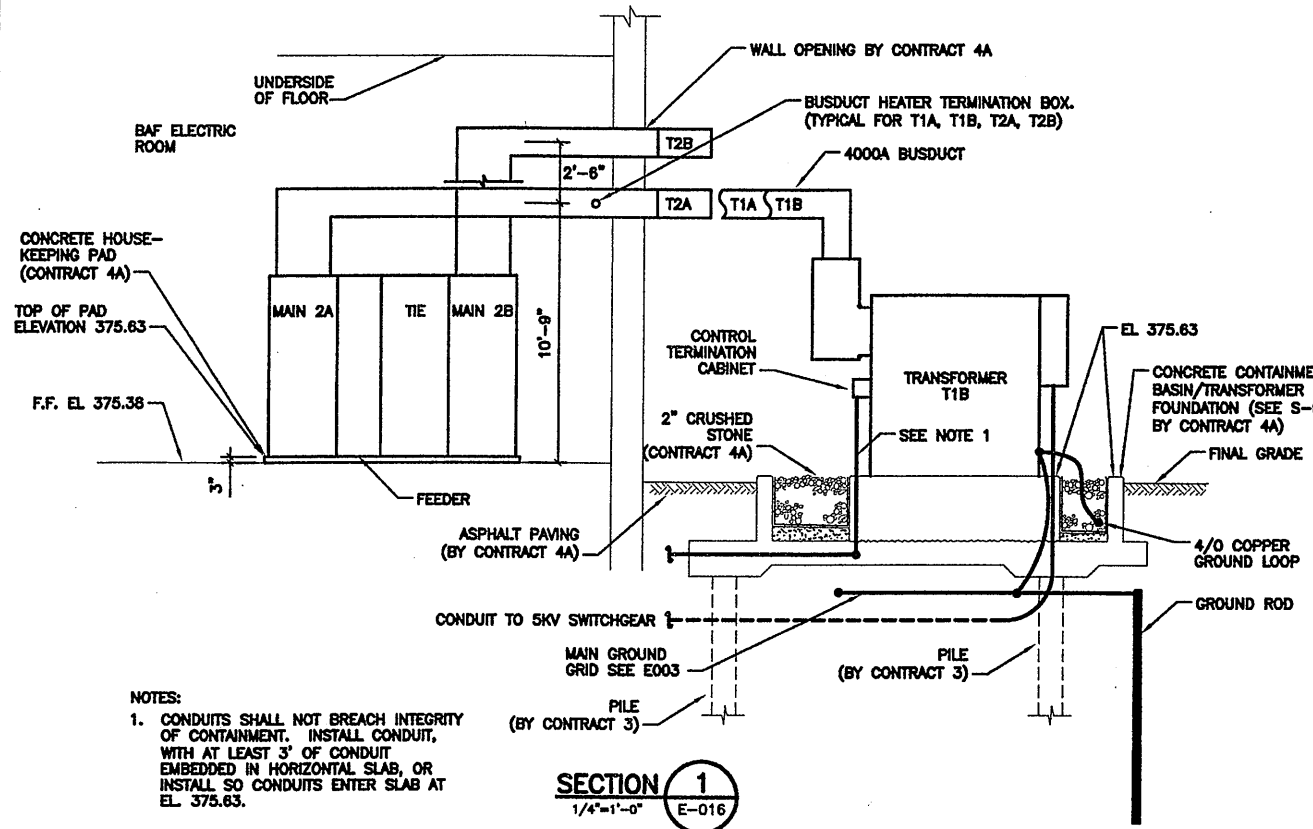

NOTES:
 1. CONDUITS SHALL NOT BREACH INTEGRITY OF CONTAINMENT. INSTALL CONDUIT WITH AT LEAST 3" OF CONDUIT EMBEDDED IN HORIZONTAL SLAB, OR INSTALL SO CONDUITS ENTER SLAB AT EL. 375.63.

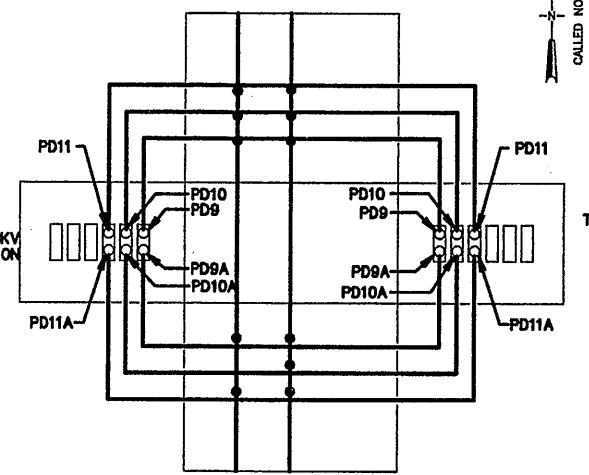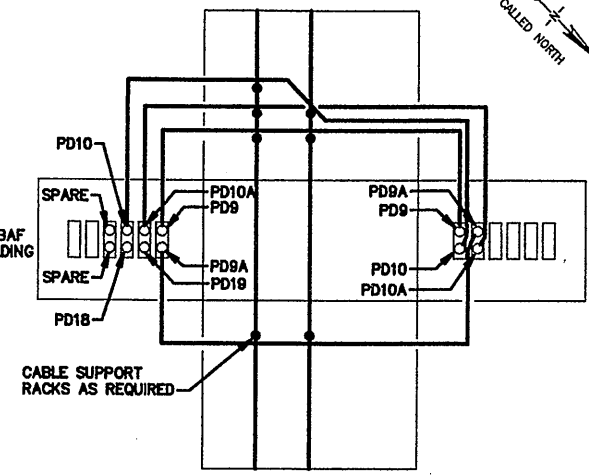


- CONTRACT 4A SHALL PROVIDE CONCRETE CONTAINMENT BASIN/TRANSFORMER FOUNDATION, PAVING, AND HOUSEKEEPING PADS.
- CONTRACT 4A SHALL PROVIDE WALL OPENING FOR BUS DUCT IN ACCORDANCE WITH CONTRACT 4B REQUIREMENTS.
- CONTRACT 3 SHALL PROVIDE PILES.

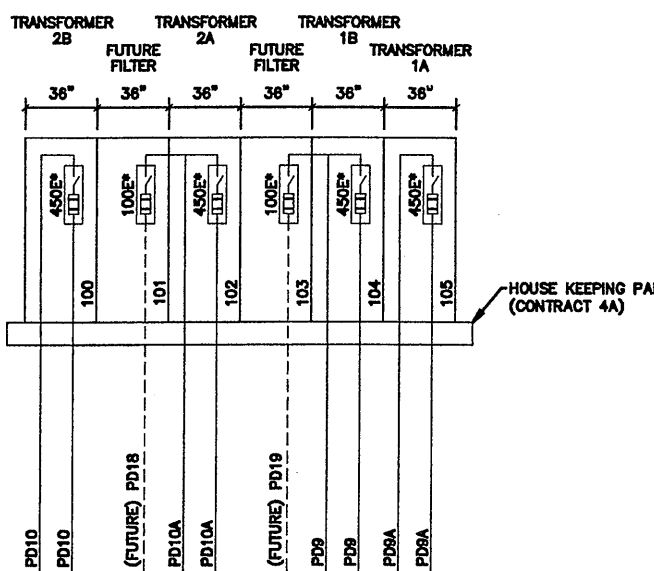

5 KV METAL-ENCLOSED SWITCHGEAR FRONT ELEVATION


* FUSE SIZE IS PRELIMINARY. FINAL FUSE SIZE SHALL BE AS SPECIFIED FOLLOWING RECEIPT OF FUSE & TRANSFORMER SHOP DRAWINGS.

RATINGS:
 RATED VOLTAGE: 4.16KV
 MAXIMUM DESIGN VOLTAGE: 4.76 KV
 IMPULSE WITHSTAND BIL: 60KV
 CONTINUOUS CURRENT: 600 AMPERES (MAIN BUS & SWITCHES)
 LOAD INTERRUPTING CURRENT: 600 AMPERES
 MOMENTARY CURRENT: 40KA ASYM.
 FAULT CLOSE CURRENT: 40KA ASYM.
 ENCLOSURE: INDOOR
 FUSES: GE EJ01.9F82 SERIES

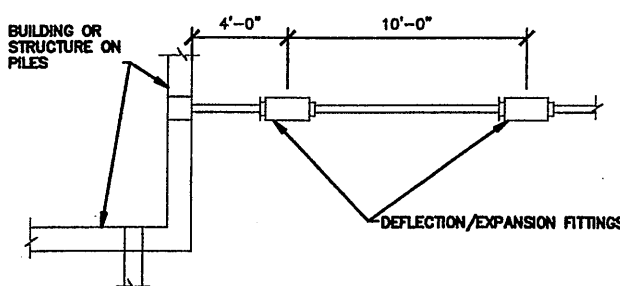


DEFLECTION FITTINGS

NOTE:
 TWO FITTINGS SHALL BE PROVIDED, AT APPROXIMATE DISTANCES SHOWN, FOR EVERY ELECTRICAL CONDUIT PASSING FROM A PILED STRUCTURE TO AN UNPILED STRUCTURE, OR TO BURIAL IN EARTH. WHERE CONDUITS ARE BENEATH BUILDING SLAB, INSTALL FITTINGS AT ACCESSIBLE LOCATION OUTSIDE OF BUILDING PERIMETER.

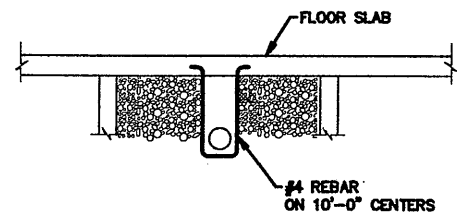

CONDUIT SUPPORT

NOTE:
 WHERE ELECTRICAL CONDUITS ORIGINATE OR TERMINATE IN PILED STRUCTURES, AND CONDUITS LEAVE THE STRUCTURE BENEATH THE STRUCTURE SLAB, SUPPORT CONDUIT FROM FLOOR SLAB AT INTERVALS OF 10' OR LESS.

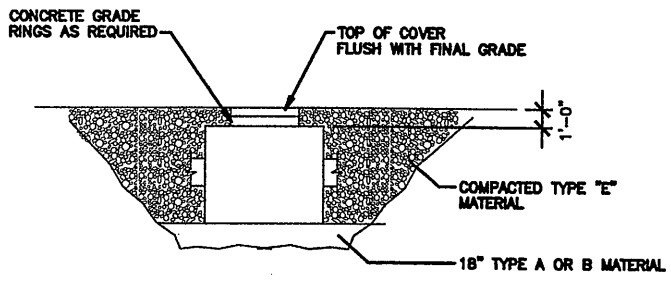

MANHOLE INSTALLATION DETAIL


NOTE:
 WHERE DUCTBANKS ARE CONCRETE ENCASED, PROVIDE #4 DOWELS BETWEEN DUCTBANK & MANHOLE, ON 6" CENTERS AROUND PERIMETER OF DUCT BANK.

RECORD DRAWING

THIS DRAWING HAS BEEN REVISIONED TO REFLECT MAJOR CHANGES, IF ANY, WHICH OCCURRED DURING CONSTRUCTION. REVISIONS ARE BASED UPON INFORMATION SUPPLIED BY CONTRACTORS.
 DATE: 4/21/05 PER: [Signature]

- SUMMARY OF WORK BY OTHER CONTRACTS:
- CONTRACT 4A SHALL PROVIDE CONCRETE CONTAINMENT BASIN/TRANSFORMER FOUNDATION, PAVING, AND HOUSEKEEPING PADS.
 - CONTRACT 4A SHALL PROVIDE WALL OPENING FOR BUS DUCT IN ACCORDANCE WITH CONTRACT 4B REQUIREMENTS.
 - CONTRACT 3 SHALL PROVIDE PILES.

THIS DRAWING WAS PREPARED AT THE SCALE INDICATED IN THE TITLE BLOCK. INACCURACIES IN THE STATED SCALE MAY BE INTRODUCED WHEN DRAWINGS ARE REPRODUCED BY ANY MEANS. USE THE GRAPHIC SCALE BAR IN THE TITLE BLOCK TO DETERMINE THE ACTUAL SCALE OF THIS DRAWING.

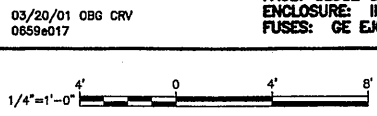


| No. | Date | Revisions | Init |
|-----|----------|---------------------|------|
| 0 | 4/20/01 | ISSUED FOR APPROVAL | TEL |
| 1 | | AS B/D | |
| 2 | 10/31/05 | RECORD DRAWING | |

In charge of: TEL
 Designed by: RAC
 Drawn by: CRV
 Checked by: WFH

ENVIRONMENTAL ENGINEERING ASSOCIATES, LLP
 SYRACUSE, NEW YORK

ONONDAGA COUNTY • DEPARTMENT OF DRAINAGE AND SANITATION • SYRACUSE, NEW YORK
 METROPOLITAN SYRACUSE WASTEWATER TREATMENT PLANT
 STAGE III AMMONIA AND STAGE II PHOSPHORUS REMOVAL PROJECT

**5KV BAF SUBSTATION 1 & 2
 SECTIONS, SCHEDULES**

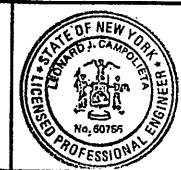

File Number: 00659
 Date: APRIL 2001

E-017

| CIRCUIT BREAKER PANELBOARD -- LPS-1 | | | | | | | | | | SCHEDULE | | | | | | | | | |
|-------------------------------------|---------------------------|--------------------|--------------|-------|------------------------------------|-------|-------|-------|--------------|--------------------|-----------------------|---------|--|--|--------------------|--|--|--|--|
| LOCATION: | | | | | 34.5 KV SUBSTATION M.C. SWITCHGEAR | | | | | FEED FROM | | | | | SWGR UNIT 108 | | | | |
| MAIN BUS RATING: | | | | | 125 AMPERES | | | | | 208/120 VOLTS | | | | | 3 PHASE, 4 WIRE | | | | |
| MINIMUM SHORTCIRCUIT: | | | | | 10,000 AMPERES | | | | | FEEDER CABLE | | | | | 6 #8, 1 #6 NEUTRAL | | | | |
| MAIN BREAKER TRIP: | | | | | 125 AMPERES | | | | | SURFACE MTD | | | | | | | | | |
| ESTIMATED CONNECTED LOAD: | | | | | 50 KVA | | | | | | | | | | | | | | |
| CKT NO. | DESCRIPTION | C/B AMPS/ POLES | LOAD TYPE | KVA | PH-A | PH-B | PH-C | KVA | LOAD TYPE | C/B AMPS/ POLES | DESCRIPTION | CKT NO. | | | | | | | |
| 1 | CAPACITOR CONTROL | 30/1P | MISC. | 0.150 | 0.300 | | | 0.150 | MISC. | 30/1P | CAPACITOR CONTROL | 2 | | | | | | | |
| 3 | COMPARTMENT HEATERS NORTH | 20/1P | HEAT | 1.250 | | 3.250 | | 2.000 | LIGHTS | 20/1P | ASILE LIGHTS | 4 | | | | | | | |
| 5 | COMPARTMENT HEATERS SOUTH | 20/1P | HEAT | 1.250 | | | 1.250 | | | 30/1P | SPARE | 6 | | | | | | | |
| 7 | ASILE HEATER SOUTH | 30 | HEAT | 1.667 | 3.330 | | | 1.667 | HEAT | 30 | ASILE HEATER NORTH | 8 | | | | | | | |
| 9 | ASILE HEATER SOUTH | | HEAT | 1.667 | | 3.330 | | 1.667 | HEAT | | ASILE HEATER NORTH | 10 | | | | | | | |
| 11 | ASILE HEATER SOUTH | 3P | HEAT | 1.667 | | | 3.330 | 1.667 | HEAT | 3P | ASILE HEATER NORTH | 12 | | | | | | | |
| 13 | ASILE HEATER CENTER | 20 | HEAT | 1.000 | 6.290 | | | 5.290 | SUB-FD | 100 | BATTERY BLDG | 14 | | | | | | | |
| 15 | ASILE HEATER CENTER | | HEAT | 1.000 | | 6.610 | | 5.610 | SUB-FD | | BATTERY BLDG | 16 | | | | | | | |
| 17 | ASILE HEATER CENTER | 3P | HEAT | 1.000 | | | 6.410 | 5.410 | SUB-FD | 3P | BATTERY BLDG | 18 | | | | | | | |
| 19 | COMPARTMENT HTRS, BANK 1 | 20 | HEAT | 1.125 | 2.125 | | | 1.000 | MISC. | 20 | TRANS. 1 CABINET | 20 | | | | | | | |
| 21 | COMPARTMENT HTRS, BANK 1 | 2P | HEAT | 1.125 | | 2.125 | | 1.000 | MISC. | 2P | TRANS. 1 CABINET | 22 | | | | | | | |
| 23 | COMPARTMENT HTRS, BANK 2 | 2P | HEAT | 1.125 | | | 1.125 | 1.000 | MISC. | 20 | TRANS. 2 CABINET | 24 | | | | | | | |
| 25 | COMPARTMENT HTRS, BANK 2 | 2P | HEAT | 1.125 | 2.125 | | | 1.000 | MISC. | 2P | TRANS. 2 CABINET | 26 | | | | | | | |
| 27 | BATTERY CHARGER/SPARE | 2P | MISC. | 1.040 | | | 2.640 | 1.600 | LIGHTS | 30/1P | STRUCTURE LIGHTS | 28 | | | | | | | |
| 29 | BATTERY CHARGER/SPARE | 2P | MISC. | 1.040 | | | | | AC | 30/1P | AIR CONDITIONER/SPARE | 30 | | | | | | | |
| 31 | SPARE | 30/1P | | | 0.300 | | | 0.300 | HEAT | 20/1P | OCB1 HEATERS | 32 | | | | | | | |
| 33 | LIGHTS/RECEPTACLES | 20/1P | LIGHTS | 0.400 | | 0.400 | | 0 | MISC | 10/1P | TRANS. 1 LTC | 34 | | | | | | | |
| 35 | TRANS. 1 LTC | 10/1P | MISC. | 0.000 | | | 0.180 | 0.180 | RECEPT | 15/1P | RECEPTACLE | 36 | | | | | | | |
| 37 | | | | | | | | | | | | 38 | | | | | | | |
| 39 | | | | | | | | | | | | 40 | | | | | | | |
| 41 | | | | | | | | | | | | | | | | | | | |
| LOAD SUMMARY | | | | 17.63 | 14.47 | 18.36 | 14.34 | 29.54 | | | | | | | | | | | |

- NOTE:
- ALL CONDUCTORS TO BE 2 #12, 1 #12G IN 3/4 INCH CONDUIT UNLESS OTHERWISE SHOWN. SEE NOTE 7
 - THIS PANELBOARD IS EXISTING GENERAL ELECTRIC TYPE NLAB WITH BOLT-ON BREAKERS.
 - CHANGE CKT 3,5 BREAKERS FROM 30/1P TO 20/1P AND USE TO SUPPLY COMPARTMENT HEATERS IN NEW METAL-CLAD SWITCHGEAR.
 - CHANGE CKT 14/16/18 FROM 20/3P TO 100/3P AND USE TO SUPPLY BATTERY BUILDING.
 - CHANGE CKT 4 BREAKER FROM 30/1P TO 20/1P AND USE TO SUPPLY AISLE LIGHTS IN NEW AND EXISTING METAL-CLAD SWITCHGEAR.
 - DISCONNECT & REMOVE EXISTING WIRING CONNECTED TO CKT27/29 (BATTERY CHARGER) AND CKT 30 (AIR CONDITIONER).
 - RECONNECT CIRCUIT LPSI-33 TO SUPPLY ONLY EXTERIOR LIGHTS & AISLE RECEPTACLES

| CIRCUIT BREAKER PANELBOARD -- LPS-2 | | | | | | | | | | SCHEDULE | | | | | | | | | |
|-------------------------------------|----------------------|--------------------|--------------|-------|-------------------------------------|-------|-------|--------|--------------|--------------------|-----------------|---------|--|--|-----------------|--|--|--|--|
| LOCATION: | | | | | 34.5 KV SUBSTATION BATTERY BUILDING | | | | | FEED FROM | | | | | LPS-1,14,16,18 | | | | |
| MAIN BUS RATING: | | | | | 100 AMPERES | | | | | 208/120 VOLTS | | | | | 3 PHASE, 4 WIRE | | | | |
| MINIMUM SHORTCIRCUIT: | | | | | 10,000 AMPERES | | | | | FEEDER CABLE | | | | | 4 #1, 1 #1 GRD | | | | |
| MAIN BREAKER TRIP: | | | | | 100 AMPERES | | | | | SURFACE MTD | | | | | | | | | |
| ESTIMATED CONNECTED LOAD: | | | | | 17 KVA | | | | | | | | | | | | | | |
| CKT NO. | DESCRIPTION | C/B AMPS/ POLES | LOAD TYPE | KVA | PH-A | PH-B | PH-C | KVA | LOAD TYPE | C/B AMPS/ POLES | DESCRIPTION | CKT NO. | | | | | | | |
| 1 | AIR CONDITIONER | 15 | AC | 0.400 | 4.570 | | | 4.170 | HEAT | 50 | UNIT HEATER | 2 | | | | | | | |
| 3 | AIR CONDITIONER | 2P | AC | 0.400 | | 4.570 | | 4.170 | HEAT | | UNIT HEATER | 4 | | | | | | | |
| 5 | INTERIOR LIGHTS | 20/1P | LIGHTS | 0.200 | | | 4.370 | 4.170 | HEAT | 3P | UNIT HEATER | 6 | | | | | | | |
| 7 | INTERIOR RECEPTACLES | 20/1P | RECEPT | 0.360 | 0.720 | | | 0.360 | MOTOR | 20/1P | FAN & LOUVER | 8 | | | | | | | |
| 9 | SPARE | 20/1P | | | | 1.040 | | 1.040 | MISC. | 20 | BATTERY CHARGER | 10 | | | | | | | |
| 11 | SPARE | 20/1P | | | | | 1.040 | 1.040 | MISC. | 2P | BATTERY CHARGER | 12 | | | | | | | |
| 13 | SPARE | 20/1P | | | 0.000 | | | | | 20/1P | SPARE | 14 | | | | | | | |
| 15 | SPARE | 20/1P | | | | 0.000 | | | | 20/1P | SPARE | 16 | | | | | | | |
| 17 | SPARE | 20/1P | | | | | 0.000 | | | 20/1P | SPARE | 18 | | | | | | | |
| 19 | SPARE | 20/1P | | | | 0.000 | | | | 20/1P | SPARE | 20 | | | | | | | |
| 21 | SPARE | 20/1P | | | | | 0.000 | | | 20/1P | SPARE | 22 | | | | | | | |
| LOAD SUMMARY | | | | 1.360 | 5.290 | 5.610 | 5.410 | 14.950 | | | | | | | | | | | |

- NOTE:
- ALL CONDUCTORS TO BE 2 #12, 1 #12G IN 3/4 INCH CONDUIT UNLESS OTHERWISE SHOWN. SEE NOTE 7

| CKT NO. | CONDUIT SIZE | NO. & SIZE CONDUCTORS | FROM | TO |
|---------------|-------------------|-----------------------|-----------------------------|------------------------------------|
| LPS1-1 | 3/4" (EXISTING) | 2#8 (EXISTING) | LPS1 | CAPACITOR BANK NO. 1 |
| LPS1-2 | 3/4" (EXISTING) | 2#8 (EXISTING) | LPS1 | CAPACITOR BANK NO. 2 |
| LPS1-3 | SEE NOTE 1 | 3#12 | LPS1 | SWGR. COMPT. HEATERS, NORTH |
| LPS1-4 | 3/4" | 2#12, 1 #12 GRD | LPS1 | LIGHTS, NEW SWGR. |
| LPS1-5 | SEE NOTE 1 | 3#12 | LPS1 | SWGR. COMPT. HEATERS, SOUTH |
| LPS1-14,16,18 | 2" | 4#1, 1 #1 GRD | LPS1 | LPS2, BATTERY BLDG. |
| LPS1-20A,22A | 3/4" (EXISTING) | 2#12 (EXISTING) | LPS1 (SEE NOTE 2) | TRANSFORMER 1 CABINET |
| LPS1-24A,26A | 3/4" (EXISTING) | 2#12 (EXISTING) | LPS1 (SEE NOTE 2) | TRANSFORMER 2 CABINET |
| LPS1-32 | 3/4" (EXISTING) | 2#12 (EXISTING) | LPS1 | OCB1 HEATERS |
| LPS1-32A | 3/4" (EXISTING) | 2#12 (EXISTING) | LPS1 | OCB2 HEATERS |
| LPS1-34 | 3/4" (EXISTING) | 2#12 (EXISTING) | LPS1 | TRANSFORMER 1 LTC |
| LPS1-35 | 3/4" (EXISTING) | 2#12 (EXISTING) | LPS1 | TRANSFORMER 2 LTC |
| LPS2-1,3 | 3/4" | 2#12, 1 #12 GRD | LPS2 | AIR CONDITIONER |
| LPS2-2,4,6 | 1" | 3#8, 1 #8 GRD | LPS2 | UNIT HEATER |
| LPS2-10,12 | 3/4" | 2#12, 1 #12 GRD | LPS2 | EXHAUST FAN CONTROL PANEL |
| LPS2-10,12A | 3/4" | 2#12, 1 #12 GRD | EXHAUST FAN CONTROL PANEL | BATTERY CHARGER |
| LPS2-8,8A,8B | 3/4" | 2#12, 1 #12 GRD | EXHAUST FAN CONTROL PANEL | EXHAUST FAN LOUVER OPERATOR |
| DR1 | 3" (SEE NOTE 6) | 4#14, TWISTED PAIRS | SHELTERED AISLE/NMPC METERS | 3rd FLOOR, PLANT OPERATIONS BLDG. |
| DR1 | 3/4" (SEE NOTE 3) | 2#12 (SEE NOTE 3) | DC PANEL | OCB 1, AIR SWITCH 1 |
| DR2 | 3/4" (SEE NOTE 3) | 2#12 (SEE NOTE 3) | DC PANEL | OCB 2, AIR SWITCH 2 |
| OS1 | 3/4" (EXISTING) | 4#10 (EXISTING) | SHELTERED AISLE | CAPACITOR BANK 1 |
| OS2 | 3/4" (EXISTING) | 4#10 (EXISTING) | SWITCHGEAR UNIT 116 | CAPACITOR BANK 2 |
| CR1 | 3/4" (EXISTING) | 4#12 (EXISTING) | SWITCHGEAR UNIT 107 | OCB #1 CTS |
| CR2 | 3/4" (EXISTING) | 4#12 (EXISTING) | SWITCHGEAR UNIT 118 | OCB #2 CTS |
| CR3 | 1" (EXISTING) | 12#12 (EXISTING) | SWITCHGEAR UNIT 108 | TRANSFORMER 1 CABINET |
| CR4 | 1" (EXISTING) | 12#12 (EXISTING) | SWITCHGEAR UNIT 117 | TRANSFORMER 2 CABINET |
| CR5 | 3/4" (EXISTING) | 2#12 (EXISTING) | SWITCHGEAR UNIT 108 | NEUTRAL CT 1 |
| CR6 | 3/4" (EXISTING) | 2#12 (EXISTING) | SWITCHGEAR UNIT 117 | NEUTRAL CT 2 |
| CR7 | 2" (EXISTING) | 32#12 (EXISTING) | SWITCHGEAR UNIT 110 | 34.5 KV TIE SWITCH (89) |
| TR1 | 1" (EXISTING) | 12#12 (EXISTING) | SWITCHGEAR UNIT 107 | OCB1 CONTROL |
| TR2 | 1" (EXISTING) | 12#12 (EXISTING) | SWITCHGEAR UNIT 118 | OCB2 CONTROL |
| DR3 | 1" (SEE NOTE 3) | 2#2 (SEE NOTE 3) | DC PANEL | EXISTING SWITCHGEAR D.C. |
| DR4 | 1" | 2#2 | DC PANEL | NEW SWITCHGEAR D.C. BUS |
| DR5 | - | 2#4/0 | BATTERY | BATTERY MAIN FUSE |
| DR6 | - | 2#10 | BATTERY MAIN FUSE | CHARGER FUSE & CHARGER |
| DR7 | 2 | 2#4/0 | BATTERY MAIN FUSE | DC PANEL |
| CR8 | 1" | - | SWITCHGEAR SHELTERED AISLE | BATTERY BUILDING |
| CR9 | 3/4" | 2#14 | SWITCHGEAR SHELTERED AISLE | BATTERY BUILDING EMERGENCY ASSIST. |

- NOTES:
- WHERE FEASIBLE, CONDUCTORS MAY BE INSTALLED IN EXISTING WIREWAY. PROVIDE NEW WIREWAY OR 3/4" WHERE REQUIRED.
 - WIRING FROM LPS1 TO EXISTING 208/230 VOLT AUTO TRANSFORMER, TO MAIN TRANSFORMER CABINET IS EXISTING. PROVIDE CONDUIT AND WIRE AT TRANSFORMER AS REQUIRED TO SUPPLY FANS.
 - RECONNECT EXISTING OCB AND SWITCHGEAR DC CIRCUITS TO NEW DC PANEL.
 - 120V OR 208V CIRCUITS NOT SCHEDULED SHALL CONSIST OF #12 CONDUCTORS WITH #12 GROUND IN 3/4" CONDUIT, UNLESS OTHERWISE SHOWN.
 - EXISTING CONDUITS AND CONDUCTORS ARE SHOWN FOR REFERENCE ONLY AND MAY NOT REFLECT AS-BUILT CONDITIONS. CONDUIT SIZES, CONDUCTOR SIZES, AND CONDUCTOR QUANTITIES SHALL BE FIELD VERIFIED BEFORE DISCONNECTING OR MODIFYING ANY EXISTING CONDUITS OR CONDUCTORS.
 - EXISTING CONDUCTORS SHALL BE REMOVED FROM NMPC METER PANEL TO 3rd FLOOR OF PLANT OPERATIONS BUILDING. EXISTING 3" CONDUIT SHALL BE REMOVED FROM THE MAIN GALLERY/ CHEMICAL GALLERY INTERSECTION TO THE POINT WHERE THE CONDUIT ENTERS THE 1st FLOOR OF THE PLANT OPERATIONS BUILDING.
 - CONDUITS WITHIN METAL-CLAD SWITCHGEAR SHALL BE RIGID GALVANIZED STEEL CONDUITS. CONDUITS NOT WITHIN METAL-CLAD SWITCHGEAR SHALL BE PVC COATED RIGID GALVANIZED STEEL.

SUMMARY OF WORK BY OTHER CONTRACTS:
ALL WORK IS PROVIDED UNDER CONTRACT 48

RECORD DRAWING

THESE DRAWINGS HAVE BEEN REVISIONED TO REFLECT WORK CHANGES, IF ANY, WHICH OCCURRED DURING CONSTRUCTION. REVISIONS ARE BASED UPON INFORMATION SUPPLIED BY CONTRACTOR.

DATE: 10/31/05 FOR: [Signature]

THIS DRAWING WAS PREPARED AT THE SCALE INDICATED IN THE TITLE BLOCK. INACCURACIES IN THE STATED SCALE MAY BE INTRODUCED WHEN DRAWINGS ARE REPRODUCED BY ANY MEANS. USE THE GRAPHIC SCALE BAR IN THE TITLE BLOCK TO DETERMINE THE ACTUAL SCALE OF THIS DRAWING.

02/28/01 086 PWW
0659e018

| No. | Date | Revisions | Init |
|-----|----------|---------------------|------|
| 0 | 4/20/01 | ISSUED FOR APPROVAL | Jlc |
| 1 | | AS BID | |
| 2 | 10/31/05 | RECORD DRAWING | |

In charge of ___ TEL ___
Designed by ___ RAC ___
Drawn by ___ CRV ___
Checked by ___ WFH ___



ONONDAGA COUNTY • DEPARTMENT OF DRAINAGE AND SANITATION • SYRACUSE, NEW YORK
METROPOLITAN SYRACUSE WASTEWATER TREATMENT PLANT
STAGE III AMMONIA AND STAGE II PHOSPHORUS REMOVAL PROJECT



MAIN SUBSTATION SCHEDULES

ELECTRICAL




File Number
00659
Date
APRIL 2001
[Signature]

E-018

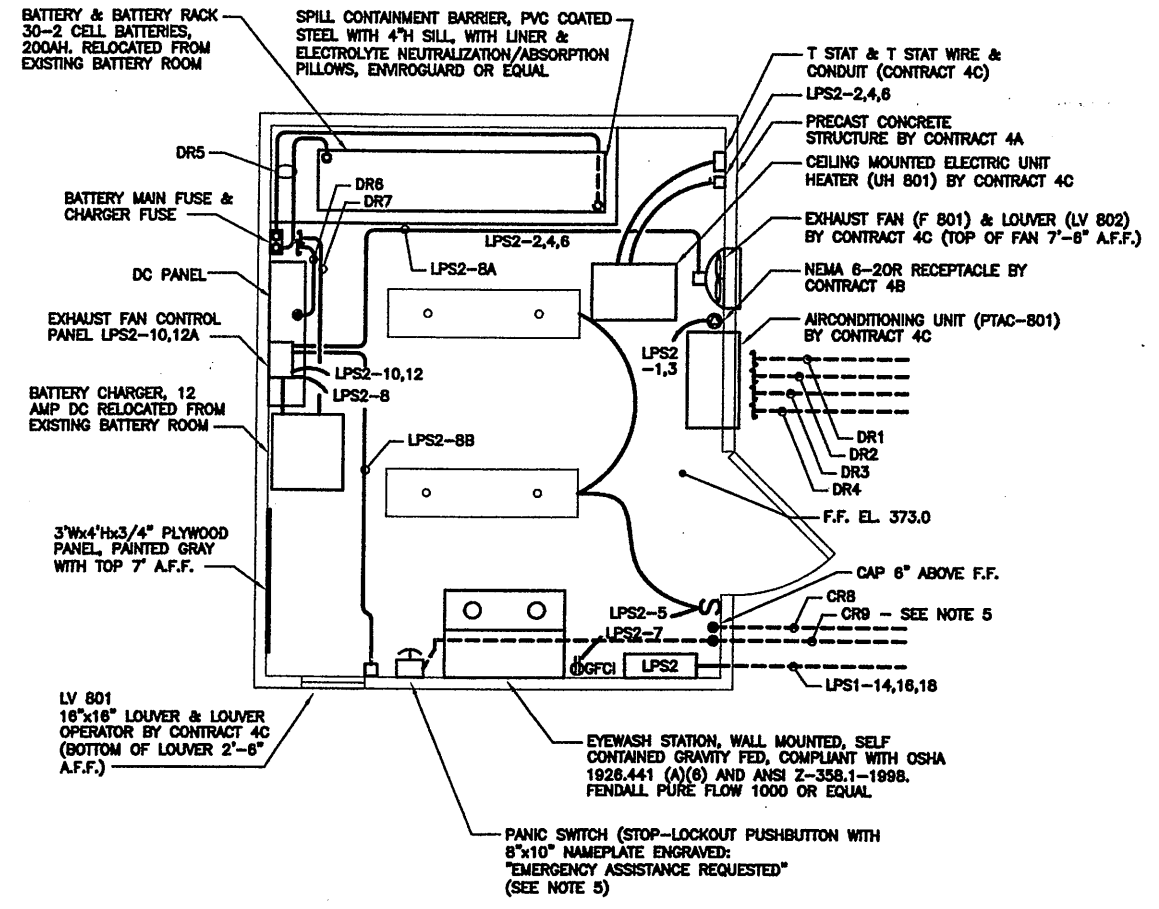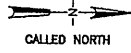

BATTERY BUILDING - 34.5KV SUBSTATION
1/2"=1'-0"

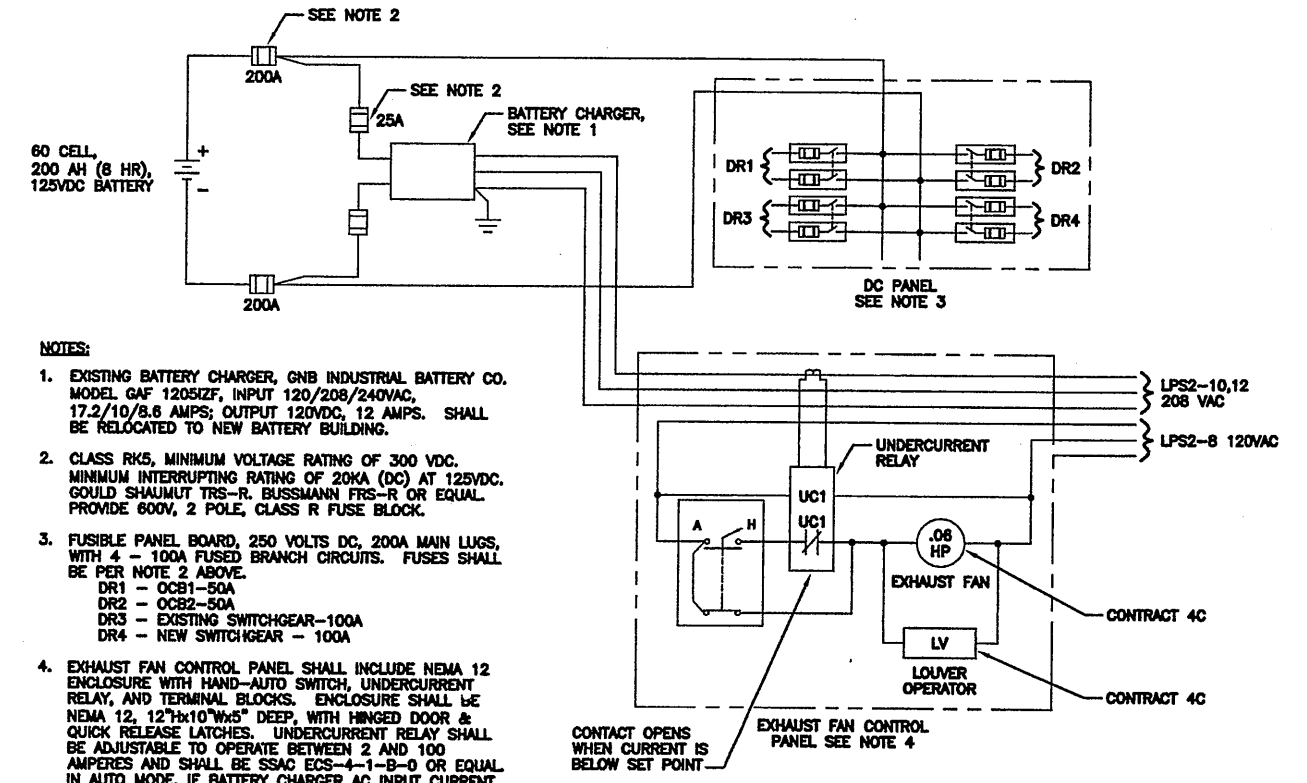

- NOTES:**
- EXISTING BATTERY CHARGER, GNB INDUSTRIAL BATTERY CO. MODEL GAF 120SIZF, INPUT 120/208/240VAC, 17.2/10/8.8 AMPS; OUTPUT 120VDC, 12 AMPS. SHALL BE RELOCATED TO NEW BATTERY BUILDING.
 - CLASS RK5, MINIMUM VOLTAGE RATING OF 300 VDC. MINIMUM INTERRUPTING RATING OF 20KA (DC) AT 125VDC. GOULD SHAUMUT TRS-R. BUSSMANN FRS-R OR EQUAL. PROVIDE 600V, 2 POLE, CLASS R FUSE BLOCK.
 - FUSIBLE PANEL BOARD, 250 VOLTS DC, 200A MAIN LUGS, WITH 4 - 100A FUSED BRANCH CIRCUITS. FUSES SHALL BE PER NOTE 2 ABOVE.
DR1 - OCB1-50A
DR2 - OCB2-50A
DR3 - EXISTING SWITCHGEAR-100A
DR4 - NEW SWITCHGEAR - 100A
 - EXHAUST FAN CONTROL PANEL SHALL INCLUDE NEMA 12 ENCLOSURE WITH HAND-AUTO SWITCH, UNDERCURRENT RELAY, AND TERMINAL BLOCKS. ENCLOSURE SHALL BE NEMA 12, 12"x10"x5" DEEP, WITH HINGED DOOR & QUICK RELEASE LATCHES. UNDERCURRENT RELAY SHALL BE ADJUSTABLE TO OPERATE BETWEEN 2 AND 100 AMPERES AND SHALL BE SSAG ECS-4-1-B-0 OR EQUAL IN AUTO MODE, IF BATTERY CHARGER AC INPUT CURRENT DECREASES BELOW SET POINT OF APPROXIMATELY 3 AMPS, UNDERCURRENT RELAY SHALL ENERGIZE AND ITS OUTPUT CONTACT SHALL OPEN, DE-ENERGIZING EXHAUST FAN. WHEN AC INPUT CURRENT INCREASES TO 3 AMPS OR MORE, RELAY SHALL DE-ENERGIZE, ITS OUTPUT CONTACT SHALL CLOSE, AND EXHAUST FAN SHALL OPERATE. FINAL RELAY SETTING SHALL BE 10% ABOVE NORMAL CHARGER AC INPUT CURRENT.
 - CONNECT TO AUXILIARY CONTACT INPUT ON THE BREAKER DISTRIBUTION PROTECTION RELAY IN UNIT 100.


ELEMENTARY DIAGRAM DC POWER SUPPLY & VENTILATION SYSTEM
NOT TO SCALE

SUMMARY OF WORK BY OTHER CONTRACTS:
1. CONTRACT 4A SHALL PROVIDE PRECAST CONCRETE STRUCTURE, INCLUDING SITE PREPARATION FOR STRUCTURE. REFERENCE S-606.
2. CONTRACT 4C SHALL PROVIDE ELECTRIC UNIT HEATER WITH THERMOSTAT & THERMOSTAT WIRING, EXHAUST FAN WITH LOUVER, INTAKE LOUVER WITH OPERATOR, AND AIR CONDITIONING UNIT. REF H-401.

RECORD DRAWING
THIS DRAWING HAS BEEN REVISIONED TO REFLECT CHANGES MADE DURING CONSTRUCTION. THESE CHANGES ARE BASED UPON INFORMATION SUPPLIED BY CONTRACTOR.
DATE: 10/21/05 PER: [Signature]

THIS DRAWING WAS PREPARED AT THE SCALE INDICATED IN THE TITLE BLOCK. INACCURACIES IN THE STATED SCALE MAY BE INTRODUCED WHEN DRAWINGS ARE REPRODUCED BY ANY MEANS. USE THE GRAPHIC SCALE BAR IN THE TITLE BLOCK TO DETERMINE THE ACTUAL SCALE OF THIS DRAWING.

03/21/01 OBG CRV
0559ED19

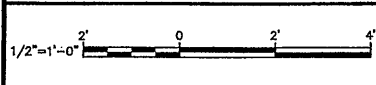


| No. | Date | Revisions | Init |
|-----|----------|---------------------|-------------|
| 0 | 4/20/01 | ISSUED FOR APPROVAL | [Signature] |
| 1 | | AS BID | |
| 2 | 10/31/05 | RECORD DRAWING | |

In charge of ___ TEL ___
Designed by ___ RAC ___
Drawn by ___ CRV ___
Checked by ___ WFH ___



ONONDAGA COUNTY • DEPARTMENT OF DRAINAGE AND SANITATION • SYRACUSE, NEW YORK
METROPOLITAN SYRACUSE WASTEWATER TREATMENT PLANT
STAGE III AMMONIA AND STAGE II PHOSPHORUS REMOVAL PROJECT

34.5 KV SUBSTATION BATTERY BUILDING
ELECTRICAL

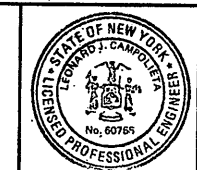

File Number
00659
Date
APRIL 2001

E-019

LIGHTING FIXTURE SCHEDULE

| TYPE | DESCRIPTION | LOCATION | LAMPS | BALLAST | VOLTAGE | MANUFACTURER |
|------|---|---|--|--|---------|--|
| A | WALL MOUNTED FIXTURE WITH ALUMINUM HOUSING WHITE ENAMEL FINISH AND HIGH-IMPACT DEEP ACRYLIC DIFFUSER. | THROUGHOUT BUILDINGS | 2-32 WATT T-8 FLUORESCENTS | ELECTRONIC, OFF STARTING TEMPERATURE | 120VAC | LITHONIA DMA SERIES OR EQUAL |
| B | UNDERCABINET FIXTURE WITH STEEL HOUSING, WHITE ENAMEL FINISH, ACRYLIC DIFFUSER AND ON/OFF ROCKER SWITCH. | OPERATIONS CENTER (I/E & LAB) | 1-32 WATT T-8 FLUORESCENT | ELECTRONIC | 120VAC | LITHONIA 2UC SERIES OR EQUAL |
| C | WALL, SURFACE OR PENDANT MOUNTED FIXTURE WITH ALUMINUM HOUSING, WHITE ENAMEL FINISH, HIGH-IMPACT DEEP ACRYLIC DIFFUSER AND WET LOCATION FITTINGS. FIXTURE SHALL BE SUITABLE FOR WET AREAS. | THROUGHOUT BUILDINGS | 2-32 WATT T-8 FLUORESCENT | ELECTRONIC, OFF STARTING TEMPERATURE | 120VAC | LITHONIA DMAW SERIES OR EQUAL |
| D | SURFACE MOUNTED DOCK LIGHTING FIXTURE WITH 60° ARM AND WIRE GUARD. | UV DISINFECTION | 1-100 WATT METAL HALIDE | HIGH REACTANCE, HIGH POWER FACTOR | 120VAC | FOSTORIA MODEL DKL-80VA MH OR EQUAL |
| E | SURFACE MOUNTED EMERGENCY LIGHTING UNIT WITH 12 VOLT MAINTENANCE-FREE LEAD CALCIUM BATTERY, CHARGER AND TEST PUSHBUTTON. FIXTURE SHALL BE SUITABLE FOR WET AREAS. | THROUGHOUT BUILDINGS | 2-12 WATT HALOGEN | - | 120VAC | LITHONIAL ELU4X SERIES OR EQUAL |
| F | SURFACE MOUNTED FLOODLIGHT WITH WIDE BEAM DISTRIBUTION, DARK BRONZE FINISH AND WALL MOUNTING BRACKET. FIXTURE SHALL BE SUITABLE FOR WET AREAS WITH MARINE UL 595 RATING. | THROUGHOUT BUILDINGS | 1-250 WATT METAL HALIDE | REGULATOR | 208VAC | WIDELITE EFX SERIES OR EQUAL |
| G | WALL MOUNTED WRAP-AROUND FIXTURE WITH STEEL HOUSING, WHITE ENAMEL FINISH AND MATT WHITE ACRYLIC DIFFUSER. | OPERATIONS CENTER | 2-32 WATT T-8 FLUORESCENTS | ELECTRONIC | 120VAC | LITHONIA WC 240 SERIES OR EQUAL |
| H | WALL MOUNTED WRAP-AROUND FIXTURE WITH STEEL HOUSING, WHITE ENAMEL FINISH AND MATT WHITE ACRYLIC DIFFUSER. | OPERATIONS CENTER | 2-17 WATT T-8 FLUORESCENTS | ELECTRONIC | 120VAC | LITHONIA WC 220 SERIES OR EQUAL |
| I | WALL MOUNTED UPLIGHT/DOWNLIGHT WITH STEEL HOUSING, FINISH TO BE SELECTED BY ENGINEER AND WHITE, REGRESSED CROSS BAFFLES. | OPERATIONS CENTER (STAIR #2) | 2-32 WATT T-8 FLUORESCENTS | ELECTRONIC | 120VAC | ICE WMARI SERIES OR EQUAL |
| J | 2'x2', RECESSED, STATIC TROFFER FIXTURE WITH STEEL HOUSING, WHITE ENAMEL FINISH, FLUSH DOOR AND ACRYLIC DIFFUSER. | OPERATIONS CENTER | 4-17WATT T-8 FLUORESCENTS | ELECTRONIC, DIMMABLE | 120VAC | LITHONIA 2SP SERIES OR EQUAL |
| K | 2'x2', RECESSED STATIC TROFFER FIXTURE WITH STEEL HOUSING, WHITE ENAMEL FINISH AND 4" DEEP, 9 CELL, DIFFUSE SILVER PARABOLIC LOUVER. | OPERATIONS CENTER (SCADA ROOM & CONTROL ROOM) | 4-17WATT T-8 FLUORESCENTS | ELECTRONIC, DIMMABLE | 120VAC | LITHONIAL 2PM4 SERIES OR EQUAL |
| L1 | PENDANT MOUNTED, ENCLOSED LOW BAY FIXTURE WITH ALUMINUM CONSTRUCTION, CORROSION RESISTANT HARDWARE, ACRYLIC REFRACTOR AND AUXILIARY QUARTZ RESTRIKE. FIXTURE SHALL BE SUITABLE FOR WET AREAS. | SECONDARY EFFLUENT PUMPING STATION & CHEMICAL BLDG. "C" | 1-250 WATT METAL HALIDE 1-150 WATT QUARTZ | REGULATOR, BI-LEVEL | 120VAC | WIDELITE LBII SERIES OR EQUAL |
| L2 | PENDANT MOUNTED, ENCLOSED LOW BAY FIXTURE WITH ALUMINUM CONSTRUCTION, CORROSION RESISTANT HARDWARE AND ACRYLIC REFRACTOR. FIXTURE SHALL BE SUITABLE FOR WET AREAS. | SECONDARY EFFLUENT PUMPING STATION & CHEMICAL BLDG "C" | 1-250 WATT METAL HALIDE | REGULATOR | 120VAC | WIDELITE LBII SERIES OR EQUAL |
| M | RECESSED, OPEN DOWNLIGHT WITH ALUMINUM HOUSING, WHITE FLANGE AND CLEAR 6" DIAMETER REFLECTOR. | OPERATIONS CENTER | 2-28 WATT COMPACT FLUORESCENT | ELECTRONIC, DIMMABLE | 120VAC | LITHONIA AF SERIES OR EQUAL |
| N | RECESSED, ENCLOSED DOWNLIGHT WITH ALUMINUM HOUSING, WHITE FLANGE, CLEAR 7" DIAMETER REFLECTOR AND PRISMATIC LENS. FIXTURE SHALL BE SUITABLE FOR WET AREAS. | OPERATIONS CENTER EXTERIOR | 1-50 WATT METAL HALIDE | HIGH REACTANCE | 120VAC | LITHONIA LGH SERIES OR EQUAL |
| O | RECESSED, ENCLOSED DOWNLIGHT WITH STEEL HOUSING, FLUSH WHITE FLANGE AND 12" SQUARE PRISMATIC LENS. FIXTURE SHALL BE SUITABLE FOR WET AREAS. | OPERATIONS CENTER SHOWERS | 2-28 WATT COMPACT FLUORESCENT | ELECTRONIC | 120VAC | LITHONIA LAF SERIES OR EQUAL |
| P | PENDANT MOUNTED, OPEN FIXTURE WITH 10% UPLIGHT, STEEL REFLECTOR AND WHITE ENAMEL FINISH. | THROUGHOUT BUILDINGS | 2-32 WATT T-8 FLUORESCENTS | ELECTRONIC, OFF STARTING TEMPERATURE | 120VAC | LITHONIA AF SERIES OR EQUAL |
| Q | SURFACE MOUNTED TRACK LIGHTING UNIT WITH 8', SINGLE CIRCUIT, 20 AMP TRACK, THREE OPEN ROUNDBACK CYLINDER FIXTURES AND ALL FITTINGS, MOUNTING HARDWARE AND ACCESSORIES AS NECESSARY. TRACK AND FIXTURES SHALL HAVE WHITE FINISH. | OPERATIONS CENTER PRESENTATION ROOM | 3-250 WATT QUARTZ (10' BEAM SPREAD) | - | 120VAC | LITHONIA TB SERIES TRACK & TCR SERIES FIXTURES OR EQUAL |
| S | TWIN POLE MOUNTED STREET LIGHTING FIXTURES WITH ALUMINUM HOUSINGS, ALZAK REFLECTORS (TYPE II DISTRIBUTION), LENSES AND MOUNTING ARMS. FIXTURES SHALL BE SUITABLE FOR WET AREAS. POLE SHALL BE 20', 4" SQUARE, NON-TAPERED STEEL. FIXTURES AND POLE SHALL HAVE DARK BRONZE FINISH. | EXTERIOR | 2-250 WATT METAL HALIDE | REGULATOR | 480VAC | WIDELITE XLM SERIES OR EQUAL |
| S1 | SINGLE POLE MOUNTED STREET LIGHTING FIXTURE WITH ALUMINUM HOUSING, ALZAK REFLECTOR (TYPE II DISTRIBUTION), LENS AND MOUNTING ARM. FIXTURE SHALL BE SUITABLE FOR WET AREAS. POLE SHALL BE 20', 4" SQUARE, NON-TAPERED, STEEL. FIXTURE AND POLE SHALL HAVE DARK BRONZE FINISH. | EXTERIOR | 1-250 WATT METAL HALIDE | REGULATOR | 480VAC | WIDELITE XLM SERIES OR EQUAL |
| S2 | SINGLE POLE MOUNTED WALKWAY LIGHTING FIXTURE WITH ALUMINUM HOUSING, ALZAK REFLECTOR (TYPE II DISTRIBUTION), LENS AND MOUNTING ARM. FIXTURE SHALL BE SUITABLE FOR WET AREAS. POLE SHALL BE 12', 4" SQUARE, NON-TAPERED, STEEL. FIXTURE AND POLE SHALL HAVE DARK BRONZE FINISH. | EXTERIOR | 1-175 WATT METAL HALIDE | REGULATOR | 480VAC | WIDELITE XLM SERIES OR EQUAL |
| W1 | WALL MOUNTED WALL-PACK FIXTURE WITH ALUMINUM HOUSING, LEXAN REFRACTOR, MEDIUM NON-CUTOFF TYPE II DISTRIBUTION AND DARK BRONZE FINISH. FIXTURE SHALL BE SUITABLE FOR WET AREAS. | EXTERIOR | 1-250 WATT METAL HALIDE | REGULATOR | 120VAC | GENERAL ELECTRIC WALLLIGHTER SERIES OR EQUAL |
| W2 | WALL MOUNTED WALL-PACK FIXTURE WITH ALUMINUM HOUSING, LEXAN REFRACTOR, MEDIUM NON-CUTOFF TYPE II DISTRIBUTION AND DARK BRONZE FINISH. FIXTURE SHALL BE SUITABLE FOR WET AREAS. | EXTERIOR | 1-175 WATT METAL HALIDE | REGULATOR | 120VAC | GENERAL ELECTRIC WALLLIGHTER SERIES OR EQUAL |
| W3 | WALL MOUNTED WALL-PACK FIXTURE WITH ALUMINUM HOUSING, LEXAN REFRACTOR, MEDIUM NON-CUTOFF TYPE II DISTRIBUTION AND DARK BRONZE FINISH. FIXTURE SHALL BE SUITABLE FOR WET AREAS. | EXTERIOR | 1-100 WATT METAL HALIDE | REGULATOR | 120VAC | GENERAL ELECTRIC WALLLIGHTER SERIES OR EQUAL |
| X | SURFACE OR CEILING MOUNTED, SINGLE FACED EXIT SIGN, SELF POWERED WITH RED LETTERS, WHITE FACE AND DIRECTION ARROWS. DOUBLE FACED EXIT SIGNS, WHERE SHOWN ON LIGHTING PLANS, SHALL CONSIST OF TWO SINGLE FACED EXIT SIGNS MOUNTED BACK-TO-BACK. | THROUGHOUT BUILDINGS | TRITIUM GAS TUBES | - | - | SRB TECHNOLOGIES BETALUX MODEL #171 OR EQUAL |
| - | TIME CLOCK SHALL BE ASTRONOMICAL TYPE WITH WALL MOUNTED ENCLOSURE, 16 HOUR SPRING BACKUP AND SINGLE POLE, DOUBLE THROW, 120VAC CONTACTS. | UV DISINFECTION | - | - | 120VAC | INTERMATIC T50000 SERIES OR EQUAL |
| - | PHOTOELECTRIC CELL SHALL BE EXTERIOR, SURFACE MOUNTED TYPE WITH 120VAC CONTACT. CONTACT SHALL CLOSE AT APPROXIMATELY 3 FOOTCANDLES AND OPEN AT APPROXIMATELY 12 FOOTCANDLES. | EXTERIOR | - | - | 120VAC | GENERAL ELECTRIC OR EQUAL |

07/01/01 086 CRV
0659e020

NOT TO SCALE

NO ALTERATIONS PERMITTED HEREON EXCEPT AS PROVIDED UNDER SECTION 7209 SUBDIVISION 2 OF THE NEW YORK STATE EDUCATION LAW

| No. | Date | Revisions | Init |
|-----|----------|----------------|------|
| 0 | | AS BID | we |
| 1 | 10/31/05 | RECORD DRAWING | |


In charge of ___ PLD ___
Designed by ___ JJC ___
Drawn by ___ CRV ___
Checked by ___ PLD ___



ONONDAGA COUNTY • DEPARTMENT OF DRAINAGE AND SANITATION • SYRACUSE, NEW YORK
METROPOLITAN SYRACUSE WASTEWATER TREATMENT PLANT
STAGE III AMMONIA AND STAGE II PHOSPHORUS REMOVAL PROJECT

LIGHTING FIXTURE SCHEDULE


ELECTRICAL

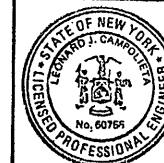

RECORD DRAWING
THESE CHANGES HAVE BEEN MADE TO REFLECT MAJOR CHANGES, IF ANY, WHICH OCCURRED DURING CONSTRUCTION. REVISIONS ARE BASED UPON INFORMATION SUPPLIED BY CONTRACTOR.
DATE: 10/21/05 PER: [Signature]

THIS DRAWING WAS PREPARED AT THE SCALE INDICATED IN THE TITLE BLOCK. INACCURACIES IN THE STATED SCALE MAY BE INTRODUCED WHEN DRAWINGS ARE REPRODUCED BY ANY MEANS. USE THE GRAPHIC SCALE BAR IN THE TITLE BLOCK TO DETERMINE THE ACTUAL SCALE OF THIS DRAWING.

File Number
00659
Date
JULY 2001
E-020

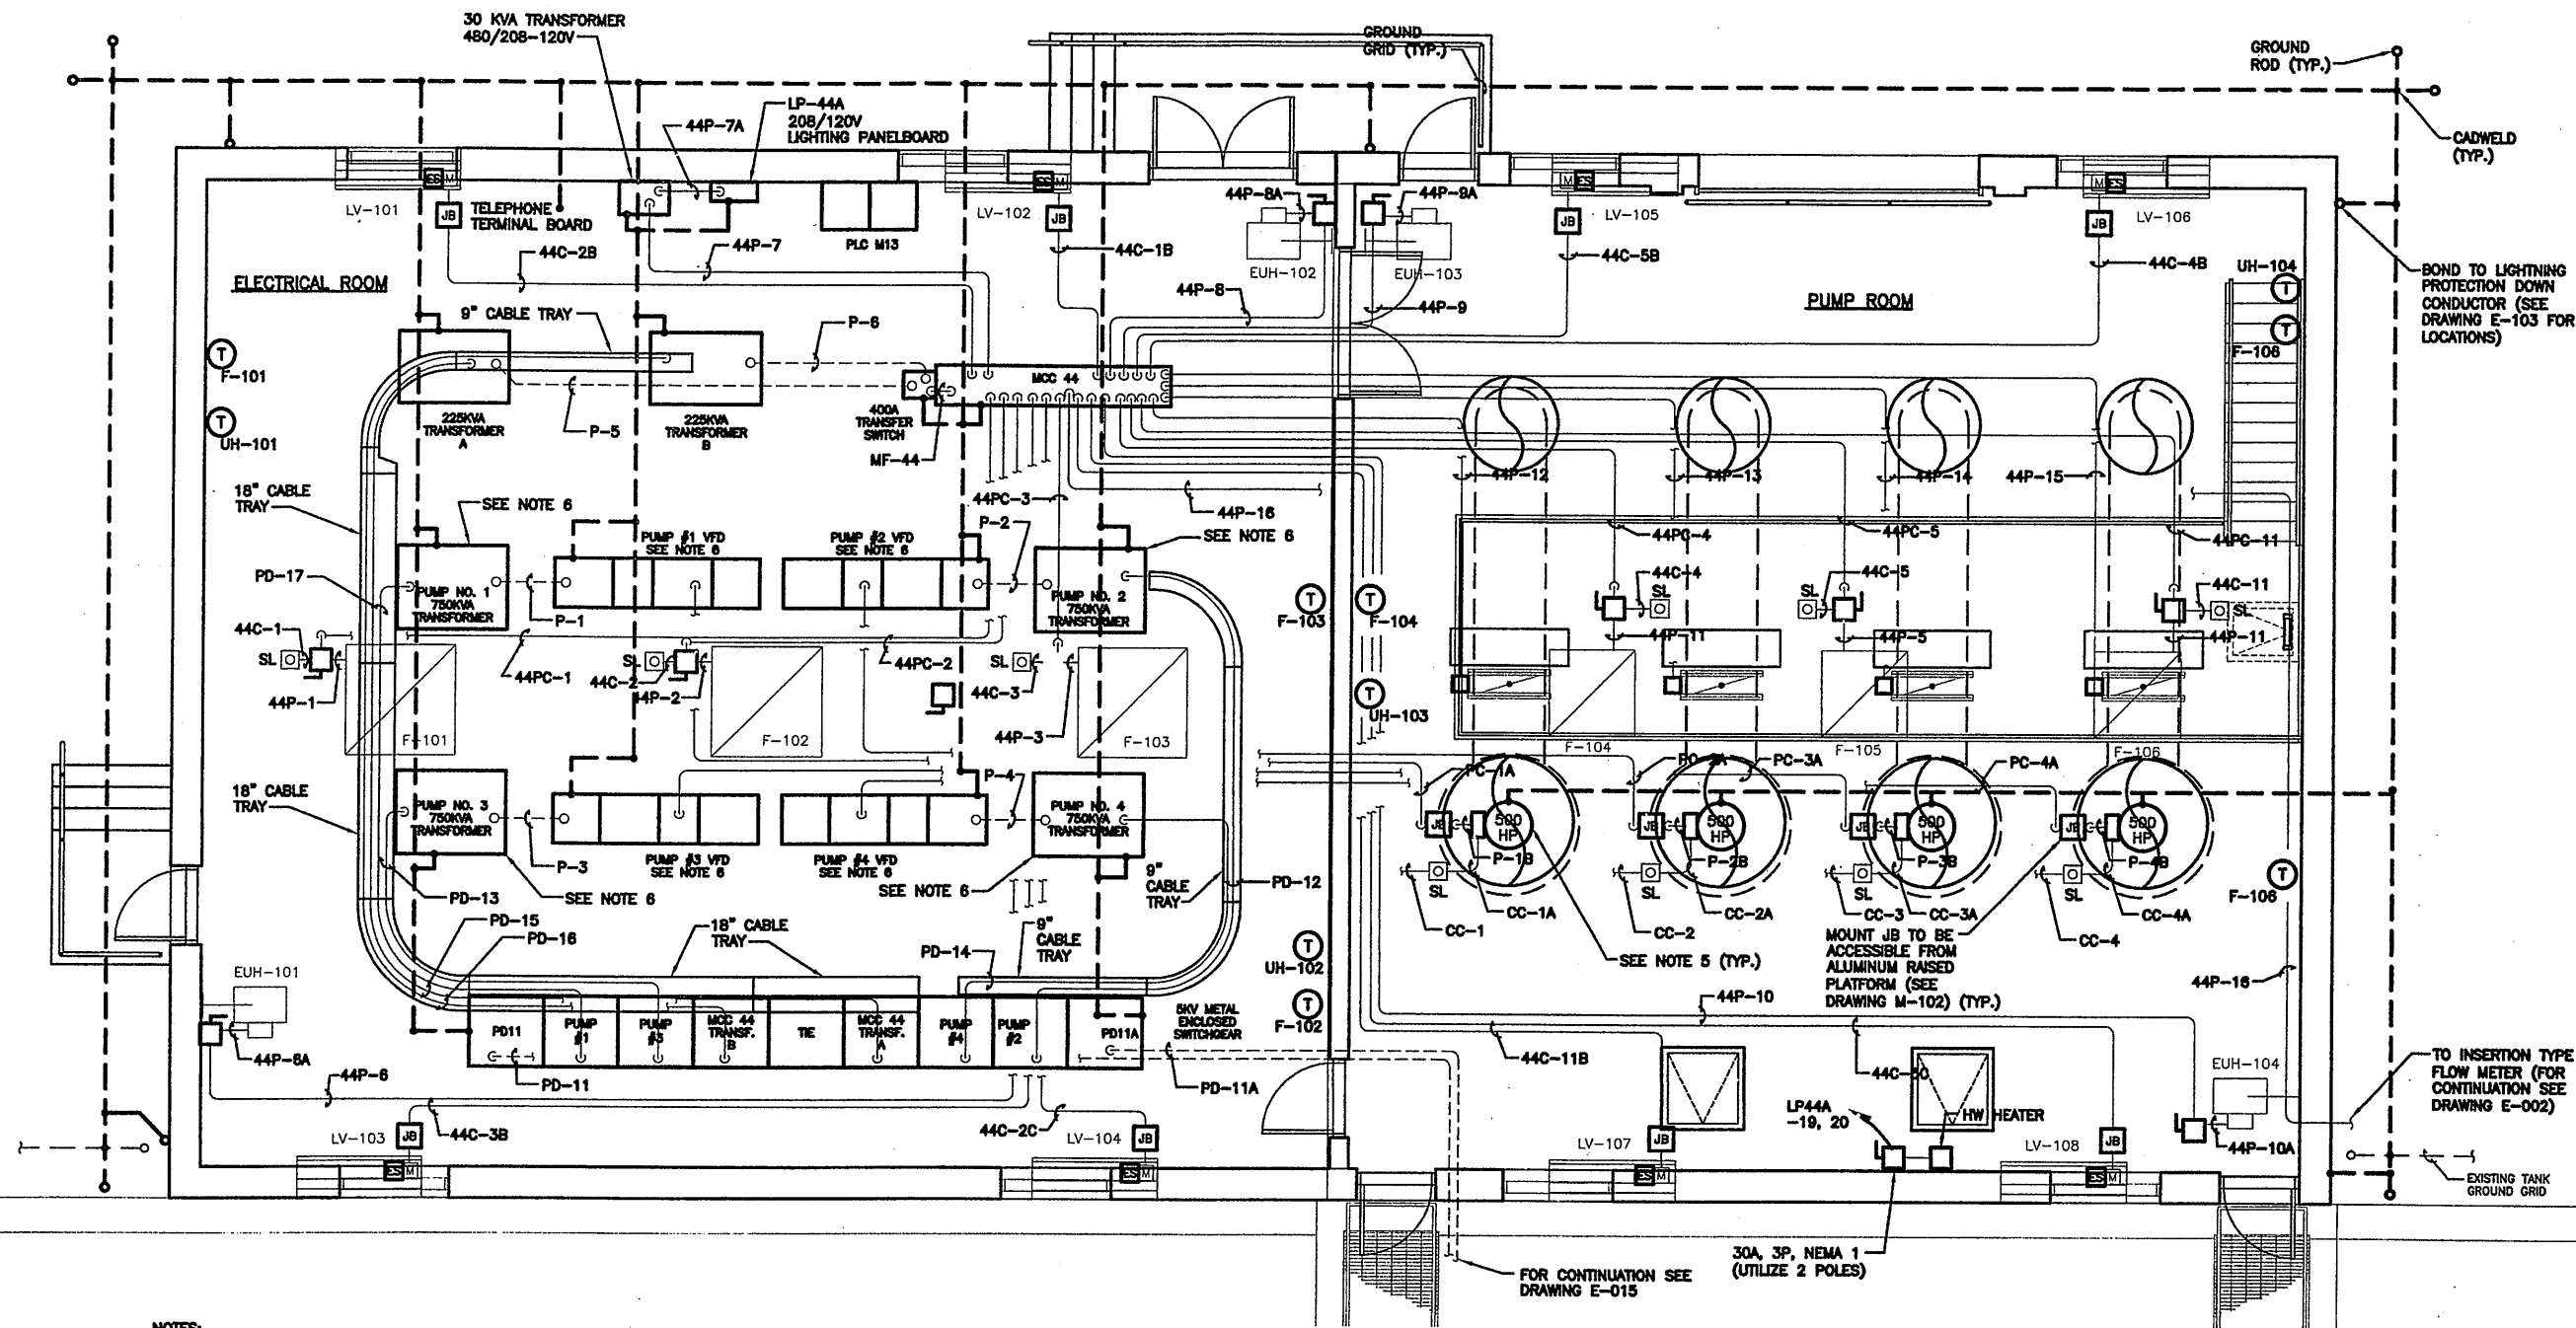

NOTES:

1. DO NOT PLACE ANY CONDUIT DIRECTLY ABOVE 36" PUMPS OR 36" BUTTERFLY VALVES.
2. FOR PD CONDUIT SCHEDULE SEE DRAWING E-009.
3. FOR P & PC CONDUIT SCHEDULE SEE DRAWING E-107.
4. LIQUID-TITE CONDUIT SHALL BE USED FOR CONNECTIONS TO VIBRATING EQUIPMENT.
5. FOR MOTOR VIBRATION AND RTD'S SEE DRAWING I-101.
6. CONTRACT 4A SHALL PROVIDE VFD'S AND TRANSFORMERS FOR PUMPS 1-4. REFERENCE SPECIFICATION 11321
7. REFER TO HVAC DRAWINGS FOR ADDITIONAL LOUVER, DAMPER, THERMOSTAT, CONTROL VALVE, CONTROL (DDC), AND OTHER CONTROL HVAC REQUIREMENTS. CONTRACT 4B (ELECTRICAL) SHALL PROVIDE ALL CONDUIT AND CONDUCTORS FOR 120 VOLT CONTROLS, AS SHOWN OR REQUIRED (EXCEPT WIRING BETWEEN DDC SYSTEM COMPONENTS). CONTRACT 4C (HVAC) SHALL PROVIDE ALL CONDUIT AND CONDUCTORS REQUIRED FOR LOW VOLTAGE (LESS THAN 120 VOLT) CONTROLS AND FOR WIRING BETWEEN DDC SYSTEM COMPONENTS INCLUDING BUT NOT LIMITED TO DDC, LOW VOLTAGE T-STAT, VARIABLE AIR VOLUME (VAV) CONTROLS, ETC.

8. DOOR SE108 SHALL BE PROVIDED WITH THE FOLLOWING:

- a. 480VAC, 3 PHASE POWER TO DOOR OPERATOR. PROVIDE A 20AMP, 3 POLE CIRCUIT BREAKER IN MCC44 WITH 3/12, 1#12 GROUND IN 3/4" CONDUIT ROUTED FROM MCC44 TO DOOR OPERATOR. PROVIDE A 30AMP, 3 POLE NEMA 1 DISCONNECT SWITCH AT DOOR OPERATOR.
- b. 120VAC, 1 PHASE POWER TO DOOR ALARM AND LIGHTS. UTILIZE SPARE 20AMP, 1 POLE CIRCUIT BREAKER (LP44A-20) AND 2#12, 1#12 GROUND IN 3/4" CONDUIT ROUTED FROM LP44 TO ALARM BELL AND LIGHTS.
- c. 2#12 IN 3/4" CONDUIT FROM DOOR OPERATOR TO DOOR ALARM BELL AND LIGHT.
- d. 2#14 IN 3/4" CONDUIT FROM DOOR OPERATOR TO DOOR SENSING EDGE JUNCTION BOX.
- e. 2#14 IN 3/4" CONDUIT FROM DOOR OPERATOR TO DOOR GUIDE INTERLOCK SWITCHES (TYPICAL TWO).
- f. 3#14 IN 3/4" CONDUIT FROM DOOR OPERATOR TO INTERIOR MOUNTED PUSHBUTTON STATION AND 4#14 IN 3/4" CONDUIT FROM INTERIOR MOUNTED PUSHBUTTON STATION TO EXTERIOR MOUNTED PUSHBUTTON STATION.

9. PROVIDE 208VAC, 1 PHASE POWER TO SEAL WATER BOOSTER PUMP IN PUMP ROOM. POWER SHALL ORIGINATE IN LIGHTING PANELBOARD LP44A. REPLACE TWO SPARE 20AMP, 1 POLE CIRCUIT BREAKERS IN LP44A WITH ONE 20AMP, 2 POLE CIRCUIT BREAKER TO SERVE THE BOOSTER PUMP. PROVIDE 2#12, 1#12 GROUND IN 3/4" CONDUIT FROM LP44A TO BOOSTER PUMP CONTROLLER TO FACILITATE WIRING. PROVIDE A TWO POLE MANUAL STARTING SWITCH AT THE CONTROLLER TO SERVE AS THE DISCONNECTING MEANS.

POWER PLAN
SCALE: 1/4"=1'-0"

Layer: ON=*; OFF=*REF*
X: 0659X101.DWG
4/10/01 BBL DCC
0550300/0659E101.DWG


| | |
|------------|----------|
| 1/4"=1'-0" | |
| No. | Date |
| 0 | 4/20/01 |
| 1 | AS BID |
| 2 | 10/31/05 |

| No. | Date | Revisions | Init |
|-----|----------|---------------------|------|
| 0 | 4/20/01 | ISSUED FOR APPROVAL | TEL |
| 1 | | AS BID | |
| 2 | 10/31/05 | RECORD DRAWING | |



In charge of TEL
Designed by TEL, MEE
Drawn by DCC
Checked by WFH



ONONDAGA COUNTY • DEPARTMENT OF DRAINAGE AND SANITATION • SYRACUSE, NEW YORK
METROPOLITAN SYRACUSE WASTEWATER TREATMENT PLANT
STAGE III AMMONIA AND STAGE II PHOSPHORUS REMOVAL PROJECT
SECONDARY EFFLUENT PUMPING STATION
POWER PLAN
ELECTRICAL

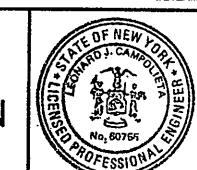

RECORD DRAWING
THESE CHANGES HAVE BEEN MADE TO REFLECT MAJOR CHANGES, IF ANY, WHICH OCCURRED DURING CONSTRUCTION. REVISIONS ARE BASED UPON INFORMATION SUPPLIED BY CONTRACTOR.
DATE: 10/31/05 PER: [Signature]
SUMMARY OF WORK ON OTHER CONTRACTS:
CONTRACT 4A SHALL PROVIDE PUMP 1-4 VFD EQUIPMENT PER NOTE 6
THIS DRAWING WAS PREPARED AT THE SCALE INDICATED IN THE TITLE BLOCK. INACCURACIES IN THE STATED SCALE MAY BE INTRODUCED WHEN DRAWINGS ARE REPRODUCED BY ANY MEANS. USE THE GRAPHIC SCALE BAR IN THE TITLE BLOCK TO DETERMINE THE ACTUAL SCALE OF THIS DRAWING.
File Number: 00659
Date: APRIL 2001
E-101
[Signature]

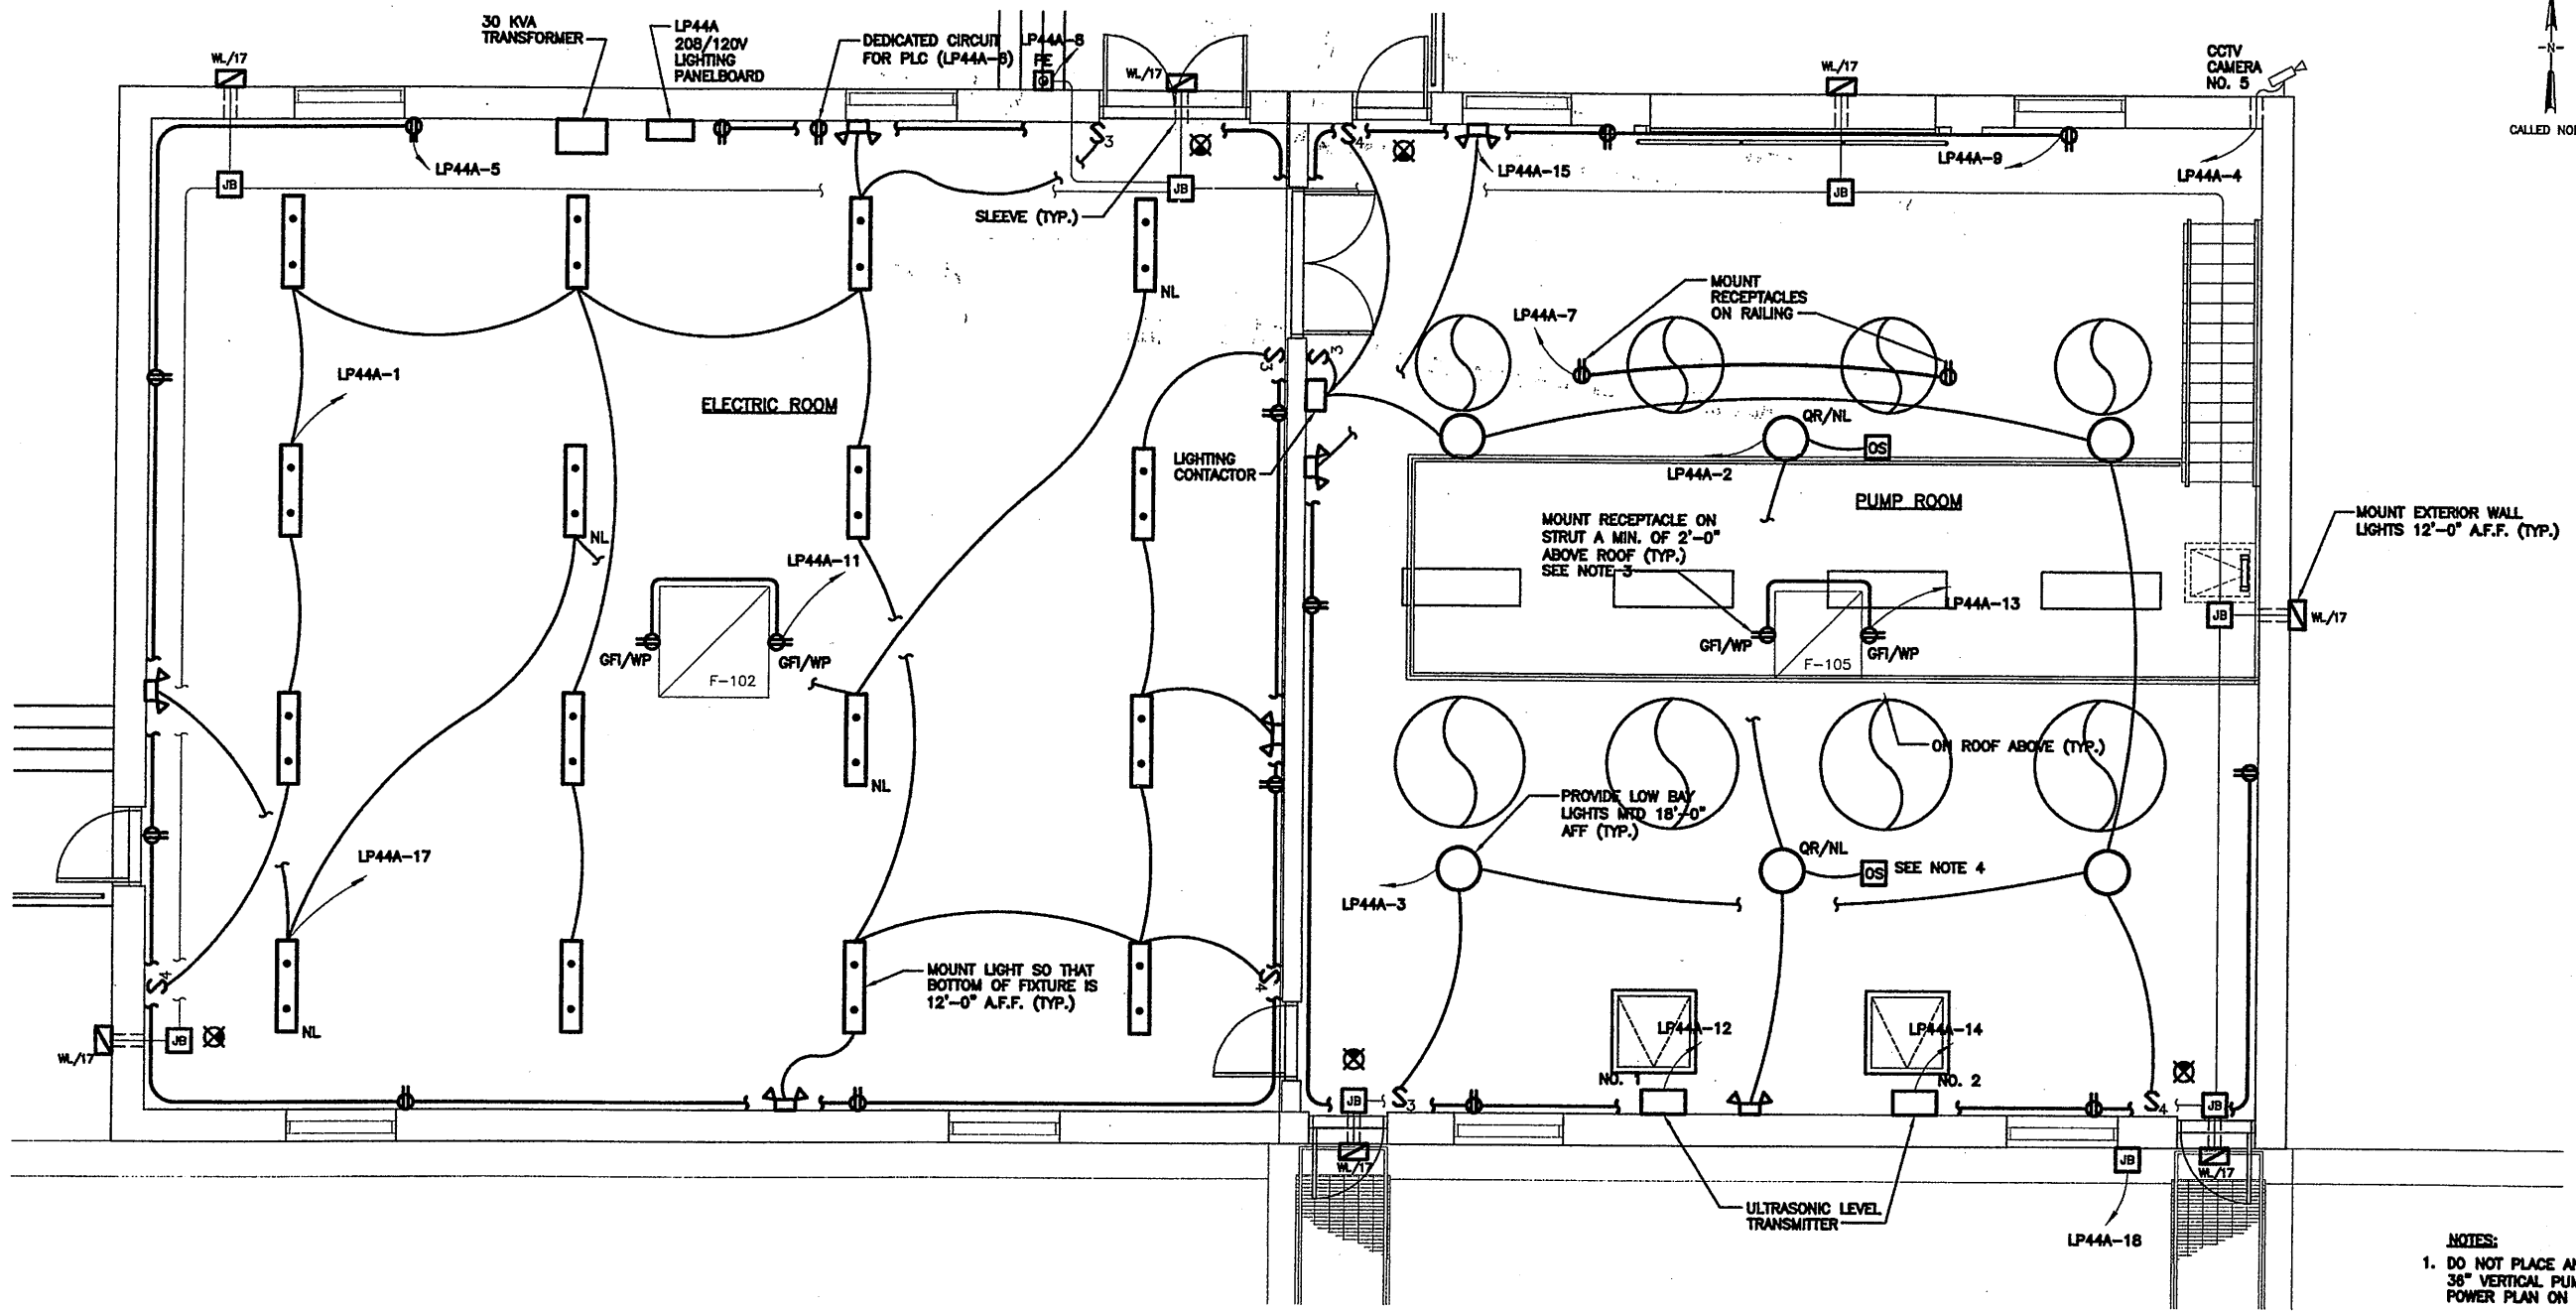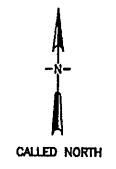

LIGHTING PLAN
SCALE: 1/4"=1'-0"


- NOTES:**
- DO NOT PLACE ANY CONDUIT OR LIGHT FIXTURES DIRECTLY ABOVE 36" VERTICAL PUMPS OR 36" BUTTERFLY VALVES. REFER TO POWER PLAN ON DRAWING E-101 FOR LOCATIONS.
 - REFER TO DRAWING E-107 FOR PANELBOARD SCHEDULE.
 - DO NOT ROUTE ANY CONDUIT OVER ROOF. KEEP ALL FEEDERS IN CEILING SPACE, FEEDING UP TO THE UNIT THROUGH THE UNIT CURB. ALL PENETRATIONS SHALL BE WATER TIGHT.
 - OCCUPANCY SENSOR TO SWITCH NIGHT LIGHTS FROM LOW TO HIGH BRIGHTNESS WITH START AT HIGH LEVEL AND MANUAL SWITCHING.
 - PROVIDE LIGHTING CONTACTOR FOR METAL HALIDE CIRCUITS.

RECORD DRAWING

THESE DRAWINGS HAVE BEEN REVISIONED TO REFLECT MAJOR CHANGES IF ANY, WHICH OCCURRED DURING CONSTRUCTION. REVISIONS ARE BASED UPON INFORMATION SUPPLIED BY CONTRACTOR.
DATE: 10/21/05 FOR: K&P/ELC

THIS DRAWING WAS PREPARED AT THE SCALE INDICATED IN THE TITLE BLOCK. INACCURACIES IN THE STATED SCALE MAY BE INTRODUCED WHEN DRAWINGS ARE REPRODUCED BY ANY MEANS. USE THE GRAPHIC SCALE BAR IN THE TITLE BLOCK TO DETERMINE THE ACTUAL SCALE OF THIS DRAWING.

Layer: ON=*, OFF=*REF*
X: 0658X101.DWG
5/30/01 BBL DCC
05503000/0658E101.DWG

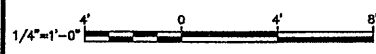

| No. | Date | Revisions | Init |
|-----|----------|---------------------|------|
| 0 | 4/20/01 | ISSUED FOR APPROVAL | LK |
| 1 | | AS BID | |
| 2 | 10/31/05 | RECORD DRAWING | |

In charge of TEL
Designed by MEE
Drawn by DCC
Checked by WFH




ONONDAGA COUNTY • DEPARTMENT OF DRAINAGE AND SANITATION • SYRACUSE, NEW YORK
METROPOLITAN SYRACUSE WASTEWATER TREATMENT PLANT
STAGE III AMMONIA AND STAGE II PHOSPHORUS REMOVAL PROJECT
SECONDARY EFFLUENT PUMPING STATION
SECONDARY EFFLUENT PUMP STATION
LIGHTING PLAN
ELECTRICAL




File Number
00659
Date
APRIL 2001

E-102

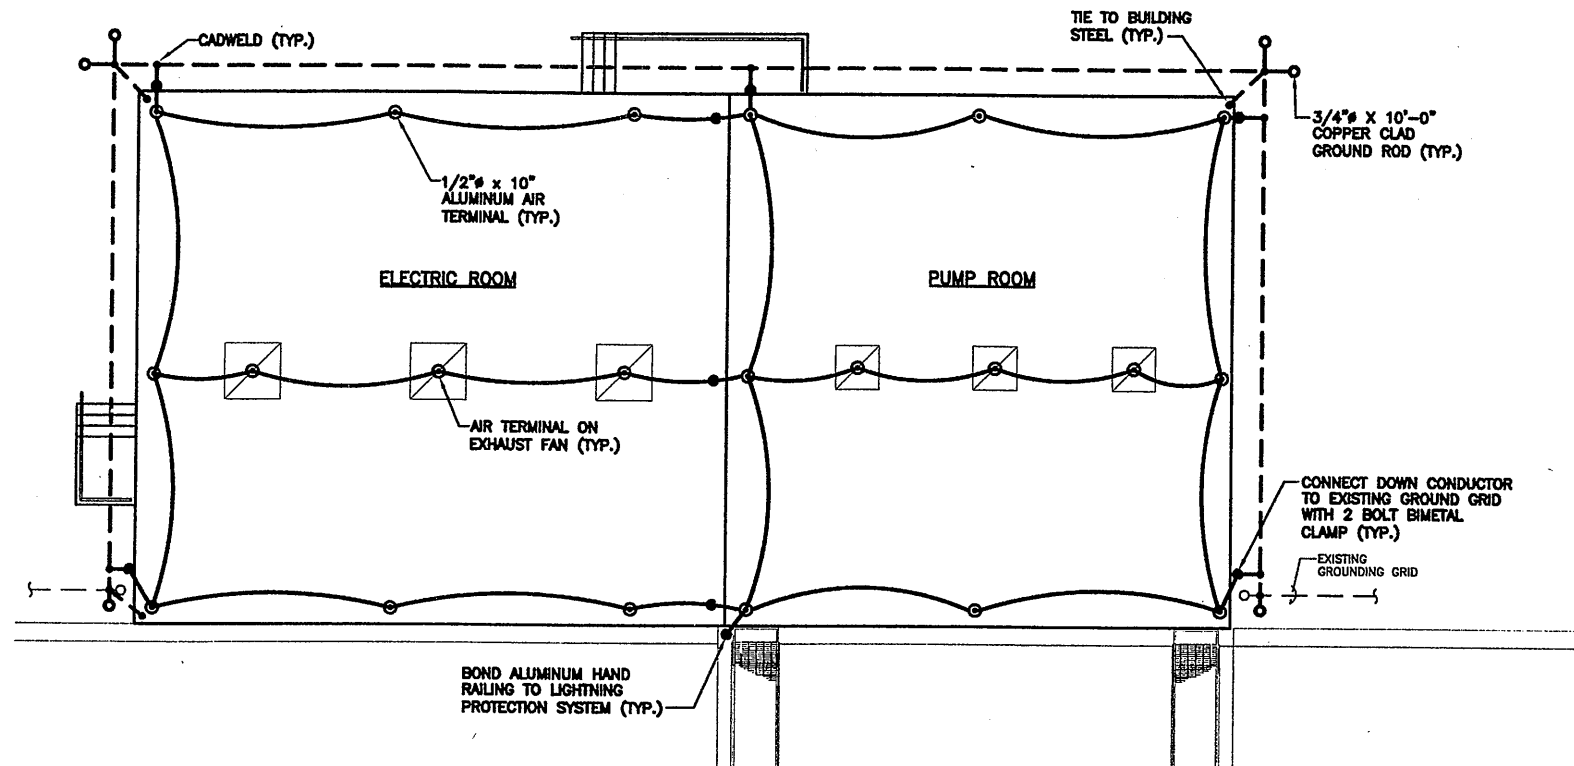

NOTE:
REFER E-004 FOR LIGHTNING PROTECTION NOTES.


LIGHTNING PROTECTION PLAN
SCALE: 1/8"=1'-0"

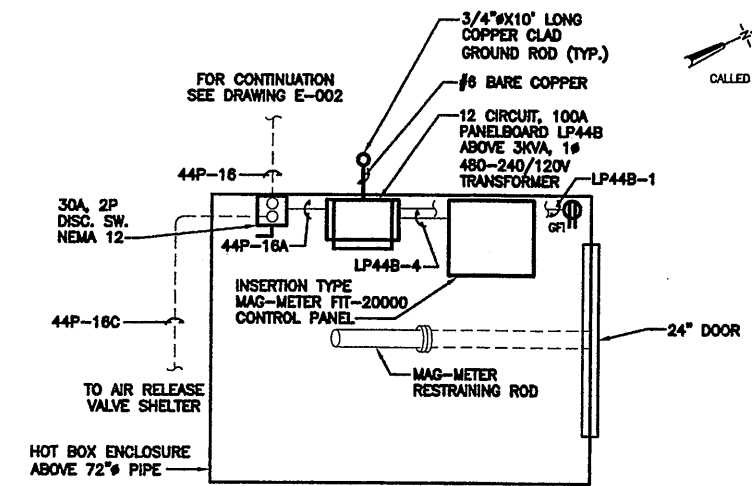

NOTE:
MOUNT ELECTRICAL EQUIPMENT ON KINDORF AND ATTACH TO SIDE WALL.

INSERTION MAG-METER SHELTER POWER PLAN
NOT TO SCALE

NOTE:
ENCLOSURE TO BE "HOT-BOX" OR EQUAL BY CONTRACT 4A.

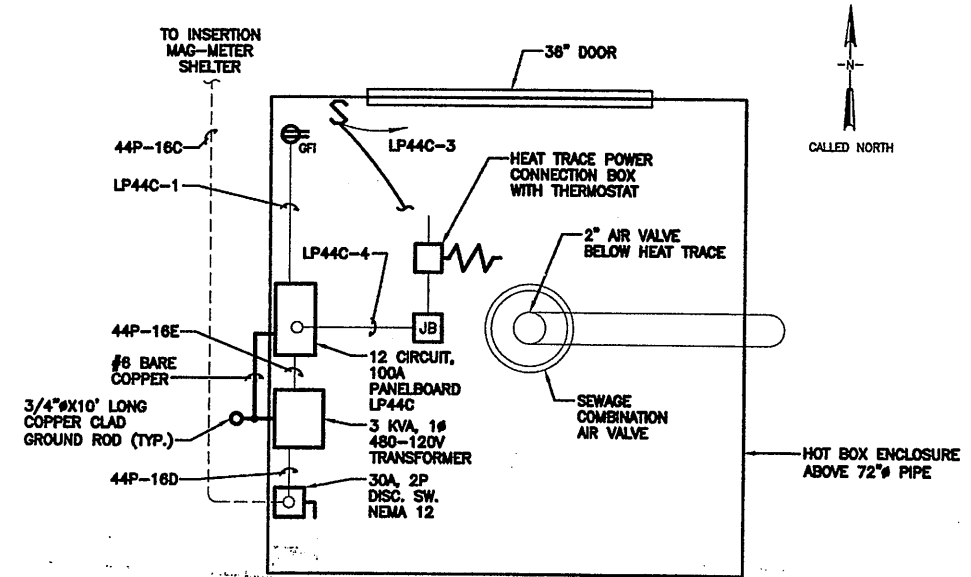

NOTE:
MOUNT ELECTRICAL EQUIPMENT ON KINDORF AND ATTACH TO SIDE WALL.

AIR RELEASE VALVE SHELTER POWER PLAN
NOT TO SCALE

NOTE:
ENCLOSURE TO BE "HOT-BOX" OR EQUAL BY CONTRACT 4A.

RECORD DRAWING
THESE CHANGES HAVE BEEN MADE TO REFLECT MAJOR CHANGES, IF ANY, WHICH OCCURRED DURING CONSTRUCTION. REVISIONS ARE BASED UPON INFORMATION SUPPLIED BY CONTRACTOR.
DATE: 10/21/01 FOR: [Signature]

THIS DRAWING WAS PREPARED AT THE SCALE INDICATED IN THE TITLE BLOCK. INACCURACIES IN THE STATED SCALE MAY BE INTRODUCED WHEN DRAWINGS ARE REPRODUCED BY ANY MEANS. USE THE GRAPHIC SCALE BAR IN THE TITLE BLOCK TO DETERMINE THE ACTUAL SCALE OF THIS DRAWING.

Layer: ON=; OFF=REF
X: 0659X100, X101.DWG
5/30/01 BBL DCC
05503000/0659E101.DWG

1/8"=1'-0"
NO ALTERATIONS PERMITTED HEREON EXCEPT AS PROVIDED UNDER SECTION 7209 SUBDIVISION 2 OF THE NEW YORK STATE EDUCATION LAW

| No. | Date | Revisions | Init |
|-----|----------|---------------------|------|
| 0 | 4/20/01 | ISSUED FOR APPROVAL | Lie |
| 1 | | AS BID | |
| 2 | 10/31/05 | RECORD DRAWING | |


In charge of --- TEL
Designed by --- MEE
Drawn by --- DCC
Checked by --- WFH



ONONDAGA COUNTY • DEPARTMENT OF DRAINAGE AND SANITATION • SYRACUSE, NEW YORK
METROPOLITAN SYRACUSE WASTEWATER TREATMENT PLANT
STAGE III AMMONIA AND STAGE II PHOSPHORUS REMOVAL PROJECT
SECONDARY EFFLUENT PUMP STATION
SECONDARY EFFLUENT PUMP STATION
LIGHTNING PROTECTION PLAN
ELECTRICAL



File Number
00659
Date
APRIL 2001
E-103
[Signature]

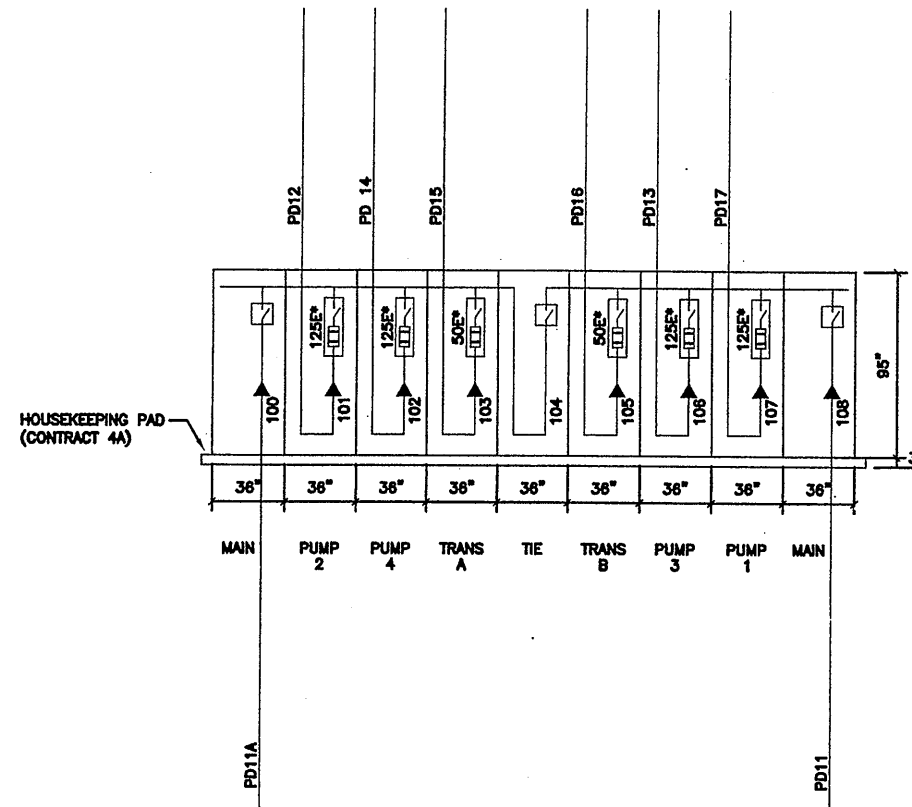

5 KV METAL-ENCLOSED SWITCHGEAR FRONT ELEVATION

NOT TO SCALE

* FUSE SIZE IS PRELIMINARY.
FINAL FUSE SIZE SHALL BE AS SPECIFIED FOLLOWING
RECEIPT OF FUSE & TRANSFORMER SHOP DRAWINGS.

RATINGS:

RATED VOLTAGE: 4.16KV
 MAXIMUM DESIGN VOLTAGE: 4.76 KV
 IMPULSE WITHSTAND BIL: 60KV
 CONTINUOUS CURRENT: 600 AMPERES (MAIN BUS & SWITCHES)
 LOAD INTERRUPTING CURRENT: 600 AMPERES
 MOMENTARY CURRENT: 40KA ASYM.
 FAULT CLOSE CURRENT: 40KA ASYM.
 ENCLOSURE: INDOOR
 FUSES: GE EJ01.9F82 SERIES

RECORD DRAWING

THESE DRAWINGS HAVE BEEN REVIEWED TO REFLECT
 MAJOR CHANGES, IF ANY, WHICH OCCURRED DURING
 CONSTRUCTION. REVISIONS ARE BASED UPON
 INFORMATION SUPPLIED BY CONTRACTOR.

DATE: 10/10/01 FOR: K&M/PLT

SUMMARY OF WORK BY OTHER CONTRACTS:
 CONTRACT 4A SHALL PROVIDE HOUSE KEEPING PAD

THIS DRAWING WAS PREPARED AT THE SCALE INDICATED IN THE
 TITLE BLOCK. INACCURACIES IN THE STATED SCALE MAY BE
 INTRODUCED WHEN DRAWINGS ARE REPRODUCED BY ANY MEANS.
 USE THE GRAPHIC SCALE BAR IN THE TITLE BLOCK TO
 DETERMINE THE ACTUAL SCALE OF THIS DRAWING.

03/21/01 OBG CRV
 0659E104

NOT TO SCALE

| No. | Date | Revisions | Init |
|-----|----------|---------------------|------|
| 0 | 4/20/01 | ISSUED FOR APPROVAL | TEL |
| 1 | | AS BID | |
| 2 | 10/31/05 | RECORD DRAWING | |

In charge of --- TEL ---
 Designed by --- RAC ---
 Drawn by --- CRV ---
 Checked by --- WFH ---



ONONDAGA COUNTY • DEPARTMENT OF DRAINAGE AND SANITATION • SYRACUSE, NEW YORK
 METROPOLITAN SYRACUSE WASTEWATER TREATMENT PLANT
 STAGE III AMMONIA AND STAGE II PHOSPHORUS REMOVAL PROJECT

**SECONDARY EFFLUENT PUMPING STATION
 5KV SWITCHGEAR**
 ELECTRICAL





File Number
 00659
 Date
 APRIL 2001
 K&M/PLT

E-104

NO ALTERATIONS PERMITTED HEREON EXCEPT
 AS PROVIDED UNDER SECTION 7209 SUBDIVISION
 2 OF THE NEW YORK STATE EDUCATION LAW

MCC 44 - SECONDARY EFFLUENT PUMPING STATION

MCC 44 - SECONDARY EFFLUENT PUMPING STATION CONTINUED

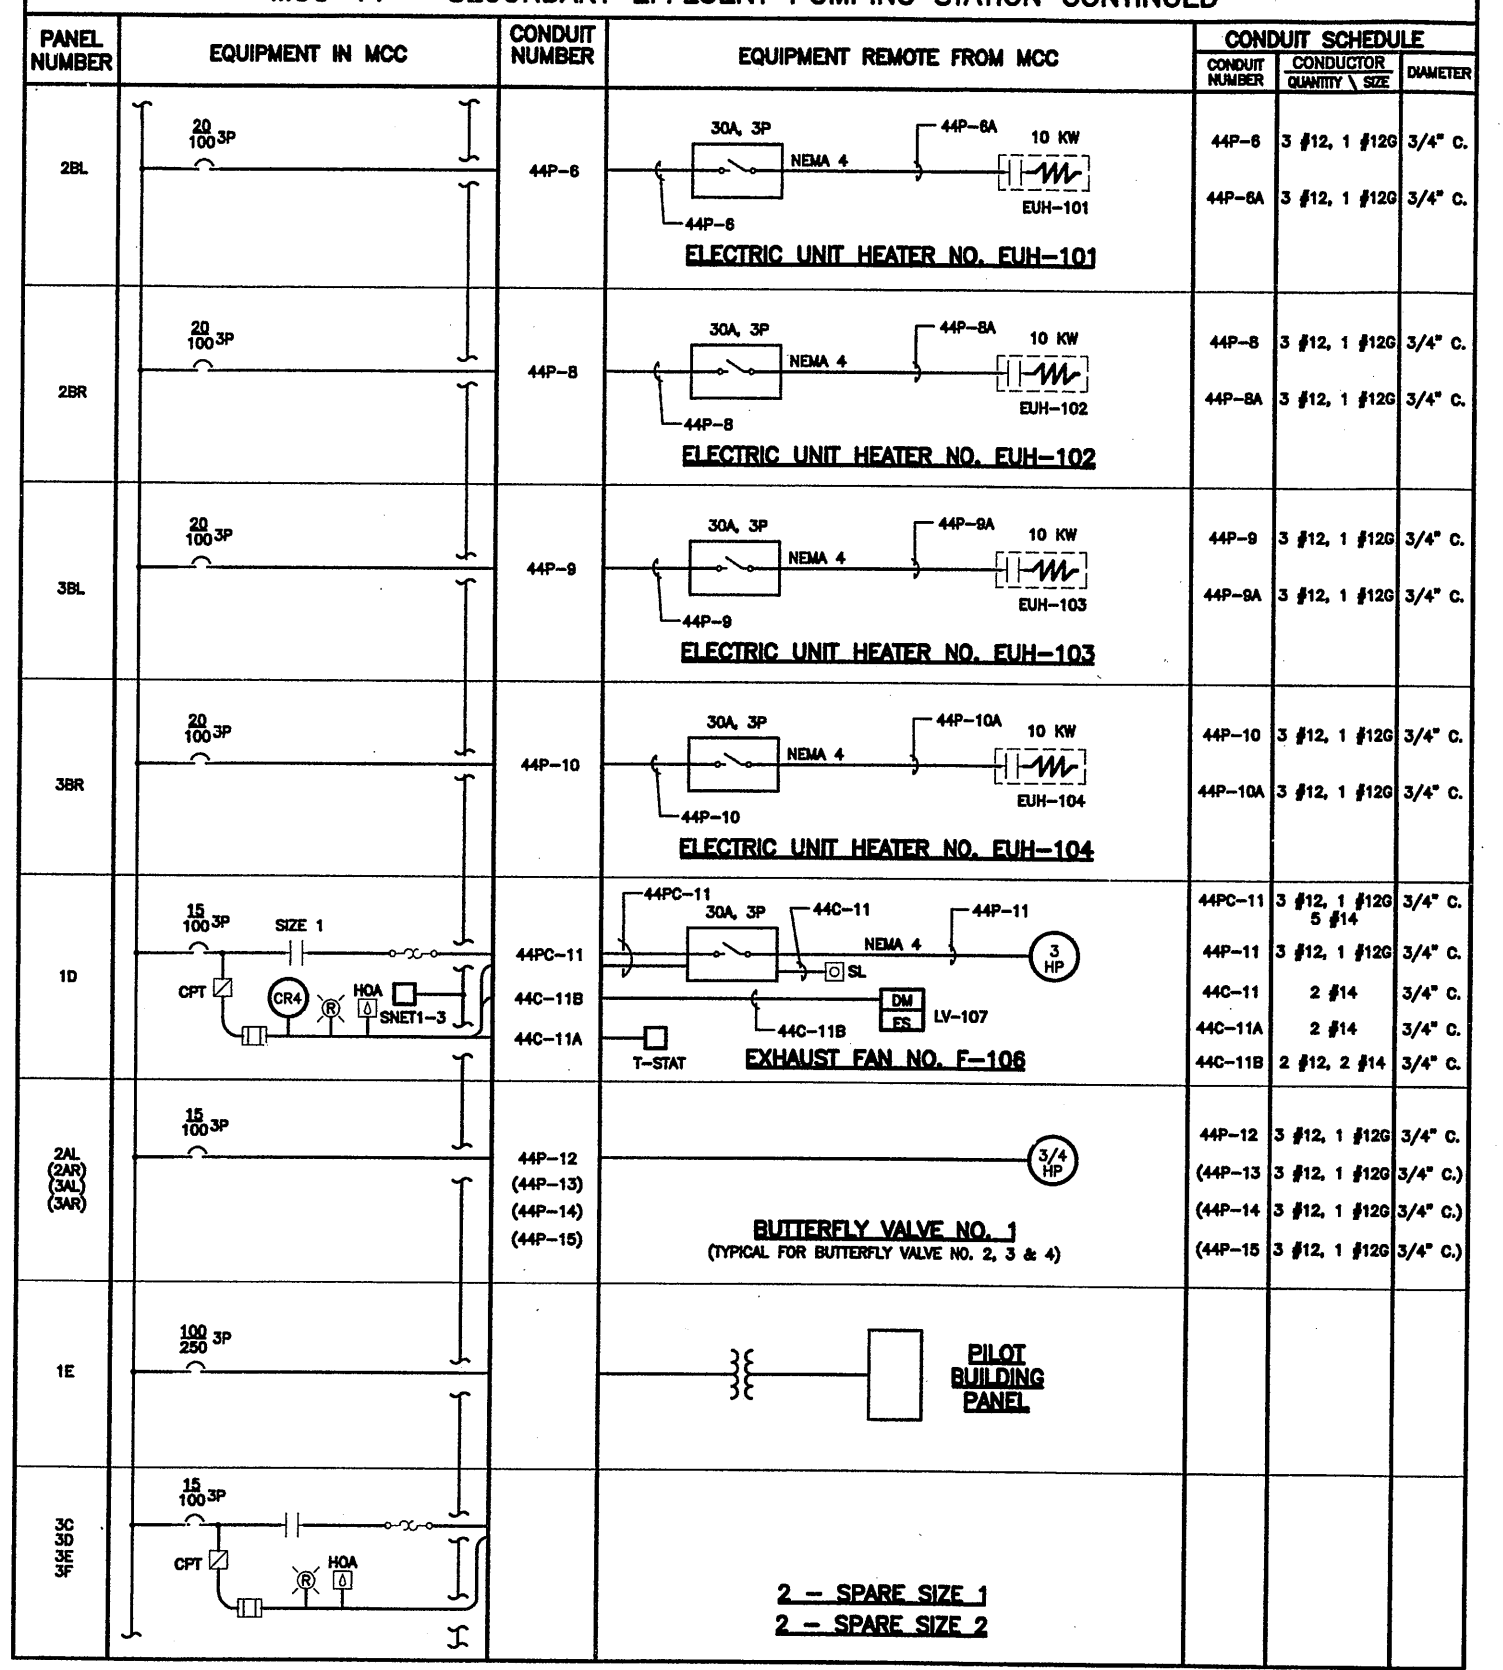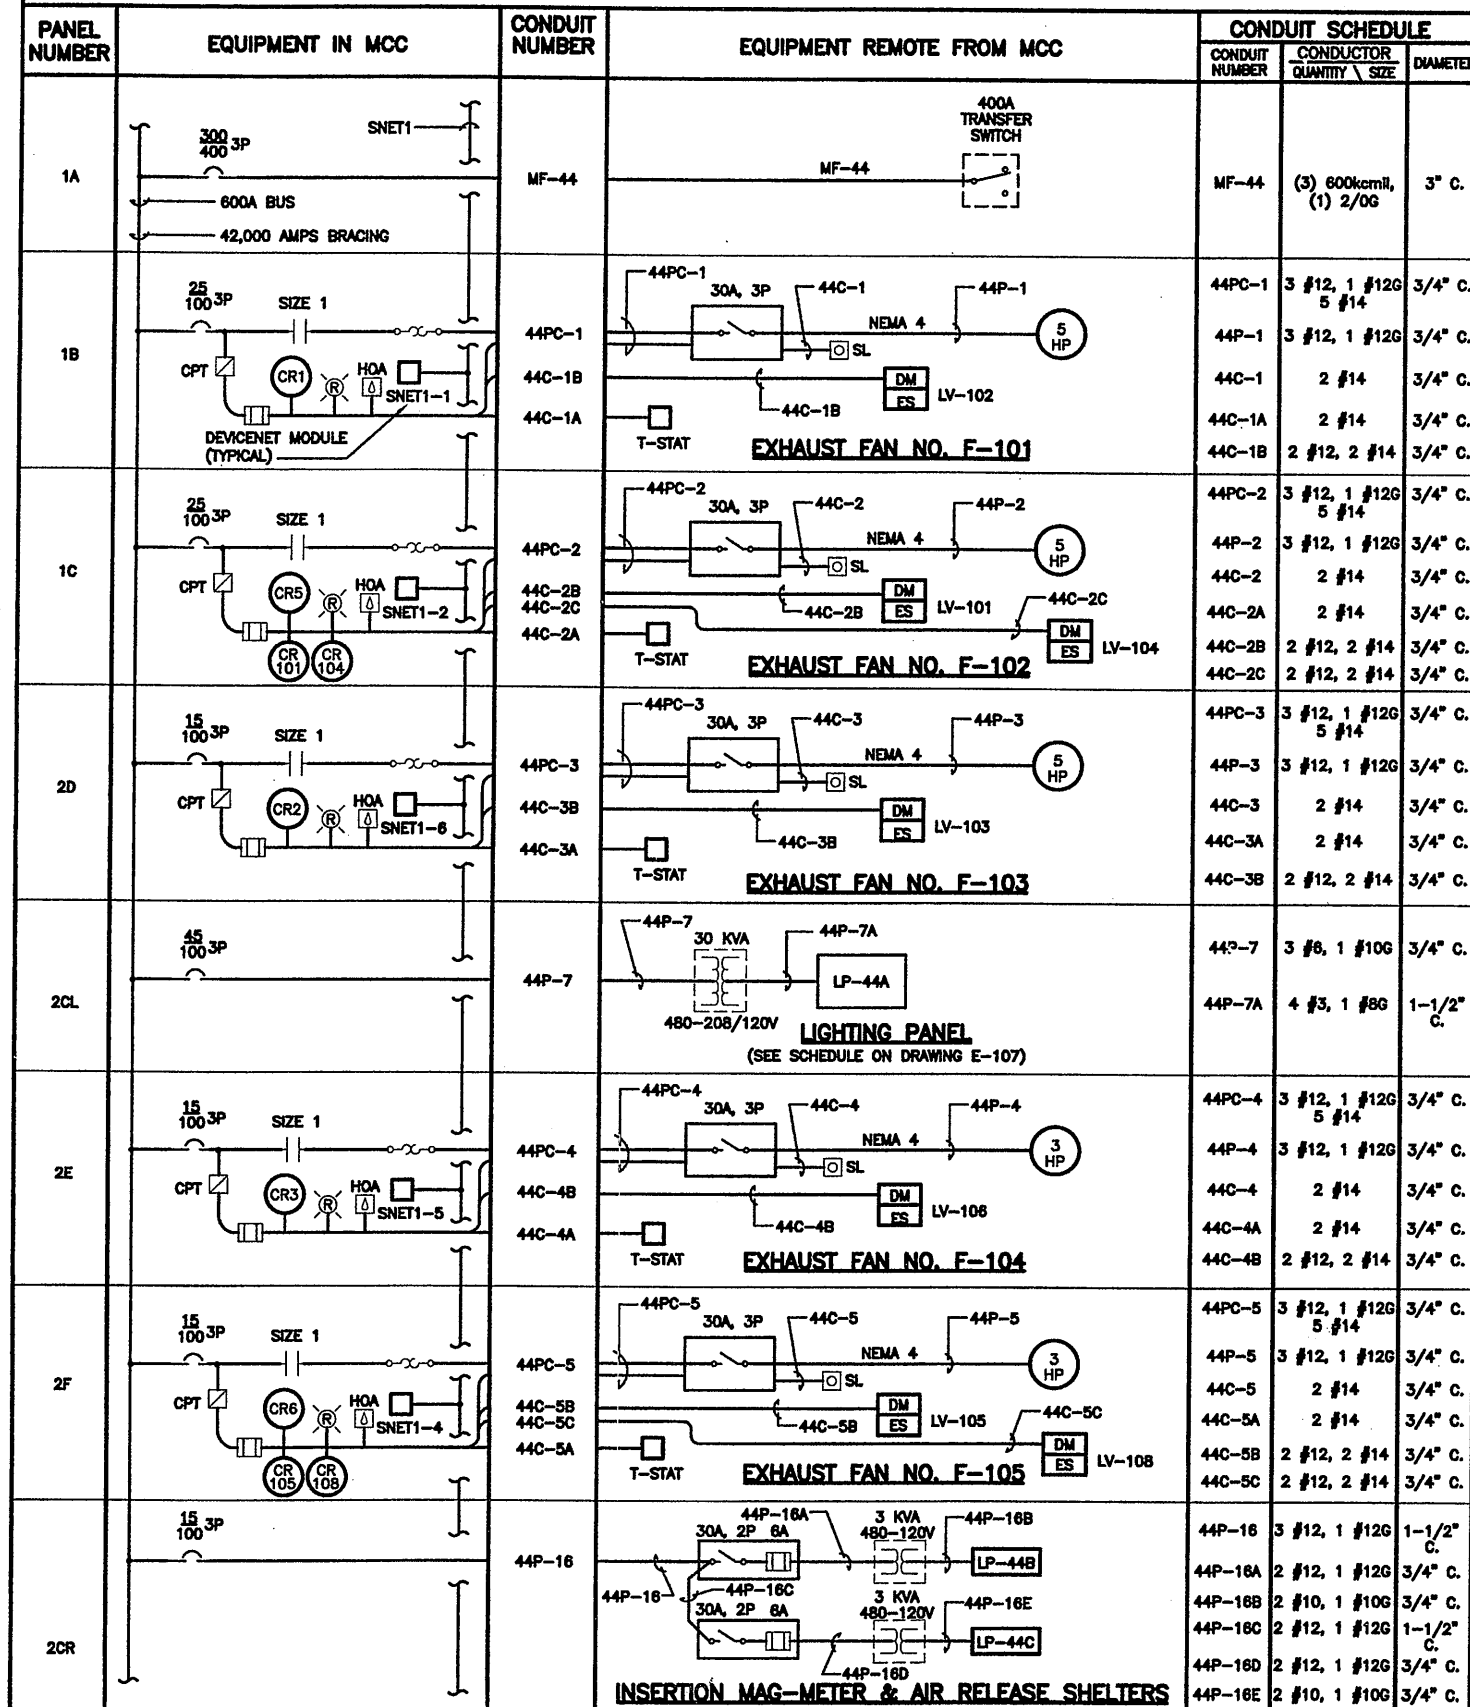

Layer: ON="; OFF="REF"
5/30/01 BBL DCC
05503000/0859E105.DWG

NOTE:
FOR MCC ELEVATION SEE DRAWING E-107.

CONDUIT NUMBER DESCRIPTION
MCC # 44P-14
P= POWER
C= CONTROL
PC= POWER & CONTROL

RECORD DRAWING
THESE CHANGES HAVE BEEN REVIEWED TO REFLECT
MAJOR CHANGES IF ANY, WHICH OCCURRED DURING
CONSTRUCTION. REVISIONS ARE BASED UPON
INFORMATION SUPPLIED BY CONTRACTOR.
DATE: 10/21/05 PER: [Signature]

THIS DRAWING WAS PREPARED AT THE SCALE INDICATED IN THE
TITLE BLOCK. INACCURACIES IN THE STATED SCALE MAY BE
INTRODUCED WHEN DRAWINGS ARE REPRODUCED BY ANY MEANS.
USE THE GRAPHIC SCALE BAR IN THE TITLE BLOCK TO
DETERMINE THE ACTUAL SCALE OF THIS DRAWING.

NOT TO SCALE
NO ALTERATIONS PERMITTED HEREON EXCEPT
AS PROVIDED UNDER SECTION 7209 SUBDIVISION
2 OF THE NEW YORK STATE EDUCATION LAW

| No. | Date | Revisions | Init |
|-----|----------|---------------------|-------------|
| 0 | 4/20/01 | ISSUED FOR APPROVAL | [Signature] |
| 1 | | AS BID | |
| 2 | 10/31/05 | RECORD DRAWING | |

In charge of TEL
Designed by AHL
Drawn by DCC
Checked by WFH




ONONDAGA COUNTY • DEPARTMENT OF DRAINAGE AND SANITATION • SYRACUSE, NEW YORK
METROPOLITAN SYRACUSE WASTEWATER TREATMENT PLANT
STAGE III AMMONIA AND STAGE II PHOSPHORUS REMOVAL PROJECT
SECONDARY EFFLUENT PUMPING STATION
SECONDARY EFFLUENT PUMPING STATION
MCC 44 ONE-LINE DIAGRAM
ELECTRICAL



File Number
00659
Date
APRIL 2001
E-105
[Signature]

SEE MCC O&M MANUAL FOR
EQUIPMENT ELEMENTARY DIAGRAMS

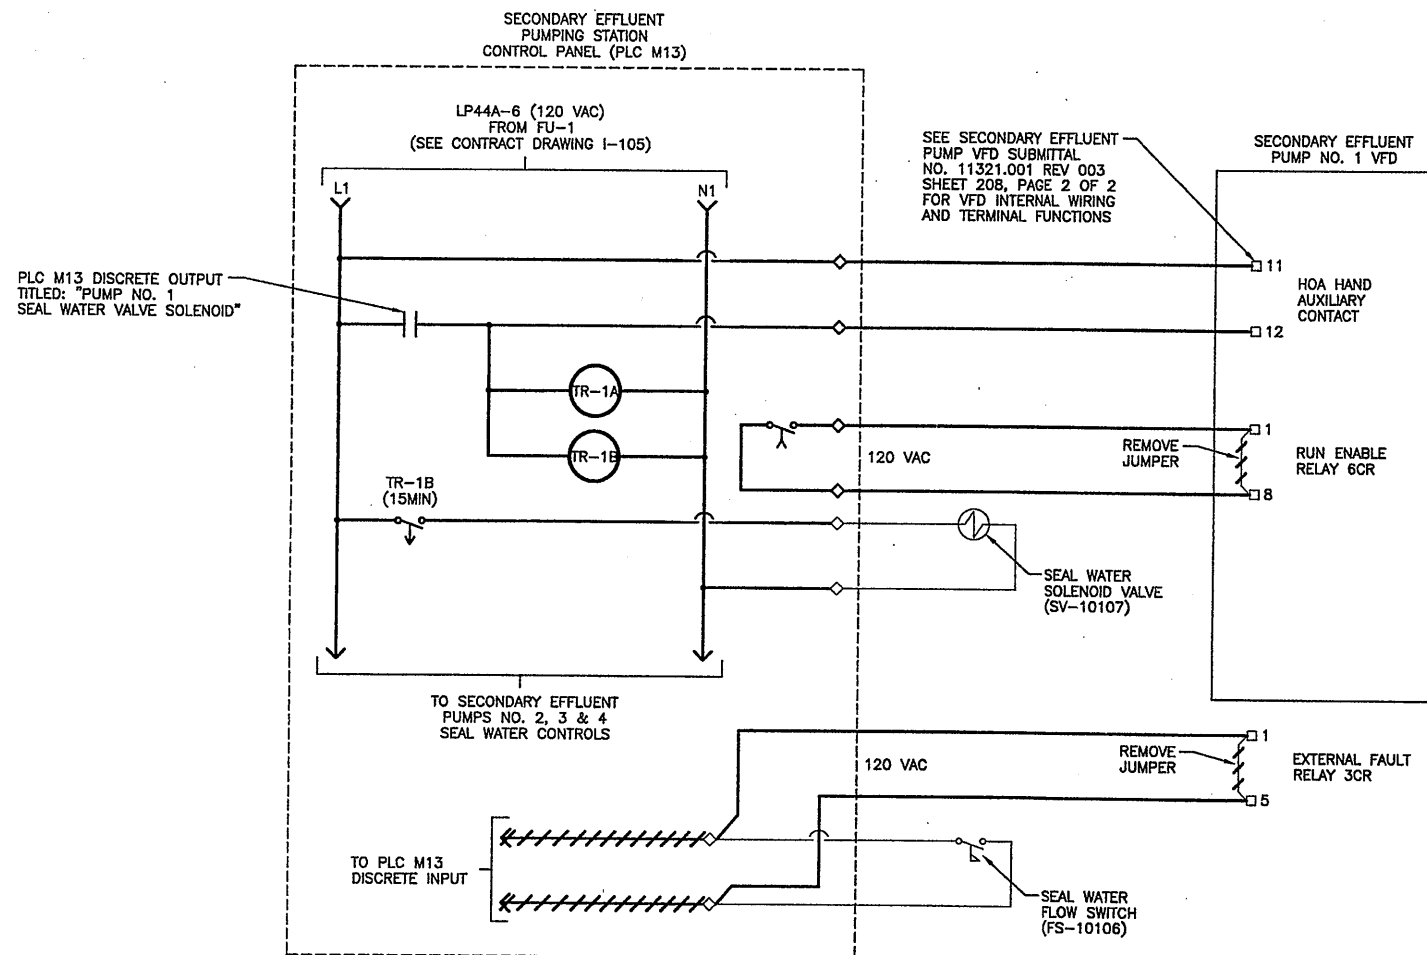

**SECONDARY EFFLUENT PUMP NO.1
SEAL WATER ELEMENTARY DIAGRAM**

NOT TO SCALE

TYPICAL: SECONDARY EFFLUENT PUMP NO.2 WITH TR-2A & TR-2B
SECONDARY EFFLUENT PUMP NO.3 WITH TR-3A & TR-3B
SECONDARY EFFLUENT PUMP NO.4 WITH TR-4A & TR-4B

NOTES:

1. TIMING RELAYS DESIGNATED TR-1A, TR-2A, TR-3A AND TR-4A SHALL BE ON DELAY, SOLID STATE TYPE.
2. TIMING RELAYS DESIGNATED TR-1B, TR-2B, TR-3B AND TR-4B SHALL BE OFF DELAY, SOLID STATE TYPE.

RECORD DRAWING

THESE DRAWINGS HAVE BEEN REVIEWED TO REFLECT
MAJOR CHANGES, IF ANY, WHICH OCCURRED DURING
CONSTRUCTION. REVISIONS ARE BASED UPON
INFORMATION SUPPLIED BY CONTRACTOR.

DATE: 10/24/01 FOR: [Signature]

THIS DRAWING WAS PREPARED AT THE SCALE INDICATED IN THE
TITLE BLOCK. INACCURACIES IN THE STATED SCALE MAY BE
INTRODUCED WHEN DRAWINGS ARE REPRODUCED BY ANY MEANS.
USE THE GRAPHIC SCALE BAR IN THE TITLE BLOCK TO
DETERMINE THE ACTUAL SCALE OF THIS DRAWING.

Layer: ON=*; OFF=*REF*

5/30/01 BBL DCC
05503000/0659E106.DWG


NOT TO SCALE

| No. | Date | Revisions | Init |
|-----|----------|---------------------------------|-------------|
| 0 | 4/20/01 | ISSUED FOR APPROVAL | [Signature] |
| 1 | 7/11/01 | AS BID | [Signature] |
| 2 | 10/18/02 | REVISED PER MODIFICATION 4B-030 | [Signature] |
| 3 | 10/31/05 | RECORD DRAWING | [Signature] |

In charge of TEL
Designed by MEE
Drawn by DCC
Checked by WFH


ENVIRONMENTAL ENGINEERING ASSOCIATES, LLP
SYRACUSE, NEW YORK

ONONDAGA COUNTY • DEPARTMENT OF DRAINAGE AND SANITATION • SYRACUSE, NEW YORK
METROPOLITAN SYRACUSE WASTEWATER TREATMENT PLANT
STAGE III AMMONIA AND STAGE II PHOSPHORUS REMOVAL PROJECT
**SECONDARY EFFLUENT PUMPING STATION
SECONDARY EFFLUENT PUMP STATION
ELEMENTARY DIAGRAMS**
ELECTRICAL

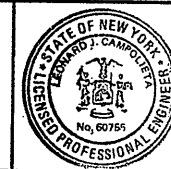

File Number
00659
Date
APRIL 2001
[Signature]

E-106

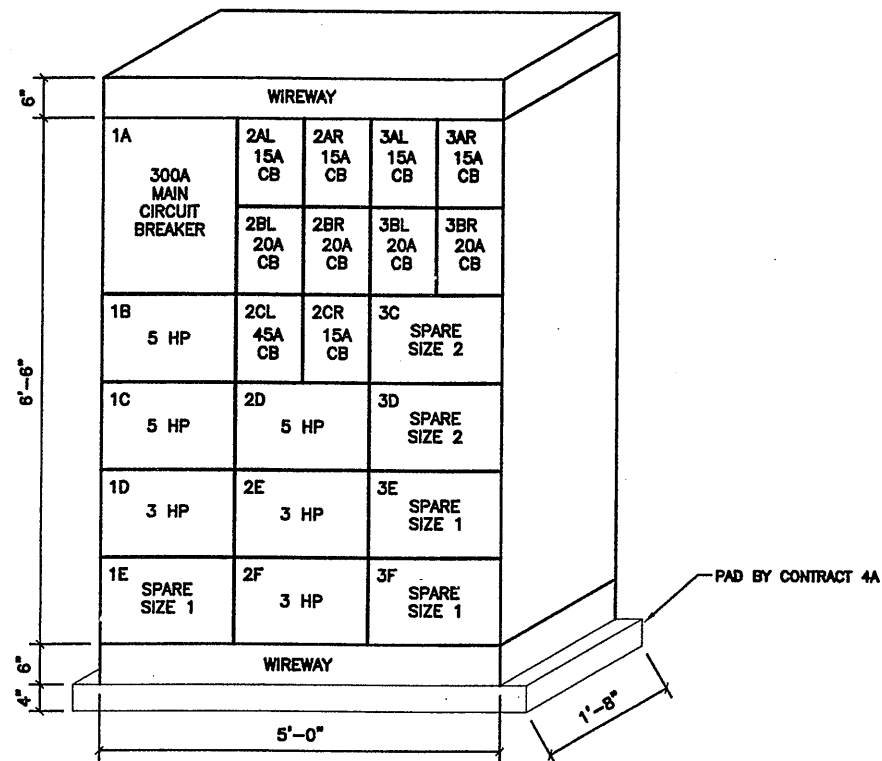

MCC 44 ELEVATION
NOT TO SCALE
(SEE DRAWING E-105)

| 480 VOLT CABLE SCHEDULE | | | | | | |
|-------------------------|---------------|------------|-------------------------------|------------|--------------------|--|
| CONDUIT NUMBER | FROM | TO | CONDUCTOR | INSULATION | CONDUIT/CABLE TRAY | |
| P-1 | PUMP 1 TRANS. | PUMP 1 VFD | 4-250KCMIL/PHASE, 4-2/0G | 600 V | 4-2 1/2" CRGS | |
| P-1A | PUMP 1 VFD | PUMP 1 | 3-380KCMIL/PHASE, 3-2/0G | 600 V | 3-2 1/2" CRGS | |
| P2 | PUMP 2 TRANS. | PUMP 2 VFD | 4-250KCMIL/PHASE, 4-2/0G | 600 V | 4-2 1/2" CRGS | |
| P-2A | PUMP 2 VFD | PUMP 2 | 3-380KCMIL/PHASE, 3-2/0G | 600 V | 3-2 1/2" CRGS | |
| P3 | PUMP 3 TRANS. | PUMP 3 VFD | 4-250KCMIL/PHASE, 4-2/0G | 600 V | 4-2 1/2" CRGS | |
| P-3A | PUMP 3 VFD | PUMP 3 | 3-380KCMIL/PHASE, 3-2/0G | 600 V | 3-2 1/2" CRGS | |
| P4 | PUMP 4 TRANS. | PUMP 4 VFD | 4-250KCMIL/PHASE, 4-2/0G | 600 V | 4-2 1/2" CRGS | |
| P-4A | PUMP 4 VFD | PUMP 4 | 3-380KCMIL/PHASE, 3-2/0G | 600 V | 3-2 1/2" CRGS | |
| P-5 | MCC TRANS. | TRANS. SW. | 1-350MCM/PHASE, 1-2/0N,1-2/0G | 600 V | 3" CRGS | |
| P-6 | MCC TRANS. | TRANS. SW. | 1-350MCM/PHASE, 1-2/0N,1-2/0G | 600 V | 3" CRGS | |
| MF-44 | TRANS. SW. | MCC 44 | 1-350MCM/PHASE, 1-2/0N,1-2/0G | 600 V | 3" CRGS | |
| CC-1 | PUMP 1 VFD | PUMP 1 SL | 4-#14 | 600 V | 1-3/4" CRGS | |
| CC-1A | PUMP 1 SL | PUMP 1 | 2-#14 | 600 V | 1-3/4" CRGS | |
| CC-2 | PUMP 2 VFD | PUMP 2 SL | 4-#14 | 600 V | 1-3/4" CRGS | |
| CC-2A | PUMP 2 SL | PUMP 2 | 2-#14 | 600 V | 1-3/4" CRGS | |
| CC-3 | PUMP 3 VFD | PUMP 3 SL | 4-#14 | 600 V | 1-3/4" CRGS | |
| CC-3A | PUMP 3 SL | PUMP 3 | 2-#14 | 600 V | 1-3/4" CRGS | |
| CC-4 | PUMP 4 VFD | PUMP 4 SL | 4-#14 | 600 V | 1-3/4" CRGS | |
| CC-4A | PUMP 4 SL | PUMP 4 | 2-#14 | 600 V | 1-3/4" CRGS | |

NOTE:
FOR ADDITIONAL 480 VOLT CONDUITS, SEE DRAWING E-105
PUMP TRANSFORMERS SHALL HAVE DELTA-WYE SECONDARY WINDINGS (6 PHASES/TRANSFORMER).

L: ON="*, OFF="REF"
5/30/01 BBL DCC
05503000/0659E107.dwg

NOT TO SCALE

| No. | Date | Revisions | Init |
|-----|----------|---------------------|------|
| 0 | 4/20/01 | ISSUED FOR APPROVAL | JK |
| 1 | | AS BID | |
| 2 | 10/31/05 | RECORD DRAWING | |

NO ALTERATIONS PERMITTED HEREON EXCEPT AS PROVIDED UNDER SECTION 7209 SUBDIVISION 2 OF THE NEW YORK STATE EDUCATION LAW

| | |
|--------------|-----|
| In charge of | TEL |
| Designed by | AHL |
| Drawn by | DCC |
| Checked by | WFH |



ONONDAGA COUNTY • DEPARTMENT OF DRAINAGE AND SANITATION • SYRACUSE, NEW YORK
METROPOLITAN SYRACUSE WASTEWATER TREATMENT PLANT
STAGE III AMMONIA AND STAGE II PHOSPHORUS REMOVAL PROJECT
SECONDARY EFFLUENT PUMP STATION SCHEDULES AND DETAILS
ELECTRICAL



File Number: 00659
Date: APRIL 2001
E-107

| CIRCUIT BREAKER PANELBOARD - LP-44A | | | | | | | | | | SCHEDULE | |
|-------------------------------------|--------------------------------|------------------------------------|--------|--------|-------|-------|-----------------|-------|-----------------|-------------------------------|-----|
| LOCATION: | | SECONDARY EFFLUENT PUMPING STATION | | | | | FEED FROM | | MCC 44, 2CL | | |
| MAIN BUS RATING: | | 225 AMPERES | | | | | 208/120 VOLTS | | 3 PHASE, 4 WIRE | | |
| MINIMUM SHORTCIRCUIT: | | 10,000 AMPERES | | | | | FEEDER CABLE | | 4 #3, 1 #60 | | |
| MAIN BREAKER TRIP: | | 100 AMPERES | | | | | SURFACE MOUNTED | | | | |
| ESTIMATED CONNECTED LOAD: | | 14.831 KVA | | | | | | | | | |
| CB | | | | | | | CB | | | | |
| CKT | | AMPS/ | LOAD | | | | LOAD | AMPS/ | | CKT | |
| NO. | DESCRIPTION | POLES | TYPE | KVA | PH-A | PH-B | PH-C | KVA | POLES | DESCRIPTION | NO. |
| 1 | LIGHTS - ELECTRIC ROOM | 20/1P | LIGHTS | 1.383 | 2.548 | | | 1.185 | 20/1P | NIGHT LIGHTS - PUMP ROOM | 2 |
| 3 | LIGHTS - PUMP ROOM | 20/1P | LIGHTS | 1.600 | | 1.630 | | 0.030 | CONTROL | CLOSED CIRCUIT TV CAMERA NO.5 | 4 |
| 5 | RECEPTACLES - ELECTRIC ROOM | 20/1P | RECEPT | 1.440 | | | 3.440 | 2.000 | RECEPT | PLC RECEPTACLE | 6 |
| 7 | SPARE | 20/1P | RECEPT | 0.360 | 1.673 | | | 1.313 | LIGHTS | EXTERIOR WALL LIGHTS | 8 |
| 9 | RECEPTACLES - PUMP ROOM LOWER | 20/1P | RECEPT | 1.260 | | 1.260 | | | 20/1P | OVERHEAD DOOR BELL & LIGHT | 10 |
| 11 | RECEPTACLES - ROOF WEST | 20/1P | RECEPT | 0.360 | | | 0.375 | 0.015 | INST | LE/LIT-10500, LEVEL #1 | 12 |
| 13 | RECEPTACLES - ROOF EAST | 20/1P | RECEPT | 0.360 | 0.375 | | | 0.015 | INST | LE/LIT-10501, LEVEL #2 | 14 |
| 15 | SPARE | 20/1P | LIGHTS | 1.165 | | 1.165 | | | 20/1P | SPARE | 16 |
| 17 | NIGHT LIGHTS - ELECTRIC ROOM | 20/1P | LIGHTS | 0.481 | | | 0.865 | 0.204 | HEAT | HEAT TRACE - HT-101 | 18 |
| 19 | HW HEATER | 20/2P | HEAT | 1.500 | 1.500 | | | | 20/1P | SPARE | 20 |
| 21 | | | | | | 1.500 | | | 20/1P | SPARE | 22 |
| 23 | RECEPTACLES - N. WALL PUMP RM. | 20/1P | | | | | 0.000 | | 20/1P | SPARE | 24 |
| 25 | RECEPTACLES - UNDER LP44A | 20/1P | | | 0.000 | | | | 20/1P | SPARE | 26 |
| 27 | SPARE | 20/1P | | | | 0.000 | | | 20/1P | SPARE | 28 |
| 29 | SPARE | 20/1P | | | | 0.000 | | | 20/1P | SPARE | 30 |
| 31 | SPARE | 20/1P | | | 0.000 | | | | 20/1P | SPARE | 32 |
| 33 | SPARE | 20/1P | | | | 0.000 | | | 20/1P | SPARE | 34 |
| 35 | SPARE | 20/1P | | | | 0.000 | | | 20/1P | SPARE | 36 |
| 37 | SPARE | 20/1P | | | 0.000 | | | | 20/1P | SPARE | 38 |
| 39 | SPARE | 20/1P | | | | 0.000 | | | 20/1P | SPARE | 40 |
| 41 | SPARE | 20/1P | | | | 0.000 | | | 20/1P | SPARE | 42 |
| LOAD SUMMARY | | | | 9.889 | 6.096 | 5.555 | 4.480 | 4.742 | | | |
| PANEL TOTAL KVA: | | | | 14.631 | | | | | | | |

NOTES:
1. ALL CONDUCTORS TO BE 2 #12, 1 #12G IN 3/4-INCH PVC COATED RIGID STEEL CONDUIT, UNLESS OTHERWISE INDICATED ON POWER PLAN.
2. HEAT TRACE BRANCH CIRCUIT BREAKERS SHALL BE GFI TYPE.

| CIRCUIT BREAKER PANELBOARD - LP-44B | | | | | | | | | | SCHEDULE | |
|-------------------------------------|----------------|-------------------|--------|-------|-------|-------|-----------------|---------|-------------------------|----------|--|
| LOCATION: | | MAG-METER SHELTER | | | | | FEED FROM | | MCC 44, 2CR | | |
| MAIN BUS RATING: | | 100 AMPERES | | | | | 208/120 VOLTS | | 1 PHASE, 2 WIRE | | |
| MINIMUM SHORTCIRCUIT: | | 10,000 AMPERES | | | | | FEEDER CABLE | | 2 #10, 1 #10G | | |
| MAIN BREAKER TRIP: | | 30 AMPERES | | | | | SURFACE MOUNTED | | | | |
| ESTIMATED CONNECTED LOAD: | | 0.360 KVA | | | | | | | | | |
| CB | | | | | | | CB | | | | |
| CKT | | AMPS/ | LOAD | | | | LOAD | AMPS/ | | CKT | |
| NO. | DESCRIPTION | POLES | TYPE | KVA | PH-A | PH-B | KVA | POLES | DESCRIPTION | NO. | |
| 1 | GFI RECEPTACLE | 20/1P | RECEPT | 0.180 | 0.180 | | | 20/1P | SPARE | 2 | |
| 3 | SPARE | 20/1P | | | 0.180 | 0.180 | | CONTROL | MAG-METER CONTROL PANEL | 4 | |
| 5 | SPARE | 20/1P | | 0.000 | | | | 20/1P | SPARE | 6 | |
| 7 | SPARE | 20/1P | | 0.000 | | | | 20/1P | SPARE | 8 | |
| 9 | SPARE | 20/1P | | 0.000 | | | | 20/1P | SPARE | 10 | |
| 11 | SPARE | 20/1P | | | 0.000 | | | 20/1P | SPARE | 12 | |
| LOAD SUMMARY | | | | 0.180 | 0.180 | 0.180 | 0.180 | | | | |
| PANEL TOTAL KVA: | | | | 0.360 | | | | | | | |


NOTES:
1. ALL CONDUCTORS TO BE 2 #12, 1 #12G IN 3/4-INCH PVC COATED RIGID STEEL CONDUIT, UNLESS OTHERWISE INDICATED ON POWER PLAN.
2. HEAT TRACE BRANCH CIRCUIT BREAKERS SHALL BE GFI TYPE.

| CIRCUIT BREAKER PANELBOARD - LP-44C | | | | | | | | | | SCHEDULE | |
|-------------------------------------|----------------|------------------------------------|--------|-------|-------|-------|-----------------|-------|-----------------|----------|--|
| LOCATION: | | SECONDARY EFFLUENT PUMPING STATION | | | | | FEED FROM | | MCC 44, 2CR | | |
| MAIN BUS RATING: | | 100 AMPERES | | | | | 208/120 VOLTS | | 1 PHASE, 2 WIRE | | |
| MINIMUM SHORTCIRCUIT: | | 10,000 AMPERES | | | | | FEEDER CABLE | | 2 #10, 1 #10G | | |
| MAIN BREAKER TRIP: | | 30 AMPERES | | | | | SURFACE MOUNTED | | | | |
| ESTIMATED CONNECTED LOAD: | | 0.240 KVA | | | | | | | | | |
| CB | | | | | | | CB | | | | |
| CKT | | AMPS/ | LOAD | | | | LOAD | AMPS/ | | CKT | |
| NO. | DESCRIPTION | POLES | TYPE | KVA | PH-A | PH-B | KVA | POLES | DESCRIPTION | NO. | |
| 1 | GFI RECEPTACLE | 20/1P | RECEPT | 0.180 | 0.180 | | | 20/1P | SPARE | 2 | |
| 3 | SPARE | 20/1P | | | | 0.060 | 0.060 | HEAT | HEAT TRACING | 4 | |
| 5 | SPARE | 20/1P | | 0.000 | | | | 20/1P | SPARE | 6 | |
| 7 | SPARE | 20/1P | | | 0.000 | | | 20/1P | SPARE | 8 | |
| 9 | SPARE | 20/1P | | 0.000 | | | | 20/1P | SPARE | 10 | |
| 11 | SPARE | 20/1P | | | 0.000 | | | 20/1P | SPARE | 12 | |
| LOAD SUMMARY | | | | 0.180 | 0.180 | 0.060 | 0.060 | | | | |
| PANEL TOTAL KVA: | | | | 0.240 | | | | | | | |


NOTES:
1. ALL CONDUCTORS TO BE 2 #12, 1 #12G IN 3/4-INCH PVC COATED RIGID STEEL CONDUIT, UNLESS OTHERWISE INDICATED ON POWER PLAN.
2. HEAT TRACE BRANCH CIRCUIT BREAKERS SHALL BE GFI TYPE.

RECORD DRAWING
THESE DRAWINGS HAVE BEEN REVIEWED TO REFLECT MAJOR CHANGES, IF ANY, WHICH OCCURRED DURING CONSTRUCTION. REVISIONS ARE BASED UPON INFORMATION SUPPLIED BY CONTRACTOR.
DATE: 10/31/05 PER: [Signature]

THIS DRAWING WAS PREPARED AT THE SCALE INDICATED IN THE TITLE BLOCK. INACCURACIES IN THE STATED SCALE MAY BE INTRODUCED WHEN DRAWINGS ARE REPRODUCED BY ANY MEANS. USE THE GRAPHIC SCALE BAR IN THE TITLE BLOCK TO DETERMINE THE ACTUAL SCALE OF THIS DRAWING.

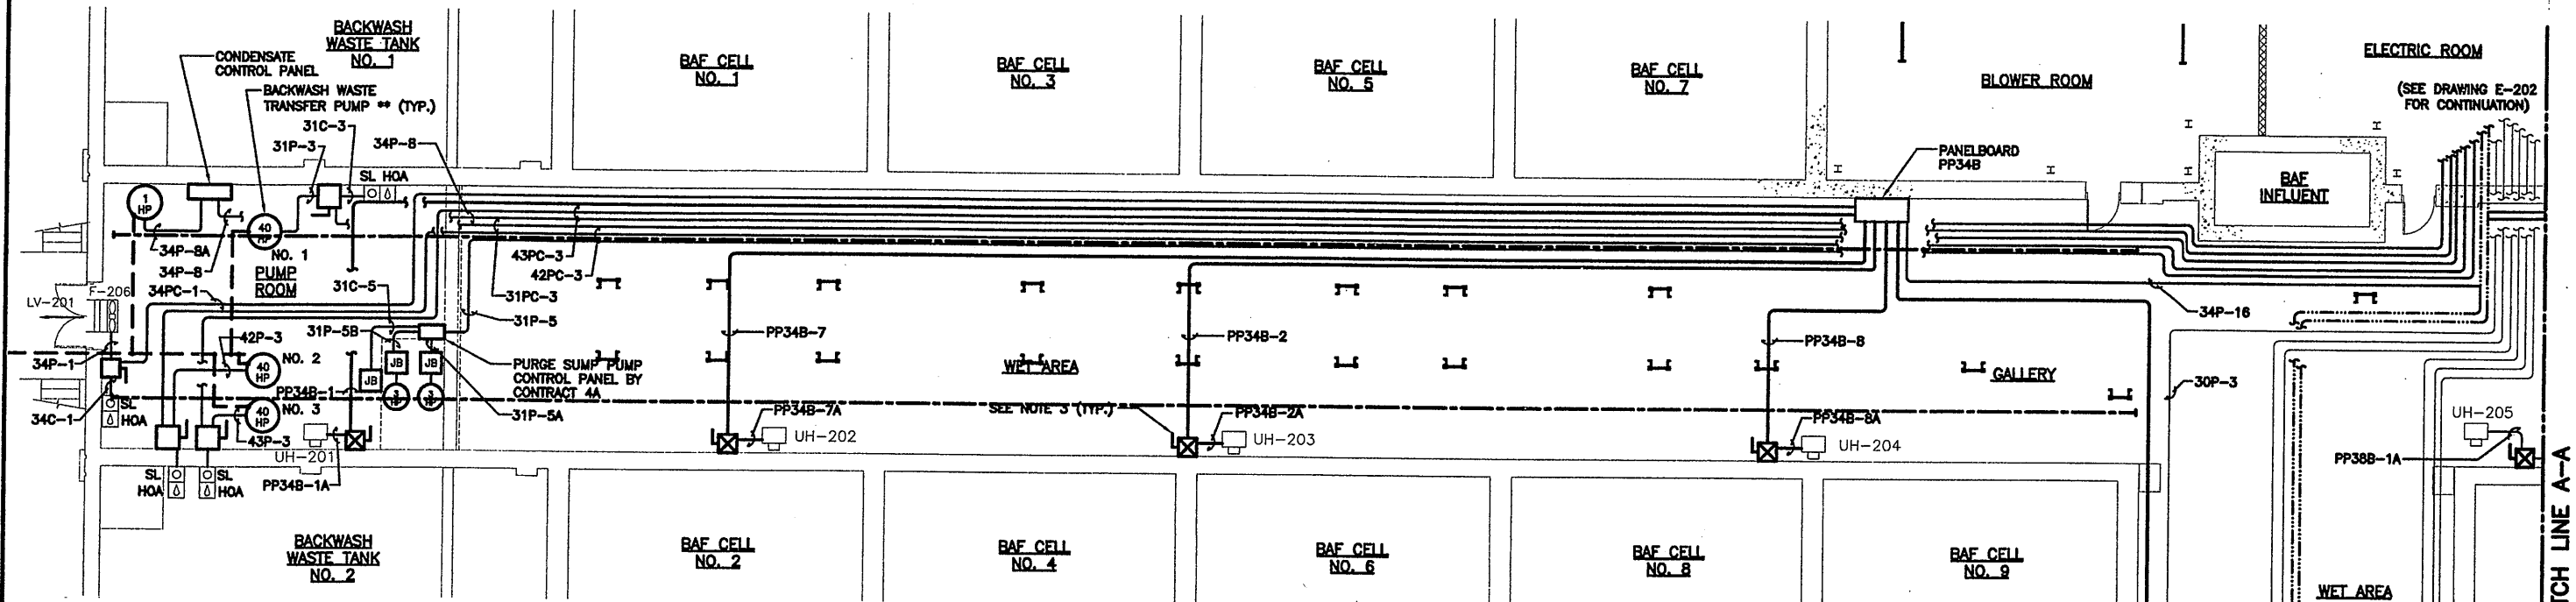

BAF LOWER LEVEL POWER PLAN SOUTH
SCALE: 1/8"=1'-0"

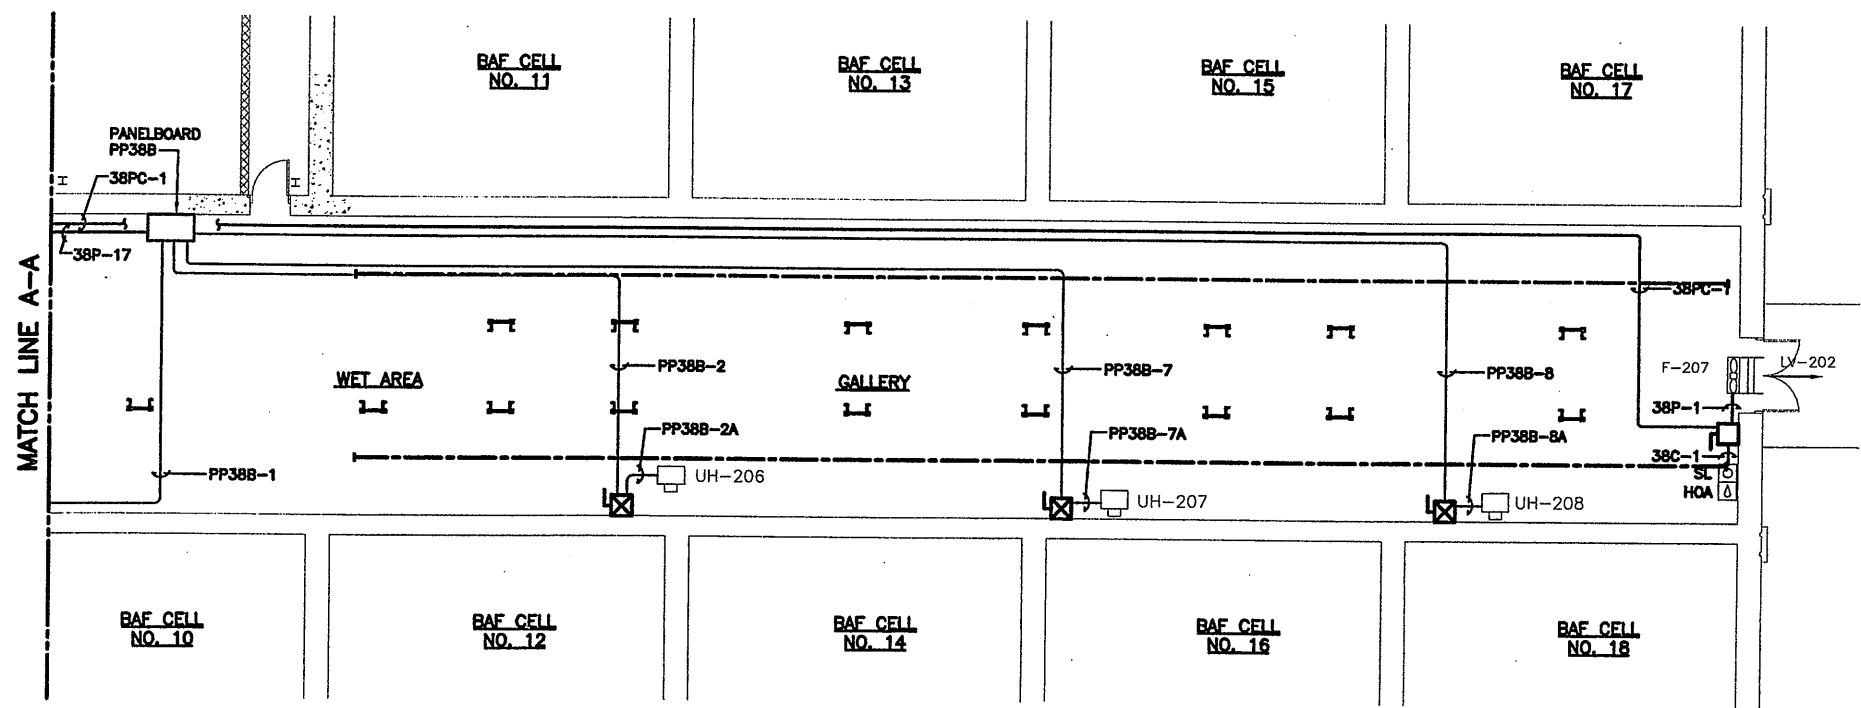

BAF LOWER LEVEL POWER PLAN NORTH
SCALE: 1/8"=1'-0"

- NOTES:**
1. FOR CONDUIT SCHEDULES REFER TO MCC DRAWINGS E-207 AND E-208.
 2. USE LIQUID-TITE FLEXIBLE CONDUIT, NOT IN EXCESS OF 6 FEET, TO CONNECT TO VIBRATING EQUIPMENT.
 3. MOUNT DISCONNECT SWITCHES WHERE ACCESSIBLE FROM GRATED WALKWAYS.
 4. ** INDICATES AN ITEM OR ITEMS SUPPLIED BY OWNER FOR INSTALLATION BY THE CONTRACTOR.
 5. PROVIDE AND INSTALL 316 STAINLESS STEEL DRIP SHIELD ABOVE MCC 39 EXTENDING OUT ONE FOOT. PLACE ABOVE CONDUITS.
 6. REFER TO HVAC DRAWINGS FOR ADDITIONAL LOUVER, DAMPER, THERMOSTAT, CONTROL VALVE, DIRECT DIGITAL CONTROL (DDC), AND OTHER CONTROL HVAC REQUIREMENTS. CONTRACT 4B (ELECTRICAL) SHALL PROVIDE ALL CONDUIT AND CONDUCTORS FOR 120 VOLT CONTROLS, AS SHOWN OR REQUIRED (EXCEPT WIRING BETWEEN DDC SYSTEM COMPONENTS). CONTRACT 4C (HVAC) SHALL PROVIDE ALL CONDUIT AND CONDUCTORS REQUIRED FOR LOW VOLTAGE (LESS THAN 120 VOLT) CONTROLS AND WIRING BETWEEN DDC SYSTEM COMPONENTS INCLUDING BUT NOT LIMITED TO, LOW VOLTAGE T-STAT, VARIABLE AIR VOLUME (VAV) CONTROLS, ETC.

RECORD DRAWING

THESE DRAWINGS HAVE BEEN REVIEWED TO REFLECT MAJOR CHANGES IF ANY, WHICH OCCURRED DURING CONSTRUCTION. REVISIONS ARE BASED UPON INFORMATION SUPPLIED BY CONTRACTOR.
DATE: 10/21/05 PER: [Signature]

THIS DRAWING WAS PREPARED AT THE SCALE INDICATED IN THE TITLE BLOCK. INACCURACIES IN THE STATED SCALE MAY BE INTRODUCED WHEN DRAWINGS ARE REPRODUCED BY ANY MEANS. USE THE GRAPHIC SCALE BAR IN THE TITLE BLOCK TO DETERMINE THE ACTUAL SCALE OF THIS DRAWING.

Layer: ON=*, OFF=*REF*
X: 0659X201.DWG
5/30/01 BBL DCC
05503000/0659E201.DWG

1/8"=1'-0"
NO ALTERATIONS PERMITTED HEREON EXCEPT AS PROVIDED UNDER SECTION 7209 SUBDIVISION 2 OF THE NEW YORK STATE EDUCATION LAW


| No. | Date | Revisions | Init |
|-----|----------|---------------------|-------------|
| 0 | 4/20/01 | ISSUED FOR APPROVAL | [Signature] |
| 1 | | AS BID | |
| 2 | 10/31/05 | RECORD DRAWING | |

In charge of TEL
Designed by MEE
Drawn by DCC
Checked by WFH

ENVIRONMENTAL ENGINEERING ASSOCIATES, LLP
SYRACUSE, NEW YORK

ONONDAGA COUNTY • DEPARTMENT OF DRAINAGE AND SANITATION • SYRACUSE, NEW YORK
METROPOLITAN SYRACUSE WASTEWATER TREATMENT PLANT
STAGE III AMMONIA AND STAGE II PHOSPHORUS REMOVAL PROJECT
BAF COMPLEX
BAF LOWER LEVEL POWER PLAN
ELECTRICAL

File Number 00659
Date APRIL 2001
E-201
[Signature]

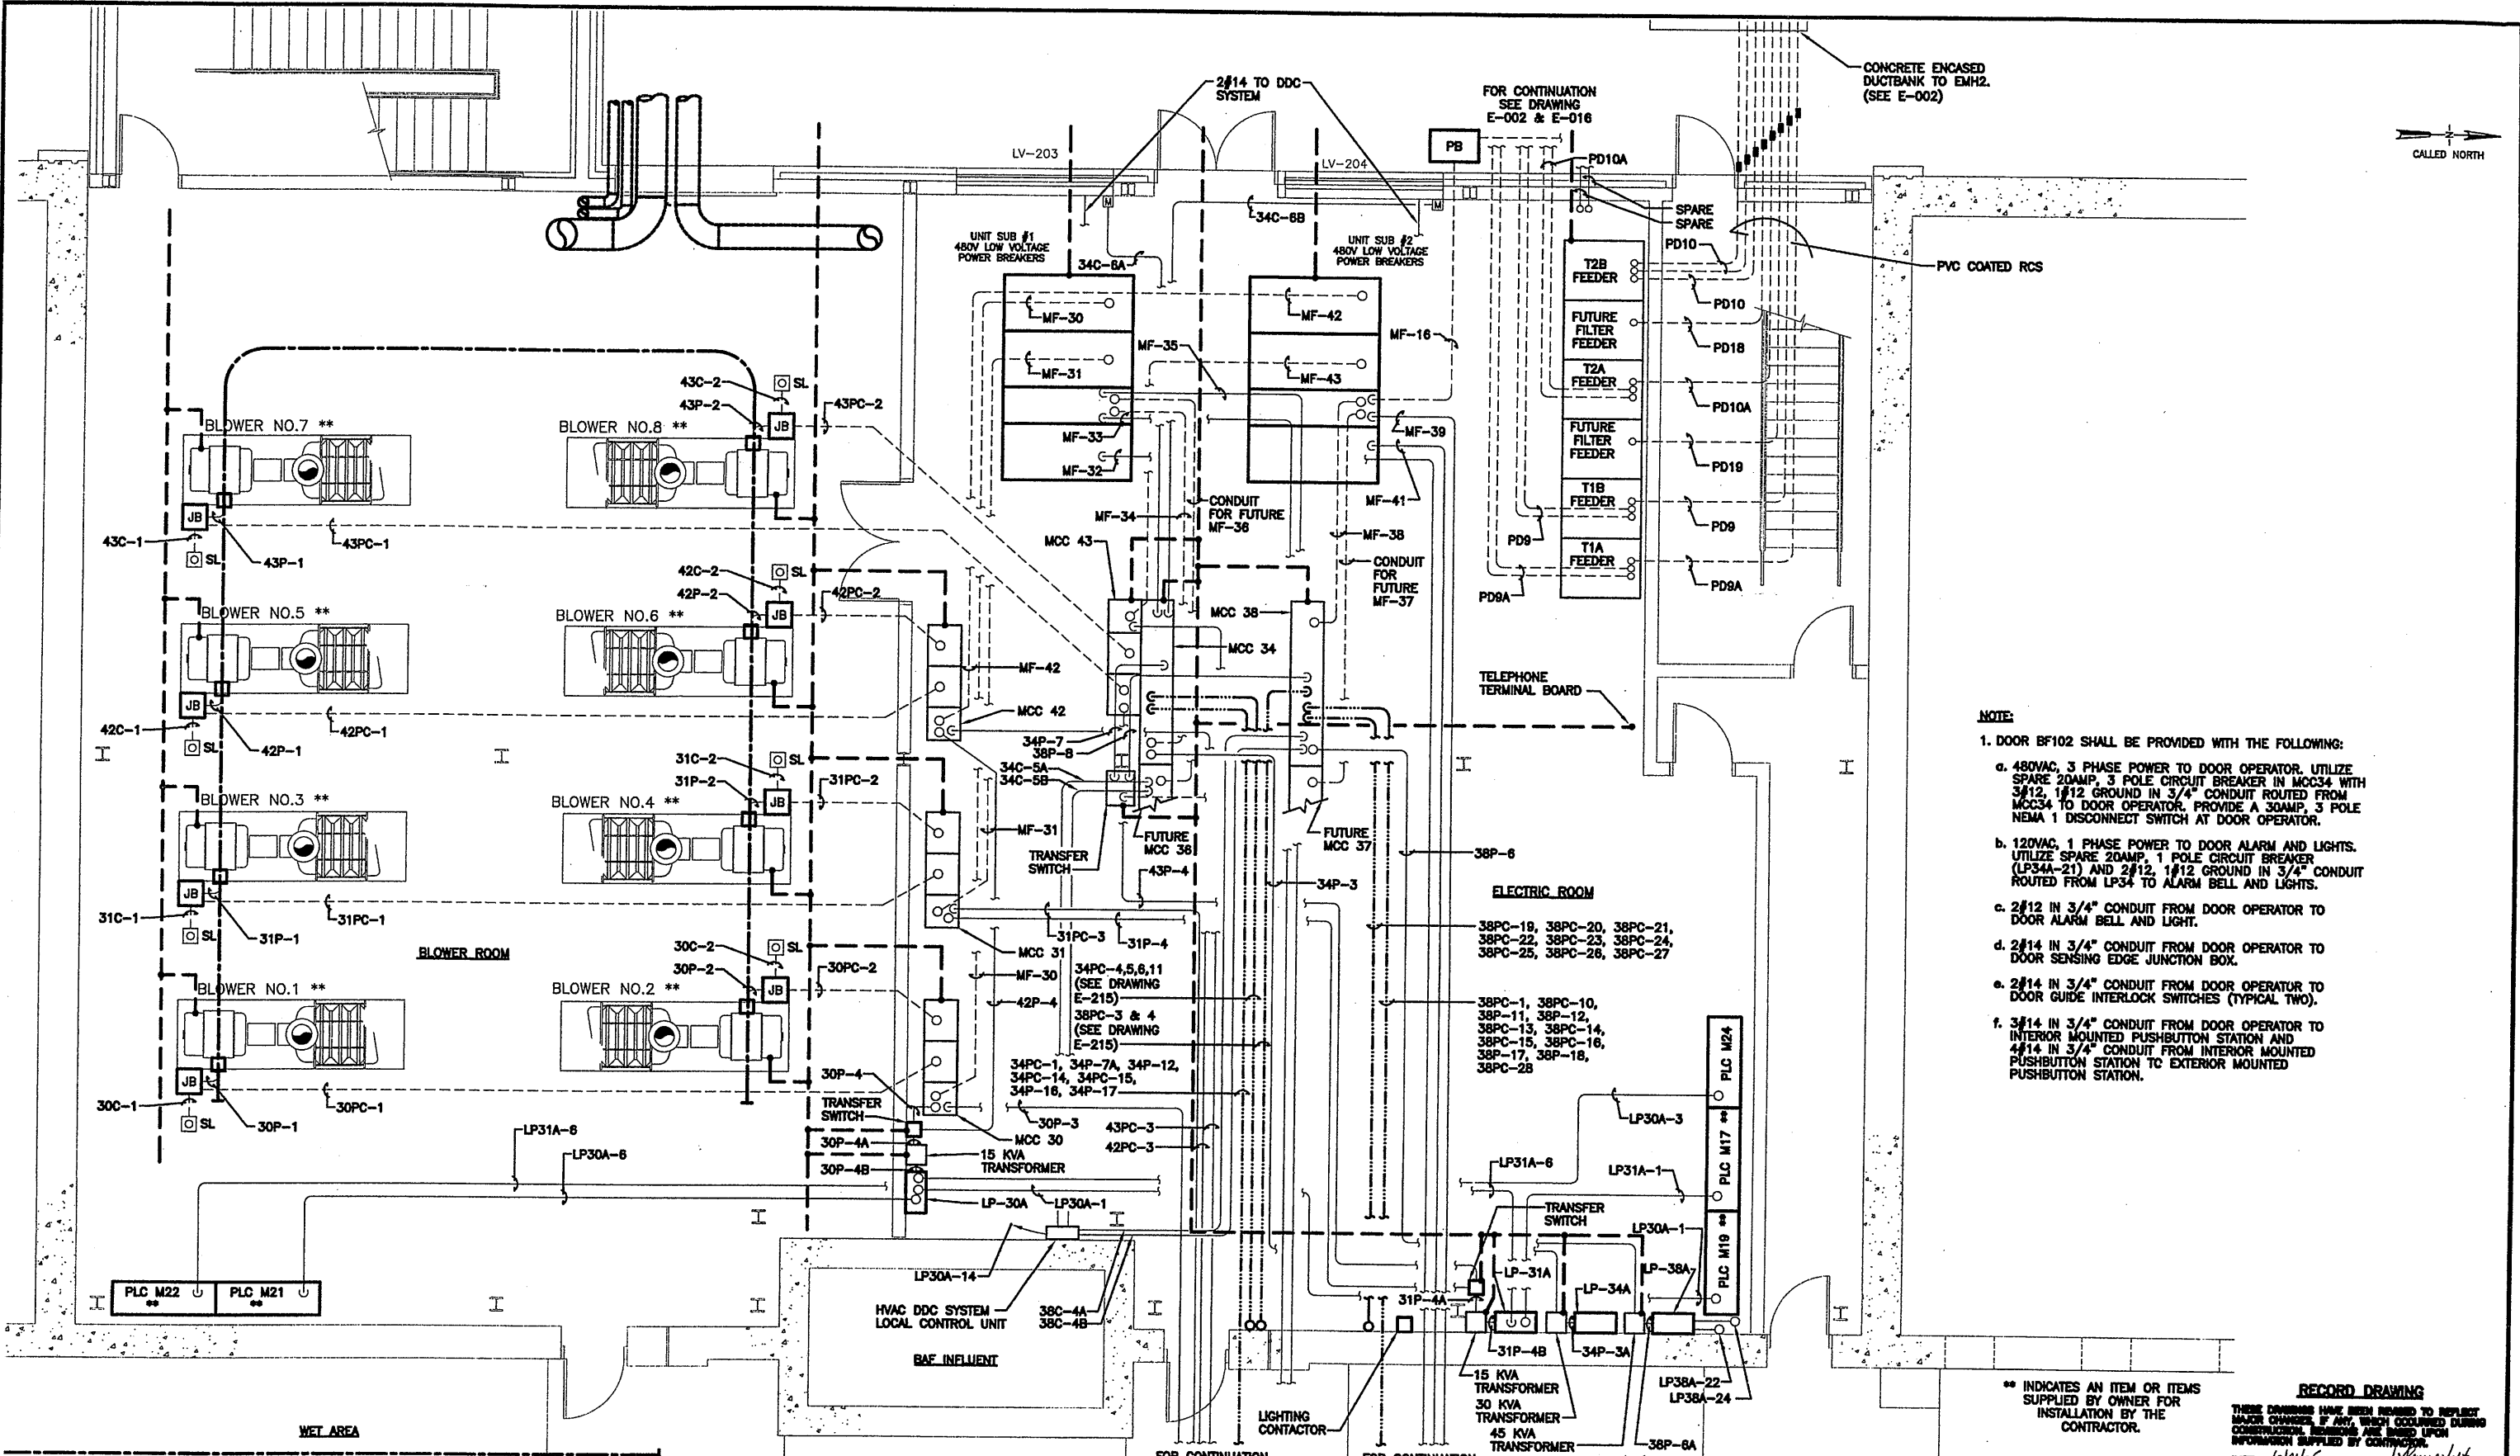

- NOTE:**
- DOOR BF102 SHALL BE PROVIDED WITH THE FOLLOWING:
 - 480VAC, 3 PHASE POWER TO DOOR OPERATOR. UTILIZE SPARE 20AMP, 3 POLE CIRCUIT BREAKER IN MCC34 WITH 3/12, 1/12 GROUND IN 3/4" CONDUIT ROUTED FROM MCC34 TO DOOR OPERATOR. PROVIDE A 30AMP, 3 POLE NEMA 1 DISCONNECT SWITCH AT DOOR OPERATOR.
 - 120VAC, 1 PHASE POWER TO DOOR ALARM AND LIGHTS. UTILIZE SPARE 20AMP, 1 POLE CIRCUIT BREAKER (LP34A-21) AND 2/12, 1/12 GROUND IN 3/4" CONDUIT ROUTED FROM LP34 TO ALARM BELL AND LIGHTS.
 - 2/12 IN 3/4" CONDUIT FROM DOOR OPERATOR TO DOOR ALARM BELL AND LIGHT.
 - 2/14 IN 3/4" CONDUIT FROM DOOR OPERATOR TO DOOR SENSING EDGE JUNCTION BOX.
 - 2/14 IN 3/4" CONDUIT FROM DOOR OPERATOR TO DOOR GUIDE INTERLOCK SWITCHES (TYPICAL TWO).
 - 3/14 IN 3/4" CONDUIT FROM DOOR OPERATOR TO INTERIOR MOUNTED PUSHBUTTON STATION AND 4/14 IN 3/4" CONDUIT FROM INTERIOR MOUNTED PUSHBUTTON STATION TO EXTERIOR MOUNTED PUSHBUTTON STATION.

RECORD DRAWING
 THESE DRAWINGS HAVE BEEN REVISIONED TO REFLECT MAJOR CHANGES, IF ANY, WHICH OCCURRED DURING CONSTRUCTION. REVISIONS ARE BASED UPON INFORMATION SUPPLIED BY CONTRACTOR.
 DATE: 10/21/05 FOR: Wampollet

BAF BLOWER AND ELECTRIC ROOM POWER PLAN

SCALE: 1/4"=1'-0"

Layer: ON=*, OFF=REF
 X: 0659X201.DWG
 5/30/01 BBL DCC
 06503000/0659E202.DWG

NO ALTERATIONS PERMITTED HEREON EXCEPT AS PROVIDED UNDER SECTION 7209 SUBDIVISION 2 OF THE NEW YORK STATE EDUCATION LAW

| No. | Date | Revisions | Init |
|-----|----------|---------------------|------|
| 0 | 4/20/01 | ISSUED FOR APPROVAL | TEL |
| 1 | | AS BID | |
| 2 | 10/31/05 | RECORD DRAWING | |

In charge of TEL
 Designed by MEE
 Drawn by DCC
 Checked by WFH




ONONDAGA COUNTY • DEPARTMENT OF DRAINAGE AND SANITATION • SYRACUSE, NEW YORK
 METROPOLITAN SYRACUSE WASTEWATER TREATMENT PLANT
 STAGE III AMMONIA AND STAGE II PHOSPHORUS REMOVAL PROJECT
BAF COMPLEX
BAF BLOWER AND ELECTRIC ROOM
 ELECTRICAL




File Number: 00659
 Date: APRIL 2001
 E-202
 Wampollet


THIS DRAWING WAS PREPARED AT THE SCALE INDICATED IN THE TITLE BLOCK. INACCURACIES IN THE STATED SCALE MAY BE INTRODUCED WHEN DRAWINGS ARE REPRODUCED BY ANY MEANS. USE THE GRAPHIC SCALE BAR IN THE TITLE BLOCK TO DETERMINE THE ACTUAL SCALE OF THIS DRAWING.

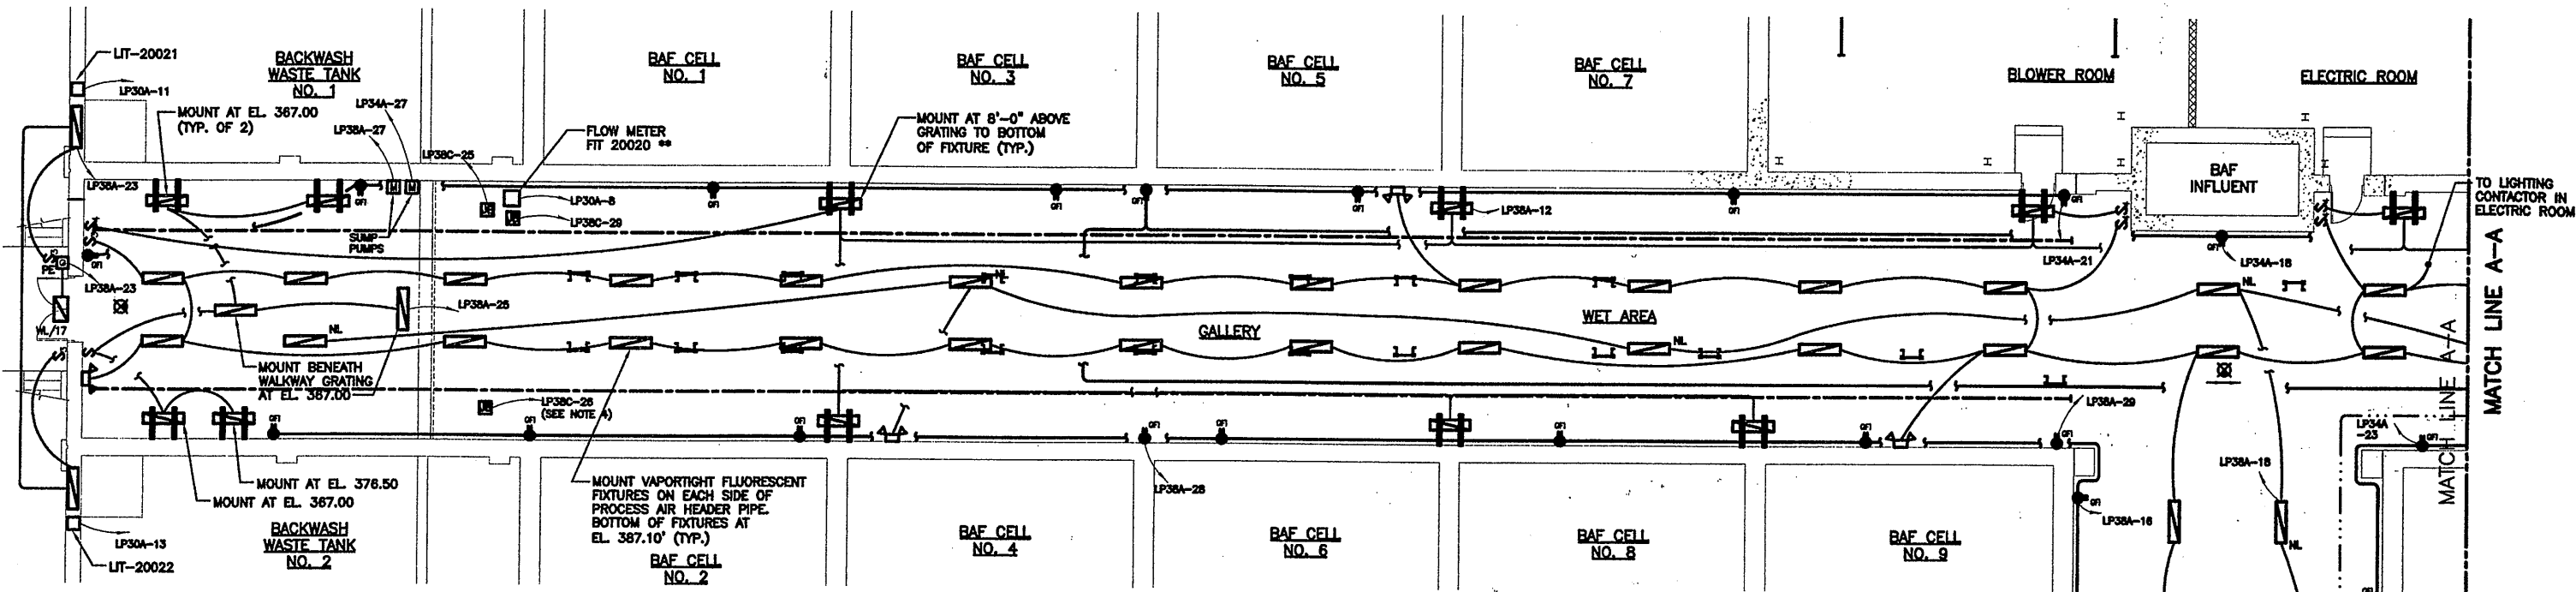

BAF LOWER LEVEL LIGHTING PLAN SOUTH
SCALE: 1/8"=1'-0"

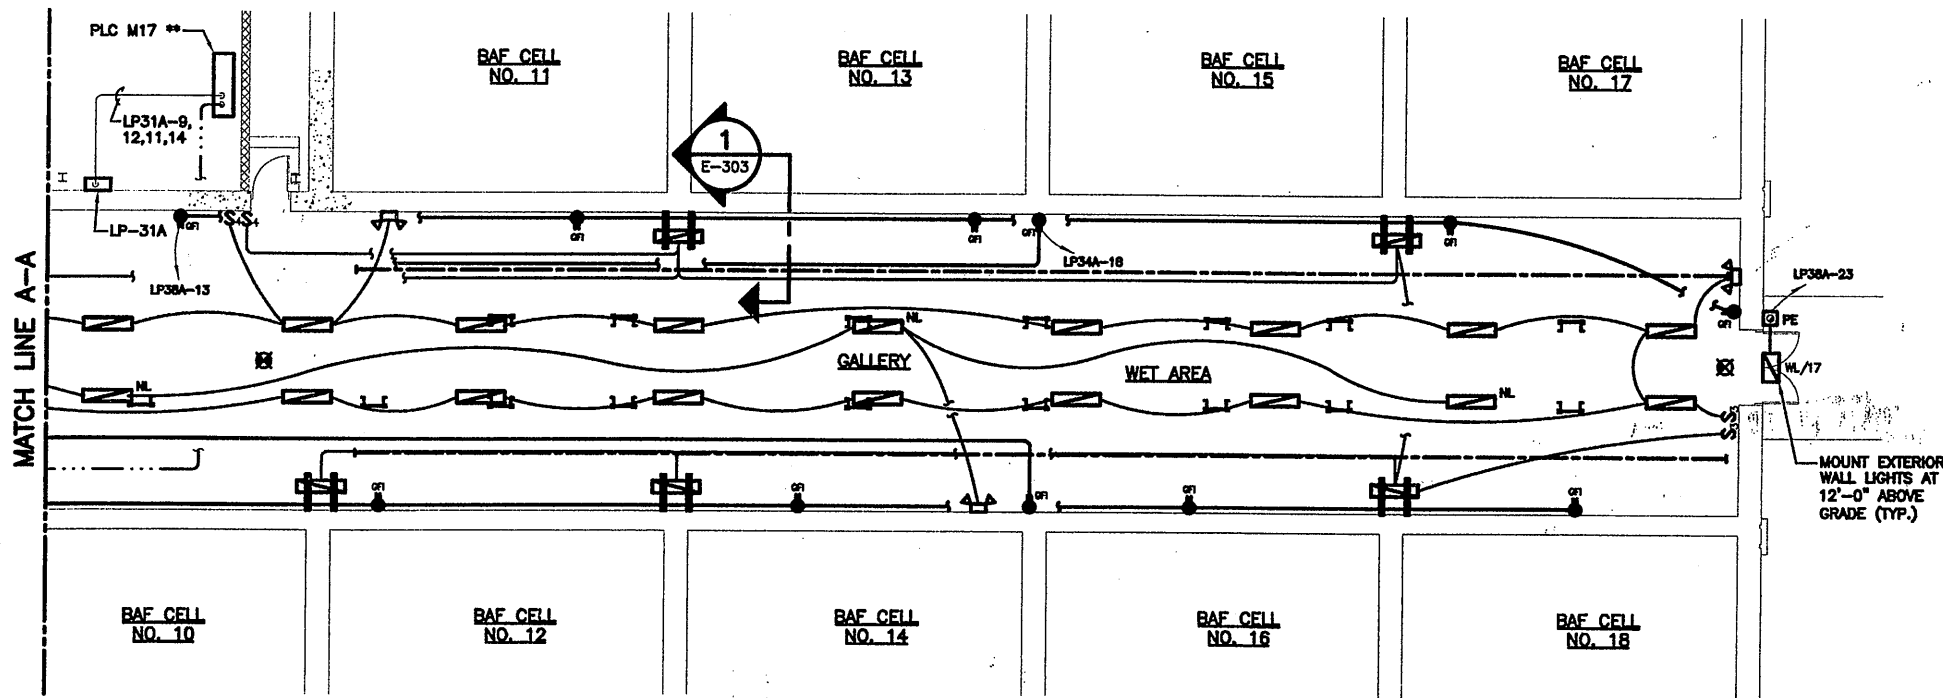

BAF LOWER LEVEL LIGHTING PLAN NORTH
SCALE: 1/8"=1'-0"

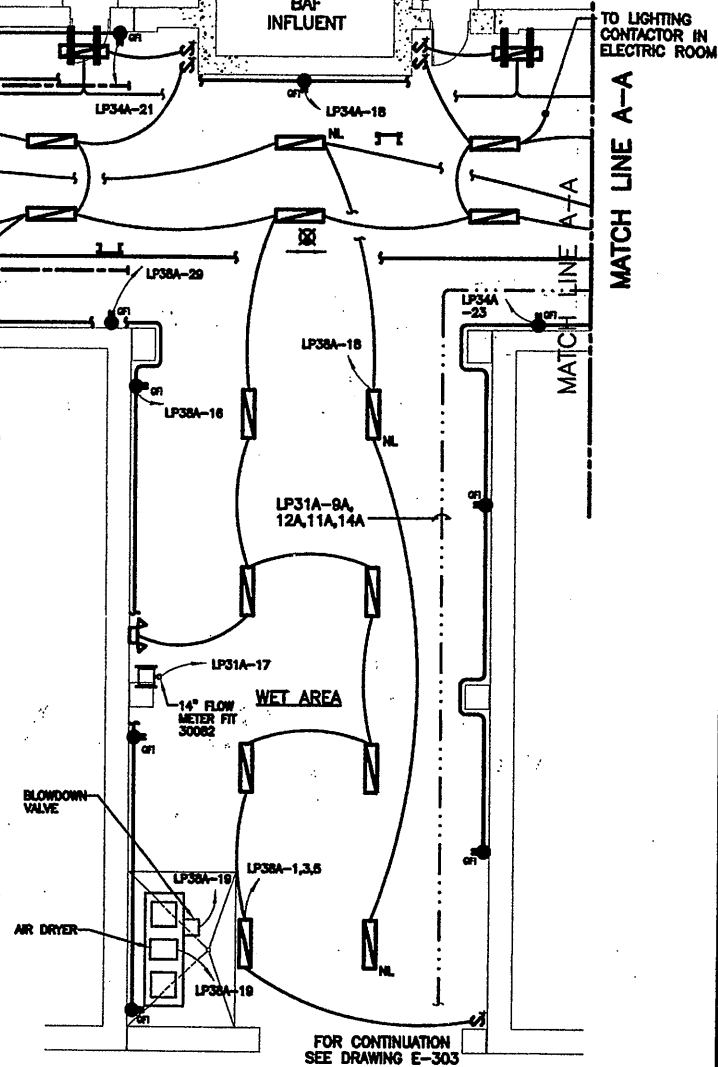

- NOTES:**
- FOR PANELBOARD SCHEDULES REFER TO DRAWINGS E-216 AND E-217.
 - USE LIQUID-TITE FLEXIBLE CONDUIT, NOT IN EXCESS OF 6 FEET, TO CONNECT TO VIBRATING EQUIPMENT.
 - ** INDICATES AN ITEM OR ITEMS SUPPLIED BY OWNER FOR INSTALLATION BY THE CONTRACTOR.
 - CONTRACTOR SHALL FURNISH AND INSTALL MULTIPLE HEAT TRACE CIRCUITS FOR ROOF DRAIN PIPING. COORDINATE LOCATIONS IN FIELD. SEE DRAWING P-202.

RECORD DRAWING
THESE DRAWINGS HAVE BEEN REVISIONED TO REFLECT MAJOR CHANGES, IF ANY, WHICH OCCURRED DURING CONSTRUCTION. REVISIONS ARE BASED UPON INFORMATION SUPPLIED BY CONTRACTOR.
DATE: 10/21/05 FOR: [Signature]

THIS DRAWING WAS PREPARED AT THE SCALE INDICATED IN THE TITLE BLOCK. INACCURACIES IN THE STATED SCALE MAY BE INTRODUCED WHEN DRAWINGS ARE REPRODUCED BY ANY MEANS. USE THE GRAPHIC SCALE BAR IN THE TITLE BLOCK TO DETERMINE THE ACTUAL SCALE OF THIS DRAWING.

Layer: ON=*, OFF=*REF*
X: 0659X201.DWG
5/30/01 BBL DCC
05503000/0659E201.DWG


1/8"=1'-0"
NO ALTERATIONS PERMITTED HEREON EXCEPT AS PROVIDED UNDER SECTION 7209 SUBDIVISION 2 OF THE NEW YORK STATE EDUCATION LAW

| No. | Date | Revisions | Init |
|-----|----------|---------------------|-------------|
| 0 | 4/20/01 | ISSUED FOR APPROVAL | [Signature] |
| 1 | | AS BID | |
| 2 | 10/31/05 | RECORD DRAWING | |

In charge of TEL
Designed by MEE
Drawn by DCC
Checked by WFH



ENVIRONMENTAL ENGINEERING ASSOCIATES, LLP
SYRACUSE, NEW YORK

ONONDAGA COUNTY • DEPARTMENT OF DRAINAGE AND SANITATION • SYRACUSE, NEW YORK
METROPOLITAN SYRACUSE WASTEWATER TREATMENT PLANT
STAGE III AMMONIA AND STAGE II PHOSPHORUS REMOVAL PROJECT
BAF COMPLEX
BAF LOWER LEVEL LIGHTING PLAN

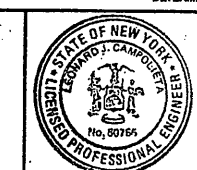

File Number: 00659
Date: APRIL 2001
E-203
[Signature]

ELECTRICAL

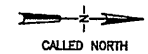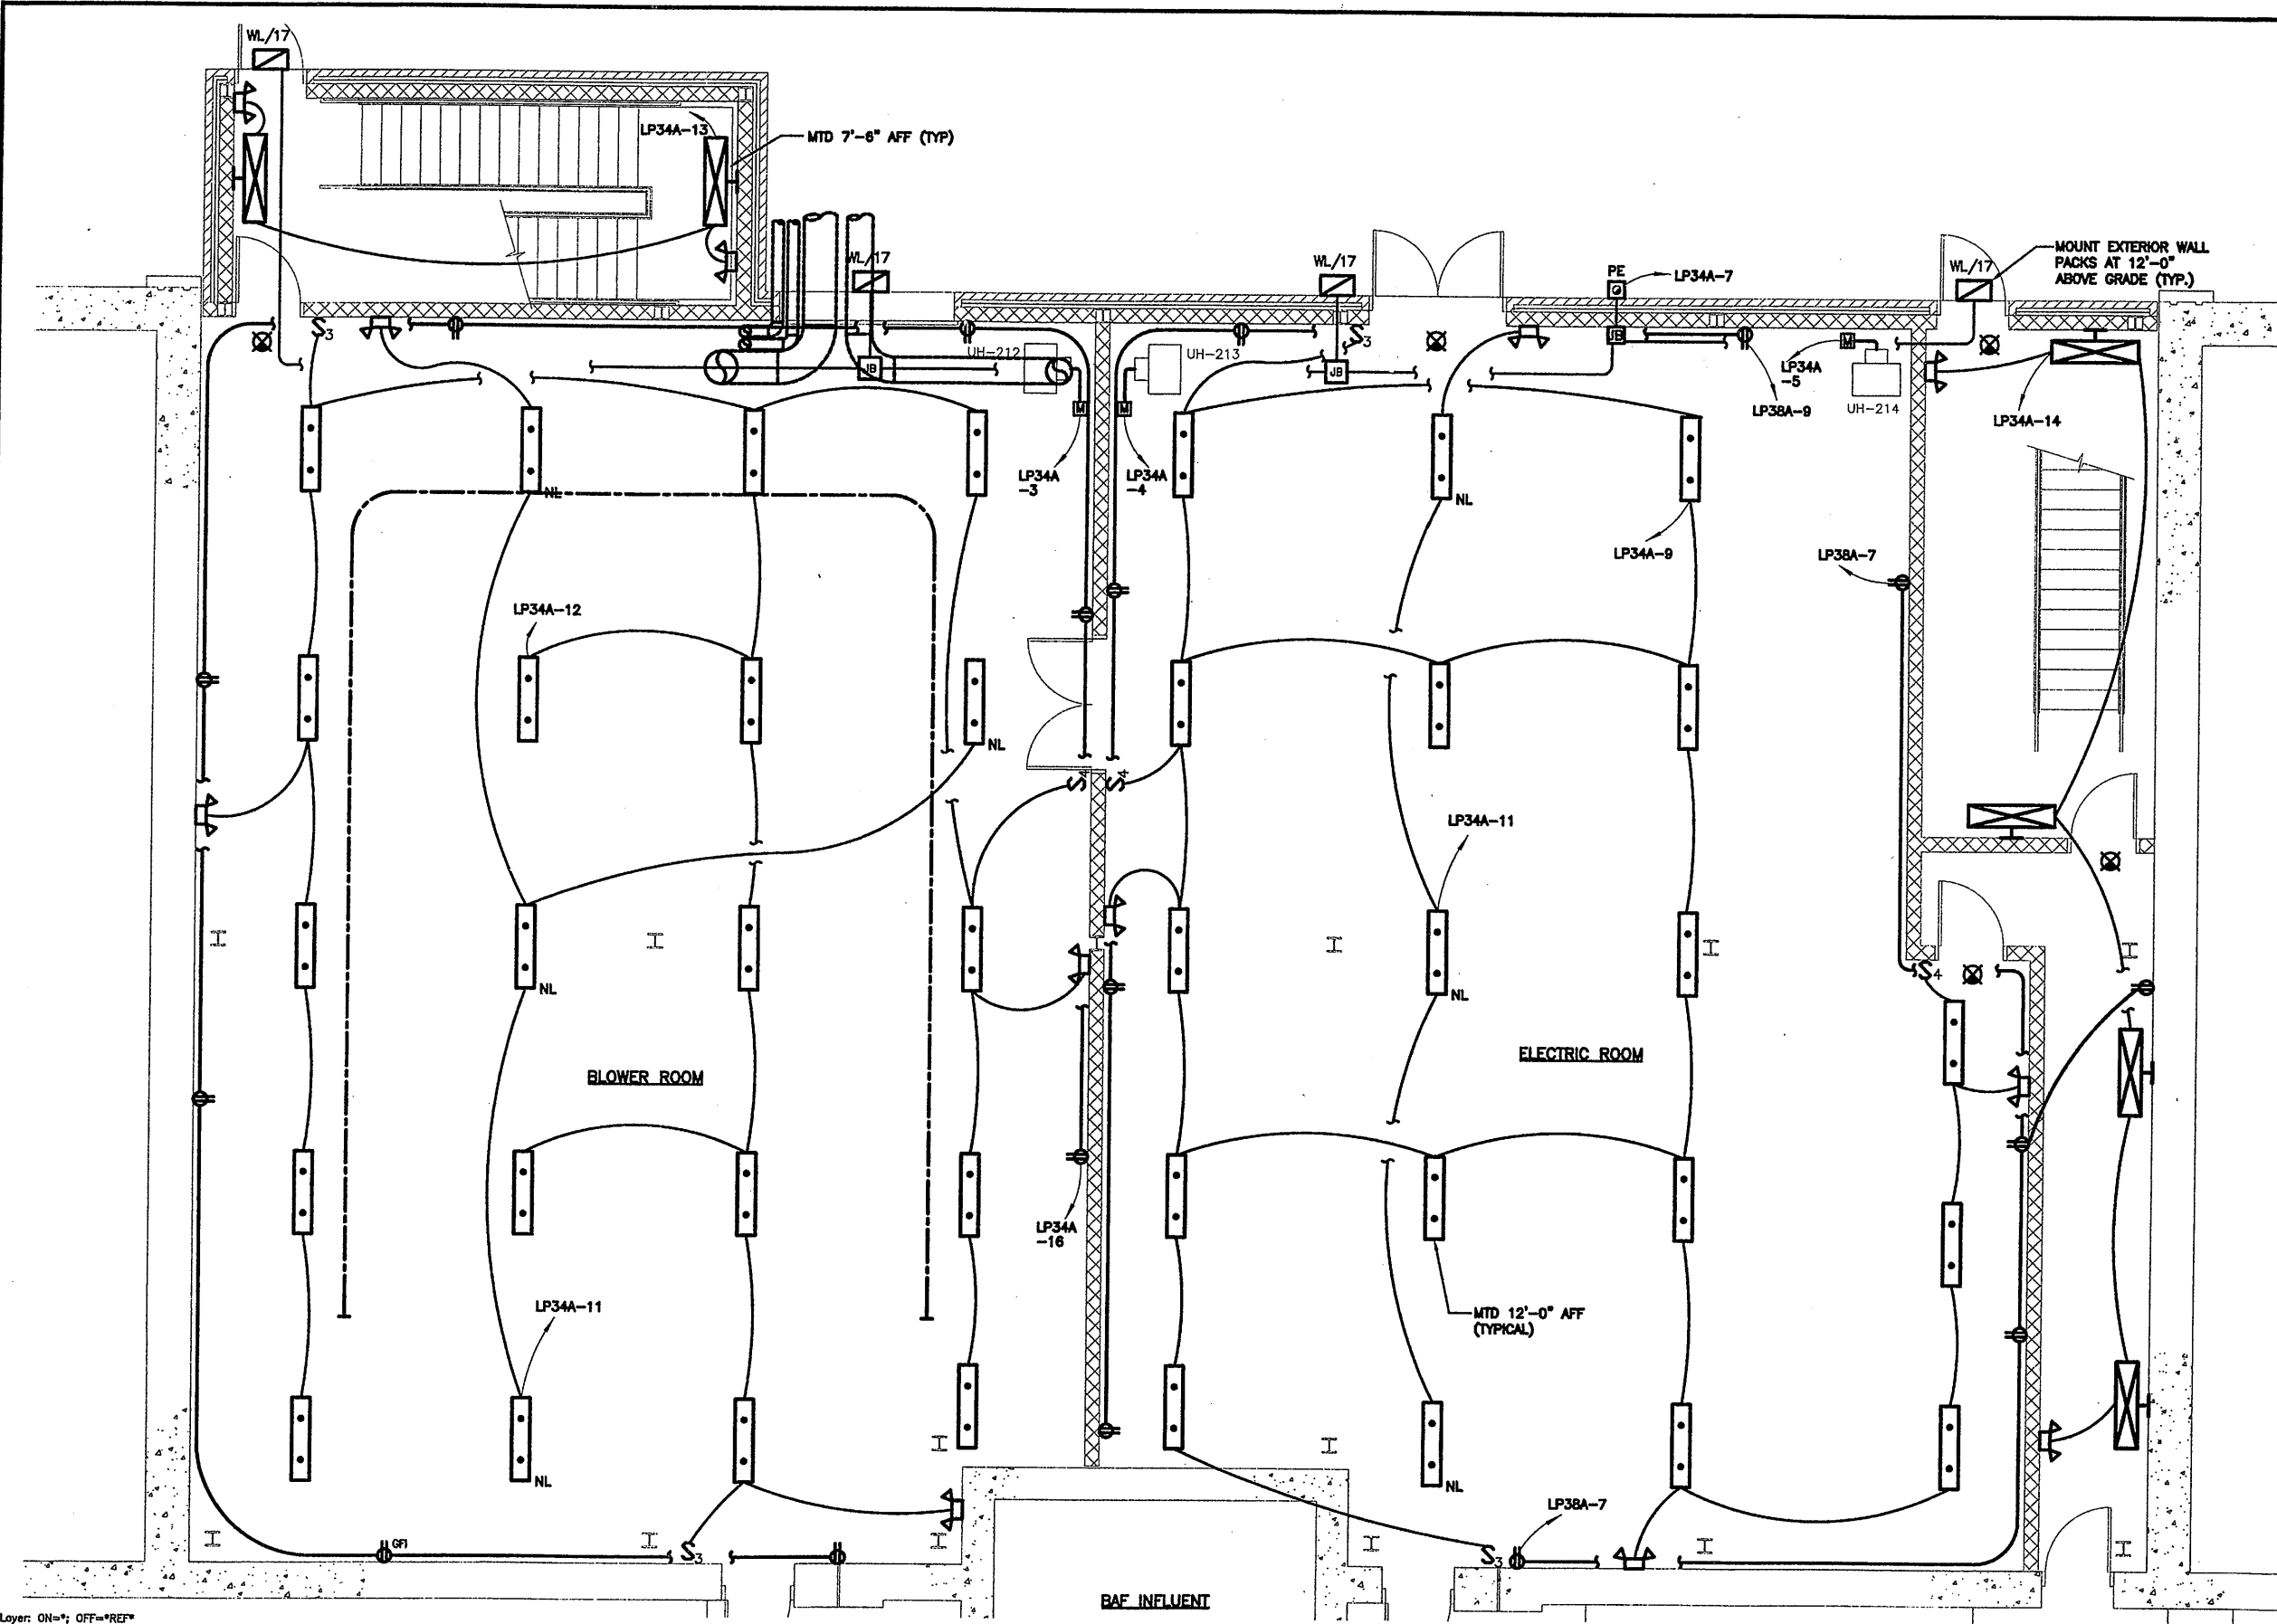


BAF BLOWER AND ELECTRIC ROOM LIGHTING PLANS
SCALE: 1/4"=1'-0"

RECORD DRAWING

THESE DRAWINGS HAVE BEEN REVISIONED TO REFLECT MAJOR CHANGES IF ANY, WHICH OCCURRED DURING CONSTRUCTION. REVISIONS ARE BASED UPON INFORMATION SUPPLIED BY CONTRACTOR.
DATE: 10/21/05 PER: *Wampol*

THIS DRAWING WAS PREPARED AT THE SCALE INDICATED IN THE TITLE BLOCK. INACCURACIES IN THE STATED SCALE MAY BE INTRODUCED WHEN DRAWINGS ARE REPRODUCED BY ANY MEANS. USE THE GRAPHIC SCALE BAR IN THE TITLE BLOCK TO DETERMINE THE ACTUAL SCALE OF THIS DRAWING.


Layer: ON=*; OFF=*REF*
X: 0659X201.DWG
5/30/01 BBL DCC
06503000/0659E204.DWG

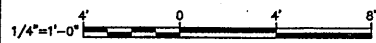

NO ALTERATIONS PERMITTED HEREON EXCEPT AS PROVIDED UNDER SECTION 7209 SUBDIVISION 2 OF THE NEW YORK STATE EDUCATION LAW

| No. | Date | Revisions | Init |
|-----|----------|---------------------|------|
| 0 | 4/20/01 | ISSUED FOR APPROVAL | LC |
| 1 | | AS BID | |
| 2 | 10/31/05 | RECORD DRAWING | |



In charge of TEL
Designed by MEE
Drawn by DCC
Checked by WFH

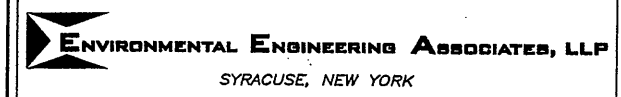

ONONDAGA COUNTY • DEPARTMENT OF DRAINAGE AND SANITATION • SYRACUSE, NEW YORK
METROPOLITAN SYRACUSE WASTEWATER TREATMENT PLANT
STAGE III AMMONIA AND STAGE II PHOSPHORUS REMOVAL PROJECT
BAF COMPLEX
BAF BLOWER AND ELECTRIC ROOM
LIGHTING PLANS
ELECTRICAL



File Number
00659
Date
APRIL 2001
Wampol
E-204

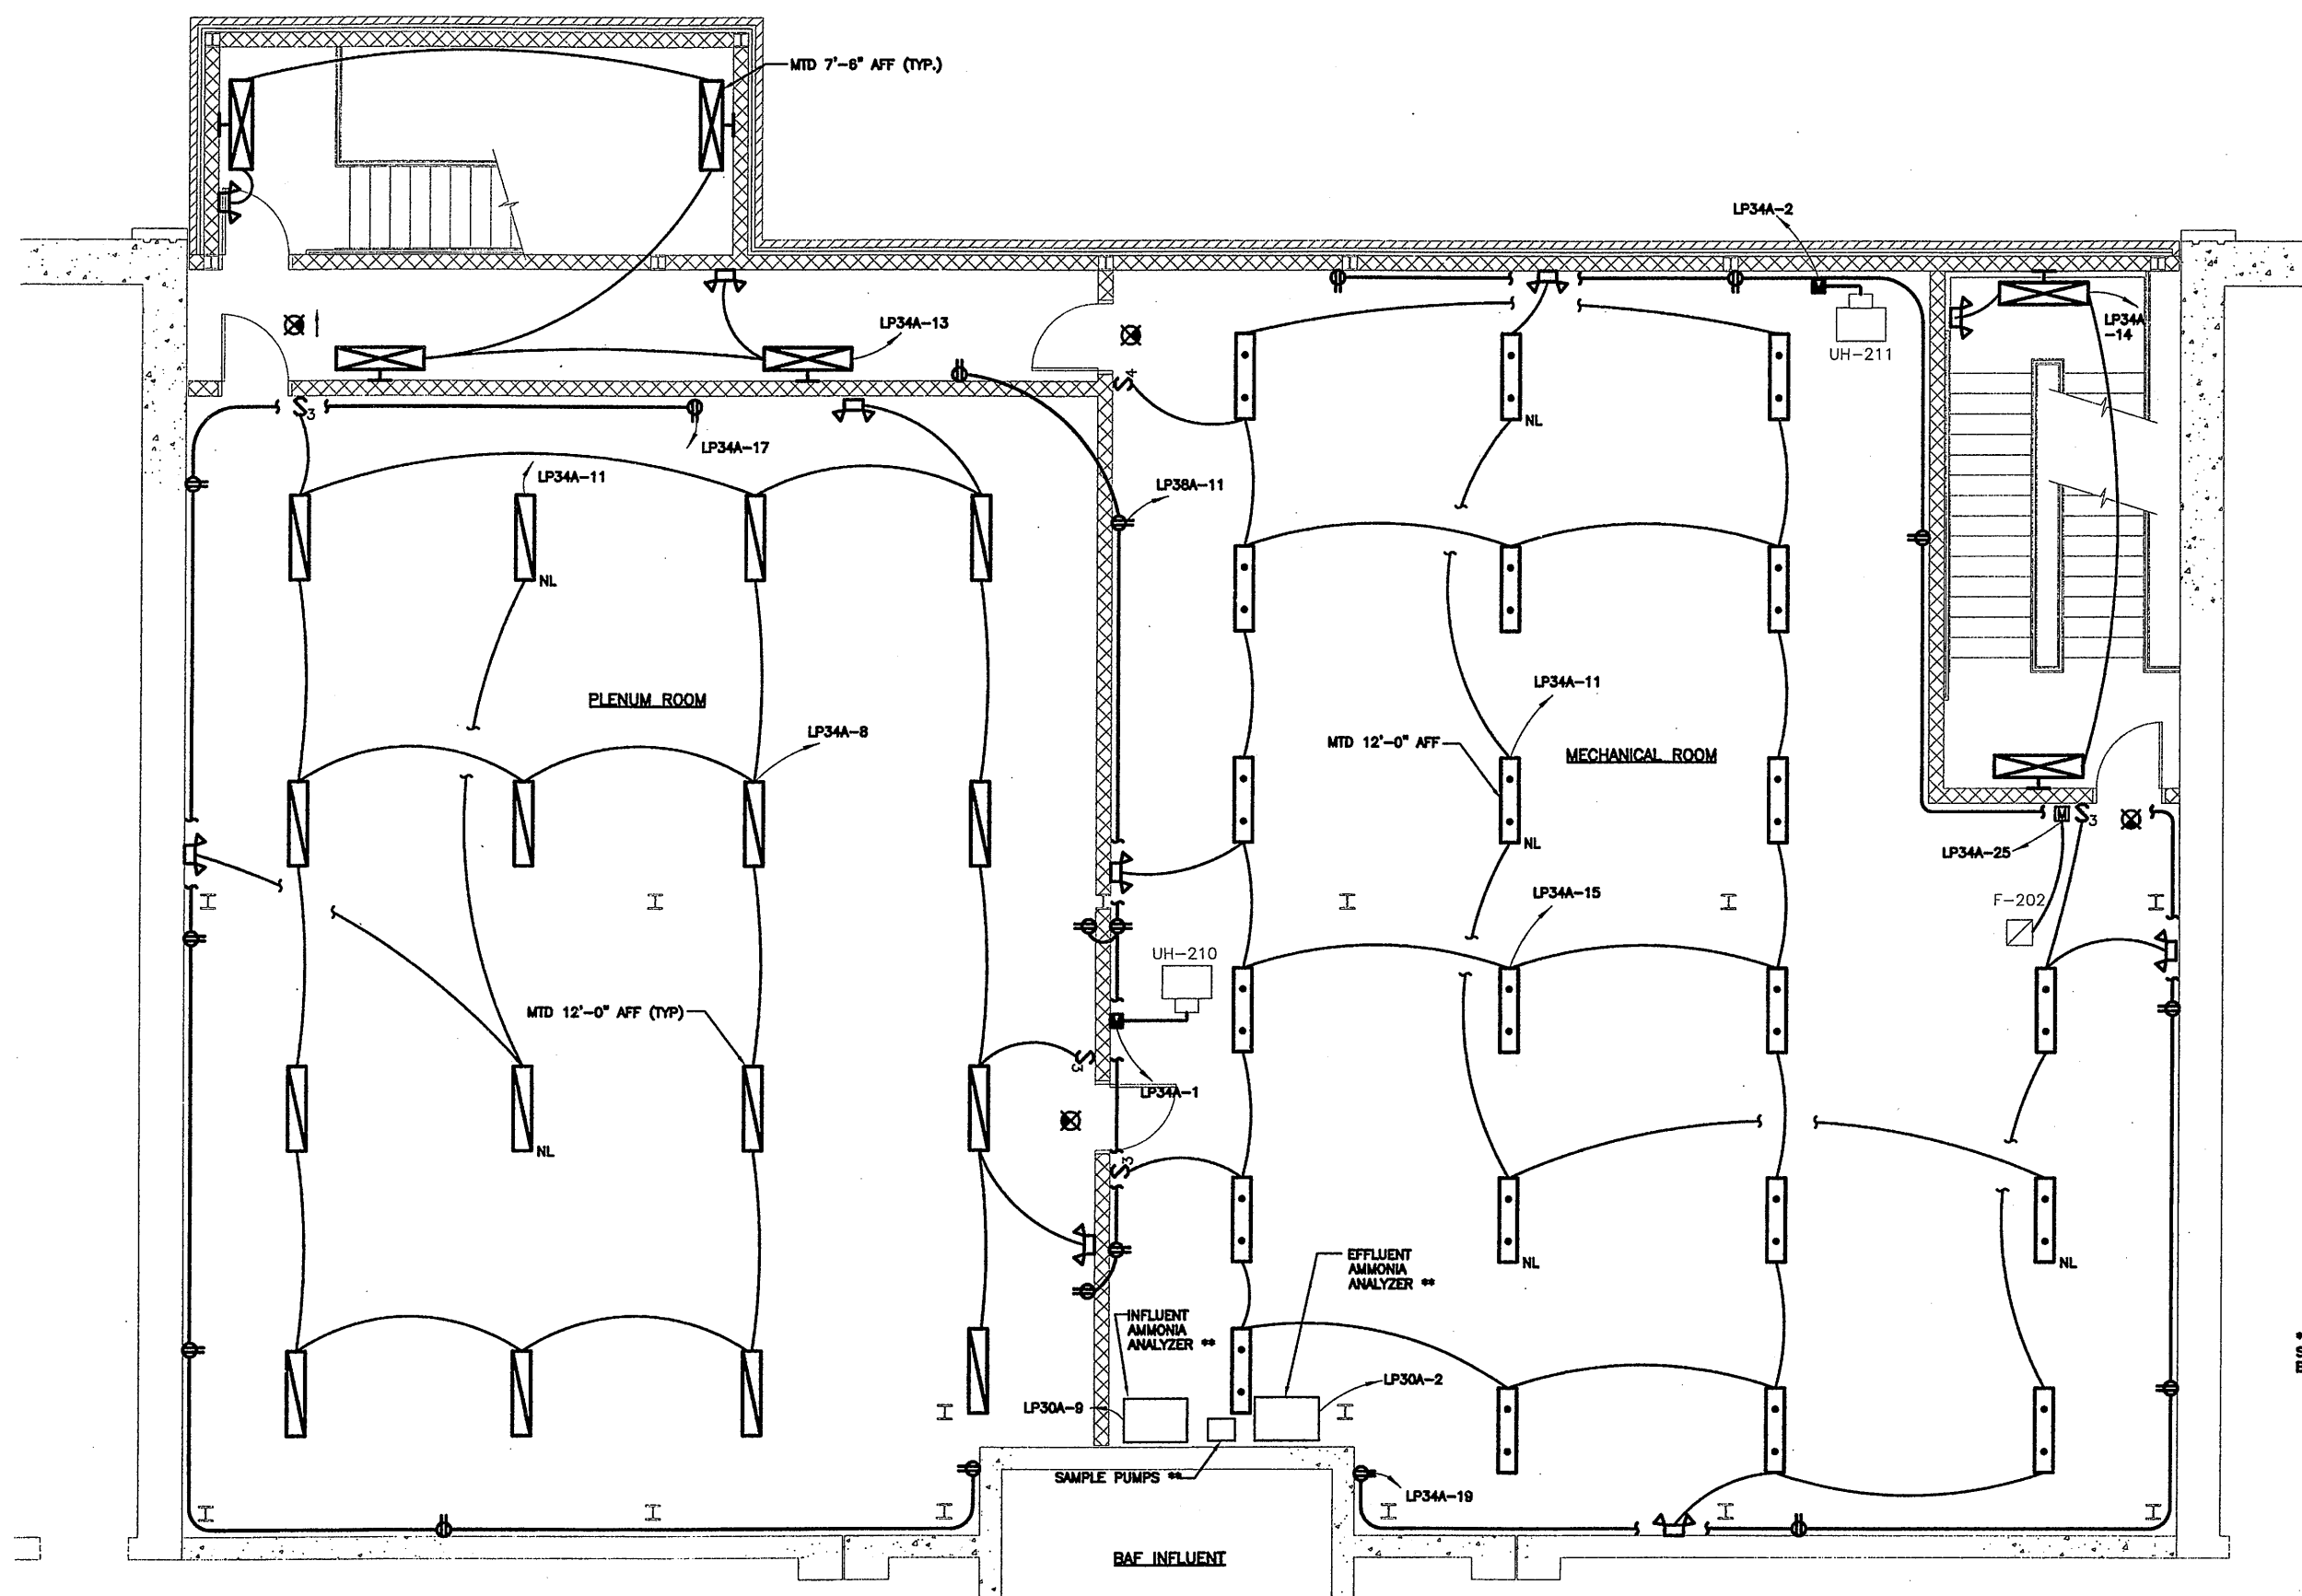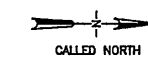

** INDICATES AN ITEM OR ITEMS SUPPLIED BY OWNER FOR INSTALLATION BY THE CONTRACTOR.

RECORD DRAWING
 THESE CHANGES HAVE BEEN MADE TO REFLECT EACH CHANGE, IF ANY, WHICH OCCURRED DURING CONSTRUCTION. REVISIONS ARE BASED UPON INFORMATION SUPPLIED BY CONTRACTOR.
 DATE: 10/21/05 PER: L. Campbell

THIS DRAWING WAS PREPARED AT THE SCALE INDICATED IN THE TITLE BLOCK. INACCURACIES IN THE STATED SCALE MAY BE INTRODUCED WHEN DRAWINGS ARE REPRODUCED BY ANY MEANS. USE THE GRAPHIC SCALE BAR IN THE TITLE BLOCK TO DETERMINE THE ACTUAL SCALE OF THIS DRAWING.

Layer: ON=*, OFF=*REF*
 X: 0659X202.DWG
 5/30/01 EBL DCC
 05503000/0659E205.DWG

BAF MECHANICAL ROOM LIGHTING PLAN
 SCALE: 1/4"=1'-0"


1/4"=1'-0"
 NO ALTERATIONS PERMITTED HEREON EXCEPT AS PROVIDED UNDER SECTION 7209 SUBDIVISION 2 OF THE NEW YORK STATE EDUCATION LAW

| No. | Date | Revisions | Init |
|-----|----------|---------------------|------|
| 0 | 4/20/01 | ISSUED FOR APPROVAL | DK |
| 1 | | AS BID | |
| 2 | 10/31/05 | RECORD DRAWING | |




In charge of --- TEL ---
 Designed by --- MEE ---
 Drawn by --- DCC ---
 Checked by --- WFH ---



ONONDAGA COUNTY • DEPARTMENT OF DRAINAGE AND SANITATION • SYRACUSE, NEW YORK
 METROPOLITAN SYRACUSE WASTEWATER TREATMENT PLANT
 STAGE III AMMONIA AND STAGE II PHOSPHORUS REMOVAL PROJECT
BAF COMPLEX
BAF PLENUM AND MECHANICAL ROOM
LIGHTING PLANS
 ELECTRICAL

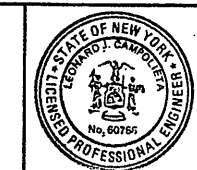


File Number
 00659
 Date
 APRIL 2001
 E-205
 L. Campbell

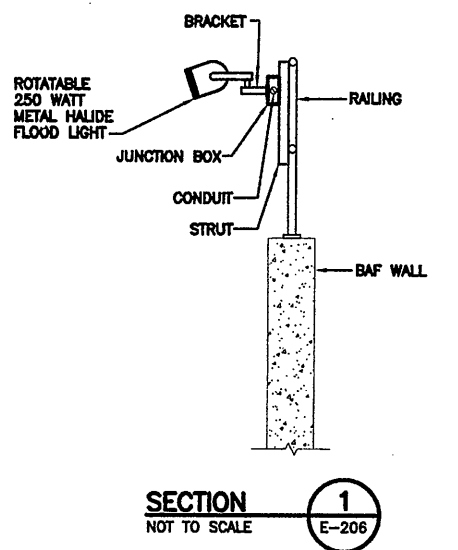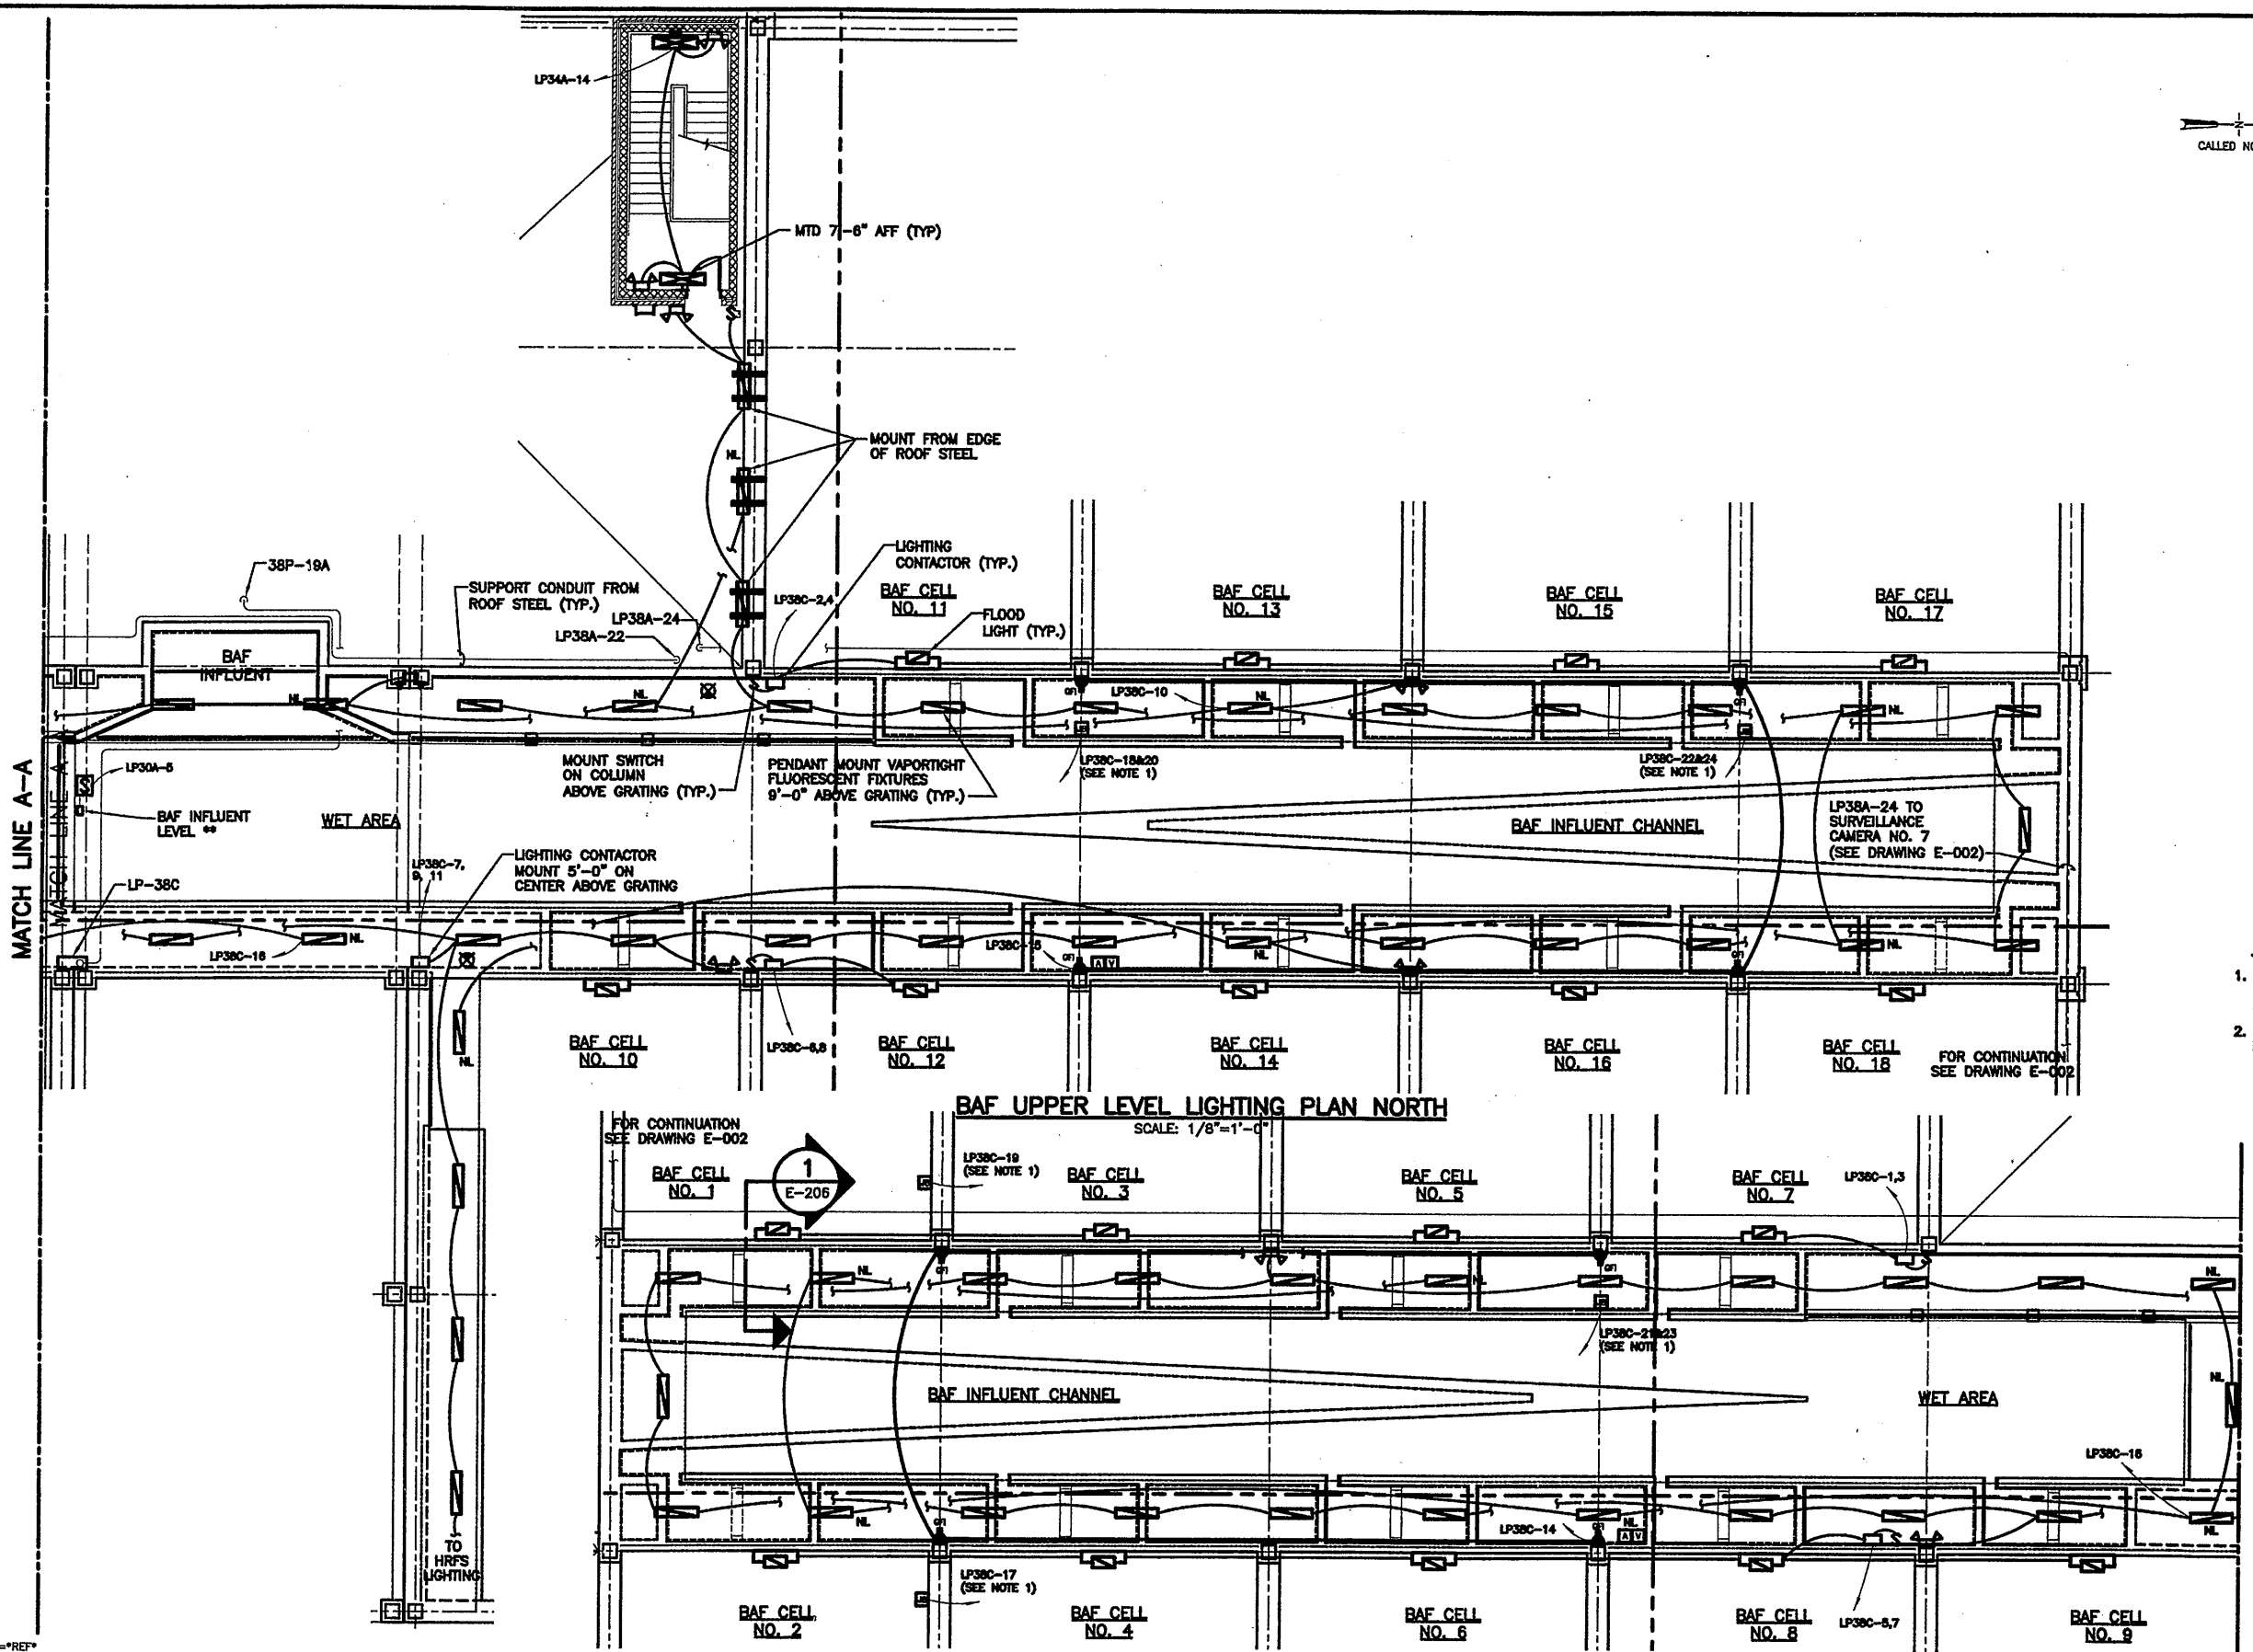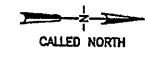

- NOTE:**
- CONTRACTOR SHALL FURNISH AND INSTALL MULTIPLE HEAT TRACE CIRCUITS FOR THE ROOF DRAIN PIPING. COORDINATE LOCATIONS IN FIELD. SEE DRAWING P-203.
 - ** INDICATES AN ITEM OR ITEMS SUPPLIED BY OWNER FOR INSTALLATION BY THE CONTRACTOR.

Layer: ON=*, OFF=**REF*
 X: 0659X203.DWG
 5/30/01 EBL DCC
 05503000/0659E206.DWG

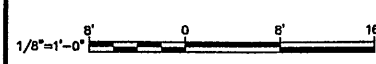


NO ALTERATIONS PERMITTED HEREON EXCEPT AS PROVIDED UNDER SECTION 7209 SUBDIVISION 2 OF THE NEW YORK STATE EDUCATION LAW

| No. | Date | Revisions | Init |
|-----|----------|---------------------|------|
| 0 | 4/20/01 | ISSUED FOR APPROVAL | |
| 1 | | AS BID | |
| 2 | 10/31/05 | RECORD DRAWING | |

In charge of TEL
 Designed by MEE
 Drawn by DCC
 Checked by WFH



ONONDAGA COUNTY • DEPARTMENT OF DRAINAGE AND SANITATION • SYRACUSE, NEW YORK
 METROPOLITAN SYRACUSE WASTEWATER TREATMENT PLANT
 STAGE III AMMONIA AND STAGE II PHOSPHORUS REMOVAL PROJECT
BAF COMPLEX
BAF UPPER LEVEL LIGHTING PLAN

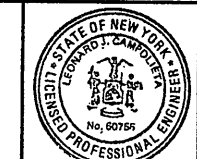


RECORD DRAWING
 THESE DRAWINGS HAVE BEEN REVIEWED TO REFLECT MAJOR CHANGES, IF ANY, WHICH OCCURRED DURING CONSTRUCTION. REVISIONS ARE BASED UPON INFORMATION SUPPLIED BY CONTRACTOR.
 DATED 10/21/05 FOR Campolatt

THIS DRAWING WAS PREPARED AT THE SCALE INDICATED IN THE TITLE BLOCK. INACCURACIES IN THE STATED SCALE MAY BE INTRODUCED WHEN DRAWINGS ARE REPRODUCED BY ANY MEANS. USE THE GRAPHIC SCALE BAR IN THE TITLE BLOCK TO DETERMINE THE ACTUAL SCALE OF THIS DRAWING.


File Number: 00659
 Date: APRIL 2001
 E-206

ELECTRICAL

MCC 30 - BAF ELECTRIC ROOM (BLOWERS)

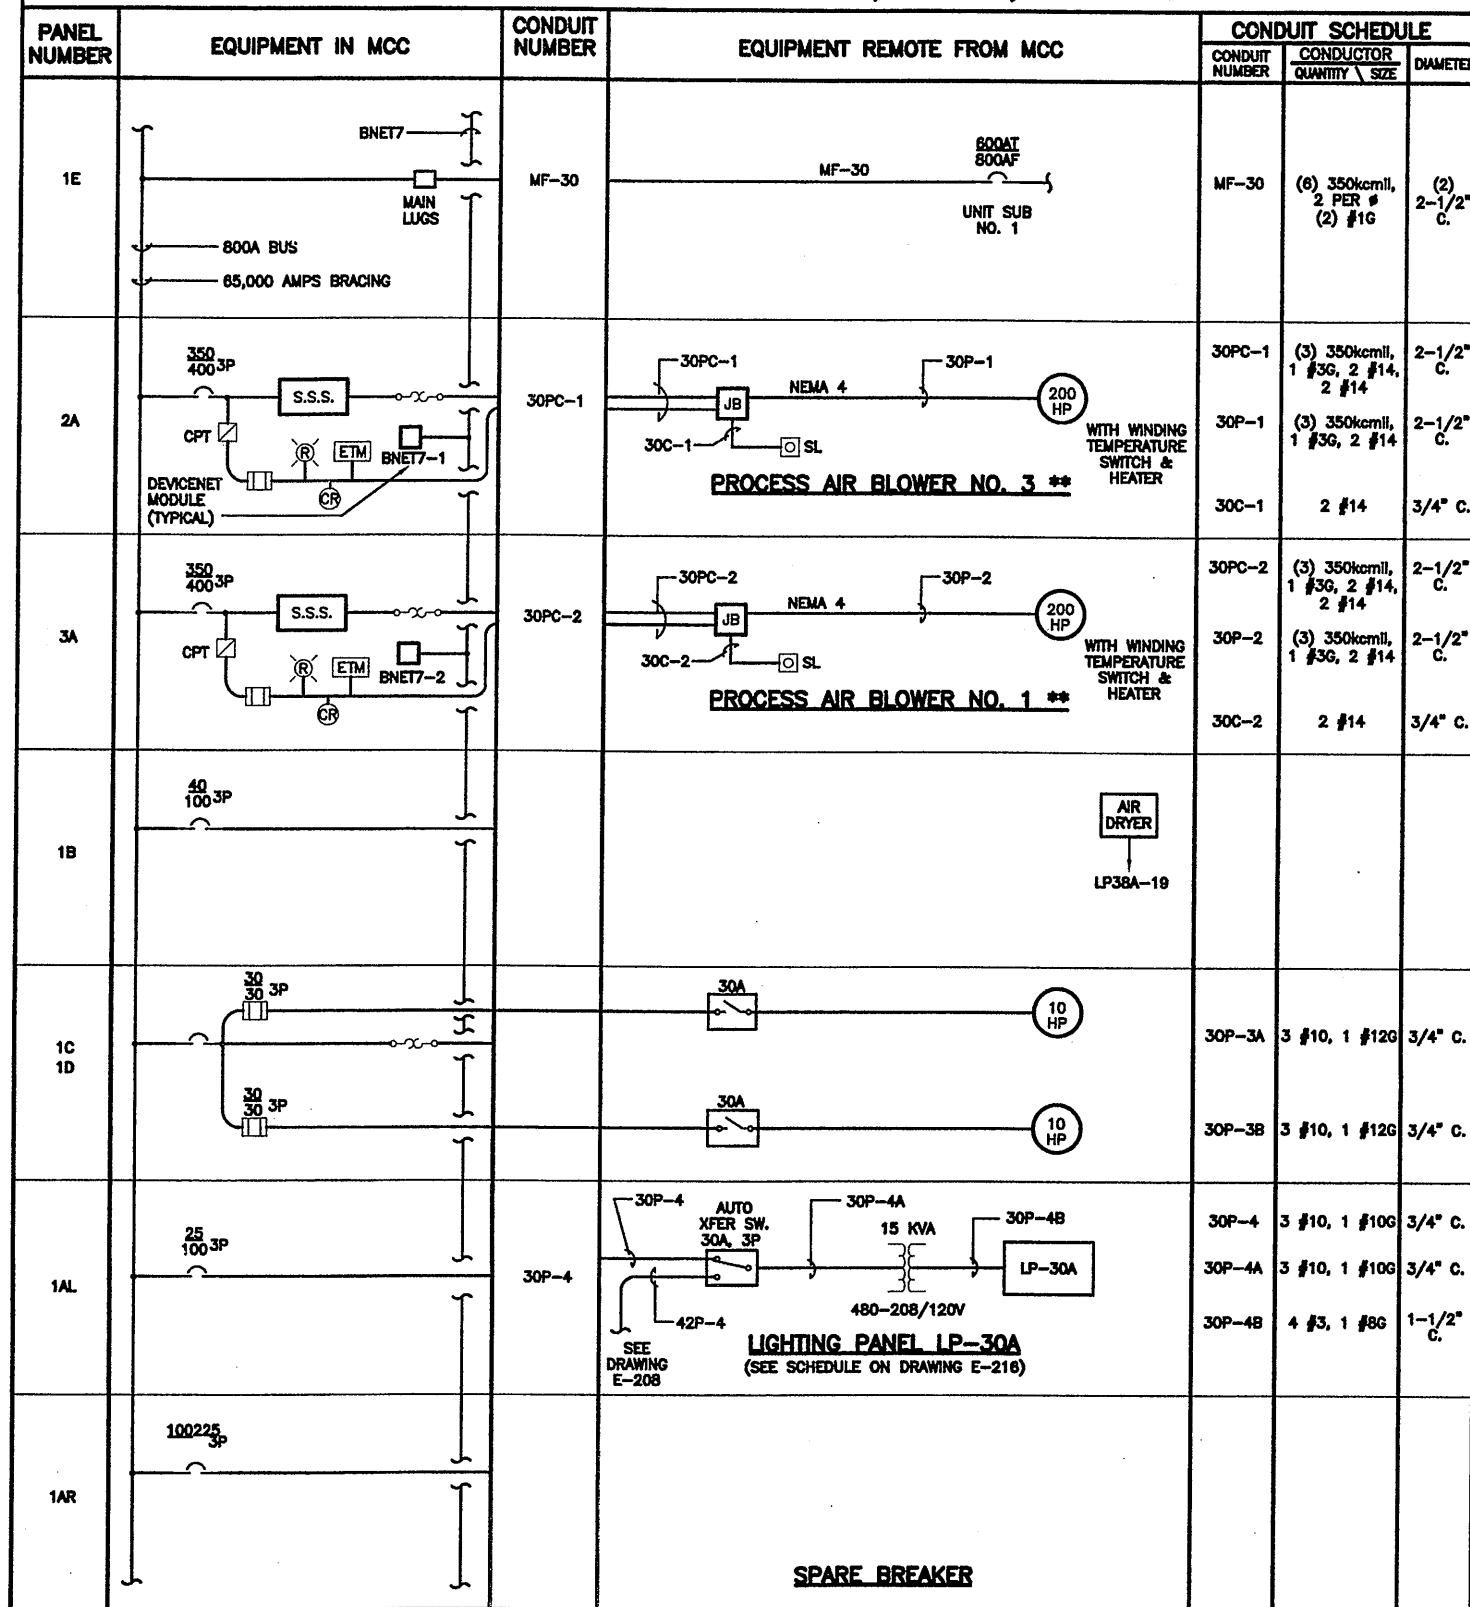


MCC 31 - BAF ELECTRIC ROOM (BLOWERS)

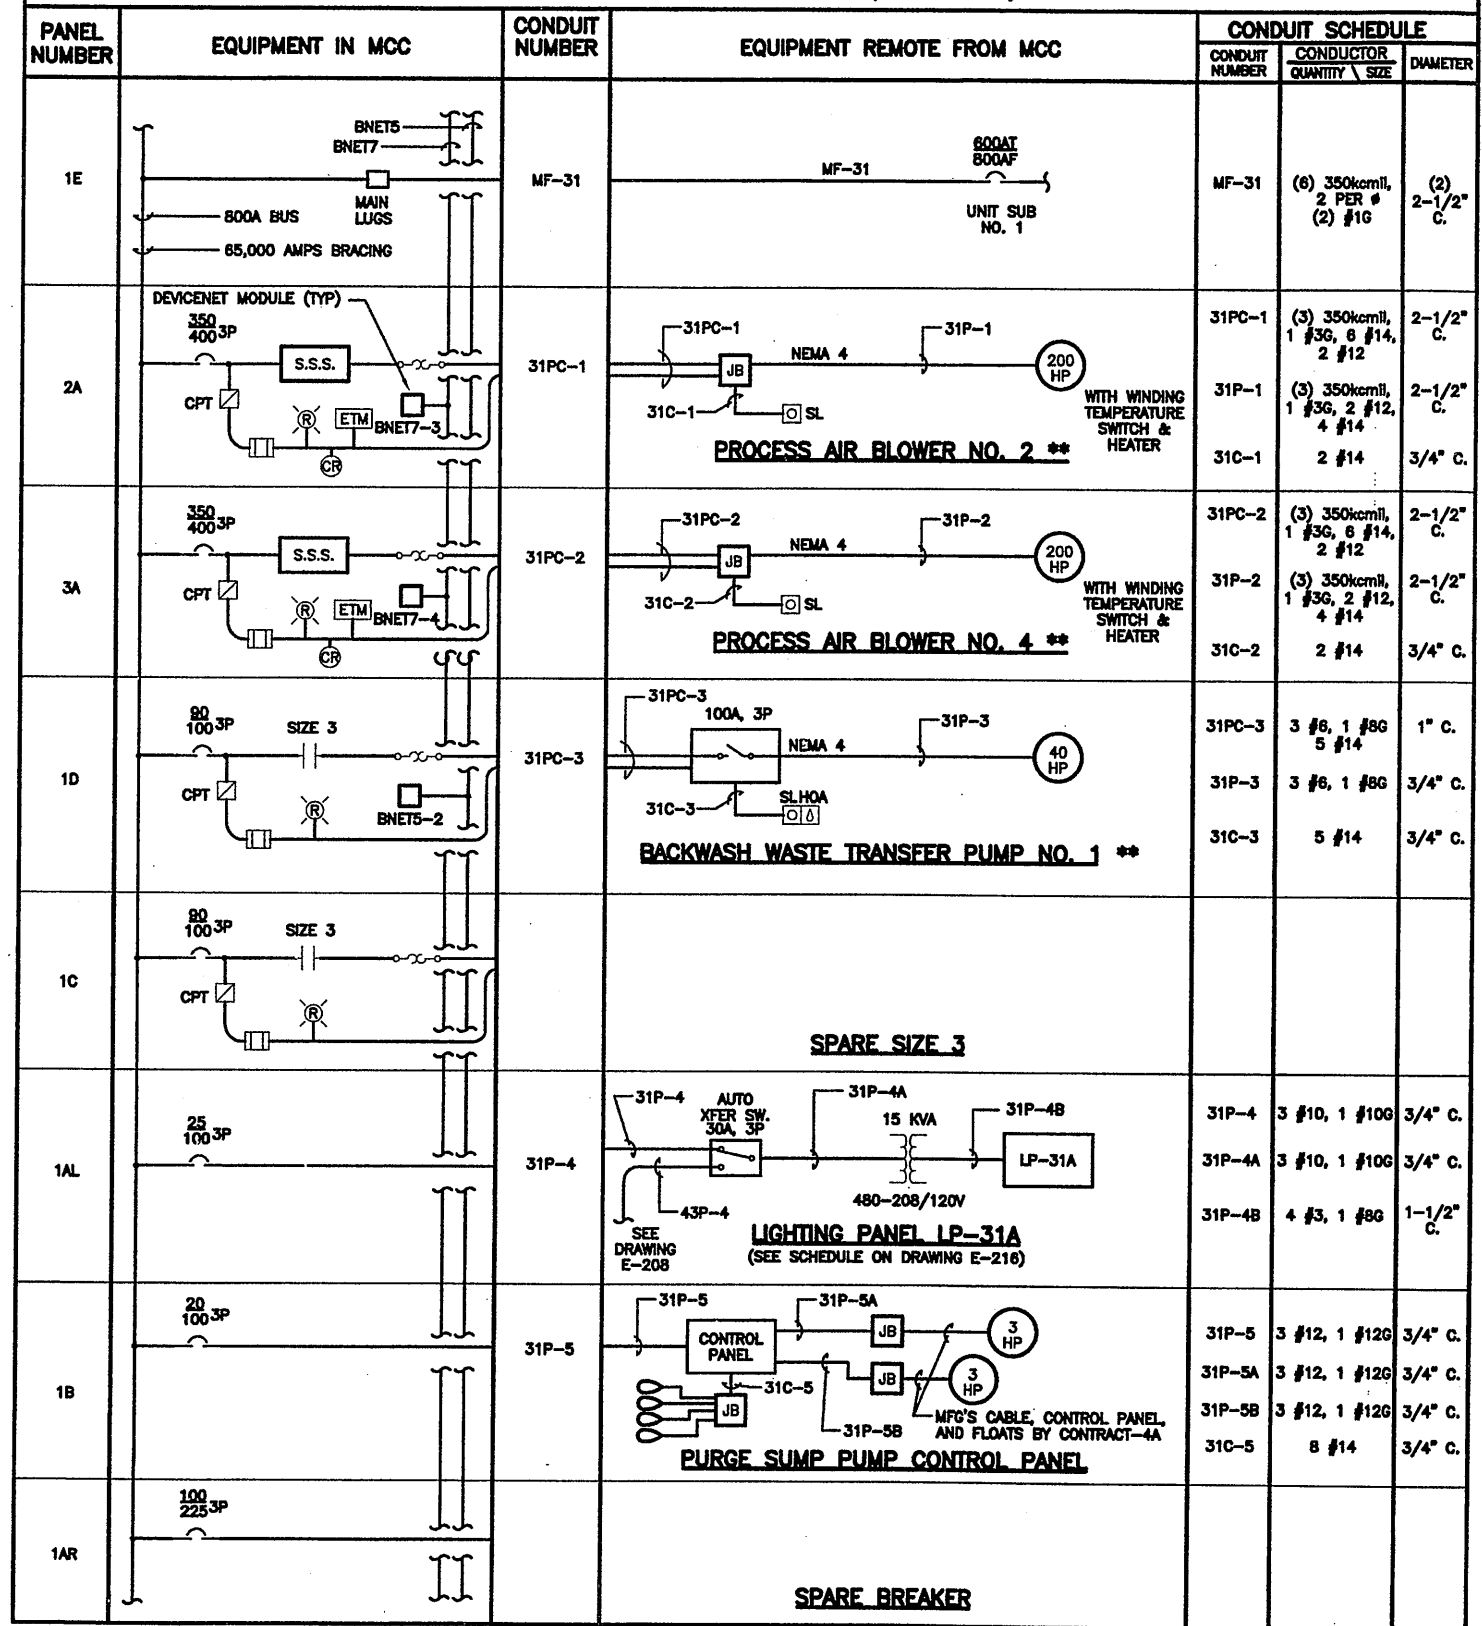

RECORD DRAWING

THESE DRAWINGS HAVE BEEN REVISED TO REFLECT MAJOR CHANGES, IF ANY, WHICH OCCURRED DURING CONSTRUCTION. REVISIONS ARE BASED UPON INFORMATION SUPPLIED BY CONTRACTOR.
DATE: 10/21/05 PER: [Signature]

CONDUIT NUMBER DESCRIPTION

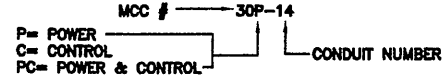

** INDICATES AN ITEM OR ITEMS SUPPLIED BY OWNER FOR INSTALLATION BY THE CONTRACTOR.

THIS DRAWING WAS PREPARED AT THE SCALE INDICATED IN THE TITLE BLOCK. INACCURACIES IN THE STATED SCALE MAY BE INTRODUCED WHEN DRAWINGS ARE REPRODUCED BY ANY MEANS. USE THE GRAPHIC SCALE BAR IN THE TITLE BLOCK TO DETERMINE THE ACTUAL SCALE OF THIS DRAWING.

Layer: ON=*, OFF=*REF*
5/30/01 BBL DCC
05503000/0559E207.DWG

NOT TO SCALE

| No. | Date | Revisions | Init |
|-----|----------|---------------------|-------------|
| 0 | 4/20/01 | ISSUED FOR APPROVAL | [Signature] |
| 1 | | AS BID | |
| 2 | 10/31/05 | RECORD DRAWING | |

In charge of --- TEL ---
Designed by --- AHL ---
Drawn by --- DCC ---
Checked by --- WFH ---




ONONDAGA COUNTY • DEPARTMENT OF DRAINAGE AND SANITATION • SYRACUSE, NEW YORK
METROPOLITAN SYRACUSE WASTEWATER TREATMENT PLANT
STAGE III AMMONIA AND STAGE II PHOSPHORUS REMOVAL PROJECT
BAF COMPLEX
BAF MCC 30 AND 31
ONE-LINE DIAGRAMS
ELECTRICAL


File Number: 00659
Date: APRIL 2001
E-207
[Professional Engineer Seal]

NO ALTERATIONS PERMITTED HEREON EXCEPT AS PROVIDED UNDER SECTION 7209 SUBDIVISION 2 OF THE NEW YORK STATE EDUCATION LAW

MCC 42 - BAF ELECTRIC ROOM (BLOWERS)

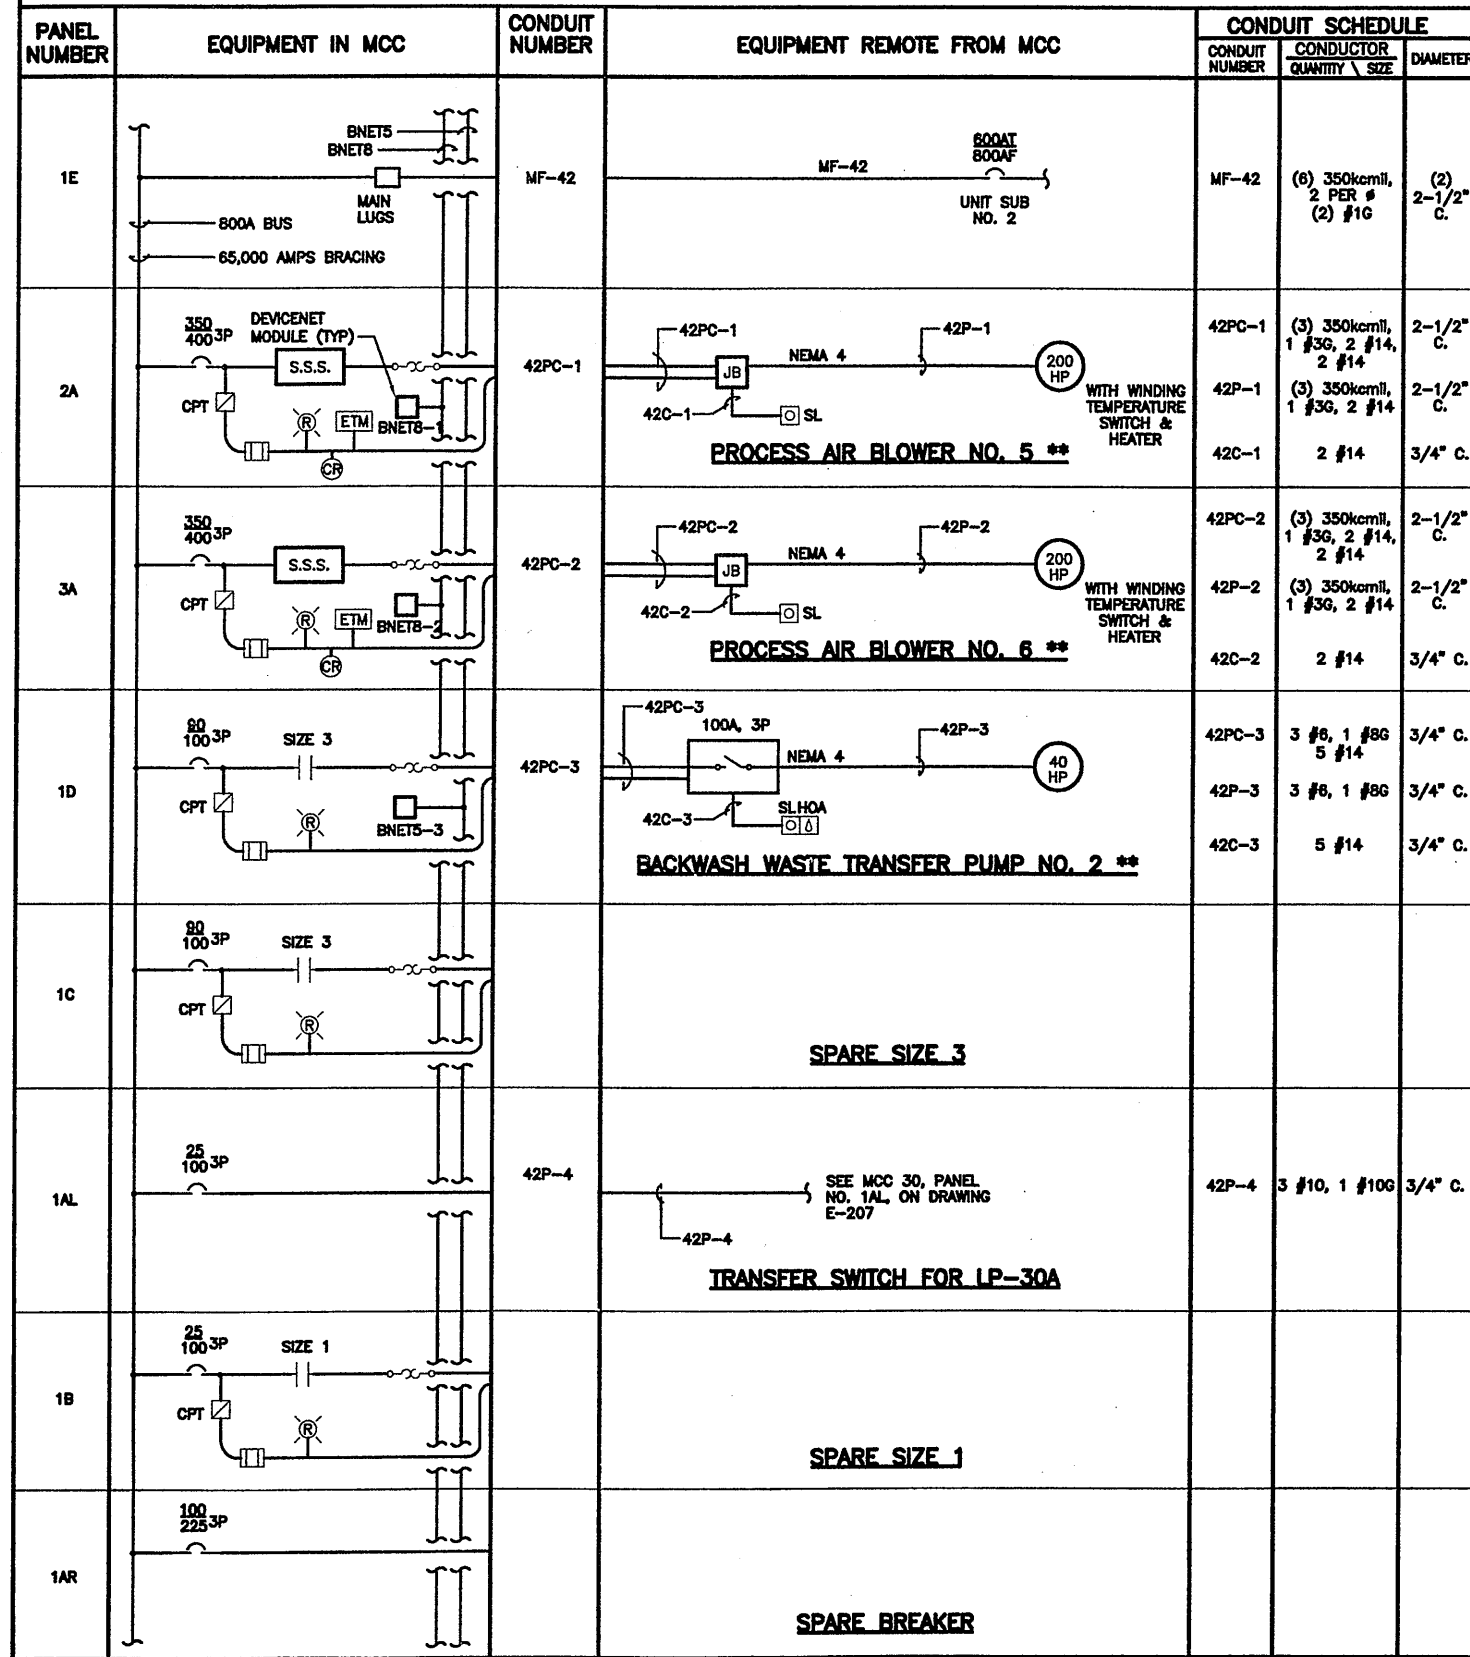

MCC 43 - BAF ELECTRIC ROOM (BLOWERS)

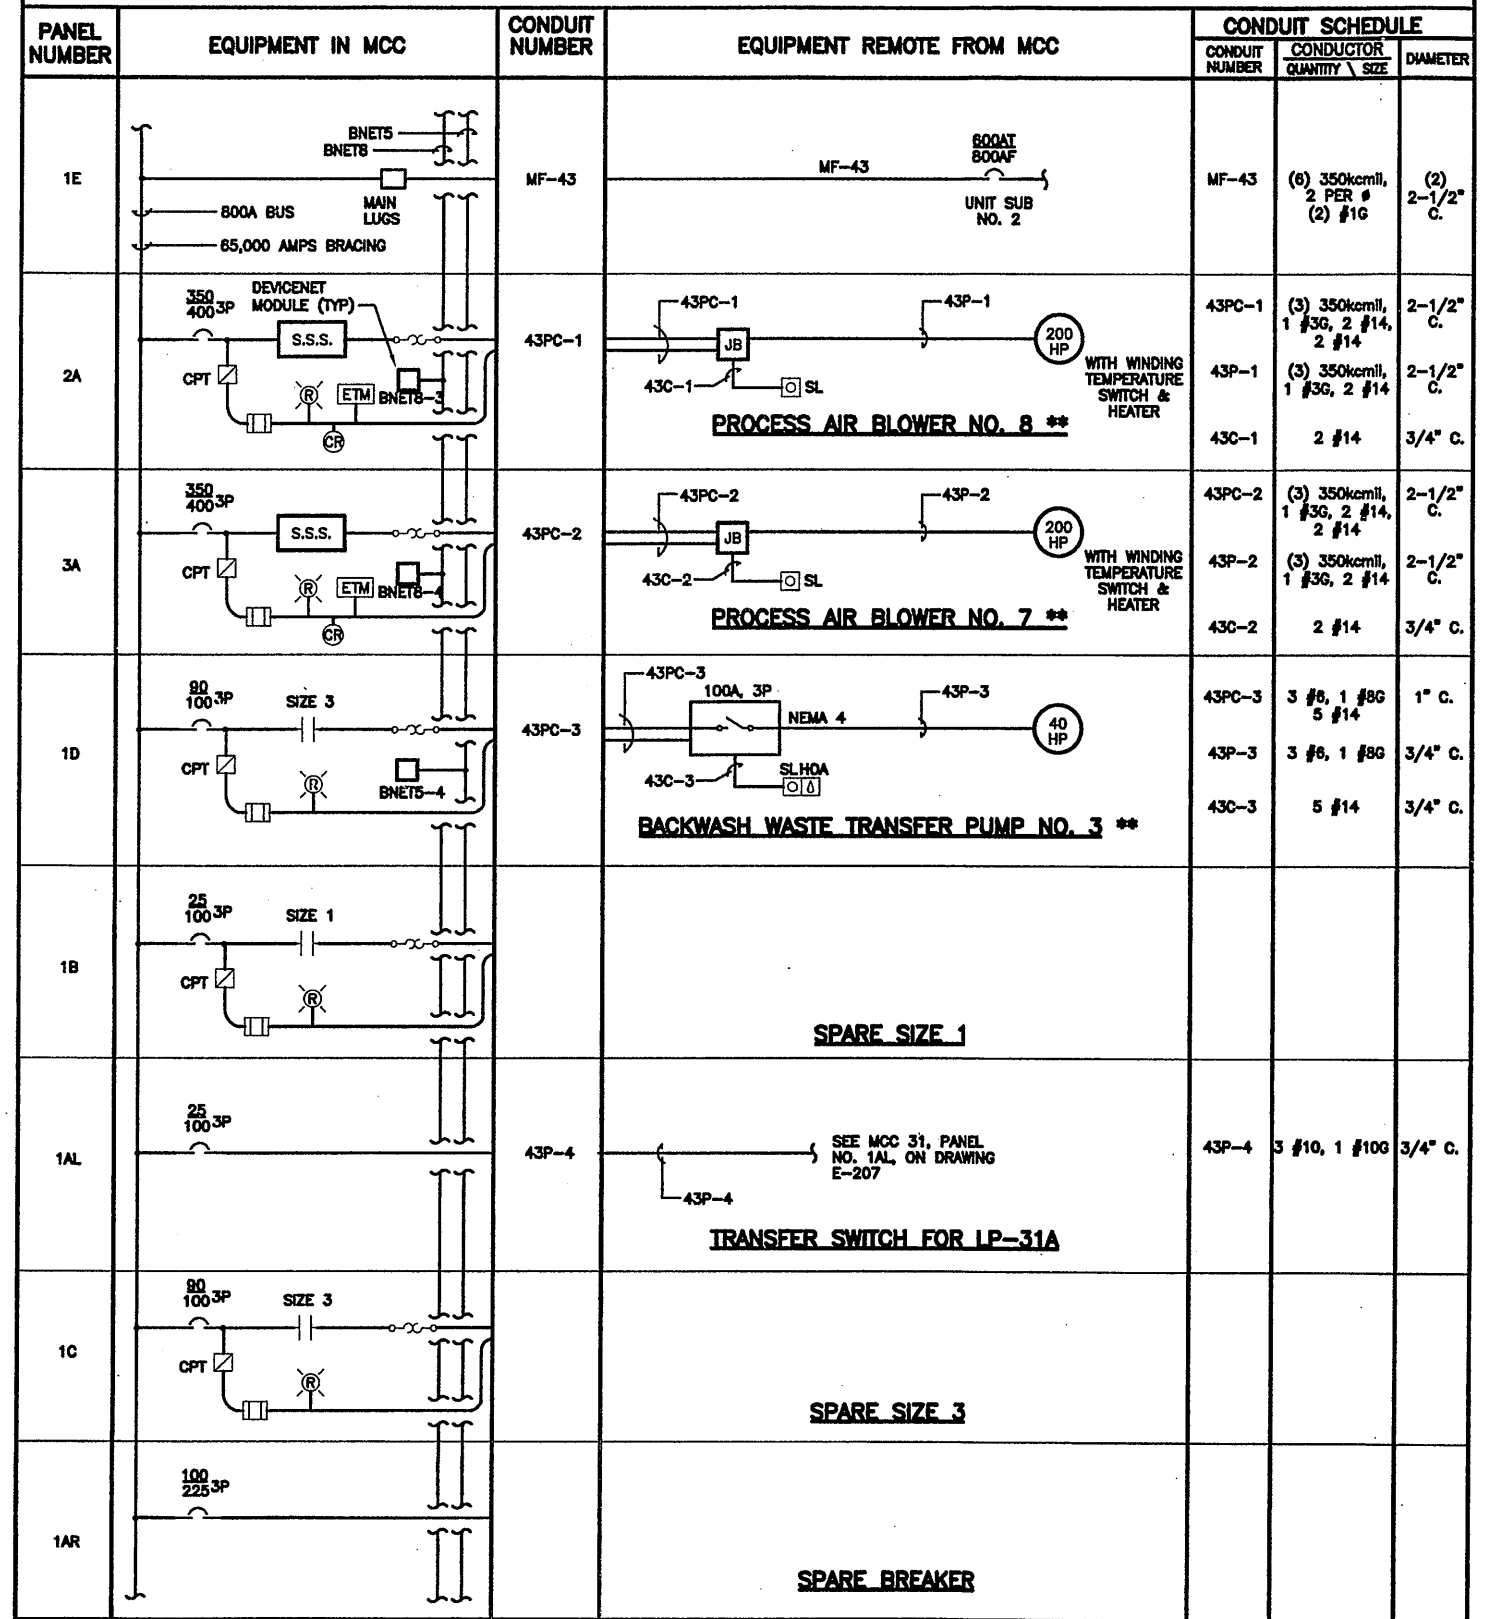

CONDUIT NUMBER DESCRIPTION

MCC # 43P-14
P= POWER
C= CONTROL
PC= POWER & CONTROL

** INDICATES AN ITEM OR ITEMS SUPPLIED BY OWNER FOR INSTALLATION BY THE CONTRACTOR.

RECORD DRAWING

THESE CHANGES HAVE BEEN MADE TO REFLECT THE LATEST CHANGES TO THE DRAWING. ANY CHANGES MADE DURING CONSTRUCTION SHOULD BE BASED UPON INFORMATION SUPPLIED BY CONTRACTOR.

THIS DRAWING WAS PREPARED AT THE SCALE INDICATED IN THE TITLE BLOCK. INACCURACIES IN THE STATED SCALE MAY BE INTRODUCED WHEN DRAWINGS ARE REPRODUCED BY ANY MEANS. USE THE GRAPHIC SCALE BAR IN THE TITLE BLOCK TO DETERMINE THE ACTUAL SCALE OF THIS DRAWING.

Layer: ON=*, OFF=REP*
5/30/01 BBL DCC
0550300/0659E208.DWG

NOT TO SCALE

| No. | Date | Revisions | Init |
|-----|----------|---------------------|------|
| 0 | 4/20/01 | ISSUED FOR APPROVAL | TEL |
| 1 | | AS BID | AH |
| 2 | 10/31/05 | RECORD DRAWING | DCC |

In charge of TEL
Designed by AHL
Drawn by DCC
Checked by WFH

ENVIRONMENTAL ENGINEERING ASSOCIATES, LLP
SYRACUSE, NEW YORK

ONONDAGA COUNTY • DEPARTMENT OF DRAINAGE AND SANITATION • SYRACUSE, NEW YORK
METROPOLITAN SYRACUSE WASTEWATER TREATMENT PLANT
STAGE III AMMONIA AND STAGE II PHOSPHORUS REMOVAL PROJECT
BAF COMPLEX
BAF MCC 42 AND 43
ONE-LINE DIAGRAMS
ELECTRICAL





File Number
00659
Date
APRIL 2001

E-208

MCC 34 - BAF ELECTRIC ROOM (HVAC SYSTEM)

MCC 34 - BAF ELECTRIC ROOM (HVAC SYSTEM CONTINUED)

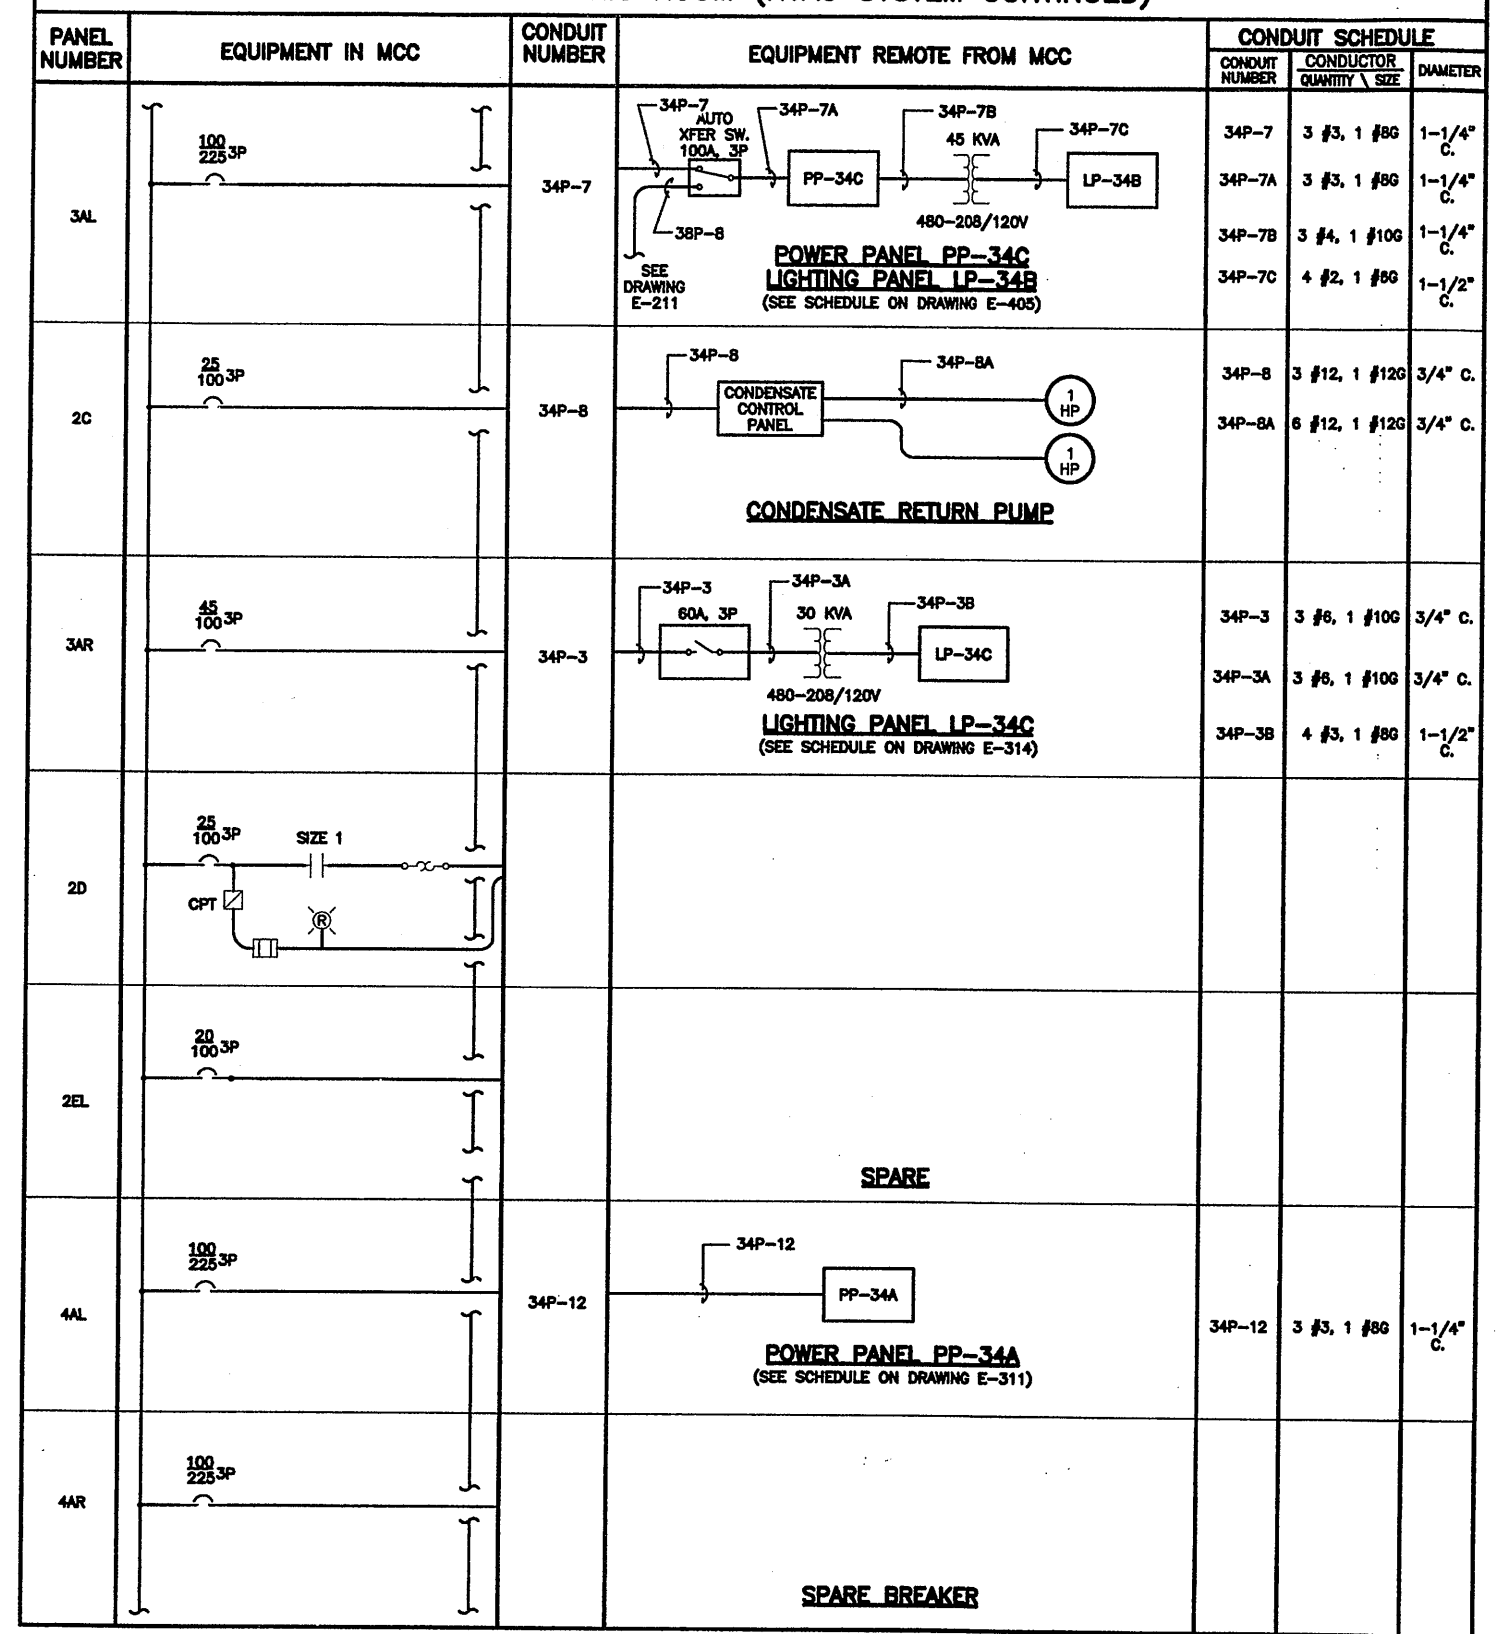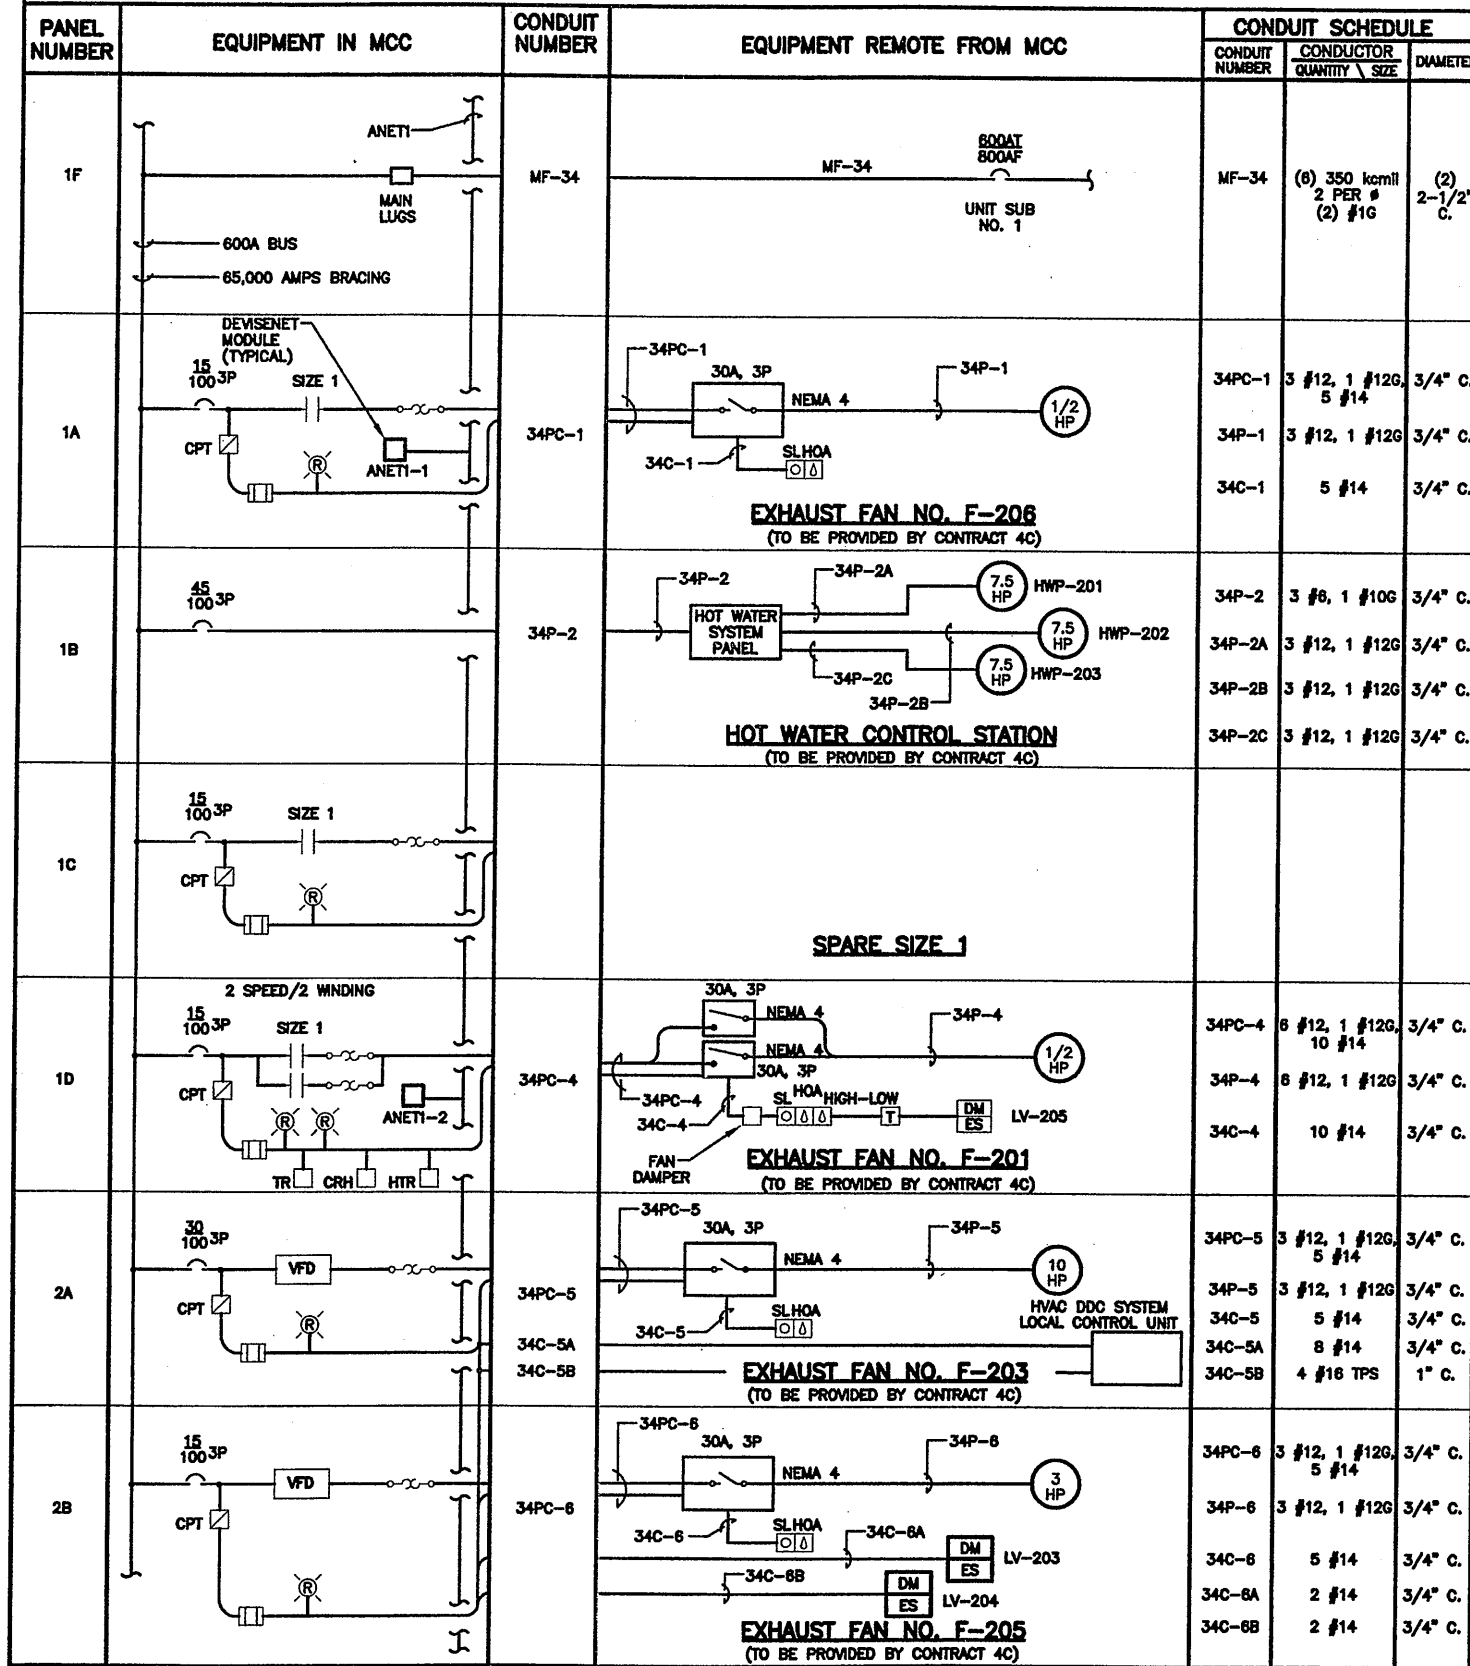

CONDUIT NUMBER DESCRIPTION

MCC # 34P-14
 P= POWER
 C= CONTROL
 PC= POWER & CONTROL

RECORD DRAWING

THESE DRAWINGS HAVE BEEN REVIEWED TO REFLECT SUCH CHANGES AS OCCURRED DURING CONSTRUCTION. REVISIONS ARE BASED UPON INFORMATION SUPPLIED BY CONTRACTOR.
 DATE: 10/21/05
 PER: [Signature]

THIS DRAWING WAS PREPARED AT THE SCALE INDICATED IN THE TITLE BLOCK. INACCURACIES IN THE STATED SCALE MAY BE INTRODUCED WHEN DRAWINGS ARE REPRODUCED BY ANY MEANS. USE THE GRAPHIC SCALE BAR IN THE TITLE BLOCK TO DETERMINE THE ACTUAL SCALE OF THIS DRAWING.

Layer: ON=*, OFF=*REF*
 5/30/01 BBL DCC
 05503000/0859E209.DWG

NOT TO SCALE

| No. | Date | Revisions | Init |
|-----|----------|---------------------|-------------|
| 0 | 4/20/01 | ISSUED FOR APPROVAL | [Signature] |
| 1 | | AS BID | |
| 2 | 10/31/05 | RECORD DRAWING | |

In charge of --- TEL ---
 Designed by --- AHL ---
 Drawn by --- DCC ---
 Checked by --- WFH ---



ONONDAGA COUNTY • DEPARTMENT OF DRAINAGE AND SANITATION • SYRACUSE, NEW YORK
 METROPOLITAN SYRACUSE WASTEWATER TREATMENT PLANT
 STAGE III AMMONIA AND STAGE II PHOSPHORUS REMOVAL PROJECT
 BAF COMPLEX
 BAF MCC 34
 ONE-LINE DIAGRAM
 ELECTRICAL





File Number 00659
 Date APRIL 2001
 [Signature]
E-209

NO ALTERATIONS PERMITTED HEREON EXCEPT AS PROVIDED UNDER SECTION 7209 SUBDIVISION 2 OF THE NEW YORK STATE EDUCATION LAW

MCC 34 - BAF ELECTRIC ROOM (HVAC SYSTEM CONTINUED)

MCC 34 - BAF ELECTRIC ROOM (HVAC SYSTEM CONTINUED)

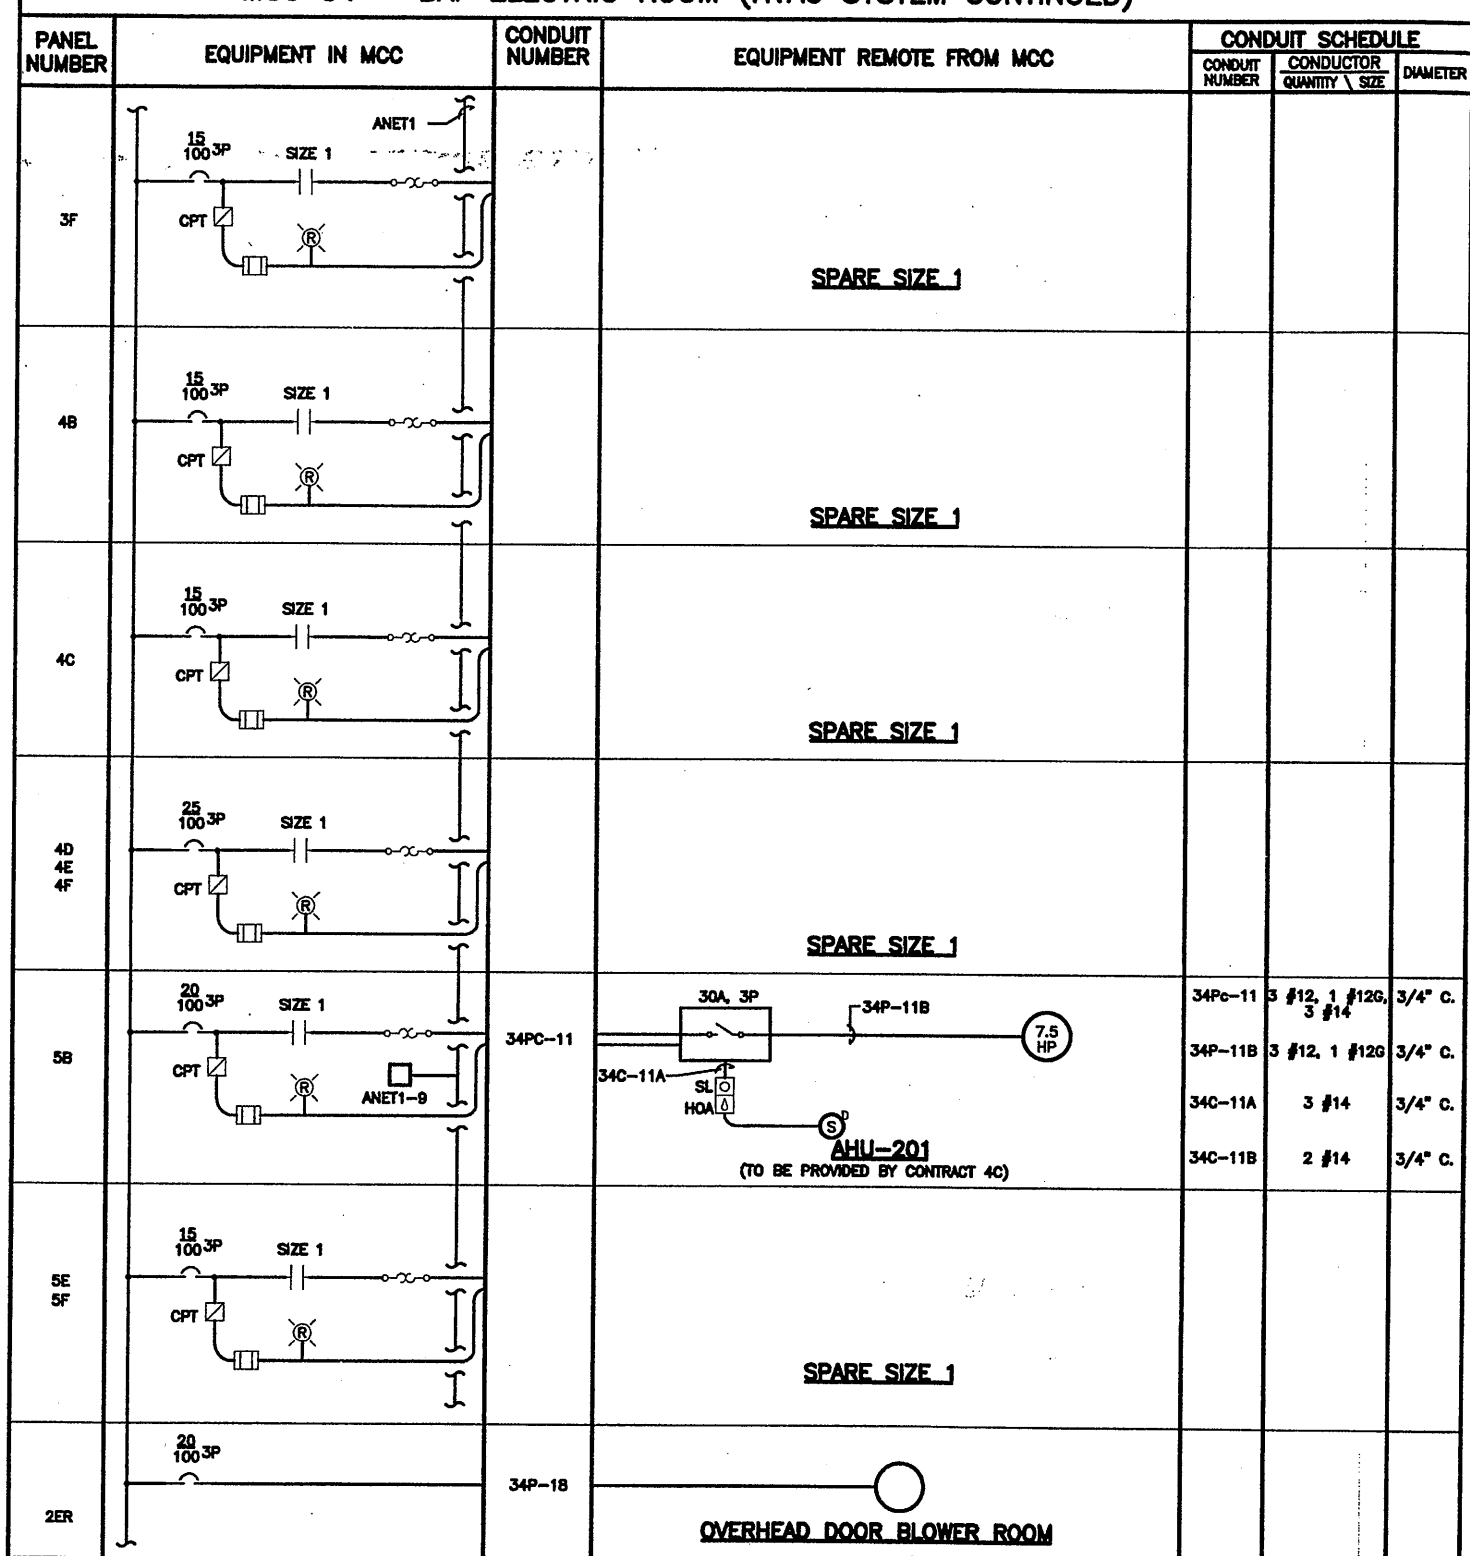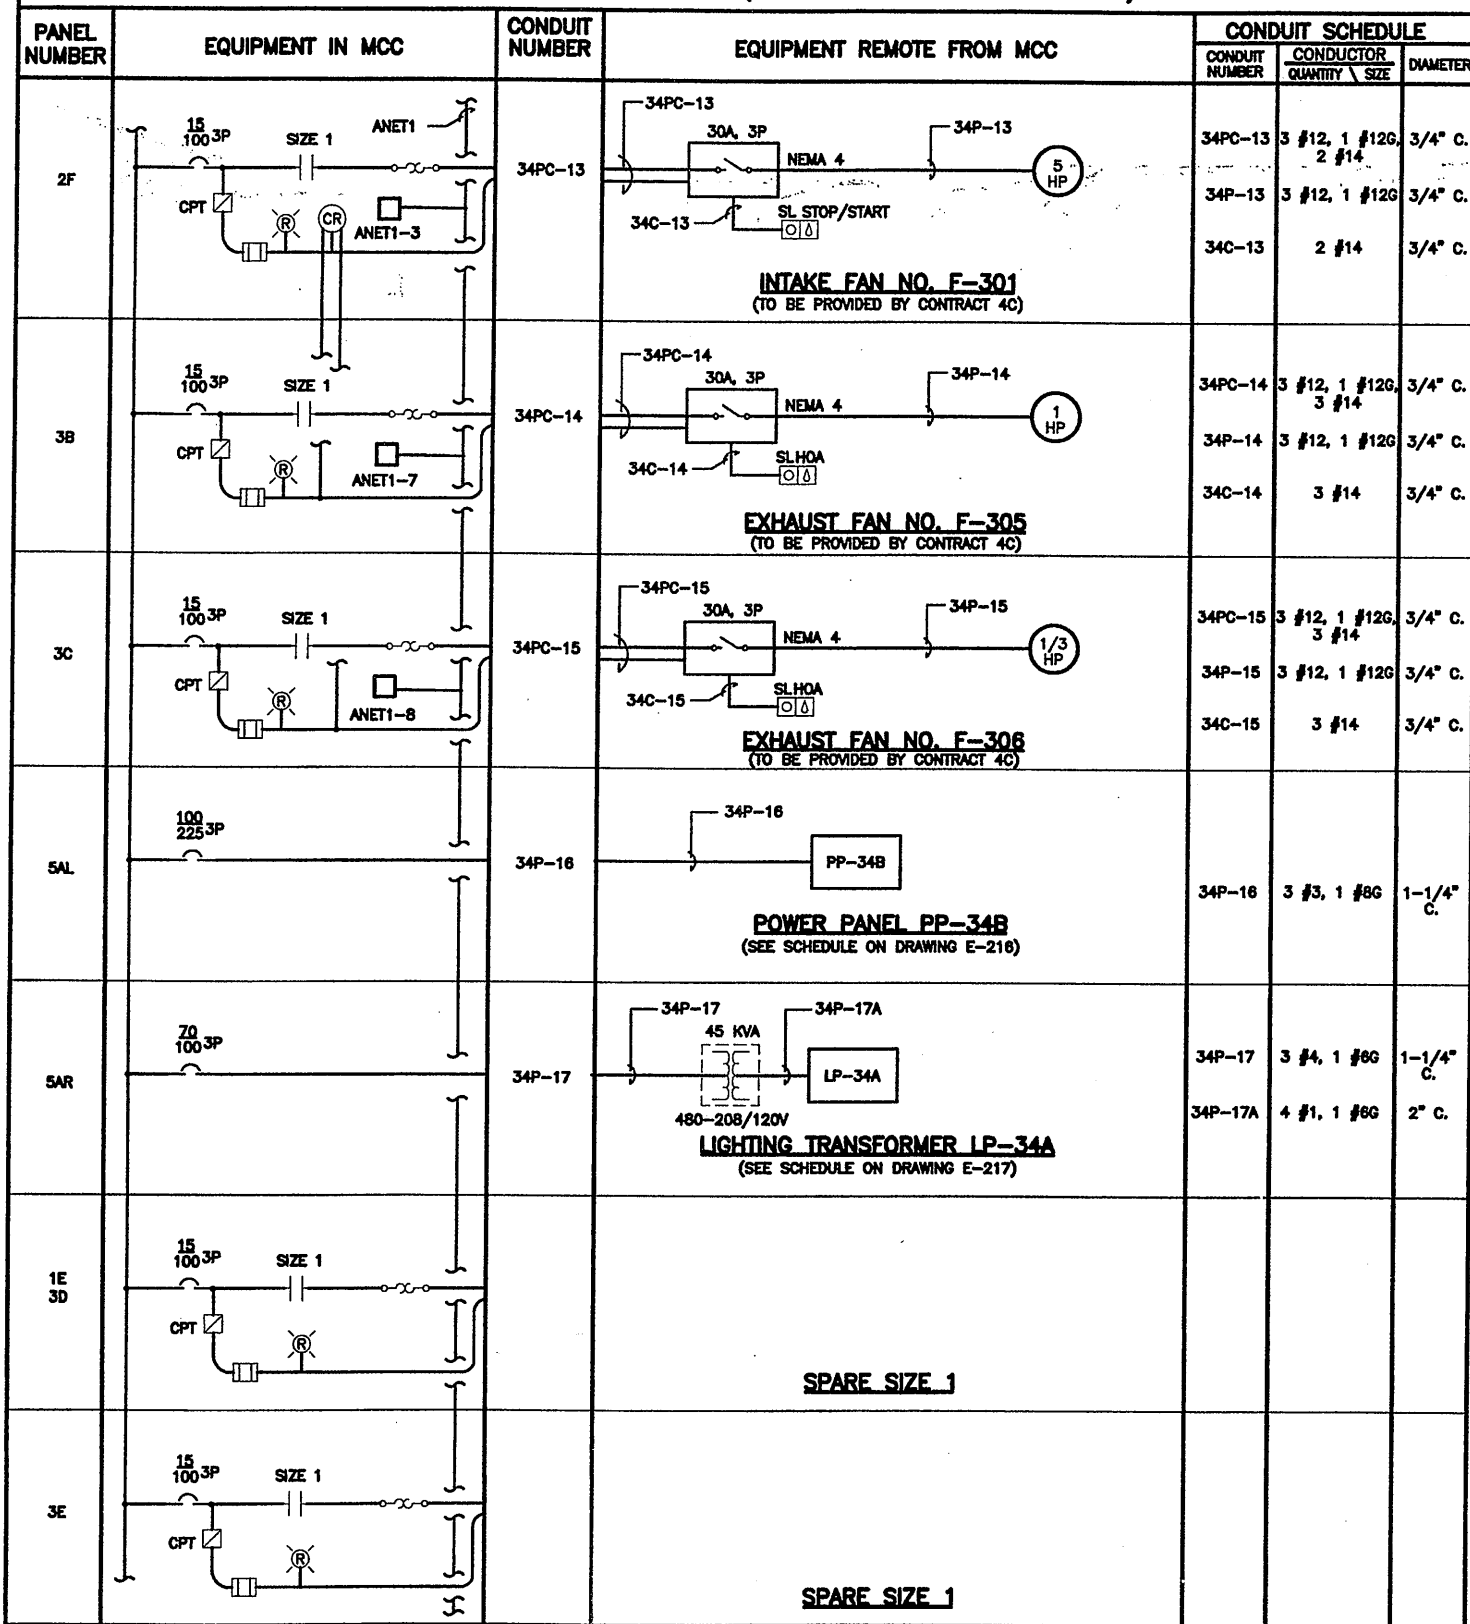

CONDUIT NUMBER DESCRIPTION
MCC # 34P-14

P= POWER
C= CONTROL
PC= POWER & CONTROL

RECORD DRAWING

THESE CHANGES HAVE BEEN MADE TO REFLECT THE CHANGES, IF ANY, WHICH OCCURRED DURING CONSTRUCTION. REVISED AND ISSUED UPON INFORMATION SUPPLIED BY CONTRACTOR.

DATE: 10/10/05 PER: [Signature]

THIS DRAWING WAS PREPARED AT THE SCALE INDICATED IN THE TITLE BLOCK. INACCURACIES IN THE STATED SCALE MAY BE INTRODUCED WHEN DRAWINGS ARE REPRODUCED BY ANY MEANS. USE THE GRAPHIC SCALE BAR IN THE TITLE BLOCK TO DETERMINE THE ACTUAL SCALE OF THIS DRAWING.

Layer: ON="1", OFF="REF"
5/30/01 BBL DCC
05503000/0659E210.DWG

NOT TO SCALE

NO ALTERATIONS PERMITTED HEREON EXCEPT AS PROVIDED UNDER SECTION 7209 SUBDIVISION 2 OF THE NEW YORK STATE EDUCATION LAW

| No. | Date | Revisions | Init |
|-----|----------|---------------------|------|
| 0 | 4/20/01 | ISSUED FOR APPROVAL | LJC |
| 1 | | AS BID | |
| 2 | 10/31/05 | RECORD DRAWING | |

In charge of TEL
Designed by AHL
Drawn by DCC
Checked by WFH

ENVIRONMENTAL ENGINEERING ASSOCIATES, LLP
SYRACUSE, NEW YORK



ONONDAGA COUNTY • DEPARTMENT OF DRAINAGE AND SANITATION • SYRACUSE, NEW YORK
METROPOLITAN SYRACUSE WASTEWATER TREATMENT PLANT
STAGE III AMMONIA AND STAGE II PHOSPHORUS REMOVAL PROJECT
BAF COMPLEX
BAF MCC 34
ONE-LINE DIAGRAM (CONTINUED)
ELECTRICAL



File Number 00659
Date APRIL 2001
E-210

MCC 38 - BAF ELECTRIC ROOM (HVAC SYSTEM)


MCC 38 - BAF ELECTRIC ROOM (HVAC SYSTEM CONTINUED)

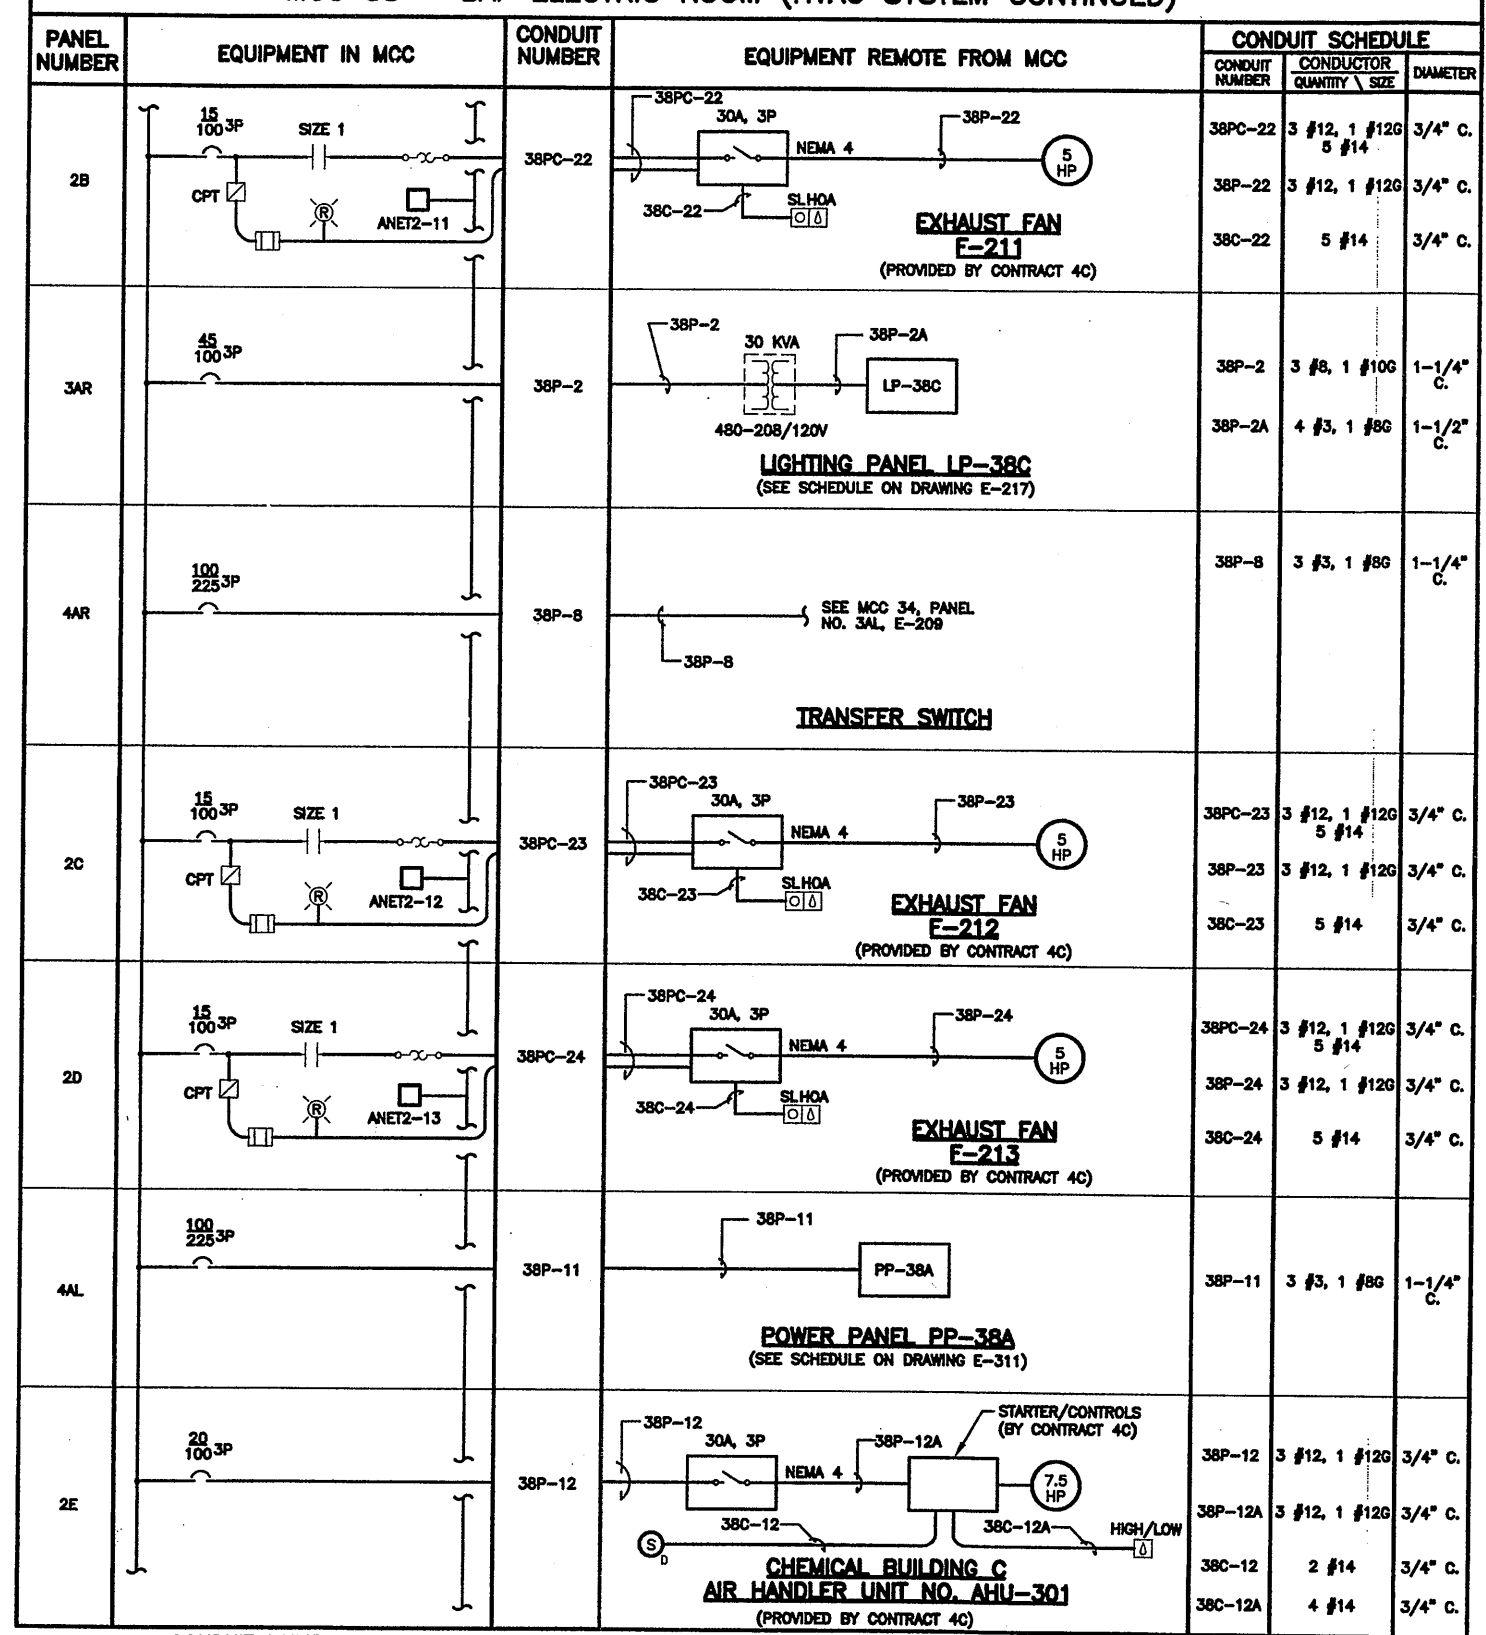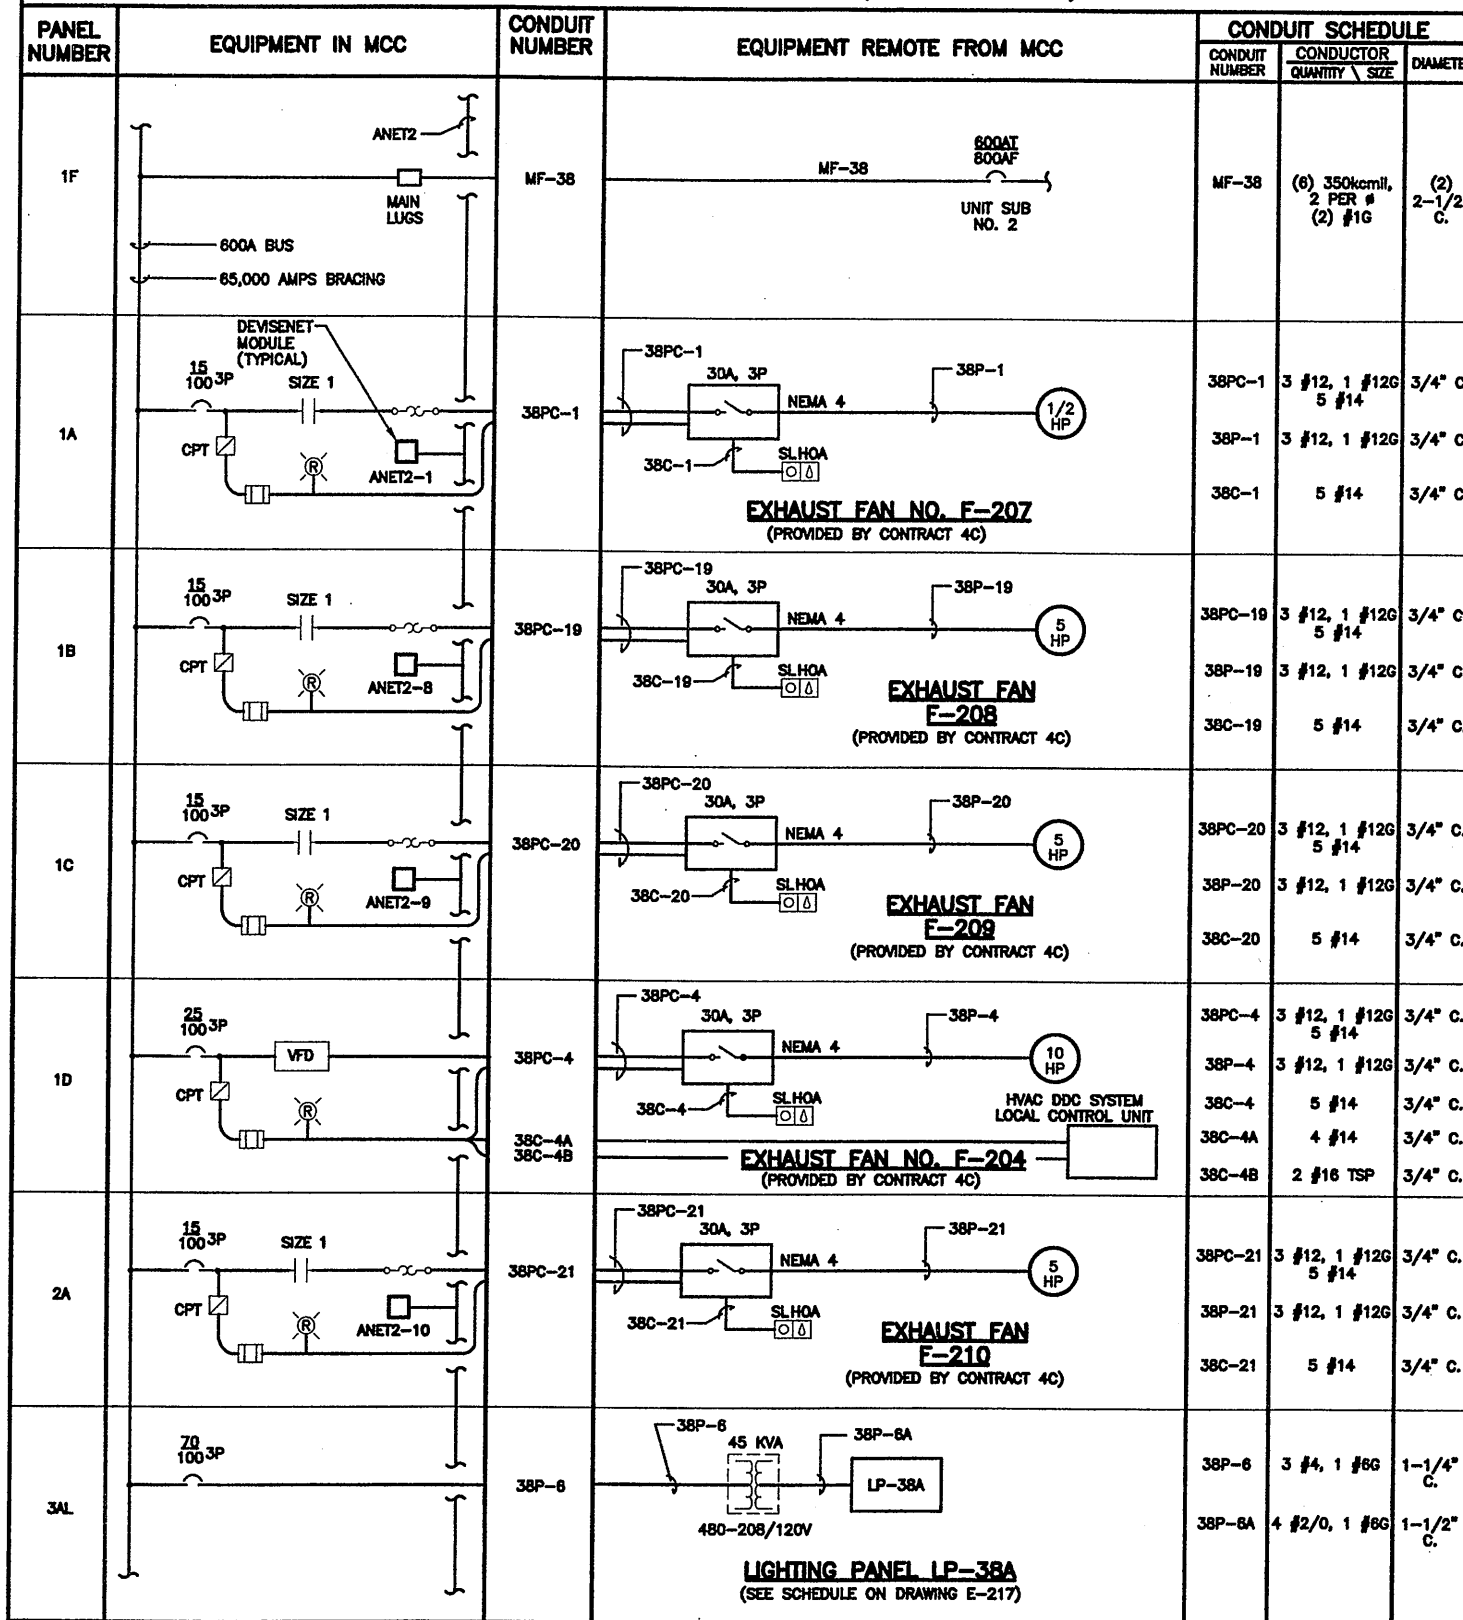

Layer: ON=*, OFF=REF*

5/30/01 BBL DCC
05503000/0659E211.DWG

CONDUIT NUMBER DESCRIPTION

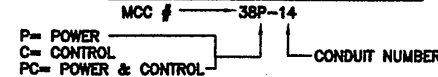

RECORD DRAWING

THESE DRAWINGS HAVE BEEN REVISIONED TO REFLECT
MAJOR CHANGES OF DATA WHICH OCCURRED DURING
CONSTRUCTION, INCLUDING ANY CHANGES UPON
INFORMATION SUPPLIED BY CONTRACTOR.

DATE: 10/16/05 PER: [Signature]

THIS DRAWING WAS PREPARED AT THE SCALE INDICATED IN THE
TITLE BLOCK. INACCURACIES IN THE STATED SCALE MAY BE
INTRODUCED WHEN DRAWINGS ARE REPRODUCED BY ANY MEANS.
USE THE GRAPHIC SCALE BAR IN THE TITLE BLOCK TO
DETERMINE THE ACTUAL SCALE OF THIS DRAWING.

NOT TO SCALE


| No. | Date | Revisions | Init |
|-----|----------|---------------------|------|
| 0 | 4/20/01 | ISSUED FOR APPROVAL | LP |
| 1 | | AS BID | |
| 2 | 10/31/05 | RECORD DRAWING | |

In charge of TEL
Designed by AHL
Drawn by DCC
Checked by WFH

ENVIRONMENTAL ENGINEERING ASSOCIATES, LLP
SYRACUSE, NEW YORK

ONONDAGA COUNTY • DEPARTMENT OF DRAINAGE AND SANITATION • SYRACUSE, NEW YORK
METROPOLITAN SYRACUSE WASTEWATER TREATMENT PLANT
STAGE III AMMONIA AND STAGE II PHOSPHORUS REMOVAL PROJECT

BAF COMPLEX
BAF MCC 38
ONE-LINE DIAGRAM
ELECTRICAL


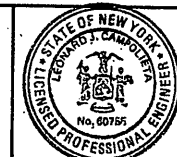


File Number
00659
Date
APRIL 2001
E-211

NO ALTERATIONS PERMITTED HEREON EXCEPT
AS PROVIDED UNDER SECTION 7209 SUBDIVISION
2 OF THE NEW YORK STATE EDUCATION LAW

MCC - 38 BAF ELECTRIC ROOM (HVAC SYSTEM CONTINUED)

MCC - 38 BAF ELECTRIC ROOM (HVAC SYSTEM CONTINUED)

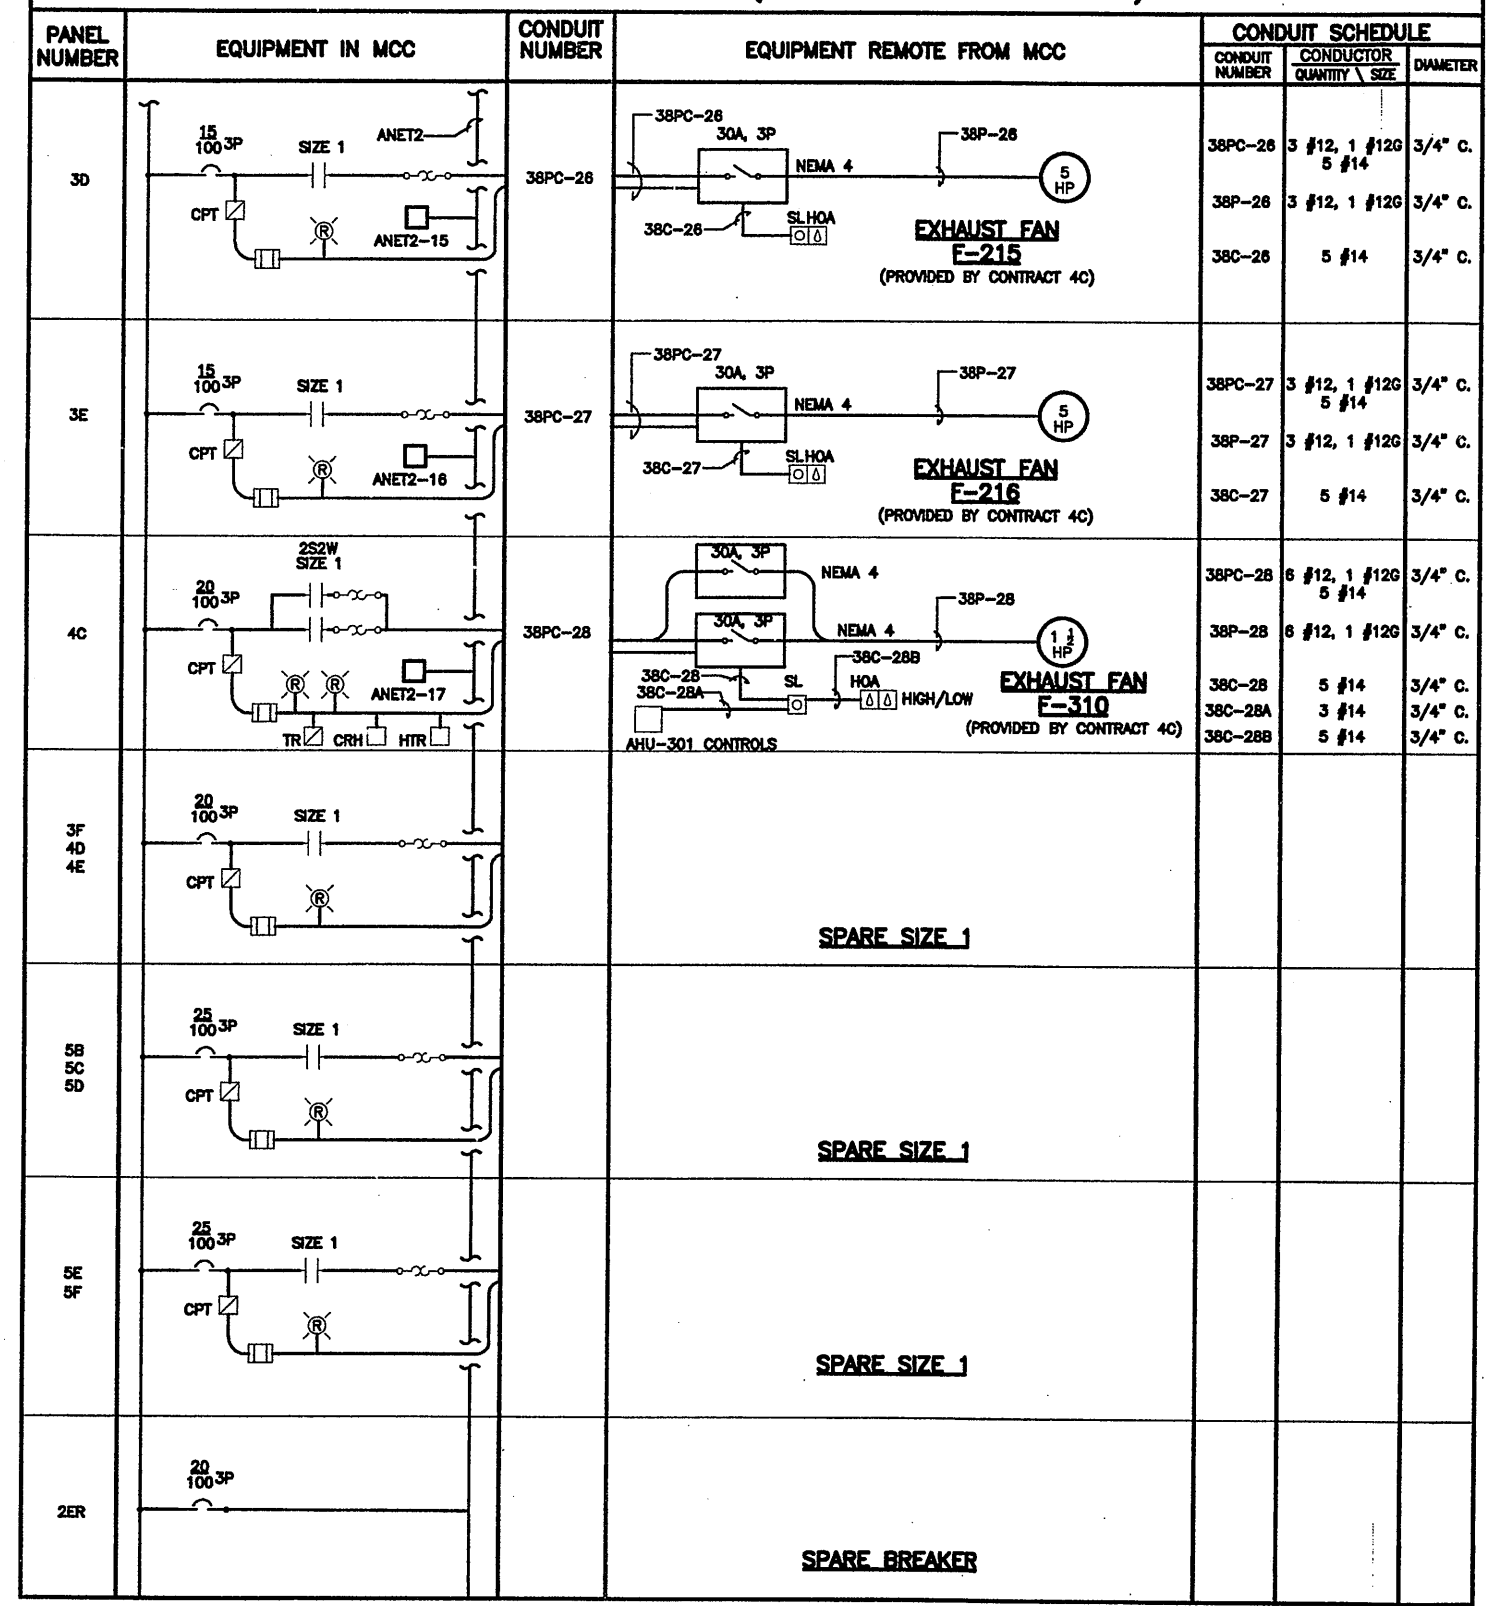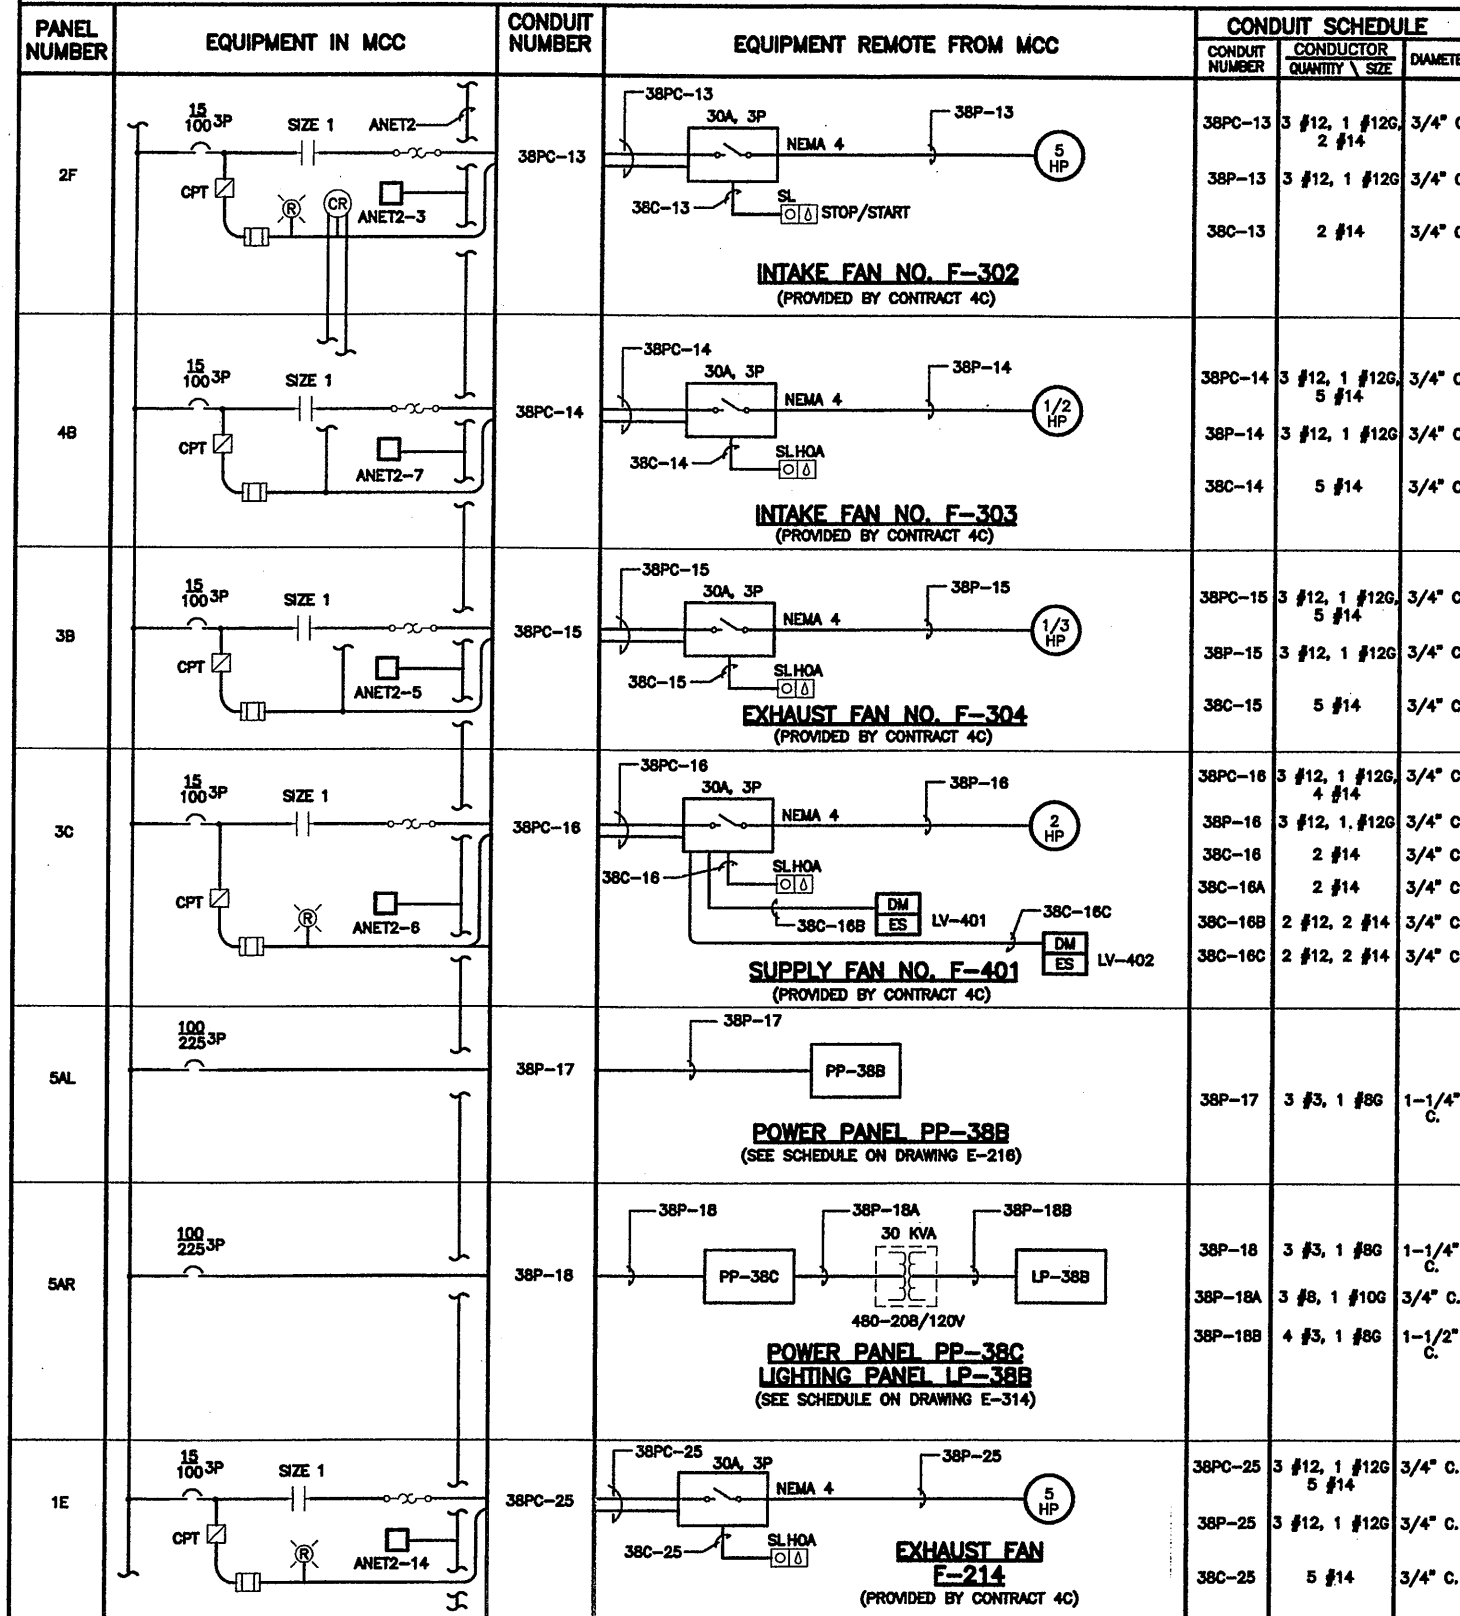

CONDUIT NUMBER DESCRIPTION
MCC # 34P-14

P= POWER
C= CONTROL
PC= POWER & CONTROL

RECORD DRAWING

THESE DRAWINGS HAVE BEEN REVISIONED TO REFLECT
MAJOR CHANGES, IF ANY, WHICH OCCURRED DURING
CONSTRUCTION. REVISIONS ARE BASED UPON
INFORMATION SUPPLIED BY CONTRACTOR.
DATE: 10/2/05 PER: [Signature]

THIS DRAWING WAS PREPARED AT THE SCALE INDICATED IN THE
TITLE BLOCK. INACCURACIES IN THE STATED SCALE MAY BE
INTRODUCED WHEN DRAWINGS ARE REPRODUCED BY ANY MEANS.
USE THE GRAPHIC SCALE BAR IN THE TITLE BLOCK TO
DETERMINE THE ACTUAL SCALE OF THIS DRAWING.

Layer: ON=*, OFF=*REF*

4/3/01 BBL DCC
05503000/0559E212.DWG

| No. | Date | Revisions | Init |
|-----|----------|---------------------|------|
| 0 | 4/20/01 | ISSUED FOR APPROVAL | LJC |
| 1 | | AS BID | |
| 2 | 10/31/05 | RECORD DRAWING | |

NOT TO SCALE

NO ALTERATIONS PERMITTED HEREON EXCEPT AS PROVIDED UNDER SECTION 7209 SUBDIVISION 2 OF THE NEW YORK STATE EDUCATION LAW


In charge of TEL
Designed by AHL
Drawn by DCC
Checked by WFH

ENVIRONMENTAL ENGINEERING ASSOCIATES, LLP
SYRACUSE, NEW YORK


ONONDAGA COUNTY • DEPARTMENT OF DRAINAGE AND SANITATION • SYRACUSE, NEW YORK
METROPOLITAN SYRACUSE WASTEWATER TREATMENT PLANT
STAGE III AMMONIA AND STAGE II PHOSPHORUS REMOVAL PROJECT
BAF COMPLEX
BAF MCC 38
ONE-LINE DIAGRAM (CONTINUED)
ELECTRICAL




File Number
00659
Date
APRIL 2001
E-212
[Signature]

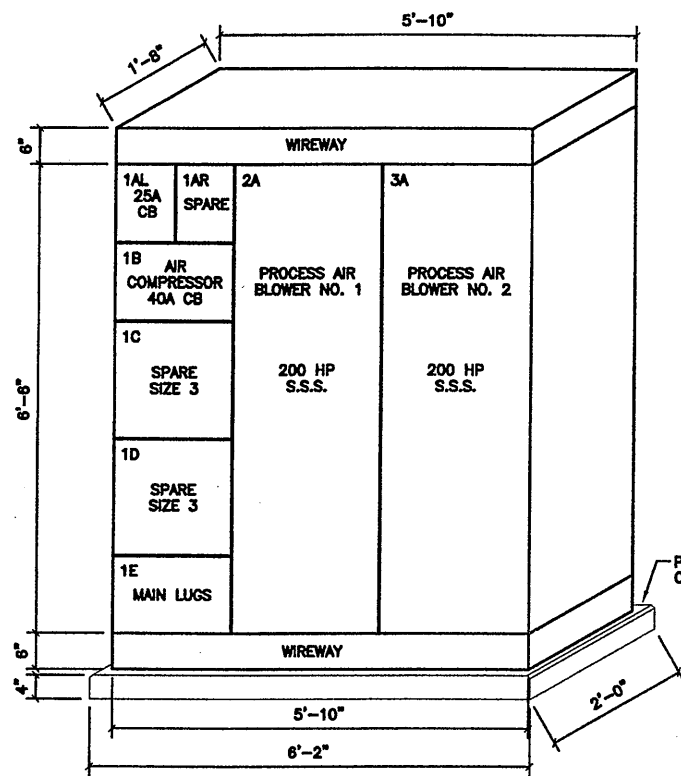


MCC 30 ELEVATION
NOT TO SCALE
(SEE DRAWING E-207)

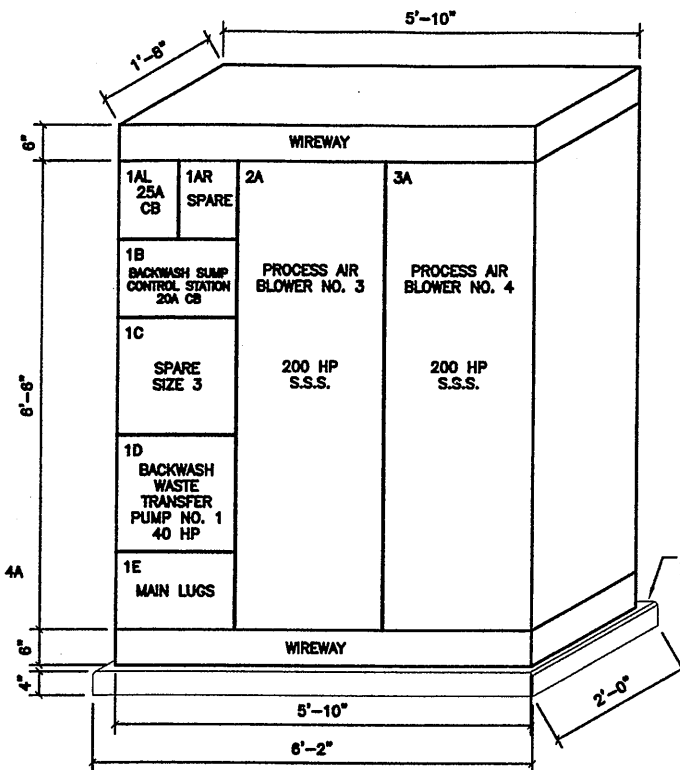


MCC 31 ELEVATION
NOT TO SCALE
(SEE DRAWING E-207)

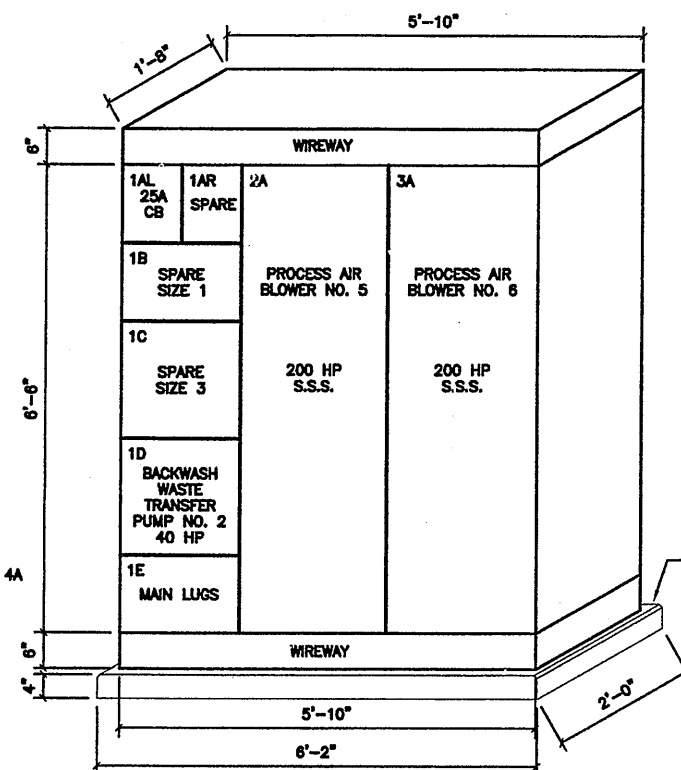


MCC 42 ELEVATION
NOT TO SCALE
(SEE DRAWING E-208)

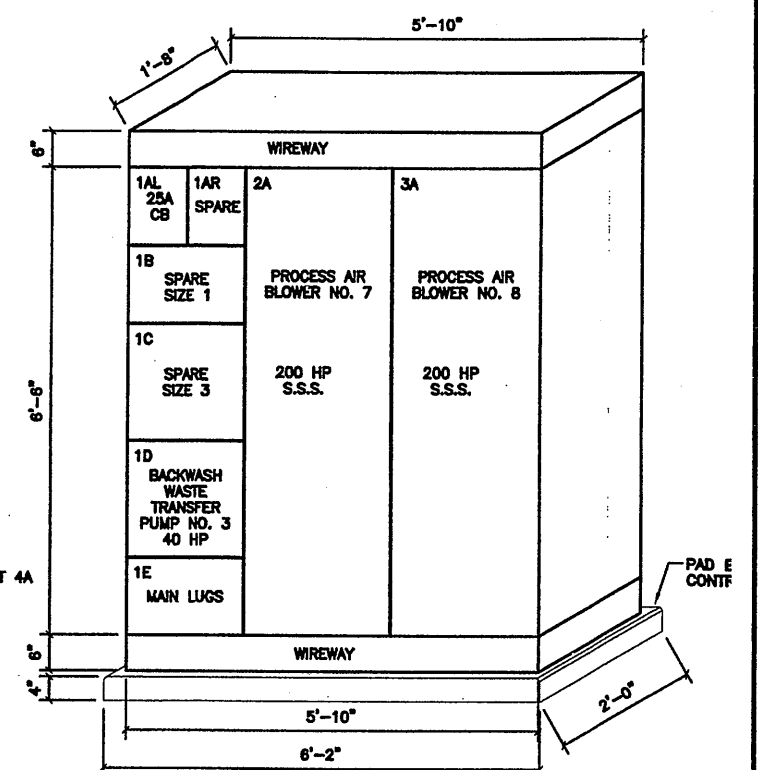

MCC 43 ELEVATION
NOT TO SCALE
(SEE DRAWING E-208)

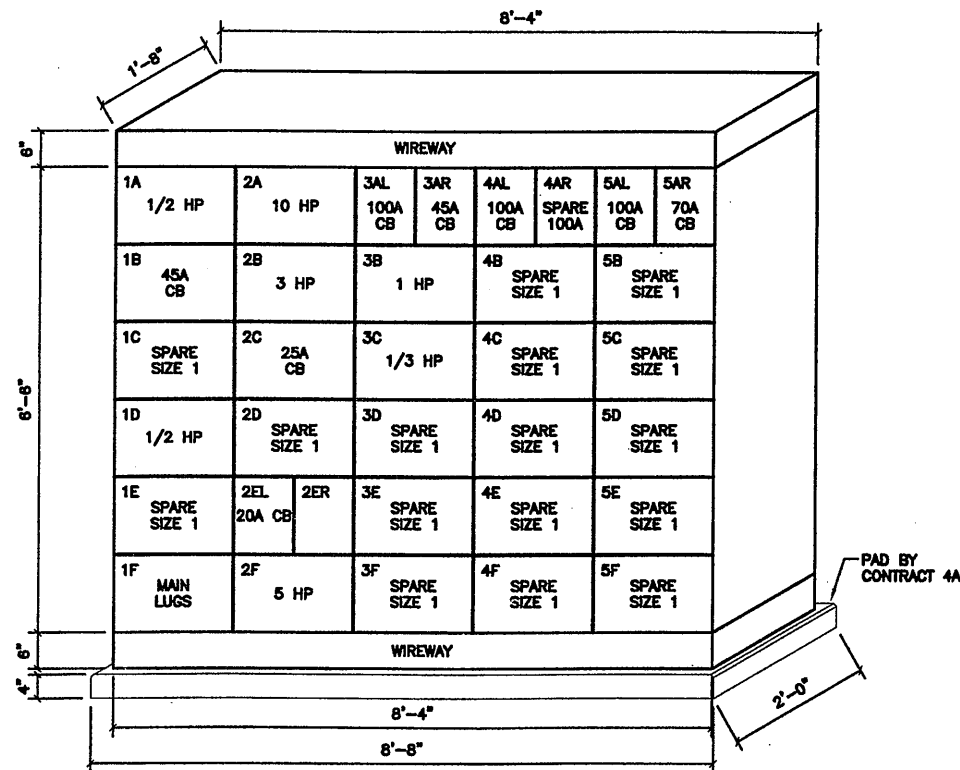

MCC 34 ELEVATION
NOT TO SCALE
(SEE DRAWING E-209 AND E-210)

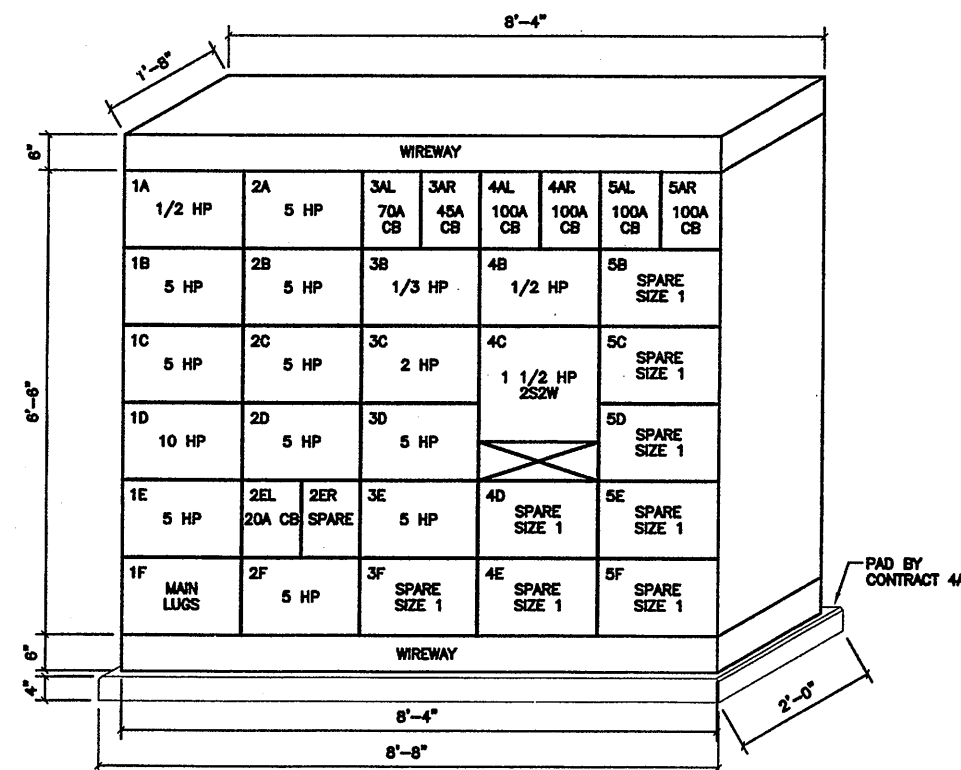

MCC 38 ELEVATION
NOT TO SCALE
(SEE DRAWING E-211 AND E-212)

Layer: ON=*; OFF=*REF*
4/4/01 BBL DCC
05503000/0659E213.DWG

RECORD DRAWING
THIS DRAWING HAS BEEN REVIEWED TO REFLECT MAJOR CHANGES, IF ANY, WHICH OCCURRED DURING CONSTRUCTION. REVISIONS ARE BASED UPON INFORMATION SUPPLIED BY CONTRACTOR.
DATE: 10/21/05 FOR: Rampolit

THIS DRAWING WAS PREPARED AT THE SCALE INDICATED IN THE TITLE BLOCK. INACCURACIES IN THE STATED SCALE MAY BE INTRODUCED WHEN DRAWINGS ARE REPRODUCED BY ANY MEANS. USE THE GRAPHIC SCALE BAR IN THE TITLE BLOCK TO DETERMINE THE ACTUAL SCALE OF THIS DRAWING.

NOT TO SCALE

| No. | Date | Revisions | Int. |
|-----|----------|---------------------|------|
| 0 | 4/20/01 | ISSUED FOR APPROVAL | Wc |
| 1 | | AS BID | |
| 2 | 10/31/05 | RECORD DRAWING | |

In charge of TEL
Designed by TEL
Drawn by DCC
Checked by WFH

ENVIRONMENTAL ENGINEERING ASSOCIATES, LLP
SYRACUSE, NEW YORK

ONONDAGA COUNTY • DEPARTMENT OF DRAINAGE AND SANITATION • SYRACUSE, NEW YORK
METROPOLITAN SYRACUSE WASTEWATER TREATMENT PLANT
STAGE III AMMONIA AND STAGE II PHOSPHORUS REMOVAL PROJECT

BAF COMPLEX
BAF MCC ELEVATIONS

ELECTRICAL




File Number
00659
Date
APRIL 2001


E-213

NO ALTERATIONS PERMITTED HEREON EXCEPT AS PROVIDED UNDER SECTION 7209 SUBDIVISION 2 OF THE NEW YORK STATE EDUCATION LAW


SEE MCC O&M MANUAL FOR EQUIPMENT ELEMENTARY DIAGRAMS

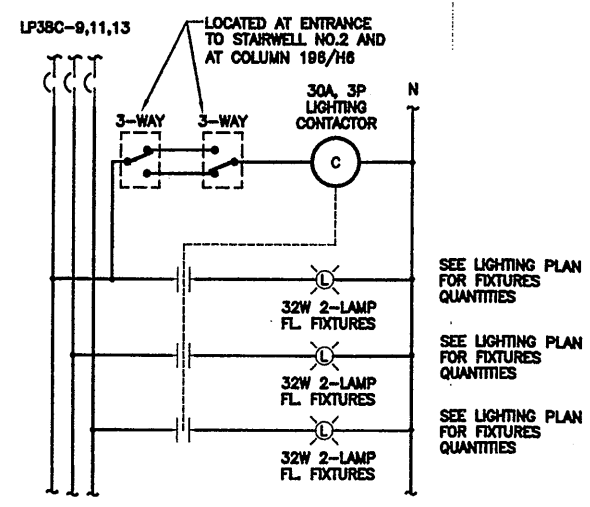


BAF UPPER LEVEL SWITCHING WIRING DIAGRAM
NOT TO SCALE

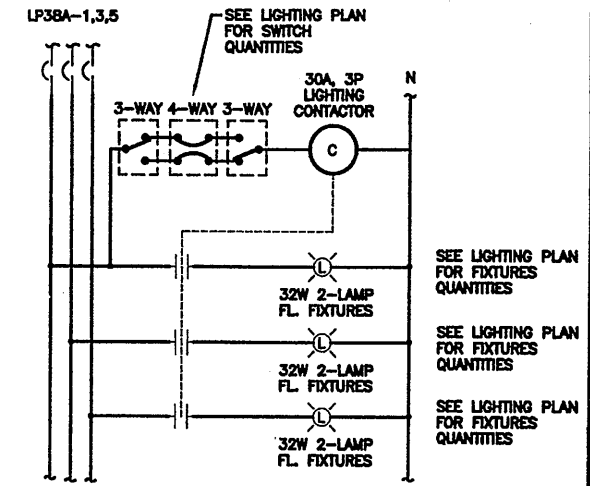


BAF LOWER LEVEL SWITCHING WIRING DIAGRAM
NOT TO SCALE

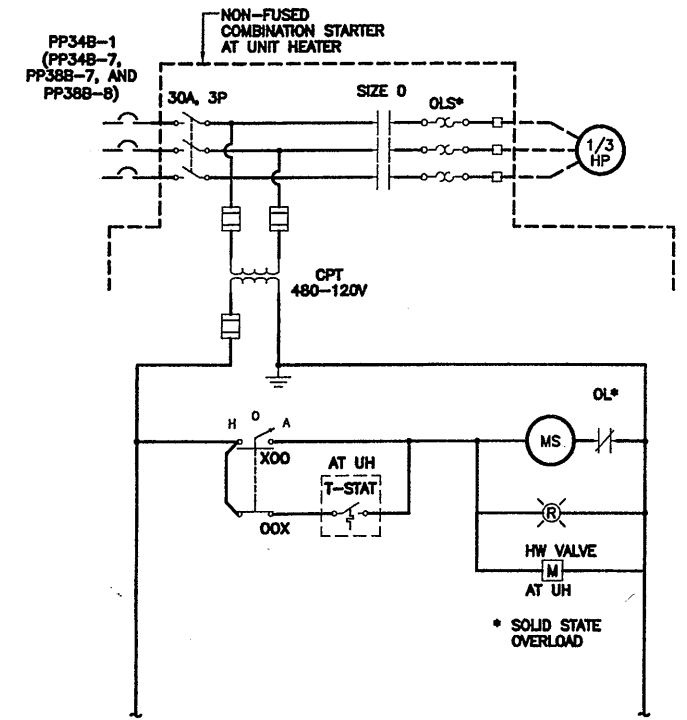


UNIT HEATER UH-201
(TYPICAL FOR UH-202, 207, AND 208)
NOT TO SCALE

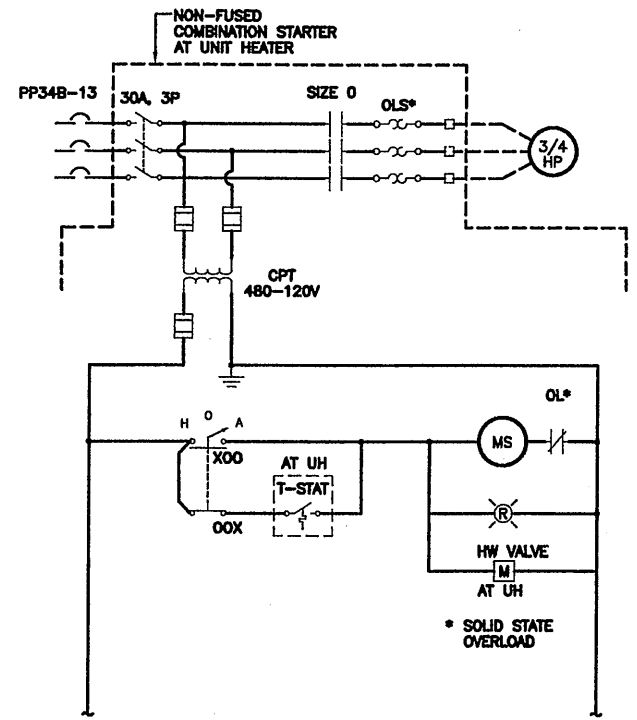

UNIT HEATER UH-209
NOT TO SCALE

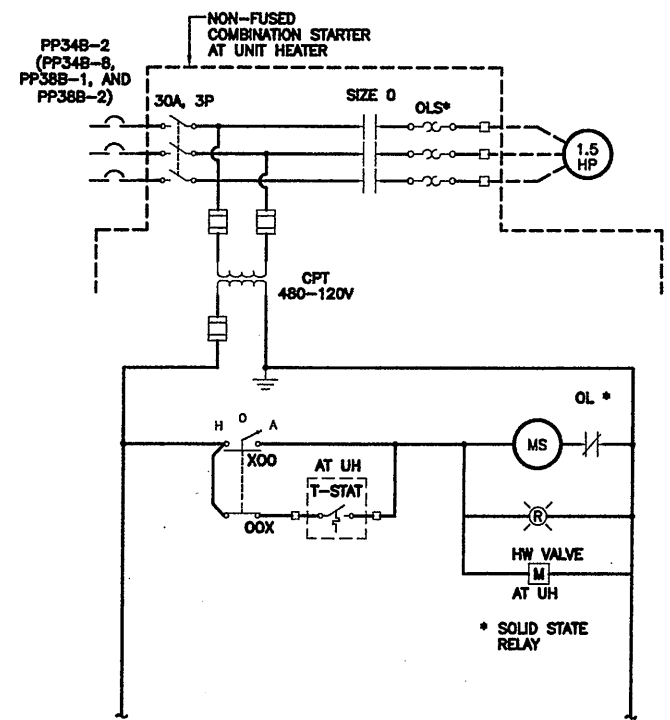

UNIT HEATER UH-203
(TYPICAL FOR UH-204 THRU UH-206)
NOT TO SCALE

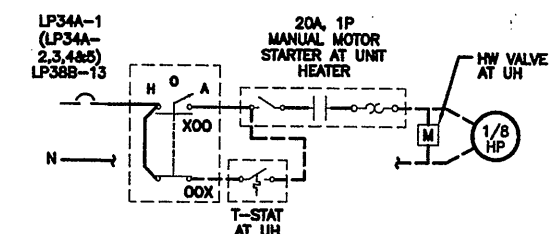

UNIT HEATER UH-210
(TYPICAL FOR UH-211 THRU UH-214, AND UH-323)
NOT TO SCALE

NOTE: SEE ONLINE DIAGRAM FOR MOTOR DISCONNECT SWITCH REQUIREMENTS.

RECORD DRAWING
THESE CHANGES HAVE BEEN REVIEWED TO REFLECT MAJOR CHANGES, IF ANY, WHICH OCCURRED DURING CONSTRUCTION. REVISIONS ARE BASED UPON INFORMATION SUPPLIED BY CONTRACTOR.
DATE: 10/26/05 PER: [Signature]

THIS DRAWING WAS PREPARED AT THE SCALE INDICATED IN THE TITLE BLOCK. INACCURACIES IN THE STATED SCALE MAY BE INTRODUCED WHEN DRAWINGS ARE REPRODUCED BY ANY MEANS. USE THE GRAPHIC SCALE BAR IN THE TITLE BLOCK TO DETERMINE THE ACTUAL SCALE OF THIS DRAWING.

Layer: ON=*, OFF=*REF*
4/17/01 BBL DCC
05503000/0659E214.DWG

NOT TO SCALE

NO ALTERATIONS PERMITTED HEREON EXCEPT AS PROVIDED UNDER SECTION 7209 SUBDIVISION 2 OF THE NEW YORK STATE EDUCATION LAW

| No. | Date | Revisions | Init |
|-----|----------|---------------------|------|
| 0 | 4/20/01 | ISSUED FOR APPROVAL | LL |
| 1 | | AS BID | |
| 2 | 10/31/05 | RECORD DRAWING | |



In charge of TEL
Designed by TEL
Drawn by DCC
Checked by WFH

ENVIRONMENTAL ENGINEERING ASSOCIATES, LLP
SYRACUSE, NEW YORK

ONONDAGA COUNTY • DEPARTMENT OF DRAINAGE AND SANITATION • SYRACUSE, NEW YORK
METROPOLITAN SYRACUSE WASTEWATER TREATMENT PLANT
STAGE III AMMONIA AND STAGE II PHOSPHORUS REMOVAL PROJECT
BAF COMPLEX
BAF ELEMENTARY DIAGRAMS
ELECTRICAL

STATE OF NEW YORK
LEONARD J. CAMPBELL
REGISTERED PROFESSIONAL ENGINEER
No. 50165

File Number: 00659
Date: APRIL 2001
E-214

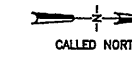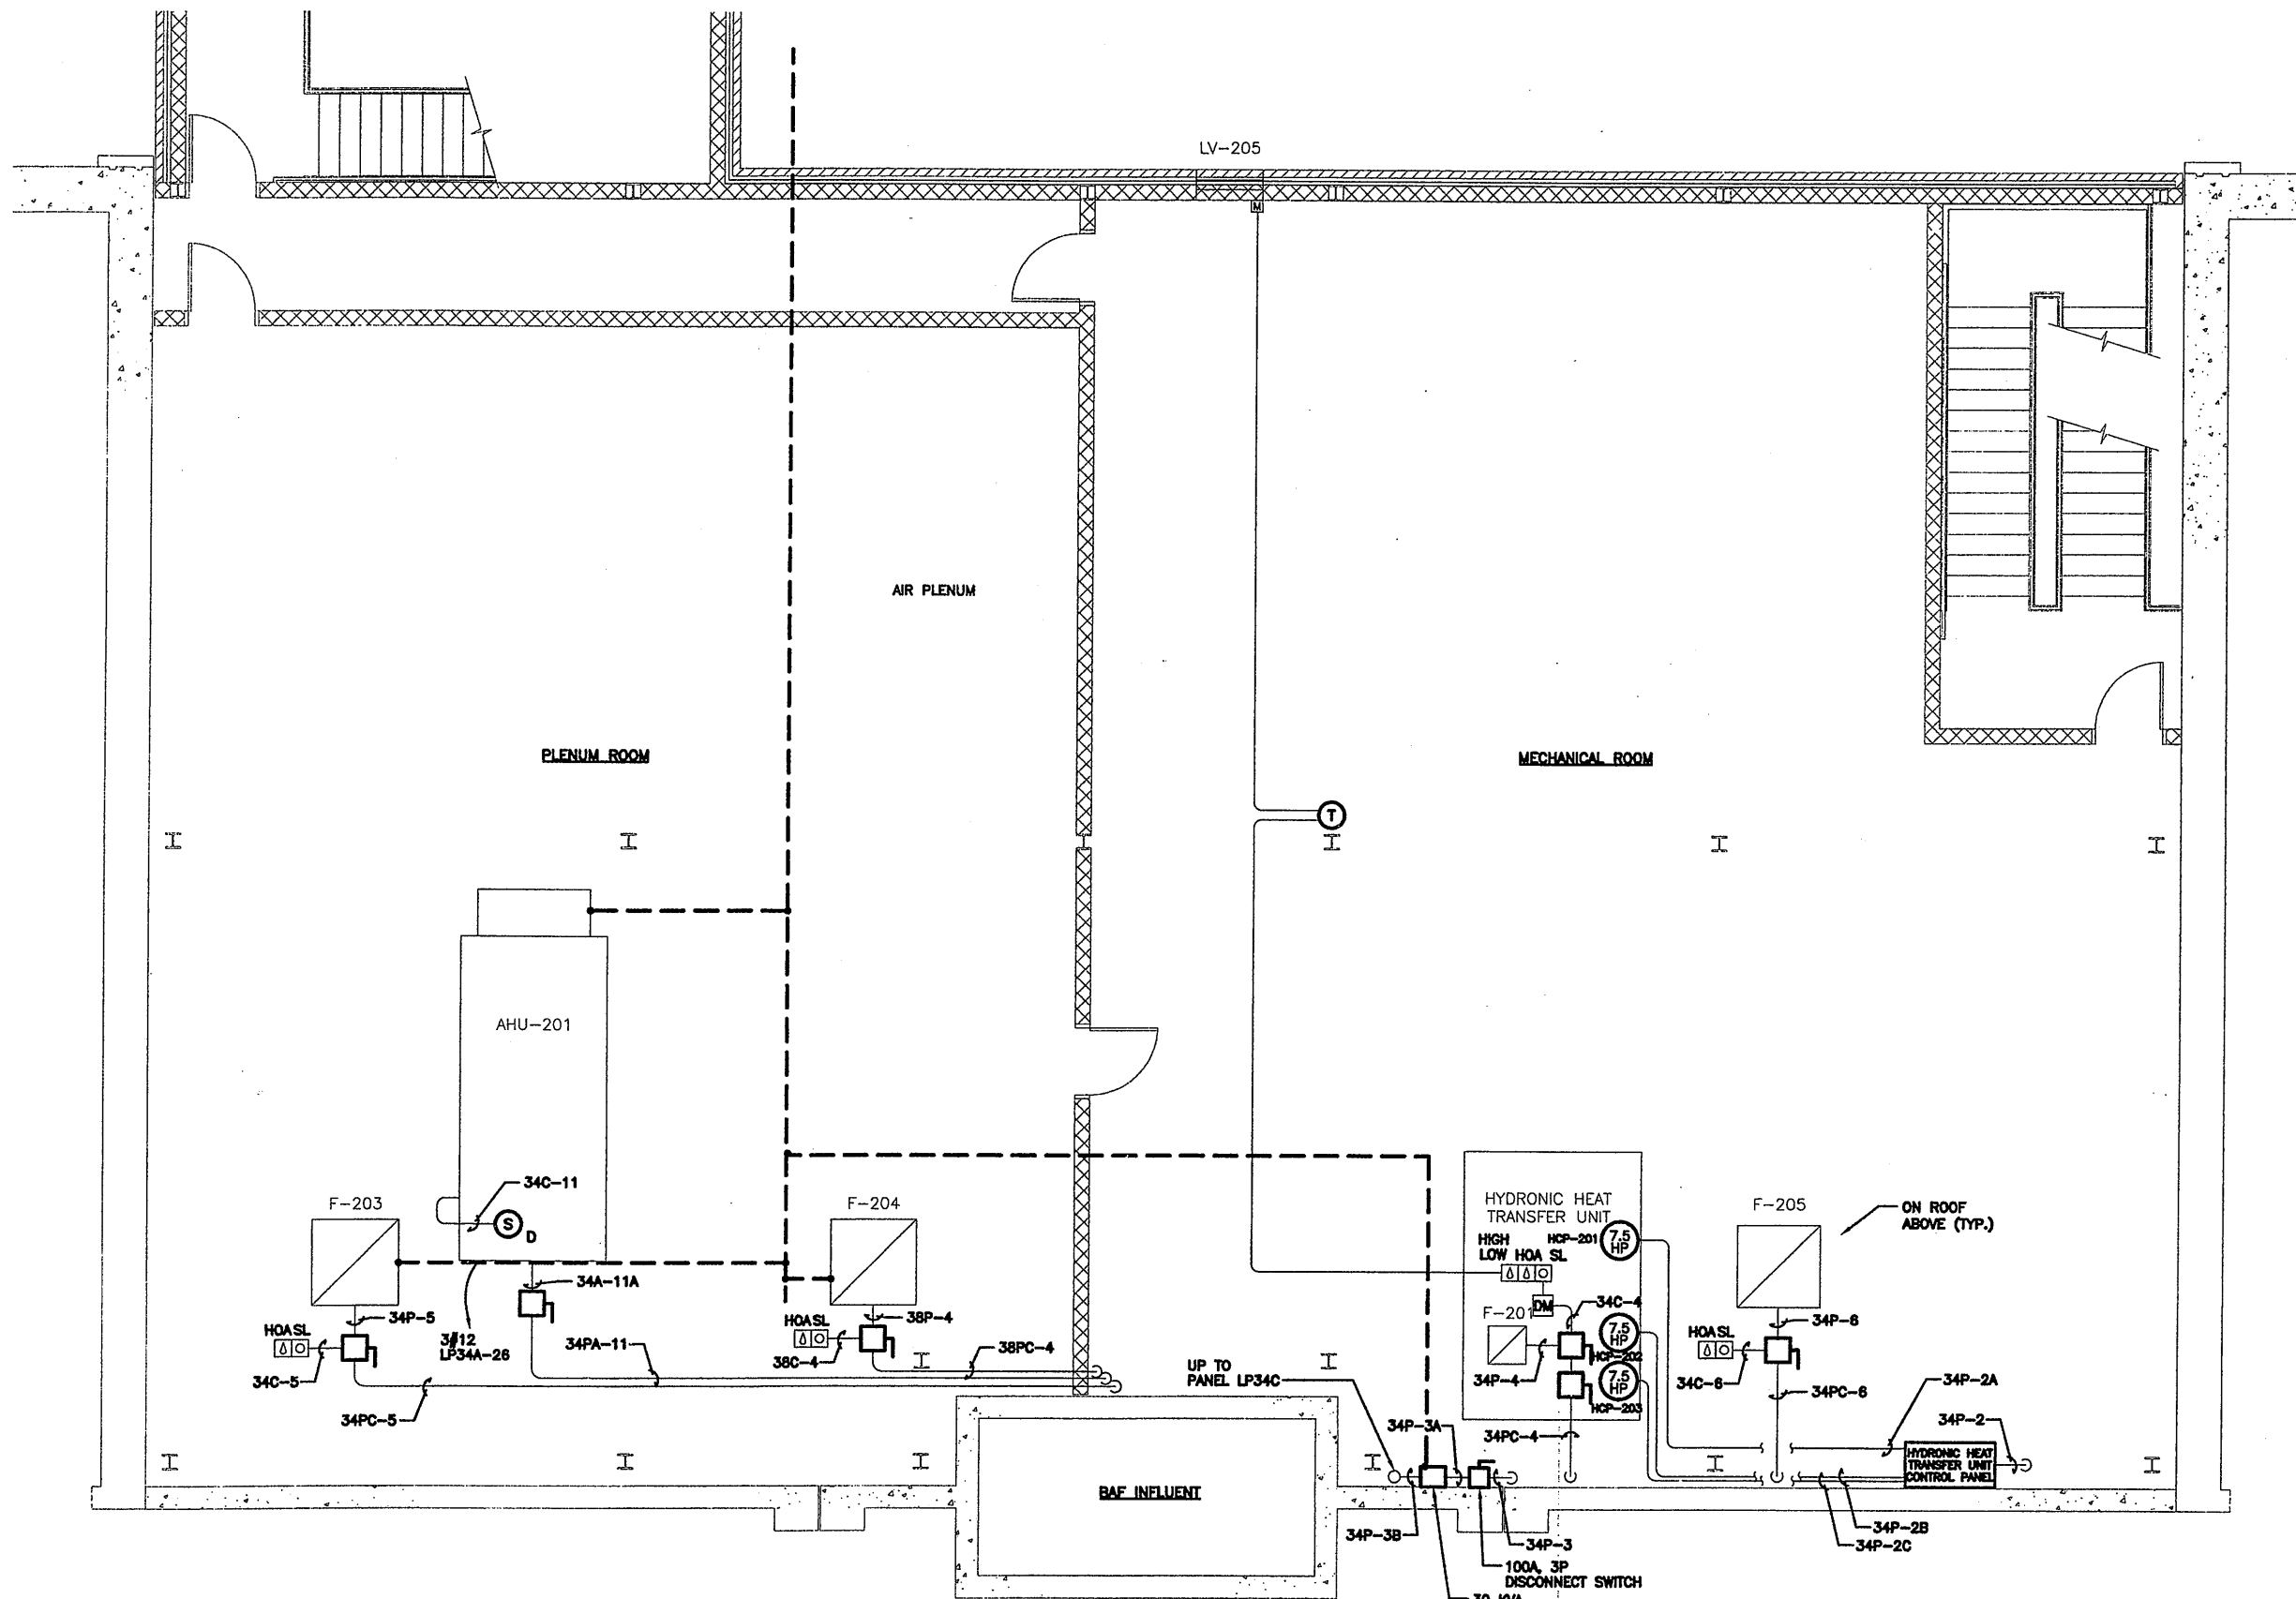

BAF PLENUM AND MECHANICAL ROOM POWER PLAN
SCALE: 1/4"=1'-0"

RECORD DRAWING
THESE DRAWINGS HAVE BEEN REVISIONED TO REFLECT MAJOR CHANGES, IF ANY, WHICH OCCURRED DURING CONSTRUCTION. REVISIONS ARE BASED UPON INFORMATION SUPPLIED BY CONTRACTOR.
DATE: 10/21/05 FOR: [Signature]

THIS DRAWING WAS PREPARED AT THE SCALE INDICATED IN THE TITLE BLOCK. INACCURACIES IN THE STATED SCALE MAY BE INTRODUCED WHEN DRAWINGS ARE REPRODUCED BY ANY MEANS. USE THE GRAPHIC SCALE BAR IN THE TITLE BLOCK TO DETERMINE THE ACTUAL SCALE OF THIS DRAWING.

Layer: ON=*, OFF=*REF*
X: 0659X202.DWG
4/13/01 BBL DCC
05503000/0659E215.DWG

1/4"=1'-0"
NO ALTERATIONS PERMITTED HEREON EXCEPT AS PROVIDED UNDER SECTION 7209 SUBDIVISION 2 OF THE NEW YORK STATE EDUCATION LAW

| No. | Date | Revisions | Init |
|-----|----------|---------------------|-------------|
| 0 | 4/20/01 | ISSUED FOR APPROVAL | [Signature] |
| 1 | | AS BID | |
| 2 | 10/31/05 | RECORD DRAWING | |

In charge of TEL
Designed by MEE
Drawn by DCC
Checked by WFH

ENVIRONMENTAL ENGINEERING ASSOCIATES, LLP
SYRACUSE, NEW YORK

ONONDAGA COUNTY • DEPARTMENT OF DRAINAGE AND SANITATION • SYRACUSE, NEW YORK
METROPOLITAN SYRACUSE WASTEWATER TREATMENT PLANT
STAGE III AMMONIA AND STAGE II PHOSPHORUS REMOVAL PROJECT
BAF COMPLEX
BAF PLENUM AND MECHANICAL ROOM
POWER PLAN
ELECTRICAL

File Number 00659
Date APRIL 2001
E-215
[Signature]

| CIRCUIT BREAKER PANELBOARD - PP-34B | | | | | | | | | | SCHEDULE | | | |
|-------------------------------------|------------------------|-------------------|-----------|-------|-------|-------|-------|-------|-----------|-----------------|------------------------|-----------------|--|
| LOCATION: | | BAF GALLERY SOUTH | | | | | | | | FEED FROM | | MCC 34, 5AL | |
| MAIN BUS RATING: | | 225 AMPERES | | | | | | | | 480 VOLT | | 3 PHASE, 4 WIRE | |
| MINIMUM SHORTCIRCUIT: | | 25,000 AMPERES | | | | | | | | FEEDER CABLE | | 3 #3, 1 #8G | |
| MAIN BREAKER TRIP: | | 100 AMPERES | | | | | | | | SURFACE MOUNTED | | | |
| ESTIMATED CONNECTED LOAD: | | 7.17 KVA | | | | | | | | | | | |
| CKT NO. | DESCRIPTION | AMPS/POLES | LOAD TYPE | KVA | PH-A | PH-B | PH-C | KVA | LOAD TYPE | AMPS/POLES | DESCRIPTION | CKT NO. | |
| 1 | UNIT HEATER NO. UH-201 | 20A | MOTOR | 0.143 | 0.973 | | | 0.830 | MOTOR | 20A | UNIT HEATER NO. UH-203 | 2 | |
| 3 | | | MOTOR | 0.143 | | 0.973 | | 0.830 | MOTOR | | | 4 | |
| 5 | | 3P | MOTOR | 0.143 | | | 0.973 | 0.830 | MOTOR | 3P | | 6 | |
| 7 | UNIT HEATER NO. UH-202 | 20A | MOTOR | 0.143 | 0.973 | | | 0.830 | MOTOR | 20A | UNIT HEATER NO. UH-204 | 8 | |
| 9 | | | MOTOR | 0.143 | | 0.973 | | 0.830 | MOTOR | | | 10 | |
| 11 | | 3P | MOTOR | 0.143 | | | 0.973 | 0.830 | MOTOR | 3P | | 12 | |
| 13 | UNIT HEATER NO. UH-209 | 20A | MOTOR | 0.443 | 0.443 | | | | | 20A | SPARE | 14 | |
| 15 | | | MOTOR | 0.443 | | 0.443 | | | | | | 16 | |
| 17 | | 3P | MOTOR | 0.443 | | | 0.443 | | | 3P | | 18 | |
| 19 | SPARE | 20A | | | 0.000 | | | | | 20A | SPARE | 20 | |
| 21 | | | | | | 0.000 | | | | | | 22 | |
| 23 | | 3P | | | | | 0.000 | | | 3P | | 24 | |
| 25 | SPARE | 20A | | | 0.000 | | | | | 20A | SPARE | 26 | |
| 27 | | | | | | 0.000 | | | | | | 28 | |
| 29 | | 3P | | | | | 0.000 | | | 3P | | 30 | |
| 31 | SPARE | 20A | | | 0.000 | | | | | 20A | SPARE | 32 | |
| 33 | | | | | | 0.000 | | | | | | 34 | |
| 35 | | 3P | | | | | 0.000 | | | 3P | | 36 | |
| 37 | SPARE | 20A | | | 0.000 | | | | | 20A | SPARE | 38 | |
| 39 | | | | | | 0.000 | | | | | | 40 | |
| 41 | | 3P | | | | | 0.000 | | | 3P | | 42 | |
| LOAD SUMMARY | | | | | 2.187 | 2.389 | 2.389 | 4.980 | | | | | |
| PANEL TOTAL KVA: | | | | | 7.167 | | | | | | | | |

NOTE:

ALL CONDUCTORS TO BE 3 #12, 1 #12G IN 3/4-INCH PVC COATED RIGID STEEL CONDUIT, UNLESS OTHERWISE INDICATED ON POWER PLAN.

| CIRCUIT BREAKER PANELBOARD - PP-38B | | | | | | | | | | SCHEDULE | | | |
|-------------------------------------|------------------------|-------------------|-----------|-------|-------|-------|-------|-------|-----------|-----------------|------------------------|-----------------|--|
| LOCATION: | | BAF GALLERY NORTH | | | | | | | | FEED FROM | | MCC 38, 5AL | |
| MAIN BUS RATING: | | 225 AMPERES | | | | | | | | 480 VOLT | | 3 PHASE, 4 WIRE | |
| MINIMUM SHORTCIRCUIT: | | 25,000 AMPERES | | | | | | | | FEEDER CABLE | | 3 #3, 1 #8G | |
| MAIN BREAKER TRIP: | | 100 AMPERES | | | | | | | | SURFACE MOUNTED | | | |
| ESTIMATED CONNECTED LOAD: | | 5.84 KVA | | | | | | | | | | | |
| CKT NO. | DESCRIPTION | AMPS/POLES | LOAD TYPE | KVA | PH-A | PH-B | PH-C | KVA | LOAD TYPE | AMPS/POLES | DESCRIPTION | CKT NO. | |
| 1 | UNIT HEATER NO. UH-205 | 20A | MOTOR | 0.830 | 1.660 | | | 0.830 | MOTOR | 20A | UNIT HEATER NO. UH-206 | 2 | |
| 3 | | | MOTOR | 0.830 | | 1.660 | | 0.830 | MOTOR | | | 4 | |
| 5 | | 3P | MOTOR | 0.830 | | | 1.660 | 0.830 | MOTOR | 3P | | 6 | |
| 7 | UNIT HEATER NO. UH-207 | 20A | MOTOR | 0.143 | 0.286 | | | 0.143 | MOTOR | 20A | UNIT HEATER NO. UH-208 | 8 | |
| 9 | | | MOTOR | 0.143 | | 0.286 | | 0.143 | MOTOR | | | 10 | |
| 11 | | 3P | MOTOR | 0.143 | | | 0.286 | 0.143 | MOTOR | 3P | | 12 | |
| 13 | SPARE | 20A | | | 0.000 | | | | | 20A | SPARE | 14 | |
| 15 | | | | | | 0.000 | | | | | | 16 | |
| 17 | | 3P | | | | | 0.000 | | | 3P | | 18 | |
| 19 | SPARE | 20A | | | 0.000 | | | | | 20A | SPARE | 20 | |
| 21 | | | | | | 0.000 | | | | | | 22 | |
| 23 | | 3P | | | | | 0.000 | | | 3P | | 24 | |
| 25 | SPARE | 20A | | | 0.000 | | | | | 20A | SPARE | 26 | |
| 27 | | | | | | 0.000 | | | | | | 28 | |
| 29 | | 3P | | | | | 0.000 | | | 3P | | 30 | |
| 31 | SPARE | 20A | | | 0.000 | | | | | 20A | SPARE | 32 | |
| 33 | | | | | | 0.000 | | | | | | 34 | |
| 35 | | 3P | | | | | 0.000 | | | 3P | | 36 | |
| 37 | SPARE | 20A | | | 0.000 | | | | | 20A | SPARE | 38 | |
| 39 | | | | | | 0.000 | | | | | | 40 | |
| 41 | | 3P | | | | | 0.000 | | | 3P | | 42 | |
| LOAD SUMMARY | | | | | 2.919 | 1.846 | 1.946 | 0.000 | 2.919 | | | | |
| PANEL TOTAL KVA: | | | | | 5.838 | | | | | | | | |

NOTE:

ALL CONDUCTORS TO BE 3 #12, 1 #12G IN 3/4-INCH PVC COATED RIGID STEEL CONDUIT, UNLESS OTHERWISE INDICATED ON POWER PLAN.

| CIRCUIT BREAKER PANELBOARD - LP-31A | | | | | | | | | | SCHEDULE | | | |
|-------------------------------------|----------------------------------|-------------------|-----------|-------|-------|-------|-------|-------|-----------|-----------------|----------------------------------|-----------------------------|--|
| LOCATION: | | BAF ELECTRIC ROOM | | | | | | | | FEED FROM | | MCC 31, 1AL AND MCC 43, 1AL | |
| MAIN BUS RATING: | | 225 AMPERES | | | | | | | | 208/120 VOLTS | | 3 PHASE, 4 WIRE | |
| MINIMUM SHORTCIRCUIT: | | 10,000 AMPERES | | | | | | | | FEEDER CABLE | | 4 #3, 1 #8G | |
| MAIN BREAKER TRIP: | | 100 AMPERES | | | | | | | | SURFACE MOUNTED | | | |
| ESTIMATED CONNECTED LOAD: | | 4.84 KVA | | | | | | | | | | | |
| CKT NO. | DESCRIPTION | AMPS/POLES | LOAD TYPE | KVA | PH-A | PH-B | PH-C | KVA | LOAD TYPE | AMPS/POLES | DESCRIPTION | CKT NO. | |
| 1 | PLC M17, ACTIFLO | 20/1P | CONTROL | 1.500 | 1.500 | | | | CONTROL | 20/1P | SPARE | 2 | |
| 3 | AIT-30000, HRFS INF TURBIDITY | 20/1P | INST | 0.040 | | 1.540 | | 1.500 | CONTROL | 20/1P | PLC M18, FERRIC/POLYMER | 4 | |
| 5 | AIT-30113, TRAIN 1 EFF TURBIDITY | 20/1P | INST | 0.040 | | | 1.540 | 1.500 | CONTROL | 20/1P | PLC M22, BLOWER BANK B | 6 | |
| 7 | AIT-30313, TRAIN 3 EFF TURBIDITY | 20/1P | INST | 0.040 | 0.080 | | | 0.040 | INST | 20/1P | AIT-30213, TRAIN 2 EFF TURBIDITY | 8 | |
| 9 | SV-30170, SAND FEED #1 | 20/1P | SOL | 0.030 | | 0.070 | | 0.040 | INST | 20/1P | AIT-30413, TRAIN 4 EFF TURBIDITY | 10 | |
| 11 | SV-30370, SAND FEED #3 | 20/1P | SOL | 0.030 | | 0.080 | 0.030 | 0.030 | SOL | 20/1P | SPARE | 12 | |
| 13 | SPARE | 20/1P | | | 0.030 | | | 0.030 | SOL | 20/1P | BOOSTER PUMP HRFS | 14 | |
| 15 | SPARE | 20/1P | | | | 0.000 | | | SOL | 20/1P | BOOSTER PUMP HRFS | 16 | |
| 17 | FIT-30082, SLUDGE DISCHARGE FLOW | 20/1P | INST | 0.020 | | 0.020 | | | INST | 20/1P | SPARE | 18 | |
| 19 | SPARE | 20/1P | | | 0.000 | | | | | 20/1P | SPARE | 20 | |
| 21 | SPARE | 20/1P | | | | 0.000 | | | | 20/1P | SPARE | 22 | |
| 23 | SPARE | 20/1P | | | | | 0.000 | | | 20/1P | SPARE | 24 | |
| 25 | SPARE | 20/1P | | | 0.000 | | | | | 20/1P | SPARE | 26 | |
| 27 | SPARE | 20/1P | | | | 0.000 | | | | 20/1P | SPARE | 28 | |
| 29 | SPARE | 20/1P | | | | | 0.000 | | | 20/1P | SPARE | 30 | |
| 31 | SPARE | 20/1P | | | 0.000 | | | | | 20/1P | F.A.PANEL | 32 | |
| 33 | SPARE | 20/1P | | | | 0.000 | | | | 20/1P | SPARE | 34 | |
| 35 | SPARE | 20/1P | | | | | 0.000 | | | 20/1P | SPARE | 36 | |
| 37 | SPARE | 20/1P | | | 0.000 | | | | | 20/1P | SPARE | 38 | |
| 39 | SPARE | 20/1P | | | | 0.000 | | | | 20/1P | SPARE | 40 | |
| 41 | SPARE | 20/1P | | | | | 0.000 | | | 20/1P | SPARE | 42 | |
| LOAD SUMMARY | | | | | 1.700 | 1.610 | 1.610 | 3.140 | | | | | |
| PANEL TOTAL KVA: | | | | | 4.840 | | | | | | | | |

NOTE:

ALL CONDUCTORS TO BE 2 #12, 1 #12G IN 3/4-INCH PVC COATED RIGID STEEL CONDUIT, UNLESS OTHERWISE INDICATED ON POWER PLAN.

| CIRCUIT BREAKER PANELBOARD - LP-30A | | | | | | | | | | SCHEDULE | | | |
|-------------------------------------|------------------------------|-------------------|-----------|-------|-------|-------|-------|-------|-----------|-----------------|-------------------------------|-----------------------------|--|
| LOCATION: | | BAF ELECTRIC ROOM | | | | | | | | FEED FROM | | MCC 30, 1AL AND MCC 42, 1AL | |
| MAIN BUS RATING: | | 225 AMPERES | | | | | | | | 208/120 VOLTS | | 3 PHASE, 4 WIRE | |
| MINIMUM SHORTCIRCUIT: | | 10,000 AMPERES | | | | | | | | FEEDER CABLE | | 4 #3, 1 #8G | |
| MAIN BREAKER TRIP: | | 100 AMPERES | | | | | | | | SURFACE MOUNTED | | | |
| ESTIMATED CONNECTED LOAD: | | 5.571 KVA | | | | | | | | | | | |
| CKT NO. | DESCRIPTION | AMPS/POLES | LOAD TYPE | KVA | PH-A | PH-B | PH-C | KVA | LOAD TYPE | AMPS/POLES | DESCRIPTION | CKT NO. | |
| 1 | PLC M19, BOSTYR | 20/1P | CONTROL | 1.500 | 1.750 | | | 0.250 | INST | 20/1P | AIT-20012, BAF EFF NH3 | 2 | |
| 3 | PLC M24 | 20/1P | CONTROL | 1.500 | | 1.515 | | 0.015 | INST | 20/1P | LIT-20012, BAF EFF LEVEL HTRS | 4 | |
| 5 | LIT-20001, BAF INF LEVEL | 20/1P | INST | 0.015 | | | 1.515 | 1.500 | CONTROL | 20/1P | PLC M21, BLOWER BANK A | 6 | |
| 7 | AIT-20002 | 20/1P | | | 0.001 | | | 0.001 | INST | 20/1P | FIT-20020, BACKWASH FLOW | 8 | |
| 9 | BAF INF NH3 HTRS | 20/1P | INST | 0.250 | | 0.255 | | 0.005 | INST | 20/1P | AIT-20014A, BAF EFF DO #1 | 10 | |
| 11 | LIT-20021, BACKWASH LEVEL #1 | 20/1P | INST | 0.015 | | 0.020 | 0.005 | 0.005 | INST | 20/1P | AIT-20014B, BAF EFF DO #2 | 12 | |
| 13 | LIT-20022, BACKWASH LEVEL #2 | 20/1P | INST | 0.015 | 0.515 | | | 0.500 | CONTROLS | 20/1P | SPARE | 14 | |
| 15 | SPARE | 20/1P | | | | 0.000 | | | | 20/1P | SPARE | 16 | |
| 17 | SPARE | 20/1P | | | | | 0.000 | | | 20/1P | SPARE | 18 | |
| 19 | SPARE | 20/1P | | | 0.000 | | | | | 20/1P | SPARE | 20 | |
| 21 | SPARE | 20/1P | | | | 0.000 | | | | 20/1P | SPARE | 22 | |
| 23 | SPARE | 20/1P | | | | | 0.000 | | | 20/1P | SPARE | 24 | |
| 25 | SPARE | 20/1P | | | 0.000 | | | | | 20/1P | SPARE | 26 | |
| 27 | SPARE | 20/1P | | | | 0.000 | | | | 20/1P | SPARE | 28 | |
| 29 | SPARE | 20/1P | | | | | 0.000 | | | 20/1P | SPARE | 30 | |
| 31 | SPARE | 20/1P | | | 0.000 | | | | | 20/1P | SPARE | 32 | |
| 33 | SPARE | 20/1P | | | | 0.000 | | | | 20/1P | SPARE | 34 | |
| 35 | SPARE | 20/1P | | | | | 0.000 | | | 20/1P | SPARE | 36 | |
| 37 | SPARE | 20/1P | | | 0.000 | | | | | 20/1P | SPARE | 38 | |
| 39 | SPARE | 20/1P | | | | 0.000 | | | | 20/1P | SPARE | 40 | |
| 41 | SPARE | 20/1P | | | | | 0.000 | | | 20/1P | SPARE | 42 | |
| LOAD SUMMARY | | | | | 3.295 | 2.286 | 1.770 | 1.535 | 2.276 | | | | |
| PANEL TOTAL KVA: | | | | | 5.571 | | | | | | | | |

NOTE:

ALL CONDUCTORS TO BE 2 #12, 1 #12G IN 3/4-INCH PVC COATED RIGID STEEL CONDUIT, UNLESS OTHERWISE INDICATED ON POWER PLAN.

RECORD DRAWING

THESE DRAWINGS HAVE BEEN REVISIONED TO REFLECT CHANGES IF ANY, WHICH OCCURRED DURING CONSTRUCTION. REVISIONS ARE BASED UPON INFORMATION SUPPLIED BY CONTRACTOR.

DATE: 10/2/05 FOR: [Signature]

THIS DRAWING WAS PREPARED AT THE SCALE INDICATED IN THE TITLE BLOCK. INACCURACIES IN THE STATED SCALE MAY BE INTRODUCED WHEN DRAWINGS ARE REPRODUCED BY ANY MEANS. USE THE GRAPHIC SCALE BAR IN THE TITLE BLOCK TO DETERMINE THE



| CIRCUIT BREAKER PANELBOARD - LP-34A | | | | | | | | | | SCHEDULE | | | | | | | | | |
|-------------------------------------|----------------------------------|------------|-----------|--------|-------------------|-------|-------|--------|-----------|-----------------|---------------------------------|---------|--|--|-----------------|--|--|--|--|
| LOCATION: | | | | | BAF ELECTRIC ROOM | | | | | FEED FROM | | | | | MCC 34, 5AR | | | | |
| MAIN BUS RATING: | | | | | 225 AMPERES | | | | | 208/120 VOLTS | | | | | 3 PHASE, 4 WIRE | | | | |
| MINIMUM SHORTCIRCUIT: | | | | | 10,000 AMPERES | | | | | FEEDER CABLE | | | | | 4 #1, 1 #8G | | | | |
| MAIN BREAKER TRIP: | | | | | 125 AMPERES | | | | | SURFACE MOUNTED | | | | | | | | | |
| ESTIMATED CONNECTED LOAD: | | | | | 24.11 KVA | | | | | | | | | | | | | | |
| | | | | | | | | | | CB | | | | | | | | | |
| CKT NO. | DESCRIPTION | AMPS/POLES | LOAD TYPE | KVA | PH-A | PH-B | PH-C | KVA | LOAD TYPE | AMPS/POLES | DESCRIPTION | CKT NO. | | | | | | | |
| 1 | UNIT HEATER UH-212 | 20/1P | MOTOR | 0.093 | 0.188 | | | 0.093 | MOTOR | 20/1P | UNIT HEATER UH-211 | 2 | | | | | | | |
| 3 | UNIT HEATER UH-213 | 20/1P | MOTOR | 0.093 | | 0.188 | | 0.093 | MOTOR | 20/1P | UNIT HEATER UH-210 | 4 | | | | | | | |
| 5 | UNIT HEATER UH-214 | 20/1P | MOTOR | 0.093 | | | 1.093 | 1.000 | HEAT | 20/1P | SPARE | 6 | | | | | | | |
| 7 | SPARE | 20/1P | HEAT | 1.750 | 3.201 | | | 1.451 | LIGHTS | 20/1P | LIGHTS - STAIR TOWER | 8 | | | | | | | |
| 9 | LIGHTS - BAF ELECTRIC ROOM | 20/1P | LIGHTS | 1.680 | | 1.860 | | 1.080 | RECEPT | 20/1P | RECEPT AT TRANSFORMERS | 10 | | | | | | | |
| 11 | NIGHT LIGHTS - BAF UTILITY ROOMS | 20/1P | LIGHTS | 1.547 | | | 3.326 | 1.779 | LIGHTS | 20/1P | LIGHTS - BAF BLOWER ROOM | 12 | | | | | | | |
| 13 | LIGHTS - PLENUM ROOM | 20/1P | LIGHTS | 0.427 | 2.141 | | | 1.714 | LIGHTS | 20/1P | LIGHTS - ELEC. ROOM STAIRS | 14 | | | | | | | |
| 15 | LIGHTS - MECHANICAL ROOM | 20/1P | LIGHTS | 1.878 | | 3.318 | | 1.440 | RECEPT | 20/1P | RECEPT - BLOWER ROOM | 16 | | | | | | | |
| 17 | RECEPT - PLENUM | 20/1P | RECEPT | 1.080 | | | 1.800 | 0.720 | RECEPT | 20/1P | RECEPT - BAF GALLERY SUMPS WEST | 18 | | | | | | | |
| 19 | RECEPT - MECH. ROOM NORTH | 20/1P | RECEPT | 1.080 | 2.180 | | | 1.080 | RECEPT | 20/1P | RECEPT - HRFS NORTH | 20 | | | | | | | |
| 21 | RECEPT - BAF GALLERY SW | 20/1P | RECEPT | 1.280 | | 2.520 | | 1.280 | RECEPT | 20/1P | RECEPT - HRFS SOUTH | 22 | | | | | | | |
| 23 | RECEPT - BAF GALLERY NE | 20/1P | RECEPT | 1.280 | | | 1.820 | 0.360 | RECEPT | 20/1P | RECEPT - HRFS GALLERY SUMPS 2 | 24 | | | | | | | |
| 25 | FAN F-202 | 20/1P | MOTOR | 0.700 | 0.700 | | | | | 20/1P | AHU-1 LIGHTS & RECEPTACLE | 26 | | | | | | | |
| 27 | DUPLEX PUMP | 20/1P | | | | 0.000 | | | | 20/1P | SUMP PUMP CELLS 3 & 5 | 28 | | | | | | | |
| 29 | RECEPTACLE - BAF INF. | 20/1P | | | | | 0.000 | | | 20/1P | SUMP CONT. PANEL HRFS EFFLUENT | 30 | | | | | | | |
| 31 | EXTERIOR LIGHTS | 20/1P | | | 0.000 | | | | | 20/1P | DDC PANEL AHU-201 | 32 | | | | | | | |
| 33 | DOOR ALARM LIGHTS OH | 20/1P | | | | 0.000 | | | | 20/1P | HX-201 DDC | 34 | | | | | | | |
| 35 | BLOW OFF PANEL | 20/1P | | | | 0.000 | | | | 20/1P | AHU-301 DDC PANEL | 36 | | | | | | | |
| 37 | FAN 203, 204, 205 CONTROL | 20/1P | | | 0.000 | | | | | 20/1P | SPARE | 38 | | | | | | | |
| 39 | SPARE | 20/1P | | | | 0.000 | | | | 20/1P | SPARE | 40 | | | | | | | |
| 41 | SPARE | 20/1P | | | | | 0.000 | | | 20/1P | SPARE | 42 | | | | | | | |
| LOAD SUMMARY | | | | 12.941 | 8.388 | 7.884 | 0.000 | 11.170 | | | | | | | | | | | |
| PANEL TOTAL KVA: | | | | 24.111 | | | | | | | | | | | | | | | |

NOTE:
ALL CONDUCTORS TO BE 2 #12, 1 #12G IN 3/4-INCH PVC COATED RIGID STEEL CONDUIT, UNLESS OTHERWISE INDICATED ON POWER PLAN.

| CIRCUIT BREAKER PANELBOARD - LP-38A | | | | | | | | | | SCHEDULE | | | | | | | | | |
|-------------------------------------|---------------------------------|------------|-----------|--------|-------------------|-------|-------|--------|-----------|-----------------|--------------------------------|---------|--|--|-----------------|--|--|--|--|
| LOCATION: | | | | | BAF ELECTRIC ROOM | | | | | FEED FROM | | | | | MCC 38, 3AL | | | | |
| MAIN BUS RATING: | | | | | 225 AMPERES | | | | | 208/120 VOLTS | | | | | 3 PHASE, 4 WIRE | | | | |
| MINIMUM SHORTCIRCUIT: | | | | | 10,000 AMPERES | | | | | FEEDER CABLE | | | | | 4 #3, 1 #8G | | | | |
| MAIN BREAKER TRIP: | | | | | 100 AMPERES | | | | | SURFACE MOUNTED | | | | | | | | | |
| ESTIMATED CONNECTED LOAD: | | | | | 22.89 KVA | | | | | | | | | | | | | | |
| | | | | | | | | | | CB | | | | | | | | | |
| CKT NO. | DESCRIPTION | AMPS/POLES | LOAD TYPE | KVA | PH-A | PH-B | PH-C | KVA | LOAD TYPE | AMPS/POLES | DESCRIPTION | CKT NO. | | | | | | | |
| 1 | LIGHTS - BAF GALLERY | 20/1P | LIGHTS | 0.896 | 2.598 | | | 1.700 | LIGHTS | 20/1P | NIGHT LIGHTS - HRFS | 2 | | | | | | | |
| 3 | LIGHTS - BAF GALLERY | 20/1P | LIGHTS | 0.896 | | 2.798 | | 1.900 | LIGHTS | 20/1P | LIGHTS - HRFS - NORTH | 4 | | | | | | | |
| 5 | LIGHTS - BAF GALLERY | 20/1P | LIGHTS | 0.897 | | | 2.797 | 1.900 | LIGHTS | 20/1P | LIGHTS - HRFS - SOUTH | 6 | | | | | | | |
| 7 | RECEPT - BAF ELECTRIC ROOM N. | 20/1P | RECEPT | 0.900 | 1.700 | | | 0.800 | LIGHTS | 20/1P | SAND PUMP LIGHTS | 8 | | | | | | | |
| 9 | RECEPT - BAF ELECTRIC ROOM S. | 20/1P | RECEPT | 0.900 | | 2.160 | | 1.280 | RECEPT | 20/1P | RECEPT - HRFS EAST | 10 | | | | | | | |
| 11 | RECEPT - MECH. ROOM SOUTH | 20/1P | RECEPT | 1.080 | | | 2.531 | 1.451 | LIGHTS | 20/1P | LIGHTS - BAF WALL | 12 | | | | | | | |
| 13 | RECEPT - BAF GALLERY NW | 20/1P | RECEPT | 0.900 | 1.500 | | | 0.800 | LIGHTS | 20/1P | LIGHTS - HRFS - EXTERIOR | 14 | | | | | | | |
| 15 | RECEPT-HRFS GALLERY SUMPS 1 | 20/1P | RECEPT | 0.360 | | 1.980 | | 1.620 | RECEPT | 20/1P | RECEPT - BAF GALLERY SE | 16 | | | | | | | |
| 17 | SLUDGE TRANSFER PUMP LIGHTS | 20/1P | LIGHTS | 0.700 | | | 1.492 | 0.792 | LIGHTS | 20/1P | NIGHT LIGHTS - BAF GALLERY | 18 | | | | | | | |
| 19 | INSTRUMENT AIR DRYER | 20/1P | MOTOR | 1.178 | 1.178 | | | | | 20/1P | SPARE | 20 | | | | | | | |
| 21 | RECEPT-BAF GALLERY SUMPS EAST | 20/1P | RECEPT | 0.900 | | 0.930 | | 0.030 | CONTROL | 20/1P | CLOSED CIRCUIT TV CAMERA NO. 6 | 22 | | | | | | | |
| 23 | EXTERIOR LIGHTS - BAF | 20/1P | LIGHTS | 0.600 | | | 0.630 | 0.030 | CONTROL | 20/1P | CLOSED CIRCUIT TV CAMERA NO. 7 | 24 | | | | | | | |
| 25 | LIGHTS - BACKWASH PUMP BASEMENT | 20/1P | LIGHTS | 0.600 | 0.600 | | | | | 20/1P | STRAINER CONTROL PANEL | 26 | | | | | | | |
| 27 | BAF PUMP ROOM SUMP CONTROL | 20/1P | | | | 0.000 | | | | 20/1P | SUMP CELLS 4 & 6 | 28 | | | | | | | |
| 29 | CROSS GALLERY SUMP CONTROL | 20/1P | | | | | 0.000 | | | 20/1P | SUMP HRFS EFFLUENT | 30 | | | | | | | |
| 31 | SPARE | 20/1P | | | 0.000 | | | | | 20/1P | DOOR ALARM & LTS OH DOOR 105 | 32 | | | | | | | |
| 33 | RECEPTACLE AT FIBRE PANEL | 20/1P | | | | 0.000 | | | | 20/1P | DOOR ALARM & LTS OH DOOR 102 | 34 | | | | | | | |
| 35 | SPARE | 20/1P | | | | | 0.000 | | | 20/1P | HEAT TRACE HRFS | 36 | | | | | | | |
| 37 | SPARE | 20/1P | | | | | 0.000 | | | 20/1P | SPARE | 38 | | | | | | | |
| 39 | SPARE | 20/1P | | | | | 0.000 | | | 20/1P | SPARE | 40 | | | | | | | |
| 41 | SPARE | 20/1P | | | | | | 0.000 | | 20/1P | SPARE | 42 | | | | | | | |
| LOAD SUMMARY | | | | | | | | 10.805 | 7.572 | 7.886 | 7.450 | 12.083 | | | | | | | |
| PANEL TOTAL KVA: | | | | 22.888 | | | | | | | | | | | | | | | |

NOTE:
ALL CONDUCTORS TO BE 2 #12, 1 #12G IN 3/4-INCH PVC COATED RIGID STEEL CONDUIT, UNLESS OTHERWISE INDICATED ON POWER PLAN.

| CIRCUIT BREAKER PANELBOARD - LP-38C | | | | | | | | | | SCHEDULE | | | | | | | | | |
|-------------------------------------|-------------------------------|------------|-----------|--------|-----------------|-------|-------|--------|-----------|-----------------|------------------------------------|---------|--|--|-----------------|--|--|--|--|
| LOCATION: | | | | | BAF UPPER LEVEL | | | | | FEED FROM | | | | | MCC 34, 3AR | | | | |
| MAIN BUS RATING: | | | | | 225 AMPERES | | | | | 208/120 VOLTS | | | | | 3 PHASE, 4 WIRE | | | | |
| MINIMUM SHORTCIRCUIT: | | | | | 10,000 AMPERES | | | | | FEEDER CABLE | | | | | 4 #3, 1 #8G | | | | |
| MAIN BREAKER TRIP: | | | | | 100 AMPERES | | | | | SURFACE MOUNTED | | | | | | | | | |
| ESTIMATED CONNECTED LOAD: | | | | | 22.19 KVA | | | | | | | | | | | | | | |
| | | | | | | | | | | CB | | | | | | | | | |
| CKT NO. | DESCRIPTION | AMPS/POLES | LOAD TYPE | KVA | PH-A | PH-B | PH-C | KVA | LOAD TYPE | AMPS/POLES | DESCRIPTION | CKT NO. | | | | | | | |
| 1 | FLOOD LTS BAF CELLS 1,3,5,7 | 20 | LIGHTS | 1.082 | 2.184 | | | 1.082 | LIGHTS | 20 | FLOOD LTS BAF CELLS 11,13,15,17 | 2 | | | | | | | |
| 3 | | 2P | | 1.082 | | 2.184 | | 1.082 | | 2P | | 4 | | | | | | | |
| 13 | FLOOD LTS BAF CELLS 2,4,6,8,9 | 20 | LIGHTS | 1.353 | | | 2.705 | 1.353 | LIGHTS | 20 | FLOOD LTS BAF CELLS 10,12,14,16,18 | 6 | | | | | | | |
| 15 | | 2P | | 1.353 | | 2.705 | | 1.353 | | 2P | | 8 | | | | | | | |
| 9 | BAF UPPER WALKWAY LIGHTS | 20/1P | LIGHTS | 1.024 | | 2.124 | | 1.100 | LIGHTS | 20/1P | BAF UPPER WALKWAY N NIGHT LIGHTS | 10 | | | | | | | |
| 11 | BAF UPPER WALKWAY LIGHTS | 20/1P | LIGHTS | 0.960 | | | 1.860 | 0.900 | RECEPT | 20/1P | BAF UPPER RECEPT SOUTH | 12 | | | | | | | |
| 7 | BAF UPPER WALKWAY LIGHTS | 20/1P | LIGHTS | 0.960 | 0.960 | | | | | 20/1P | SPARE | 14 | | | | | | | |
| 5 | BAF UPPER RECEPT NORTH | 20/1P | RECEPT | 0.900 | | 2.000 | | 1.100 | LIGHTS | 20/1P | BAF UPPER WALKWAY S NIGHT LIGHTS | 16 | | | | | | | |
| 17 | RF DRAIN HEAT TRACE HT-201 | 20/1P | HEAT | 0.504 | | | 1.178 | 0.672 | HEAT | 20/1P | RF DRAIN HEAT TRACE HT-202 | 18 | | | | | | | |
| 19 | RF DRAIN HEAT TRACE HT-203 | 20/1P | HEAT | 0.684 | 1.284 | | | 0.600 | HEAT | 30/1P | RF DRAIN HEAT TRACE HT-204 | 20 | | | | | | | |
| 21 | RF DRAIN HEAT TRACE HT-205 | 20/1P | HEAT | 0.672 | | 1.284 | | 0.612 | HEAT | 20/1P | RF DRAIN HEAT TRACE HT-213 | 22 | | | | | | | |
| 23 | RF DRAIN HEAT TRACE HT-207 | 30/1P | HEAT | 0.300 | | | 0.812 | 0.612 | HEAT | 20/1P | RF DRAIN HEAT TRACE HT-208 | 24 | | | | | | | |
| 25 | RF DRAIN HEAT TRACE HT-209 | 20/1P | HEAT | 0.168 | 0.336 | | | 0.168 | HEAT | 20/1P | RF DRAIN HEAT TRACE HT-210 | 26 | | | | | | | |
| 27 | HEAT TRACE 212 | 20/1P | | | | 0.000 | | | | 20/1P | SPARE | 28 | | | | | | | |
| 29 | RF DRAIN HEAT TRACE HT-211 | 20/1P | HEAT | 0.516 | | | 0.516 | | | 20 | SPARE | 30 | | | | | | | |
| 31 | SPARE | 20/1P | | | 0.000 | | | | | 2P | | 32 | | | | | | | |
| 33 | SPARE | 40 | | | | 0.000 | | | | 20/1P | SPARE | 34 | | | | | | | |
| 35 | | 2P | | | | | 0.000 | | | 20/1P | SPARE | 36 | | | | | | | |
| 37 | SPARE | 40 | | | | 0.000 | | | | 20/1P | SPARE | 38 | | | | | | | |
| 39 | | | | | | 0.000 | | | | 20/1P | SPARE | 40 | | | | | | | |
| 41 | | 3P | | | | | 0.000 | | | 20/1P | SPARE | 42 | | | | | | | |
| LOAD SUMMARY | | | | 11.557 | 7.449 | 7.572 | 7.169 | 10.833 | | | | | | | | | | | |
| PANEL TOTAL KVA: | | | | 22.190 | | | | | | | | | | | | | | | |

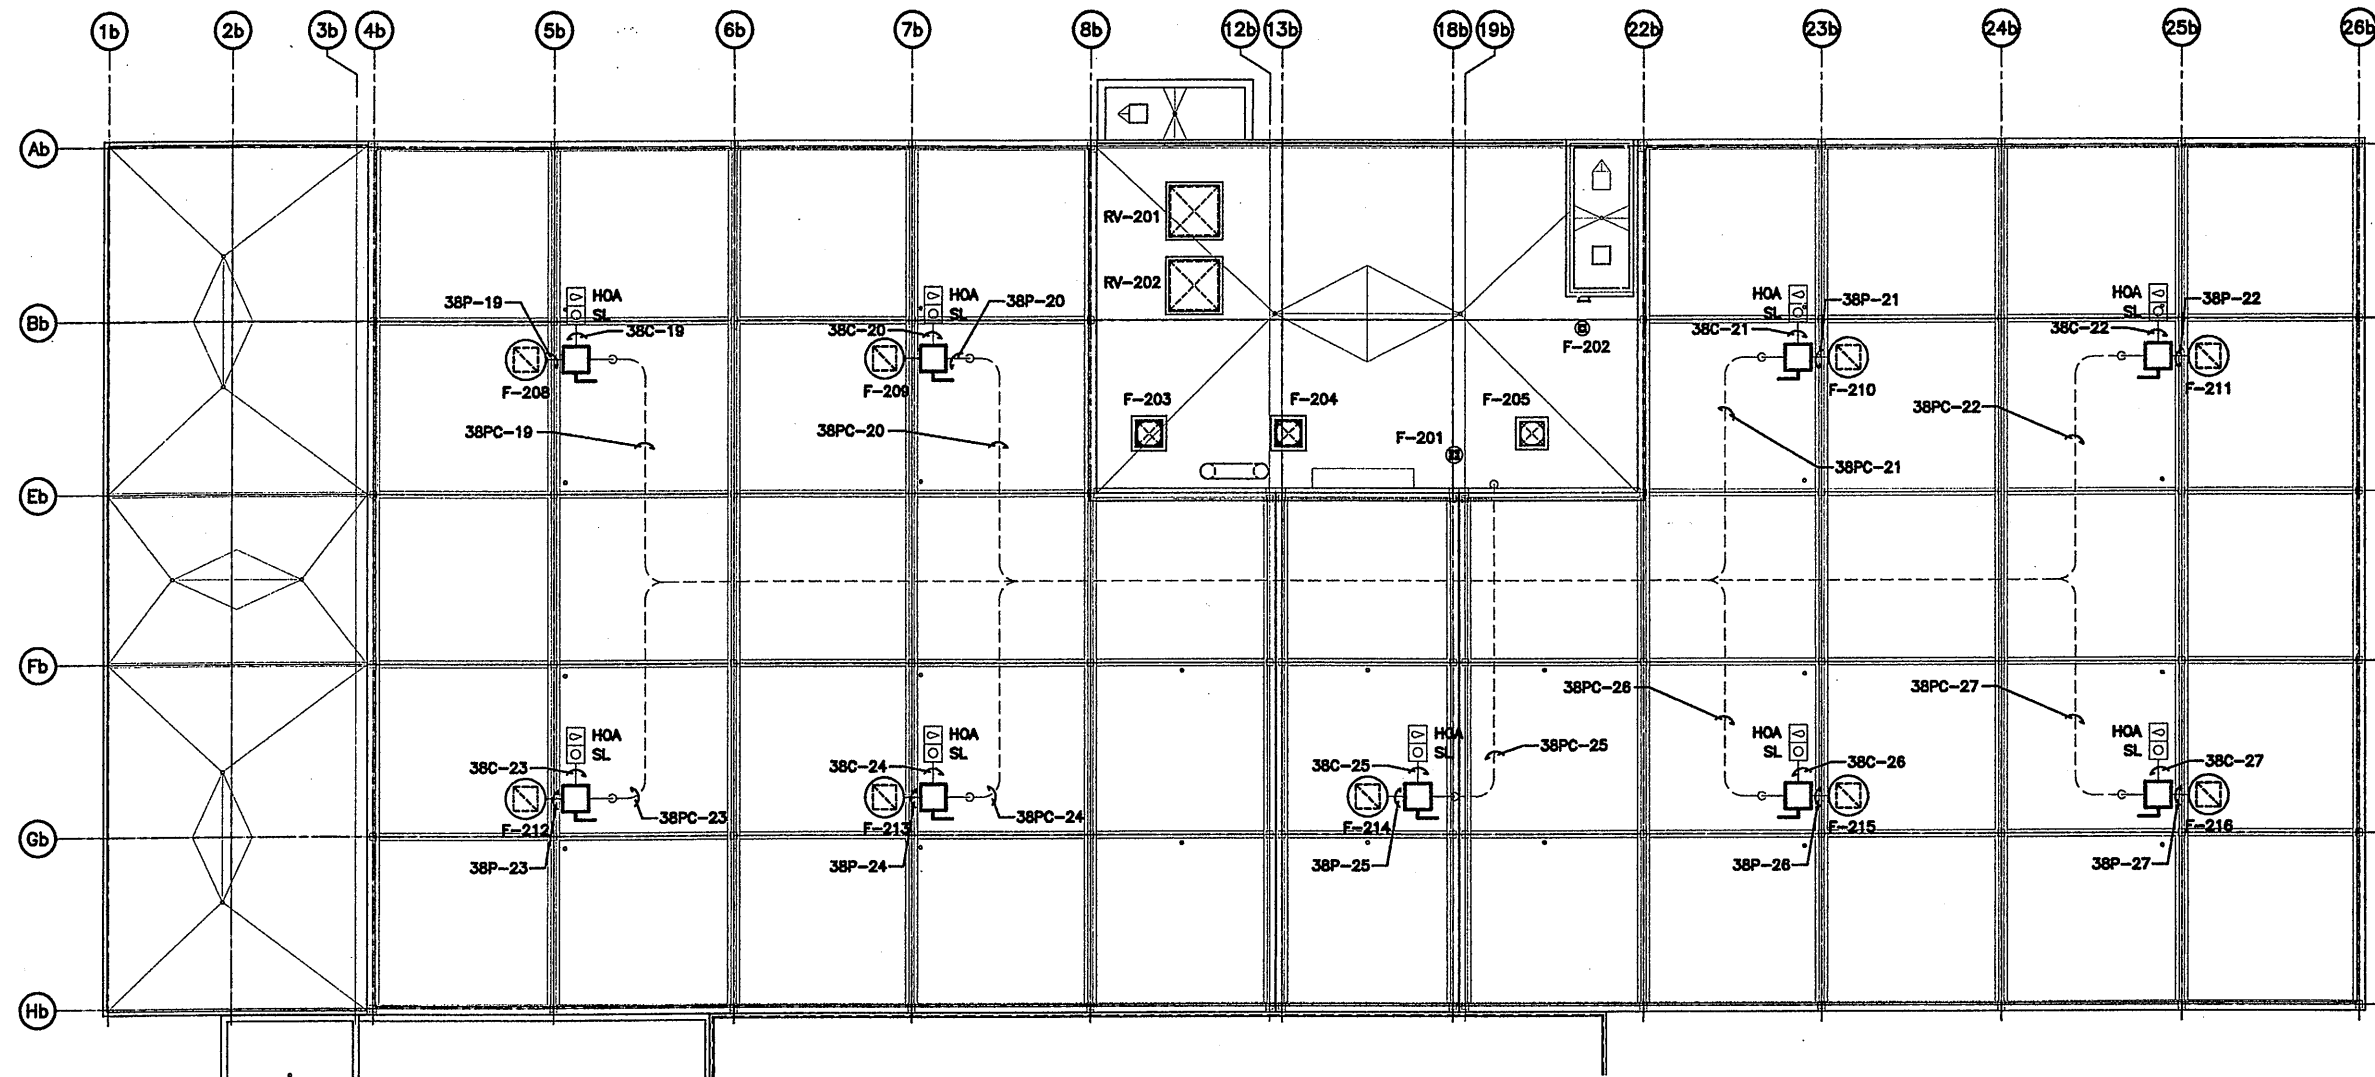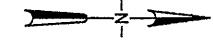


ROOF PLAN
SCALE: 1"=16'-0"

RECORD DRAWING

THESE CHANGES HAVE BEEN MADE TO REFLECT MAJOR CHANGES, IF ANY, WHICH OCCURRED DURING CONSTRUCTION. REVISIONS ARE BASED UPON INFORMATION SUPPLIED BY CONTRACTOR.
DATE: 10/21/05 PER: [Signature]

THIS DRAWING WAS PREPARED AT THE SCALE INDICATED IN THE TITLE BLOCK. INACCURACIES IN THE STATED SCALE MAY BE INTRODUCED WHEN DRAWINGS ARE REPRODUCED BY ANY MEANS. USE THE GRAPHIC SCALE BAR IN THE TITLE BLOCK TO DETERMINE THE ACTUAL SCALE OF THIS DRAWING.

0659E218

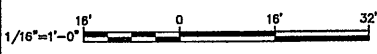


| No. | Date | Revisions | Init |
|-----|----------|----------------|-------------|
| 0 | | AS BID | [Signature] |
| 1 | 10/31/05 | RECORD DRAWING | [Signature] |

In charge of _____
Designed by _____
Drawn by _____
Checked by _____

ENVIRONMENTAL ENGINEERING ASSOCIATES, LLP
SYRACUSE, NEW YORK

ONONDAGA COUNTY • DEPARTMENT OF DRAINAGE AND SANITATION • SYRACUSE, NEW YORK
METROPOLITAN SYRACUSE WASTEWATER TREATMENT PLANT
STAGE III AMMONIA AND STAGE II PHOSPHORUS REMOVAL PROJECT
BAF COMPLEX
ROOF PLAN

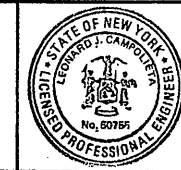

File Number
00659
Date
JULY 2001
[Signature]

E-218

ELECTRICAL

NO ALTERATIONS PERMITTED HEREON EXCEPT AS PROVIDED UNDER SECTION 7209 SUBDIVISION 2 OF THE NEW YORK STATE EDUCATION LAW

SEE MCC O&M MANUAL FOR
EQUIPMENT ELEMENTARY DIAGRAM

RECORD DRAWING

THESE CHANGES HAVE BEEN MADE TO REFLECT
MAJOR CHANGES IF ANY, WHICH OCCURRED DURING
CONSTRUCTION. REVISIONS AND DATED LUNCH
INFORMATION SUPPLIED BY CONTRACTOR.
DATE: 10/21/05 FOR: [Signature]

THIS DRAWING WAS PREPARED AT THE SCALE INDICATED IN THE
TITLE BLOCK. INACCURACIES IN THE STATED SCALE MAY BE
INTRODUCED WHEN DRAWINGS ARE REPRODUCED BY ANY MEANS.
USE THE GRAPHIC SCALE BAR IN THE TITLE BLOCK TO
DETERMINE THE ACTUAL SCALE OF THIS DRAWING.


Layer: ON="*, OFF="*REF"
04/03/01 DBS CRV
05503000/0659E219.DWG

| No. | Date | Revisions | Init |
|-----|----------|----------------|-------------|
| 0 | | AS BID | PLD |
| 1 | 10/31/05 | RECORD DRAWING | [Signature] |
| | | | |
| | | | |
| | | | |

NOT TO SCALE


NO ALTERATIONS PERMITTED HEREON EXCEPT
AS PROVIDED UNDER SECTION 7209 SUBDIVISION
2 OF THE NEW YORK STATE EDUCATION LAW

In charge of _ _ _ PLD _ _ _
Designed by _ _ _ JJC _ _ _
Drawn by _ _ _ CRV _ _ _
Checked by _ _ _ PLD _ _ _





ENVIRONMENTAL ENGINEERING ASSOCIATES, LLP
SYRACUSE, NEW YORK

ONONDAGA COUNTY • DEPARTMENT OF DRAINAGE AND SANITATION • SYRACUSE, NEW YORK
METROPOLITAN SYRACUSE WASTEWATER TREATMENT PLANT
STAGE III AMMONIA AND STAGE II PHOSPHORUS REMOVAL PROJECT
BAF COMPLEX
BAF ELEMENTARY DIAGRAMS
ELECTRICAL



File Number
00659
Date
JULY 2001
E-219
[Signature]

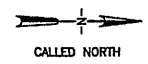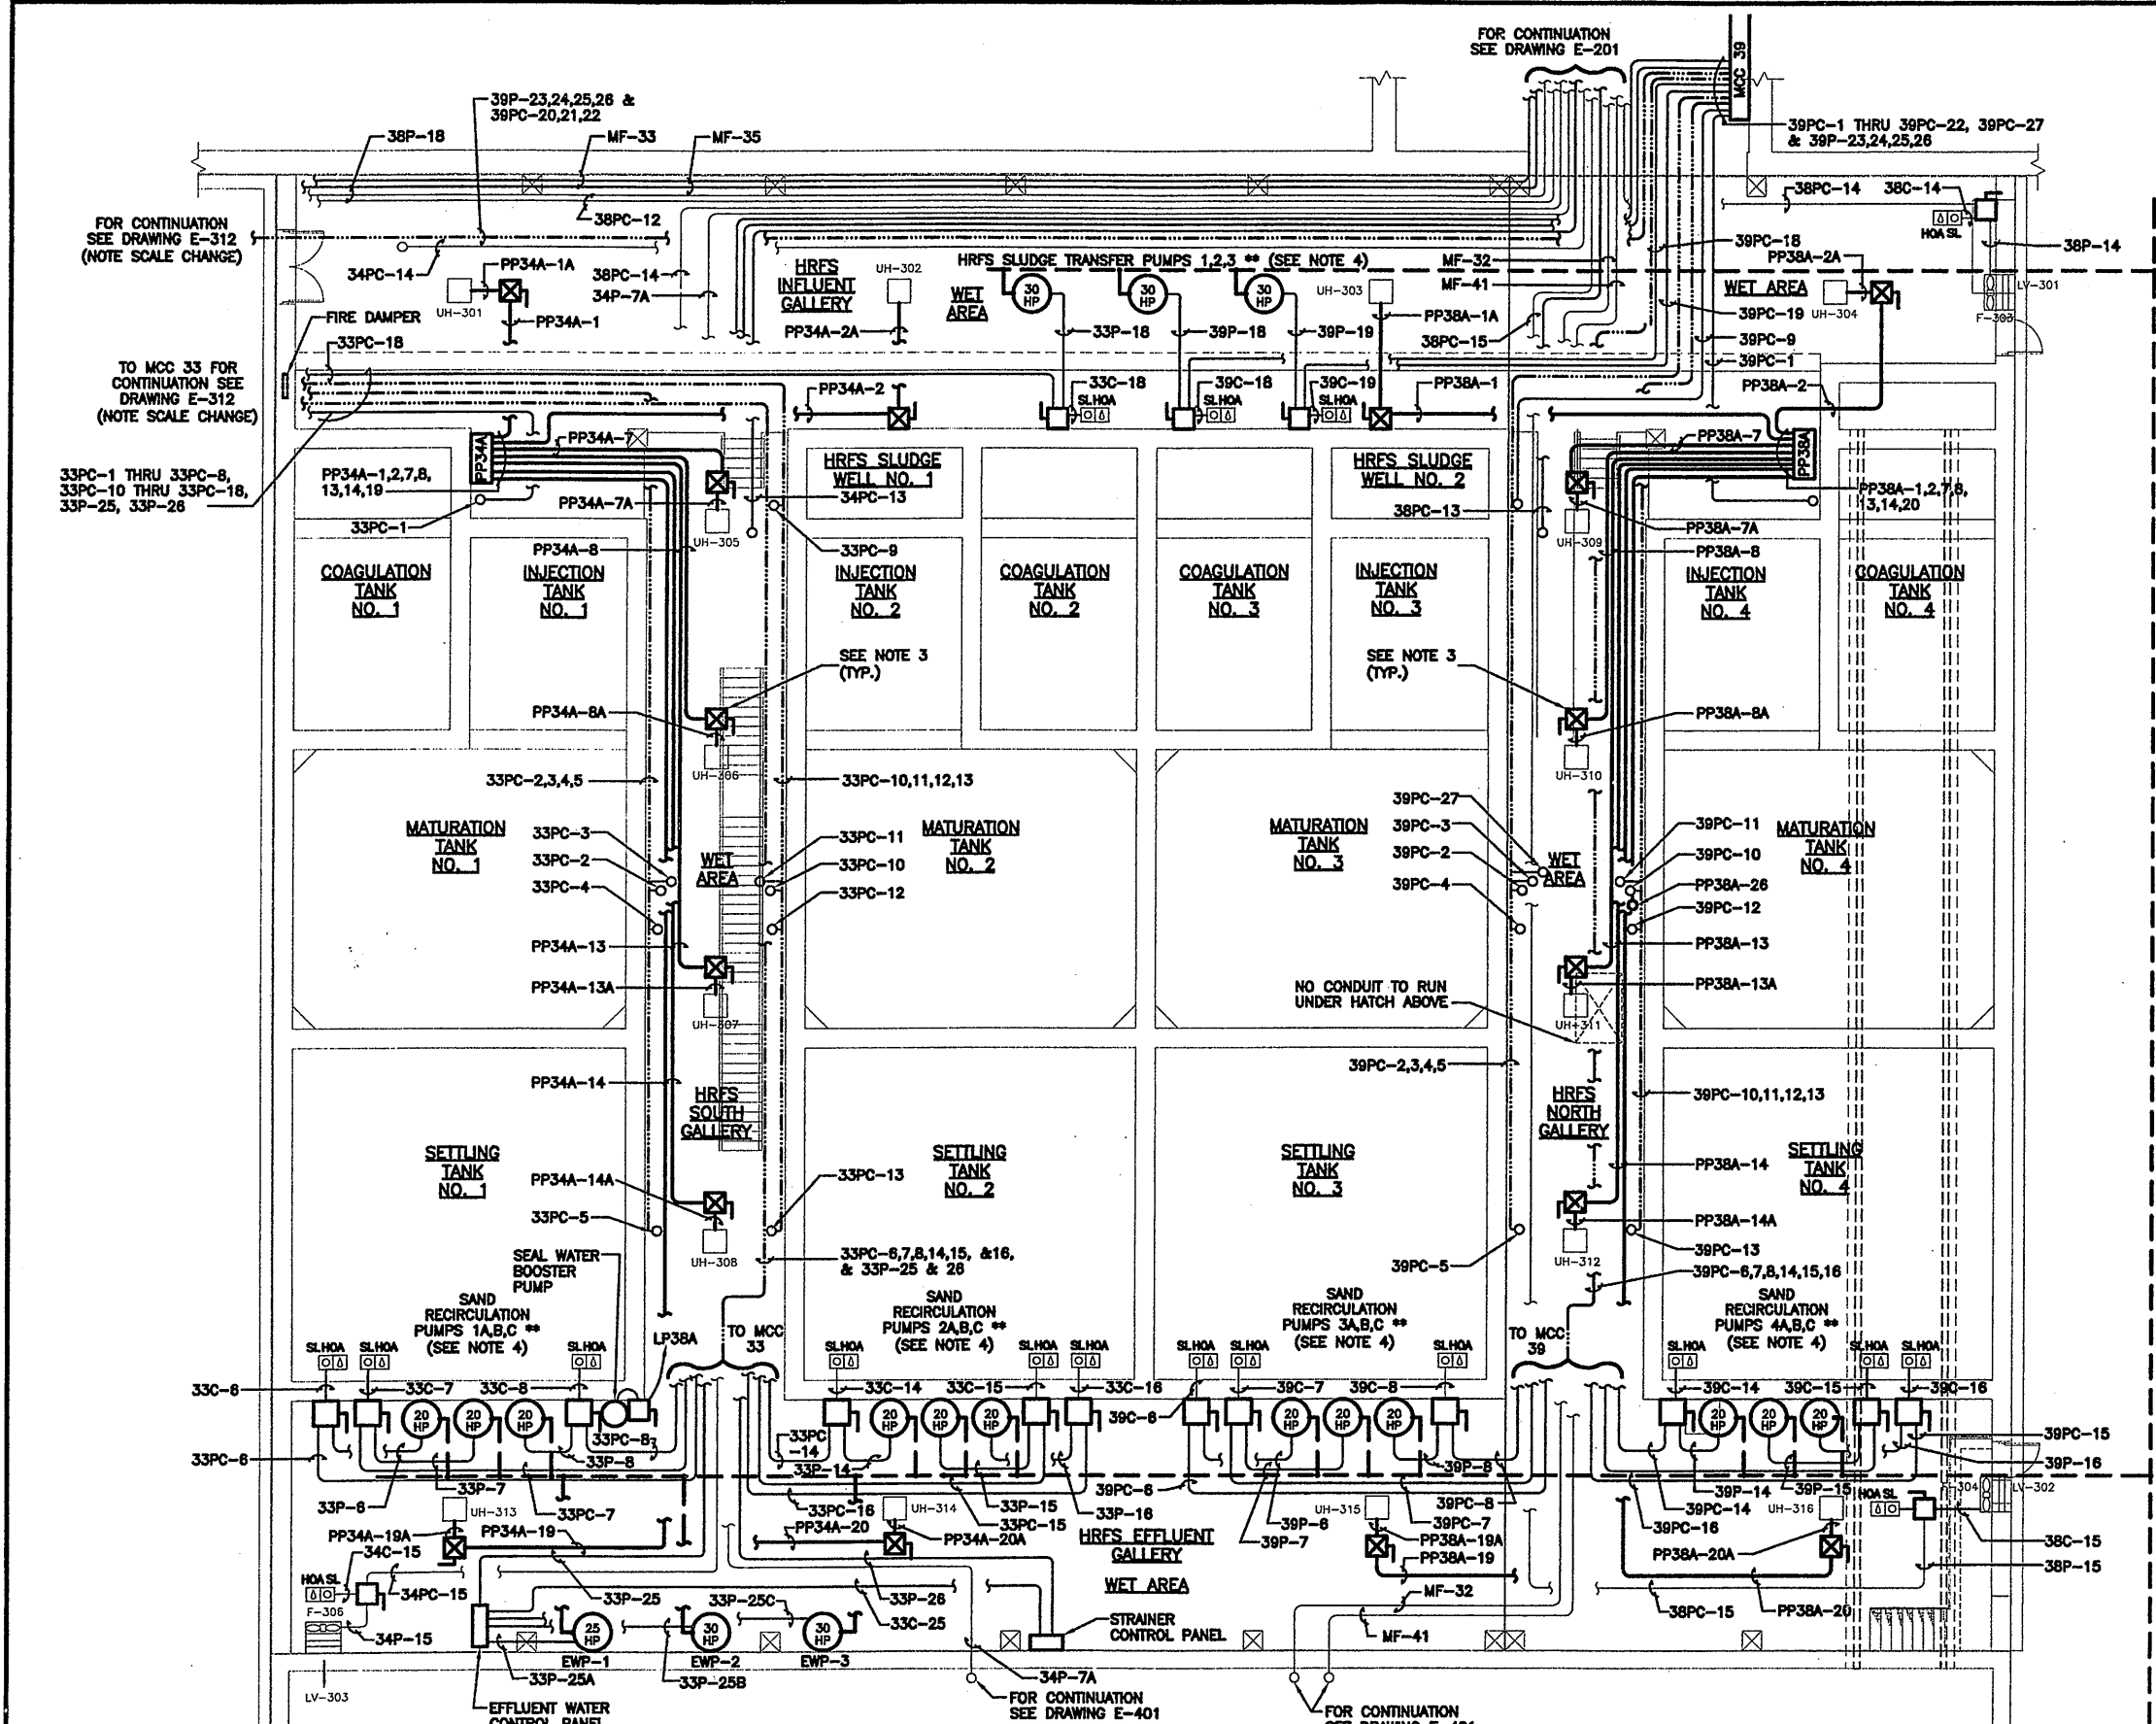

- NOTES:**
- FOR CONDUIT SCHEDULES REFER TO MCC DRAWINGS E-305, E-306, E-307, AND E-308.
 - USE LIQUID-TITE FLEXIBLE CONDUIT, NOT IN EXCESS OF 6 FEET, TO CONNECT TO VIBRATING EQUIPMENT.
 - MOUNT COMBINATION STARTERS FOR UNIT HEATERS ON GALLERY WALL.
 - HRFS SLUDGE TRANSFER PUMPS AND SAND RECIRCULATION PUMPS SHALL HAVE A SEAL WATER SOLENOID AND FLOW SWITCH WIRED AS SHOWN ON MCC ONE-LINE DIAGRAMS.
 - ** INDICATES AN ITEM OR ITEMS SUPPLIED BY OWNER FOR INSTALLATION BY THE CONTRACTOR.
 - REFER TO HVAC DRAWINGS FOR ADDITIONAL LOUVER, DAMPER, THERMOSTAT, CONTROL VALVE, DIRECT DIGITAL CONTROL (DDC), AND OTHER CONTROL HVAC REQUIREMENTS. CONTRACT 4B (ELECTRICAL) SHALL PROVIDE ALL CONDUIT AND CONDUCTORS FOR 120 VOLT CONTROLS, AS SHOWN OR REQUIRED (EXCEPT WIRING BETWEEN DDC SYSTEM COMPONENTS). CONTRACT 4C (HVAC) SHALL PROVIDE ALL CONDUIT AND CONDUCTORS REQUIRED FOR LOW VOLTAGE (LESS THAN 120 VOLT) CONTROLS AND WIRING BETWEEN DDC SYSTEM COMPONENTS INCLUDING BUT NOT LIMITED TO, LOW VOLTAGE T-STAT, VARIABLE AIR VOLUME (VAV) CONTROLS, ETC.
 - DOOR HR102 AND HR105 SHALL EACH BE PROVIDED WITH THE FOLLOWING:
 - 480VAC, 3 PHASE POWER TO DOOR OPERATOR. UTILIZE SPARE 20AMP, 3 POLE CIRCUIT BREAKER IN POWER PANEL PP38A (CIRCUITS 31, 33, 35 AND 32, 34, 36) WITH 3/12, 1#12 GROUND IN 3/4" CONDUIT ROUTED FROM PP38A TO DOOR OPERATOR. PROVIDE A 30AMP, 3 POLE NEMA 4 DISCONNECT SWITCH AT DOOR OPERATOR.
 - 120VAC, 1 PHASE POWER TO DOOR ALARM AND LIGHTS. UTILIZE SPARE 20AMP, 1 POLE CIRCUIT BREAKER (LP38A-31 & 32) AND 2#12, 1#12 GROUND IN 3/4" CONDUIT ROUTED FROM LP38A TO ALARM BELL AND LIGHTS.
 - 2#12 IN 3/4" CONDUIT FROM DOOR OPERATOR TO DOOR ALARM BELL AND LIGHT.
 - 2#14 IN 3/4" CONDUIT FROM DOOR OPERATOR TO DOOR SENSING EDGE JUNCTION BOX.
 - 2#14 IN 3/4" CONDUIT FROM DOOR OPERATOR TO DOOR GUIDE INTERLOCK SWITCHES (TYPICAL TWO EACH DOOR).
 - 3#14 IN 3/4" CONDUIT FROM DOOR OPERATOR TO INTERIOR MOUNTED PUSHBUTTON STATION AND 4#14 IN 3/4" CONDUIT FROM INTERIOR MOUNTED PUSHBUTTON STATION TO EXTERIOR MOUNTED PUSHBUTTON STATION.

- COMPLETE INSTALLATION OF TWO ADDITIONAL LEVEL FLOAT SWITCHES IN HRFS SLUDGE WELL NO.1 (FURNISHED BY CONTRACT 1B). SWITCHES SHALL BE DESIGNATED LSHH-30081 AND LSL-30081. ELEVATIONS SHALL BE AS SUMMARIZED IN THE TABLE BELOW. PROVIDE CONNECTION OF EACH SWITCH TO DEVCENET INTERFACE MODULE HDN5, N3 WITH 2#14 IN 3/4" CONDUIT.
- COMPLETE INSTALLATION OF FOUR LEVEL FLOAT SWITCHES IN HRFS SLUDGE WELL NO. 2 (FURNISHED BY CONTRACT 1B). SWITCHES SHALL BE DESIGNATED LSHH-30084, LSH-30084, LSL-30084 AND LSL-30084. ELEVATIONS SHALL BE AS SUMMARIZED IN THE TABLE BELOW. PROVIDE CONNECTION OF EACH SWITCH TO DEVCENET INTERFACE MODULE (ITEM C BELOW) WITH 2#14 IN 3/4" CONDUIT.
- COMPLETE INSTALLATION OF DEVCENET INTERFACE MODULE (FURNISHED BY CONTRACT 1B) ADJACENT TO HRFS SLUDGE WELL NO. 2 IN THE HRFS NORTH GALLERY. PROVIDE CONNECTION OF MODULE TO DEVCENET NETWORK 5 DOWNSTREAM OF MODULE HDN5, N3. PROVIDE TWO BELDEN 3083A IN 1" CONDUIT ROUTED FROM HDN5, N3 TO HRFS SLUDGE WELL NO. 2 DEVCENET INTERFACE MODULE TO FACILITATE CONNECTION.
- FLOAT LEVEL SWITCH ELEVATIONS:

| ALARM TYPE | ELEVATION |
|------------------|-----------|
| HIGH LEVEL ALARM | 391.50 |
| PUMP ON | 390.50 |
| PUMP OFF | 389.50 |
| LOW LEVEL ALARM | 379.50 |

RECORD DRAWING

THESE DRAWINGS HAVE BEEN REVISIONED TO REFLECT MAJOR CHANGES OF ANY KIND WHICH OCCURRED DURING CONSTRUCTION. REVISIONS ARE SHOWN UPON INFORMATION SUPPLIED BY CONTRACTOR.

DATE: 10/15/05 PER: [Signature]

THIS DRAWING WAS PREPARED AT THE SCALE INDICATED IN THE TITLE BLOCK. INACCURACIES IN THE STATED SCALE MAY BE INTRODUCED WHEN DRAWINGS ARE REPRODUCED BY ANY MEANS. USE THE GRAPHIC SCALE BAR IN THE TITLE BLOCK TO DETERMINE THE ACTUAL SCALE OF THIS DRAWING.

Layer: ON=*, OFF=*REF*
X: 0659X301.DWG
4/23/01 BBL DCC
05503000/0659E301.DWG

NO ALTERATIONS PERMITTED HEREON EXCEPT AS PROVIDED UNDER SECTION 7209 SUBDIVISION 2 OF THE NEW YORK STATE EDUCATION LAW

| No. | Date | Revisions | Init |
|-----|----------|---------------------|------|
| 0 | 4/20/01 | ISSUED FOR APPROVAL | |
| 1 | | AS BID | |
| 2 | 10/31/05 | RECORD DRAWING | |

In charge of TEL
Designed by MEE
Drawn by DCC
Checked by WFH

ENVIRONMENTAL ENGINEERING ASSOCIATES, LLP
SYRACUSE, NEW YORK



ONONDAGA COUNTY • DEPARTMENT OF DRAINAGE AND SANITATION • SYRACUSE, NEW YORK
METROPOLITAN SYRACUSE WASTEWATER TREATMENT PLANT
STAGE III AMMONIA AND STAGE II PHOSPHORUS REMOVAL PROJECT
HRFS COMPLEX
HRFS LOWER LEVEL POWER PLAN

FILE NUMBER: 00659
DATE: APRIL 2001
E-301

STATE OF NEW YORK
LICENSED PROFESSIONAL ENGINEER
No. 00765

[Signature]

ELECTRICAL

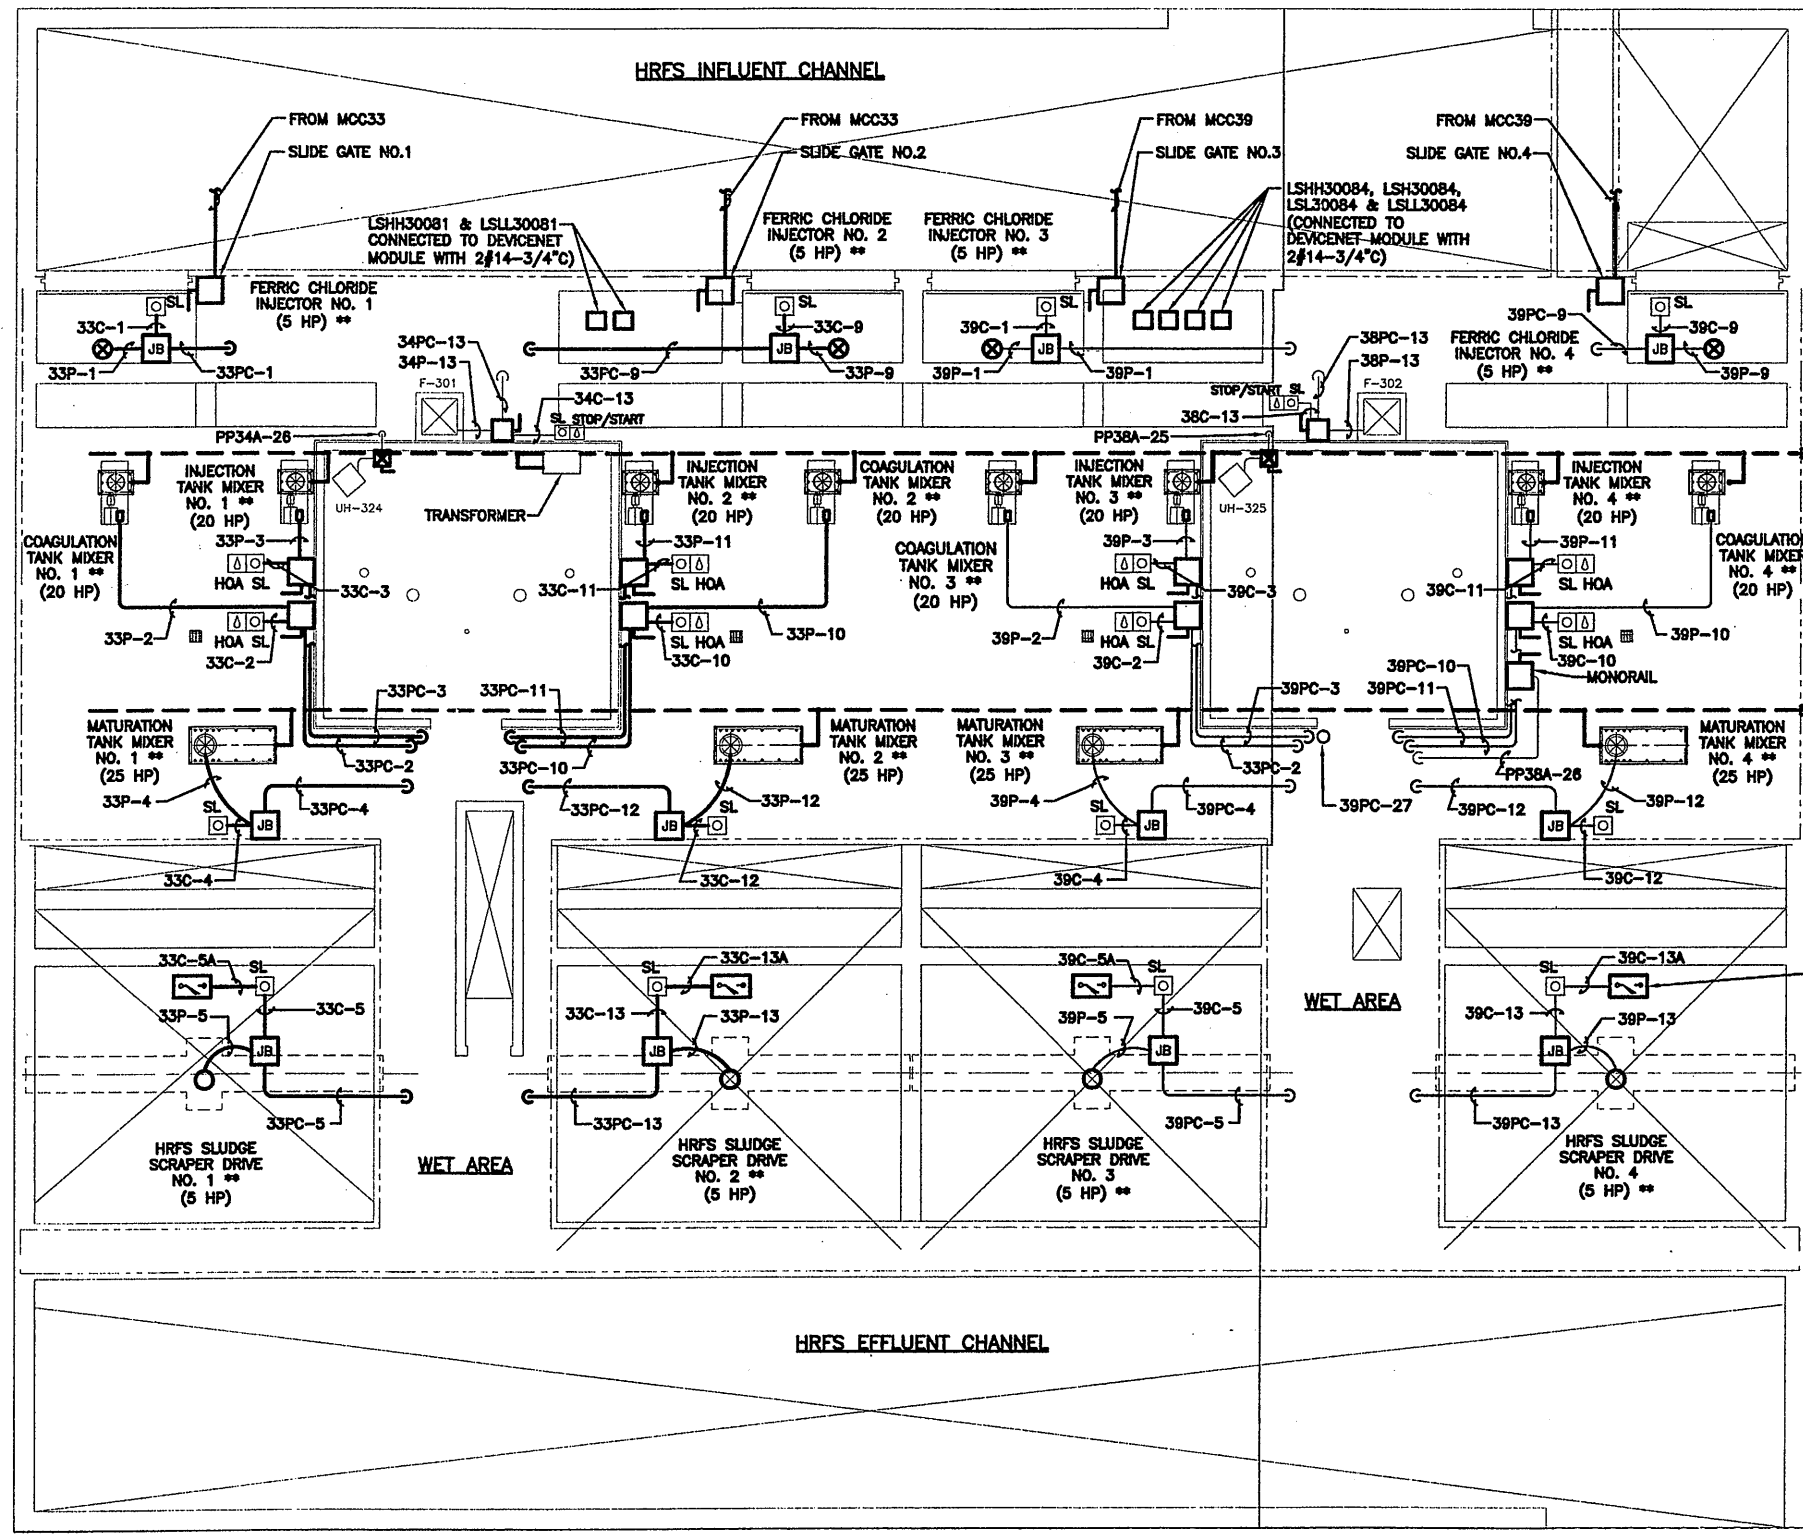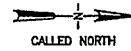

CONCEAL GROUND CONDUCTOR WITHIN BUILDING BLOCK AND CONCRETE DECK (TYP.)

GROUND GRID

HIGH TORQUE ALARM & SHUT-OFF SWITCH ** (TYP.)


- NOTES:**
- FOR CONDUIT SCHEDULES REFER TO MCC DRAWINGS E-305, E-306, E-307, AND E-308.
 - USE LIQUID-TITE FLEXIBLE CONDUIT, NOT IN EXCESS OF 3 FEET, TO CONNECT TO VIBRATING EQUIPMENT.
 - ** INDICATES AN ITEM OR ITEMS SUPPLIED BY OWNER FOR INSTALLATION BY THE CONTRACTOR.

HRFS UPPER LEVEL POWER PLAN
SCALE: 1/8"=1'-0"

RECORD DRAWING
 THESE DRAWINGS HAVE BEEN REVIEWED TO REFLECT
 MAKE CHANGES, IF ANY, WHICH OCCURRED DURING
 CONSTRUCTION. REVISIONS ARE BASED UPON
 INFORMATION SUPPLIED BY CONTRACTOR.
 DATE: 10/21/05 FOR: Campbell

THIS DRAWING WAS PREPARED AT THE SCALE INDICATED IN THE
 TITLE BLOCK. INACCURACIES IN THE STATED SCALE MAY BE
 INTRODUCED WHEN DRAWINGS ARE REPRODUCED BY ANY MEANS.
 USE THE GRAPHIC SCALE BAR IN THE TITLE BLOCK TO
 DETERMINE THE ACTUAL SCALE OF THIS DRAWING.

Layer: ON=; OFF=REF*
 X: 0659A302.DWG
 4/13/01 BSL DCC
 06503000/0659E302.DWG

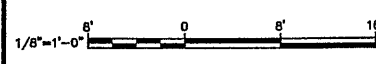

NO ALTERATIONS PERMITTED HEREON EXCEPT
 AS PROVIDED UNDER SECTION 7209 SUBDIVISION
 2 OF THE NEW YORK STATE EDUCATION LAW

| No. | Date | Revisions | Init |
|-----|----------|---------------------|------|
| 0 | 4/20/01 | ISSUED FOR APPROVAL | Ue |
| 1 | | AS BID | |
| 2 | 10/31/05 | RECORD DRAWING | |

In charge of TEL
 Designed by MEE
 Drawn by DCC
 Checked by WFH






ONONDAGA COUNTY • DEPARTMENT OF DRAINAGE AND SANITATION • SYRACUSE, NEW YORK
 METROPOLITAN SYRACUSE WASTEWATER TREATMENT PLANT
 STAGE III AMMONIA AND STAGE II PHOSPHORUS REMOVAL PROJECT
HRFS COMPLEX
HRFS UPPER LEVEL POWER PLAN



File Number
 00659
 Date
 APRIL 2001
 E-302
 Campbell


ELECTRICAL

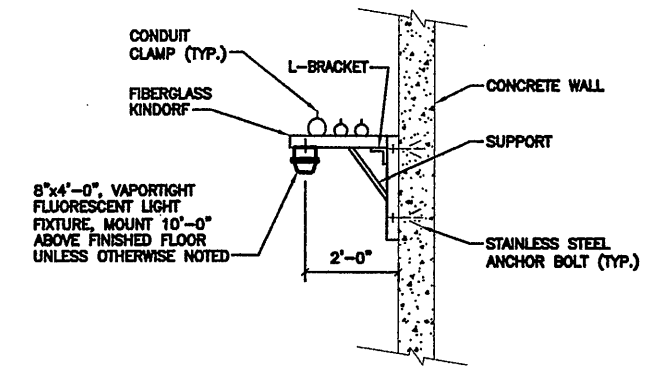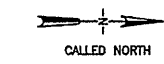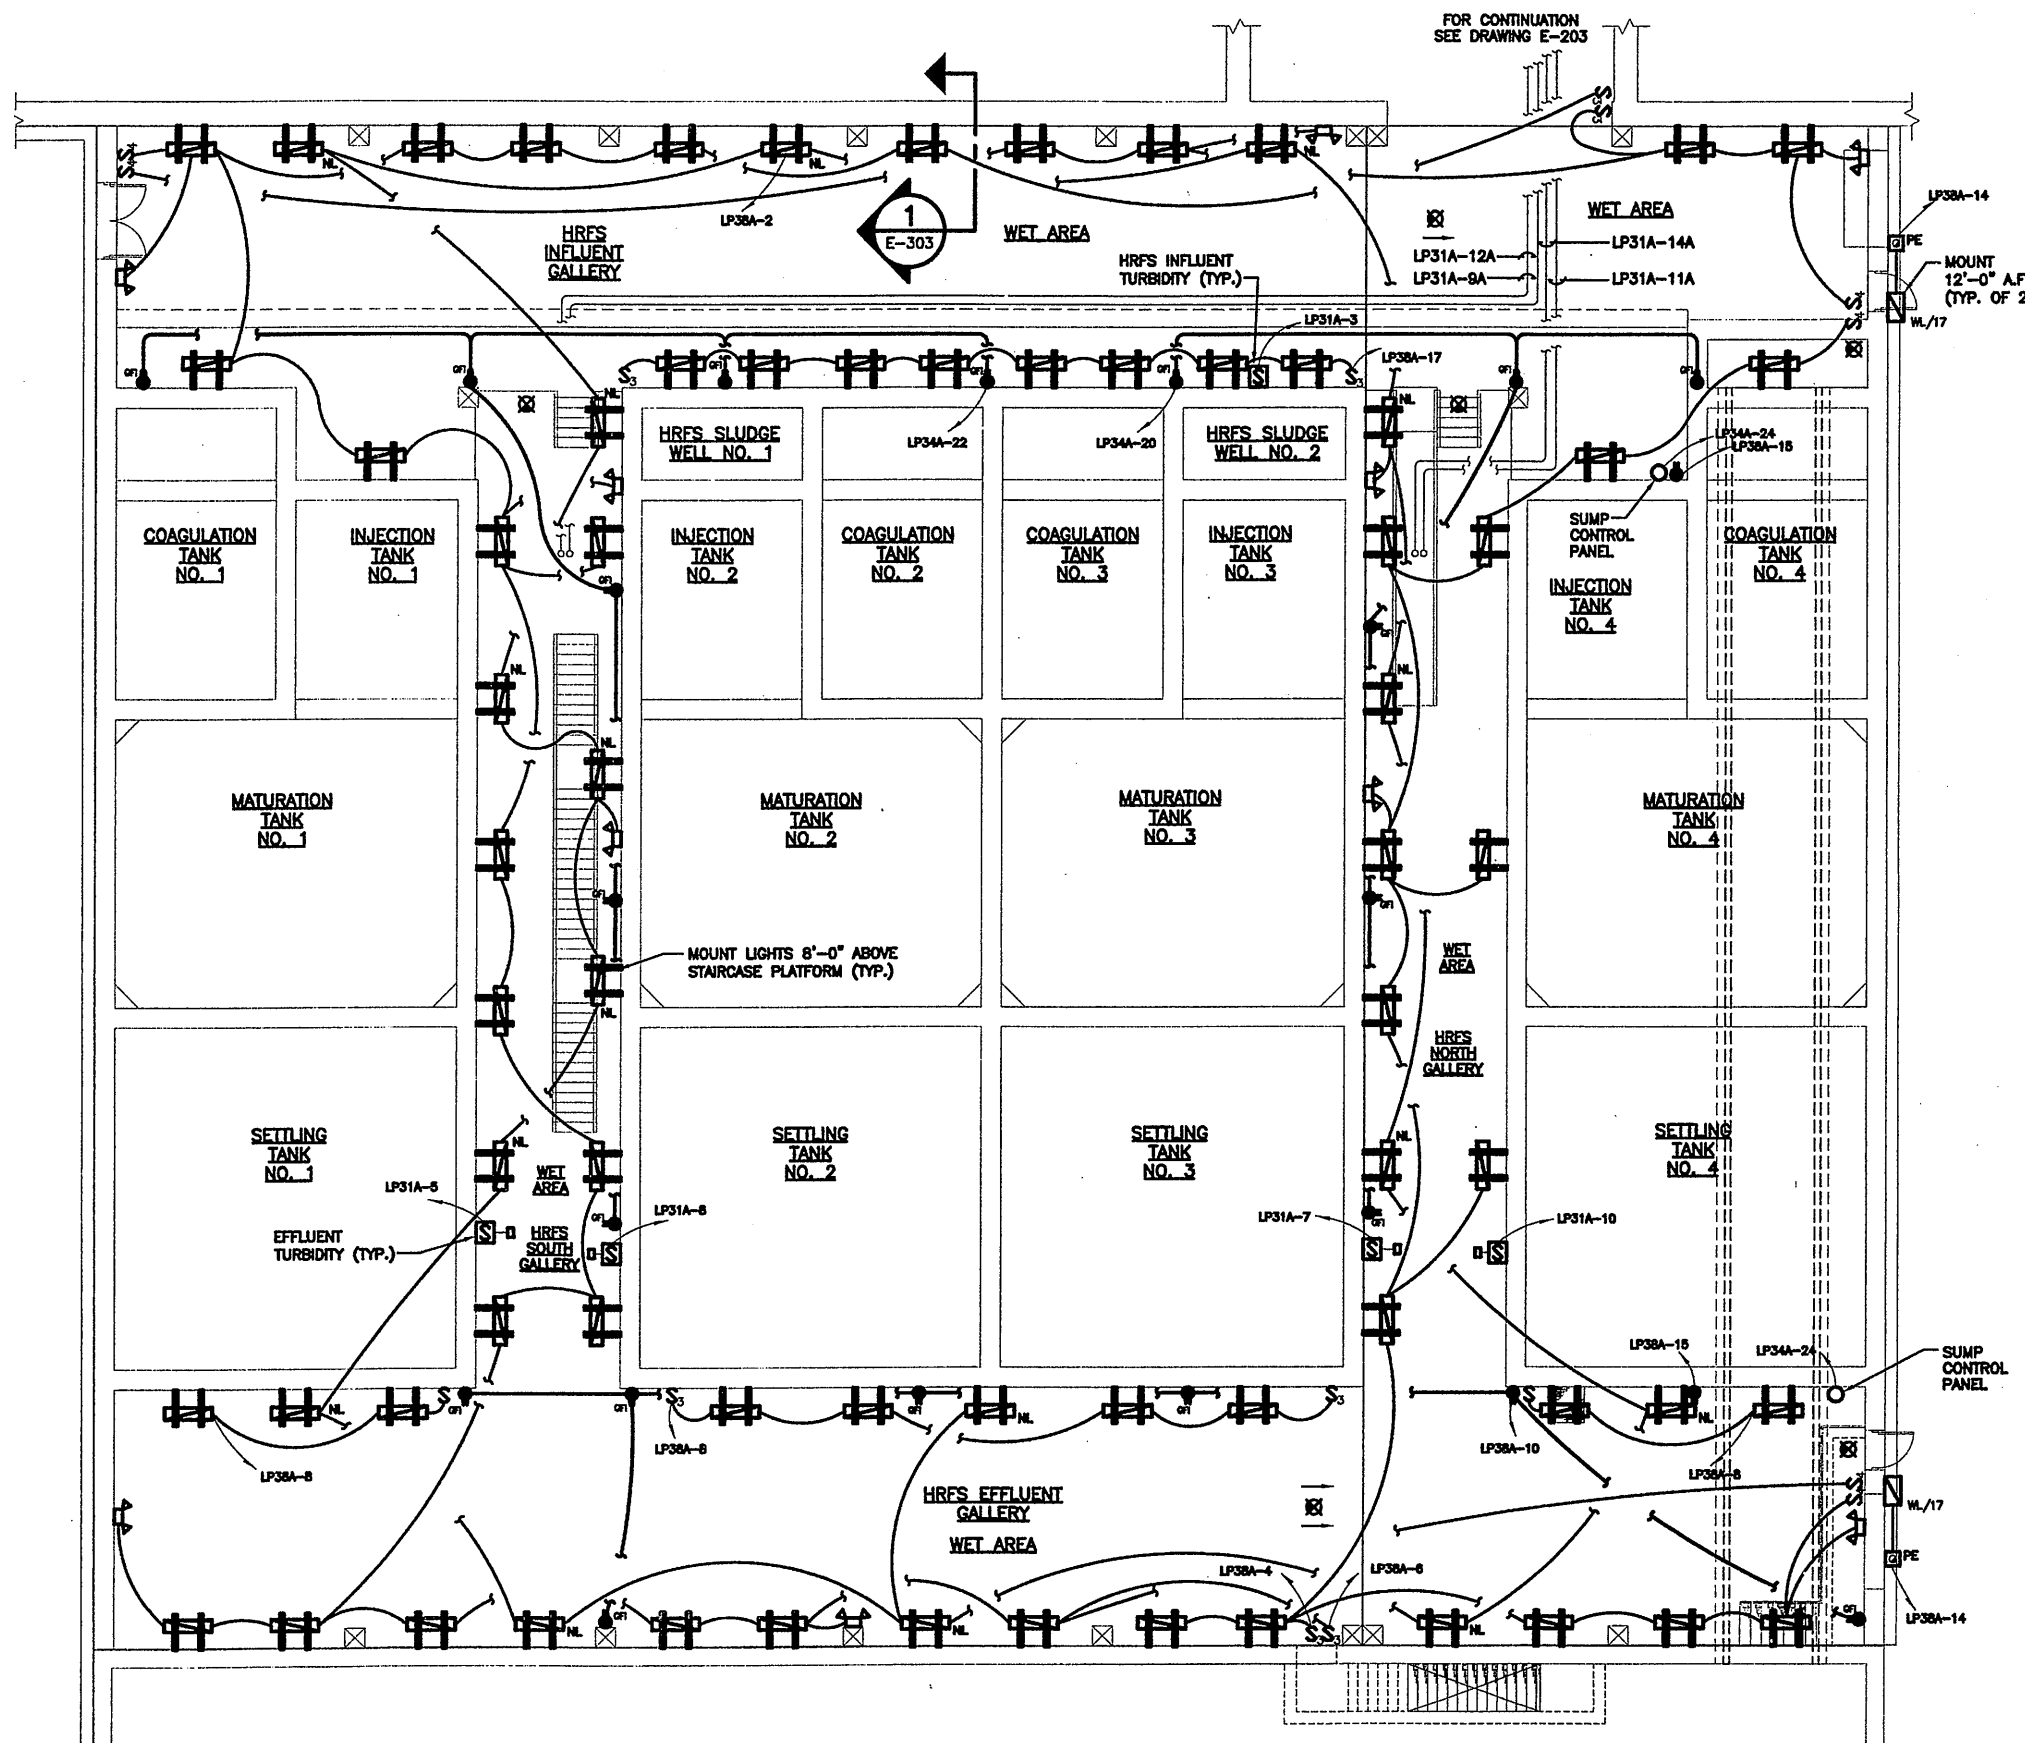

SECTION 1
NOT TO SCALE
E-303

HRFS LOWER LEVEL LIGHTING PLAN
SCALE: 1/8"=1'-0"

Layer: ON=*, OFF=*REF*
X: 0659X301.DWG
4/4/01 BBL DCC
05503000/0659E303.DWG

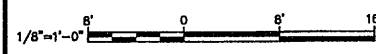

NO ALTERATIONS PERMITTED HEREON EXCEPT AS PROVIDED UNDER SECTION 7209 SUBDIVISION 2 OF THE NEW YORK STATE EDUCATION LAW

| No. | Date | Revisions | Init |
|-----|----------|---------------------|------|
| 0 | 4/20/01 | ISSUED FOR APPROVAL | Ue |
| 1 | | AS BID | |
| 2 | 10/31/05 | RECORD DRAWING | |

In charge of **TEL**
Designed by **MEE**
Drawn by **DCC**
Checked by **WFH**



ONONDAGA COUNTY • DEPARTMENT OF DRAINAGE AND SANITATION • SYRACUSE, NEW YORK
METROPOLITAN SYRACUSE WASTEWATER TREATMENT PLANT
STAGE III AMMONIA AND STAGE II PHOSPHORUS REMOVAL PROJECT
HRFS COMPLEX
HRFS LOWER LEVEL LIGHTING PLAN





File Number
00659
Date
APRIL 2001
E-303

RECORD DRAWING
THESE CHANGES HAVE BEEN MADE TO REFLECT MAJOR CHANGES OF ANY KIND OCCURRED DURING CONSTRUCTION. REVISIONS ARE BASED UPON INFORMATION SUPPLIED BY CONTRACTOR.
DATE: 10/21/05 PER: [Signature]

THIS DRAWING WAS PREPARED AT THE SCALE INDICATED IN THE TITLE BLOCK. INACCURACIES IN THE STATED SCALE MAY BE INTRODUCED WHEN DRAWINGS ARE REPRODUCED BY ANY MEANS. USE THE GRAPHIC SCALE BAR IN THE TITLE BLOCK TO DETERMINE THE ACTUAL SCALE OF THIS DRAWING.

ELECTRICAL

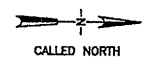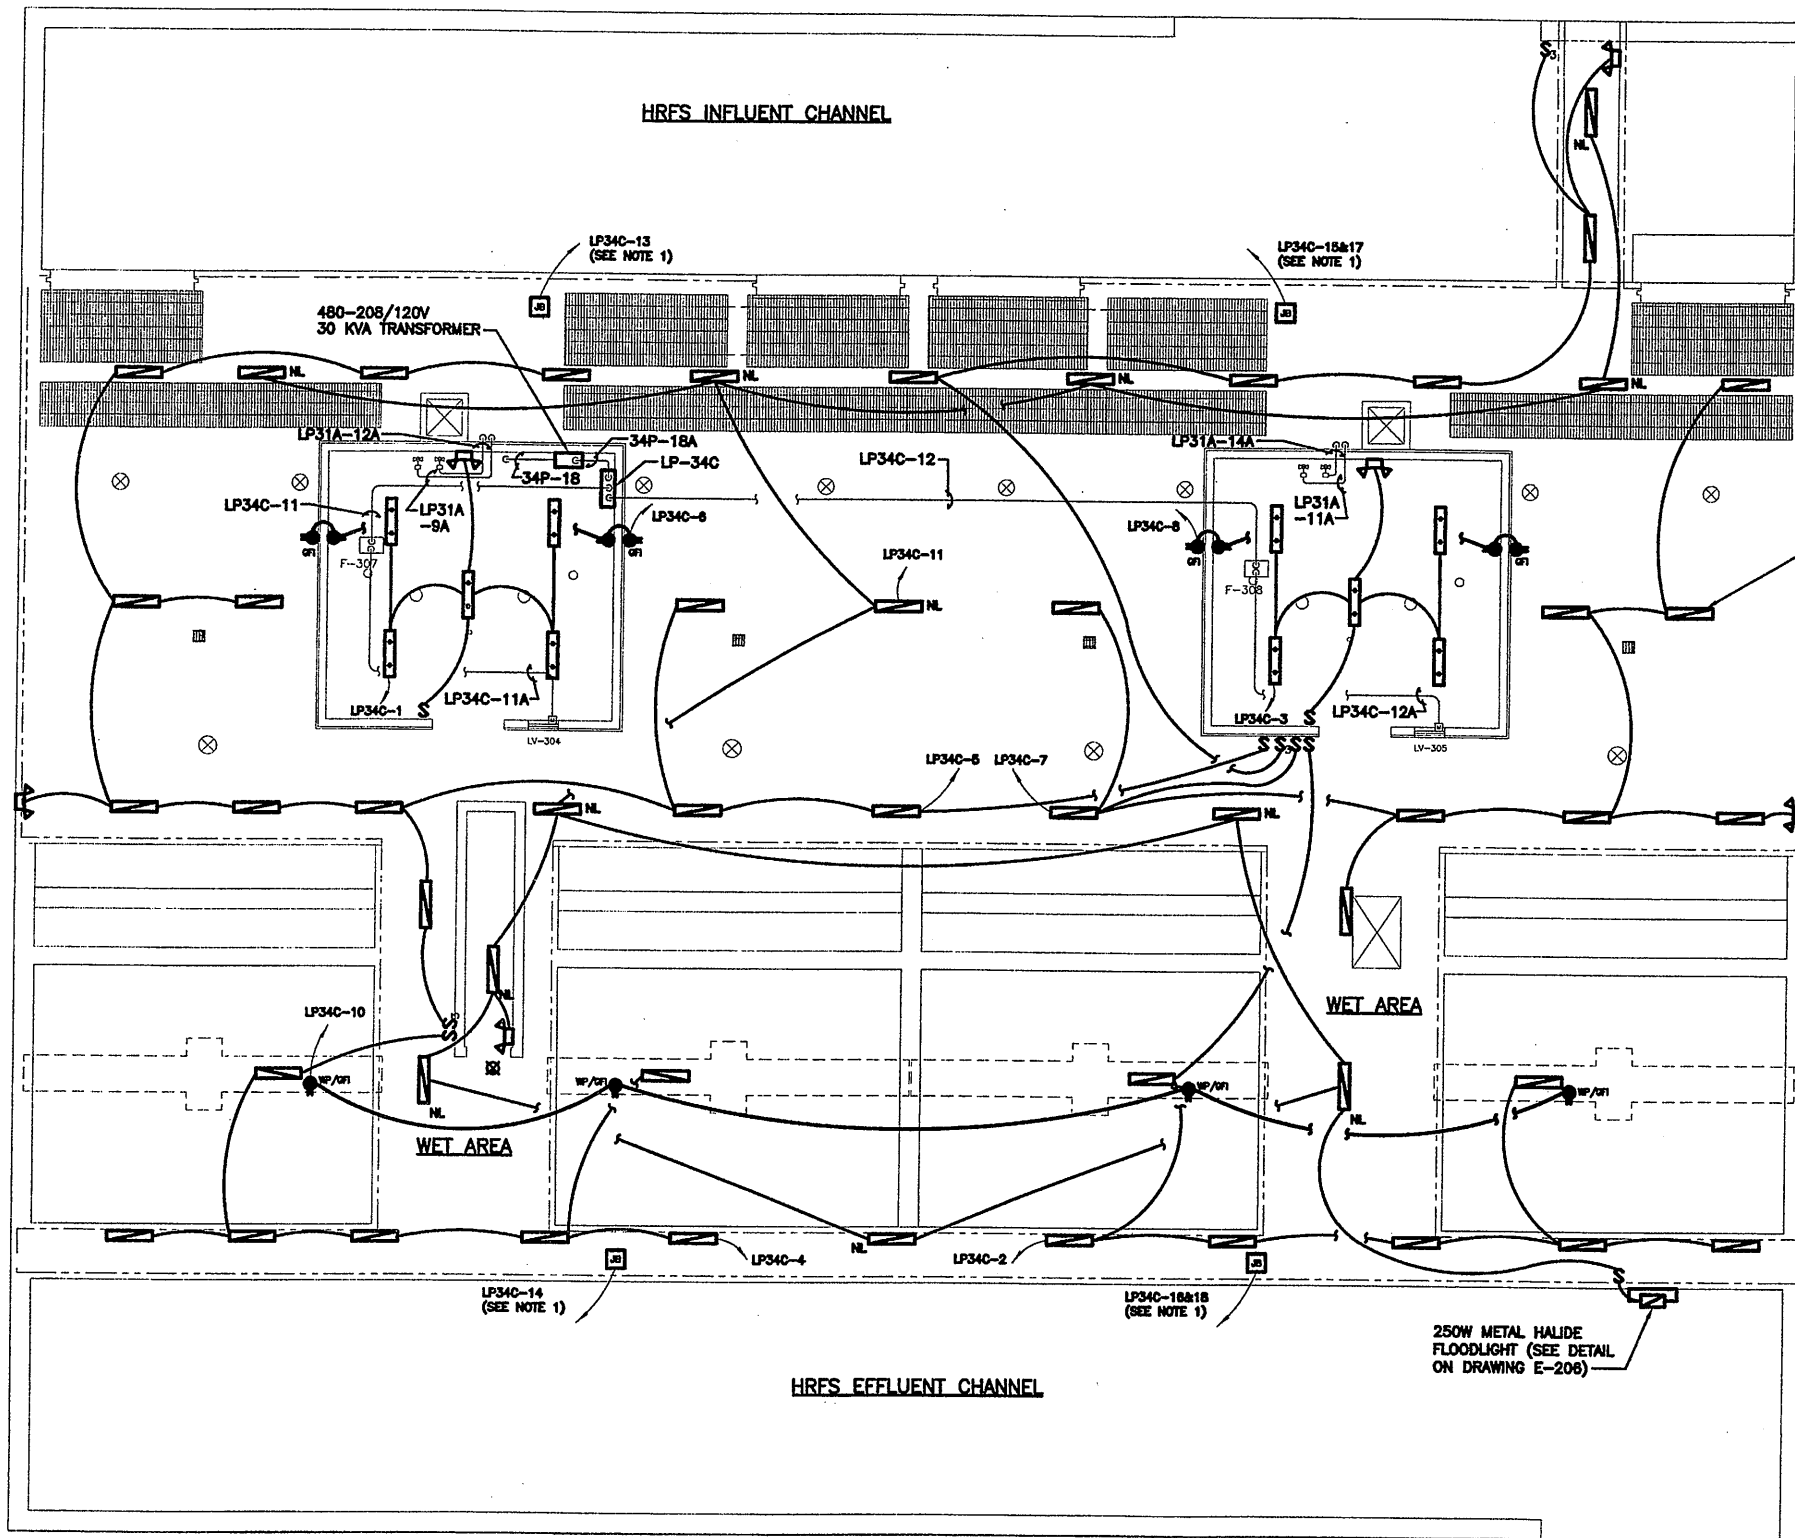

HRFS UPPER LIGHTING PLAN

SCALE: 1/8"=1'-0"

NOTE:
 1. CONTRACTOR SHALL FURNISH AND INSTALL MULTIPLE HEAT TRACE CIRCUITS FOR THE ROOF DRAIN PIPING. COORDINATE LOCATIONS IN FIELD. SEE DRAWING P-302.

RECORD DRAWING
 THESE DRAWINGS HAVE BEEN REVISIONED TO REFLECT MAJOR CHANGES, IF ANY, WHICH OCCURRED DURING CONSTRUCTION. REVISIONS ARE BASED UPON INFORMATION SUPPLIED BY CONTRACTOR.
 DATE: 10/21/05 PER: [Signature]

THIS DRAWING WAS PREPARED AT THE SCALE INDICATED IN THE TITLE BLOCK. INACCURACIES IN THE STATED SCALE MAY BE INTRODUCED WHEN DRAWINGS ARE REPRODUCED BY ANY MEANS. USE THE GRAPHIC SCALE BAR IN THE TITLE BLOCK TO DETERMINE THE ACTUAL SCALE OF THIS DRAWING.

Layer: ON=*; OFF=*REF*
 X: 0659X302.DWG
 4/11/01 BBL DCC
 05503000/0659E304.DWG

1/8"=1'-0"
 NO ALTERATIONS PERMITTED HEREON EXCEPT AS PROVIDED UNDER SECTION 7209 SUBDIVISION 2 OF THE NEW YORK STATE EDUCATION LAW

| No. | Date | Revisions | Init |
|-----|----------|---------------------|-------------|
| 0 | 4/20/01 | ISSUED FOR APPROVAL | [Signature] |
| 1 | | AS BID | |
| 2 | 10/31/05 | RECORD DRAWING | |

In charge of TEL
 Designed by MEE
 Drawn by DCC
 Checked by WFH



ONONDAGA COUNTY • DEPARTMENT OF DRAINAGE AND SANITATION • SYRACUSE, NEW YORK
 METROPOLITAN SYRACUSE WASTEWATER TREATMENT PLANT
 STAGE III AMMONIA AND STAGE II PHOSPHORUS REMOVAL PROJECT
HRFS COMPLEX
HRFS UPPER LEVEL LIGHTING PLAN




File Number: 00659
 Date: APRIL 2001
 [Signature]


E-304

ELECTRICAL


MCC 33 - CHEMICAL BUILDING C ELECTRIC ROOM (HRFS 1 & 2)

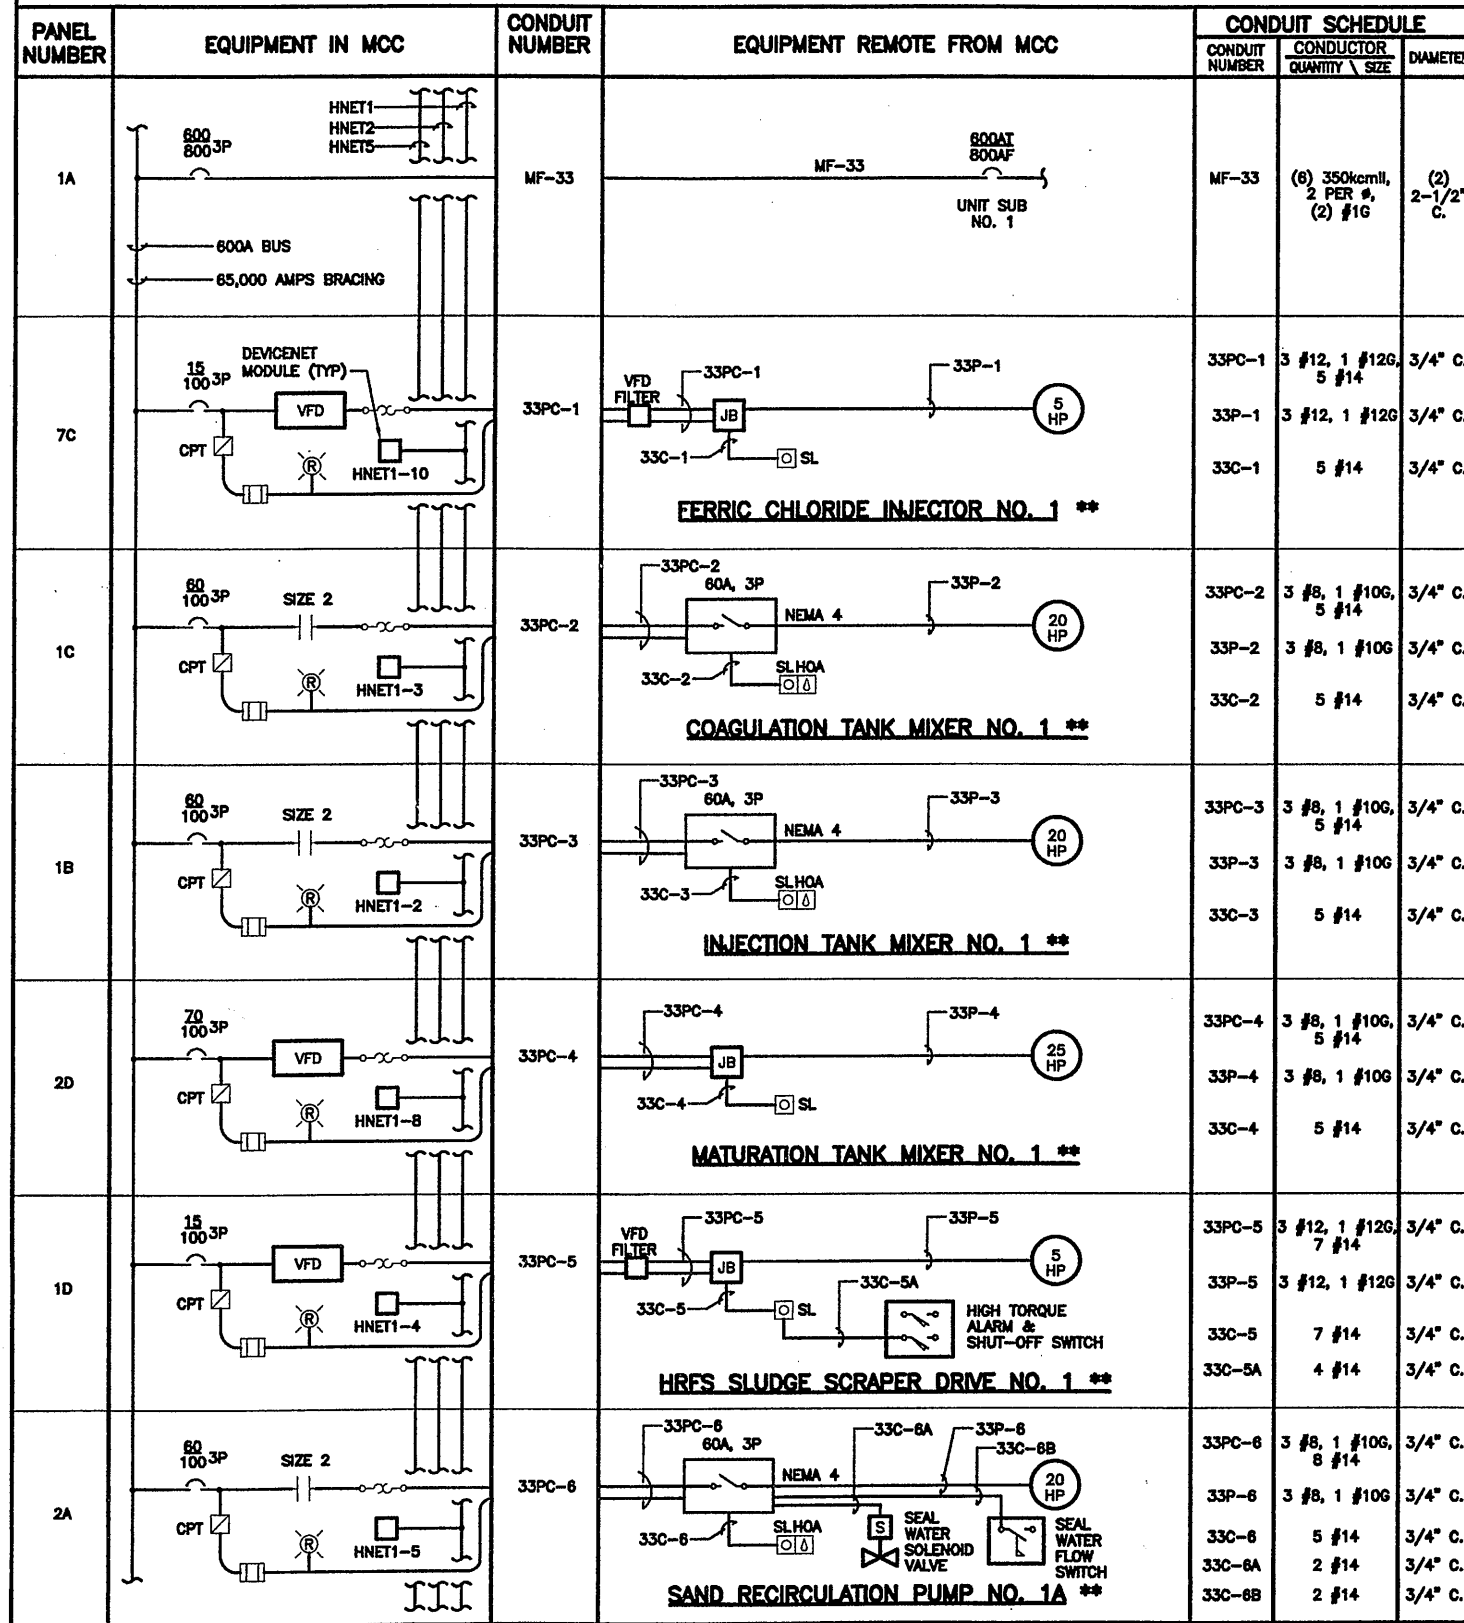

MCC 33 - CHEMICAL BUILDING C ELECTRIC ROOM (HRFS 1 & 2 CONTINUED)

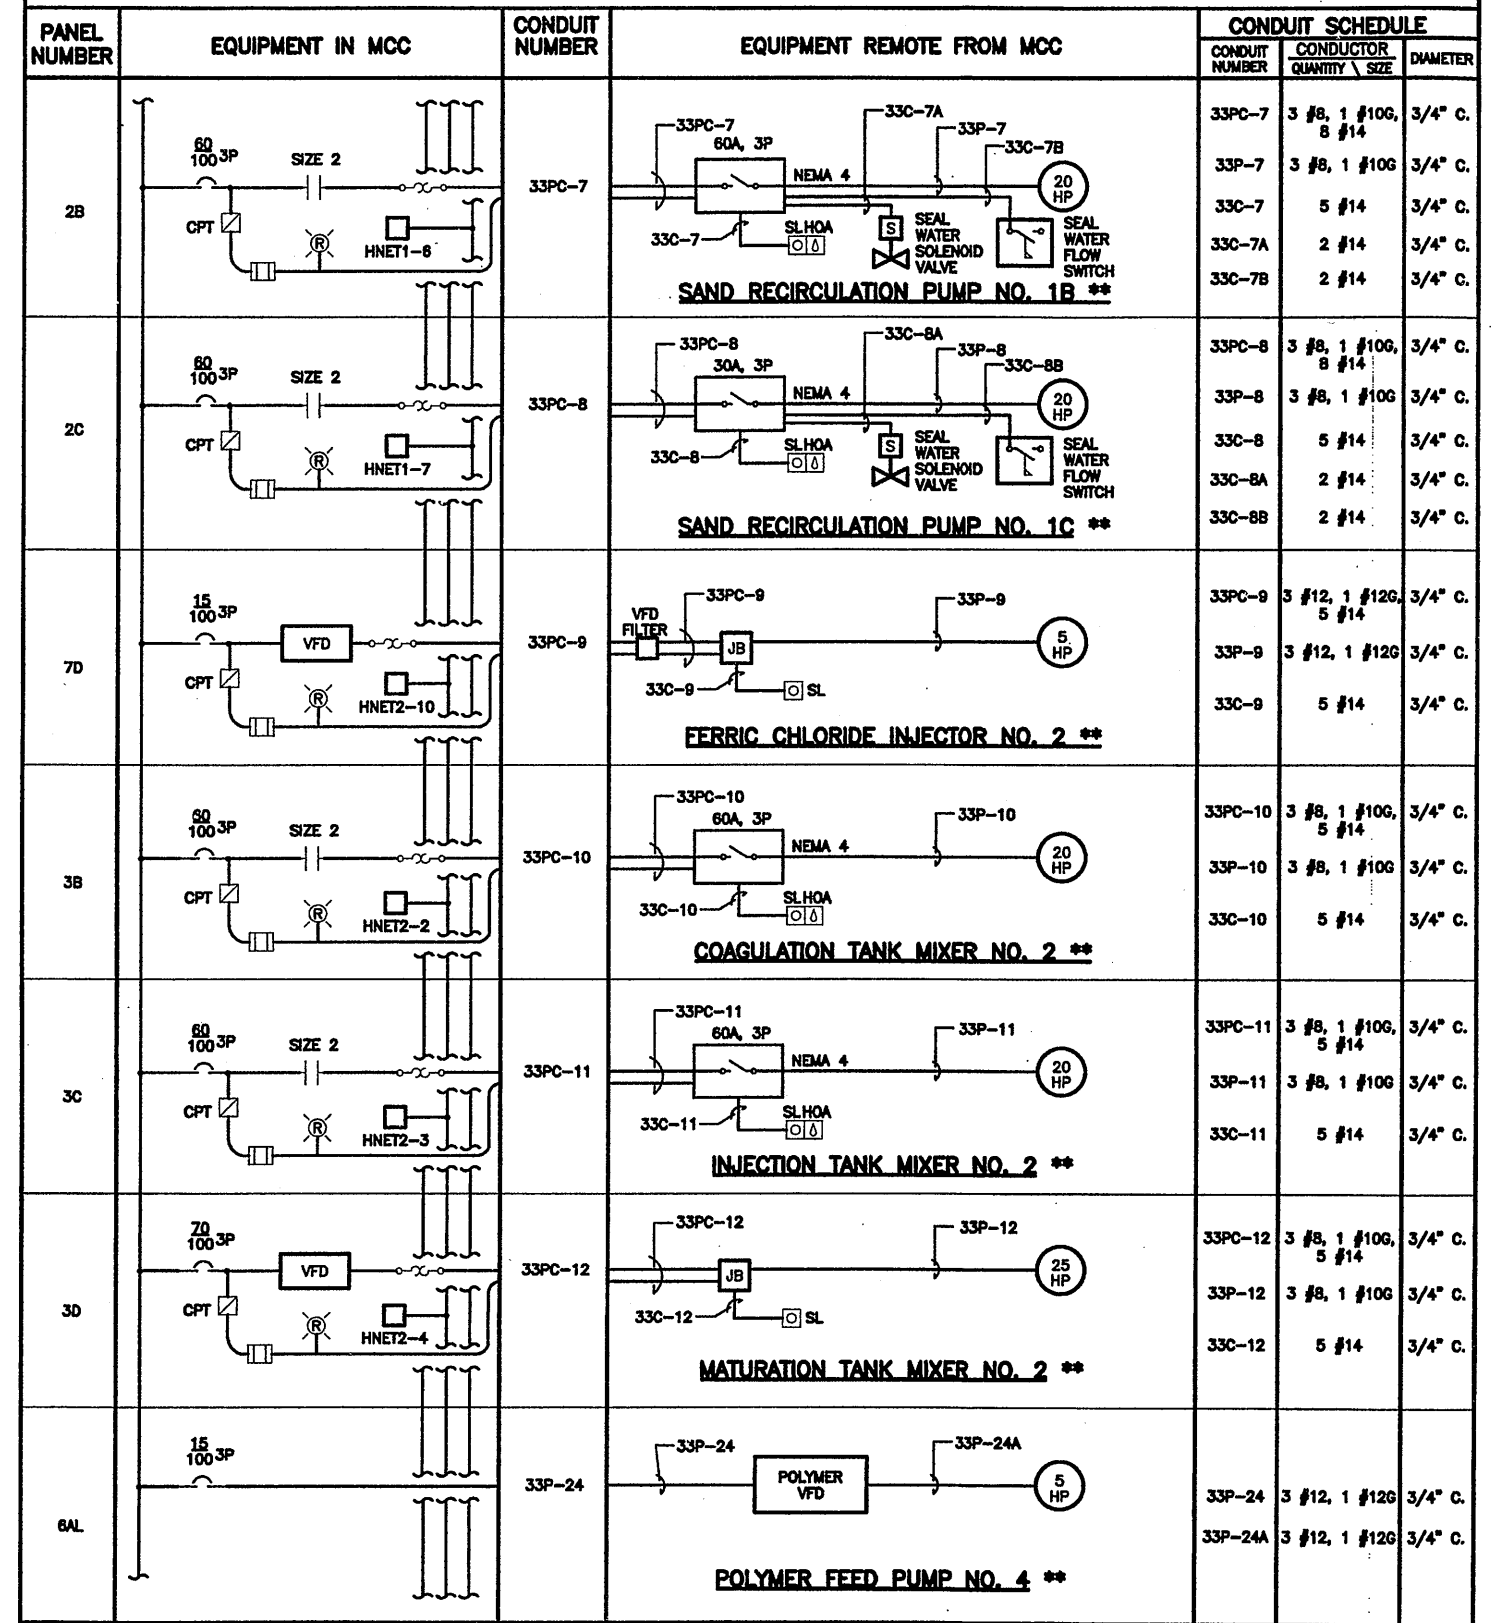

CONDUIT NUMBER DESCRIPTION

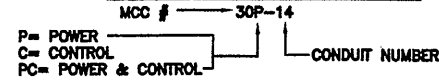

** INDICATES AN ITEM OR ITEMS SUPPLIED BY OWNER OFR INSTALLATION BY THE CONTRACTOR.

RECORD DRAWING

THIS DRAWING HAS BEEN REVISED TO REFLECT MAJOR CHANGES IF ANY, WHICH OCCURRED DURING CONSTRUCTION. REVISIONS ARE BASED UPON INFORMATION SUPPLIED BY CONTRACTOR.

DATE: 10/21/05 PER: [Signature]

THIS DRAWING WAS PREPARED AT THE SCALE INDICATED IN THE TITLE BLOCK. INACCURACIES IN THE STATED SCALE MAY BE INTRODUCED WHEN DRAWINGS ARE REPRODUCED BY ANY MEANS. USE THE GRAPHIC SCALE BAR IN THE TITLE BLOCK TO DETERMINE THE ACTUAL SCALE OF THIS DRAWING.

Layer: ON=*, OFF=**REF*
4/4/01 BBL DCC
05503000/0659E305.DWG

NOT TO SCALE

| No. | Date | Revisions | Init |
|-----|----------|---------------------|-------------|
| 0 | 4/20/01 | ISSUED FOR APPROVAL | [Signature] |
| 1 | | AS BID | |
| 2 | 10/31/05 | RECORD DRAWING | |

In charge of TEL
Designed by AHL
Drawn by DCC
Checked by WFH



ONONDAGA COUNTY • DEPARTMENT OF DRAINAGE AND SANITATION • SYRACUSE, NEW YORK
METROPOLITAN SYRACUSE WASTEWATER TREATMENT PLANT
STAGE III AMMONIA AND STAGE II PHOSPHORUS REMOVAL PROJECT
HRFS COMPLEX
HRFS MCC 33
ONE-LINE DIAGRAM
ELECTRICAL





File Number
00659
Date
APRIL 2001
[Signature]

E-305

NO ALTERATIONS PERMITTED HEREON EXCEPT AS PROVIDED UNDER SECTION 7209 SUBDIVISION 2 OF THE NEW YORK STATE EDUCATION LAW

MCC 33 - CHEMICAL BUILDING C ELECTRIC ROOM (HRFS 1 & 2 CONTINUED)

MCC 33 - CHEMICAL BUILDING C ELECTRIC ROOM (HRFS 1 & 2 CONTINUED)

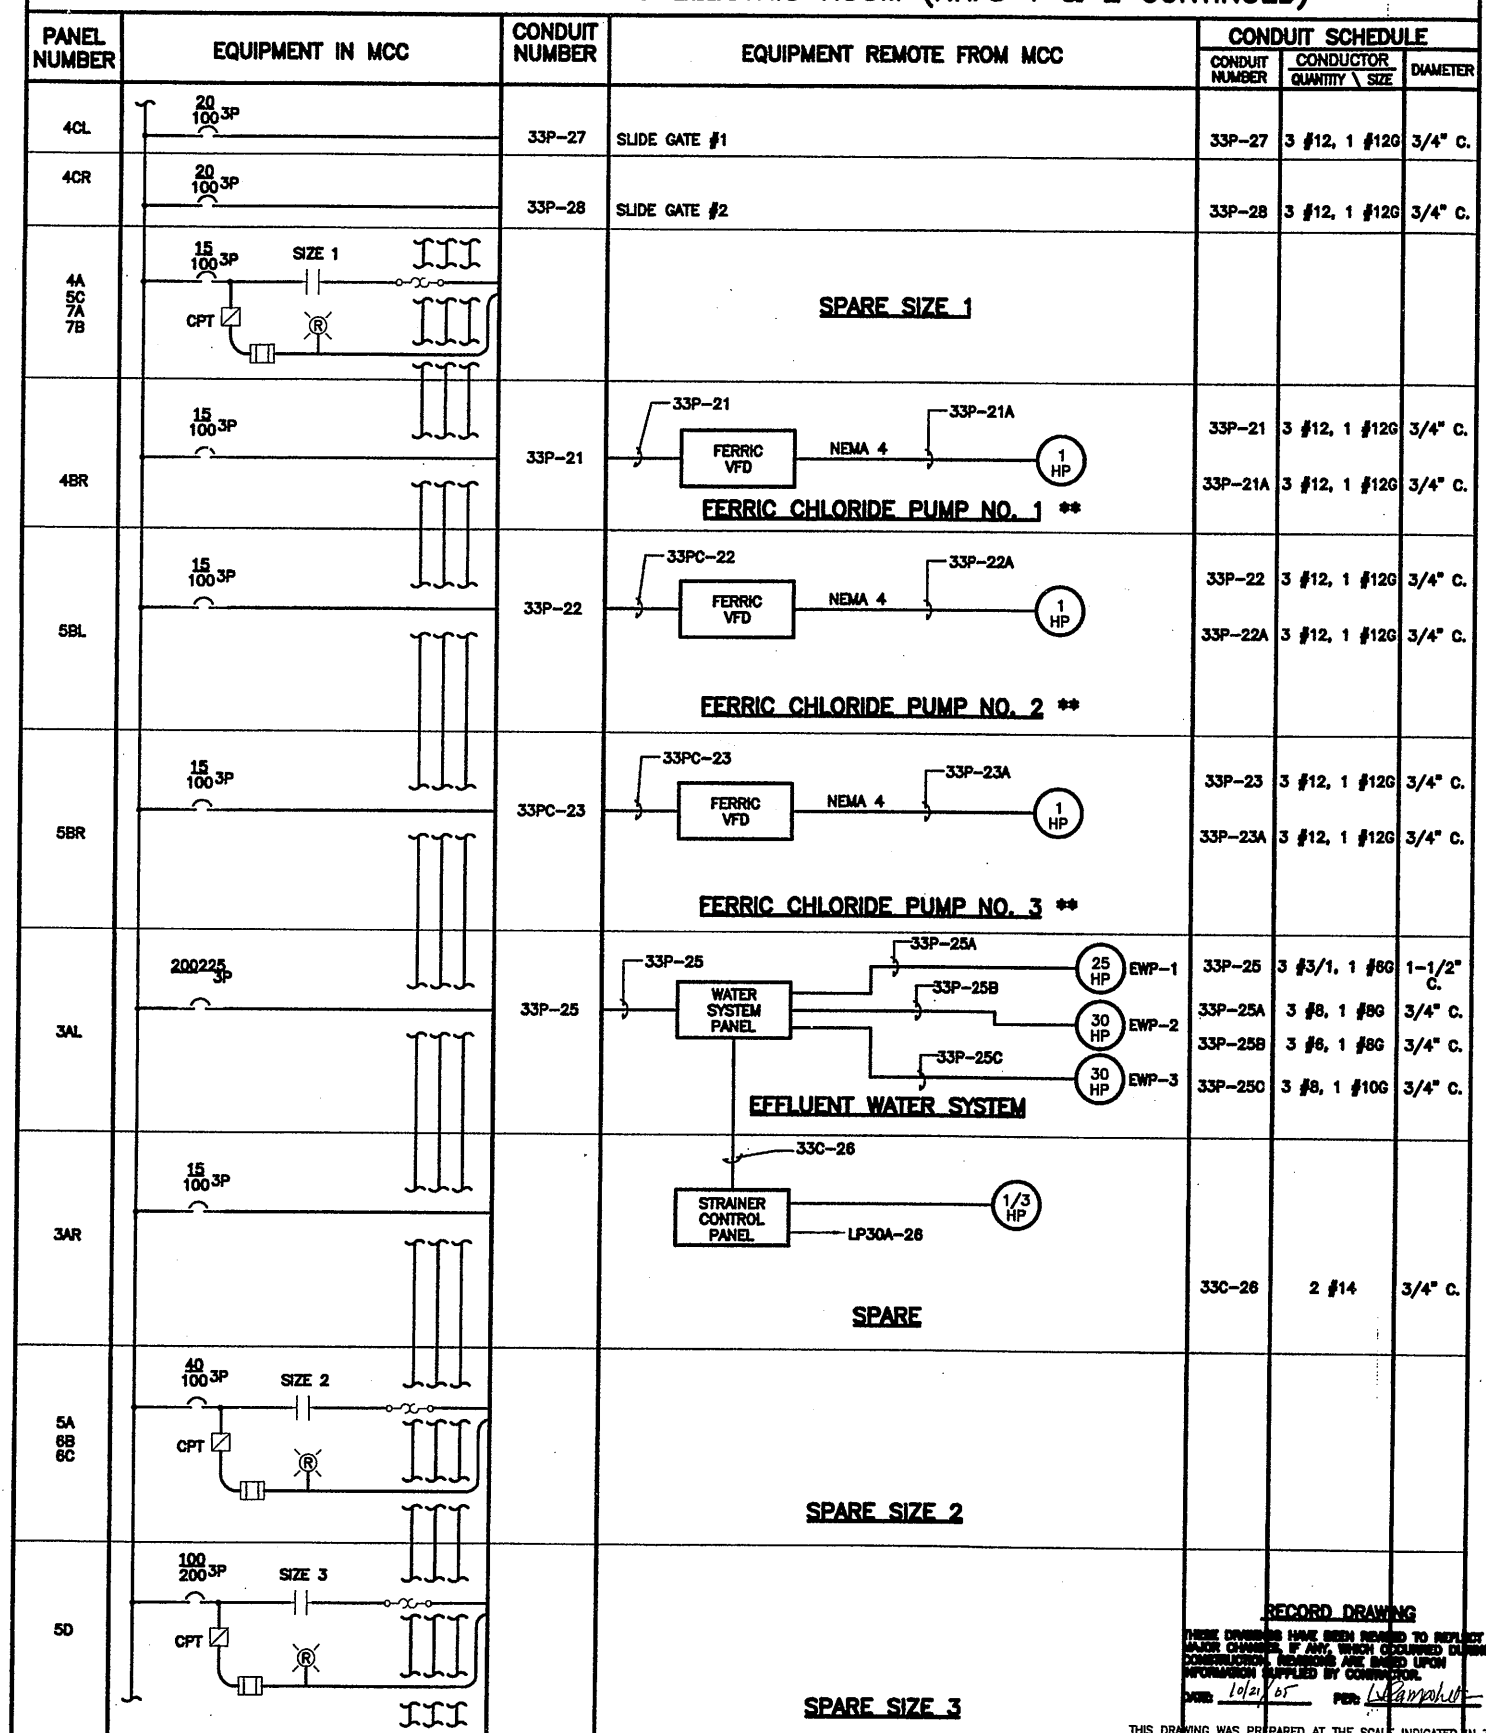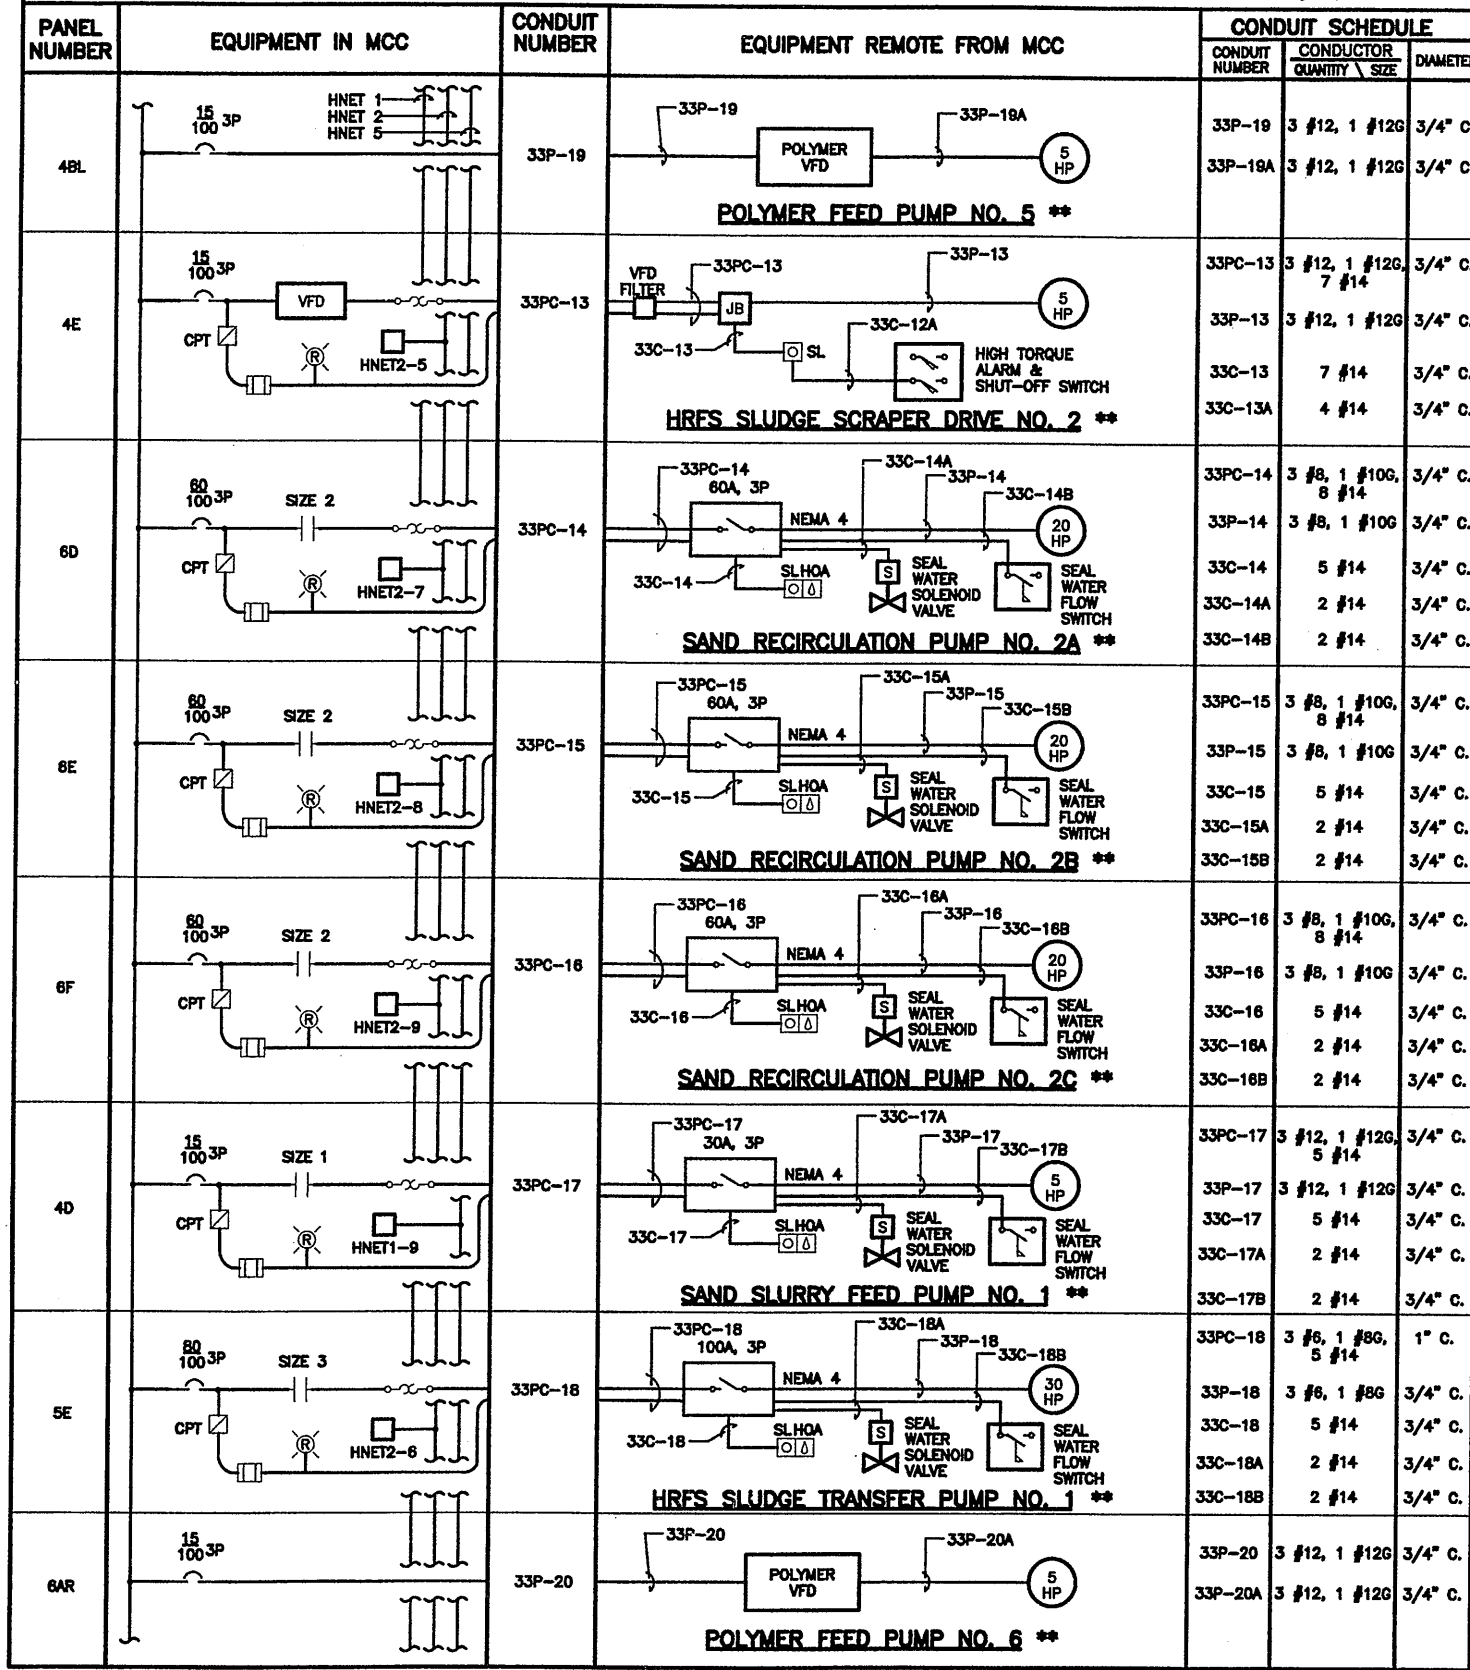

CONDUIT NUMBER DESCRIPTION
MCC # 33P-14

P= POWER
C= CONTROL
PC= POWER & CONTROL

** INDICATES AN ITEM OR ITEMS SUPPLIED BY OWNER FOR INSTALLATION BY THE CONTRACTOR

RECORD DRAWING
THIS DRAWING HAS BEEN REVISIONED TO REFLECT...
DATE 10/21/05 FOR [Signature]

THIS DRAWING WAS PREPARED AT THE SCALE INDICATED IN THE TITLE BLOCK...
INTRODUCED WHEN DRAWINGS ARE REPRODUCED BY ANY MEANS...
USE THE GRAPHIC SCALE BAR IN THE TITLE BLOCK TO DETERMINE THE ACTUAL SCALE OF THIS DRAWING.


Layer: ON=*, OFF=*REF*
4/23/01 BBL DCC
05503000/0659E306.DWG

| No. | Date | Revisions | Init |
|-----|----------|---------------------|------|
| 0 | 4/20/01 | ISSUED FOR APPROVAL | UC |
| 1 | | AS BID | |
| 2 | 10/31/05 | RECORD DRAWING | |


NOT TO SCALE

NO ALTERATIONS PERMITTED HEREON EXCEPT AS PROVIDED UNDER SECTION 7209 SUBDIVISION 2 OF THE NEW YORK STATE EDUCATION LAW

In charge of TEL
Designed by AHL
Drawn by DCC
Checked by WFH

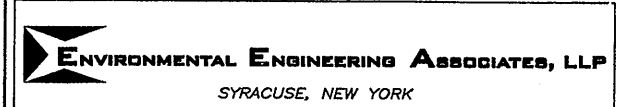



ONONDAGA COUNTY • DEPARTMENT OF DRAINAGE AND SANITATION • SYRACUSE, NEW YORK
METROPOLITAN SYRACUSE WASTEWATER TREATMENT PLANT
STAGE III AMMONIA AND STAGE II PHOSPHORUS REMOVAL PROJECT
HRFS COMPLEX
HRFS MCC 33
ONE-LINE DIAGRAM (CONTINUED)
ELECTRICAL

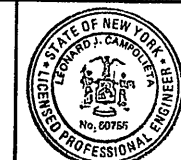


File Number 00659
Date APRIL 2001
E-306
[Signature]

MCC 39 - HRFS INFLUENT GALLERY (HRFS 3 & 4)

MCC 39 - HRFS INFLUENT GALLERY (HRFS 3 & 4 CONTINUED)

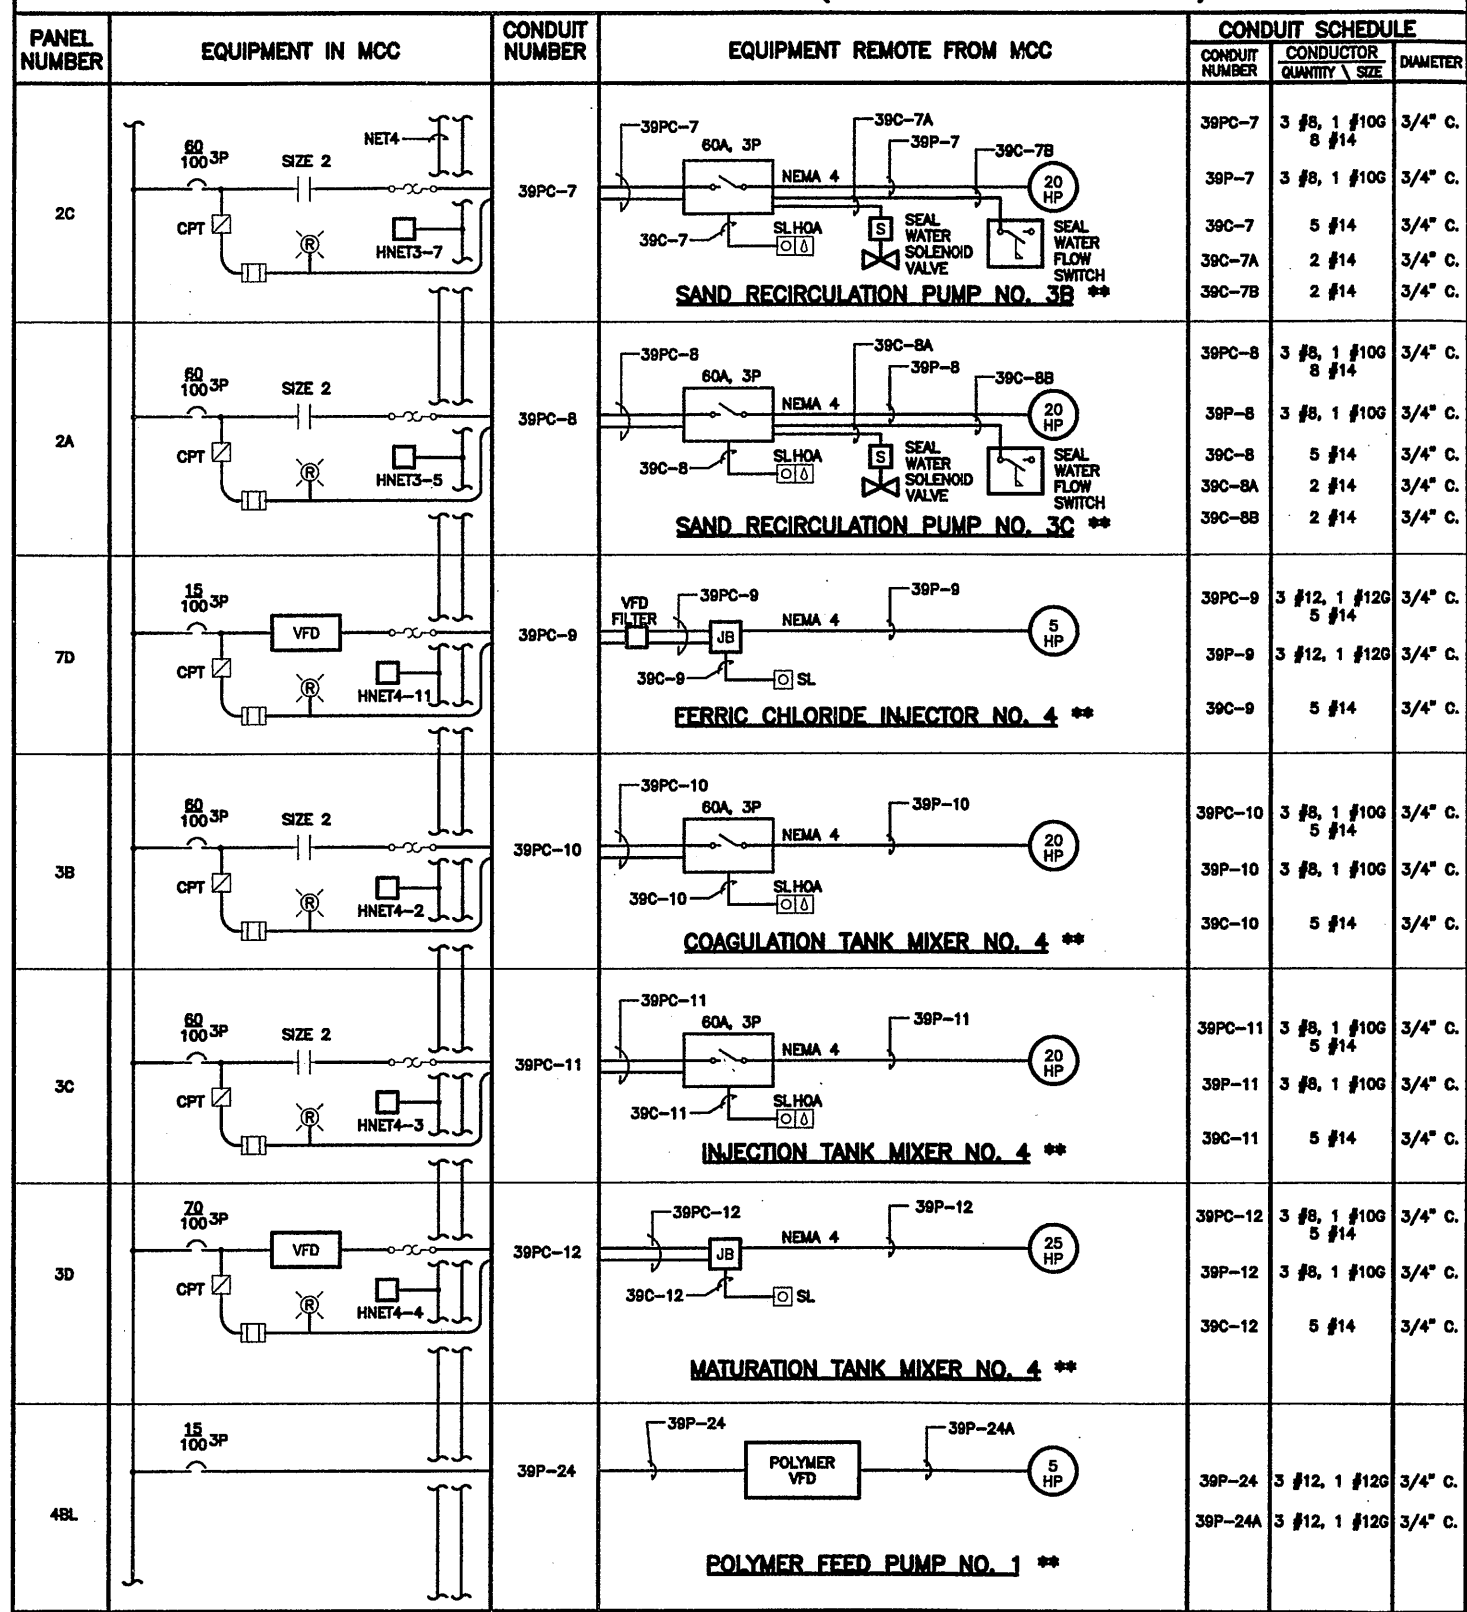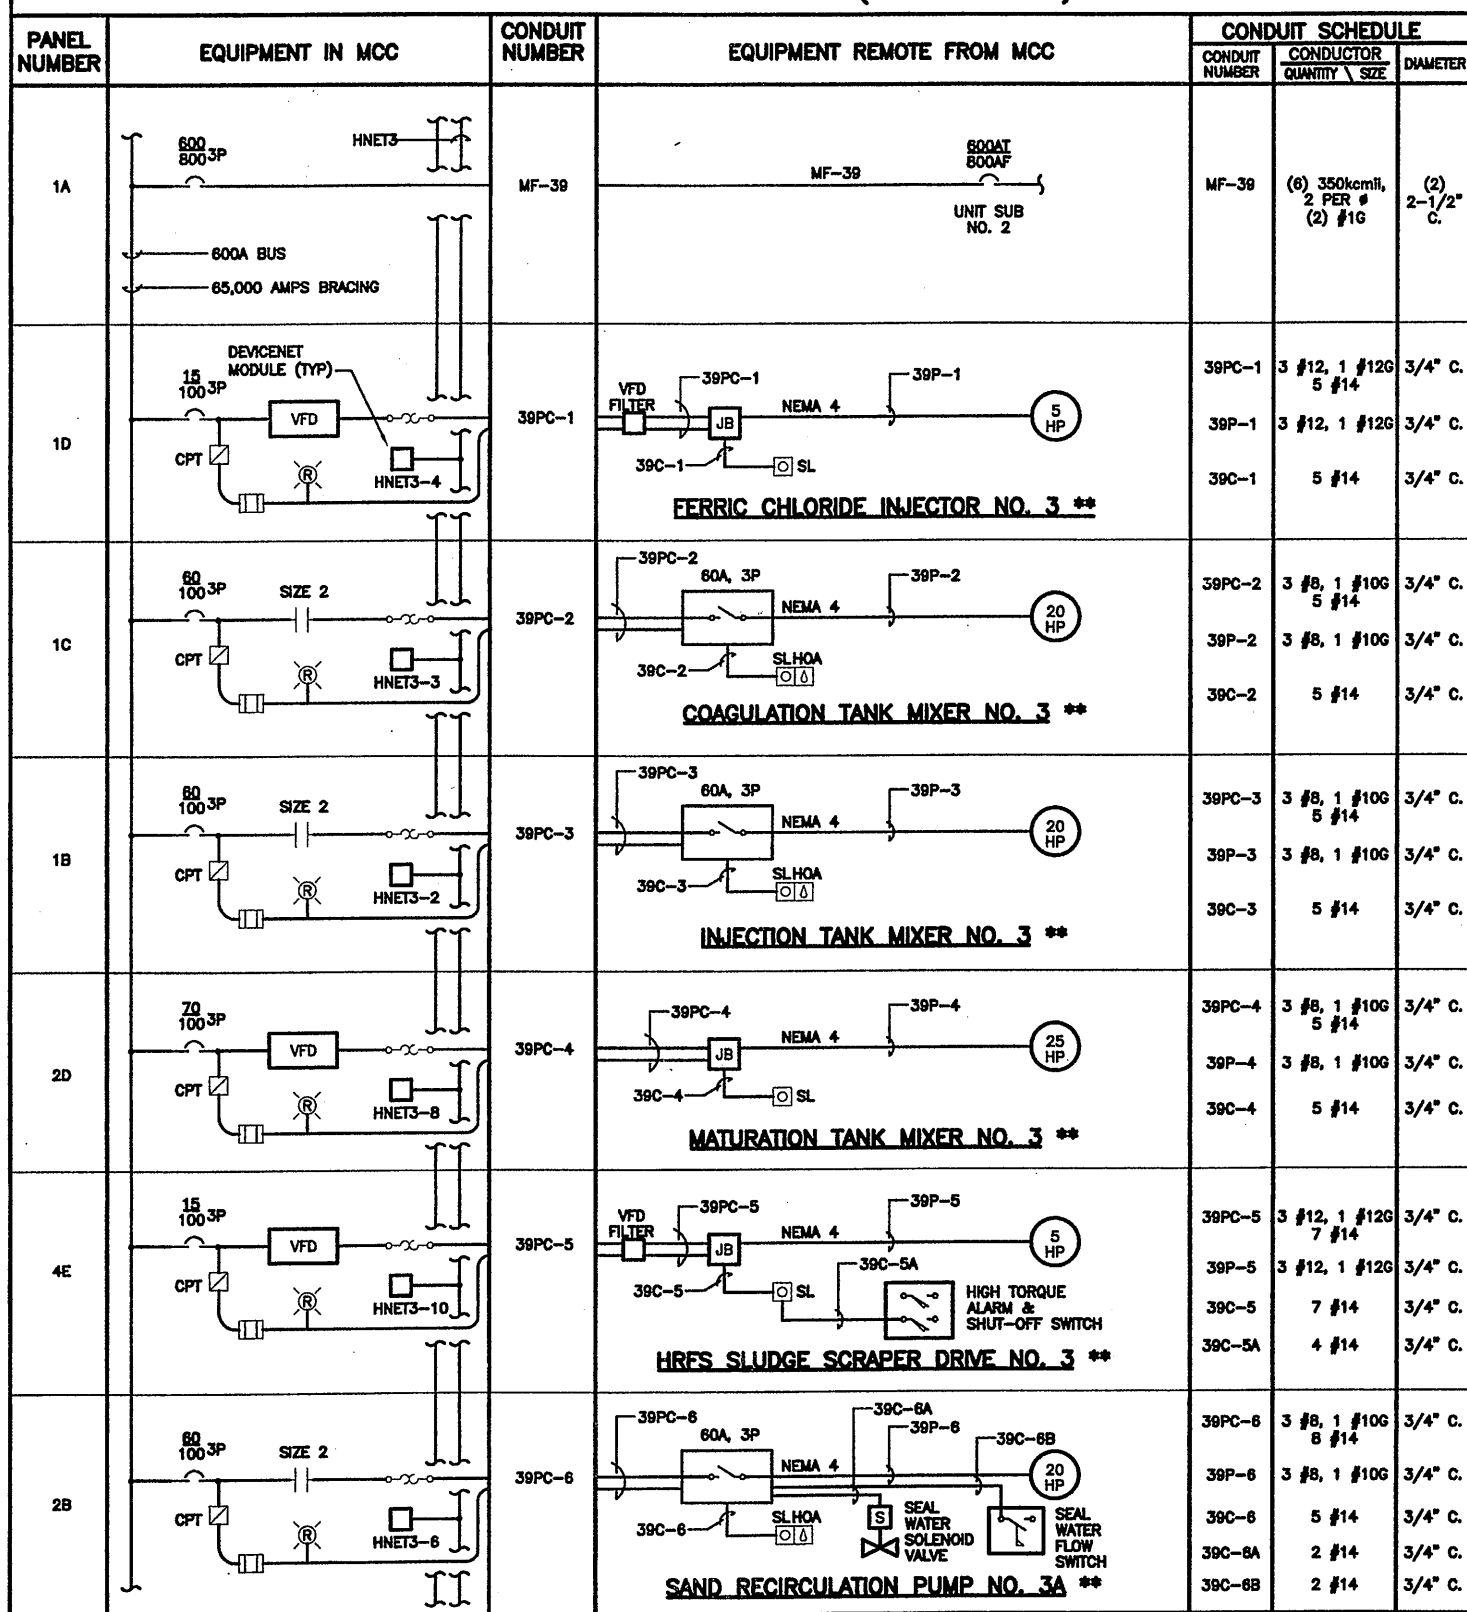

CONDUIT NUMBER DESCRIPTION

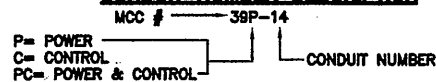

** INDICATES AN ITEM OR ITEMS SUPPLIED BY OWNER FOR INSTALLATION BY THE CONTRACTOR.

RECORD DRAWING

THESE CHANGES HAVE BEEN MADE TO REFLECT OWNER CHANGES, IF ANY, WHICH OCCURRED DURING CONSTRUCTION. REVISIONS ARE LISTED BELOW INFORMATION SUPPLIED BY CONTRACTOR.

THIS DRAWING WAS PREPARED AT THE SCALE INDICATED IN THE TITLE BLOCK. INACCURACIES IN THE STATED SCALE MAY BE INTRODUCED WHEN DRAWINGS ARE REPRODUCED BY ANY MEANS. USE THE GRAPHIC SCALE BAR IN THE TITLE BLOCK TO DETERMINE THE ACTUAL SCALE OF THIS DRAWING.

Layer: ON=; OFF=REF*
4/4/01 BBL DCC
05503000/0659307.DWG

| | |
|--------------|----------|
| NOT TO SCALE | |
| No. | Date |
| 0 | 4/20/01 |
| 1 | AS BID |
| 2 | 10/31/05 |

| Revisions | Init |
|---------------------|------|
| ISSUED FOR APPROVAL | LE |
| AS BID | |
| RECORD DRAWING | |

IN CHARGE OF: TEL
DESIGNED BY: AHL
DRAWN BY: DCC
CHECKED BY: WFH



ENVIRONMENTAL ENGINEERING ASSOCIATES, LLP
SYRACUSE, NEW YORK

ONONDAGA COUNTY • DEPARTMENT OF DRAINAGE AND SANITATION • SYRACUSE, NEW YORK
METROPOLITAN SYRACUSE WASTEWATER TREATMENT PLANT
STAGE III AMMONIA AND STAGE II PHOSPHORUS REMOVAL PROJECT
HRFS COMPLEX
HRFS MCC 39
ONE-LINE DIAGRAM
ELECTRICAL

File Number: 00659
Date: APRIL 2001
E-307

MCC 39 - HRFS INFLUENT GALLERY (HRFS 3 & 4 CONTINUED)

MCC 39 - HRFS INFLUENT GALLERY (HRFS 3 & 4 CONTINUED)

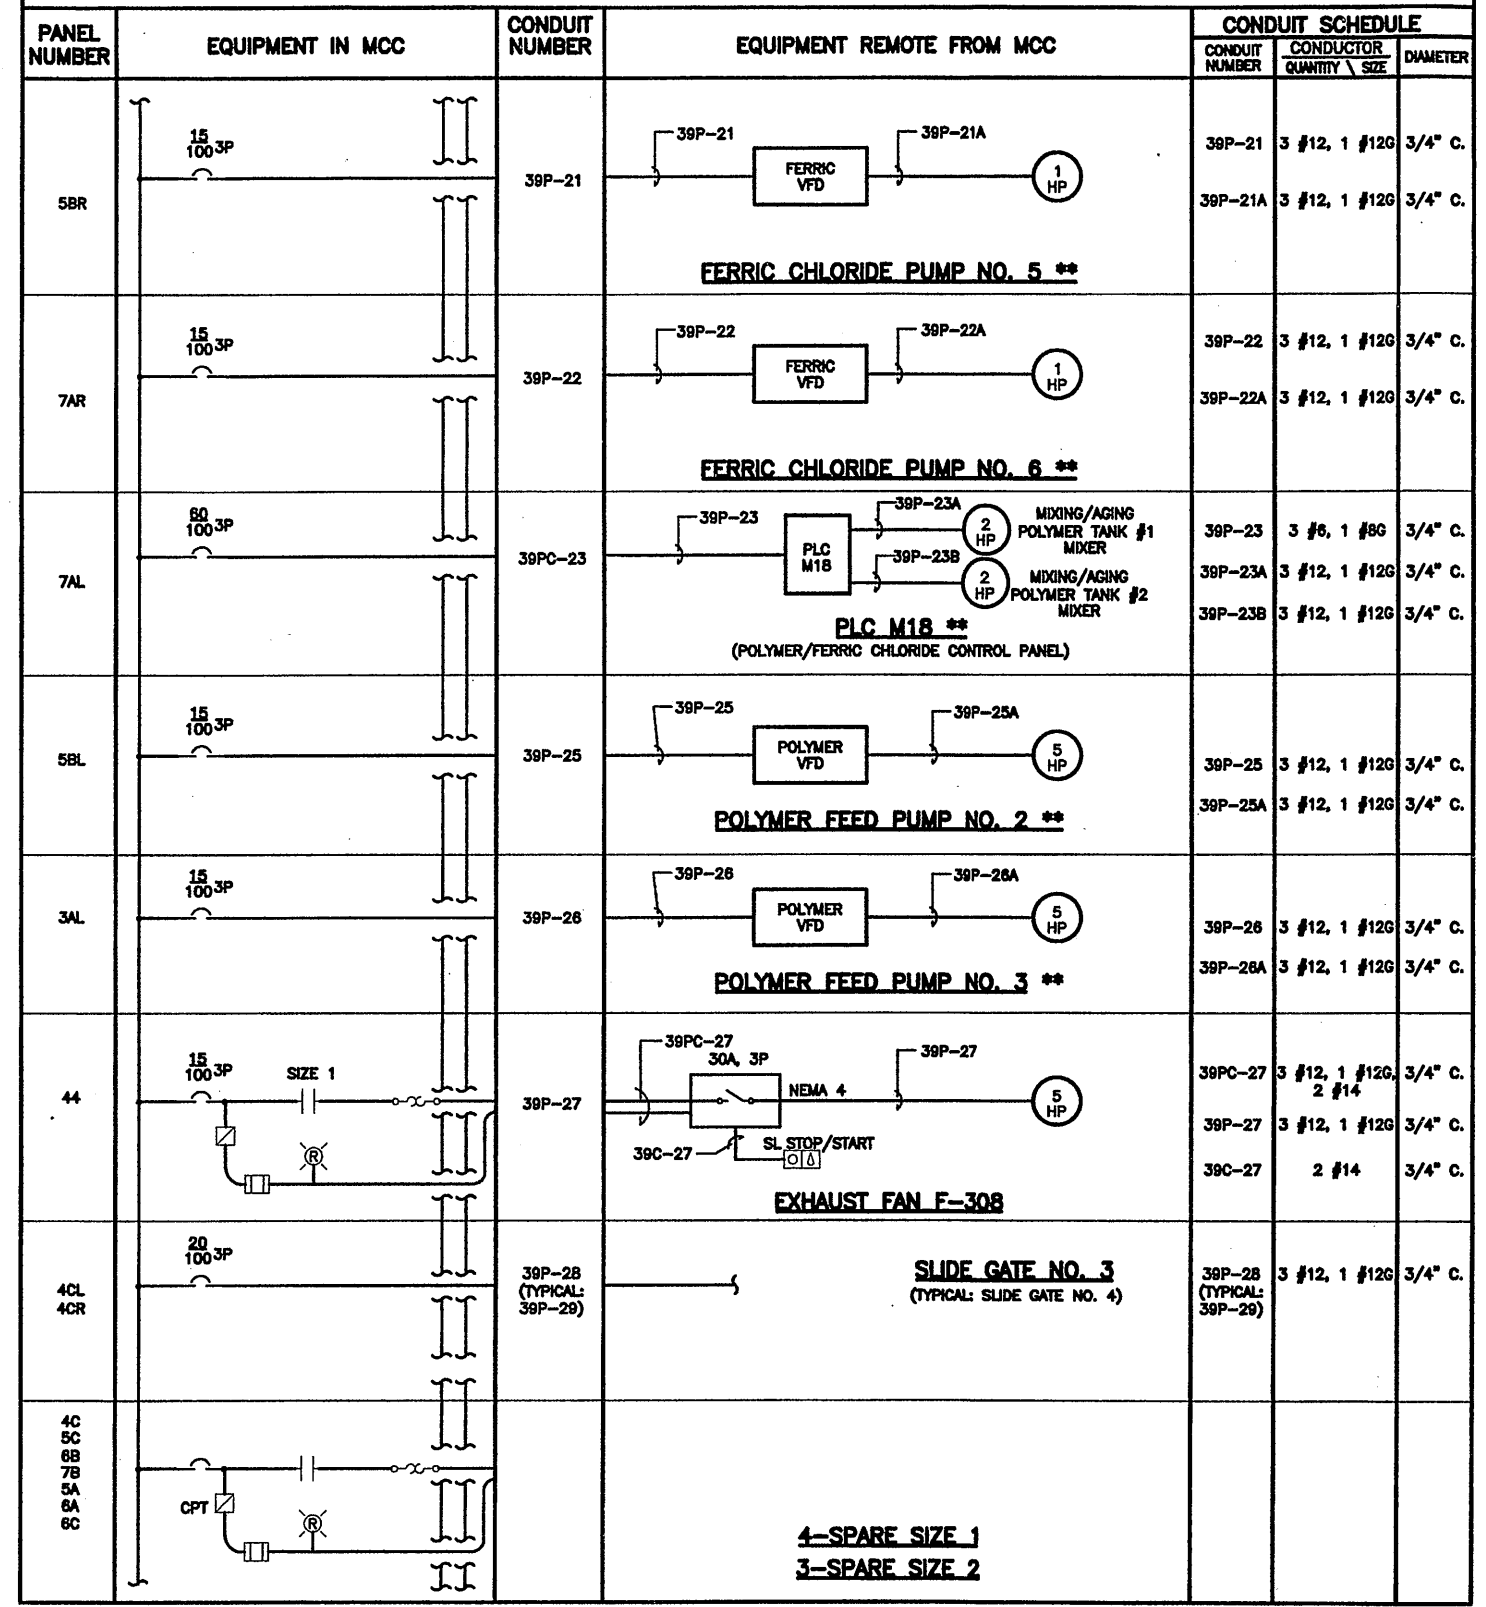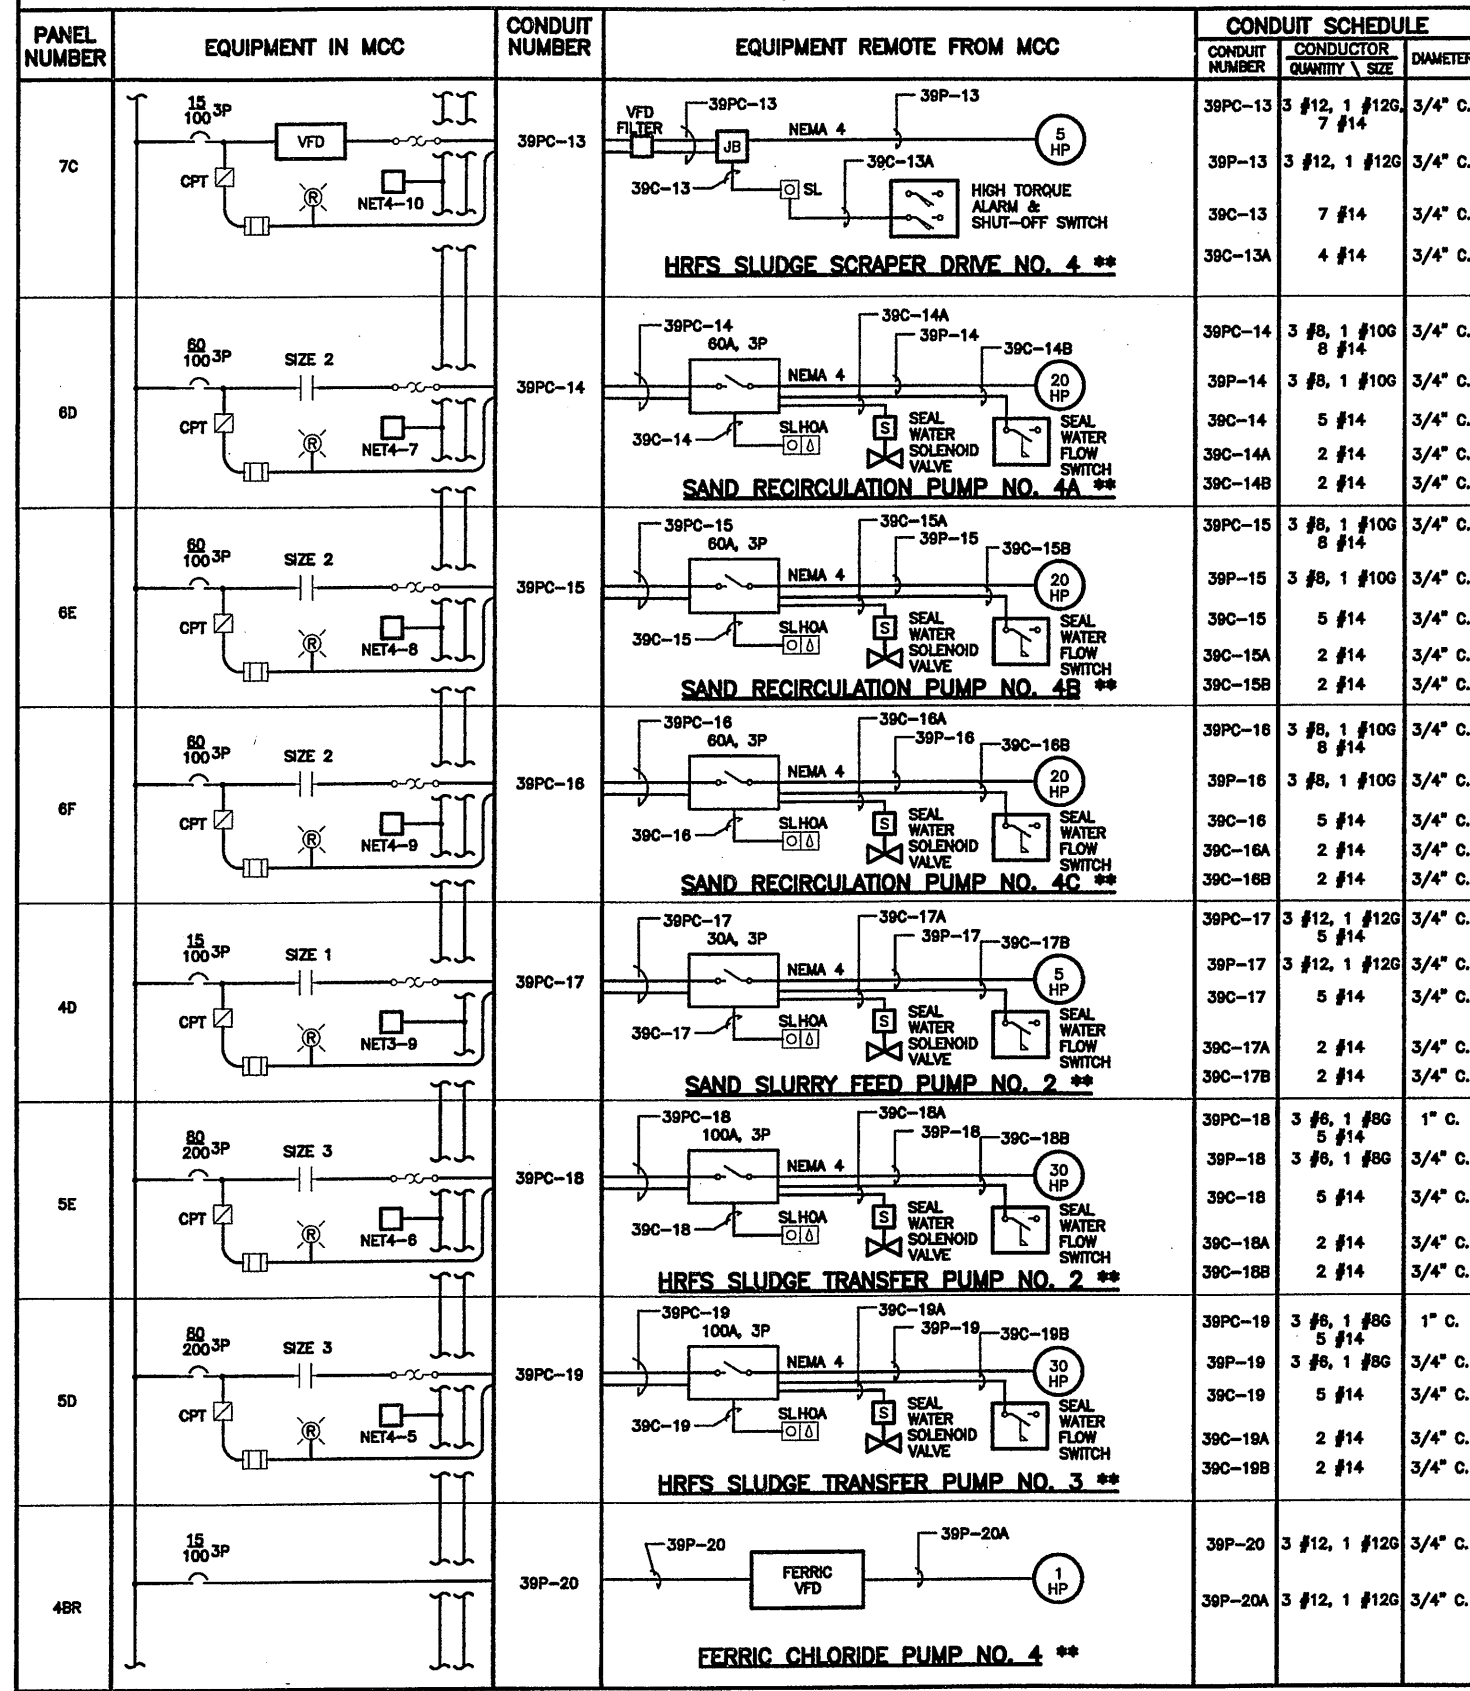

CONDUIT NUMBER DESCRIPTION
MCC # - 39P-14
P= POWER
C= CONTROL
PC= POWER & CONTROL

RECORD DRAWING
THESE DIMENSIONS HAVE BEEN REVISED TO REFLECT
MATERIAL CHANGES, IF ANY, WHICH OCCURRED DURING
CONSTRUCTION. REVISIONS ARE BASED UPON
INFORMATION SUPPLIED BY CONTRACTOR.
DATE: 10/10/01 PER: [Signature]

THIS DRAWING WAS PREPARED AT THE SCALE INDICATED IN THE
TITLE BLOCK. INACCURACIES IN THE STATED SCALE MAY BE
INTRODUCED WHEN DRAWINGS ARE REPRODUCED BY ANY MEANS.
USE THE GRAPHIC SCALE BAR IN THE TITLE BLOCK TO
DETERMINE THE ACTUAL SCALE OF THIS DRAWING.

Layer: ON=""; OFF="REF"
4/4/01 BBL DCC
05503000/0659E308.DWG

NOT TO SCALE
NO ALTERATIONS PERMITTED HEREON EXCEPT
AS PROVIDED UNDER SECTION 7209 SUBDIVISION
2 OF THE NEW YORK STATE EDUCATION LAW


| No. | Date | Revisions | Init |
|-----|----------|---------------------|-------------|
| 0 | 4/20/01 | ISSUED FOR APPROVAL | [Signature] |
| 1 | | AS BID | |
| 2 | 10/31/05 | RECORD DRAWING | |

In charge of - TEL
Designed by - AHL
Drawn by - DCC
Checked by - WFH


ENVIRONMENTAL ENGINEERING ASSOCIATES, LLP
SYRACUSE, NEW YORK

ONONDAGA COUNTY • DEPARTMENT OF DRAINAGE AND SANITATION • SYRACUSE, NEW YORK
METROPOLITAN SYRACUSE WASTEWATER TREATMENT PLANT
STAGE III AMMONIA AND STAGE II PHOSPHORUS REMOVAL PROJECT
HRFS COMPLEX
HRFS MCC 39
ONE-LINE DIAGRAM (CONTINUED)
ELECTRICAL

File Number
00659
Date
APRIL 2001
E-308
[Signature]

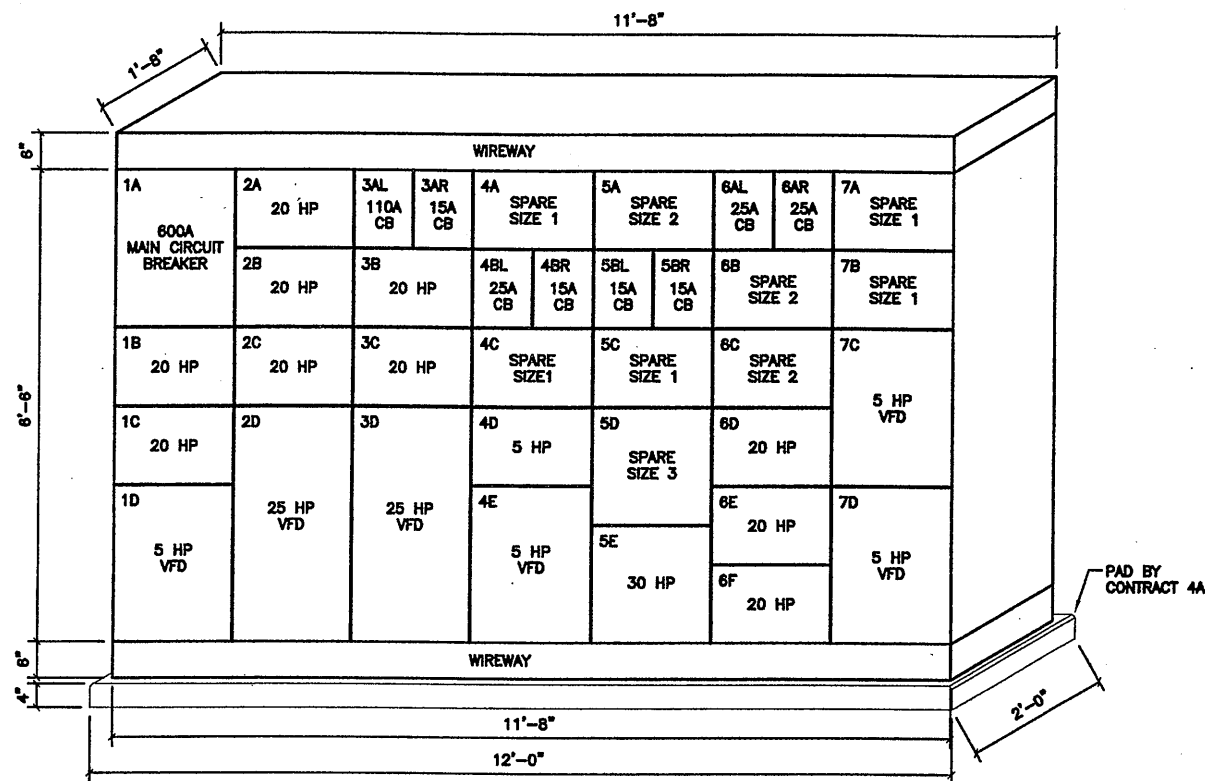

MCC 33 ELEVATION
NOT TO SCALE
(SEE DRAWING E-305 AND E-306)

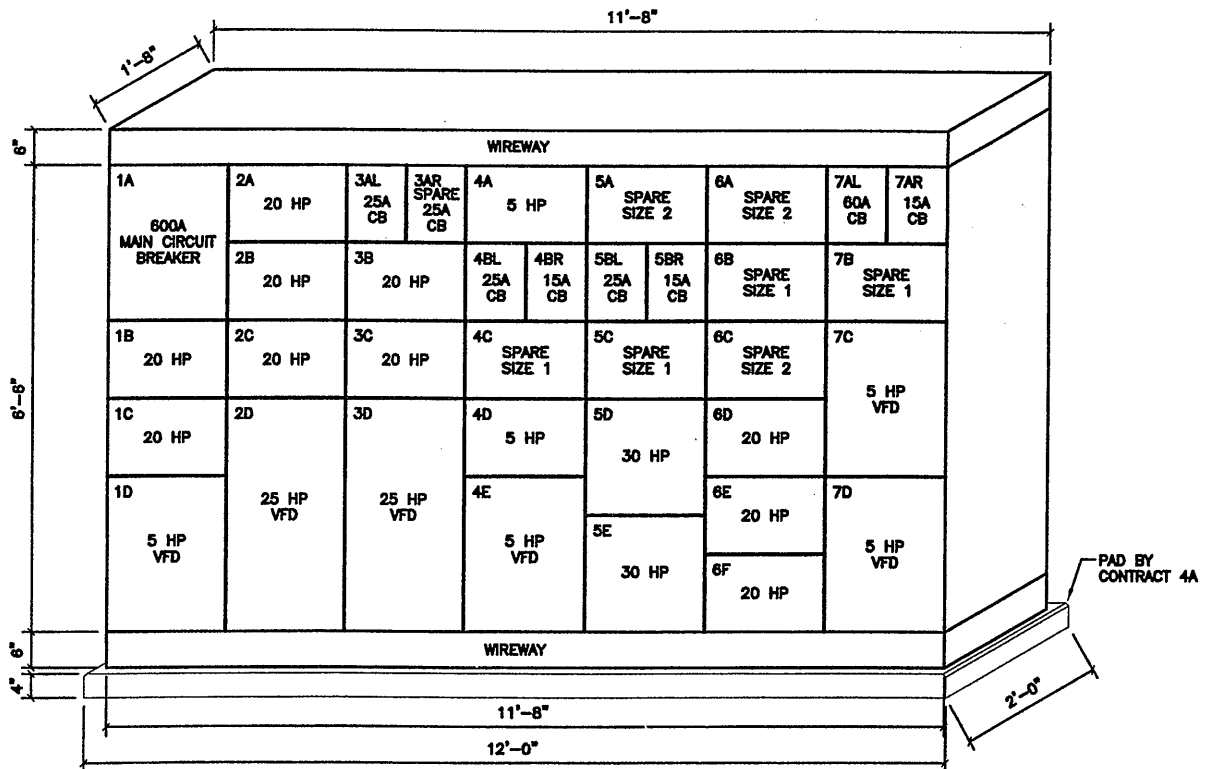

MCC 39 ELEVATION
NOT TO SCALE
(SEE DRAWING E-307 AND E-308)

SEE MCC O&M MANUAL FOR
EQUIPMENT ELEMENTARY DIAGRAMS

RECORD DRAWING
THESE DRAWINGS HAVE BEEN REVISIONED TO REFLECT
MAJOR CHANGES, IF ANY, WHICH OCCURRED DURING
CONSTRUCTION. REVISIONS ARE BASED UPON
INFORMATION SUPPLIED BY CONTRACTOR.
DATE: 10/21/05 PER: [Signature]

THIS DRAWING WAS PREPARED AT THE SCALE INDICATED IN THE
TITLE BLOCK. INACCURACIES IN THE STATED SCALE MAY BE
INTRODUCED WHEN DRAWINGS ARE REPRODUCED BY ANY MEANS.
USE THE GRAPHIC SCALE BAR IN THE TITLE BLOCK TO
DETERMINE THE ACTUAL SCALE OF THIS DRAWING.

Layer: ON=*, OFF=*REF*
4/17/01 BBL DCC
05503000/0659E309.DWG

NOT TO SCALE

| No. | Date | Revisions | Init |
|-----|----------|---------------------|-------------|
| 0 | 4/20/01 | ISSUED FOR APPROVAL | [Signature] |
| 1 | | AS BID | |
| 2 | 10/31/05 | RECORD DRAWING | |

In charge of --- TEL ---
Designed by --- TEL ---
Drawn by --- DCC ---
Checked by --- WFH ---



ONONDAGA COUNTY • DEPARTMENT OF DRAINAGE AND SANITATION • SYRACUSE, NEW YORK
METROPOLITAN SYRACUSE WASTEWATER TREATMENT PLANT
STAGE III AMMONIA AND STAGE II PHOSPHORUS REMOVAL PROJECT
HRFS COMPLEX
HRFS MCC ELEVATIONS



File Number
00659
Date
APRIL 2001
E-309
[Signature]

ELECTRICAL

SEE MCC O&M MANUAL FOR
EQUIPMENT ELEMENTARY DIAGRAM

Layer: ON=*; OFF=*REF*
4/4/01 BBL DCC
05503000/0659E310.DWG

RECORD DRAWING

THESE CHANGES HAVE BEEN MADE TO REFLECT
MARCH CHANGES. IF ANY, WHICH OCCURRED DURING
CONSTRUCTION. REVISIONS ARE BASED UPON
INFORMATION SUPPLIED BY CONTRACTOR.

DATE: 10/10/01 FOR: Rampolot

THIS DRAWING WAS PREPARED AT THE SCALE INDICATED IN THE
TITLE BLOCK. INACCURACIES IN THE STATED SCALE MAY BE
INTRODUCED WHEN DRAWINGS ARE REPRODUCED BY ANY MEANS.
USE THE GRAPHIC SCALE BAR IN THE TITLE BLOCK TO
DETERMINE THE ACTUAL SCALE OF THIS DRAWING.

NOT TO SCALE

| No. | Date | Revisions | Init |
|-----|----------|---------------------|------|
| 0 | 4/20/01 | ISSUED FOR APPROVAL | WCC |
| 1 | | AS BID | |
| 2 | 10/31/05 | RECORD DRAWING | |

In charge of --- TEL ---
Designed by --- MEE ---
Drawn by --- DCC ---
Checked by --- WFH ---



ONONDAGA COUNTY • DEPARTMENT OF DRAINAGE AND SANITATION • SYRACUSE, NEW YORK
METROPOLITAN SYRACUSE WASTEWATER TREATMENT PLANT
STAGE III AMMONIA AND STAGE II PHOSPHORUS REMOVAL PROJECT
HRFS COMPLEX
HRFS ELEMENTARY DIAGRAMS


ELECTRICAL




File Number
00659
Date
APRIL 2001
Rampolot

E-310


NO ALTERATIONS PERMITTED HEREON EXCEPT
AS PROVIDED UNDER SECTION 7209 SUBDIVISION
2 OF THE NEW YORK STATE EDUCATION LAW

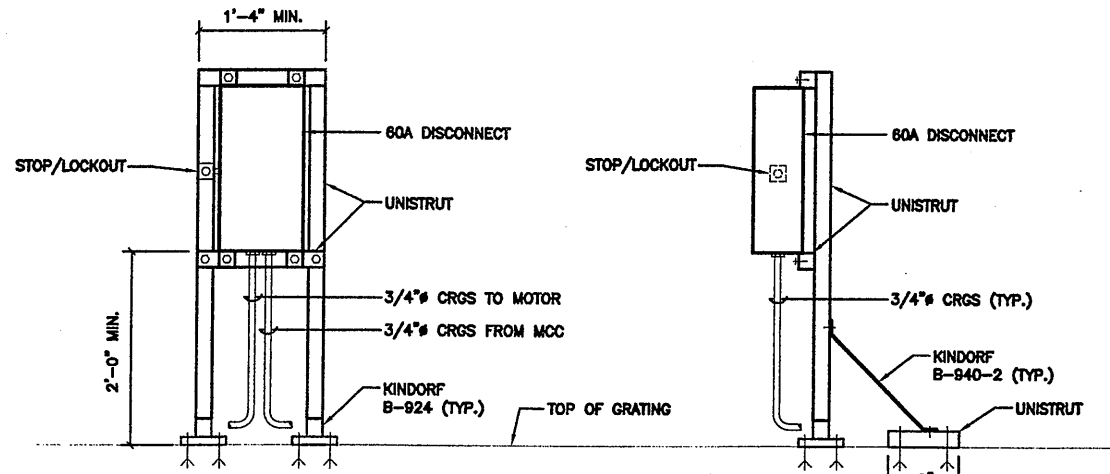

60 AMP DISCONNECT SUPPORT DETAIL (TYP.)
NOT TO SCALE

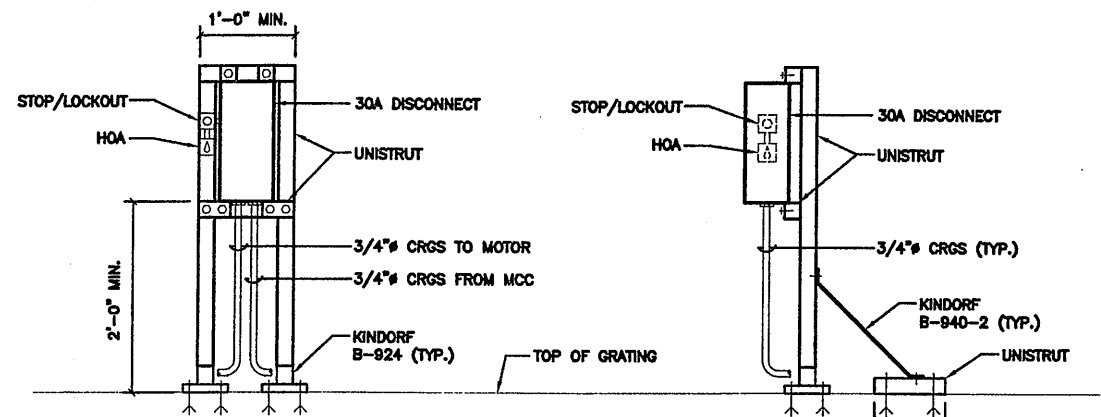

30 AMP DISCONNECT SUPPORT DETAIL (TYP.)
NOT TO SCALE

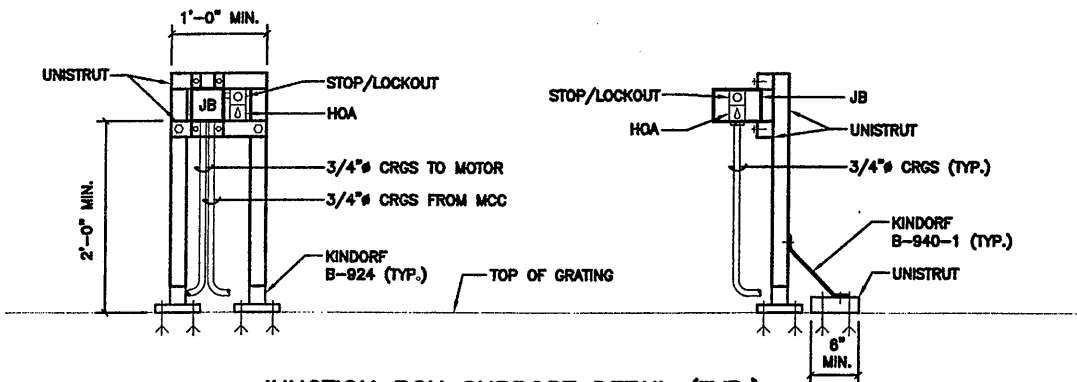

JUNCTION BOX SUPPORT DETAIL (TYP.)
NOT TO SCALE

| CIRCUIT BREAKER PANELBOARD - PP-38A | | | | | | | | | | SCHEDULE | | |
|-------------------------------------|------------------------|----------------------------------|-----------|-------|-------|-------|-------|-----------------|-----------|-----------------|------------------------|---------|
| LOCATION: | | HRFS INFLUENT PIPE GALLERY NORTH | | | | | | FEED FROM | | MCC 38, 4AL | | |
| MAIN BUS RATING: | | 225 AMPERES | | | | | | 480 VOLT | | 3 PHASE, 4 WIRE | | |
| MINIMUM SHORTCIRCUIT: | | 25,000 AMPERES | | | | | | FEEDER CABLE | | 3 #3, 1 #8G | | |
| MAIN BREAKER TRIP: | | 100 AMPERES | | | | | | SURFACE MOUNTED | | | | |
| ESTIMATED CONNECTED LOAD: | | 9.70 KVA | | | | | | | | | | |
| CKT NO. | DESCRIPTION | C/B AMPS/POLES | LOAD TYPE | KVA | PH-A | PH-B | PH-C | KVA | LOAD TYPE | POLES | DESCRIPTION | CKT NO. |
| 1 | UNIT HEATER NO. UH-303 | 20A | MOTOR | 0.143 | 0.286 | | | 0.143 | MOTOR | 20A | UNIT HEATER NO. UH-304 | 2 |
| 3 | | | MOTOR | 0.143 | | 0.286 | | 0.143 | MOTOR | | | 4 |
| 5 | | 3P | MOTOR | 0.143 | | | 0.286 | 0.143 | MOTOR | 3P | | 6 |
| 7 | UNIT HEATER NO. UH-309 | 20A | MOTOR | 0.443 | 0.886 | | | 0.443 | MOTOR | 20A | UNIT HEATER NO. UH-310 | 8 |
| 9 | | | MOTOR | 0.443 | | 0.886 | | 0.443 | MOTOR | | | 10 |
| 11 | | 3P | MOTOR | 0.443 | | | 0.886 | 0.443 | MOTOR | 3P | | 12 |
| 13 | UNIT HEATER NO. UH-311 | 20A | MOTOR | 0.443 | 0.886 | | | 0.443 | MOTOR | 20A | UNIT HEATER NO. UH-312 | 14 |
| 15 | | | MOTOR | 0.443 | | 0.886 | | 0.443 | MOTOR | | | 16 |
| 17 | | 3P | MOTOR | 0.443 | | | 0.886 | 0.443 | MOTOR | 3P | | 18 |
| 19 | UNIT HEATER NO. UH-315 | 20A | MOTOR | 0.143 | 0.286 | | | 0.143 | MOTOR | 20A | UNIT HEATER NO. UH-316 | 20 |
| 21 | | | MOTOR | 0.143 | | 0.286 | | 0.143 | MOTOR | | | 22 |
| 23 | | 3P | MOTOR | 0.143 | | | 0.286 | 0.143 | MOTOR | 3P | | 24 |
| 25 | UNIT HEATER NO. UH-325 | 20A | MOTOR | 0.143 | 0.889 | | | 0.748 | MOTOR | 20A | MONORAIL CONTROL PANEL | 28 |
| 27 | | | MOTOR | 0.143 | | 0.889 | | 0.748 | MOTOR | | | 28 |
| 29 | | 3P | MOTOR | 0.143 | | | 0.889 | 0.748 | MOTOR | 3P | | 30 |
| 31 | O.H. DOOR WEST | 20A | | | 0.000 | | | | | 20A | O.H. DOOR EAST | 32 |
| 33 | | | | | | 0.000 | | | | | | 34 |
| 35 | | 3P | | | | | 0.000 | | | 3P | | 36 |
| 37 | SPARE | 20A | | | 0.000 | | | | | 20A | SPARE | 38 |
| 39 | | | | | | 0.000 | | | | | | 40 |
| 41 | | 3P | | | | | 0.000 | | | 3P | | 42 |
| LOAD SUMMARY | | | | | 3.945 | 3.233 | 3.233 | 3.233 | 5.754 | | | |
| PANEL TOTAL KVA: | | | | | 9.699 | | | | | | | |

NOTE:
ALL CONDUCTORS TO BE 3 #12, 1 #12G IN 3/4-INCH PVC COATED CONDUIT, UNLESS OTHERWISE INDICATED ON POWER PLAN.

| CIRCUIT BREAKER PANELBOARD - PP-34A | | | | | | | | | | SCHEDULE | | |
|-------------------------------------|------------------------|----------------------------------|-----------|-------|-------|-------|-------|-----------------|-----------|-----------------|------------------------|---------|
| LOCATION: | | HRFS INFLUENT PIPE GALLERY SOUTH | | | | | | FEED FROM | | MCC 34, 4AL | | |
| MAIN BUS RATING: | | 225 AMPERES | | | | | | 480 VOLT | | 3 PHASE, 4 WIRE | | |
| MINIMUM SHORTCIRCUIT: | | 25,000 AMPERES | | | | | | FEEDER CABLE | | 3 #3, 1 #8G | | |
| MAIN BREAKER TRIP: | | 100 AMPERES | | | | | | SURFACE MOUNTED | | | | |
| ESTIMATED CONNECTED LOAD: | | 7.48 KVA | | | | | | | | | | |
| CKT NO. | DESCRIPTION | C/B AMPS/POLES | LOAD TYPE | KVA | PH-A | PH-B | PH-C | KVA | LOAD TYPE | POLES | DESCRIPTION | CKT NO. |
| 1 | UNIT HEATER NO. UH-301 | 20A | MOTOR | 0.143 | 0.286 | | | 0.143 | MOTOR | 20A | UNIT HEATER NO. UH-302 | 2 |
| 3 | | | MOTOR | 0.143 | | 0.286 | | 0.143 | MOTOR | | | 4 |
| 5 | | 3P | MOTOR | 0.143 | | | 0.286 | 0.143 | MOTOR | 3P | | 6 |
| 7 | UNIT HEATER NO. UH-305 | 20A | MOTOR | 0.443 | 0.886 | | | 0.443 | MOTOR | 20A | UNIT HEATER NO. UH-306 | 8 |
| 9 | | | MOTOR | 0.443 | | 0.886 | | 0.443 | MOTOR | | | 10 |
| 11 | | 3P | MOTOR | 0.443 | | | 0.886 | 0.443 | MOTOR | 3P | | 12 |
| 13 | UNIT HEATER NO. UH-307 | 20A | MOTOR | 0.443 | 0.886 | | | 0.443 | MOTOR | 20A | UNIT HEATER NO. UH-308 | 14 |
| 15 | | | MOTOR | 0.443 | | 0.886 | | 0.443 | MOTOR | | | 16 |
| 17 | | 3P | MOTOR | 0.443 | | | 0.886 | 0.443 | MOTOR | 3P | | 18 |
| 19 | UNIT HEATER NO. UH-313 | 20A | MOTOR | 0.143 | 0.286 | | | 0.143 | MOTOR | 20A | UNIT HEATER NO. UH-314 | 20 |
| 21 | | | MOTOR | 0.143 | | 0.286 | | 0.143 | MOTOR | | | 22 |
| 23 | | 3P | MOTOR | 0.143 | | | 0.286 | 0.143 | MOTOR | 3P | | 24 |
| 25 | SPARE | 20A | | 0.143 | | | | 0.143 | MOTOR | 20A | UNIT HEATER NO. UH-324 | 26 |
| 27 | | | | | | 0.143 | | 0.143 | MOTOR | | | 28 |
| 29 | | 3P | | | | | 0.143 | 0.143 | MOTOR | 3P | | 30 |
| 31 | SPARE | 20A | | | 0.000 | | | | | 20A | SPARE | 32 |
| 33 | | | | | | 0.000 | | | | | | 34 |
| 35 | | 3P | | | | | 0.000 | | | 3P | | 36 |
| 37 | SPARE | 20A | | | 0.000 | | | | | 20A | SPARE | 38 |
| 39 | | | | | | 0.000 | | | | | | 40 |
| 41 | | 3P | | | | | 0.000 | | | 3P | | 42 |
| LOAD SUMMARY | | | | | 3.516 | 2.487 | 2.487 | 2.487 | 3.945 | | | |
| PANEL TOTAL KVA: | | | | | 7.461 | | | | | | | |

NOTE:
ALL CONDUCTORS TO BE 3 #12, 1 #12G IN 3/4-INCH PVC COATED CONDUIT, UNLESS OTHERWISE INDICATED ON POWER PLAN.

RECORD DRAWING

THIS DRAWING HAS BEEN REVIEWED TO REFLECT MAJOR CHANGES, IF ANY, WHICH OCCURRED DURING CONSTRUCTION. REVISIONS ARE BASED UPON INFORMATION SUPPLIED BY CONTRACTOR.
DATE: 10/21/05 PER: [Signature]

THIS DRAWING WAS PREPARED AT THE SCALE INDICATED IN THE TITLE BLOCK. INACCURACIES IN THE TITLE SCALE MAY BE INTRODUCED WHEN DRAWINGS ARE REPRODUCED BY ANY MEANS. USE THE GRAPHIC SCALE BAR IN THE TITLE BLOCK TO DETERMINE THE ACTUAL SCALE OF THIS DRAWING.

Layer: ON=*; OFF=*REF*
4/11/01 BBL DCC
Q5503000/0659E311.DWG

| No. | Date | Revisions | Init |
|-----|----------|---------------------|------|
| 0 | 4/20/01 | ISSUED FOR APPROVAL | WJ |
| 1 | | AS BID | |
| 2 | 10/31/05 | RECORD DRAWING | |



In charge of --- TEL
Designed by --- MEE
Drawn by --- DCC
Checked by --- WFH

ENVIRONMENTAL ENGINEERING ASSOCIATES, LLP
SYRACUSE, NEW YORK

ONONDAGA COUNTY • DEPARTMENT OF DRAINAGE AND SANITATION • SYRACUSE, NEW YORK
METROPOLITAN SYRACUSE WASTEWATER TREATMENT PLANT
STAGE III AMMONIA AND STAGE II PHOSPHORUS REMOVAL PROJECT
HRFS COMPLEX
HRFS SCHEDULES AND DETAILS



File Number: 00659
Date: APRIL 2001
E-311
[Signature]

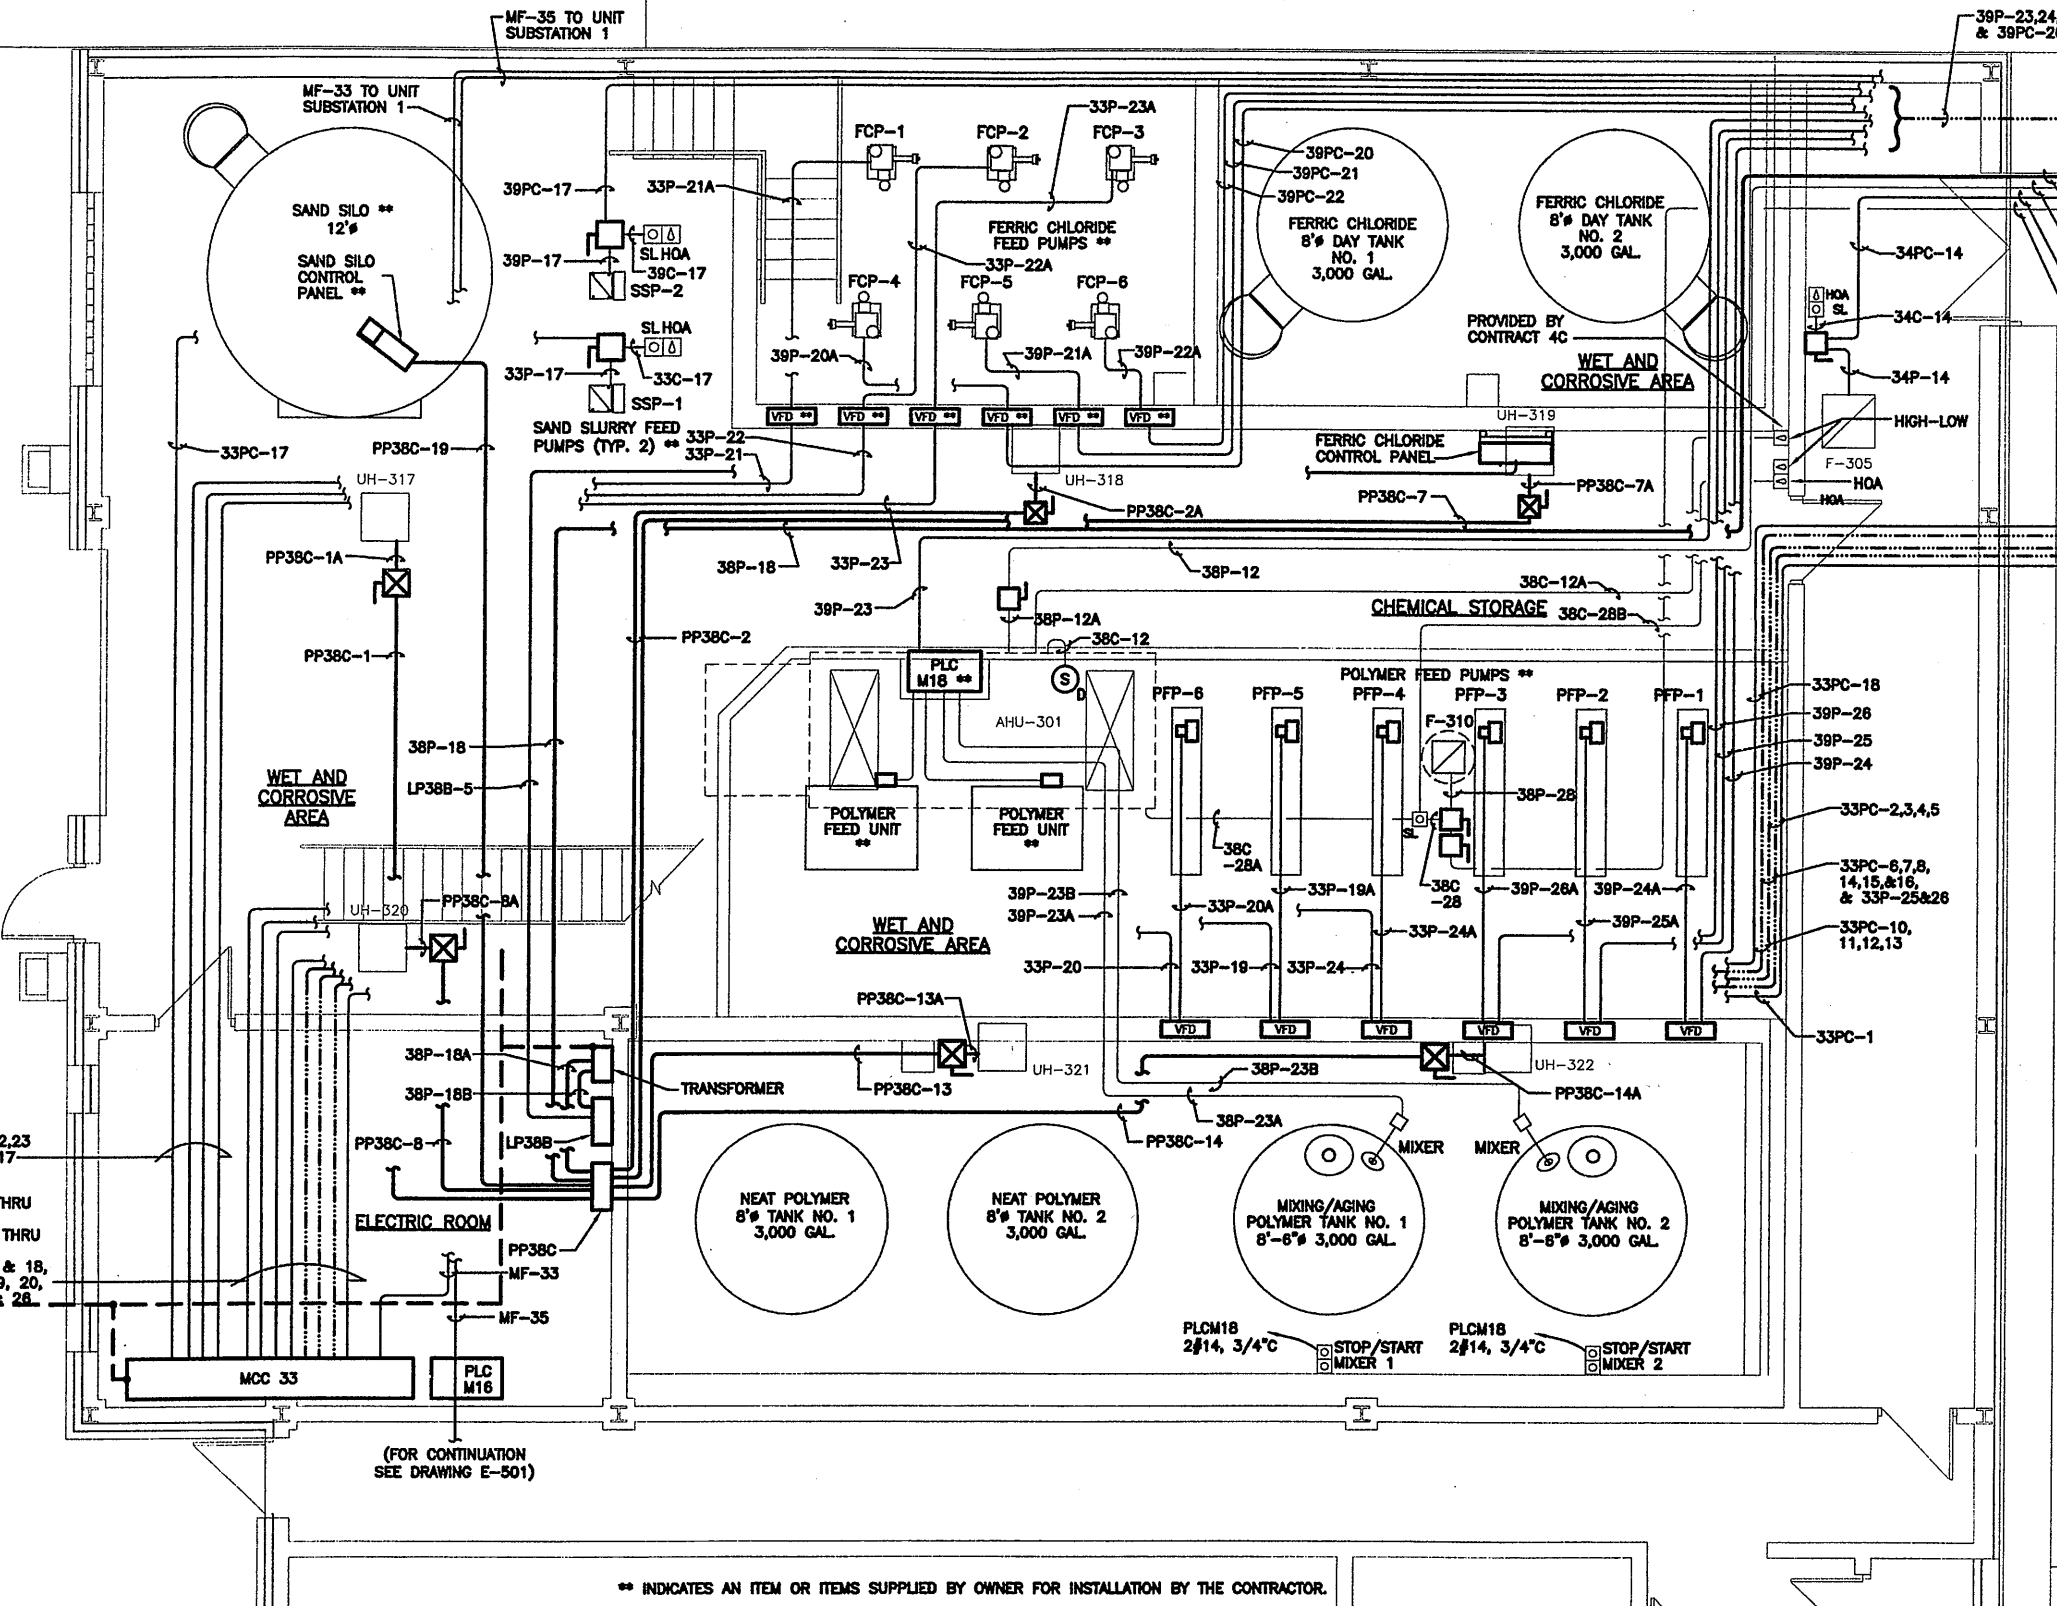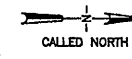


- NOTES:**
- SAND SLURRY FEED PUMPS NO. 1 & 2 SHALL HAVE A SEALWATER SOLENOID AND FLOW SWITCH WIRED AS SHOWN ON MCC ONE-LINE DIAGRAMS.
 - PROVIDE THE FOLLOWING WIRING ASSOCIATED WITH EACH POLYMER FEED PUMP NOS. 1-6:
 - 1-#16 SHIELDED TWISTED PAIR ROUTED FROM DISCHARGE PRESSURE TRANSMITTER TO PLCM18 ANALOG INPUT MODULE. PROVIDE 3/4" CONDUIT FROM TRANSMITTER TO PUMP VFD AND UTILIZE CONDUITS HCCH401B, HCCH402B, HCCH403B, HCCH404B, HCCH405B AND HCCH406B (FOR PUMPS NO. 1-6 RESPECTIVELY) FOR ROUTING.
 - 5-#14 IN 3/4" CONDUIT ROUTED FROM PUMP VFD TO A JUNCTION BOX LOCATED AT THE PUMP. 3-#14 SHALL CONTINUE FROM JUNCTION BOX IN 3/4" CONDUIT TO THE PUMP LEAK DETECTOR. 2-#14 SHALL CONTINUE FROM THE JUNCTION BOX IN 3/4" CONDUIT TO THE PUMP STROKE LENGTH CONTROLLER.
 - 6-#14 IN 3/4" CONDUIT FROM THE PUMP STROKE LENGTH CONTROLLER TO THE PUMP STROKE LENGTH ACTUATOR.
 - 1-#16 SHIELDED TWISTED PAIR ROUTED FROM THE PUMP STROKE LENGTH CONTROLLER TO PUMP VFD AND UTILIZE CONDUITS HCCH501B, HCCH502B, HCCH503B, HCCH504B, HCCH505B AND HCCH506B (FOR PUMPS NO. 1-6 RESPECTIVELY) FOR ROUTING.
 - 4-#14 IN 3/4" CONDUIT FROM HIGH AND LOW DISCHARGE PRESSURE SWITCHES.
 - PROVIDE THE FOLLOWING WIRING FROM PLCM18 TO EACH POLYMER FEED UNIT (TYPICAL 2).
 - 3-#12, 1-#12 GROUND IN 3/4" CONDUIT TO UNIT MOUNTED MIXER MOTOR.
 - 8-#14 IN 3/4" CONDUIT TO UNIT MOUNTED TERMINAL BOX (CONTROLS).
 - 3-#14 IN 3/4" CONDUIT TO UNIT MOUNTED TERMINAL BOX (FLOW SENSOR).
 - PROVIDE THE FOLLOWING WIRING FROM PLCM18 TO LIT-30037 (TYPICAL LIT-30040):
 - 6-#14, 1-#14 GROUND IN 3/4" CONDUIT (120 VAC POWER, LSH-30037, LSL-30037).
 - 1-#16 SHIELDED TWISTED PAIR IN 3/4" CONDUIT.
 - PROVIDE THE FOLLOWING WIRING ASSOCIATED WITH NEAT POLYMER TANK NO. 1 AND 2 LEVEL TRANSMITTERS LIT-50035 AND LIT-50038:
 - 1-#16 SHIELDED TWISTED PAIR IN CONDUITS HCCH201B AND HCCH202B IN LIEU OF RG62 A/U COAX.
 - 4-#14 IN 3/4" CONDUIT (DESIGNATED HCCH201C AND HCCH202C) ROUTED FROM EACH LEVEL TRANSMITTER TO PLCM18.
 - PROVIDE 8-#14, 1-#14 GROUND IN 3/4" CONDUIT FROM PLCM18 TO POLYMER FEED PUMP DISCHARGE FLOW METERS FIT-30043, FIT-30044, FIT-30045 AND FIT-30046 (120 VAC POWER).
 - PROVIDE THE FOLLOWING WIRING ASSOCIATED WITH DOOR OC124:
 - PROVIDE 480 VAC, 3 PHASE POWER TO DOOR FROM POWER PANEL PP38C. UTILIZE SPARE 20AMP, 3 POLE CIRCUIT BREAKER (CIRCUIT 25, 27, 28) AND 3-#12, 1-#12 GROUND IN 3/4" CONDUIT ROUTED FROM PP38C TO DOOR OPERATOR. PROVIDE A 30AMP, 3 POLE, NEMA 4 DISCONNECT SWITCH AT DOOR OPERATOR.
 - PROVIDE 120 VAC, 1 PHASE POWER TO DOOR ALARM BELLS AND LIGHT. UTILIZE SPARE 20 AMP, 1 POLE CIRCUIT BREAKER IN LIGHTING PANELBOARD LP38B (CIRCUIT 27) AND 2-#12, 1-#12 GROUND IN 3/4" CONDUIT ROUTED FROM LP38B TO ALARM BELL AND LIGHT.
 - 2-#12 IN 3/4" CONDUIT FROM DOOR OPERATOR TO DOOR ALARM BELL AND LIGHT.
 - 2-#14 IN 3/4" CONDUIT FROM DOOR OPERATOR TO DOOR SENSING EDGE JUNCTION BOX.
 - 2-#14 IN 3/4" CONDUIT FROM DOOR OPERATOR TO DOOR GUIDE INTERLOCK SWITCHES (TYPICAL 2).
 - 3-#14 IN 3/4" CONDUIT FROM DOOR OPERATOR TO INTERIOR MOUNTED PUSHBUTTON STATION AND 4-#14 IN 3/4" CONDUIT FROM INTERIOR PUSHBUTTON STATION TO EXTERIOR PUSHBUTTON STATION.

** INDICATES AN ITEM OR ITEMS SUPPLIED BY OWNER FOR INSTALLATION BY THE CONTRACTOR.

CHEMICAL BUILDING C POWER PLAN
SCALE: 1/4"=1'-0"

Layer: ON=*, OFF=*REF*
X: 0659X01.DWG
4/11/01 BBL DCC
0550300/0659E312.DWG

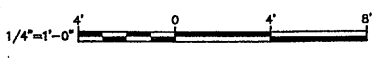

NO ALTERATIONS PERMITTED HEREON EXCEPT AS PROVIDED UNDER SECTION 7209 SUBDIVISION 2 OF THE NEW YORK STATE EDUCATION LAW

| No. | Date | Revisions | Init |
|-----|----------|---------------------|------|
| 0 | 4/20/01 | ISSUED FOR APPROVAL | TEL |
| 1 | | AS BID | |
| 2 | 10/31/05 | RECORD DRAWING | |

In charge of --- TEL ---
Designed by --- MEE ---
Drawn by --- DCC ---
Checked by --- WFH ---



ONONDAGA COUNTY • DEPARTMENT OF DRAINAGE AND SANITATION • SYRACUSE, NEW YORK
METROPOLITAN SYRACUSE WASTEWATER TREATMENT PLANT
STAGE III AMMONIA AND STAGE II PHOSPHORUS REMOVAL PROJECT
CHEMICAL BUILDING C
CHEMICAL BUILDING C POWER PLAN




File Number
00659
Date
APRIL 2001
E-312

RECORD DRAWING
THIS DRAWING HAS BEEN REVIEWED TO REFLECT MAJOR CHANGES, IF ANY, WHICH OCCURRED DURING CONSTRUCTION. REVISIONS ARE BASED UPON INFORMATION SUPPLIED BY CONTRACTOR.
DATE: 10/21/07 PER: [Signature]

THIS DRAWING WAS PREPARED AT THE SCALE INDICATED IN THE TITLE BLOCK. INACCURACIES IN THE STATED SCALE MAY BE INTRODUCED WHEN DRAWINGS ARE REPRODUCED BY ANY MEANS. USE THE GRAPHIC SCALE BAR IN THE TITLE BLOCK TO DETERMINE THE ACTUAL SCALE OF THIS DRAWING.

ELECTRICAL

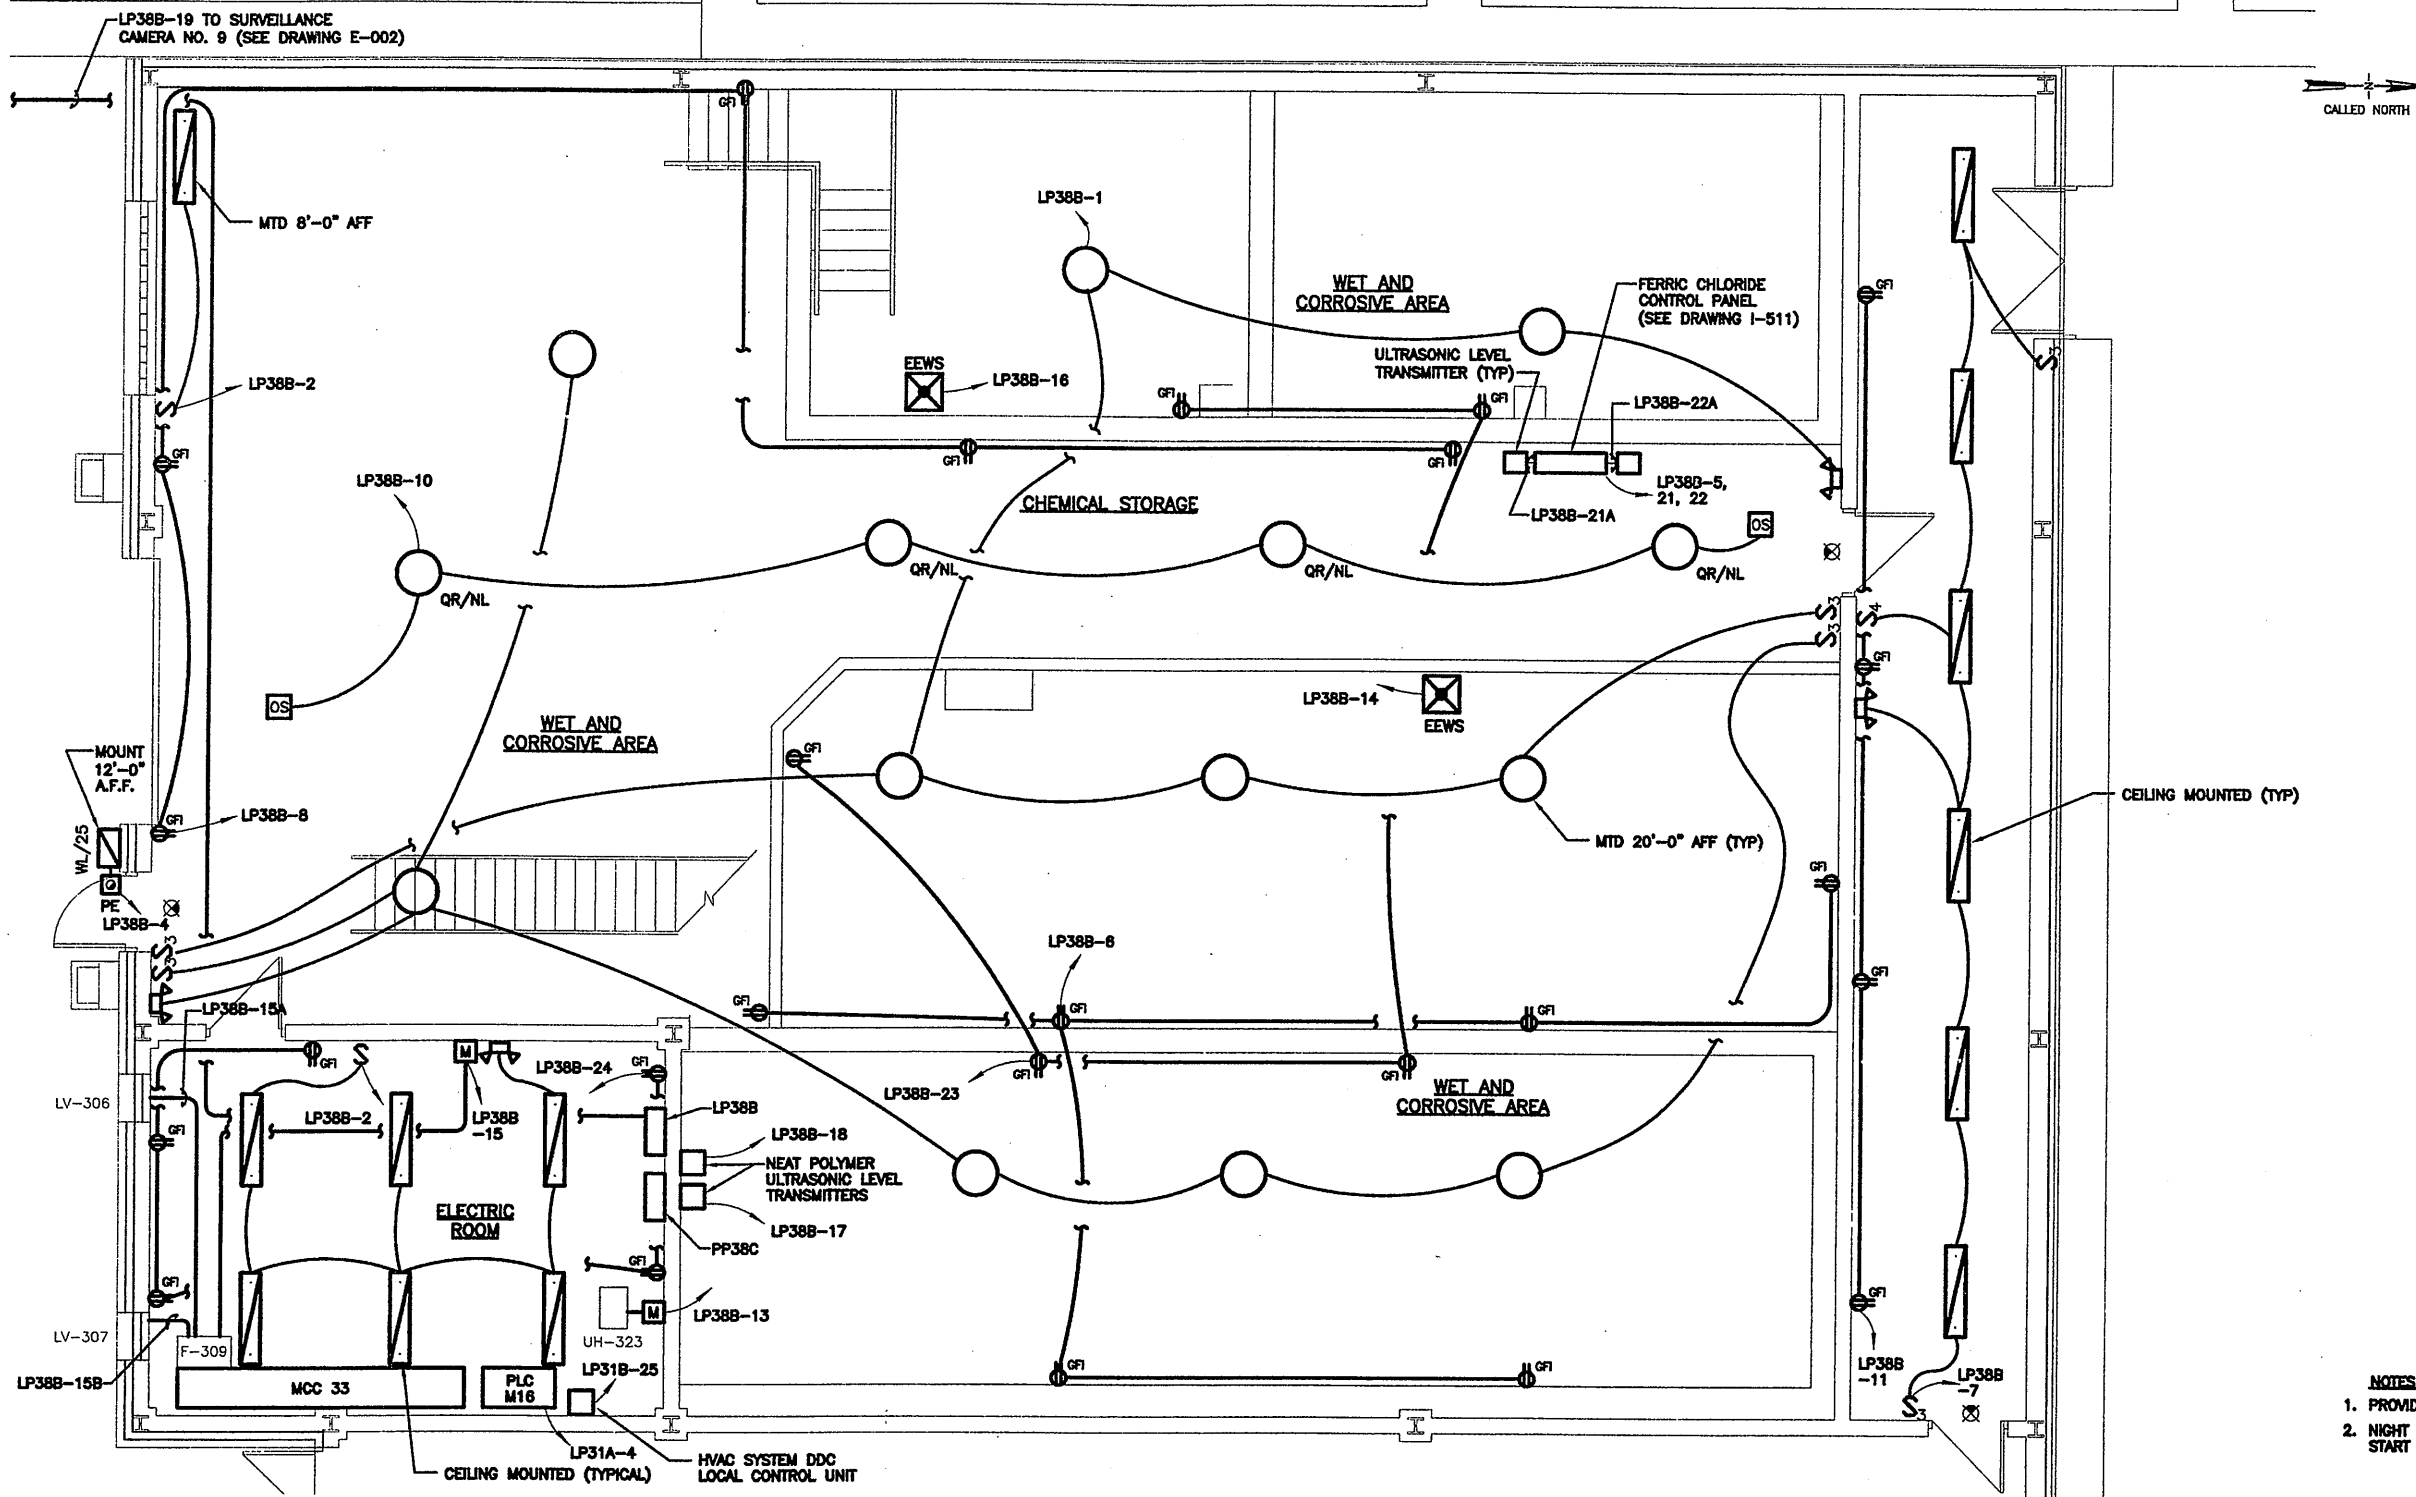

↑
CALLED NORTH

- NOTES:**
1. PROVIDE LIGHTING CONTACTOR FOR METAL HALIDE CIRCUITS.
 2. NIGHT LIGHT CIRCUIT REQUIRES BI-LEVEL BALLAST CONTROL SYSTEM WITH START AT HIGH LEVEL, OCCUPANCY DETECTORS AND MANUAL SWITCHING.

CHEMICAL BUILDING C LIGHTING PLAN
SCALE: 1/4"=1'-0"

RECORD DRAWING
THESE DRAWINGS HAVE BEEN REVIEWED TO REFLECT MAJOR CHANGES, IF ANY, WHICH OCCURRED DURING CONSTRUCTION. REVISIONS ARE BASED UPON INFORMATION SUPPLIED BY CONTRACTOR.
DATE: 10/21/05 PER: [Signature]

THIS DRAWING WAS PREPARED AT THE SCALE INDICATED IN THE TITLE BLOCK. INACCURACIES IN THE STATED SCALE MAY BE INTRODUCED WHEN DRAWINGS ARE REPRODUCED BY ANY MEANS. USE THE GRAPHIC SCALE BAR IN THE TITLE BLOCK TO DETERMINE THE ACTUAL SCALE OF THIS DRAWING.

Layer: ON=; OFF=*REF*
X: 0659X501.DWG
4/10/01 BBL DCC
05503000/0659E313.DWG

1/4"=1'-0"
NO ALTERATIONS PERMITTED HEREON EXCEPT AS PROVIDED UNDER SECTION 7209 SUBDIVISION 2 OF THE NEW YORK STATE EDUCATION LAW

| No. | Date | Revisions | Init |
|-----|----------|---------------------|------|
| 0 | 4/20/01 | ISSUED FOR APPROVAL | LC |
| 1 | | AS BID | |
| 2 | 10/31/05 | RECORD DRAWING | |

In charge of TEL
Designed by MEE
Drawn by DCC
Checked by WFH

ENVIRONMENTAL ENGINEERING ASSOCIATES, LLP
SYRACUSE, NEW YORK

ONONDAGA COUNTY • DEPARTMENT OF DRAINAGE AND SANITATION • SYRACUSE, NEW YORK
METROPOLITAN SYRACUSE WASTEWATER TREATMENT PLANT
STAGE III AMMONIA AND STAGE II PHOSPHORUS REMOVAL PROJECT
CHEMICAL BUILDING C LIGHTING PLAN
ELECTRICAL

File Number 00659
Date APRIL 2001
E-313
[Professional Engineer Seal]

| CIRCUIT BREAKER PANELBOARD - LP-38B | | | | | | | | | | SCHEDULE | | |
|-------------------------------------|--------------------------------|-----------------------------------|-----------|--------|-------|-----------------|-------|-----------------|-----------|---------------|--------------------------------|---------|
| LOCATION: | | CHEMICAL BUILDING C ELECTRIC ROOM | | | | FEED FROM | | PP-38C-20 | | | | |
| MAIN BUS RATING: | | 225 AMPERES | | | | 208/120 VOLTS | | 3 PHASE, 4 WIRE | | | | |
| MINIMUM SHORTCIRCUIT: | | 10,000 AMPERES | | | | FEEDER CABLE | | 4 #3, 1 #8G | | | | |
| MAIN BREAKER TRIP: | | 100 AMPERES | | | | SURFACE MOUNTED | | | | | | |
| ESTIMATED CONNECTED LOAD: | | 12.595 KVA | | | | | | | | | | |
| CKT NO. | DESCRIPTION | CB AMPS/POLES | LOAD TYPE | KVA | PH-A | PH-B | PH-C | KVA | LOAD TYPE | CB AMPS/POLES | DESCRIPTION | CKT NO. |
| 1 | CHEM BLDG C INTERIOR LIGHTS | 20/1P | LIGHTS | 1.415 | 2.108 | | | 0.693 | LIGHTS | 20/1P | ELEC ROOM LIGHTS | 2 |
| 3 | CHEM. BLDG. C INTERIOR LIGHTS | 20/1P | LIGHTS | 1.415 | | 1.965 | | 0.550 | LIGHTS | 20/1P | ELEC ROOM LIGHTS | 4 |
| 5 | FERRIC CHLORIDE CONT. PANEL | 20/1P | CONTROL | 0.600 | | | 1.680 | 1.080 | RECEPT | 20/1P | RECEPTACLES - EAST | 6 |
| 7 | HALLWAY LIGHTS | 20/1P | LIGHTS | 0.658 | 1.559 | | | 0.900 | RECEPT | 20/1P | RECEPTACLES - WEST | 8 |
| 9 | SPARE | 20/1P | CONTROL | 0.200 | | 1.280 | | 1.080 | LIGHTS | 20/1P | CHEM BLDG C NIGHT LIGHTS | 10 |
| 11 | HALLWAY RECEPTACLES | 20/1P | RECEPT | 0.720 | | | 0.720 | | LIGHTS | 20/1P | POLYMER TRUCK PANEL | 12 |
| 13 | UNIT HEATER NO. UH-323 | 20/1P | MOTOR | 0.093 | 0.193 | | | 0.100 | HEAT | 20/1P | SPARE | 14 |
| 15 | EXHAUST FAN F-309 AND LOUVERS | 20/1P | MOTOR | 0.600 | | 0.700 | | 0.100 | HEAT | 20/1P | SPARE | 16 |
| 17 | LT-50035, NEAT POLYMER TK #1 | 20/1P | INST | 0.015 | | | 0.030 | 0.015 | INST | 20/1P | LT-50038, NEAT POLYMER TK #2 | 18 |
| 19 | CLOSED CIRCUIT TV CAMERA NO. 9 | 20/1P | CONTROL | 0.030 | 0.030 | | | | | 20/1P | SAND TRUCK PANEL | 20 |
| 21 | LT-30081, FERRIC CHL DAY TK #1 | 20/1P | INST | 0.015 | | 0.030 | | 0.015 | INST | 20/1P | LT-30082, FERRIC CHL DAY TK #2 | 22 |
| 23 | SUMP RECEPTACLES | 20/1P | RECEPT | 0.900 | | | 1.800 | 0.900 | RECEPT | 20/1P | ELEC ROOM RECEPTACLES | 24 |
| 25 | LOCAL CONTROL UNIT HVAC | 20/1P | CONTROLS | 0.500 | 0.500 | | | | | 20/1P | AHU-301 LIGHTS & RECEPTACLES | 26 |
| 27 | O.H. DOOR CONTROL | 20/1P | | | | 0.000 | | | | 20/1P | SPARE | 28 |
| 29 | SPARE | 20/1P | | | | 0.000 | | | | 20/1P | SPARE | 30 |
| 31 | SPARE | 20/1P | | | 0.000 | | | | | 20/1P | LIGHT AT SAND SILO S.W. | 32 |
| 33 | SPARE | 20/1P | | | 0.000 | | | | | 20/1P | SPARE | 34 |
| 35 | SPARE | 20/1P | | | | 0.000 | | | | 20/1P | SPARE | 36 |
| 37 | SPARE | 20/1P | | | 0.000 | | | | | 20/1P | SPARE | 38 |
| 39 | SPARE | 20/1P | | | | 0.000 | | | | 20/1P | SPARE | 40 |
| 41 | SPARE | 20/1P | | | | 0.000 | | | | 20/1P | SPARE | 42 |
| LOAD SUMMARY | | | | 7.182 | 4.390 | 3.975 | 4.230 | 5.433 | | | | |
| PANEL TOTAL KVA: | | | | 12.595 | | | | | | | | |

NOTE:
ALL CONDUCTORS TO BE 2 #12, 1 #12G IN 3/4-INCH PVC COATED RIGID STEEL CONDUIT, UNLESS OTHERWISE INDICATED ON POWER PLAN.

| CIRCUIT BREAKER PANELBOARD - PP-38C | | | | | | | | | | SCHEDULE | | |
|-------------------------------------|-------------------------|-----------------------------------|-----------|--------|--------|-----------------|--------|-----------------|-----------|---------------|------------------------|---------|
| LOCATION: | | CHEMICAL BUILDING C ELECTRIC ROOM | | | | FEED FROM | | MCC 38, 6AR | | | | |
| MAIN BUS RATING: | | 225 AMPERES | | | | 480 VOLT | | 3 PHASE, 4 WIRE | | | | |
| MINIMUM SHORTCIRCUIT: | | 25,000 AMPERES | | | | FEEDER CABLE | | 3 #3, 1 #8G | | | | |
| MAIN BREAKER TRIP: | | 100 AMPERES | | | | SURFACE MOUNTED | | | | | | |
| ESTIMATED CONNECTED LOAD: | | 43.58 KVA | | | | | | | | | | |
| CKT NO. | DESCRIPTION | CB AMPS/POLES | LOAD TYPE | KVA | PH-A | PH-B | PH-C | KVA | LOAD TYPE | CB AMPS/POLES | DESCRIPTION | CKT NO. |
| 1 | UNIT HEATER NO. UH-317 | 20A | MOTOR | 0.443 | 0.886 | | | 0.443 | MOTOR | 20A | UNIT HEATER NO. UH-318 | 2 |
| 3 | | | | 0.443 | | 0.886 | | 0.443 | | | | 4 |
| 5 | | 3P | | 0.443 | | | 0.886 | 0.443 | | 3P | | 6 |
| 7 | UNIT HEATER NO. UH-319 | 20A | MOTOR | 0.443 | 0.886 | | | 0.443 | MOTOR | 20A | UNIT HEATER NO. UH-320 | 8 |
| 9 | | | | 0.443 | | 0.886 | | 0.443 | | | | 10 |
| 11 | | 3P | | 0.443 | | | 0.886 | 0.443 | | 3P | | 12 |
| 13 | UNIT HEATER NO. UH-321 | 20A | MOTOR | 0.443 | 0.886 | | | 0.443 | MOTOR | 20A | UNIT HEATER NO. UH-322 | 14 |
| 15 | | | | 0.443 | | 0.886 | | 0.443 | | | | 16 |
| 17 | | 3P | | 0.443 | | | 0.886 | 0.443 | | 3P | | 18 |
| 19 | SPARE | 20A | CONTROL | 7.750 | 13.055 | | | 5.305 | SUB | 45A | PANELBOARD LP-38B | 20 |
| 21 | | | | 7.750 | | 13.140 | | 5.190 | | | | 22 |
| 23 | | 3P | | 4.100 | | | 9.410 | 5.310 | | 3P | | 24 |
| 25 | O.H. DOOR | 20A | | | 0.000 | | | | | 20A | SPARE | 26 |
| 27 | | | | | | 0.000 | | | | | | 28 |
| 29 | | 3P | | | | | 0.000 | | | 3P | | 30 |
| 31 | SPARE | 20A | | | 0.000 | | | | | 20A | SPARE | 32 |
| 33 | | | | | | 0.000 | | | | | | 34 |
| 35 | | 3P | | | | | 0.000 | | | 3P | | 36 |
| 37 | SAND SILO CONTROL PANEL | 40A | | | 0.000 | | | | | 20A | SPARE | 38 |
| 39 | | | | | | | 0.000 | | | | | 40 |
| 41 | | 3P | | | | | 0.000 | | | 3P | | 42 |
| LOAD SUMMARY | | | | 23.587 | 15.713 | 15.798 | 12.068 | 19.992 | | | | |
| PANEL TOTAL KVA: | | | | 43.579 | | | | | | | | |

NOTE:
1. ALL CONDUCTORS TO BE 3 #12, 1 #12G IN 3/4-INCH PVC COATED RIGID STEEL CONDUIT, UNLESS OTHERWISE INDICATED ON POWER PLAN.
2. * CONDUCTORS TO BE 3 #6, 1 #8G IN 1-INCH PVC COATED RIGID STEEL CONDUIT.
3. *** SEE 38P-188 ON DRAWING E-212 FOR CONDUIT AND WIRE SCHEDULE.

| CIRCUIT BREAKER PANELBOARD - LP-34C | | | | | | | | | | SCHEDULE | | |
|-------------------------------------|------------------------------|------------------------------|-----------|--------|-------|-----------------|-------|-----------------|-----------|---------------|------------------------------|---------|
| LOCATION: | | HRFS SOUTH HYDROCYCLONE ROOM | | | | FEED FROM | | MCC 38, 3AR | | | | |
| MAIN BUS RATING: | | 225 AMPERES | | | | 208/120 VOLTS | | 3 PHASE, 4 WIRE | | | | |
| MINIMUM SHORTCIRCUIT: | | 10,000 AMPERES | | | | FEEDER CABLE | | 4 #3, 1 #8G | | | | |
| MAIN BREAKER TRIP: | | 100 AMPERES | | | | SURFACE MOUNTED | | | | | | |
| ESTIMATED CONNECTED LOAD: | | 12.95 KVA | | | | | | | | | | |
| CKT NO. | DESCRIPTION | CB AMPS/POLES | LOAD TYPE | KVA | PH-A | PH-B | PH-C | KVA | LOAD TYPE | CB AMPS/POLES | DESCRIPTION | CKT NO. |
| 1 | LIGHTS SOUTH HYDRO ROOM | 20/1P | LIGHTS | 0.500 | 1.200 | | | 0.700 | LIGHTS | 20/1P | LIGHTS NE. HRFS UPPER LEVEL | 2 |
| 3 | LIGHTS NORTH HYDRO ROOM | 20/1P | LIGHTS | 0.500 | | 1.200 | | 0.700 | LIGHTS | 20/1P | LIGHTS SE. HRFS UPPER LEVEL | 4 |
| 5 | LIGHTS SW. HRFS UPPER LEVEL | 20/1P | LIGHTS | 1.200 | | | 1.920 | 0.720 | RECEPT | 20/1P | RECEPTACLES S. HYDRO ROOM | 6 |
| 7 | LIGHTS NW. HRFS UPPER LEVEL | 20/1P | LIGHTS | 1.300 | 2.020 | | | 0.720 | RECEPT | 20/1P | RECEPTACLES N. HYDRO ROOM | 8 |
| 9 | SPARE | 20/1P | LIGHTS | 1.100 | | 1.820 | | 0.720 | RECEPT | 20/1P | RECEPT SCRAPPER DRIVES | 10 |
| 11 | NIGHT LTS, HRFS UPPER LEVEL | 20/1P | MOTOR | 0.600 | | | 1.200 | 0.600 | MOTOR | 20/1P | FAN F-308 AND LOUVER LV-305 | 12 |
| 13 | ROOF DRAIN HEAT TRACE HT-301 | 20/1P | HEAT | 0.720 | 1.056 | | | 0.338 | HEAT | 20/1P | ROOF DRAIN HEAT TRACE HT-304 | 14 |
| 15 | ROOF DRAIN HEAT TRACE HT-302 | 20/1P | HEAT | 0.780 | | 1.404 | | 0.624 | HEAT | 20/1P | ROOF DRAIN HEAT TRACE HT-305 | 16 |
| 17 | ROOF DRAIN HEAT TRACE HT-303 | 20/1P | HEAT | 0.552 | | | 1.128 | 0.576 | HEAT | 20/1P | SPARE | 18 |
| 19 | SPARE | 20/1P | | | 0.000 | | | | | 20/1P | SPARE | 20 |
| 21 | SPARE | 20/1P | | | | 0.000 | | | | 20/1P | SPARE | 22 |
| 23 | F307 & LV304 | 20/1P | | | | 0.000 | | | | 20/1P | SPARE | 24 |
| 25 | SPARE | 20/1P | | | 0.000 | | | | | 20/1P | SPARE | 26 |
| 27 | SPARE | 20/1P | | | | 0.000 | | | | 20/1P | SPARE | 28 |
| 29 | SPARE | 20/1P | | | | 0.000 | | | | 20/1P | SPARE | 30 |
| 31 | SPARE | 20/1P | | | 0.000 | | | | | 20/1P | SPARE | 32 |
| 33 | SPARE | 20/1P | | | | 0.000 | | | | 20/1P | SPARE | 34 |
| 35 | SPARE | 20/1P | | | | | 0.000 | | | 20/1P | SPARE | 36 |
| 37 | SPARE | 20/1P | | | 0.000 | | | | | 20/1P | SPARE | 38 |
| 39 | SPARE | 20/1P | | | | | 0.000 | | | 20/1P | SPARE | 40 |
| 41 | SPARE | 20/1P | | | | | 0.000 | | | 20/1P | SPARE | 42 |
| LOAD SUMMARY | | | | 7.252 | 4.276 | 4.424 | 4.248 | 5.696 | | | | |
| PANEL TOTAL KVA: | | | | 12.948 | | | | | | | | |

NOTES:
1. ALL CONDUCTORS TO BE 2 #12, 1 #12G IN 3/4-INCH PVC COATED RIGID STEEL CONDUIT, UNLESS OTHERWISE INDICATED ON POWER PLAN.
2. HEAT TRACE BRANCH CIRCUIT BRAKERS SHALL BE GFI TYPE.

Layer: ON=; OFF=REF*
4/25/01 BBL DCC
05503000/0859E314.DWG

| | | | | |
|---|-----|----------|---------------------|------|
| NOT TO SCALE | No. | Date | Revisions | Init |
| | 0 | 4/20/01 | ISSUED FOR APPROVAL | Je |
| | 1 | | AS BID | |
| | 2 | 10/31/05 | RECORD DRAWING | |
| NO ALTERATIONS PERMITTED HEREON EXCEPT AS PROVIDED UNDER SECTION 7209 SUBDIVISION 2 OF THE NEW YORK STATE EDUCATION LAW | | | | |

In charge of TEL
Designed by MEE
Drawn by DCC
Checked by WFH


ENVIRONMENTAL ENGINEERING ASSOCIATES, LLP
SYRACUSE, NEW YORK

ONONDAGA COUNTY • DEPARTMENT OF DRAINAGE AND SANITATION • SYRACUSE, NEW YORK
METROPOLITAN SYRACUSE WASTEWATER TREATMENT PLANT
STAGE III AMMONIA AND STAGE II PHOSPHORUS REMOVAL PROJECT
CHEMICAL BUILDING C
SCHEDULES
ELECTRICAL

RECORD DRAWING
THESE DRAWINGS HAVE BEEN REVISIONED TO REFLECT ALL CHANGES, IF ANY, WHICH OCCURRED DURING CONSTRUCTION. REVISIONS ARE BASED UPON INFORMATION SUPPLIED BY CONTRACTOR.
DATE: 10/21/05 FOR: KAMARLET

THIS DRAWING WAS PREPARED AT THE SCALE INDICATED IN THE TITLE BLOCK. INACCURACIES IN THE STATED SCALE MAY BE INTRODUCED WHEN DRAWINGS ARE REPRODUCED BY ANY MEANS. USE THE GRAPHIC SCALE BAR IN THE TITLE BLOCK TO DETERMINE THE ACTUAL SCALE OF THIS DRAWING.

File Number: 00659
Date: APRIL 2001
E-314

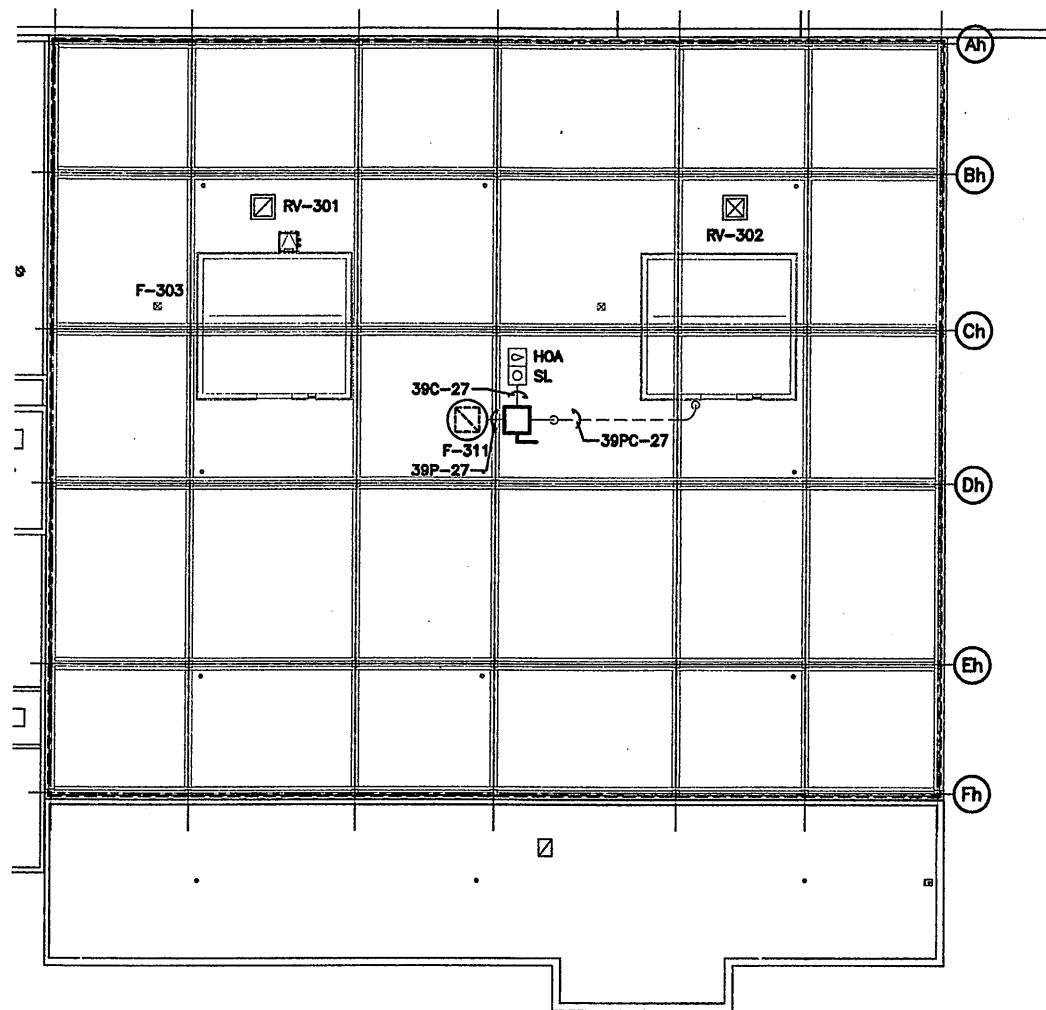

ROOF PLAN
SCALE: 1"=16'-0"


RECORD DRAWING

THESE DRAWINGS HAVE BEEN REVIEWED TO REFLECT
MAJOR CHANGES, IF ANY, WHICH OCCURRED DURING
CONSTRUCTION. REVISIONS ARE BASED UPON
INFORMATION SUPPLIED BY CONTRACTOR.

DATE: 10/26/01 PER: W. Kamphet

THIS DRAWING WAS PREPARED AT THE SCALE INDICATED IN THE
TITLE BLOCK. INACCURACIES IN THE STATED SCALE MAY BE
INTRODUCED WHEN DRAWINGS ARE REPRODUCED BY ANY MEANS.
USE THE GRAPHIC SCALE BAR IN THE TITLE BLOCK TO
DETERMINE THE ACTUAL SCALE OF THIS DRAWING.

0659E315

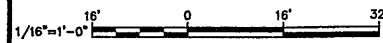

NO ALTERATIONS PERMITTED HEREON EXCEPT
AS PROVIDED UNDER SECTION 7209 SUBDIVISION
2 OF THE NEW YORK STATE EDUCATION LAW

| No. | Date | Revisions | Init |
|-----|----------|----------------|------|
| 0 | | AS BID | LJE |
| 1 | 10/31/05 | RECORD DRAWING | |

In charge of _____
Designed by _____
Drawn by _____
Checked by _____



ONONDAGA COUNTY • DEPARTMENT OF DRAINAGE AND SANITATION • SYRACUSE, NEW YORK
METROPOLITAN SYRACUSE WASTEWATER TREATMENT PLANT
STAGE III AMMONIA AND STAGE II PHOSPHORUS REMOVAL PROJECT

**HRFS
ROOF PLAN**



ELECTRICAL




File Number
00659
Date
JULY 2001

E-315

W. Kamphet

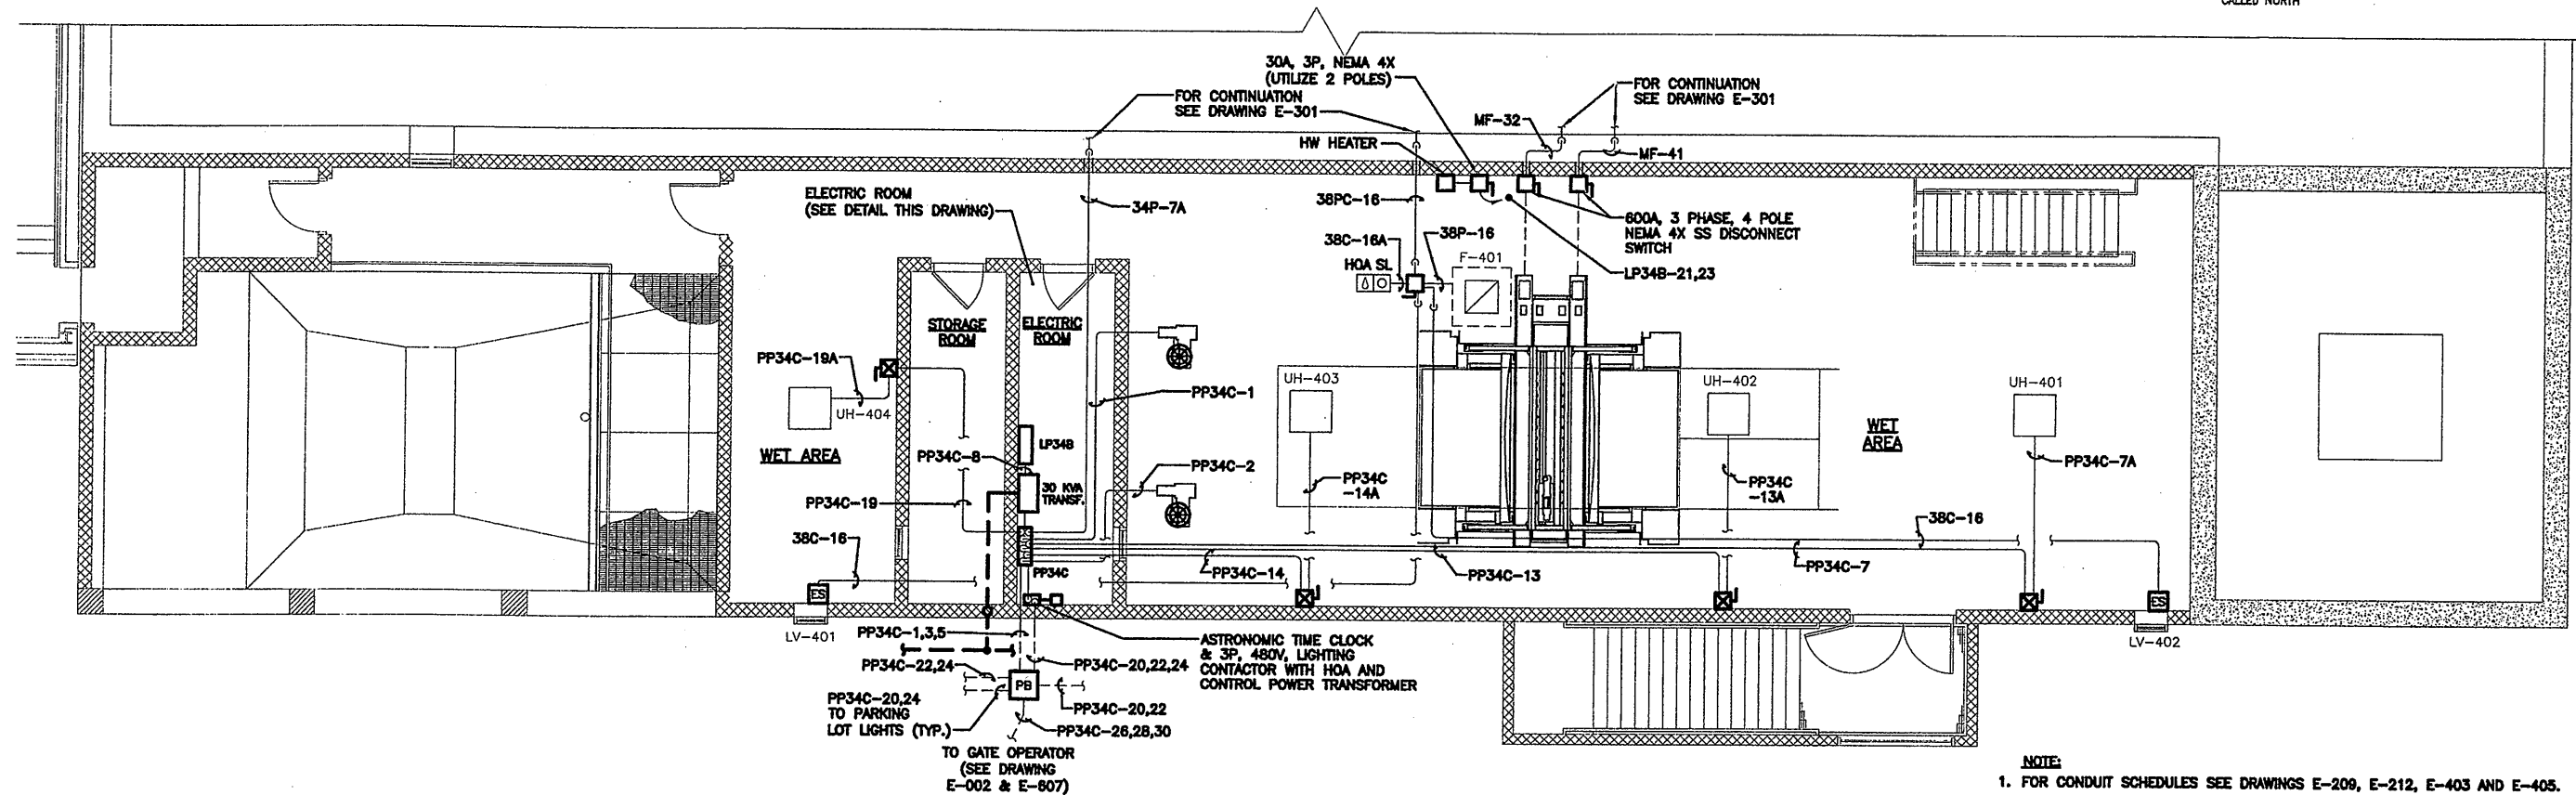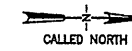

POWER PLAN
SCALE: 3/16"=1'-0"

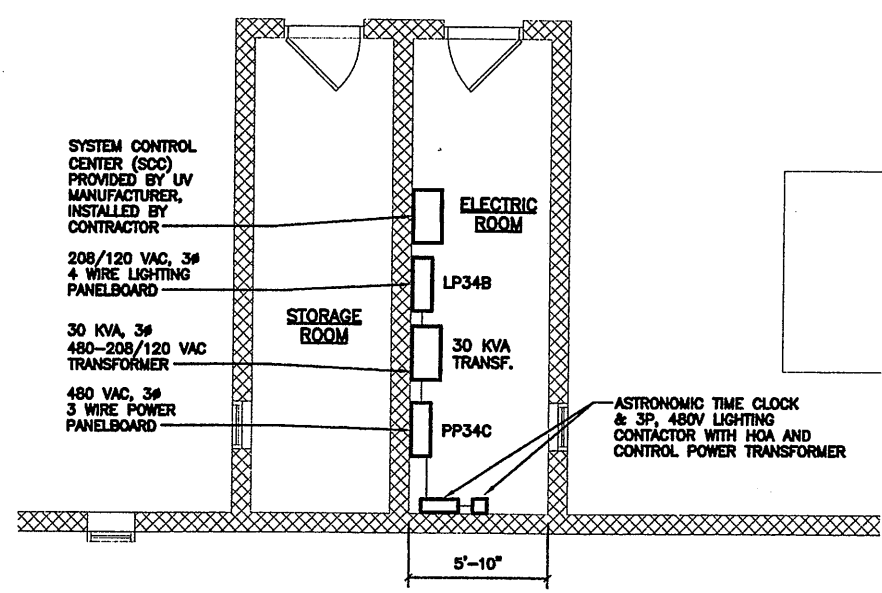

ELECTRIC ROOM PLAN
SCALE: 1/4"=1'-0"


- NOTE:**
- FOR CONDUIT SCHEDULES SEE DRAWINGS E-209, E-212, E-403 AND E-405.
 - CIRCUIT PP34C-20,22,24 SHALL BE 3-#10, 1-#10G IN 3/4" PVC COATED RIGID STEEL CONDUIT.
 - REFER TO HVAC DRAWINGS FOR ADDITIONAL LOUVER, DAMPER, THERMOSTAT, CONTROL VALVE, DIRECT DIGITAL CONTROL (DDC), AND OTHER CONTROL HVAC REQUIREMENTS. CONTRACT 4B (ELECTRICAL) SHALL PROVIDE ALL CONDUIT AND CONDUCTORS FOR 120 VOLT CONTROLS, AS SHOWN OR REQUIRED (EXCEPT WIRING BETWEEN DDC SYSTEM COMPONENTS). CONTRACT 4C (HVAC) SHALL PROVIDE ALL CONDUIT AND CONDUCTORS REQUIRED FOR LOW VOLTAGE (LESS THAN 120 VOLT) CONTROLS AND WIRING BETWEEN DDC SYSTEM COMPONENTS INCLUDING BUT NOT LIMITED TO, LOW VOLTAGE T-STAT, VARIABLE AIR VOLUME (VAV) CONTROLS, ETC.
 - PROVIDE THE FOLLOWING ASSOCIATED WITH CONTROL OF THE ENTRANCE GATE:
 - PROVIDE THREE CONTROL RELAYS (ALLEN-BRADLEY CATALOG NO. 700-HA33A1-1-4) WITH BASES (ALLEN-BRADLEY CATALOG NO. 700-HN101) MOUNTED ON THE FAR RIGHT VERTICAL DIN RAIL IN THE SCC. SEE TROJAN TECHNOLOGIES, INC.'S DRAWING NO. 929155, SHEET 5 OF 7 (REV. D) FOR SCC LAYOUT. RELAYS SHALL BE LABELED AND SHALL HAVE FUNCTIONS AS FOLLOWS:
 - "312CR" - ENTRANCE GATE OPEN CONTROL
 - "313CR" - ENTRANCE GATE CLOSE CONTROL
 - "314CR" - ENTRANCE GATE STOP MOVEMENT
 - PROVIDE CONNECTION OF THE RELAY COILS TO SPARE PLCM14 DISCRETE OUTPUTS "002/08", "002/09" AND "002/10". SEE TROJAN TECHNOLOGIES, INC.'S DRAWING NO. 929155 SHEET 3 OF 7 (REV. D) FOR SPARE DISCRETE OUTPUT LOCATIONS. WIRING FROM THE DISCRETE OUTPUTS TO THE RELAY COILS SHALL BE LABELED AND ROUTED AS FOLLOWS:
 - WIRE NO. "3121" FROM OUTPUT "002/08" TO "312CR"
 - WIRE NO. "3131" FROM OUTPUT "002/09" TO "313CR"
 - WIRE NO. "3141" FROM OUTPUT "002/10" TO "314CR"
 - PROVIDE CONNECTION OF A NORMALLY OPEN CONTACT FROM EACH RELAY DIRECTLY TO THE WIRING IN CONDUIT CC-12 AS REQUIRED FOR GATE OPEN, CLOSE, STOP CONTROL. CC-12 IS 6-#14 IN 1 1/2" CGRS ROUTED FROM THE SCC TO THE ENTRANCE GATE.
 - RELAY COILS SHALL BE NORMALLY DE-ENERGIZED/MOMENTARILY ENERGIZED TO PROVIDE THE OPERATOR SELECTED CONTROL.

RECORD DRAWING

DATE: 10/21/05
BY: J. Campbell

THIS DRAWING WAS PREPARED AT THE SCALE INDICATED IN THE TITLE BLOCK. INACCURACIES IN THE STATED SCALE MAY BE INTRODUCED WHEN DRAWINGS ARE REPRODUCED BY ANY MEANS. USE THE GRAPHIC SCALE BAR IN THE TITLE BLOCK TO DETERMINE THE ACTUAL SCALE OF THIS DRAWING.

Layer: ON=*, OFF=**REF*
X: 0659X402.DWG
4/6/01 BSL DCC
05503000/0659E401.DWG

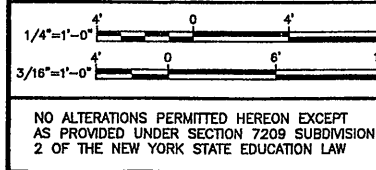

| No. | Date | Revisions | Init |
|-----|----------|---------------------|------|
| 0 | 4/20/01 | ISSUED FOR APPROVAL | LL |
| 1 | | AS BID | |
| 2 | 10/31/05 | RECORD DRAWING | |

In charge of: TEL
Designed by: MEE
Drawn by: DCC
Checked by: WFH





ONONDAGA COUNTY • DEPARTMENT OF DRAINAGE AND SANITATION • SYRACUSE, NEW YORK
METROPOLITAN SYRACUSE WASTEWATER TREATMENT PLANT
STAGE III AMMONIA AND STAGE II PHOSPHORUS REMOVAL PROJECT
UV DISINFECTION/PARSHALL FLUME
POWER PLAN AND ROOM PLAN
ELECTRICAL




File Number: 00659
Date: APRIL 2001

E-401

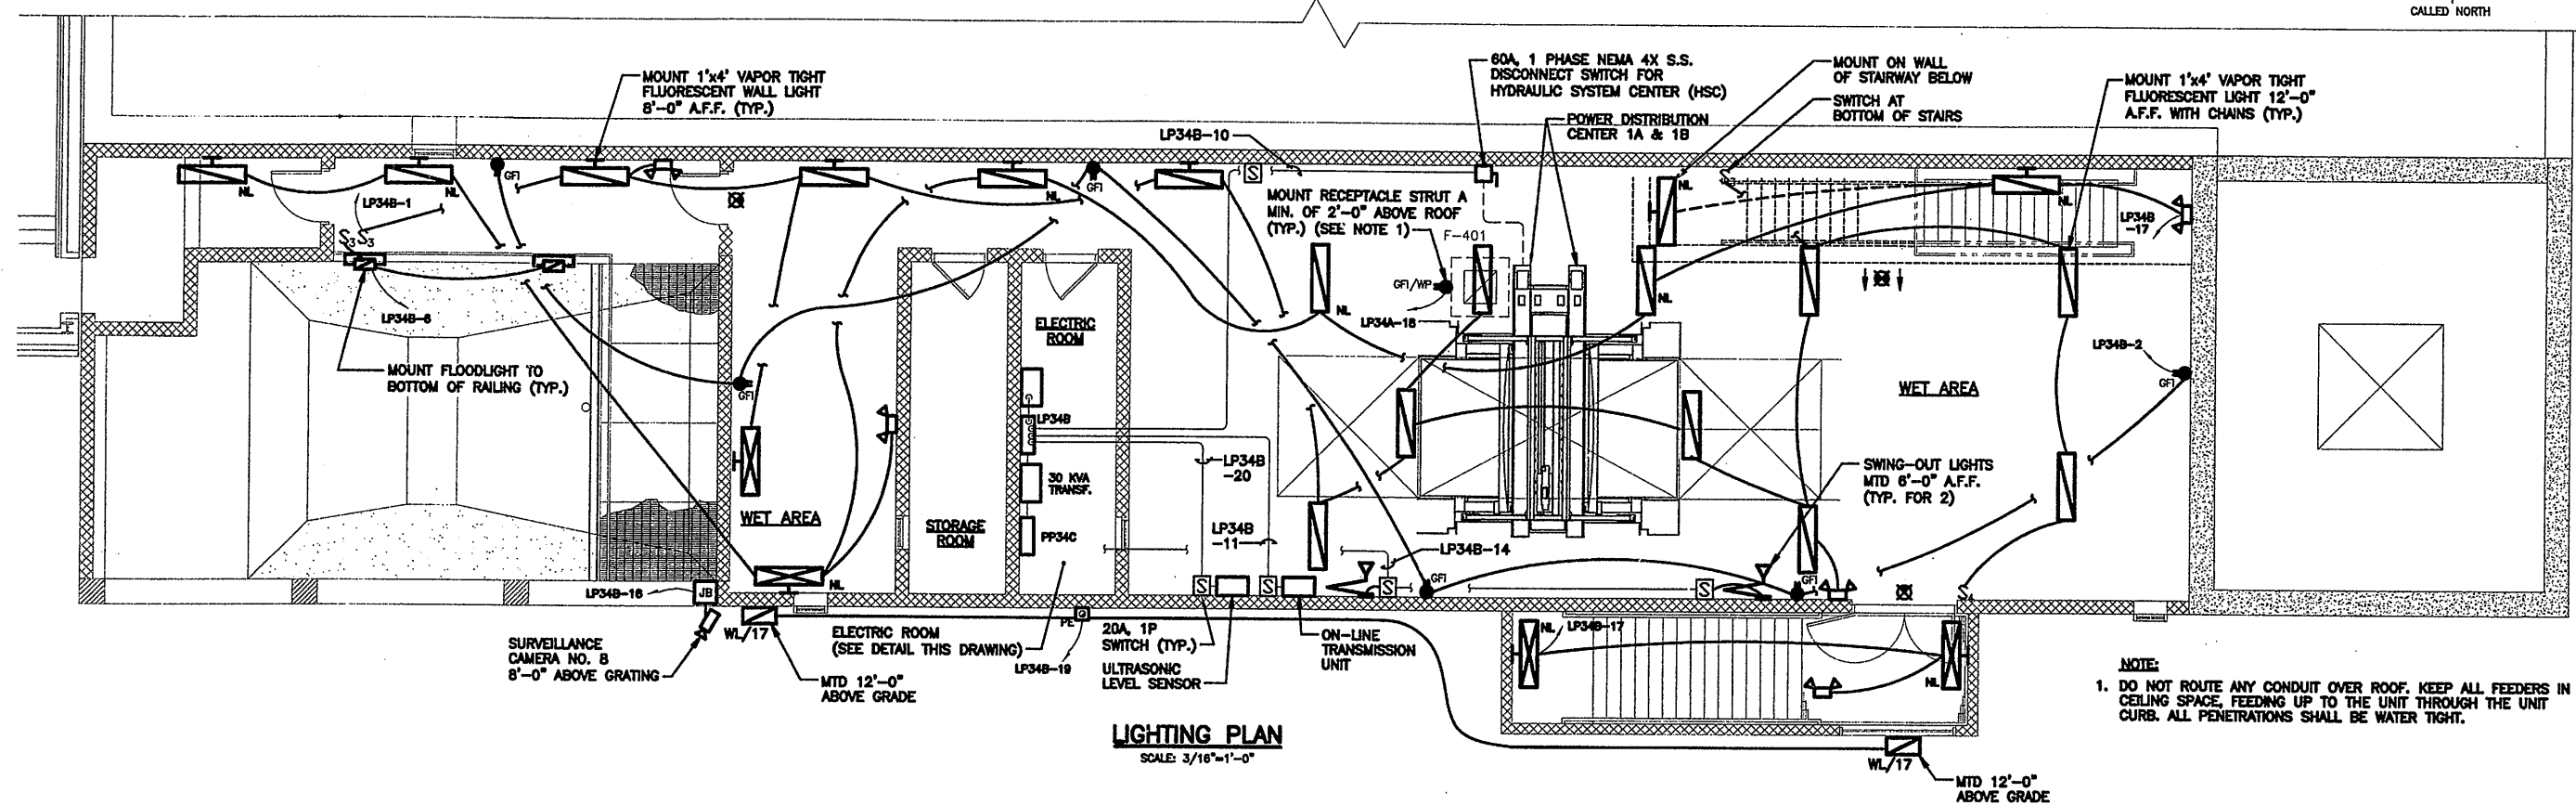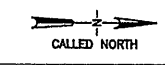


LIGHTING PLAN
SCALE: 3/16"=1'-0"

NOTE:
1. DO NOT ROUTE ANY CONDUIT OVER ROOF. KEEP ALL FEEDERS IN CEILING SPACE, FEEDING UP TO THE UNIT THROUGH THE UNIT CURB. ALL PENETRATIONS SHALL BE WATER TIGHT.

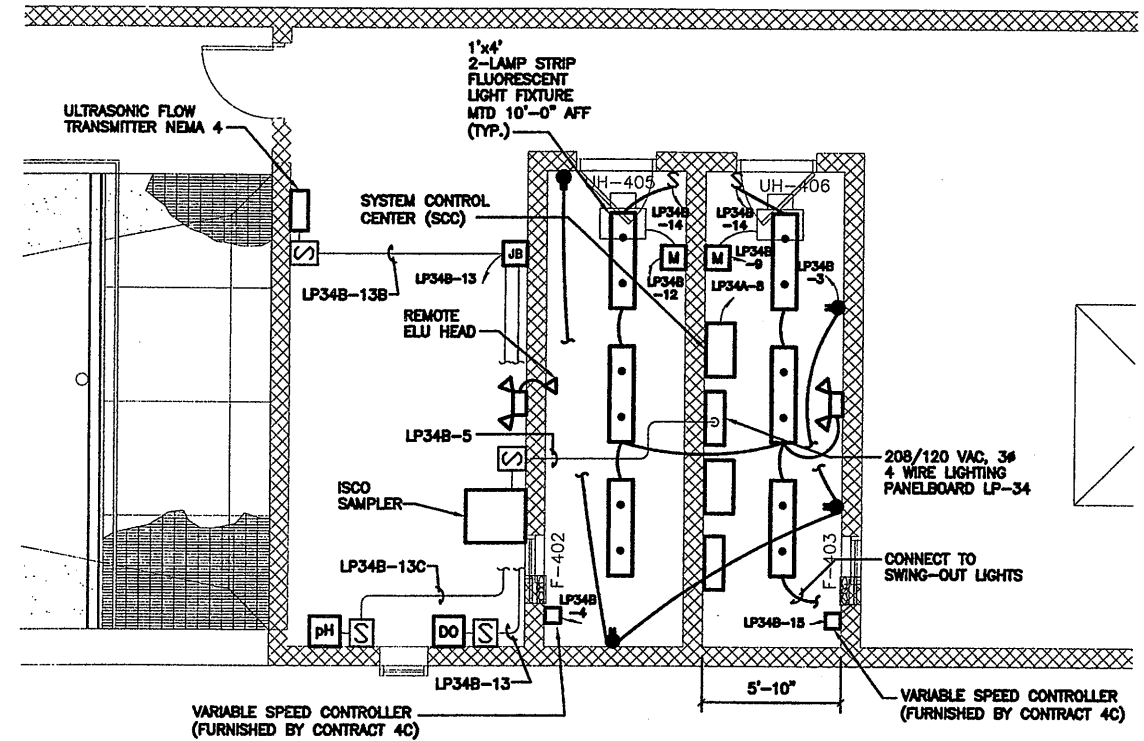

ELECTRIC ROOM PLAN
SCALE: 1/4"=1'-0"

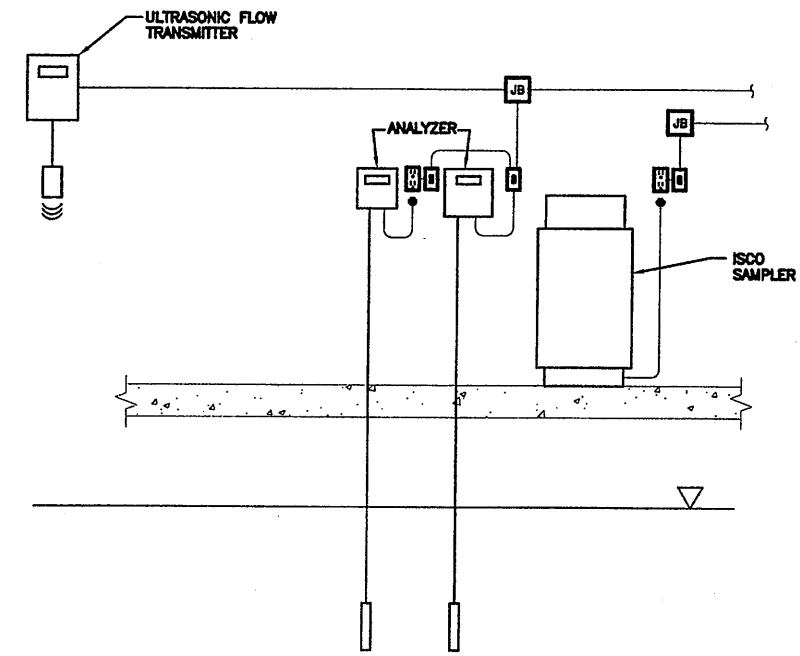


EFFLUENT MONITORING SYSTEM POWER DETAIL
NOT TO SCALE

RECORD DRAWING
THESE DRAWINGS HAVE BEEN REVIEWED TO REFLECT MAJOR CHANGES, IF ANY, WHICH OCCURRED DURING CONSTRUCTION. REVISIONS ARE BASED UPON INFORMATION SUPPLIED BY CONTRACTOR.
DATE: 10/21/05 FOR: K. Kampit

THIS DRAWING WAS PREPARED AT THE SCALE INDICATED IN THE TITLE BLOCK. INACCURACIES IN THE STATED SCALE MAY BE INTRODUCED WHEN DRAWINGS ARE REPRODUCED BY ANY MEANS. USE THE GRAPHIC SCALE BAR IN THE TITLE BLOCK TO DETERMINE THE ACTUAL SCALE OF THIS DRAWING.

Layer: ON=*, OFF=*REF*
X: 0659X401.DWG
4/17/01 BBL DCC
05503000/0659E402.DWG

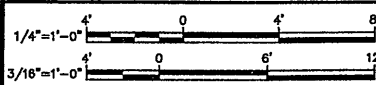

| No. | Date | Revisions | Init |
|-----|----------|---------------------|------|
| 0 | 4/20/01 | ISSUED FOR APPROVAL | JL |
| 1 | | AS BID | |
| 2 | 10/31/05 | RECORD DRAWING | |

In charge of TEL
Designed by MEE
Drawn by DCC
Checked by WFH




ONONDAGA COUNTY • DEPARTMENT OF DRAINAGE AND SANITATION • SYRACUSE, NEW YORK
METROPOLITAN SYRACUSE WASTEWATER TREATMENT PLANT
STAGE III AMMONIA AND STAGE II PHOSPHORUS REMOVAL PROJECT
UV DISINFECTION/PARSHALL FLUME LIGHTING PLANS
ELECTRICAL



File Number
00659
Date
APRIL 2001
E-402

NO ALTERATIONS PERMITTED HEREON EXCEPT AS PROVIDED UNDER SECTION 7209 SUBDIVISION 2 OF THE NEW YORK STATE EDUCATION LAW

| CONDUIT SCHEDULE | | |
|------------------|----------------------------|----------|
| CONDUIT NUMBER | CONDUCTORS QUANTITY \ SIZE | DIAMETER |
| MF-32 | 8 - 350 KCMIL, 1-#2 G | 2-3" C |
| MF-41 | 8 - 350 KCMIL, 1-#2 G | 2-3" C |
| | 2 PER PHASE AND NEUTRAL | |
| | 2 PER PHASE AND NEUTRAL | |

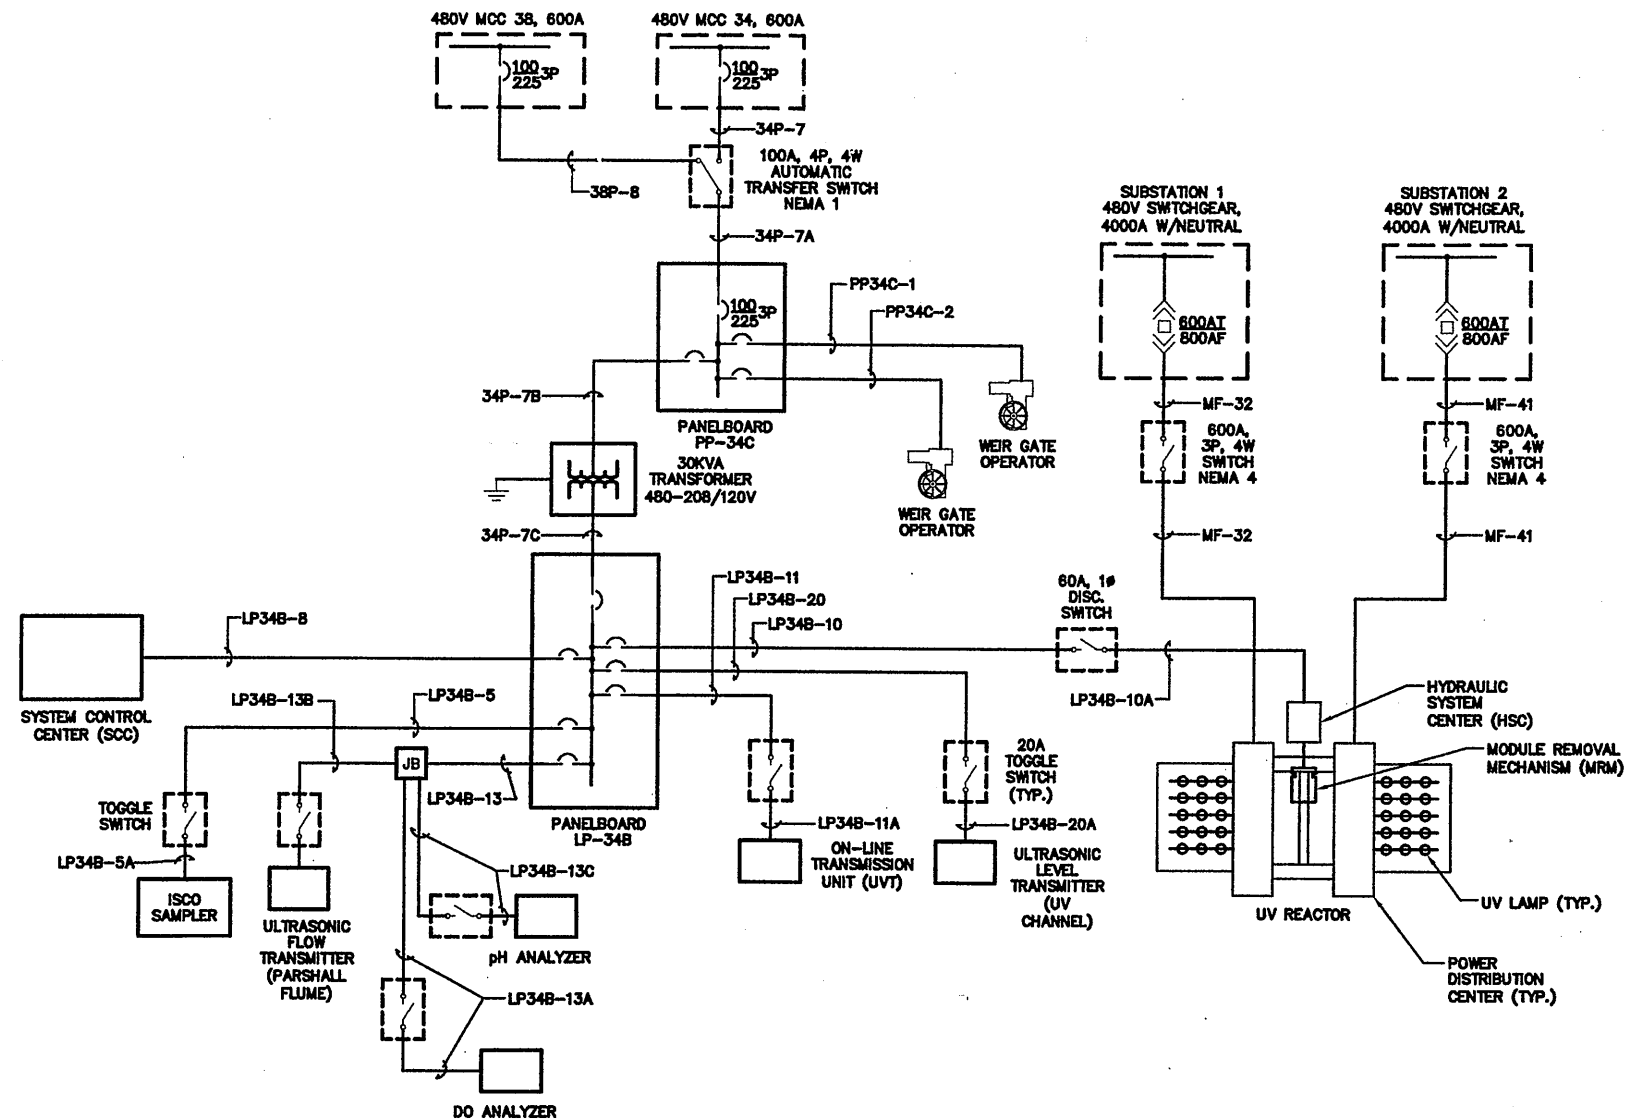

UV DISINFECTION ELECTRICAL ONE-LINE DIAGRAM
NOT TO SCALE

RECORD DRAWING

THESE DRAWINGS HAVE BEEN REVIEWED TO REFLECT
MAJOR CHANGES, IF ANY, WHICH OCCURRED DURING
CONSTRUCTION. REVISIONS ARE BASED UPON
INFORMATION SUPPLIED BY CONTRACTOR.
DATE: 10/21/05 FOR: [Signature]

THIS DRAWING WAS PREPARED AT THE SCALE INDICATED IN THE
TITLE BLOCK. INACCURACIES IN THE STATED SCALE MAY BE
INTRODUCED WHEN DRAWINGS ARE REPRODUCED BY ANY MEANS.
USE THE GRAPHIC SCALE BAR IN THE TITLE BLOCK TO
DETERMINE THE ACTUAL SCALE OF THIS DRAWING.

Layer: ON=*; OFF=*REF*

4/5/01 BBL DCC
05503000/0659E403.DWG

NOT TO SCALE

| No. | Date | Revisions | Init |
|-----|----------|---------------------|------|
| 0 | 4/20/01 | ISSUED FOR APPROVAL | LK |
| 1 | | AS BID | |
| 2 | 10/31/05 | RECORD DRAWING | |

In charge of TEL
Designed by MEE
Drawn by DCC
Checked by WFH

ENVIRONMENTAL ENGINEERING ASSOCIATES, LLP
SYRACUSE, NEW YORK


ONONDAGA COUNTY • DEPARTMENT OF DRAINAGE AND SANITATION • SYRACUSE, NEW YORK
METROPOLITAN SYRACUSE WASTEWATER TREATMENT PLANT
STAGE III AMMONIA AND STAGE II PHOSPHORUS REMOVAL PROJECT
UV DISINFECTION
UV DISINFECTION/PARSHALL FLUME
ONE-LINE DIAGRAM
ELECTRICAL



File Number
00659
Date
APRIL 2001
[Signature]


E-403

SEE MCC O&M MANUAL FOR
EQUIPMENT ELEMENTARY DIAGRAMS

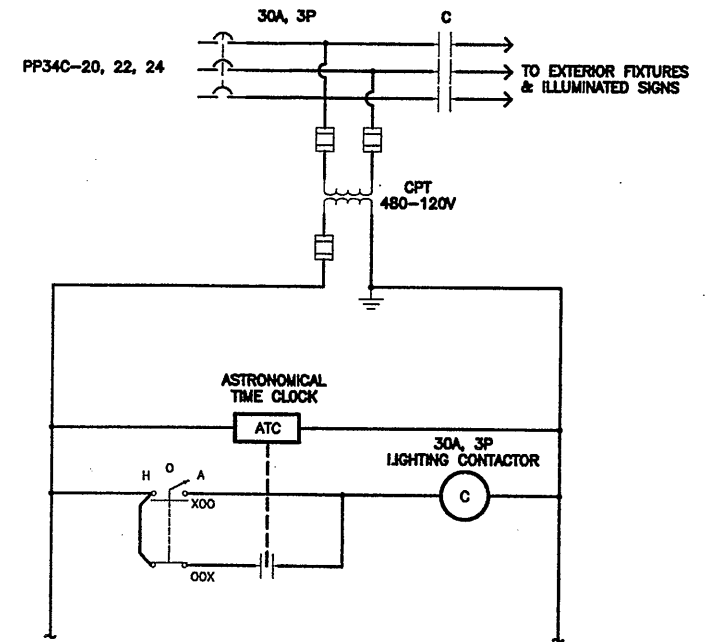


EXTERIOR LIGHTING WIRING DIAGRAM

NOT TO SCALE

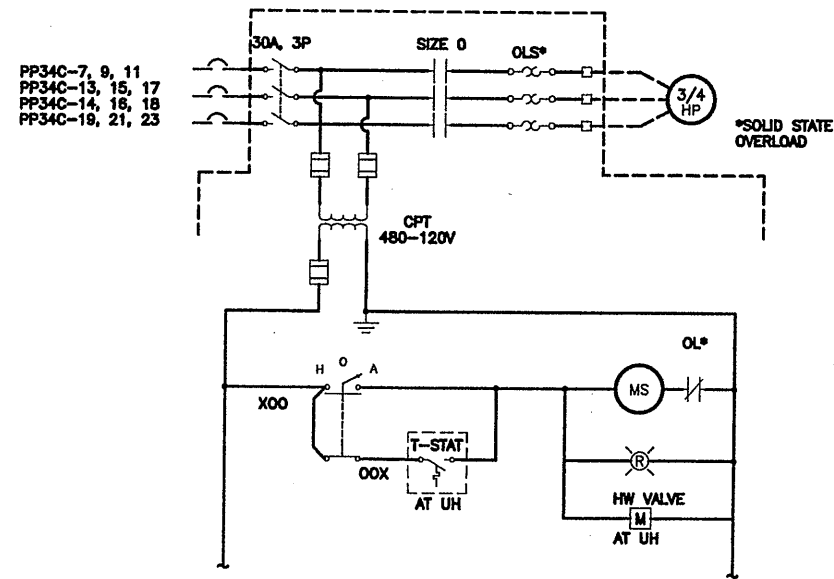

UNIT HEATER UH-401

(TYPICAL FOR UH-402, 403, 404)
NOT TO SCALE

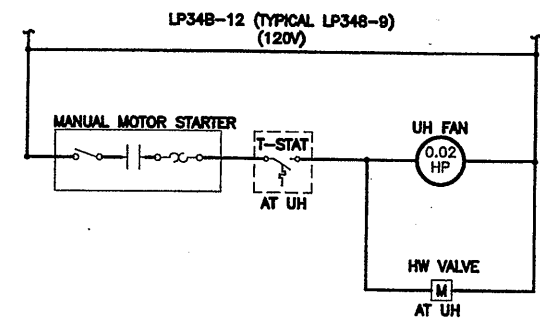

UNIT HEATER UH-405

(TYPICAL FOR UH-406)
NOT TO SCALE

RECORD DRAWING

THESE CHANGES HAVE BEEN MADE TO REFLECT
MAJOR CHANGES OF ANY WHICH OCCURRED DURING
CONSTRUCTION. REVISIONS ARE BASED UPON
INFORMATION SUPPLIED BY CONTRACTOR.

DATE: 1/21/05 PER: [Signature]

THIS DRAWING WAS PREPARED AT THE SCALE INDICATED IN THE
TITLE BLOCK. INACCURACIES IN THE STATED SCALE MAY BE
INTRODUCED WHEN DRAWINGS ARE REPRODUCED BY ANY MEANS.
USE THE GRAPHIC SCALE BAR IN THE TITLE BLOCK TO
DETERMINE THE ACTUAL SCALE OF THIS DRAWING.

Layer: ON=*, OFF=*REF*
4/4/01 BBL DCC
05503000/0659E404.DWG


NOT TO SCALE

| No. | Date | Revisions | Ink |
|-----|----------|---------------------|-----|
| 0 | 4/20/01 | ISSUED FOR APPROVAL | Le |
| 1 | | AS BID | |
| 2 | 10/31/05 | RECORD DRAWING | |

In charge of TEL
Designed by MEE
Drawn by DCC
Checked by WFH



ONONDAGA COUNTY • DEPARTMENT OF DRAINAGE AND SANITATION • SYRACUSE, NEW YORK
METROPOLITAN SYRACUSE WASTEWATER TREATMENT PLANT
STAGE III AMMONIA AND STAGE II PHOSPHORUS REMOVAL PROJECT
**UV DISINFECTION/PARSHALL FLUME
ELEMENTARY DIAGRAMS**
ELECTRICAL

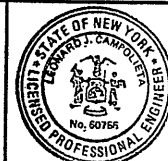

File Number
00659

Date
APRIL 2001

E-404

NO ALTERATIONS PERMITTED HEREON EXCEPT
AS PROVIDED UNDER SECTION 7209 SUBDIVISION
2 OF THE NEW YORK STATE EDUCATION LAW

| CIRCUIT BREAKER PANELBOARD - PP-34C | | | | | | | | | | SCHEDULE | |
|---|
| LOCATION: | | UV BUILDING ELECTRIC ROOM | | | | | FEED FROM | | MCC 34, 3AL | |
| MAIN BUS RATING: | | 225 AMPERES | | | | 480 VOLT | | 3 PHASE, 4 WIRE | |
| MINIMUM SHORTCIRCUIT: | | 25,000 AMPERES | | | | FEEDER CABLE | | 3 #2, 1 #6G | |
| MAIN BREAKER TRIP: | | 100 AMPERES | | | | SURFACE MOUNTED | |
| ESTIMATED CONNECTED LOAD: | | 35.09 KVA | |
| <table border="1"> <thead> <tr> <th>CKT NO.</th> <th>DESCRIPTION</th> <th>CB AMPS/POLES</th> <th>LOAD TYPE</th> <th>KVA</th> <th>PH-A</th> <th>PH-B</th> <th>PH-C</th> <th>KVA</th> <th>LOAD TYPE</th> <th>CB AMPS/POLES</th> <th>DESCRIPTION</th> <th>CKT NO.</th> </tr> </thead> <tbody> <tr> <td>1</td> <td>WEIR GATE OPERATOR (1 HP)</td> <td>20A</td> <td>MOTOR</td> <td>0.581</td> <td>1.162</td> <td></td> <td></td> <td>0.581</td> <td>MOTOR</td> <td>20A</td> <td>WEIR GATE OPERATOR (1 HP)</td> <td>2</td> </tr> <tr> <td>3</td> <td></td> <td></td> <td></td> <td>0.581</td> <td></td> <td>1.162</td> <td></td> <td>0.581</td> <td></td> <td></td> <td></td> <td>4</td> </tr> <tr> <td>5</td> <td></td> <td>3P</td> <td></td> <td>0.581</td> <td></td> <td></td> <td>1.162</td> <td>0.581</td> <td></td> <td>3P</td> <td></td> <td>6</td> </tr> <tr> <td>7</td> <td>UNIT HEATER NO. UH-401</td> <td>20A</td> <td>MOTOR</td> <td>0.443</td> <td>6.291</td> <td></td> <td></td> <td>5.848</td> <td>SUB</td> <td>20A</td> <td>PANELBOARD LP-34B</td> <td>8</td> </tr> <tr> <td>9</td> <td></td> <td></td> <td></td> <td>0.443</td> <td></td> <td>6.272</td> <td></td> <td>5.829</td> <td></td> <td></td> <td></td> <td>10</td> </tr> <tr> <td>11</td> <td></td> <td>3P</td> <td></td> <td>0.443</td> <td></td> <td></td> <td>6.395</td> <td>5.952</td> <td></td> <td>3P</td> <td></td> <td>12</td> </tr> <tr> <td>13</td> <td>UNIT HEATER NO. UH-402</td> <td>20A</td> <td>MOTOR</td> <td>0.443</td> <td>0.886</td> <td></td> <td></td> <td>0.443</td> <td>MOTOR</td> <td>20A</td> <td>UNIT HEATER NO. UH-403</td> <td>14</td> </tr> <tr> <td>15</td> <td></td> <td></td> <td></td> <td>0.443</td> <td></td> <td>0.886</td> <td></td> <td>0.443</td> <td></td> <td></td> <td></td> <td>16</td> </tr> <tr> <td>17</td> <td></td> <td>3P</td> <td></td> <td>0.443</td> <td></td> <td></td> <td>0.886</td> <td>0.443</td> <td></td> <td>3P</td> <td></td> <td>18</td> </tr> <tr> <td>19</td> <td>UNIT HEATER NO. UH-404</td> <td>20A</td> <td>MOTOR</td> <td>0.443</td> <td>2.943</td> <td></td> <td></td> <td>2.500</td> <td>LIGHTS</td> <td>30A</td> <td>PARKING LOT LIGHTS</td> <td>20</td> </tr> <tr> <td>21</td> <td></td> <td></td> <td></td> <td>0.443</td> <td></td> <td>3.018</td> <td></td> <td>2.575</td> <td></td> <td></td> <td></td> <td>22</td> </tr> <tr> <td>23</td> <td></td> <td>3P</td> <td></td> <td>0.443</td> <td></td> <td></td> <td>2.943</td> <td></td> <td>0.000</td> <td></td> <td></td> <td></td> <td></td> <td></td> <td>34</td> </tr> <tr> <td>35</td> <td></td> <td>3P</td> <td></td> <td></td> <td></td> <td></td> <td>0.000</td> <td></td> <td></td> <td>3P</td> <td></td> <td>36</td> </tr> <tr> <td colspan="4">LOAD SUMMARY</td> <td>5.730</td> <td>11.642</td> <td>11.698</td> <td>11.748</td> <td>29.356</td> <td colspan="4"></td> </tr> <tr> <td colspan="4">PANEL TOTAL KVA:</td> <td>35.086</td> <td colspan="7"></td> </tr> </tbody> </table> | | | | | | | | | | | CKT NO. | DESCRIPTION | CB AMPS/POLES | LOAD TYPE | KVA | PH-A | PH-B | PH-C | KVA | LOAD TYPE | CB AMPS/POLES | DESCRIPTION | CKT NO. | 1 | WEIR GATE OPERATOR (1 HP) | 20A | MOTOR | 0.581 | 1.162 | | | 0.581 | MOTOR | 20A | WEIR GATE OPERATOR (1 HP) | 2 | 3 | | | | 0.581 | | 1.162 | | 0.581 | | | | 4 | 5 | | 3P | | 0.581 | | | 1.162 | 0.581 | | 3P | | 6 | 7 | UNIT HEATER NO. UH-401 | 20A | MOTOR | 0.443 | 6.291 | | | 5.848 | SUB | 20A | PANELBOARD LP-34B | 8 | 9 | | | | 0.443 | | 6.272 | | 5.829 | | | | 10 | 11 | | 3P | | 0.443 | | | 6.395 | 5.952 | | 3P | | 12 | 13 | UNIT HEATER NO. UH-402 | 20A | MOTOR | 0.443 | 0.886 | | | 0.443 | MOTOR | 20A | UNIT HEATER NO. UH-403 | 14 | 15 | | | | 0.443 | | 0.886 | | 0.443 | | | | 16 | 17 | | 3P | | 0.443 | | | 0.886 | 0.443 | | 3P | | 18 | 19 | UNIT HEATER NO. UH-404 | 20A | MOTOR | 0.443 | 2.943 | | | 2.500 | LIGHTS | 30A | PARKING LOT LIGHTS | 20 | 21 | | | | 0.443 | | 3.018 | | 2.575 | | | | 22 | 23 | | 3P | | 0.443 | | | 2.943 | 2.500 | | 3P | | 24 | 25 | SPARE | 20A | | | 0.360 | | | 0.360 | MOTOR | 20A | ENTRANCE GATE OPERATOR (1.5 HP) | 26 | 27 | | | | | | 0.360 | | 0.360 | | | | 28 | 29 | | 3P | | | | | 0.360 | 0.360 | | 3P | | 30 | 31 | SPARE | 20A | | | 0.000 | | | | | 20A | SPARE | 32 | 33 | | | | | | 0.000 | | | | | | 34 | 35 | | 3P | | | | | 0.000 | | | 3P | | 36 | LOAD SUMMARY | | | | 5.730 | 11.642 | 11.698 | 11.748 | 29.356 | | | | | PANEL TOTAL KVA: | | | | 35.086 | | | | | | | |
| CKT NO. | DESCRIPTION | CB AMPS/POLES | LOAD TYPE | KVA | PH-A | PH-B | PH-C | KVA | LOAD TYPE | CB AMPS/POLES | DESCRIPTION | CKT NO. | |
| 1 | WEIR GATE OPERATOR (1 HP) | 20A | MOTOR | 0.581 | 1.162 | | | 0.581 | MOTOR | 20A | WEIR GATE OPERATOR (1 HP) | 2 | |
| 3 | | | | 0.581 | | 1.162 | | 0.581 | | | | 4 | |
| 5 | | 3P | | 0.581 | | | 1.162 | 0.581 | | 3P | | 6 | |
| 7 | UNIT HEATER NO. UH-401 | 20A | MOTOR | 0.443 | 6.291 | | | 5.848 | SUB | 20A | PANELBOARD LP-34B | 8 | |
| 9 | | | | 0.443 | | 6.272 | | 5.829 | | | | 10 | |
| 11 | | 3P | | 0.443 | | | 6.395 | 5.952 | | 3P | | 12 | |
| 13 | UNIT HEATER NO. UH-402 | 20A | MOTOR | 0.443 | 0.886 | | | 0.443 | MOTOR | 20A | UNIT HEATER NO. UH-403 | 14 | |
| 15 | | | | 0.443 | | 0.886 | | 0.443 | | | | 16 | |
| 17 | | 3P | | 0.443 | | | 0.886 | 0.443 | | 3P | | 18 | |
| 19 | UNIT HEATER NO. UH-404 | 20A | MOTOR | 0.443 | 2.943 | | | 2.500 | LIGHTS | 30A | PARKING LOT LIGHTS | 20 | |
| 21 | | | | 0.443 | | 3.018 | | 2.575 | | | | 22 | |
| 23 | | 3P | | 0.443 | | | 2.943 | 2.500 | | 3P | | 24 | |
| 25 | SPARE | 20A | | | 0.360 | | | 0.360 | MOTOR | 20A | ENTRANCE GATE OPERATOR (1.5 HP) | 26 | |
| 27 | | | | | | 0.360 | | 0.360 | | | | 28 | |
| 29 | | 3P | | | | | 0.360 | 0.360 | | 3P | | 30 | |
| 31 | SPARE | 20A | | | 0.000 | | | | | 20A | SPARE | 32 | |
| 33 | | | | | | 0.000 | | | | | | 34 | |
| 35 | | 3P | | | | | 0.000 | | | 3P | | 36 | |
| LOAD SUMMARY | | | | 5.730 | 11.642 | 11.698 | 11.748 | 29.356 | |
| PANEL TOTAL KVA: | | | | 35.086 | |

NOTES:

- ALL CONDUCTORS TO BE 3 #12, 1 #12G IN 3/4-INCH PVC COATED RIGID STEEL CONDUIT, UNLESS OTHERWISE INDICATED ON POWER PLAN.

| CIRCUIT BREAKER PANELBOARD - LP-34B | | | | | | | | | | SCHEDULE | |
|---|
| LOCATION: | | UV ELECTRIC ROOM | | | | | FEED FROM | | PP-34C, UV ELECTRIC ROOM | |
| MAIN BUS RATING: | | 225 AMPERES | | | | 208/120 VOLTS | | 3 PHASE, 4 WIRE | |
| MINIMUM SHORTCIRCUIT: | | 18,000 AMPERES | | | | FEEDER CABLE | | 4 #2, 1 #6G | |
| MAIN BREAKER TRIP: | | 100 AMPERES | | | | SURFACE MOUNTED | |
| ESTIMATED CONNECTED LOAD: | | 19.581 KVA | |
| <table border="1"> <thead> <tr> <th>CKT NO.</th> <th>DESCRIPTION</th> <th>CB AMPS/POLES</th> <th>LOAD TYPE</th> <th>KVA</th> <th>PH-A</th> <th>PH-B</th> <th>PH-C</th> <th>KVA</th> <th>LOAD TYPE</th> <th>CB AMPS/POLES</th> <th>DESCRIPTION</th> <th>CKT NO.</th> </tr> </thead> <tbody> <tr> <td>1</td> <td>UV REACTOR AREA LIGHTS</td> <td>20/1P</td> <td>LIGHTS</td> <td>1.584</td> <td>2.664</td> <td></td> <td></td> <td>1.080</td> <td>RECPT</td> <td>20/1P</td> <td>BUILDING RECEPTACLES</td> <td>2</td> </tr> <tr> <td>3</td> <td>ELECTRIC ROOM RECEPTACLES</td> <td>20/1P</td> <td>RECPT</td> <td>0.720</td> <td></td> <td>0.750</td> <td></td> <td>0.030</td> <td>MOTOR</td> <td>20/1P</td> <td>TRANSFER FAN F-402 (0.04HP)</td> <td>4</td> </tr> <tr> <td>5</td> <td>ISCO SAMPLER</td> <td>25/1P</td> <td>INST</td> <td>2.400</td> <td></td> <td></td> <td>3.165</td> <td>0.785</td> <td>LIGHTS</td> <td>20/1P</td> <td>PARSHALL FLUME LIGHTS</td> <td>6</td> </tr> <tr> <td>7</td> <td>AMMONIA & PHOSPH. ANALYZER</td> <td>20/1P</td> <td>INST</td> <td>0.150</td> <td>2.154</td> <td></td> <td></td> <td>2.004</td> <td>MANUF</td> <td>20/1P</td> <td>SYSTEM CONTROL CENTER (SCC)</td> <td>8</td> </tr> <tr> <td>9</td> <td>UNIT HEATER NO. UH-406</td> <td>20/1P</td> <td>HEAT</td> <td>0.015</td> <td></td> <td>5.019</td> <td></td> <td>5.004</td> <td>MANUF</td> <td>50/1P</td> <td>HYDRAULIC SYS CENTER (HSC)</td> <td>10</td> </tr> <tr> <td>11</td> <td>ON-LINE TRANS UNIT (UVT)</td> <td>20/1P</td> <td>INST</td> <td>1.800</td> <td></td> <td></td> <td>1.815</td> <td>0.015</td> <td>HEAT</td> <td>20/1P</td> <td>UNIT HEATER NO. UH-405</td> <td>12</td> </tr> <tr> <td>13</td> <td>FLOW TRANS, pH & DO</td> <td>20/1P</td> <td>INST</td> <td>0.150</td> <td>0.930</td> <td></td> <td></td> <td>0.780</td> <td>LIGHTS</td> <td>20/1P</td> <td>ELEC RM, STRG, & SWING-OUT</td> <td>14</td> </tr> <tr> <td>15</td> <td>TRANSFER FAN F-403 (0.04HP)</td> <td>20/1P</td> <td>MOTOR</td> <td>0.030</td> <td></td> <td></td> <td>0.080</td> <td>0.030</td> <td>CAMERA</td> <td>20/1P</td> <td>CLOSED CIRCUIT TV CAMERA NO. 8</td> <td>16</td> </tr> <tr> <td>17</td> <td>UV AREA NIGHT LIGHTS</td> <td>20/1P</td> <td>LIGHTS</td> <td>0.792</td> <td></td> <td></td> <td>0.972</td> <td>0.180</td> <td>RECPT</td> <td>20/1P</td> <td>ROOF MAINT. RECEPTACLE</td> <td>18</td> </tr> <tr> <td>19</td> <td>EXTERIOR LIGHTS</td> <td>20/1P</td> <td>LIGHTS</td> <td>0.432</td> <td>0.532</td> <td></td> <td></td> <td>0.100</td> <td>INST</td> <td>20/1P</td> <td>ULTRASONIC LEVEL TRANSMITTER</td> <td>20</td> </tr> <tr> <td>21</td> <td>HW HEATER</td> <td>20</td> <td>HEAT</td> <td>1.500</td> <td></td> <td>1.500</td> <td></td> <td></td> <td></td> <td>20/1P</td> <td>RECEPTACLE UV SOUTH</td> <td>22</td> </tr> <tr> <td>23</td> <td></td> <td>2P</td> <td></td> <td></td> <td></td> <td></td> <td>1.500</td> <td></td> <td></td> <td>20/1P</td> <td>SWING OUT LIGHTS</td> <td>24</td> </tr> <tr> <td>25</td> <td>SPARE</td> <td>25/1P</td> <td></td> <td></td> <td>0.000</td> <td></td> <td></td> <td></td> <td></td> <td>50/1P</td> <td>SPARE</td> <td>26</td> </tr> <tr> <td>27</td> <td>SPARE</td> <td>20/1P</td> <td></td> <td></td> <td></td> <td>0.000</td> <td></td> <td></td> <td></td> <td>20/1P</td> <td>SPARE</td> <td>28</td> </tr> <tr> <td>29</td> <td>SPARE</td> <td>20/1P</td> <td></td> <td></td> <td></td> <td></td> <td>0.000</td> <td></td> <td></td> <td>20/1P</td> <td>SPARE</td> <td>30</td> </tr> <tr> <td>31</td> <td>SPARE</td> <td>20/1P</td> <td></td> <td></td> <td>0.000</td> <td></td> <td></td> <td></td> <td></td> <td>20/1P</td> <td>SPARE</td> <td>32</td> </tr> <tr> <td>33</td> <td>SPARE</td> <td>20/1P</td> <td></td> <td></td> <td></td> <td>0.000</td> <td></td> <td></td> <td></td> <td>20/1P</td> <td>SPARE</td> <td>34</td> </tr> <tr> <td>35</td> <td>SPARE</td> <td>20/1P</td> <td></td> <td></td> <td></td> <td></td> <td>0.000</td> <td></td> <td></td> <td>20/1P</td> <td>SPARE</td> <td>36</td> </tr> <tr> <td>37</td> <td>SPARE</td> <td>20/1P</td> <td></td> <td></td> <td>0.000</td> <td></td> <td></td> <td></td> <td></td> <td>20/1P</td> <td>SPARE</td> <td>38</td> </tr> <tr> <td>39</td> <td>SPARE</td> <td>20/1P</td> <td></td> <td></td> <td></td> <td>0.000</td> <td></td> <td></td> <td></td> <td>20/1P</td> <td>SPARE</td> <td>40</td> </tr> <tr> <td>41</td> <td>SPARE</td> <td>20/1P</td> <td></td> <td></td> <td></td> <td></td> <td>0.000</td> <td></td> <td></td> <td>20/1P</td> <td>SPARE</td> <td>42</td> </tr> <tr> <td colspan="4">LOAD SUMMARY</td> <td>9.573</td> <td>6.280</td> <td>7.329</td> <td>7.452</td> <td>9.988</td> <td colspan="4"></td> </tr> <tr> <td colspan="4">PANEL TOTAL KVA:</td> <td>19.581</td> <td colspan="7"></td> </tr> </tbody> </table> | | | | | | | | | | | CKT NO. | DESCRIPTION | CB AMPS/POLES | LOAD TYPE | KVA | PH-A | PH-B | PH-C | KVA | LOAD TYPE | CB AMPS/POLES | DESCRIPTION | CKT NO. | 1 | UV REACTOR AREA LIGHTS | 20/1P | LIGHTS | 1.584 | 2.664 | | | 1.080 | RECPT | 20/1P | BUILDING RECEPTACLES | 2 | 3 | ELECTRIC ROOM RECEPTACLES | 20/1P | RECPT | 0.720 | | 0.750 | | 0.030 | MOTOR | 20/1P | TRANSFER FAN F-402 (0.04HP) | 4 | 5 | ISCO SAMPLER | 25/1P | INST | 2.400 | | | 3.165 | 0.785 | LIGHTS | 20/1P | PARSHALL FLUME LIGHTS | 6 | 7 | AMMONIA & PHOSPH. ANALYZER | 20/1P | INST | 0.150 | 2.154 | | | 2.004 | MANUF | 20/1P | SYSTEM CONTROL CENTER (SCC) | 8 | 9 | UNIT HEATER NO. UH-406 | 20/1P | HEAT | 0.015 | | 5.019 | | 5.004 | MANUF | 50/1P | HYDRAULIC SYS CENTER (HSC) | 10 | 11 | ON-LINE TRANS UNIT (UVT) | 20/1P | INST | 1.800 | | | 1.815 | 0.015 | HEAT | 20/1P | UNIT HEATER NO. UH-405 | 12 | 13 | FLOW TRANS, pH & DO | 20/1P | INST | 0.150 | 0.930 | | | 0.780 | LIGHTS | 20/1P | ELEC RM, STRG, & SWING-OUT | 14 | 15 | TRANSFER FAN F-403 (0.04HP) | 20/1P | MOTOR | 0.030 | | | 0.080 | 0.030 | CAMERA | 20/1P | CLOSED CIRCUIT TV CAMERA NO. 8 | 16 | 17 | UV AREA NIGHT LIGHTS | 20/1P | LIGHTS | 0.792 | | | 0.972 | 0.180 | RECPT | 20/1P | ROOF MAINT. RECEPTACLE | 18 | 19 | EXTERIOR LIGHTS | 20/1P | LIGHTS | 0.432 | 0.532 | | | 0.100 | INST | 20/1P | ULTRASONIC LEVEL TRANSMITTER | 20 | 21 | HW HEATER | 20 | HEAT | 1.500 | | 1.500 | | | | 20/1P | RECEPTACLE UV SOUTH | 22 | 23 | | 2P | | | | | 1.500 | | | 20/1P | SWING OUT LIGHTS | 24 | 25 | SPARE | 25/1P | | | 0.000 | | | | | 50/1P | SPARE | 26 | 27 | SPARE | 20/1P | | | | 0.000 | | | | 20/1P | SPARE | 28 | 29 | SPARE | 20/1P | | | | | 0.000 | | | 20/1P | SPARE | 30 | 31 | SPARE | 20/1P | | | 0.000 | | | | | 20/1P | SPARE | 32 | 33 | SPARE | 20/1P | | | | 0.000 | | | | 20/1P | SPARE | 34 | 35 | SPARE | 20/1P | | | | | 0.000 | | | 20/1P | SPARE | 36 | 37 | SPARE | 20/1P | | | 0.000 | | | | | 20/1P | SPARE | 38 | 39 | SPARE | 20/1P | | | | 0.000 | | | | 20/1P | SPARE | 40 | 41 | SPARE | 20/1P | | | | | 0.000 | | | 20/1P | SPARE | 42 | LOAD SUMMARY | | | | 9.573 | 6.280 | 7.329 | 7.452 | 9.988 | | | | | PANEL TOTAL KVA: | | | | 19.581 | | | | | | | |
| CKT NO. | DESCRIPTION | CB AMPS/POLES | LOAD TYPE | KVA | PH-A | PH-B | PH-C | KVA | LOAD TYPE | CB AMPS/POLES | DESCRIPTION | CKT NO. | |
| 1 | UV REACTOR AREA LIGHTS | 20/1P | LIGHTS | 1.584 | 2.664 | | | 1.080 | RECPT | 20/1P | BUILDING RECEPTACLES | 2 | |
| 3 | ELECTRIC ROOM RECEPTACLES | 20/1P | RECPT | 0.720 | | 0.750 | | 0.030 | MOTOR | 20/1P | TRANSFER FAN F-402 (0.04HP) | 4 | |
| 5 | ISCO SAMPLER | 25/1P | INST | 2.400 | | | 3.165 | 0.785 | LIGHTS | 20/1P | PARSHALL FLUME LIGHTS | 6 | |
| 7 | AMMONIA & PHOSPH. ANALYZER | 20/1P | INST | 0.150 | 2.154 | | | 2.004 | MANUF | 20/1P | SYSTEM CONTROL CENTER (SCC) | 8 | |
| 9 | UNIT HEATER NO. UH-406 | 20/1P | HEAT | 0.015 | | 5.019 | | 5.004 | MANUF | 50/1P | HYDRAULIC SYS CENTER (HSC) | 10 | |
| 11 | ON-LINE TRANS UNIT (UVT) | 20/1P | INST | 1.800 | | | 1.815 | 0.015 | HEAT | 20/1P | UNIT HEATER NO. UH-405 | 12 | |
| 13 | FLOW TRANS, pH & DO | 20/1P | INST | 0.150 | 0.930 | | | 0.780 | LIGHTS | 20/1P | ELEC RM, STRG, & SWING-OUT | 14 | |
| 15 | TRANSFER FAN F-403 (0.04HP) | 20/1P | MOTOR | 0.030 | | | 0.080 | 0.030 | CAMERA | 20/1P | CLOSED CIRCUIT TV CAMERA NO. 8 | 16 | |
| 17 | UV AREA NIGHT LIGHTS | 20/1P | LIGHTS | 0.792 | | | 0.972 | 0.180 | RECPT | 20/1P | ROOF MAINT. RECEPTACLE | 18 | |
| 19 | EXTERIOR LIGHTS | 20/1P | LIGHTS | 0.432 | 0.532 | | | 0.100 | INST | 20/1P | ULTRASONIC LEVEL TRANSMITTER | 20 | |
| 21 | HW HEATER | 20 | HEAT | 1.500 | | 1.500 | | | | 20/1P | RECEPTACLE UV SOUTH | 22 | |
| 23 | | 2P | | | | | 1.500 | | | 20/1P | SWING OUT LIGHTS | 24 | |
| 25 | SPARE | 25/1P | | | 0.000 | | | | | 50/1P | SPARE | 26 | |
| 27 | SPARE | 20/1P | | | | 0.000 | | | | 20/1P | SPARE | 28 | |
| 29 | SPARE | 20/1P | | | | | 0.000 | | | 20/1P | SPARE | 30 | |
| 31 | SPARE | 20/1P | | | 0.000 | | | | | 20/1P | SPARE | 32 | |
| 33 | SPARE | 20/1P | | | | 0.000 | | | | 20/1P | SPARE | 34 | |
| 35 | SPARE | 20/1P | | | | | 0.000 | | | 20/1P | SPARE | 36 | |
| 37 | SPARE | 20/1P | | | 0.000 | | | | | 20/1P | SPARE | 38 | |
| 39 | SPARE | 20/1P | | | | 0.000 | | | | 20/1P | SPARE | 40 | |
| 41 | SPARE | 20/1P | | | | | 0.000 | | | 20/1P | SPARE | 42 | |
| LOAD SUMMARY | | | | 9.573 | 6.280 | 7.329 | 7.452 | 9.988 | |
| PANEL TOTAL KVA: | | | | 19.581 | |

NOTES:

- ALL CONDUCTORS TO BE 2 #12, 1 #12G IN 3/4-INCH PVC COATED RIGID STEEL RIGID STEEL CONDUIT, UNLESS OTHERWISE INDICATED ON POWER PLAN.
- * CONDUCTORS TO BE 2 #8, 1 #8G IN 1-INCH PVC COATED RIGID STEEL RIGID STEEL CONDUIT.
- ** CONDUCTORS TO BE 2 #10, 1 #10G IN 3/4-INCH PVC COATED RIGID STEEL RIGID STEEL CONDUIT.

Layer: ON=*; OFF=*REF*
4/25/01 BBL DCC
05503000/0659E405.DWG

NOT TO SCALE

NO ALTERATIONS PERMITTED HEREON EXCEPT AS PROVIDED UNDER SECTION 7209 SUBDIVISION 2 OF THE NEW YORK STATE EDUCATION LAW

| No. | Date | Revisions | Init |
|-----|----------|---------------------|------|
| 0 | 4/20/01 | ISSUED FOR APPROVAL | Wf |
| 1 | | AS BID | |
| 2 | 10/31/05 | RECORD DRAWING | |



In charge of TEL
Designed by MEE
Drawn by DCC
Checked by WFH

ENVIRONMENTAL ENGINEERING ASSOCIATES, LLP
SYRACUSE, NEW YORK

ONONDAGA COUNTY • DEPARTMENT OF DRAINAGE AND SANITATION • SYRACUSE, NEW YORK
METROPOLITAN SYRACUSE WASTEWATER TREATMENT PLANT
STAGE III AMMONIA AND STAGE II PHOSPHORUS REMOVAL PROJECT
**UV DISINFECTION
UV DISINFECTION/PARSHALL FLUME
SCHEDULES**
ELECTRICAL



RECORD DRAWING
THESE CHANGES HAVE BEEN MADE TO REFLECT MAJOR CHANGES IF ANY, WHICH OCCURRED DURING CONSTRUCTION. REVISIONS ARE BASED UPON INFORMATION SUPPLIED BY CONTRACTOR.
DATE: 10/21/05 FOR: Campollet
THIS DRAWING WAS PREPARED AT THE SCALE INDICATED IN THE TITLE BLOCK. INACCURACIES IN THE STATED SCALE MAY BE INTRODUCED WHEN DRAWINGS ARE REPRODUCED BY ANY MEANS. USE THE GRAPHIC SCALE BAR IN THE TITLE BLOCK TO DETERMINE THE ACTUAL SCALE OF THIS DRAWING.
File Number: 00659
Date: APRIL 2001
E-405
Campollet

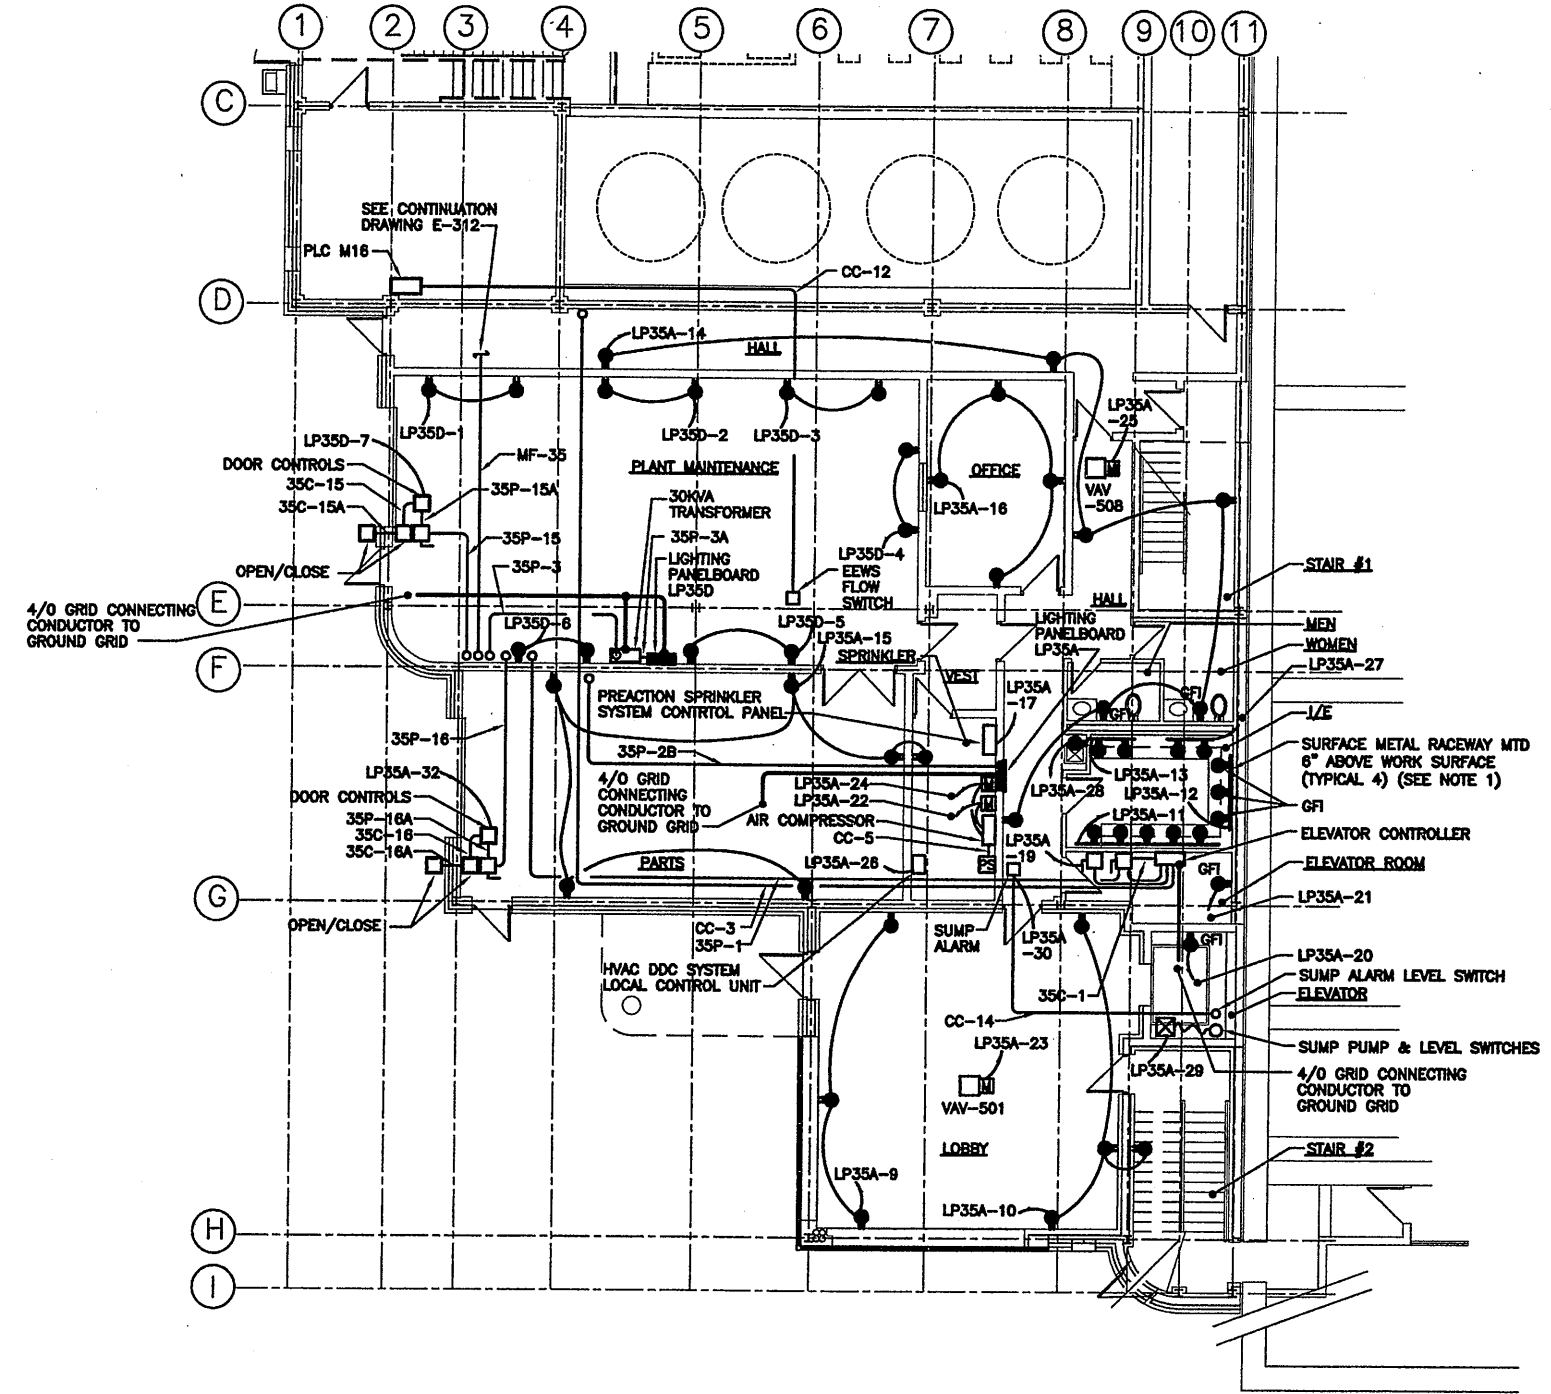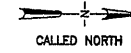

- NOTES:**
1. SURFACE METAL RACEWAY IN 1/E SHALL HAVE 3'-0" SPACING BETWEEN RECEPTACLES. EVERY OTHER RECEPTACLE IN RACEWAYS SHALL BE PROVIDED WITH AN ON/OFF SNAP SWITCH.
 2. REFER TO HVAC DRAWINGS FOR ADDITIONAL LOUVER, DAMPER, THERMOSTAT, CONTROL VALVE, DIRECT DIGITAL CONTROL (DDC), AND OTHER CONTROL HVAC REQUIREMENTS. CONTRACT 4B (ELECTRICAL) SHALL PROVIDE ALL CONDUIT AND CONDUCTORS FOR 120 VOLT CONTROLS, AS SHOWN OR REQUIRED (EXCEPT WIRING BETWEEN DDC SYSTEM COMPONENTS). CONTRACT 4C (HVAC) SHALL PROVIDE ALL CONDUIT AND CONDUCTORS REQUIRED FOR LOW VOLTAGE (LESS THAN 120 VOLT) CONTROLS AND WIRING BETWEEN DDC SYSTEM COMPONENTS INCLUDING BUT NOT LIMITED TO, LOW VOLTAGE T-STAT, VARIABLE AIR VOLUME (VAV) CONTROLS, ETC.

FIRST FLOOR PLAN
SCALE: 1/8"=1'-0"

RECORD DRAWING

THESE DRAWINGS HAVE BEEN REVIEWED TO REFLECT
MAJOR CHANGES, IF ANY, WHICH OCCURRED DURING
CONSTRUCTION. REVISIONS ARE BASED UPON
INFORMATION SUPPLIED BY CONTRACTOR.
DATE: 10/21/05 FOR: [Signature]

THIS DRAWING WAS PREPARED AT THE SCALE INDICATED IN THE
TITLE BLOCK. INACCURACIES IN THE STATED SCALE MAY BE
INTRODUCED WHEN DRAWINGS ARE REPRODUCED BY ANY MEANS.
USE THE GRAPHIC SCALE BAR IN THE TITLE BLOCK TO
DETERMINE THE ACTUAL SCALE OF THIS DRAWING.

0659X501
03/23/01 OBG CRV
0659E501

| | |
|------------|----------|
| 1/8"=1'-0" | |
| No. | Date |
| 0 | 4/20/01 |
| 1 | AS BID |
| 2 | 10/31/05 |

| No. | Date | Revisions | Ink |
|-----|----------|---------------------|-------------|
| 0 | 4/20/01 | ISSUED FOR APPROVAL | [Signature] |
| 1 | | AS BID | |
| 2 | 10/31/05 | RECORD DRAWING | |

In charge of ___ TEL ___
Designed by JJC
Drawn by CRV
Checked by WFH


ENVIRONMENTAL ENGINEERING ASSOCIATES, LLP
SYRACUSE, NEW YORK

ONONDAGA COUNTY • DEPARTMENT OF DRAINAGE AND SANITATION • SYRACUSE, NEW YORK
METROPOLITAN SYRACUSE WASTEWATER TREATMENT PLANT
STAGE III AMMONIA AND STAGE II PHOSPHORUS REMOVAL PROJECT
OPERATIONS CENTER
FIRST FLOOR
ELECTRICAL




File Number
00659
Date
APRIL 2001

E-501

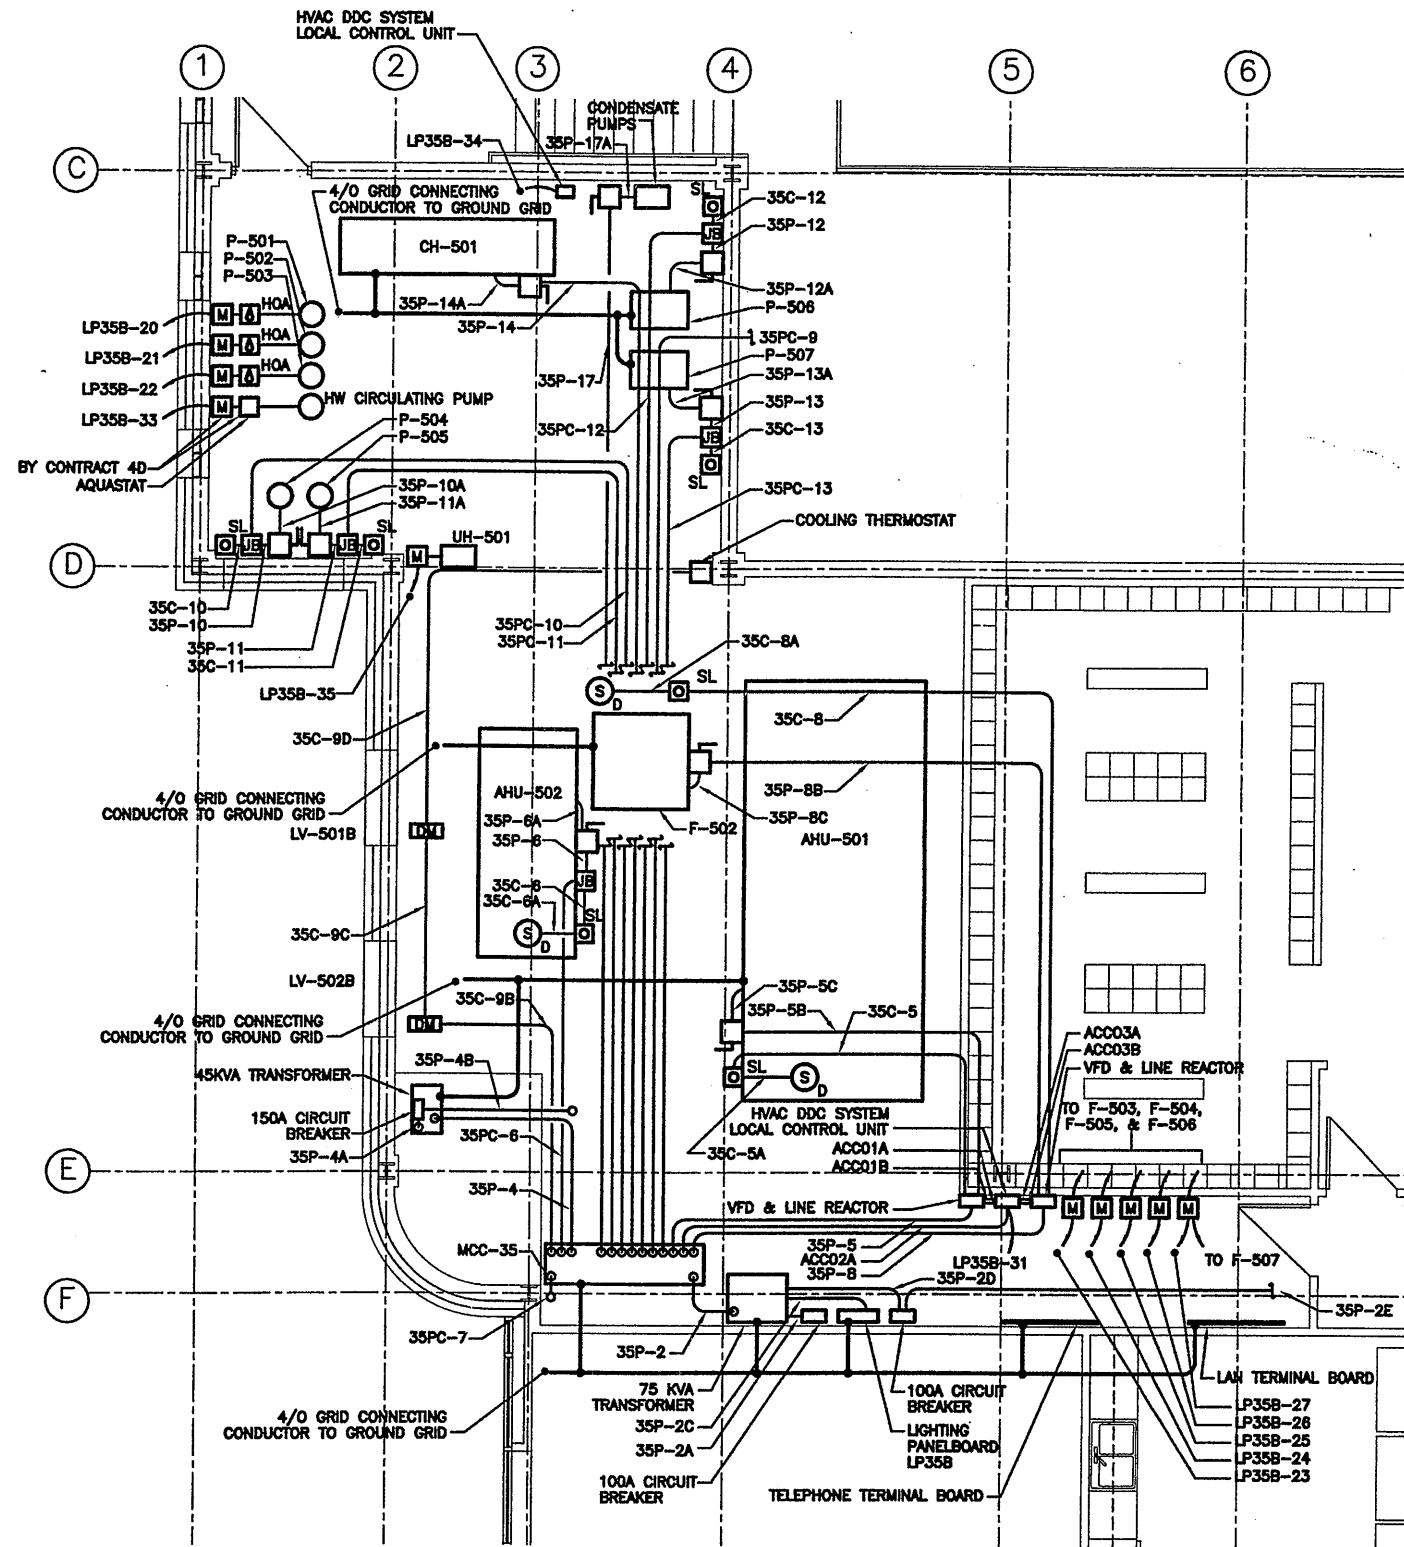

ELECTRICAL/MECHANICAL ROOM POWER PLAN
SCALE: 1/4"=1'-0"

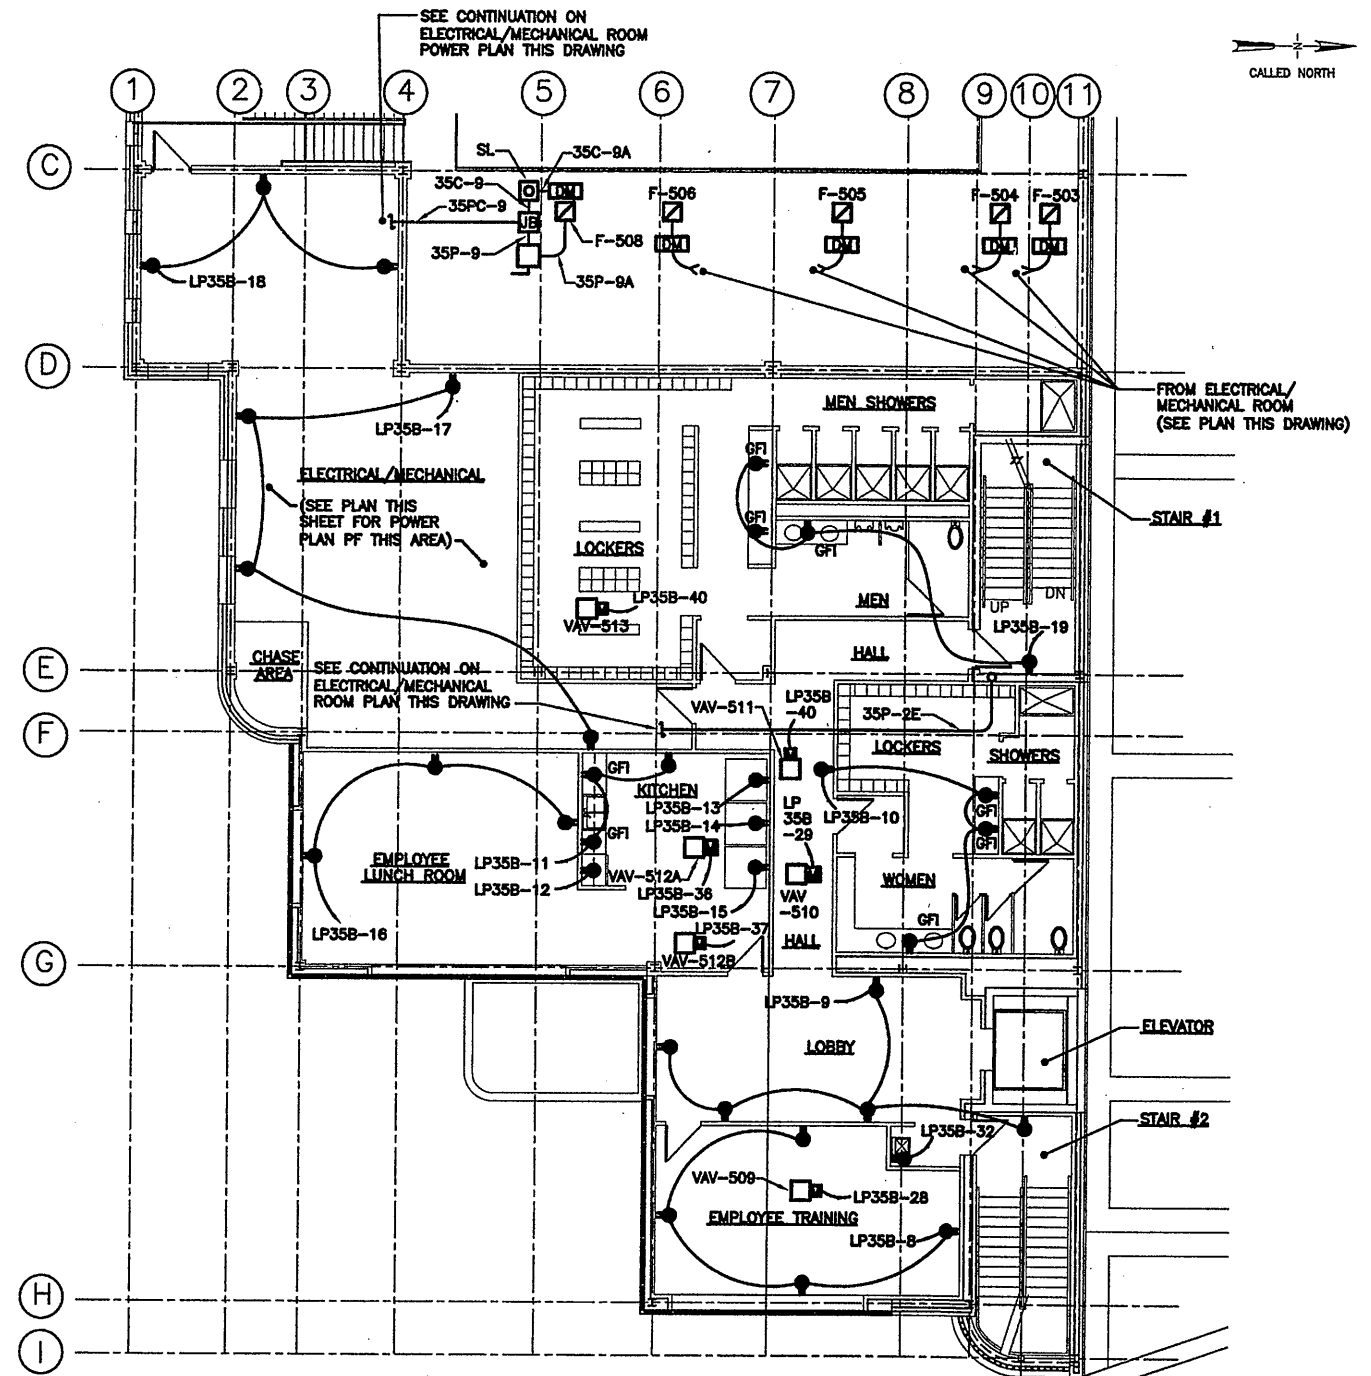

SECOND FLOOR POWER PLAN
SCALE: 1/8"=1'-0"


- NOTES:**
- DISCONNECT SWITCH AND STOP LOCKOUT FOR F-508 SHALL BE ROOF MOUNTED. PROVIDE SUPPORT CHANNELS AS NECESSARY FOR MOUNTING.
 - PROVIDE 3-#12 IN 3/4" CONDUIT ROUTED FROM THE WALL MOUNTED CONTROL RELAY LOCATED ADJACENT TO AHU-501'S VFD TO MCC35. PROVIDE 2-#12 IN 3/4" CONDUIT ROUTED FROM MCC35 TO RV-501 ACTUATORS. USING THIS WIRING AND LP35B-1 IN THE CONTROL RELAY AS THE ACTUATOR POWER SOURCE. PROVIDE PARALLEL CONNECTION OF A NORMALLY OPEN CONTACT ON THE CONTROL RELAY WITH A NORMALLY OPEN AUXILIARY CONTACT ON AHU-502'S MOTOR STARTER LOCATED IN MCC35. LOAD SIDE OF THE PARALLELED CONTACTS SHALL BE CONNECTED TO THE LINE SIDE OF RV-501 ACTUATORS. ACTUATORS SHALL BE CONNECTED IN PARALLEL. A COMMON NEUTRAL SHALL BE ROUTED FROM THE ACTUATORS BACK TO THE CONTROL RELAY VIA MCC35.

RECORD DRAWING

THESE DRAWINGS HAVE BEEN REVIEWED TO REFLECT MAJOR CHANGES, IF ANY, WHICH OCCURRED DURING CONSTRUCTION. REVISIONS ARE BASED UPON INFORMATION SUPPLIED BY CONTRACTOR.
DATE: 10/21/05 PER: [Signature]

THIS DRAWING WAS PREPARED AT THE SCALE INDICATED IN THE TITLE BLOCK. INACCURACIES IN THE STATED SCALE MAY BE INTRODUCED WHEN DRAWINGS ARE REPRODUCED BY ANY MEANS. USE THE GRAPHIC SCALE BAR IN THE TITLE BLOCK TO DETERMINE THE ACTUAL SCALE OF THIS DRAWING.

0659X502
03/23/01 OBG CRV
0659E502

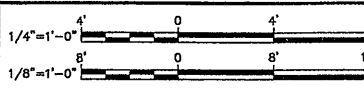

| No. | Date | Revisions | Init. |
|-----|----------|---------------------|-------|
| 0 | 4/20/01 | ISSUED FOR APPROVAL | LL |
| 1 | | AS BID | |
| 2 | 10/31/05 | RECORD DRAWING | |

In charge of: TEL
Designed by: JJC
Drawn by: CRV
Checked by: WEH

ENVIRONMENTAL ENGINEERING ASSOCIATES, LLP
SYRACUSE, NEW YORK



ONONDAGA COUNTY • DEPARTMENT OF DRAINAGE AND SANITATION • SYRACUSE, NEW YORK
METROPOLITAN SYRACUSE WASTEWATER TREATMENT PLANT
STAGE III AMMONIA AND STAGE II PHOSPHORUS REMOVAL PROJECT

**OPERATIONS CENTER
SECOND FLOOR
POWER PLAN**
ELECTRICAL




File Number: 00659
Date: APRIL 2001
[Signature]

E-502

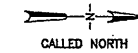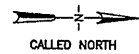

RADIO ANTENNA
(FURNISHED &
INSTALLED BY OWNER)

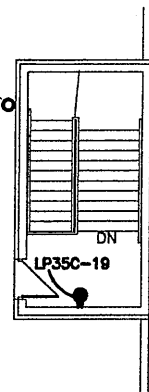


STAIR #1 ROOF PLAN


SCALE: 1/8"=1'-0"

NOTES:

1. PROVIDE 1" CONDUIT FROM CONTROL ROOM UNDERFLOOR SPACE TO OFFICE FOR OFFICE CCTV MONITOR VIDEO CABLE. CONDUIT SHALL TERMINATE IN OFFICE 7'-0" ABOVE FINISHED FLOOR WITH OUTLET BOX, WALL PLATE AND CABLE BUSHING.
2. PROVIDE 2" CONDUIT FROM CONTROL ROOM UNDERFLOOR SPACE TO OFFICE FOR OFFICE COMPUTER WORKSTATION MONITOR CABLE AND KEYBOARD CABLE. CONDUIT SHALL TERMINATE IN OFFICE 3" ABOVE FINISHED FLOOR.
3. PROVIDE 1" CONDUIT FROM CONTROL ROOM UNDERFLOOR SPACE TO ROOF FOR RADIO EQUIPMENT ANTENNA CABLE. CABLE SHALL BE FURNISHED, INSTALLED AND CONNECTED BY OTHERS. CONDUIT SHALL TERMINATE ON EXTERIOR WALL OF STAIR #1 1'-0" ABOVE ROOF. PROVIDE PULL WIRE AND CAP ON EXTERIOR END OF CONDUIT.
4. RELOCATE EXISTING KEY BOX FROM EXISTING PLANT OPERATIONS BUILDING THIRD FLOOR CONTROL ROOM TO THE LOCATION SHOWN ON THIS DRAWING. PROVIDE POWER AND CONTROL CONNECTIONS AS SHOWN.
5. PROVIDE 2" CONDUIT FROM CONTROL ROOM UNDERFLOOR SPACE TO LAB FOR COMPUTER WORKSTATION MONITOR CABLE AND KEYBOARD CABLE. CONDUIT SHALL TERMINATE IN LAB 2" ABOVE WORK SURFACE.
6. DISCONNECT SWITCH AND STOP LOCKOUT FOR F-501 SHALL BE ROOF MOUNTED. PROVIDE SUPPORT CHANNELS AS NECESSARY FOR MOUNTING.
7. PROVIDE 208VAC, 1 PHASE POWER TO COOKTOP IN SUPPLY FILES FROM LP35B. CIRCUIT SHALL BE 40AMP/2 POLE.
8. PROVIDE 120VAC, 1 PHASE POWER TO EXHAUST HOOD IN SUPPLY FILES FROM LP35B. CIRCUIT SHALL BE 20AMP/ 1 POLE.

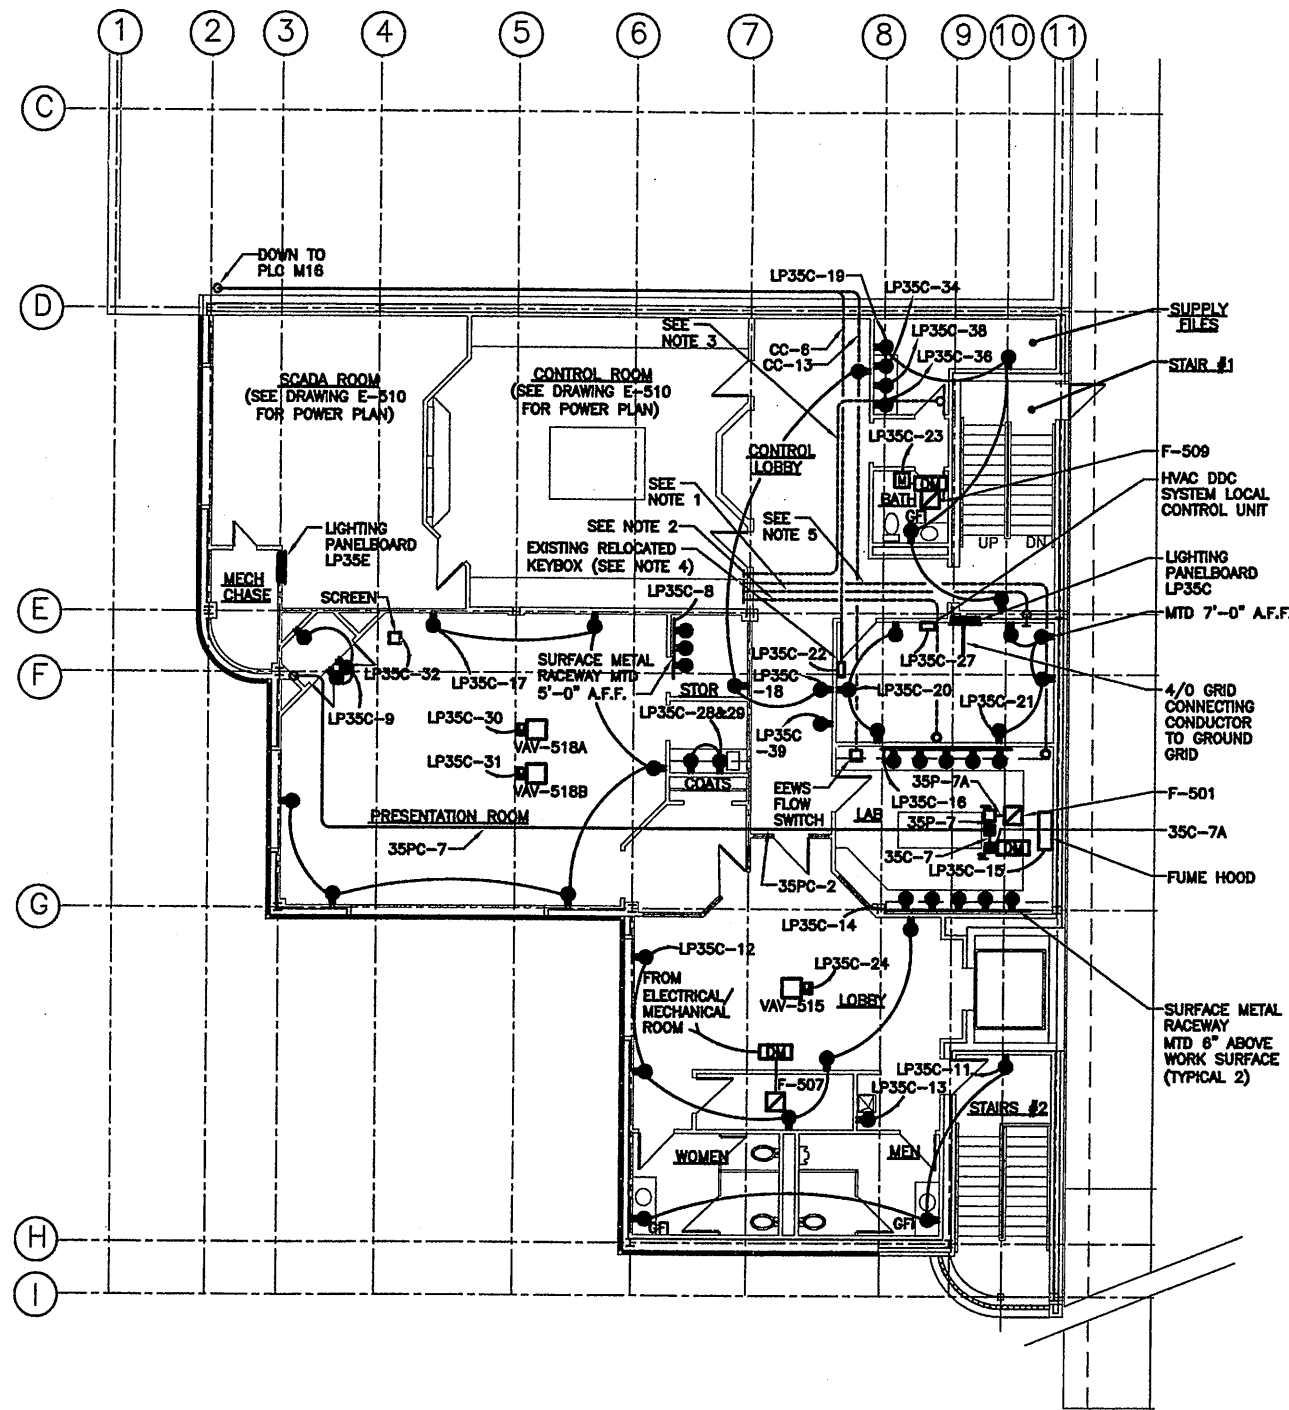

0659x503
03/23/01 OBG CRV
0659E503

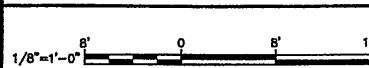

NO ALTERATIONS PERMITTED HEREON EXCEPT AS PROVIDED UNDER SECTION 7209 SUBDIVISION 2 OF THE NEW YORK STATE EDUCATION LAW

| No. | Date | Revisions | Init |
|-----|----------|---------------------|------|
| 0 | 4/20/01 | ISSUED FOR APPROVAL | LP |
| 1 | | AS BID | |
| 2 | 10/31/05 | RECORD DRAWING | |

In charge of TEL
Designed by JJC
Drawn by CRV
Checked by WFH

ENVIRONMENTAL ENGINEERING ASSOCIATES, LLP
SYRACUSE, NEW YORK

ONONDAGA COUNTY • DEPARTMENT OF DRAINAGE AND SANITATION • SYRACUSE, NEW YORK
METROPOLITAN SYRACUSE WASTEWATER TREATMENT PLANT
STAGE III AMMONIA AND STAGE II PHOSPHORUS REMOVAL PROJECT

**OPERATIONS CENTER
THIRD FLOOR
POWER PLAN**
ELECTRICAL



File Number
00659
Date
APRIL 2001
Handwritten signature


E-503

RECORD DRAWING

THESE DRAWINGS HAVE BEEN REARED TO REFLECT MAJOR CHANGES IF ANY, WHICH OCCURRED DURING CONSTRUCTION. REVISIONS ARE BASED UPON INFORMATION SUPPLIED BY CONTRACTOR.

DATE 10/21/05 PER Handwritten signature

THIS DRAWING WAS PREPARED AT THE SCALE INDICATED IN THE TITLE BLOCK. INACCURACIES IN THE STATED SCALE MAY BE INTRODUCED WHEN DRAWINGS ARE REPRODUCED BY ANY MEANS. USE THE GRAPHIC SCALE BAR IN THE TITLE BLOCK TO DETERMINE THE ACTUAL SCALE OF THIS DRAWING.

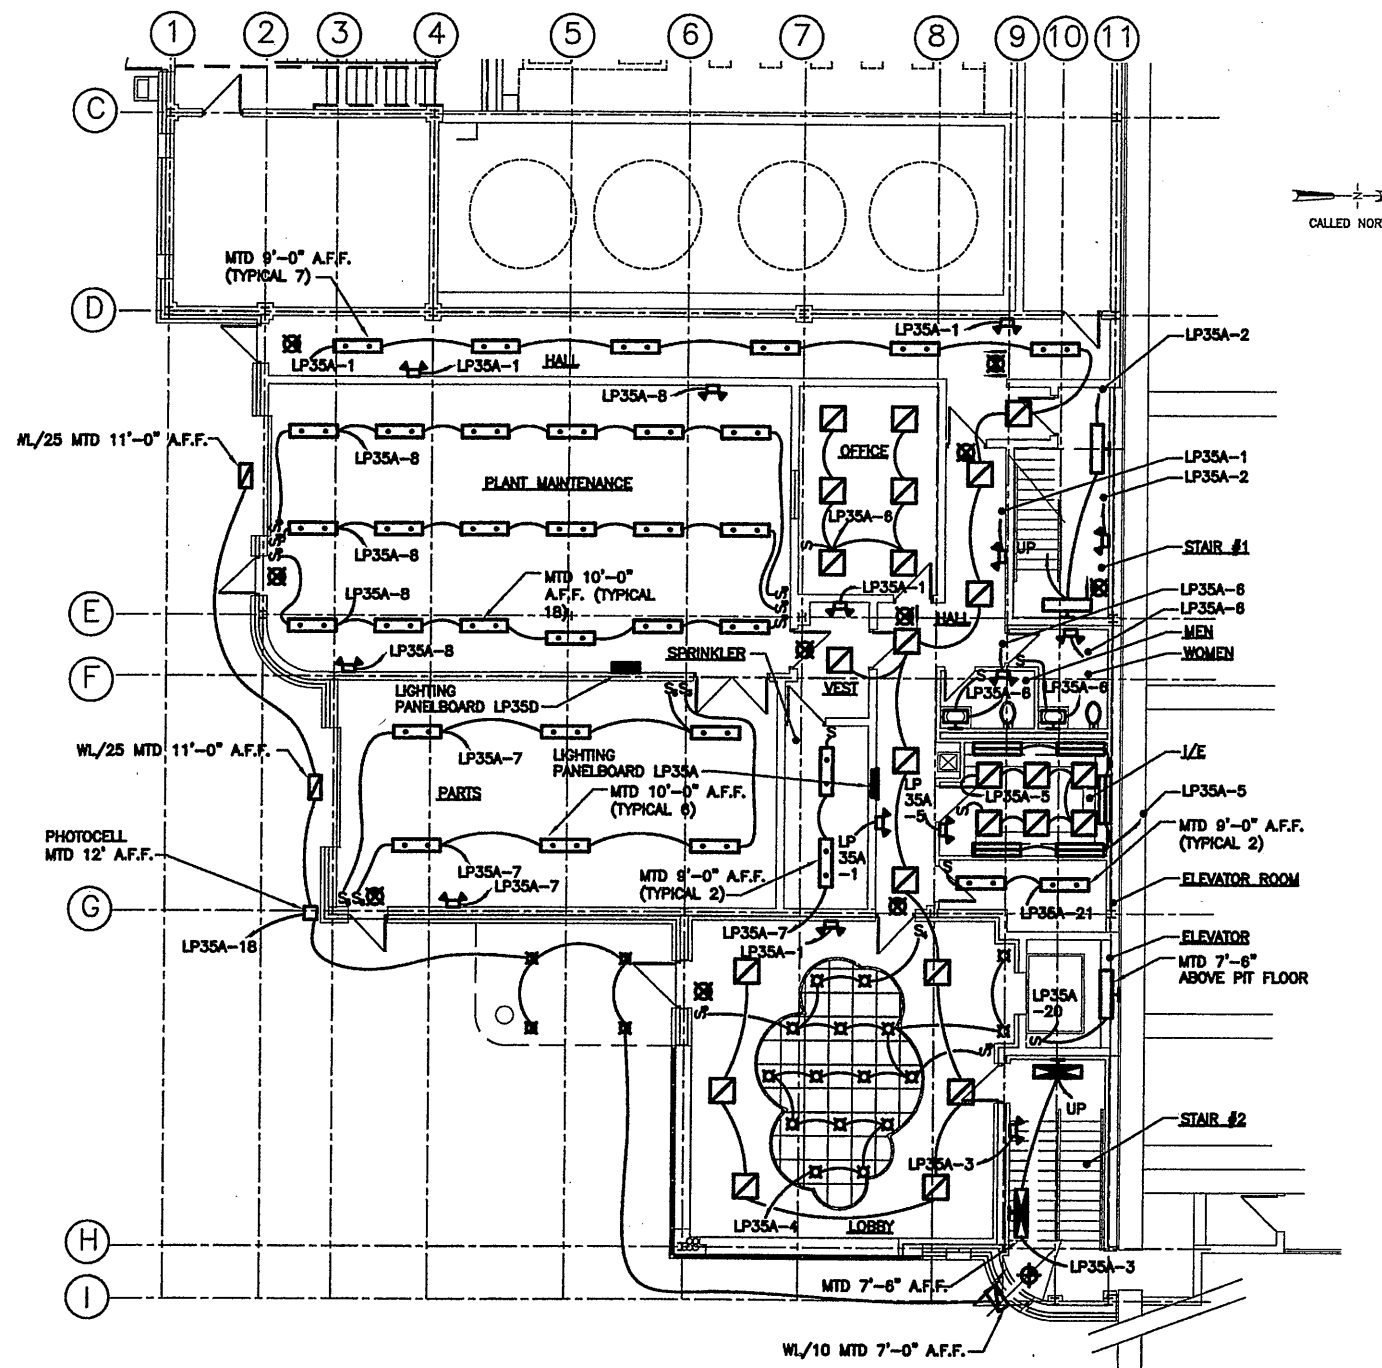

FIRST FLOOR PLAN
SCALE: 1/8"=1'-0"

- NOTES:**
- MEN AND WOMEN WALL MOUNTED FLUORESCENT FIXTURES SHALL BE MOUNTED 6" ABOVE MIRRORS.
 - ELU'S SHALL BE MOUNTED 7'-6" ABOVE FINISHED FLOOR.
 - WALL MOUNTED EXIT SIGNS SHALL BE MOUNTED 8'-0" ABOVE FINISHED FLOOR
 - STAIR #1 & STAIR #2 WALL MOUNTED FLUORESCENT FIXTURES SHALL BE MOUNTED 7'-6" ABOVE FINISHED FLOOR.

RECORD DRAWING

THESE DRAWINGS HAVE BEEN REVISIONED TO REFLECT MAJOR CHANGES OF ANY KIND OCCURRED DURING CONSTRUCTION. REVISIONS ARE BASED UPON INFORMATION SUPPLIED BY CONTRACTOR.
DATE: 10/21/01 FOR: [Signature]

THIS DRAWING WAS PREPARED AT THE SCALE INDICATED IN THE TITLE BLOCK. INACCURACIES IN THE STATED SCALE MAY BE INTRODUCED WHEN DRAWINGS ARE REPRODUCED BY ANY MEANS. USE THE GRAPHIC SCALE BAR IN THE TITLE BLOCK TO DETERMINE THE ACTUAL SCALE OF THIS DRAWING.

0659x501
03/23/01 OBG CRV
0659x504

1/8"=1'-0"
NO ALTERATIONS PERMITTED HEREON EXCEPT AS PROVIDED UNDER SECTION 7209 SUBDIVISION 2 OF THE NEW YORK STATE EDUCATION LAW

| No. | Date | Revisions | Init |
|-----|----------|---------------------|-------------|
| 0 | 4/20/01 | ISSUED FOR APPROVAL | [Signature] |
| 1 | | AS BID | |
| 2 | 10/31/05 | RECORD DRAWING | |

In charge of TEL
Designed by JJC
Drawn by CRV
Checked by WFH


ENVIRONMENTAL ENGINEERING ASSOCIATES, LLP
SYRACUSE, NEW YORK

ONONDAGA COUNTY • DEPARTMENT OF DRAINAGE AND SANITATION • SYRACUSE, NEW YORK
METROPOLITAN SYRACUSE WASTEWATER TREATMENT PLANT
STAGE III AMMONIA AND STAGE II PHOSPHORUS REMOVAL PROJECT
**OPERATIONS CENTER
FIRST FLOOR
LIGHTING PLAN**
ELECTRICAL



File Number 00659
Date APRIL 2001
[Signature]

E-504

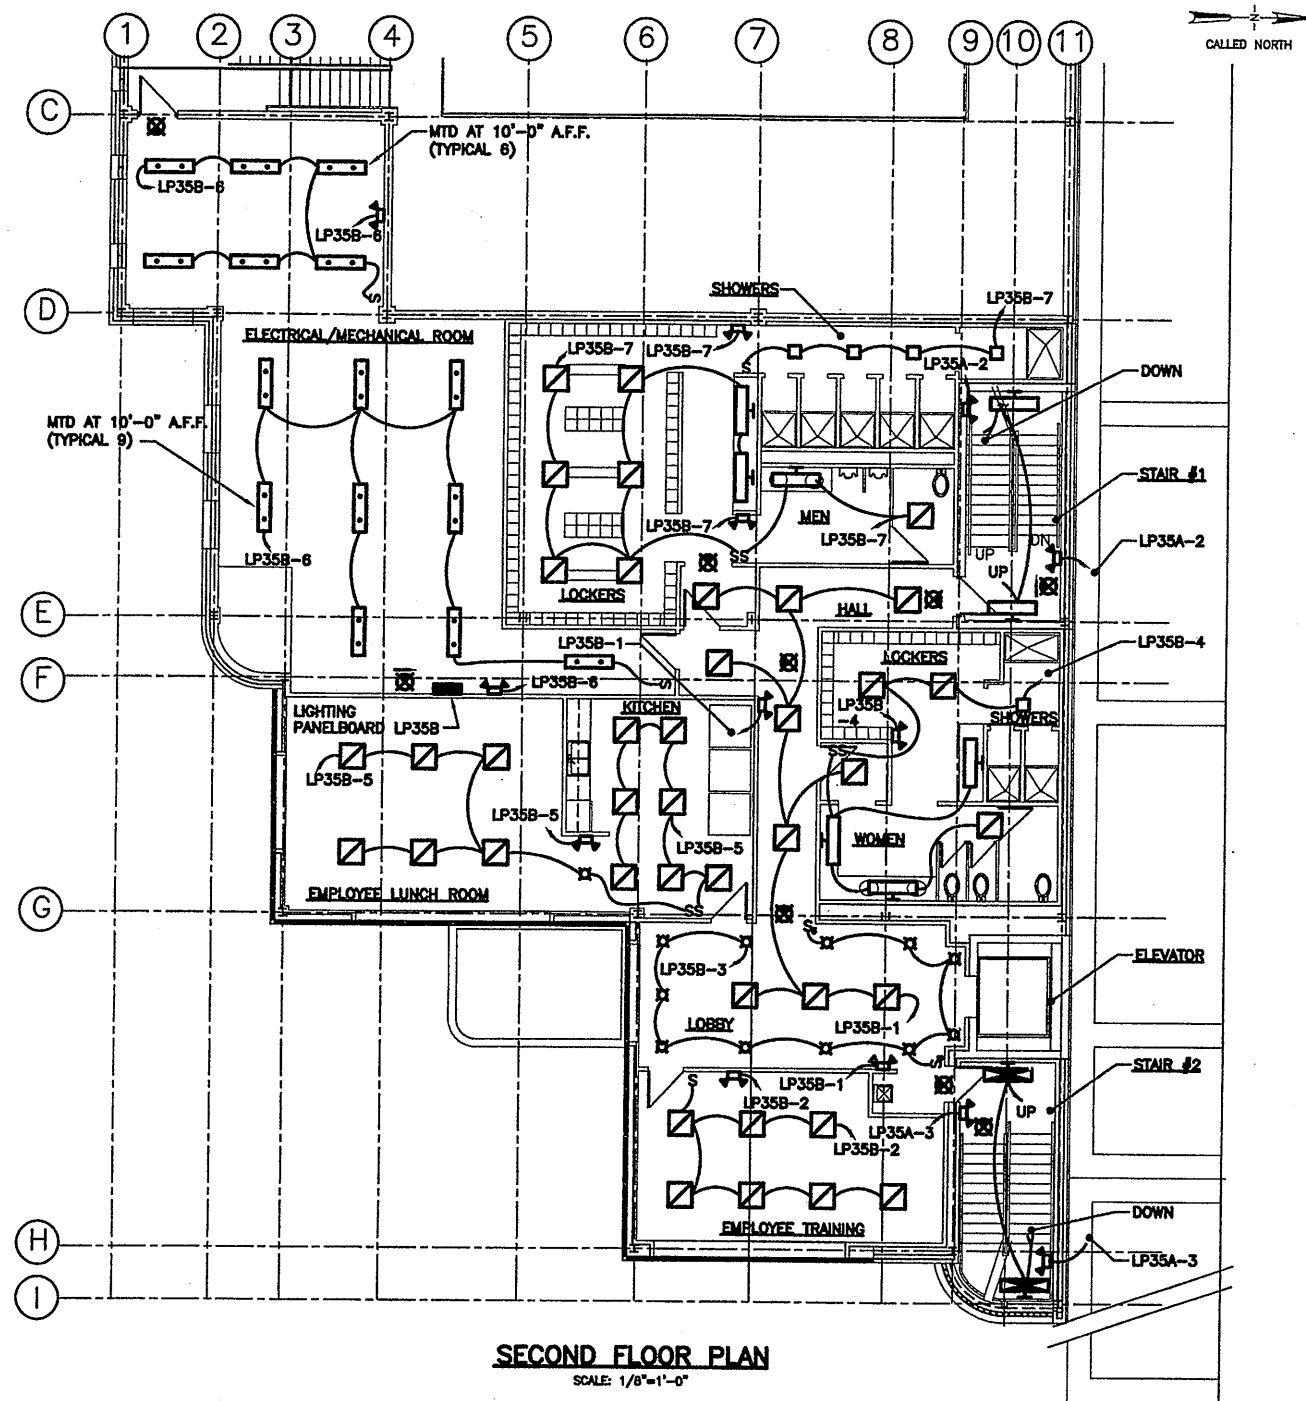

- NOTES:**
1. MEN AND WOMEN WALL MOUNTED FLUORESCENT FIXTURES SHALL BE MOUNTED 6" ABOVE MIRRORS.
 2. ELU'S SHALL BE MOUNTED 7'-6" ABOVE FINISHED FLOOR.
 3. WALL MOUNTED EXIT SIGNS SHALL BE MOUNTED 6'-0" ABOVE FINISHED FLOOR.
 4. STAIR #1 & STAIR #2 WALL MOUNTED FLUORESCENT FIXTURES SHALL BE MOUNTED 7'-6" ABOVE FINISHED FLOOR.

SECOND FLOOR PLAN
SCALE: 1/8"=1'-0"


RECORD DRAWING

THESE DRAWINGS HAVE BEEN REVISIONED TO REFLECT MAKE CHANGES IF ANY, WHICH OCCURRED DURING CONSTRUCTION. REVISIONS ARE BASED UPON INFORMATION SUPPLIED BY CONTRACTOR.

DATE: 10/21/05 FOR: L&A/PROJECT

THIS DRAWING WAS PREPARED AT THE SCALE INDICATED IN THE TITLE BLOCK. INACCURACIES IN THE STATED SCALE MAY BE INTRODUCED WHEN DRAWINGS ARE REPRODUCED BY ANY MEANS. USE THE GRAPHIC SCALE BAR IN THE TITLE BLOCK TO DETERMINE THE ACTUAL SCALE OF THIS DRAWING.

0659e502
03/2/01 OBG DIV59 CRV
0659e505

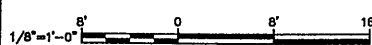

| No. | Date | Revisions | Init |
|-----|----------|---------------------|------|
| 0 | 4/20/01 | ISSUED FOR APPROVAL | LJC |
| 1 | | AS BID | |
| 2 | 10/31/05 | RECORD DRAWING | |

In charge of TEL
Designed by JJC
Drawn by CRV
Checked by WEH

ENVIRONMENTAL ENGINEERING ASSOCIATES, LLP
SYRACUSE, NEW YORK

ONONDAGA COUNTY • DEPARTMENT OF DRAINAGE AND SANITATION • SYRACUSE, NEW YORK
METROPOLITAN SYRACUSE WASTEWATER TREATMENT PLANT
STAGE III AMMONIA AND STAGE II PHOSPHORUS REMOVAL PROJECT



**OPERATIONS CENTER
SECOND FLOOR
LIGHTING PLAN**
ELECTRICAL



File Number
00659
Date
APRIL 2001
L&A/PROJECT

E-505

NO ALTERATIONS PERMITTED HEREON EXCEPT AS PROVIDED UNDER SECTION 7209 SUBDIVISION 2 OF THE NEW YORK STATE EDUCATION LAW

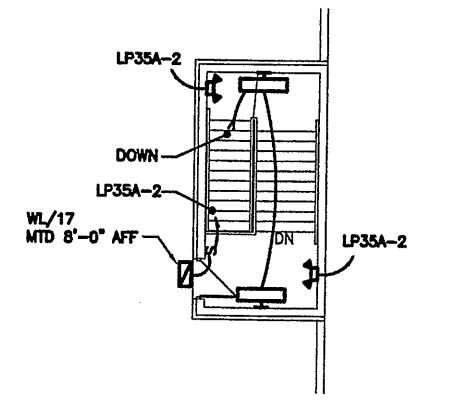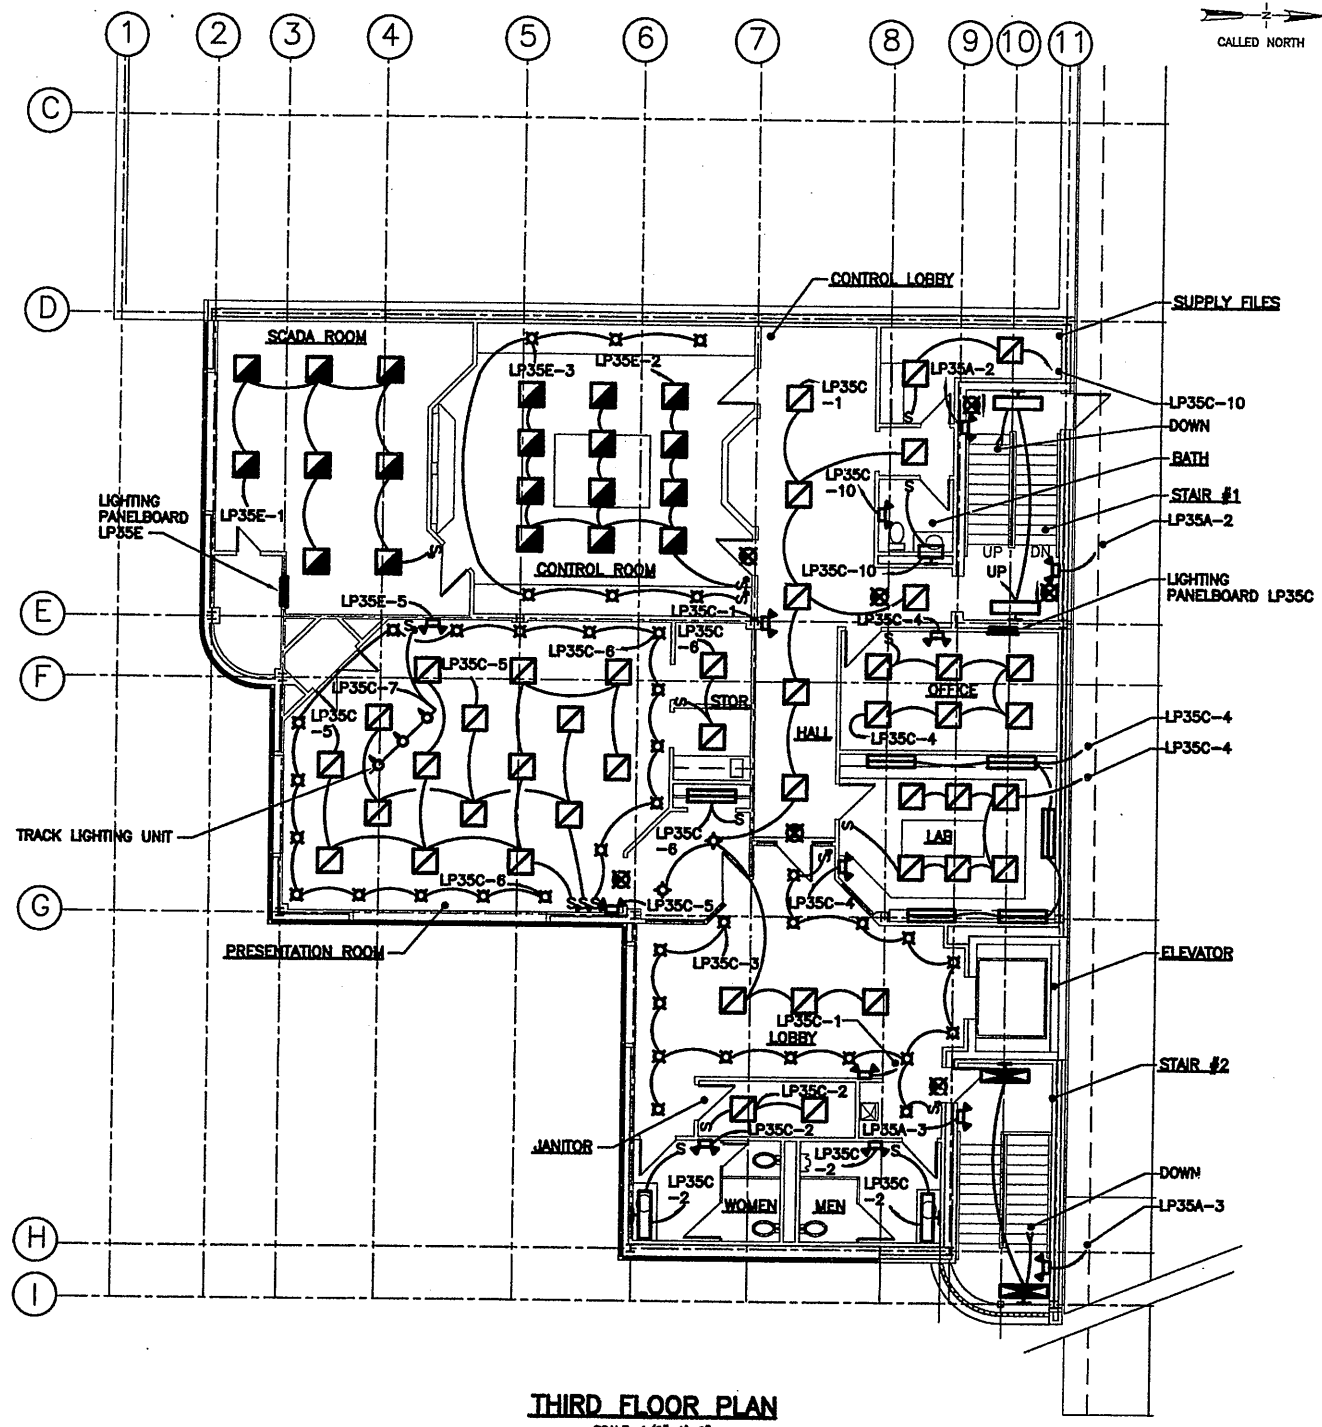

- NOTES:**
- MEN AND WOMEN WALL MOUNTED FLUORESCENT FIXTURES SHALL BE MOUNTED 6" ABOVE MIRRORS.
 - ELU'S SHALL BE MOUNTED 7'-6" ABOVE FINISHED FLOOR.
 - WALL MOUNTED EXIT SIGNS SHALL BE MOUNTED 8'-0" ABOVE FINISHED FLOOR.
 - STAIR #1 & STAIR #2 WALL MOUNTED FLUORESCENT FIXTURES SHALL BE MOUNTED 7'-6" ABOVE FINISHED FLOOR.

0659x503
03/23/01 OBG CRV
0659x506

1/8"=1'-0"
NO ALTERATIONS PERMITTED HEREON EXCEPT AS PROVIDED UNDER SECTION 7209 SUBDIVISION 2 OF THE NEW YORK STATE EDUCATION LAW

| No. | Date | Revisions | Init |
|-----|----------|---------------------|------|
| 0 | 4/20/01 | ISSUED FOR APPROVAL | JJC |
| 1 | | AS BID | |
| 2 | 10/31/05 | RECORD DRAWING | |

In charge of TEL
Designed by JJC
Drawn by CRV
Checked by WEH



ONONDAGA COUNTY • DEPARTMENT OF DRAINAGE AND SANITATION • SYRACUSE, NEW YORK
METROPOLITAN SYRACUSE WASTEWATER TREATMENT PLANT
STAGE III AMMONIA AND STAGE II PHOSPHORUS REMOVAL PROJECT

**OPERATIONS CENTER
THIRD FLOOR
LIGHTING PLAN**
ELECTRICAL





File Number
00659
Date
APRIL 2001

E-506

RECORD DRAWING
THESE DRAWINGS HAVE BEEN REVIEWED TO REFLECT MAJOR CHANGES, IF ANY, WHICH OCCURRED DURING CONSTRUCTION. REVISIONS ARE BASED UPON INFORMATION SUPPLIED BY CONTRACTOR.
DATE 10/21/05 FOR [Signature]

THIS DRAWING WAS PREPARED AT THE SCALE INDICATED IN THE TITLE BLOCK. INACCURACIES IN THE STATED SCALE MAY BE INTRODUCED WHEN DRAWINGS ARE REPRODUCED BY ANY MEANS. USE THE GRAPHIC SCALE BAR IN THE TITLE BLOCK TO DETERMINE THE ACTUAL SCALE OF THIS DRAWING.

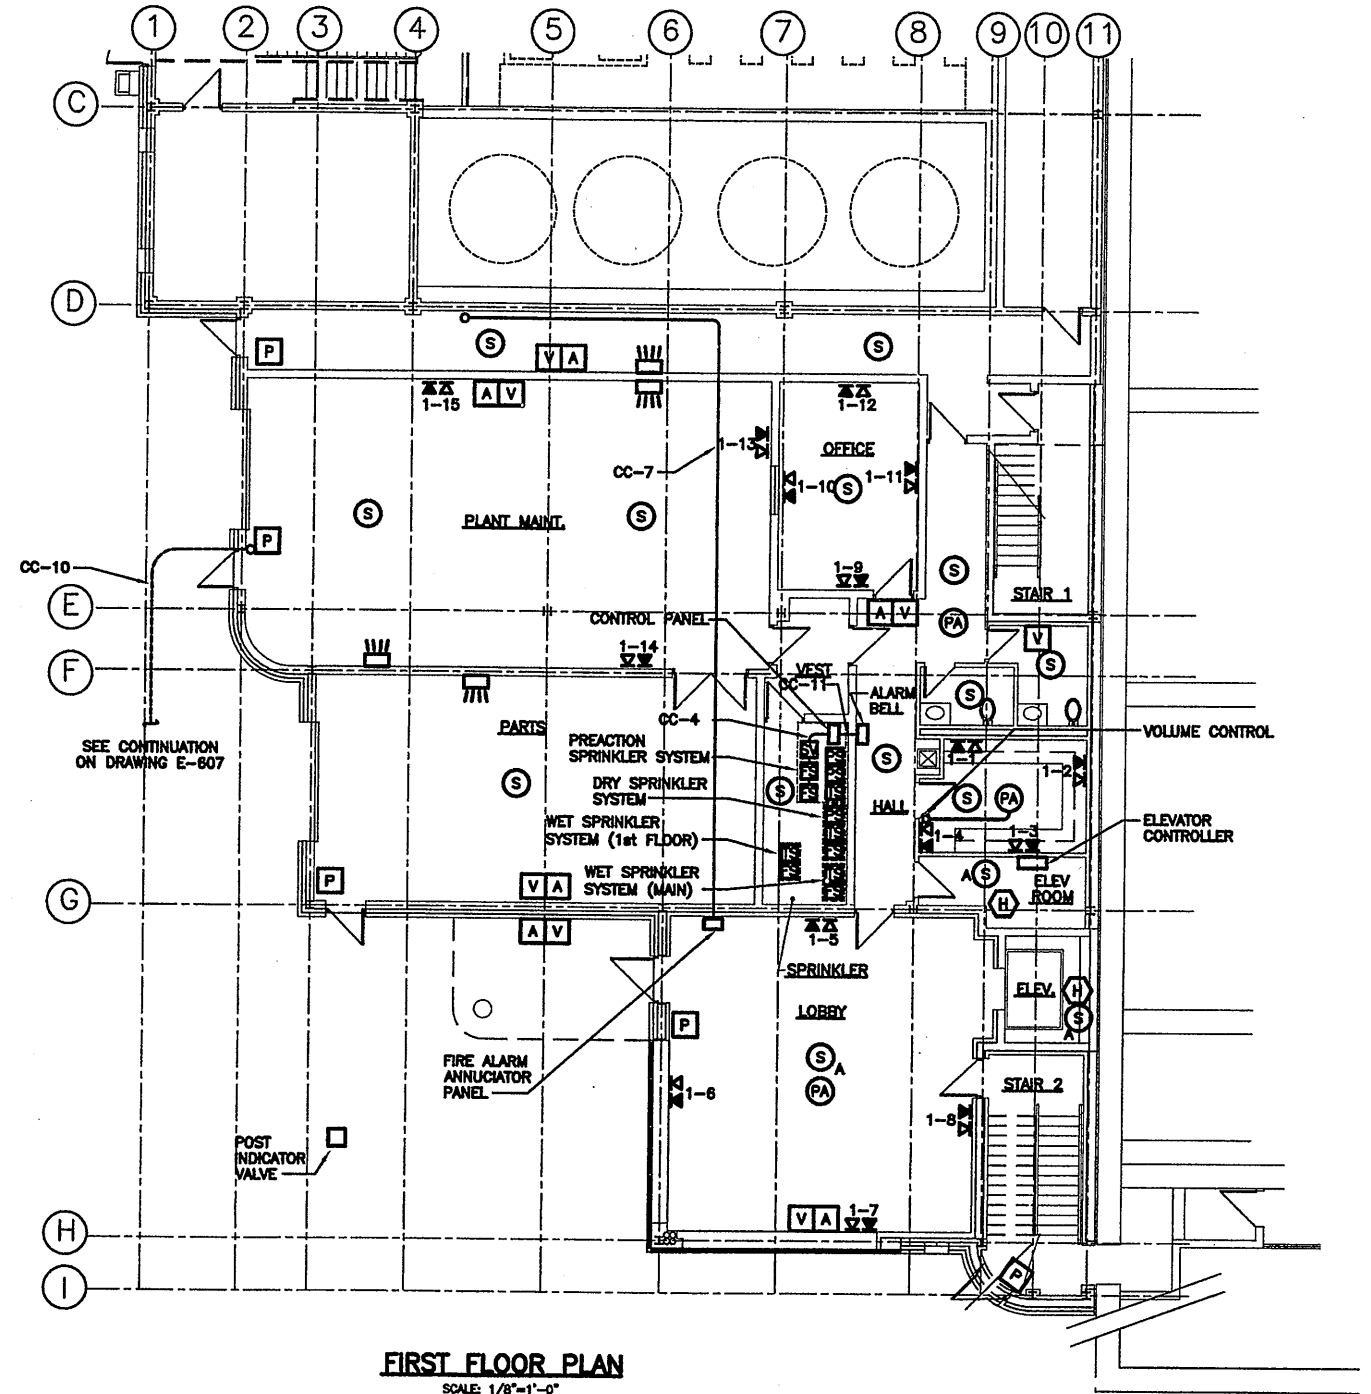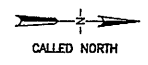


FIRST FLOOR PLAN
SCALE: 1/8"=1'-0"

RECORD DRAWING

THESE DRAWINGS HAVE BEEN REVISIONED TO REFLECT
MAJOR CHANGES, IF ANY, WHICH OCCURRED DURING
CONSTRUCTION. REVISIONS ARE LISTED UPON
INFORMATION SUPPLIED BY CONTRACTOR.
DATE *10/2/01* FOR *10/2/01*

THIS DRAWING WAS PREPARED AT THE SCALE INDICATED IN THE
TITLE BLOCK. INACCURACIES IN THE STATED SCALE MAY BE
INTRODUCED WHEN DRAWINGS ARE REPRODUCED BY ANY MEANS.
USE THE GRAPHIC SCALE BAR IN THE TITLE BLOCK TO
DETERMINE THE ACTUAL SCALE OF THIS DRAWING.

0659x501
03/23/01 OBG CRV
0659x507

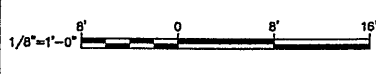

| No. | Date | Revisions | Init |
|-----|----------|---------------------|------------|
| 0 | 4/20/01 | ISSUED FOR APPROVAL | <i>llk</i> |
| 1 | | AS BID | |
| 2 | 10/31/01 | RECORD DRAWING | |

In charge of TEL
Designed by JJC
Drawn by CRV
Checked by WEH

ENVIRONMENTAL ENGINEERING ASSOCIATES, LLP
SYRACUSE, NEW YORK



ONONDAGA COUNTY • DEPARTMENT OF DRAINAGE AND SANITATION • SYRACUSE, NEW YORK
METROPOLITAN SYRACUSE WASTEWATER TREATMENT PLANT
STAGE III AMMONIA AND STAGE II PHOSPHORUS REMOVAL PROJECT
OPERATIONS CENTER
FIRST FLOOR
MISCELLANEOUS SYSTEMS PLAN
ELECTRICAL



File Number
00659
Date
APRIL 2001
Leonard J. Campbell

E-507

NO ALTERATIONS PERMITTED HEREON EXCEPT
AS PROVIDED UNDER SECTION 7209 SUBDIVISION
2 OF THE NEW YORK STATE EDUCATION LAW

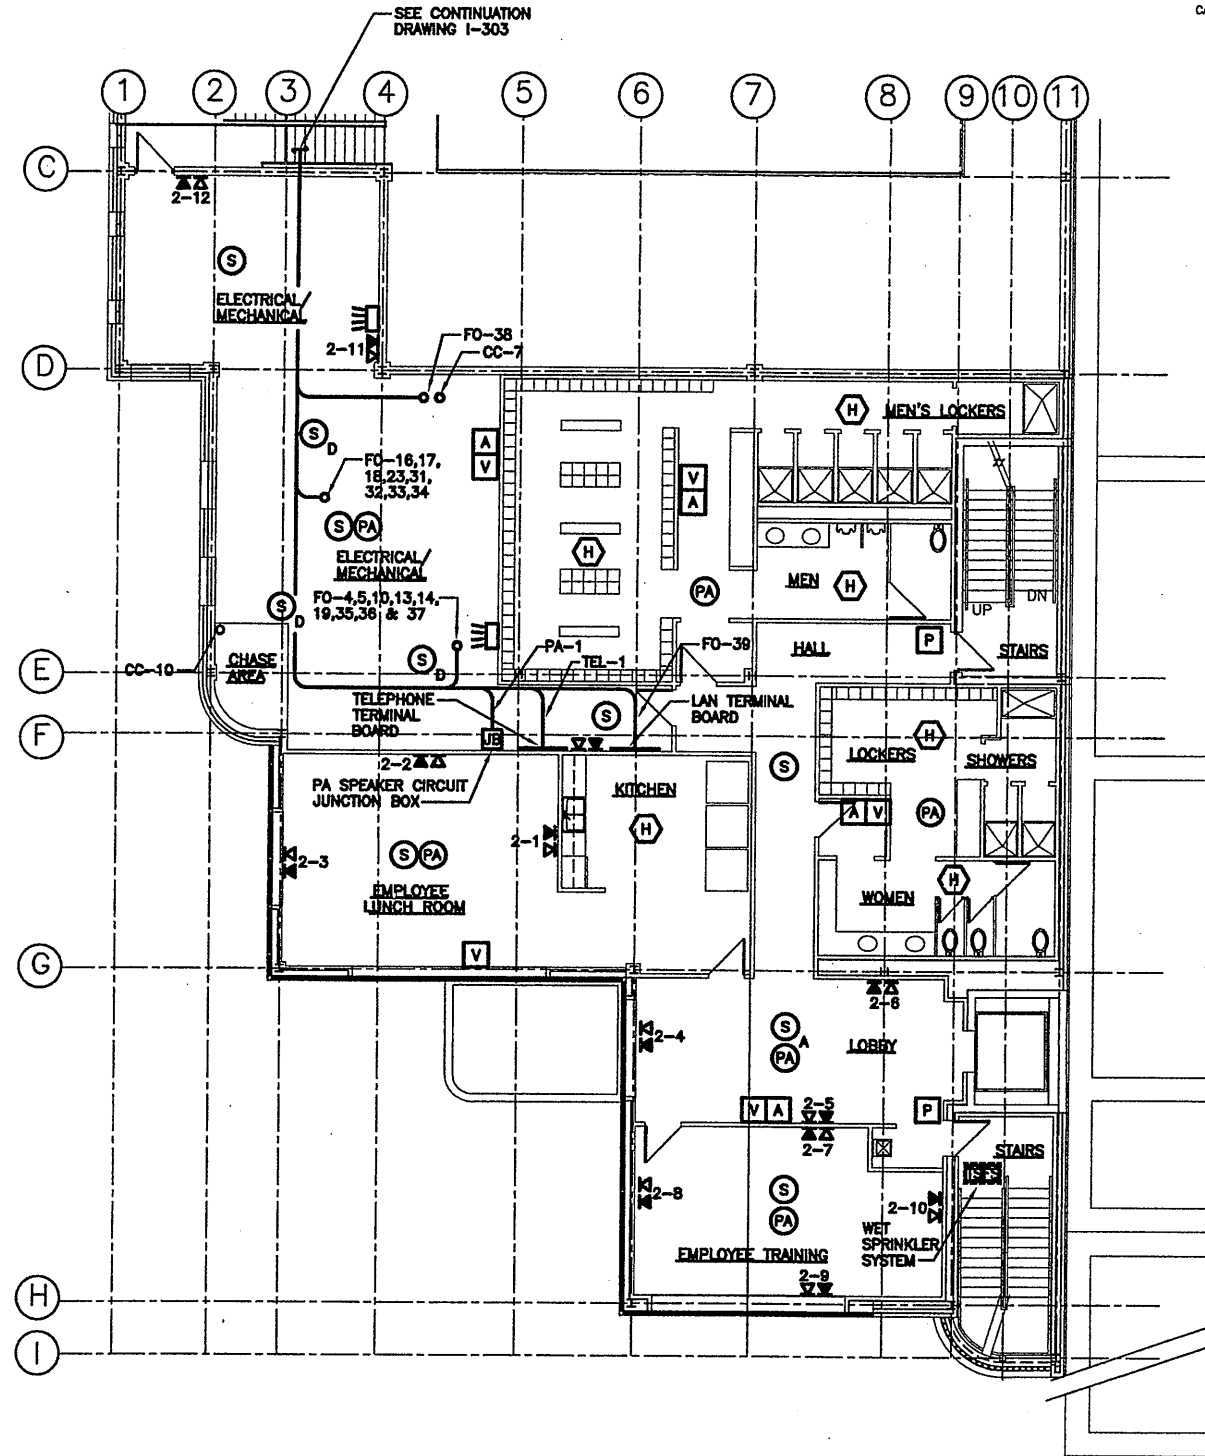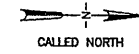


SECOND FLOOR PLAN
SCALE: 1/8"=1'-0"

RECORD DRAWING

THESE DRAWINGS HAVE BEEN REVIEWED TO REFLECT
MAJOR CHANGES, IF ANY, WHICH OCCURRED DURING
CONSTRUCTION. REVISIONS ARE BASED UPON
INFORMATION SUPPLIED BY CONTRACTOR.
DATE: 10/21/05 FOR: Rampolot

THIS DRAWING WAS PREPARED AT THE SCALE INDICATED IN THE
TITLE BLOCK. INACCURACIES IN THE STATED SCALE MAY BE
INTRODUCED WHEN DRAWINGS ARE REPRODUCED BY ANY MEANS.
USE THE GRAPHIC SCALE BAR IN THE TITLE BLOCK TO
DETERMINE THE ACTUAL SCALE OF THIS DRAWING.

0659X502
03/23/01 OBG CRV
0659E508

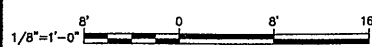

NO ALTERATIONS PERMITTED HEREON EXCEPT
AS PROVIDED UNDER SECTION 7209 SUBDIVISION
2 OF THE NEW YORK STATE EDUCATION LAW

| No. | Date | Revisions | Init |
|-----|----------|---------------------|------|
| 0 | 4/20/01 | ISSUED FOR APPROVAL | LJE |
| 1 | | AS B/D | |
| 2 | 10/31/05 | RECORD DRAWING | |

In charge of TEL
Designed by JJC
Drawn by CRV
Checked by WFH




ONONDAGA COUNTY • DEPARTMENT OF DRAINAGE AND SANITATION • SYRACUSE, NEW YORK
METROPOLITAN SYRACUSE WASTEWATER TREATMENT PLANT
STAGE III AMMONIA AND STAGE II PHOSPHORUS REMOVAL PROJECT

**OPERATIONS CENTER
SECOND FLOOR
MISCELLANEOUS SYSTEMS PLAN**
ELECTRICAL




File Number
00659
Date
APRIL 2001
Rampolot

E-508

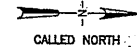

NOTE:

1. SMOKE DETECTORS IN THE SCADA ROOM UNDERFLOOR SPACE AND CONTROL ROOM UNDERFLOOR SPACE SHALL BE MOUNTED INDEPENDENT OF THE RAISED FLOOR SYSTEM. PROVIDE MOUNTING BRACKETS AS NECESSARY TO FACILITATE INSTALLATION.
2. PROVIDE A 36" WIDE x 18" DEEP SHELF AND BRACKETS FOR MOUNTING WIRELESS MICROPHONE RECEIVER & AMPLIFIER. SHELF SHALL BE MOUNTED 5'-0" A.F.F.
3. IN THE CONTROL ROOM, PROVIDE 7 ADDITIONAL DATA OUTLETS ON THE WEST WALL AND SEVEN ADDITIONAL DATA OUTLETS ON THE EAST WALL. OUTLETS SHALL BE MOUNTED IN THE SURFACE METAL RACEWAY ON THOSE WALLS AND SHALL BE EQUALLY SPACED ON THE RACEWAY. PROVIDE HORIZONTAL CABLING FROM THE OUTLETS TO THE LAN TERMINAL BOARD LOCATED IN THE OPERATIONS CENTER ELECTRICAL/MECHANICAL ROOM.

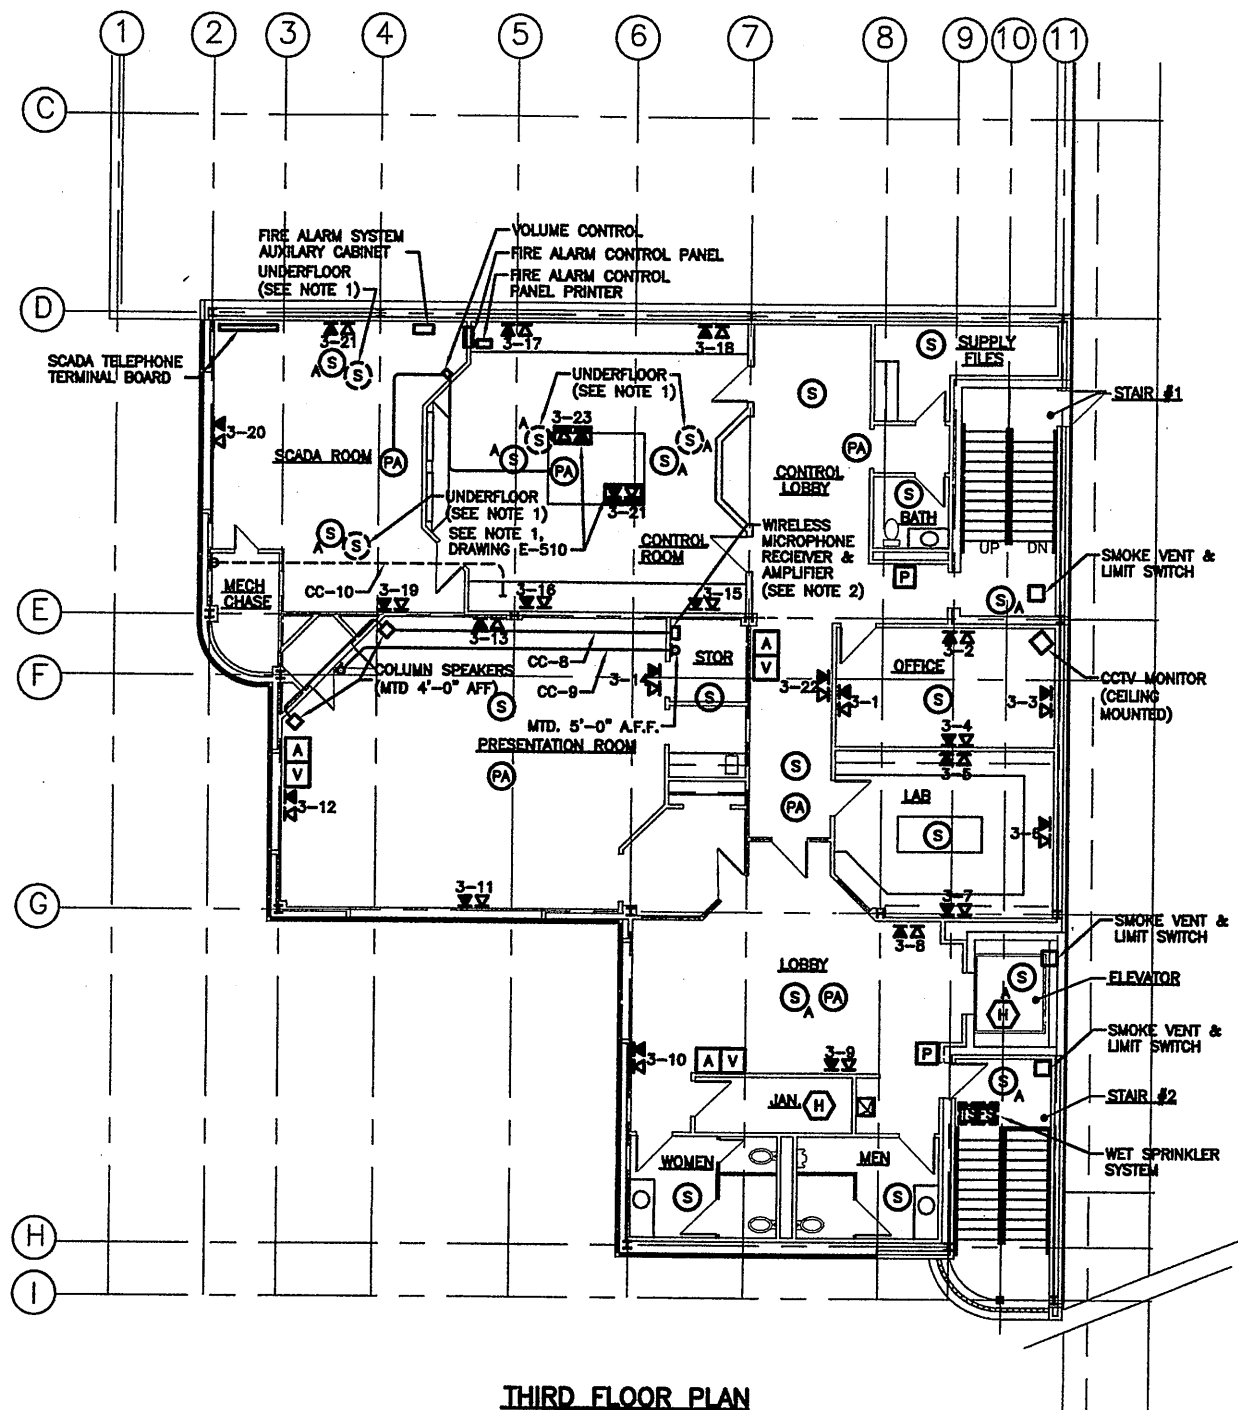

THIRD FLOOR PLAN
SCALE: 1/8"=1'-0"

RECORD DRAWING

THESE CHANGES HAVE BEEN MADE TO REFLECT
 MAKE CHANGES IF ANY, WHICH OCCURRED DURING
 CONSTRUCTION. REVISIONS ARE BASED UPON
 INFORMATION SUPPLIED BY CONSTRUCTOR.
 DATE: 10/21/01 FOR: *Reamplate*

THIS DRAWING WAS PREPARED AT THE SCALE INDICATED IN THE
 TITLE BLOCK. INACCURACIES IN THE STATED SCALE MAY BE
 INTRODUCED WHEN DRAWINGS ARE REPRODUCED BY ANY MEANS.
 USE THE GRAPHIC SCALE BAR IN THE TITLE BLOCK TO
 DETERMINE THE ACTUAL SCALE OF THIS DRAWING.

0659x503
 03/23/01 OBG CRV
 0659x509

1/8"=1'-0"
 NO ALTERATIONS PERMITTED HEREON EXCEPT
 AS PROVIDED UNDER SECTION 7209 SUBDIVISION
 2 OF THE NEW YORK STATE EDUCATION LAW

| No. | Date | Revisions | Init |
|-----|----------|---------------------|------|
| 0 | 4/20/01 | ISSUED FOR APPROVAL | LP |
| 1 | | AS BID | |
| 2 | 10/31/01 | RECORD DRAWING | |



In charge of ___ TEL ___
 Designed by ___ JJC ___
 Drawn by ___ CRV ___
 Checked by ___ WFH ___



ONONDAGA COUNTY • DEPARTMENT OF DRAINAGE AND SANITATION • SYRACUSE, NEW YORK
 METROPOLITAN SYRACUSE WASTEWATER TREATMENT PLANT
 STAGE III AMMONIA AND STAGE II PHOSPHORUS REMOVAL PROJECT
OPERATIONS CENTER
THIRD FLOOR
MISCELLANEOUS SYSTEMS PLAN
 ELECTRICAL



File Number
 00659
 Date
 APRIL 2001
Reamplate
E-509

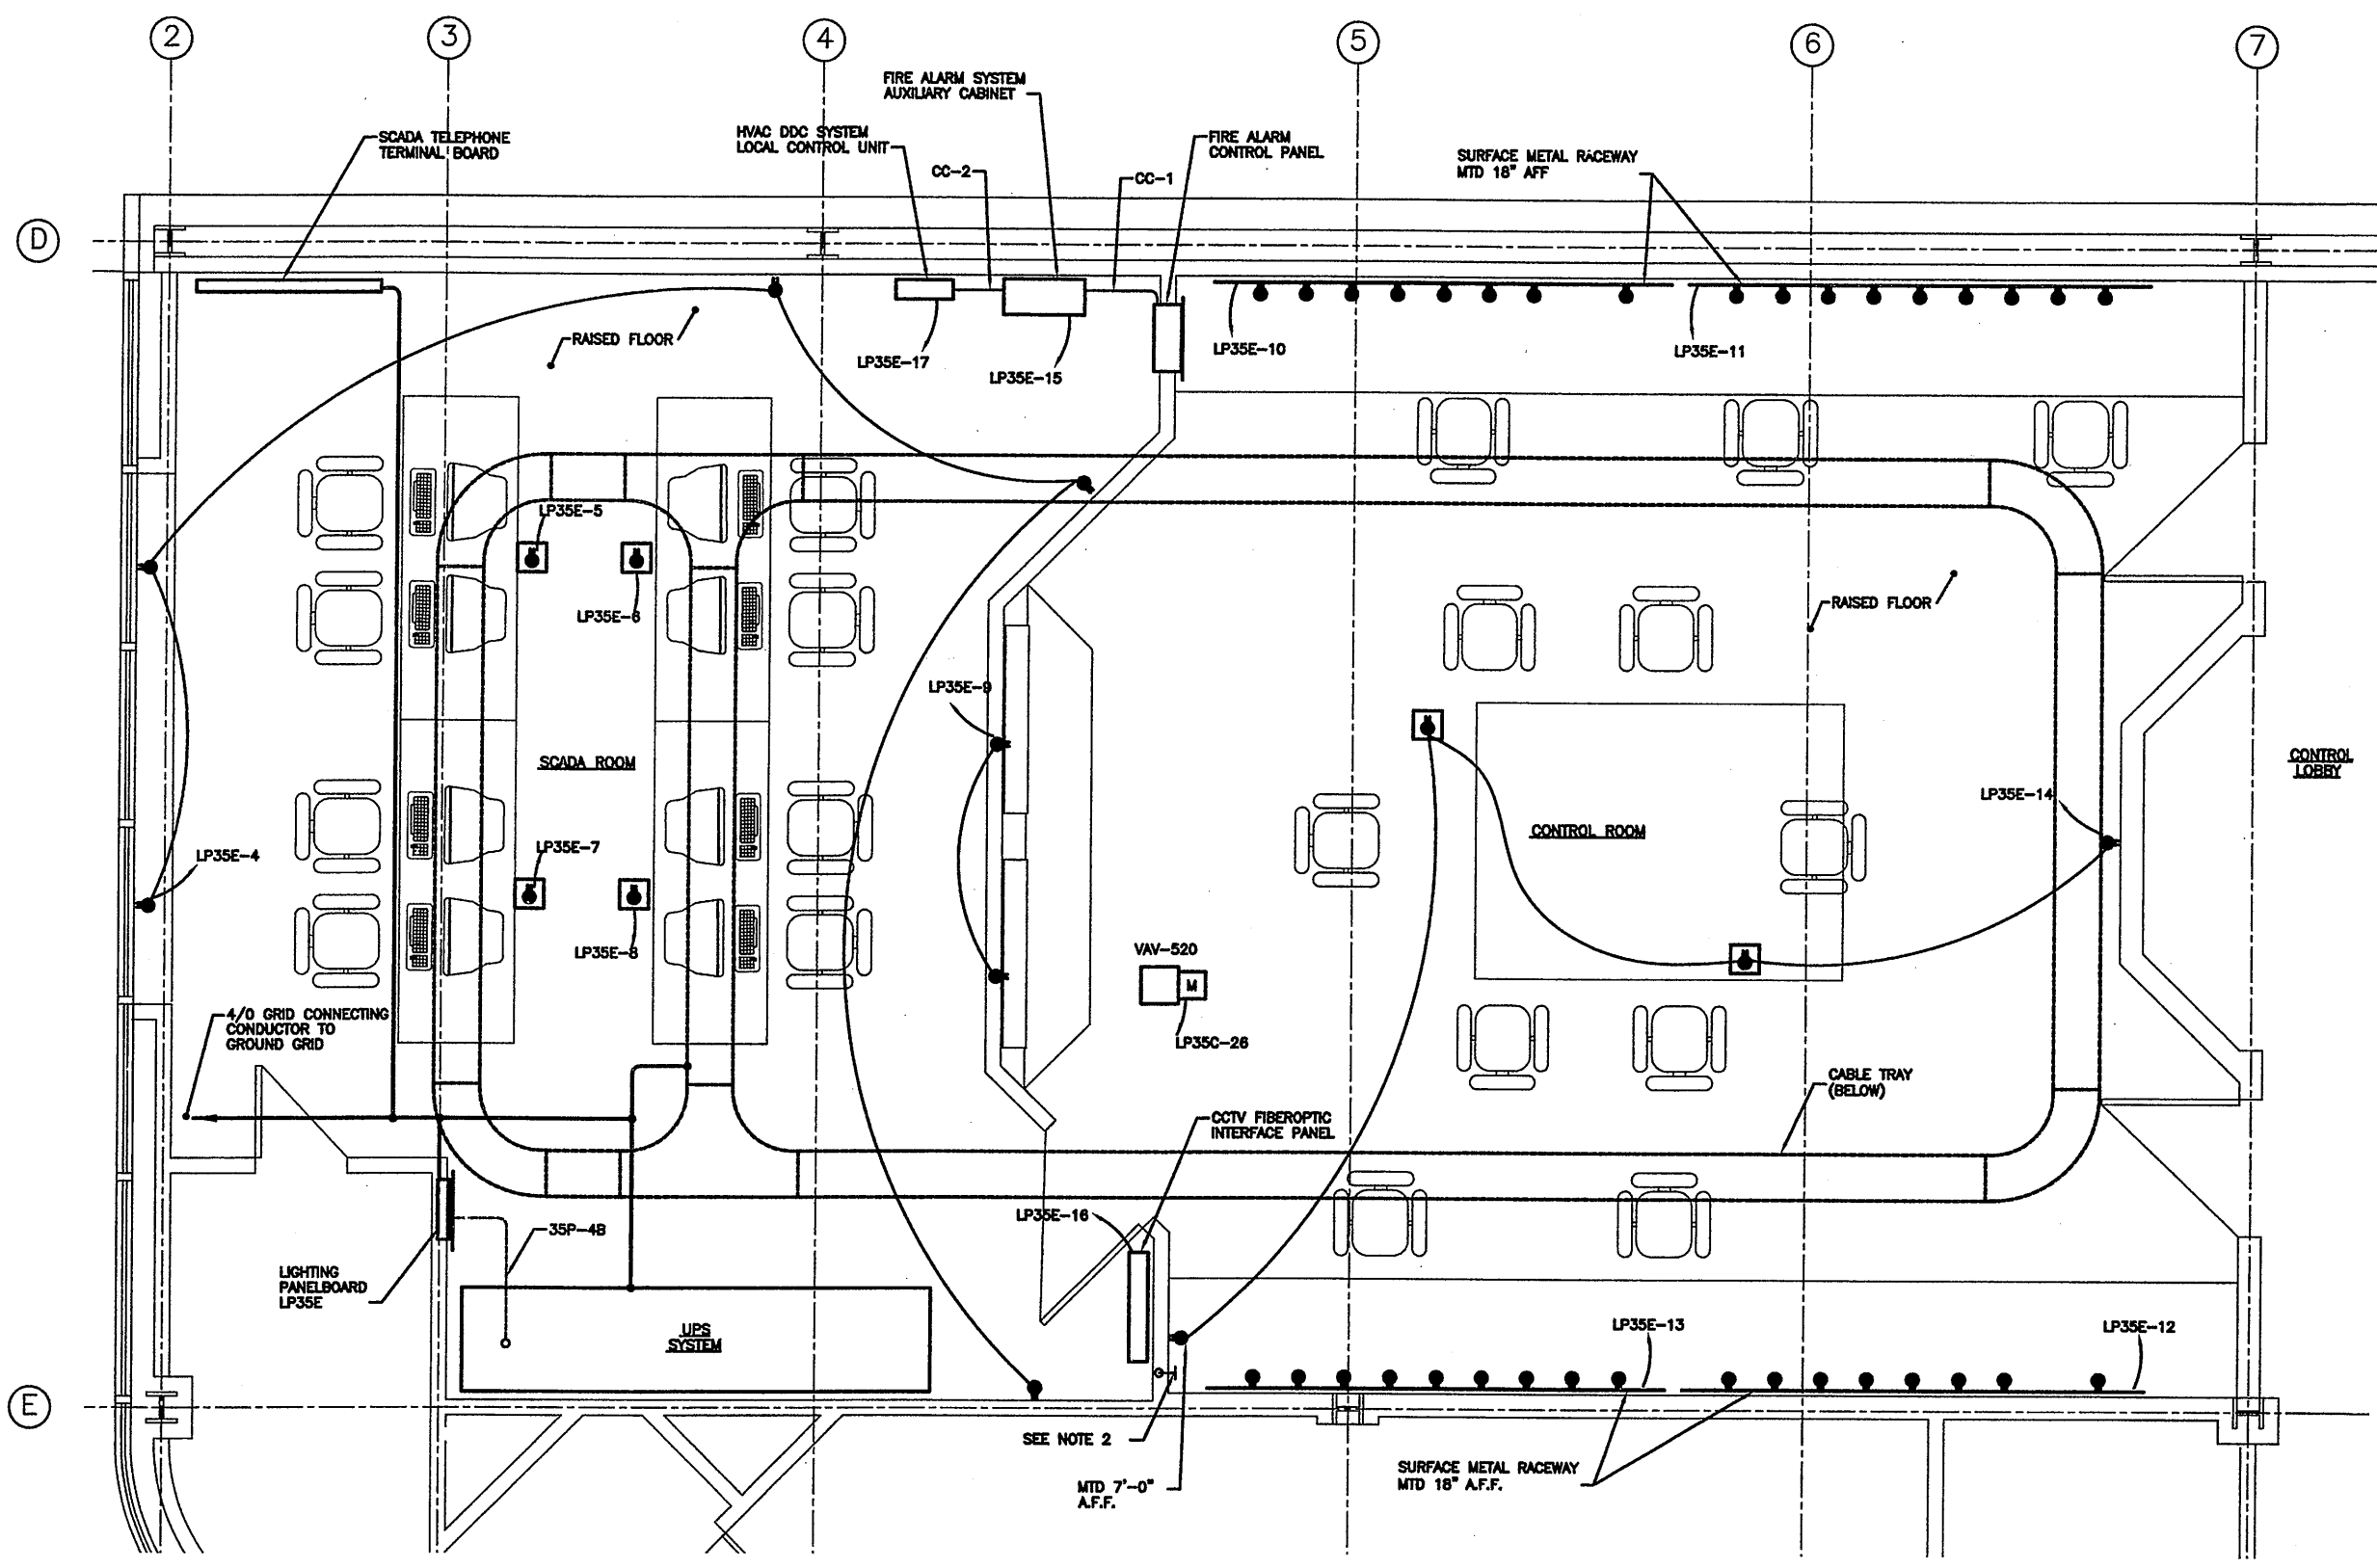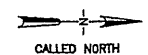

- NOTES:**
1. FLOOR RECEPTACLES, FLOOR TELEPHONE OUTLETS AND FLOOR DATA OUTLETS IN THE SCADA ROOM AND CONTROL ROOM SHALL BE MOUNTED IN FLUSH MOUNTED SERVICE CENTERS FURNISHED WITH THE RAISED FLOOR SYSTEM. SEE DRAWING E-509 FOR TELEPHONE AND DATA OUTLET LOCATIONS.
 2. PROVIDE 1" CONDUIT FROM UNDERFLOOR SPACE TO CONTROL ROOM WALL FOR CCTV MONITOR VIDEO CABLE. CONDUIT SHALL TERMINATE ON WALL 7'-0" ABOVE FINISHED FLOOR WITH OUTLET BOX, WALL PLATE AND CABLE BUSHING.
 3. PROVIDE TWO 2" CONDUITS FROM CCTV FIBEROPTIC INTERFACE PANEL TO UNDERFLOOR SPACE (DIRECTLY BELOW PANEL) FOR ROUTING VIDEO & CONTROL CABLES.


SCADA ROOM/CONTROL ROOM PLAN
SCALE: 1/2"=1'-0"

RECORD DRAWING

THESE DRAWINGS HAVE BEEN REVISIONED TO REFLECT MAJOR CHANGES, IF ANY, WHICH OCCURRED DURING CONSTRUCTION. REVISIONS ARE BASED UPON INFORMATION SUPPLIED BY CONTRACTOR.
DATE: 10/21/01 PER: [Signature]

THIS DRAWING WAS PREPARED AT THE SCALE INDICATED IN THE TITLE BLOCK. INACCURACIES IN THE STATED SCALE MAY BE INTRODUCED WHEN DRAWINGS ARE REPRODUCED BY ANY MEANS. USE THE GRAPHIC SCALE BAR IN THE TITLE BLOCK TO DETERMINE THE ACTUAL SCALE OF THIS DRAWING.

0569x503
03/23/01 OBG CRV
0659x510

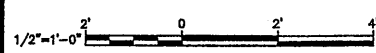

| No. | Date | Revisions | Init |
|-----|----------|---------------------|-------------|
| 0 | 4/20/01 | ISSUED FOR APPROVAL | [Signature] |
| 1 | | AS BID | |
| 2 | 10/31/05 | RECORD DRAWING | |

In charge of --- TEL ---
Designed by --- JJC ---
Drawn by --- CRV ---
Checked by --- WFH ---



ONONDAGA COUNTY • DEPARTMENT OF DRAINAGE AND SANITATION • SYRACUSE, NEW YORK
METROPOLITAN SYRACUSE WASTEWATER TREATMENT PLANT
STAGE III AMMONIA AND STAGE II PHOSPHORUS REMOVAL PROJECT
OPERATIONS CENTER
**SCADA ROOM/CONTROL ROOM
POWER PLAN**



File Number
00659
Date
APRIL 2001
E-510
[Signature]

ELECTRICAL

MCC 35 - OPERATIONS CENTER

| PANEL NUMBER | EQUIPMENT IN MCC | CONDUIT NUMBER | EQUIPMENT REMOTE FROM MCC | CONDUIT SCHEDULE | | |
|--------------|------------------|----------------|--|---|--|--|
| | | | | CONDUIT NUMBER | CONDUCTOR QUANTITY \ SIZE | DIAMETER |
| 1D | 600 AT 600 AF | MF-35 | 600AT 600AF 480 VOLT 3 PHASE 60 HERTZ FROM UNIT SUBSTATION #1 | MF-35 | (6) 350 kcmil 2 PER # 2-2/0 G | (2) 2 1/2" C |
| 1A | 80 100 3P | 35P-1 | FURNISHED INSTALLED & CONNECTED BY CONTRACT NO. 4B 80A, 3P (SEE NOTE 1) 35P-1 35C-1 30A, 3P (ONE POLE ONLY CONNECTED) LP35A-19 ELEVATOR FURNISHED INSTALLED & CONNECTED BY CONTRACT NO. 4A 25 HP ELEVATOR CONTROLLER | 35P-1 35C-1 | 3#3, 1 #8G 2#14 | 1" C 3/4" C |
| 1B | 125 225 3P | 35P-2 | 100AT 100AF 75 KVA 480- 208/120V 35P-2A 35P-2C 35P-2D LP35A LP35B LP35C LIGHTING TRANSFORMER (ELECTRICAL/MECHANICAL) | 35P-2 35P-2A 35P-2B 35P-2C 35P-2D 35P-2E | 3#1, 1 #8G 4#1, 1 #8G 4#1, 1 #8G 4#1, 1 #8G 4#1, 1 #8G 4#1, 1 #8G | 1 1/2" C 1 1/2" C 1 1/2" C 1 1/2" C 1 1/2" C 1 1/2" C |
| 1AR | 45 100 3P | 35P-3 | 35P-3 30 KVA 480- 208/120V 35P-3A LP-35D LIGHTING TRANSFORMER (PLANT MAINTENANCE) | 35P-3 35P-3A | 3#6, 1 #10G 4#1, 1 #8G | 3/4" C 1 1/2" C |
| 2FL | 70 100 3P | 35P-4 | 35P-4 45 KVA 150AT 225AF 35P-4B 30 KVA UPS LP-35E UPS (SCADA ROOM) | 35P-4 35P-4A 35P-4B 35P-4C | 3#4, 1 #8G 4 1/0, 1 #8G 4 1/0, 1 #8G 4 #1, 1 #8G | 1" C 1 1/2" C 1 1/2" C 1 1/2" C |

NOTES:
1. ELEVATOR 80A 3P CIRCUIT BREAKER SHALL HAVE A SHUNT TRIP.

MCC 35 - OPERATIONS CENTER (CONTINUED)

| PANEL NUMBER | EQUIPMENT IN MCC | CONDUIT NUMBER | EQUIPMENT REMOTE FROM MCC | CONDUIT SCHEDULE | | |
|--------------|--------------------------------------|----------------|---|--|--|--|
| | | | | CONDUIT NUMBER | CONDUCTOR QUANTITY \ SIZE | DIAMETER |
| 1CL | 40 100 3P | ACC02A | 35P-5 35P-5A 35P-5B 35P-5C 35C-5 35C-5A ACC01A ACC01B ACC03A ACC03B HVAC DDC SYSTEM LOCAL CONTROL UNIT TO F-502 VFD (BELOW) AHU-501 | 35P-5 35P-5A 35P-5B 35P-5C 35C-5 35C-5A ACC01A ACC01B ACC02A | 3#8, 1 #10G 3#8, 1 #10G 3#8, 1 #10G 3#8, 1 #10G 4#14 2#14 2#14 1#16 TPS 22#14 (INCLUDES SPARES) | 3/4" C 3/4" C 3/4" C 3/4" C 3/4" C 3/4" C 3/4" C 3/4" C 3/4" C |
| 2A | 15 100 3P SIZE 1 CPT HOA | 35PC-8 | 35PC-8 35P-6 30A, 3P 35P-6A 35C-6 35C-6A AHU-502 | 35PC-8 35P-6 35P-6A 35C-6 35C-6A | 3#12, 1 #12G 4#14 3#12, 1 #12G 3#12, 1 #12G 4#14 2#14 | 3/4" C 3/4" C 3/4" C 3/4" C 3/4" C |
| 2B | 15 100 3P SIZE 1 CPT HOA | 35PC-7 | 35PC-7 35P-7 30A, 3P 35P-7A 35C-7 35C-7A EXHAUST FAN F-501 | 35PC-7 35P-7 35P-7A 35C-7 35C-7A | 3#12, 1 #12G 4#14 3#12, 1 #12G 3#12, 1 #12G 4#14 2#14 | 3/4" C 3/4" C 3/4" C 3/4" C 3/4" C 3/4" C |
| 1CR | 30 100 3P | 35P-8 | 35P-8 35P-8A 35P-8B 35P-8C 35C-8 35C-8A ACC03A ACC03B FROM HVAC DDC SYSTEM LOCAL CONTROL UNIT (ABOVE) EXHAUST FAN F-502 | 35P-8 35P-8A 35P-8B 35P-8C 35C-8 35C-8A ACC03A ACC03B | 3#10, 1 #10G 3#12, 1 #12G 3#12, 1 #12G 3#12, 1 #12G 4#14 2#14 2#14 1#16 TPS | 3/4" C 3/4" C 3/4" C 3/4" C 3/4" C 3/4" C 3/4" C 3/4" C |
| 2C | 15 100 3P SIZE 1 CPT HOA | 35PC-9 | 35PC-9 35P-9 30A, 3P 35P-9A 35C-9 35C-9A 35C-9B 35C-9C 35C-9D LV-501B LV-502B COOLING THERMOSTAT EXHAUST FAN F-508 RECORD DRAWING | 35PC-9 35P-9 35P-9A 35C-9 35C-9A 35C-9B 35C-9C 35C-9D | 3#12, 1 #12G 4#14 3#12, 1 #12G 3#12, 1 #12G 4#14 2#14 4#14 4#14 4#14 2#14 | 3/4" C 3/4" C 3/4" C 3/4" C 3/4" C 3/4" C 3/4" C 3/4" C 3/4" C |

THIS DRAWING WAS PREPARED AT THE SCALE INDICATED IN THE TITLE BLOCK. INACCURACIES IN THE STATED SCALE MAY BE INTRODUCED WHEN DRAWINGS ARE REPRODUCED BY ANY MEANS. USE THE GRAPHIC SCALE BAR IN THE TITLE BLOCK TO DETERMINE THE ACTUAL SCALE OF THIS DRAWING.


03/23/01 086 CRV
0659E511.DWG

NOT TO SCALE

NO ALTERATIONS PERMITTED HEREON EXCEPT AS PROVIDED UNDER SECTION 7209 SUBDIVISION 2 OF THE NEW YORK STATE EDUCATION LAW

| No. | Date | Revisions | Init |
|-----|----------|---------------------|------|
| 0 | 4/20/01 | ISSUED FOR APPROVAL | JJC |
| 1 | | AS BID | |
| 2 | 10/31/05 | RECORD DRAWING | |

In charge of ___ TEL ___
Designed by ___ JJC ___
Drawn by ___ CRV ___
Checked by ___ WFH ___

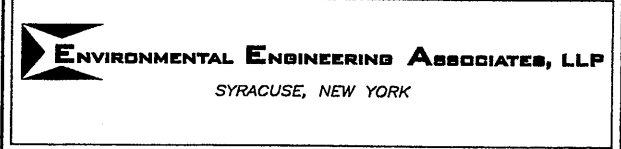

ONONDAGA COUNTY • DEPARTMENT OF DRAINAGE AND SANITATION • SYRACUSE, NEW YORK
METROPOLITAN SYRACUSE WASTEWATER TREATMENT PLANT
STAGE III AMMONIA AND STAGE II PHOSPHORUS REMOVAL PROJECT
OPERATIONS CENTER
MCC 35
ONE-LINE DIAGRAM
ELECTRICAL

File Number
00659

Date
APRIL 2001



E-511

MCC 35 - OPERATIONS CENTER (CONTINUED)

| PANEL NUMBER | EQUIPMENT IN MCC | CONDUIT NUMBER | EQUIPMENT REMOTE FROM MCC | CONDUIT SCHEDULE | | |
|----------------------------------|---------------------------------|----------------|--|--|--|----------|
| | | | | CONDUIT NUMBER | CONDUCTOR QUANTITY \ SIZE | DIAMETER |
| 2D | 15 100 3P SIZE 1 CPT, HOA | 35PC-10 | 35PC-10 JB, 35P-10 30A 3P, 35P-10A HP HOT WATER/GLYCOL PUMP P-504 | 35PC-10 35P-10 35P-10A 35C-10 | 3#12, 1#12G 2#14 | 3/4" C |
| 2E | 15 100 3P SIZE 1 CPT, HOA | 35PC-11 | 35PC-11 JB, 35P-11 30A 3P, 35P-11A HP HOT WATER/GLYCOL PUMP P-505 | 35PC-11 35P-11 35P-11A 35C-11 | 3#12, 1#12G 2#14 | 3/4" C |
| 3A | 25 100 3P SIZE 1 CPT, HOA | 35PC-12 | 35PC-12 JB, 35P-12 30A 3P, 35P-12A 10 HP CHILLED WATER/GLYCOL PUMP P-506 | 35PC-12 35P-12 35P-12A 35C-12 | 3#12, 1#12G 2#14 | 3/4" C |
| 3B | 25 100 3P SIZE 1 CPT, HOA | 35PC-13 | 35PC-13 JB, 35P-13 30A 3P, 35P-13A 10 HP CHILLED WATER/GLYCOL PUMP P-507 | 35PC-13 35P-13 35P-13A 35C-13 | 3#12, 1#12G 2#14 | 3/4" C |
| 3C | 150 225 3P | 35P-14 | 35P-14 100A 3P, 35P-14A CHILLER CONTROL PANEL CHILLER CH-501 | 35P-14 35P-14A | 3 1/0, 1#6G 3 1/0, 1#6G | 1 1/2" C |
| 3DL | 15 100 3P | 35P-15 | 35P-15 30A 3P, DOOR CONTROLS, 1/3 HP OPEN/CLOSE, 35C-15, 35C-15A PLANT MAINTENANCE DOOR OPERATOR | 35P-15 35P-15A 35C-15 35C-15A | 3#12, 1#12G 3#12, 1#12G 4#14 4#14 | 3/4" C |
| 3E 4A 4B 4C 4D 4E | 15 100 3P SIZE 1 CPT, HOA | | SPARE | | | |

MCC-35 OPERATIONS CENTER (CONTINUED)

| PANEL NUMBER | EQUIPMENT IN MCC | CONDUIT NUMBER | EQUIPMENT REMOTE FROM MCC | CONDUIT SCHEDULE | | |
|--------------------------|------------------|----------------|--|--|--|----------|
| | | | | CONDUIT NUMBER | CONDUCTOR QUANTITY \ SIZE | DIAMETER |
| 3DR | 15 100 3P | 35P-16 | 35P-16 30A 3P, 35P-16A DOOR CONTROLS, 1/3 HP OPEN/CLOSE, 35C-16, 35C-16A PARTS DOOR OPERATOR | 35P-16 35P-16A 35C-16 35C-16A | 3#12, 1#12G 3#12, 1#12G 4#14 4#14 | 3/4" C |
| 3FL 3FR 4FL 4FR | 20 100 3P | | SPARE | | | |
| 2FR | 20 100 3P | 35P-17 | 35P-17 30A 3P, 35P-17A PUMP CONTROLS, 3 CONDENSATE PUMPS | 35P-17 35P-17A | 3#12, 1#12G 3#12, 1#12G | 3/4" C |

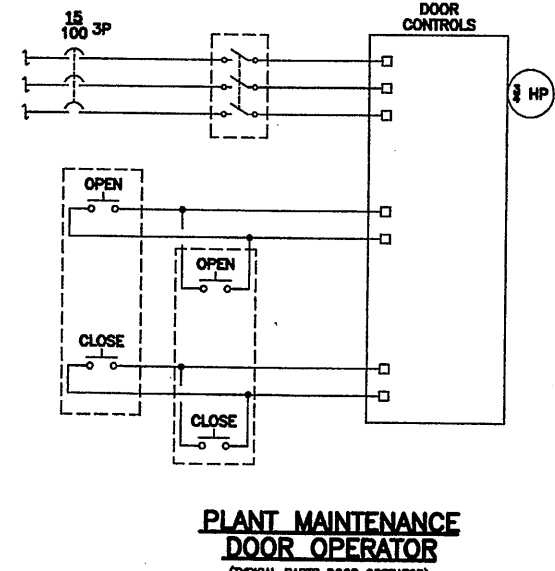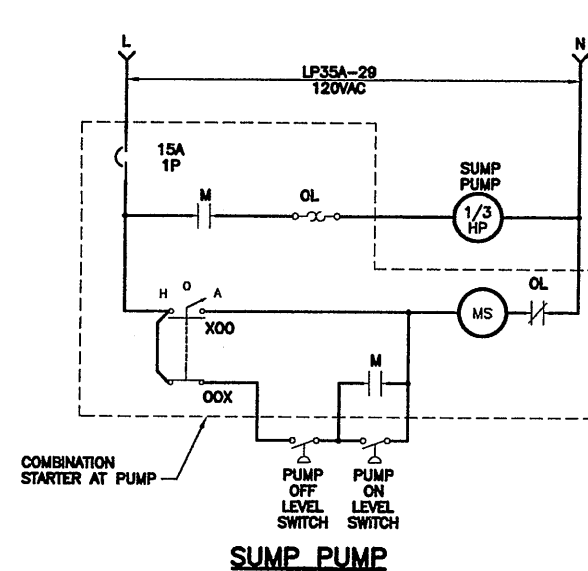

RECORD DRAWING
 THESE DRAWINGS HAVE BEEN REVIEWED TO REFLECT MAJOR CHANGES, IF ANY, WHICH OCCURRED DURING CONSTRUCTION. REVISIONS ARE BASED UPON INFORMATION SUPPLIED BY CONTRACTOR.
 DATE 10/21/05 FOR [Signature]

THIS DRAWING WAS PREPARED AT THE SCALE INDICATED IN THE TITLE BLOCK. INACCURACIES IN THE STATED SCALE MAY BE INTRODUCED WHEN DRAWINGS ARE REPRODUCED BY ANY MEANS. USE THE GRAPHIC SCALE BAR IN THE TITLE BLOCK TO DETERMINE THE ACTUAL SCALE OF THIS DRAWING.

03/23/01 086 CRV
0859E512

NOT TO SCALE

NO ALTERATIONS PERMITTED HEREON EXCEPT AS PROVIDED UNDER SECTION 7209 SUBDIVISION 2 OF THE NEW YORK STATE EDUCATION LAW

| No. | Date | Revisions | Init |
|-----|----------|---------------------|-------------|
| 0 | 4/20/01 | ISSUED FOR APPROVAL | [Signature] |
| 1 | | AS BID | |
| 2 | 10/31/05 | RECORD DRAWING | |

In charge of --- TEL ---
 Designed by --- JJC ---
 Drawn by --- CRV ---
 Checked by --- WEH ---

ENVIRONMENTAL ENGINEERING ASSOCIATES, LLP
 SYRACUSE, NEW YORK

ONONDAGA COUNTY • DEPARTMENT OF DRAINAGE AND SANITATION • SYRACUSE, NEW YORK
 METROPOLITAN SYRACUSE WASTEWATER TREATMENT PLANT
 STAGE III AMMONIA AND STAGE II PHOSPHORUS REMOVAL PROJECT
OPERATIONS CENTER
MCC 35
ONE-LINE DIAGRAM
 ELECTRICAL


FILE NUMBER
00659

DATE
APRIL 2001

E-512


[Professional Engineer Seal]

SEE MCC O&M MANUAL FOR
EQUIPMENT ELEMENTARY DIAGRAM

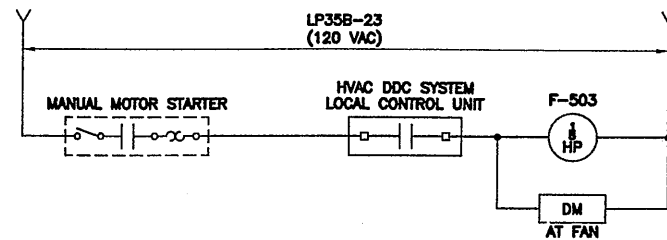


F-503
NOT TO SCALE

TYPICAL: F-504 WITH LP35B-24 AND 1/2 HP MOTOR
F-505 WITH LP35B-25 AND 1/2 HP MOTOR
F-506 WITH LP35B-26 AND 1/2 HP MOTOR
F-507 WITH LP35B-27 AND 1/2 HP MOTOR
F-508 WITH LP35C-23 AND 20 HP MOTOR

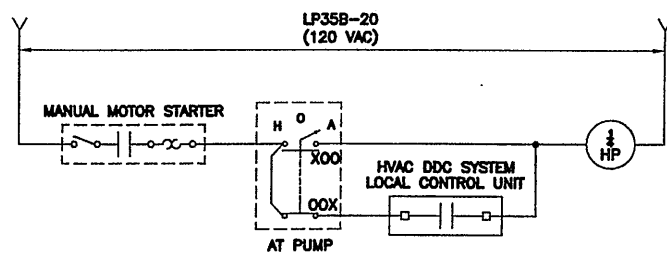

P-501
NOT TO SCALE

TYPICAL: P-502 WITH LP35B-21
P-503 WITH LP35B-22

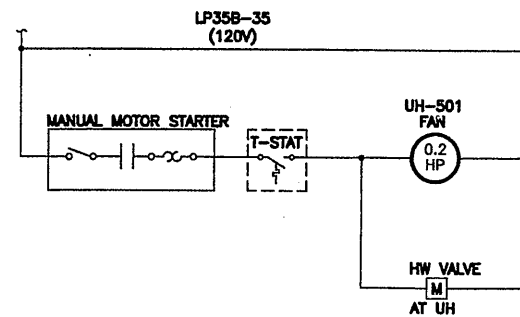

RECORD DRAWING

THESE DRAWINGS HAVE BEEN REVISIONED TO REFLECT
MAJOR CHANGES, IF ANY, WHICH OCCURRED DURING
CONSTRUCTION. REVISIONS ARE BASED UPON
INFORMATION SUPPLIED BY CONTRACTOR.
DATE: 10/10/05 PER: [Signature]

THIS DRAWING WAS PREPARED AT THE SCALE INDICATED IN THE
TITLE BLOCK. INACCURACIES IN THE STATED SCALE MAY BE
INTRODUCED WHEN DRAWINGS ARE REPRODUCED BY ANY MEANS.
USE THE GRAPHIC SCALE BAR IN THE TITLE BLOCK TO
DETERMINE THE ACTUAL SCALE OF THIS DRAWING.

03/23/01 OBG CRV
0659E513

NOT TO SCALE

| No. | Date | Revisions | Init |
|-----|----------|---------------------|-------------|
| 0 | 4/20/01 | ISSUED FOR APPROVAL | [Signature] |
| 1 | | AS BID | |
| 2 | 10/31/05 | RECORD DRAWING | |

In charge of: TEL
Designed by: JJC
Drawn by: CRV
Checked by: WFH

ENVIRONMENTAL ENGINEERING ASSOCIATES, LLP
SYRACUSE, NEW YORK

ONONDAGA COUNTY • DEPARTMENT OF DRAINAGE AND SANITATION • SYRACUSE, NEW YORK
METROPOLITAN SYRACUSE WASTEWATER TREATMENT PLANT
STAGE III AMMONIA AND STAGE II PHOSPHORUS REMOVAL PROJECT
**OPERATIONS CENTER
ELEMENTARY DIAGRAMS**



File Number
00659
Date
APRIL 2001
[Signature]

E-513

ELECTRICAL

NO ALTERATIONS PERMITTED HEREON EXCEPT
AS PROVIDED UNDER SECTION 7209 SUBDIVISION
2 OF THE NEW YORK STATE EDUCATION LAW

| CIRCUIT BREAKER PANELBOARD LP35A SCHEDULE | | | | | | | | | | | | |
|---|-----------------------------|---------------|--|-------|-------|-------|---------------|--------|-----------|-----------------|----------------------------------|---------|
| LOCATION: | | | OPERATIONS CENTER -- FIRST FLOOR--HALL | | | | FEED FROM | | | MCC 35, 1B | | |
| MAIN BUS RATING: | | | 225 AMPERES | | | | 208/120 VOLTS | | | 3 PHASE, 4 WIRE | | |
| MINIMUM SHORTCIRCUIT: | | | 10,000 AMPERES | | | | FEEDER CABLE | | | 4 #1, 1 #8 GRD | | |
| MAIN BREAKER TRIP: | | | 100 AMPERES | | | | FLUSH MTD | | | | | |
| ESTIMATED CONNECTED LOAD: | | | 20.058 KVA | | | | | | | | | |
| CKT NO. | DESCRIPTION | CB AMPS/POLES | LOAD TYPE | KVA | PH-A | PH-B | PH-C | KVA | LOAD TYPE | CB AMPS/POLES | DESCRIPTION | CKT NO. |
| 1 | LOBBY, VEST, HALL LIGHTS | 20/1P | LIGHTS | 1.330 | 1.990 | | | 0.680 | LIGHTS | 20/1P | STAIR #1 LIGHTS | 2 |
| 3 | STAIR #2 LIGHTS | 20/1P | LIGHTS | 0.420 | | 1.260 | | 0.840 | LIGHTS | 20/1P | LOBBY LIGHTS | 4 |
| 5 | I/E LIGHTS | 20/1P | LIGHTS | 0.490 | | | 0.980 | 0.490 | LIGHTS | 20/1P | MEN, WOMEN, OFF. LIGHTS | 6 |
| 7 | PARTS, SPRINKLER LIGHTS | 20/1P | LIGHTS | 0.560 | 1.820 | | | 1.260 | LIGHTS | 20/1P | PLANT MAINT. LIGHTS | 8 |
| 9 | LOBBY RECPTS | 20/1P | RECPTS | 0.540 | | 1.260 | | 0.720 | RECPTS | 20/1P | LOBBY, STAIR #2 RECPTS | 10 |
| 11 | I/E RECPTS | 20/1P | RECPTS | 0.900 | | | 1.440 | 0.540 | RECPTS | 20/1P | I/E RECPTS | 12 |
| 13 | I/E RECPTS | 20/1P | RECPTS | 0.360 | 1.820 | | | 1.260 | RECPTS | 20/1P | HALL, MEN, WOMEN, STAIR #1 RECPT | 14 |
| 15 | PARTS, SPRINKLER RECPTS | 20/1P | RECPTS | 1.080 | | 1.800 | | 0.720 | RECPTS | 20/1P | OFFICE RECPTS | 16 |
| 17 | PREA. SPKR SYS. CONT. PANEL | 20/1P | CONTROLS | 0.100 | | | 0.950 | 0.850 | LIGHTS | 20/1P | EXTERIOR LIGHTS | 18 |
| 19 | ELEVATOR CONTROLLER | 20/1P | CONTROLS | 0.500 | 0.750 | | | 0.250 | LT/RECPT | 20/1P | ELEV. LIGHT/RECPT | 20 |
| 21 | ELEV. RM. LIGHTS/RECPT | 20/1P | LTS/RECPT | 0.320 | | 1.496 | | 1.176 | MOTOR | 20/1P | | 22 |
| 23 | VAV-501 | 20/1P | MTR/CTRLS | 0.864 | | | 2.040 | 0.500 | MOTOR | 20/1P | AIR COMPRESSOR | 24 |
| 25 | VAV-508 | 20/1P | MTR/CTRLS | 0.300 | 0.800 | | | 0.500 | MOTOR | 20/1P | VAV 502 | 26 |
| 27 | I/E RECPTS | 20/1P | RECPTS | 0.360 | | 0.888 | | 0.528 | MOTOR | 20/1P | WATER COOLER RECEPT | 28 |
| 29 | SUMP PUMP ALARM | 20/1P | MOTOR | 0.864 | | | 0.964 | 0.100 | CONTROLS | 20/1P | SUMP ALARM | 30 |
| 31 | SUMP PUMP | 20/1P | | | 0.000 | | | | | 20/1P | SPARE | 32 |
| 33 | SPARE | 20/1P | | | | 0.000 | | | | 20/1P | SPARE | 34 |
| 35 | SPARE | 20/1P | | | | | 0.000 | | | 20/1P | SPARE | 36 |
| 37 | SPARE | 20/1P | | | | | | | | 20/1P | SPARE | 38 |
| 39 | SPARE | 20/1P | | | | | | | | 20/1P | SPARE | 40 |
| 41 | SPARE | 20/1P | | | | | | | | 20/1P | SPARE | 42 |
| LOAD SUMMARY | | | | 8.988 | 6.980 | 6.704 | 6.374 | 11.070 | | | | |

NOTE:
1. ALL CONDUCTORS TO BE 2 #12, 1 #12G IN 3/4 INCH CONDUIT UNLESS OTHERWISE INDICATED.

| CIRCUIT BREAKER PANELBOARD LP35C SCHEDULE | | | | | | | | | | | | |
|---|-----------------------------------|---------------|--|--------|-------|-------|---------------|-------|-------------|-----------------|---------------------------------|---------|
| LOCATION: | | | OPERATIONS CENTER -- THIRD FLOOR--OFFICE | | | | FEED FROM | | | MCC 35, 1B | | |
| MAIN BUS RATING: | | | 225 AMPERES | | | | 208/120 VOLTS | | | 3 PHASE, 4 WIRE | | |
| MINIMUM SHORTCIRCUIT: | | | 10,000 AMPERES | | | | FEEDER CABLE | | | 4 #1, 1 #8 GRD | | |
| MAIN BREAKER TRIP: | | | 100 AMPERES | | | | FLUSH MTD | | | | | |
| ESTIMATED CONNECTED LOAD: | | | 20.947 KVA | | | | | | | | | |
| CKT NO. | DESCRIPTION | CB AMPS/POLES | LOAD TYPE | KVA | PH-A | PH-B | PH-C | KVA | LOAD TYPE | CB AMPS/POLES | DESCRIPTION | CKT NO. |
| 1 | LOBBY, HALL, CONT. LOBBY LIGHTS | 20/1P | LIGHTS | 0.680 | 0.820 | | | 0.140 | LIGHTS | 20/1P | MEN, WOMEN LIGHTS | 2 |
| 3 | LOBBY LIGHTS | 20/1P | LIGHTS | 1.100 | | 2.115 | | 1.016 | LIGHTS | 20/1P | LAB, OFFICE LIGHTS | 4 |
| 5 | PRESENTATION RM LIGHTS | 20/1P | LIGHTS | 1.120 | | | 2.255 | 1.135 | LIGHTS | 20/1P | PRES. RM., STORAGE LIGHTS | 6 |
| 7 | PRES. RM TRACK LIGHTING | 20/1P | LIGHTS | 0.750 | 1.280 | | | 0.540 | RECPTS | 20/1P | STORAGE RECPTS | 8 |
| 9 | PRESENTATION RM RECPTS | 20/1P | RECPTS | 0.540 | | 0.785 | | 0.245 | LIGHTS | 20/1P | SUP. FILES, BATH LIGHTS | 10 |
| 11 | MEN, WOMEN, STAIR #2 RECPTS | 20/1P | RECPTS | 0.540 | | | 1.440 | 0.900 | RECPTS | 20/1P | LOBBY RECPTS | 12 |
| 13 | WATER COOLER RECPT | 20/1P | RECPTS | 0.528 | 1.428 | | | 0.900 | RECPTS | 20/1P | LAB RECPTS | 14 |
| 15 | FUME HOOD | 20/1P | RECPTS | 0.540 | | 1.440 | | 0.900 | RECPTS | 20/1P | LAB RECPTS | 16 |
| 17 | PRESENTATION RM. RECPTS | 20/1P | RECPTS | 1.080 | | | 1.820 | 0.540 | RECPTS | 20/1P | STOR., HALL, CONT., LOBBY RECPT | 18 |
| 19 | SUP. FILES, BATH, STAIR #1 RECPTS | 20/1P | RECPTS | 0.900 | 1.440 | | | 0.540 | RECPTS | 20/1P | OFFICE RECPTS | 20 |
| 21 | OFFICE RECPTS | 20/1P | RECPTS | 0.720 | | 0.770 | | 0.050 | CONTROLS | 20/1P | KEY BOX | 22 |
| 23 | F-509 | 20/1P | MOTOR | 0.076 | | | 0.772 | 0.696 | MTR/CONTRLS | 20/1P | VAV-515 | 24 |
| 25 | SPARE | 25/1P | MTR/CONTRLS | 1.656 | 2.352 | | | 0.696 | MTR/CONTRLS | 20/1P | VAV-520 | 26 |
| 27 | VAV 514, 516, 517, 519, 521 | 20/1P | MISC. | 0.500 | | 1.460 | | 0.980 | MISC | 20/1P | UNIT KITCHEN | 28 |
| 29 | UNIT KITCHEN | 20/1P | MISC. | 0.960 | | 0.960 | | | | 20/1P | VAV 518A | 30 |
| 31 | VAV 518B | 20/1P | | | 0.000 | | | | | 20/1P | SCREEN | 32 |
| 33 | SPARE | 20/1P | | | | 0.000 | | | | 20/1P | REFRIGERATOR | 34 |
| 35 | SPARE | 20/1P | | | | | 0.000 | | | 20/1P | HOT WATER HEATER | 36 |
| 37 | SPARE | 20/1P | | | | | | | | 20/1P | MICROWAVE | 38 |
| 39 | TIME CLOCK | 20/1P | | | | | | | | 20/1P | SPARE | 40 |
| 41 | SPARE | 20/1P | | | | | | | | 20/1P | SPARE | 42 |
| LOAD SUMMARY | | | | 11.690 | 7.330 | 6.570 | 7.047 | 9.257 | | | | |

NOTE:
1. ALL CONDUCTORS TO BE 2 #12, 1 #12G IN 3/4 INCH CONDUIT EXCEPT CKT. NO. 25. CKT NO. 25 SHALL BE 2#10, 1#10G IN 3/4 INCH CONDUIT.

| CIRCUIT BREAKER PANELBOARD LP35B SCHEDULE | | | | | | | | | | | | |
|---|---------------------------|---------------|---|--------|-------|-------|---------------|-------|-------------|-----------------|-------------------------|---------|
| LOCATION: | | | OPERATIONS CENTER -- SECOND FLOOR--ELEC/MECH ROOM | | | | FEED FROM | | | MCC 35, 1B | | |
| MAIN BUS RATING: | | | 225 AMPERES | | | | 208/120 VOLTS | | | 3 PHASE, 4 WIRE | | |
| MINIMUM SHORTCIRCUIT: | | | 10,000 AMPERES | | | | FEEDER CABLE | | | 4 #1, 1 #8 GRD | | |
| MAIN BREAKER TRIP: | | | 100 AMPERES | | | | SURFACE MTD | | | | | |
| ESTIMATED CONNECTED LOAD: | | | 19.886 KVA | | | | | | | | | |
| CKT NO. | DESCRIPTION | CB AMPS/POLES | LOAD TYPE | KVA | PH-A | PH-B | PH-C | KVA | LOAD TYPE | CB AMPS/POLES | DESCRIPTION | CKT NO. |
| 1 | LOBBY, HALL LIGHTS | 20/1P | LIGHTS | 0.630 | 1.120 | | | 0.490 | LIGHTS | 20/1P | EMP. TRAINING LIGHTS | 2 |
| 3 | LOBBY LIGHTS | 20/1P | LIGHTS | 0.680 | | 1.140 | | 0.480 | LIGHTS | 20/1P | WOMEN LKR, SHWR. LIGHTS | 4 |
| 5 | EMP LUNCH RM, KIT. LIGHTS | 20/1P | LIGHTS | 0.670 | | | 1.920 | 1.050 | LIGHTS | 20/1P | ELEC/MECH. RM LIGHTS | 6 |
| 7 | MEN LKR, SHWR LIGHTS | 20/1P | LIGHTS | 0.640 | 1.680 | | | 0.720 | RECPTS | 20/1P | EMP. TRAINING RECPTS | 8 |
| 9 | LOBBY, STAIR #2 RECPTS | 20/1P | RECPTS | 0.600 | | 1.820 | | 0.720 | RECPTS | 20/1P | WOMEN, HALL RECPT | 10 |
| 11 | KITCHEN RECPTS | 20/1P | RECPTS | 0.540 | | | 0.720 | 0.180 | RECPTS | 20/1P | KIT. REFRIG. RECPT | 12 |
| 13 | KITCHEN VENDING RECPT | 20/1P | RECPTS | 0.180 | 0.360 | | | 0.180 | RECPTS | 20/1P | KIT. VENDING RECPT | 14 |
| 15 | KITCHEN VENDING RECPT | 20/1P | RECPTS | 0.180 | | 0.900 | | 0.720 | RECPTS | 20/1P | EMP. LUNCH RM. RECPTS | 16 |
| 17 | ELEC./MECH. RECPTS | 20/1P | RECPTS | 0.720 | | | 1.260 | 0.540 | RECPTS | 20/1P | ELEC/MECH RECPTS | 18 |
| 19 | MEN, STAIR #1 RECPTS | 20/1P | RECPTS | 0.720 | 1.416 | | | 0.696 | MOTOR | 20/1P | P-501 | 20 |
| 21 | P-502 | 20/1P | MOTOR | 0.696 | | 1.392 | | 0.696 | MOTOR | 20/1P | P-503 | 22 |
| 23 | F-503 | 20/1P | MOTOR | 0.140 | | | 0.240 | 0.100 | MOTOR | 20/1P | F-504 | 24 |
| 25 | F-505 | 20/1P | MOTOR | 0.696 | 0.636 | | | 0.140 | MOTOR | 20/1P | F-506 | 26 |
| 27 | F-507 | 20/1P | MOTOR | 0.130 | | 0.994 | | 0.884 | MTR/CONTRLS | 20/1P | VAV-509 | 28 |
| 29 | VAV-510 | 20/1P | MTR/CTRLS | 0.300 | | | 1.956 | 1.656 | MTR/CONTRLS | 25/1P | VAV-512A | 30 |
| 31 | LOCAL CONTROL UNIT | 20/1P | CONTROLS | 0.500 | 1.028 | | | 0.528 | MOTOR | 20/1P | WATER COOLER RECEPT | 32 |
| 33 | HW CIRC PUMP | 20/1P | MOTOR | 0.528 | | 0.828 | | 0.100 | CONTROLS | 20/1P | LOCAL CONTROL UNIT | 34 |
| 35 | UH-501 | 20/1P | MOTOR | 0.696 | | | 0.696 | | | 20/1P | | 36 |
| 37 | VAV 512B | 20/1P | | | | | | | CONTROL | 20/1P | HX-501 | 38 |
| 39 | COOKTOP | 40/2P | | | | | | | | 20/1P | | 40 |
| 41 | | | | | | | | | | 20/1P | SPARE | 42 |
| LOAD SUMMARY | | | | 10.026 | 6.420 | 6.674 | 6.792 | 9.860 | | | | |

NOTE:
1. ALL CONDUCTORS TO BE 2 #12, 1 #12G IN 3/4 INCH CONDUIT EXCEPT CKT. NO. 30. CKT NO. 30 SHALL BE 2#10, 1#10G IN 3/4 INCH CONDUIT.

| CIRCUIT BREAKER PANELBOARD LP35D SCHEDULE | | | | | | | | | | | | |
|---|-----------------|---------------|---|-------|-------|-------|---------------|-------|-----------|-----------------|-------------|---------|
| LOCATION: | | | OPERATIONS CENTER -- FIRST FLOOR--PLANT MAINTENANCE | | | | FEED FROM | | | MCC 35, 1 AR | | |
| MAIN BUS RATING: | | | 225 AMPERES | | | | 208/120 VOLTS | | | 3 PHASE, 4 WIRE | | |
| MINIMUM SHORTCIRCUIT: | | | 10,000 AMPERES | | | | FEEDER CABLE | | | 4 #1, 1 #8 GRD | | |
| MAIN BREAKER TRIP: | | | 100 AMPERES | | | | SURFACE MTD | | | | | |
| ESTIMATED CONNECTED LOAD: | | | 2.180 KVA | | | | | | | | | |
| CKT NO. | DESCRIPTION | CB AMPS/POLES | LOAD TYPE | KVA | PH-A | PH-B | PH-C | KVA | LOAD TYPE | CB AMPS/POLES | DESCRIPTION | CKT NO. |
| 1 | RECPTS | 20/1P | RECPTS | 0.360 | 0.720 | | | 0.360 | RECPTS | 20/1P | RECPTS | 2 |
| 3 | RECPTS | 20/1P | RECPTS | 0.360 | | 0.720 | | 0.360 | RECPTS | 20/1P | RECPTS | 4 |
| 5 | RECPTS | 20/1P | RECPTS | 0.360 | | | 0.720 | 0.360 | RECPTS | 20/1P | RECPTS | 6 |
| 7 | O.H. DOOR ALARM | 20/1P | | | 0.000 | | | | | 20/1P | SPARE | 8 |
| 9 | SPARE | 20/1P | | | | 0.000 | | | | 20/1P | SPARE | 10 |
| 11 | SPARE | 20/1P | | | | | 0.000 | | | 20/1P | SPARE | 12 |
| 13 | SPACE | | | | 0.000 | | | | | | SPACE | 14 |
| 15 | SPACE | | | | | 0.000 | | | | | SPACE | 16 |
| 17 | SPACE | | | | | | 0.000 | | | | SPACE | 18 |
| 19 | SPACE | | | | 0.000 | | | | | | SPACE | 20 |
| 21 | SPACE | | | | | 0.000 | | | | | SPACE | 22 |
| 23 | SPACE | | | | | | 0.000 | | | | SPACE | 24 |
| 25 | SPACE | | | | 0.000 | | | | | | SPACE | 26 |
| 27 | SPACE | | | | | 0.000 | | | | | SPACE | 28 |
| 29 | SPACE | | | | | | 0.000 | | | | SPACE | 30 |
| 31 | SPACE | | | | 0.000 | | | | | | SPACE | 32 |
| 33 | SPACE | | | | | 0.000 | | | | | SPACE | 34 |
| 35 | SPACE | | | | | | 0.000 | | | | SPACE | 36 |
| 37 | SPACE | | | | | | | 0.000 | | | SPACE | 38 |
| 39 | SPACE | | | | | | | | | | SPACE | 40 |
| 41 | SPACE | | | | | | | | | | SPACE | 42 |
| LOAD SUMMARY | | | | 1.080 | 0.720 | 0.720 | 0.720 | 1.080 | | | | |


NOTE:
1. ALL CONDUCTORS TO BE 2 #12, 1 #12G IN 3/4 INCH CONDUIT UNLESS OTHERWISE INDICATED.

| CIRCUIT BREAKER PANELBOARD LP35E SCHEDULE | | | | | | | | | | | | |
|---|--------------------------|--|-----------|-------|-------|-------|-------|---------------|-----------|-----------------|---------------------------|---------|
| LOCATION: | | OPERATIONS CENTER - THIRD FLOOR SCADA ROOM | | | | | | FEED FROM | | MCC 35, 2FL | | |
| MAIN BUS RATING: | | 225 AMPERES | | | | | | 208/120 VOLTS | | 3 PHASE, 4 WIRE | | |
| MINIMUM SHORTCIRCUIT: | | 10,000 AMPERES | | | | | | FEEDER CABLE | | 4 #1, 1 #8 GRD | | |
| MAIN BREAKER TRIP: | | 100 AMPERES | | | | | | FLUSH MTD | | | | |
| ESTIMATED CONNECTED LOAD: | | 9.380 KVA | | | | | | | | | | |
| CKT NO. | DESCRIPTION | CB AMPS/POLES | LOAD TYPE | KVA | PH-A | PH-B | PH-C | KVA | LOAD TYPE | CB AMPS/POLES | DESCRIPTION | CKT NO. |
| 1 | SCADA RM LIGHTS | 20/1P | LIGHTS | 0.580 | 1.400 | | | 0.840 | LIGHTS | 20/1P | CONTROL RM LIGHTS | 2 |
| 3 | CONTROL RM LIGHTS | 20/1P | LIGHTS | 0.360 | | 1.280 | | 0.900 | RECPTS | 20/1P | SCADA RM RECPTS | 4 |
| 5 | SCADA RM FLR RECPT | 20/1P | RECPT | 0.180 | | | 0.360 | 0.180 | RECPT | 20/1P | SCADA RM FLR RECPT | 6 |
| 7 | SCADA RM FLR RECPT | 20/1P | RECPT | 0.180 | 0.360 | | | 0.180 | RECPT | 20/1P | SCADA RM FLR RECPT | 8 |
| 9 | SCADA RM RECPTS | 20/1P | RECPTS | 0.360 | | 1.280 | | 0.900 | RECPTS | 20/1P | CONTROL RM RECPTS | 10 |
| 11 | CONTROL RM RECPTS | 20/1P | RECPTS | 0.900 | | | 1.800 | 0.900 | RECPTS | 20/1P | CONTROL RM RECPTS | 12 |
| 13 | CONTROL RM RECPTS | 20/1P | RECPTS | 0.900 | 1.820 | | | 0.720 | RECPTS | 20/1P | CONTROL RM FLR RECPTS | 14 |
| 15 | FIRE ALARM CONTROL PANEL | 20/1P | CONTROLS | 0.720 | | 0.820 | | 0.100 | CONTROLS | 20/1P | CCTV F.O. INTERFACE PANEL | 16 |
| 17 | LOCAL CONTROL UNIT | 20/1P | CONTROLS | 0.500 | | | 0.000 | | | 20/1P | DDC CONTROLLER | 18 |
| 19 | SPARE | 20/1P | | | 0.000 | | | | | 20/1P | SPARE | 20 |
| 21 | SPARE | 20/1P | | | | 0.000 | | | | 20/1P | SPARE | 22 |
| 23 | SPARE | 20/1P | | | | | 0.000 | | | 20/1P | SPARE | 24 |
| 25 | SPARE | 20/1P | | | 0.000 | | | | | 20/1P | SPARE | 26 |
| 27 | SPARE | 20/1P | | | | 0.00 | | | | 20/1P | SPARE | 28 |
| 29 | SPARE | 20/1P | | | | | 0.00 | | | 20/1P | SPARE | 30 |
| 31 | SPACE | | | | 0.00 | | | | | | SPACE | 32 |
| 33 | SPACE | | | | | 0.000 | | | | | SPACE | 34 |
| 35 | SPACE | | | | | | 0.000 | | | | SPACE | 36 |
| 37 | SPACE | | | | | | | 0.000 | | | SPACE | 38 |
| 39 | SPACE | | | | | | | | | | SPACE | 40 |
| 41 | SPACE | | | | | | | | | | SPACE | 42 |
| LOAD SUMMARY | | | | 4.660 | 3.38 | 3.340 | 2.16 | 4.720 | | | | |

NOTE:
1. ALL CONDUCTORS TO BE 2 #12, 1 #12G IN 3/4 INCH CONDUIT UNLESS OTHERWISE INDICATED.

OPERATIONS CENTER CONDUIT SCHEDULE

| CKT NO. | CONDUIT SIZE | NO. & SIZE CONDUCTORS | FROM | TO |
|---------|--------------|-----------------------|---|--|
| CC-1 | 1" | MANUFACTURER'S CABLES | FIRE ALARM CONTROL PANEL | FIRE ALARM SYSTEM AUXILIARY CABINET |
| CC-2 | 3/4" | 20#14 | FIRE ALARM SYS. AUXILIARY CABINET | HVAC DDC SYSTEM LOCAL CONTROL UNIT |
| CC-3 | 3/4" | 10#14 | FIRE ALARM SYS. AUXILIARY CABINET | ELEVATOR CONTROLLER |
| CC-4 | 3/4" | 6#14 | PREACTION SPRINKLER SYSTEM CONTROL PANEL | PREACTION SPRINKLER SYSTEM SOLENOID VALVE, PRESSURE SW & FLOW SW |
| CC-5 | 3/4" | 2#14 | SPRINKLER SYS. AIR COMPRESSOR | PRESSURE SWITCH |
| CC-6 | 3/4" | 4#14 | EXISTING RELOCATED KEY BOX | PLC M16 |
| CC-7 | 1" | MANUFACTURER'S CABLES | FIRE ALARM CONTROL PANEL | FIRE ALARM ANNUNCIATOR PANEL |
| CC-8 | 3/4" | 4#18 | PRESENTATION ROOM WIRELESS MICROPHONE AMPLIFIER | COLUMN SPEAKERS |
| CC-9 | 3/4" | 1 COAXIAL CABLE | STORAGE ROOM COAX CABLE CONNECTOR | PRESENTATION ROOM COAX CABLE CONNECTOR |
| CC-10 | 3/4" | 1 3/C #18 SHIELDED | NORTH ENTRANCE GATE INTERCOM | CONTROL ROOM INTERCOM |
| CC-11 | 3/4" | 2-#14 | PREACTION SPRINKLER SYSTEM CONTROL PANEL | ALARM BELL |
| CC-12 | 3/4" | 2-#14 | PLANT MAINTENANCE EWS | PLC M16 |
| CC-13 | 3/4" | 2-#14 | LAB EWS | PLC M16 |
| CC-14 | 3/4" | 2-#12 | SUMP ALARM LEVEL SWITCH | SUMP ALARM |

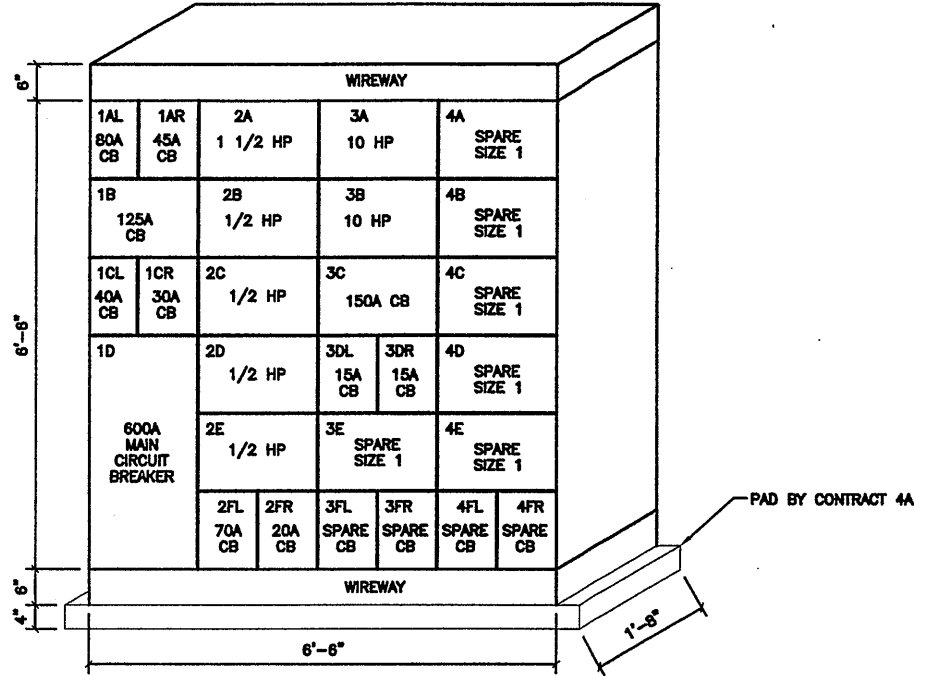

MCC 35 ELEVATION
NOT TO SCALE
(SEE DRAWINGS E-511 & E-512)

04/25/01 OBG CRV
0659E515

| | | | | |
|--------------|-----|---------|---------------------|------|
| NOT TO SCALE | No. | Date | Revisions | Init |
| | 0 | 4/20/01 | ISSUED FOR APPROVAL | LC |
| | 1 | | AS BID | |
| | 2 | 0/31/05 | RECORD DRAWING | |

In charge of ___ TEL ___
Designed by ___ JJC ___
Drawn by ___ CRV ___
Checked by ___ WFH ___



ONONDAGA COUNTY • DEPARTMENT OF DRAINAGE AND SANITATION • SYRACUSE, NEW YORK
METROPOLITAN SYRACUSE WASTEWATER TREATMENT PLANT
STAGE III AMMONIA AND STAGE II PHOSPHORUS REMOVAL PROJECT

OPERATIONS CENTER
SCHEDULES & DETAILS

ELECTRICAL

RECORD DRAWING
THESE DRAWINGS HAVE BEEN REVISED TO REFLECT MAJOR CHANGES, IF ANY, WHICH OCCURRED DURING CONSTRUCTION. REVISIONS ARE BASED UPON INFORMATION SUPPLIED BY CONTRACTOR.
DATE: 10/2/05 PER: K. Rampert

THIS DRAWING WAS PREPARED AT THE SCALE INDICATED IN THE TITLE BLOCK. INACCURACIES IN THE STATED SCALE MAY BE INTRODUCED WHEN DRAWINGS ARE REPRODUCED BY ANY MEANS. USE THE GRAPHIC SCALE BAR IN THE TITLE BLOCK TO DETERMINE THE ACTUAL SCALE OF THIS DRAWING.

File Number
00659
Date
APRIL 2001
E-515

NOTES:

1. SEE DRAWING E-701 FOR DUCT SMOKE DETECTOR ADDITIONS TO EXISTING FIRE ALARM SYSTEMS.
2. SEE MCC #34 AND MCC#38 ONE-LINE DIAGRAMS AND ELEMENTARY DIAGRAMMS FOR DUCT SMOKE DETECTOR CONNECTIONS TO AHU-201 AND AHU-301.
3. SEE FIRE ALARM SYSTEM O&M MANUAL FOR SYSTEM SCHEMATIC.

RECORD DRAWING

THESE CHANGES HAVE BEEN REQUIRED TO REFLECT
 MAKE CHANGES IF ANY, WHICH OCCURRED DURING
 CONSTRUCTION. REVISIONS ARE BASED UPON
 INFORMATION SUPPLIED BY CONTRACTOR.

DATE 10/21/05 PER *Kampdet*

THIS DRAWING WAS PREPARED AT THE SCALE INDICATED IN THE
 TITLE BLOCK. INACCURACIES IN THE STATED SCALE MAY BE
 INTRODUCED WHEN DRAWINGS ARE REPRODUCED BY ANY MEANS.
 USE THE GRAPHIC SCALE BAR IN THE TITLE BLOCK TO
 DETERMINE THE ACTUAL SCALE OF THIS DRAWING.

4/23/01 OBG CRV
 0569E601

NOT TO SCALE

NO ALTERATIONS PERMITTED HEREON EXCEPT
 AS PROVIDED UNDER SECTION 7209 SUBDIVISION
 2 OF THE NEW YORK STATE EDUCATION LAW

| No. | Date | Revisions | Init |
|-----|----------|---------------------|------------|
| 0 | 4/20/01 | ISSUED FOR APPROVAL | <i>LJR</i> |
| 1 | | AS BID | |
| 2 | 10/31/05 | RECORD DRAWING | |

In charge of TEL
 Designed by JJC
 Drawn by CRV
 Checked by WFH



ONONDAGA COUNTY • DEPARTMENT OF DRAINAGE AND SANITATION • SYRACUSE, NEW YORK
 METROPOLITAN SYRACUSE WASTEWATER TREATMENT PLANT
 STAGE III AMMONIA AND STAGE II PHOSPHORUS REMOVAL PROJECT

FIRE ALARM SYSTEM SCHEMATIC

ELECTRICAL



File Number
 00659

Date
 APRIL 2001

Kampdet

E-601

NOTES:

1. HEAT DETECTORS IN THE CONTROL ROOM, SCADA ROOM, CONTROL ROOM UNDERFLOOR SPACE AND SCADA ROOM UNDERFLOOR SPACE SHALL BE CONNECTED SUCH THAT BOTH DETECTORS IN AN AREA MUST ACTUATE TO ENABLE OPERATION OF THE PREACTION SPRINKLER SYSTEM. THE CONTROL ROOM EMERGENCY MANUAL RELEASE (EMR) SHALL ENABLE OPERATION OF THE PREACTION SPRINKLER SYSTEM INDEPENDANT OF HEAT DETECTOR OPERATION.
2. SEE FIRE PROTECTION DRAWINGS FOR ADDITIONAL DETAILS ON SPRINKLER SYSTEM/FIRE ALARM SYSTEM INTERFACES.
3. SEE MCC #35 ONE-LINE DIAGRAM AND ELEMENTARY DIAGRAMS FOR DUCT SMOKE DETECTOR CONNECTIONS TO AHU-501, AHU-502 & F-502.
4. WET SPRINKLER SYSTEM, DRY SPRINKLER SYSTEM AND PREACTION SPRINKLER SYSTEM DEVICES (INCLUDING POST INDICATOR VALVE TAMPER SWITCH, ALARM BELL, CONTROL ROOM DETECTORS, SCADA ROOM DETECTORS, CONTROL ROOM UNDERFLOOR SPACE DETECTORS, SCADA ROOM UNDERFLOOR SPACE DETECTORS, AND EMR) SHALL BE FURNISHED AND INSTALLED BY CONTRACT 4D, CONNECTED BY CONTRACT 4B.
5. SEE FIRE ALARM SYSTEM O&M MANUAL FOR SYSTEM SCHEMATIC.



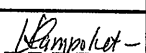
RECORD DRAWING

THESE DRAWINGS HAVE BEEN REVISIONED TO REFLECT MAJOR CHANGES, IF ANY, WHICH OCCURRED DURING CONSTRUCTION. REVISIONS ARE BASED UPON INFORMATION SUPPLIED BY CONTRACTOR.

DATE: 10/21/01 PER: [Signature]

THIS DRAWING WAS PREPARED AT THE SCALE INDICATED IN THE TITLE BLOCK. INACCURACIES IN THE STATED SCALE MAY BE INTRODUCED WHEN DRAWINGS ARE REPRODUCED BY ANY MEANS. USE THE GRAPHIC SCALE BAR IN THE TITLE BLOCK TO DETERMINE THE ACTUAL SCALE OF THIS DRAWING.

03/23/01 OBG CRV
0659E602
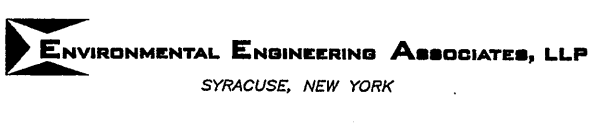
| | | | | | | | | | | | |
|--|-----|------|-----------|------|--------------|-----|--|--|---|-------------|---------------------|
| <p>NOT TO SCALE</p> | No. | Date | Revisions | Init | | |  <p>ENVIRONMENTAL ENGINEERING ASSOCIATES, LLP SYRACUSE, NEW YORK</p> | <p>ONONDAGA COUNTY • DEPARTMENT OF DRAINAGE AND SANITATION • SYRACUSE, NEW YORK METROPOLITAN SYRACUSE WASTEWATER TREATMENT PLANT STAGE III AMMONIA AND STAGE II PHOSPHORUS REMOVAL PROJECT</p> <p>FIRE ALARM SYSTEM SCHEMATIC</p> <p>ELECTRICAL</p> |  | File Number | <p>E-602</p> |
| | | | | | In charge of | TEL | | | | 00659 | |
| | | | | | Designed by | JJC | | | | Date | |
| <p>NO ALTERATIONS PERMITTED HEREON EXCEPT AS PROVIDED UNDER SECTION 7209 SUBDIVISION 2 OF THE NEW YORK STATE EDUCATION LAW</p> | | | | | Drawn by | CRV |  | <p>PER: [Signature]</p> | | | |
| | | | | | Checked by | WFH | | | | | |

NOTES:

1. FIELD VERIFY EXISTING WIRING CONDUCTOR QUANTITY AND SIZE TO EXISTING 22 POINT FIRE ALARM ANNUNCIATOR PANEL.
2. UTILIZE EXISTING SOURCE PRESENTLY POWERING EXISTING 22 POINT FIRE ALARM ANNUNCIATOR PANEL TO POWER DISTRIBUTED MODULE. FIELD VERIFY EXISTING SOURCE VOLTAGE CHARACTERISTICS, CONDUCTOR QUANTITY AND CONDUCTOR SIZE.
3. DISTRIBUTED MODULE SHALL BE WALL MOUNTED ADJACENT TO OR IN THE LOCATION PRESENTLY UTILIZED BY THE EXISTING 22 POINT FIRE ALARM ANNUNCIATOR PANEL.
4. SEE FIRE ALARM SYSTEM O&M MANUAL FOR SYSTEM SCHEMATIC.



RECORD DRAWING

THESE CHANGES HAVE BEEN MADE TO REFLECT MAJOR CHANGES, IF ANY, WHICH OCCURRED DURING CONSTRUCTION. REVISIONS ARE BASED UPON INFORMATION SUPPLIED BY CONTRACTOR.


DATE 10/21/05 FOR [Signature]

THIS DRAWING WAS PREPARED AT THE SCALE INDICATED IN THE TITLE BLOCK. INACCURACIES IN THE STATED SCALE MAY BE INTRODUCED WHEN DRAWINGS ARE REPRODUCED BY ANY MEANS. USE THE GRAPHIC SCALE BAR IN THE TITLE BLOCK TO DETERMINE THE ACTUAL SCALE OF THIS DRAWING.

4/23/01 OBG CRV
0659E603

| | | | | | |
|---|-----|----------|---------------------|-------------|--------------------------|
| NOT TO SCALE | No. | Date | Revisions | Init | In charge of --- TEL --- |
| | 0 | 4/20/01 | ISSUED FOR APPROVAL | [Signature] | Designed by --- JJC --- |
| | 1 | | AS BID | | Drawn by --- CRV --- |
| | 2 | 10/31/05 | RECORD DRAWING | | Checked by --- WFH --- |
| <div style="display: flex; justify-content: space-between; align-items: center;"> <div style="width: 25%;">  <p>ENVIRONMENTAL ENGINEERING ASSOCIATES, LLP SYRACUSE, NEW YORK</p> </div> <div style="width: 40%; text-align: center;"> <p>ONONDAGA COUNTY • DEPARTMENT OF DRAINAGE AND SANITATION • SYRACUSE, NEW YORK METROPOLITAN SYRACUSE WASTEWATER TREATMENT PLANT STAGE III AMMONIA AND STAGE II PHOSPHORUS REMOVAL PROJECT</p> <p>FIRE ALARM SYSTEM SCHEMATIC</p> <p>ELECTRICAL</p> </div> <div style="width: 25%; text-align: right;">  <p>File Number 00659</p> <p>Date APRIL 2001</p> <p>[Signature]</p> </div> </div> | | | | | |
| <p>NO ALTERATIONS PERMITTED HEREON EXCEPT AS PROVIDED UNDER SECTION 7209 SUBDIVISION 2 OF THE NEW YORK STATE EDUCATION LAW</p> | | | | | |

E-603

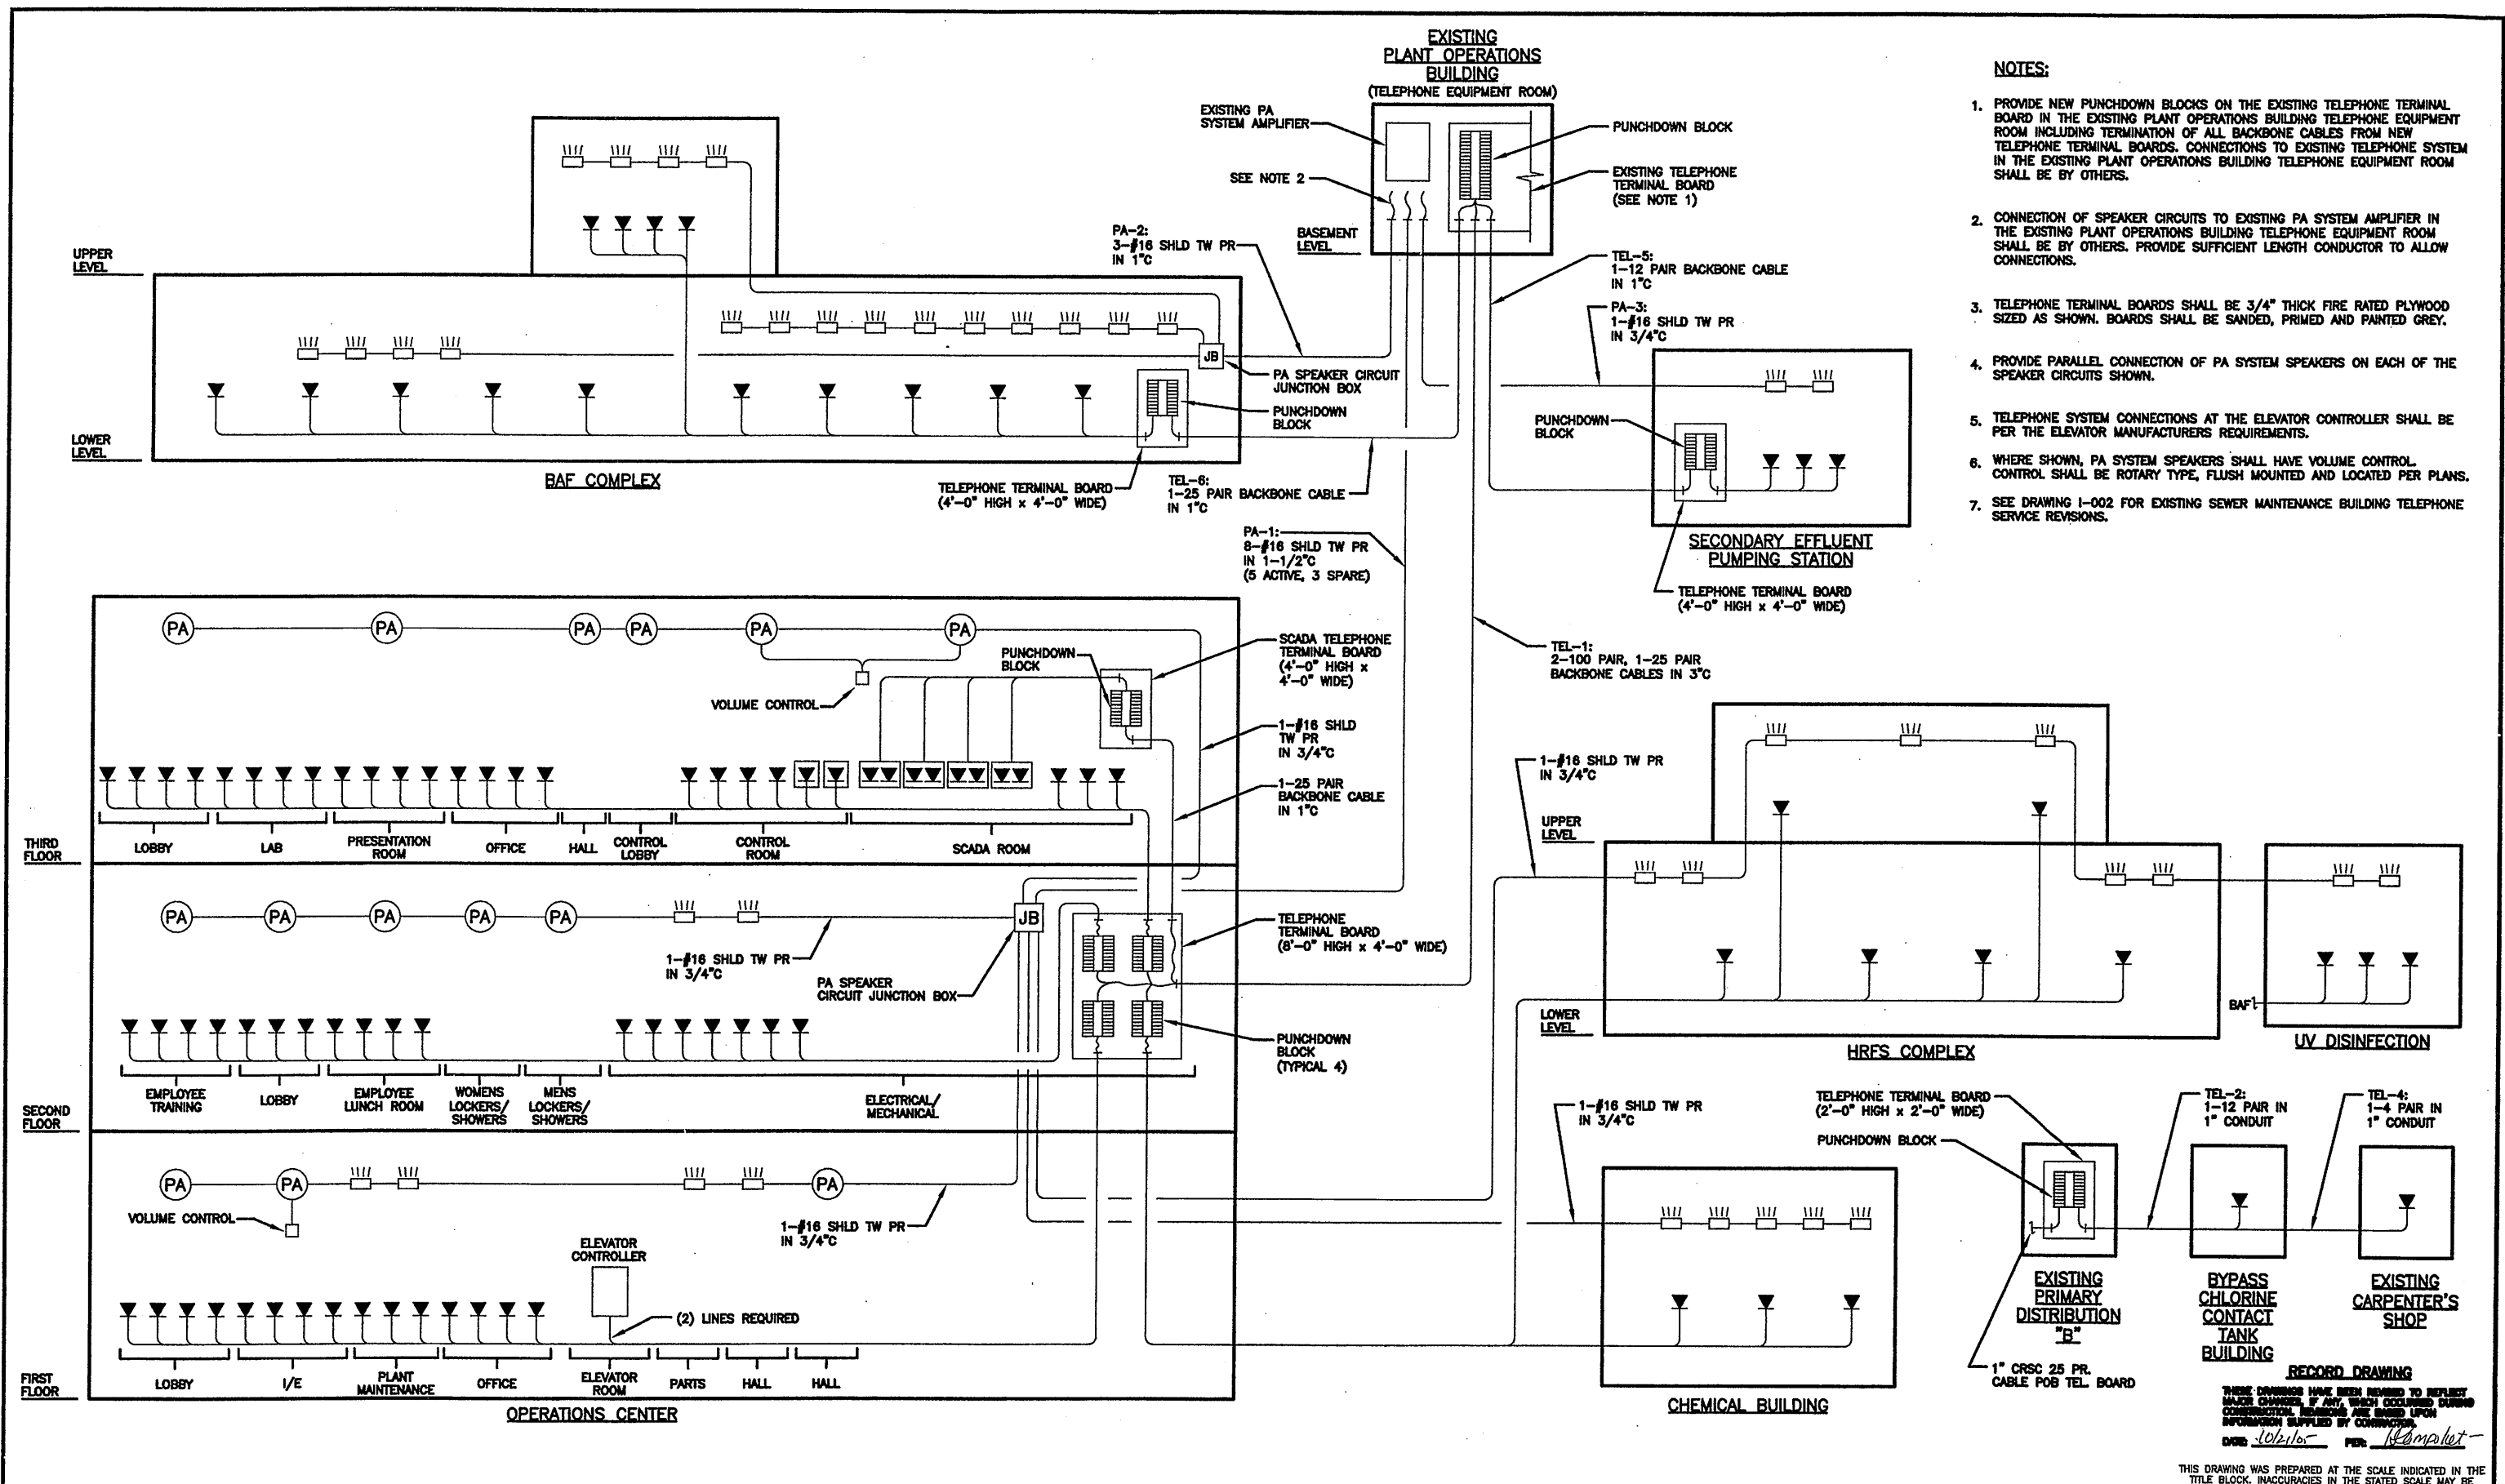

- NOTES:**
1. PROVIDE NEW PUNCHDOWN BLOCKS ON THE EXISTING TELEPHONE TERMINAL BOARD IN THE EXISTING PLANT OPERATIONS BUILDING TELEPHONE EQUIPMENT ROOM INCLUDING TERMINATION OF ALL BACKBONE CABLES FROM NEW TELEPHONE TERMINAL BOARDS. CONNECTIONS TO EXISTING TELEPHONE SYSTEM IN THE EXISTING PLANT OPERATIONS BUILDING TELEPHONE EQUIPMENT ROOM SHALL BE BY OTHERS.
 2. CONNECTION OF SPEAKER CIRCUITS TO EXISTING PA SYSTEM AMPLIFIER IN THE EXISTING PLANT OPERATIONS BUILDING TELEPHONE EQUIPMENT ROOM SHALL BE BY OTHERS. PROVIDE SUFFICIENT LENGTH CONDUCTOR TO ALLOW CONNECTIONS.
 3. TELEPHONE TERMINAL BOARDS SHALL BE 3/4" THICK FIRE RATED PLYWOOD SIZED AS SHOWN. BOARDS SHALL BE SAWNED, PRIMED AND PAINTED GREY.
 4. PROVIDE PARALLEL CONNECTION OF PA SYSTEM SPEAKERS ON EACH OF THE SPEAKER CIRCUITS SHOWN.
 5. TELEPHONE SYSTEM CONNECTIONS AT THE ELEVATOR CONTROLLER SHALL BE PER THE ELEVATOR MANUFACTURERS REQUIREMENTS.
 6. WHERE SHOWN, PA SYSTEM SPEAKERS SHALL HAVE VOLUME CONTROL. CONTROL SHALL BE ROTARY TYPE, FLUSH MOUNTED AND LOCATED PER PLANS.
 7. SEE DRAWING I-002 FOR EXISTING SEWER MAINTENANCE BUILDING TELEPHONE SERVICE REVISIONS.

RECORD DRAWING
 THESE CHANGES HAVE BEEN REVIEWED TO REFLECT
 VALUE CHANGES, IF ANY, WHICH OCCURRED DURING
 CONSTRUCTION. REVISIONS ARE BASED UPON
 INFORMATION SUPPLIED BY CONTRACTOR.
 DATE: 10/31/05 PER: [Signature]

THIS DRAWING WAS PREPARED AT THE SCALE INDICATED IN THE
 TITLE BLOCK. INACCURACIES IN THE STATED SCALE MAY BE
 INTRODUCED WHEN DRAWINGS ARE REPRODUCED BY ANY MEANS.
 USE THE GRAPHIC SCALE BAR IN THE TITLE BLOCK TO
 DETERMINE THE ACTUAL SCALE OF THIS DRAWING.

4/23/01 086 CRV
 0859E604

NOT TO SCALE

NO ALTERATIONS PERMITTED HEREON EXCEPT
 AS PROVIDED UNDER SECTION 7209 SUBDIVISION
 2 OF THE NEW YORK STATE EDUCATION LAW

| No. | Date | Revisions | Init |
|-----|----------|---------------------|-------------|
| 0 | 4/20/01 | ISSUED FOR APPROVAL | [Signature] |
| 1 | | AS BID | |
| 2 | 10/31/05 | RECORD DRAWING | |

In charge of --- TEL ---
 Designed by --- JJC ---
 Drawn by --- CRV ---
 Checked by --- WFH ---



ONONDAGA COUNTY • DEPARTMENT OF DRAINAGE AND SANITATION • SYRACUSE, NEW YORK
 METROPOLITAN SYRACUSE WASTEWATER TREATMENT PLANT
 STAGE III AMMONIA AND STAGE II PHOSPHORUS REMOVAL PROJECT


TELEPHONE/PA SYSTEM SCHEMATIC

ELECTRICAL

File Number 0659
 Date APRIL 2001
 E-604

NOTES:

1. ALL CCTV SYSTEM EQUIPMENT SHALL BE FURNISHED BY A SINGLE SUPPLIER WHO SHALL COORDINATE EQUIPMENT REQUIREMENTS, CHECK SYSTEM INSTALLATION, ADJUST AND TEST ALL SYSTEM COMPONENTS. ALL COMPONENTS NECESSARY FOR A COMPLETE AND OPERATING SYSTEM SHALL BE PROVIDED. SUPPLIER SHALL ALSO PROVIDE TRAINING AS NECESSARY FOR OWNER'S PERSONNEL ON THE OPERATION AND MAINTENANCE OF THE SYSTEM. MANUFACTURER SHALL BE SIMPLEX, VICON OR EQUAL.
2. SHOP DRAWINGS FOR CCTV SYSTEM SHALL BE SUBMITTED INCLUDING SYSTEM WIRING DIAGRAMS, PANEL LAYOUTS AND DESCRIPTIVE LITERATURE ON ALL COMPONENTS.
3. CAMERAS SHALL BE BLACK & WHITE, SOLID STATE TYPE WITH AUTO IRIS, 0.5 FOOTCANDLE MINIMUM SENSITIVITY, ZOOM LENS, PAN/TILT OPERATOR AND WEATHERPROOF ENCLOSURE. ENCLOSURE SHALL HAVE THERMOSTATICALLY CONTROLLED BLOWER/HEATER, ACCESS COVER AND WALL MOUNTING BRACKET. CAMERAS SHALL INCLUDE CONTROLLERS AS NECESSARY HOUSED IN NEMA 4 ENCLOSURES PROVIDING CONTROL OF PAN, TILT AND ZOOM OPERATIONS FROM A SINGLE INPUT SIGNAL. CONTROLLERS SHALL BE MOUNTED ADJACENT TO CAMERAS. CAMERAS SHALL OPERATE AT 120VAC.
4. SEQUENCER SHALL HAVE VIDEO INPUTS FOR THE CAMERA QUANTITIES AS SHOWN PLUS A MINIMUM OF TWO SPARE INPUTS. SEQUENCER SHALL SCROLL THROUGH INPUTS AND PROVIDE OUTPUT OF EACH INPUT IN SEQUENCE. SEQUENCER SHALL HAVE ADJUSTABLE SEQUENCE TIME, HOLD FUNCTION AND PAN-TILT-ZOOM CONTROL OF THE SELECTED CAMERA. OUTPUTS SHALL BE PROVIDED FOR MONITORS, VCR, PLUS SPARE. SEQUENCER SHALL OPERATE AT 120VAC.
5. MONITORS SHALL BE BLACK & WHITE WITH 19" SCREEN AND CEILING MOUNTING BRACKET. MONITORS SHALL OPERATE AT 120VAC.
6. VIDEO CASSETTE RECORDER (VCR) SHALL BE VHS FORMAT WITH RECORD, PLAY, REWIND, FAST FORWARD AND PAUSE CONTROL. RECORDER SHALL PROVIDE 7 DAY REPEAT RECORDING ON A SINGLE CASSETTE TAPE. RECORDER SHALL OPERATE AT 120VAC.
7. NEW CCTV EQUIPMENT AND CABLING SHALL BE COMPATIBLE WITH THE EXISTING CCTV SYSTEM. CONTRACTOR SHALL FIELD VERIFY LOCATIONS, CONNECTIONS AND CONFIGURATION OF THE EXISTING CCTV SYSTEM AS NECESSARY FOR THE COORDINATION OF NEW CCTV EQUIPMENT AND CABLING.
8. EXISTING FIBEROPTIC CABLE ROUTED FROM EXISTING MAINTENANCE GARAGE & ADMINISTRATION BUILDING TO EXISTING PLANT OPERATIONS BUILDING CONSISTS OF 5 FIBERS (2 ACTIVE/3 SPARE). FIBER PRESENTLY UTILIZED FOR CAMERA NO. 1 COMMUNICATIONS SHALL BE DESIGNATED FO-4. UTILIZE ONE SPARE FIBER FOR CAMERA NO. 3 COMMUNICATIONS DESIGNATED FO-10.
9. PROVIDE CONNECTION OF NEW FIBEROPTIC CABLES TO EXISTING FIBEROPTIC CABLE INCLUDING ALL NECESSARY CONNECTORS AND FITTINGS. CONNECTORS SHALL BE IN ACCORDANCE WITH THE CABLE MANUFACTURER'S REQUIREMENTS.
10. EXISTING CCTV SYSTEM EQUIPMENT SHOWN FOR REMOVAL SHALL BE RETURNED TO OWNER.
11. CCTV FIBEROPTIC INTERFACE PANEL SHALL BE A NEMA 12, SINGLE DOOR ENCLOSURE, 42" HIGH x 30" WIDE x 8" DEEP (MINIMUM). PANEL SHALL INCLUDE THE FIBEROPTIC VIDEO RECEIVER/DATA TRANSMITTERS AS SHOWN, SPACE FOR TWO FUTURE FIBEROPTIC VIDEO RECEIVER/DATA TRANSMITTERS, 24 VAC POWER SUPPLY (WITH 120VAC INPUT) AND ALL TERMINALS, CONNECTORS AND HARDWARE AS NECESSARY.
12. FIBEROPTIC VIDEO TRANSMITTERS/DATA RECEIVERS SHALL EACH BE HOUSED IN A NEMA 4, SINGLE DOOR ENCLOSURE, 16" HIGH x 12" WIDE x 6" DEEP (MINIMUM). ENCLOSURES SHALL ALSO INCLUDE 24 VAC POWER SUPPLY (WITH 120VAC INPUT) AND ALL TERMINALS, CONNECTORS AND HARDWARE AS NECESSARY. FIBEROPTIC VIDEO TRANSMITTERS/DATA RECEIVERS SHALL BE MOUNTED ADJACENT TO CAMERAS.
13. CABLES BETWEEN CCTV COMPONENTS (EXCEPT FIBEROPTIC CABLES) SHALL BE FURNISHED BY THE CCTV SYSTEM SUPPLIER. CABLES SHALL BE OF THE TYPE, LENGTH AND SHALL INCLUDE ALL CONNECTORS AS NECESSARY TO FACILITATE CONNECTION OF CCTV SYSTEM COMPONENTS.

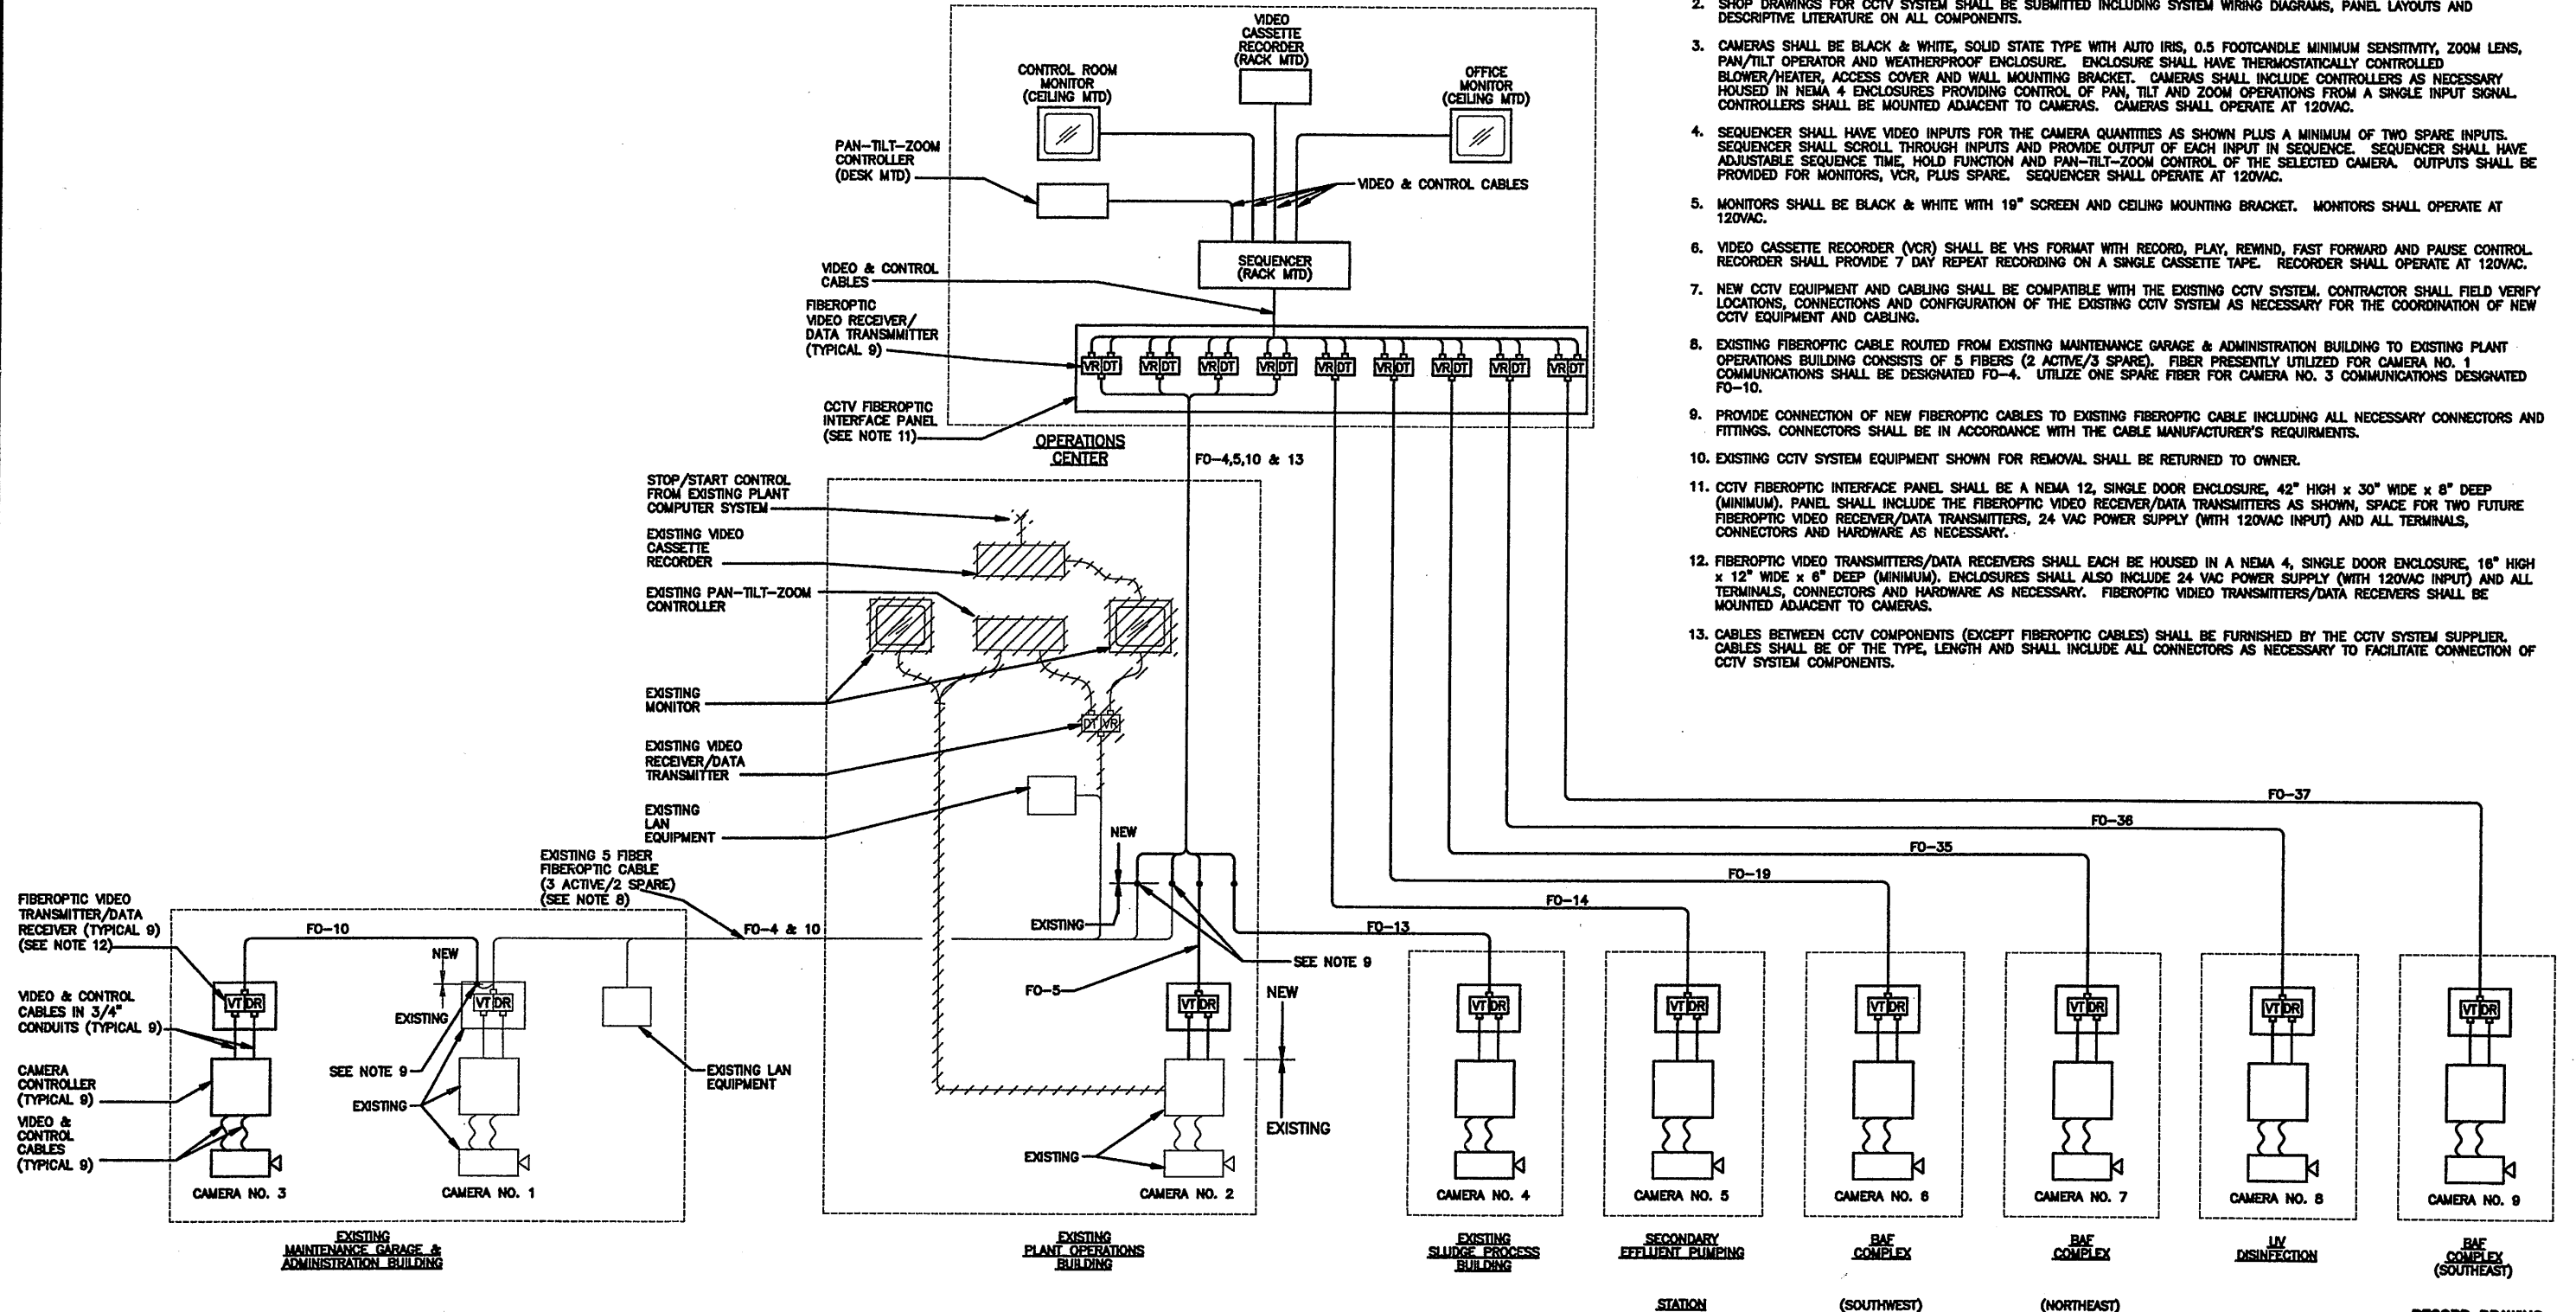

RECORD DRAWING

THESE DRAWINGS HAVE BEEN REVIEWED TO REFLECT
 MAJOR CHANGES, IF ANY, WHICH OCCURRED DURING
 CONSTRUCTION. REVISIONS ARE BASED UPON
 INFORMATION SUPPLIED BY CONTRACTOR.
 DATE: 10/21/01 FOR: [Signature]

THIS DRAWING WAS PREPARED AT THE SCALE INDICATED IN THE
 TITLE BLOCK. INACCURACIES IN THE STATED SCALE MAY BE
 INTRODUCED WHEN DRAWINGS ARE REPRODUCED BY ANY MEANS.
 USE THE GRAPHIC SCALE BAR IN THE TITLE BLOCK TO
 DETERMINE THE ACTUAL SCALE OF THIS DRAWING.

03/23/01 056 CRV
 0659E605

NOT TO SCALE

| No. | Date | Revisions | Init |
|-----|----------|---------------------|------|
| 0 | 4/20/01 | ISSUED FOR APPROVAL | lck |
| 1 | | AS BID | |
| 2 | 10/31/05 | RECORD DRAWING | |

In charge of ___ TEL ___
 Designed by ___ JJC ___
 Drawn by ___ CRV ___
 Checked by ___ WFH ___



ONONDAGA COUNTY • DEPARTMENT OF DRAINAGE AND SANITATION • SYRACUSE, NEW YORK
 METROPOLITAN SYRACUSE WASTEWATER TREATMENT PLANT
 STAGE III AMMONIA AND STAGE II PHOSPHORUS REMOVAL PROJECT

CCTV SYSTEM SCHEMATIC


ELECTRICAL




File Number
 00659
 Date
 APRIL 2001
 [Signature]

E-605


NO ALTERATIONS PERMITTED HEREON EXCEPT
 AS PROVIDED UNDER SECTION 7209 SUBDIVISION
 2 OF THE NEW YORK STATE EDUCATION LAW

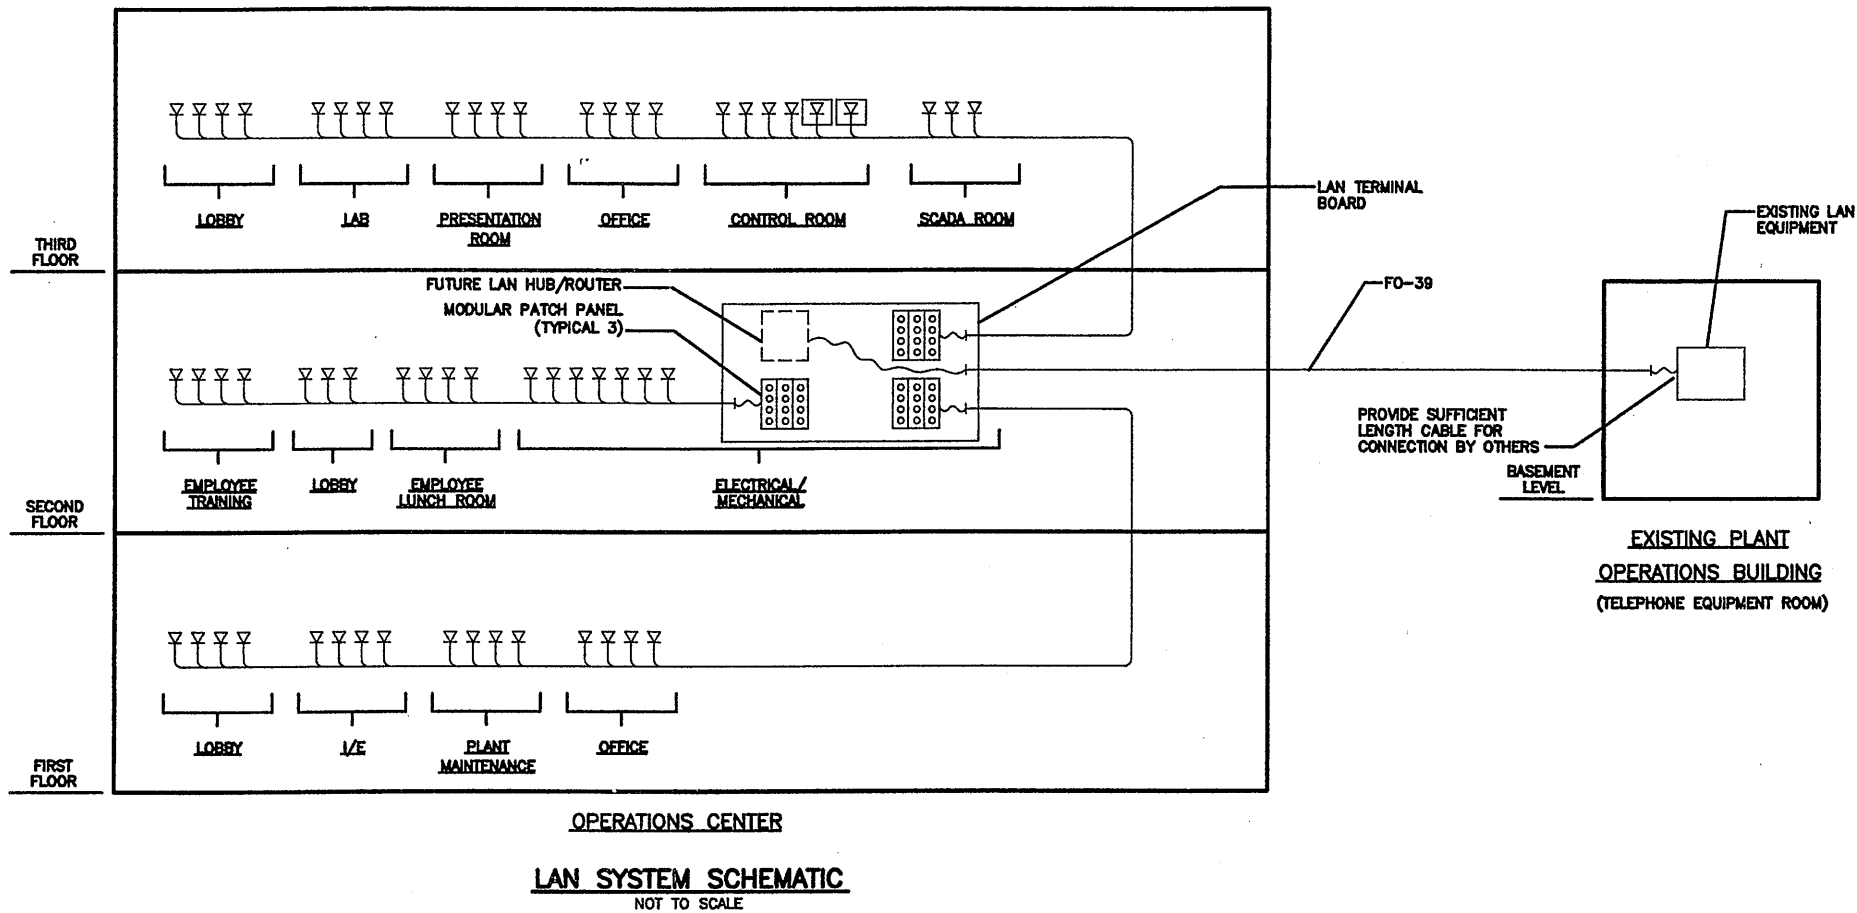

LAN SYSTEM SCHEMATIC
NOT TO SCALE

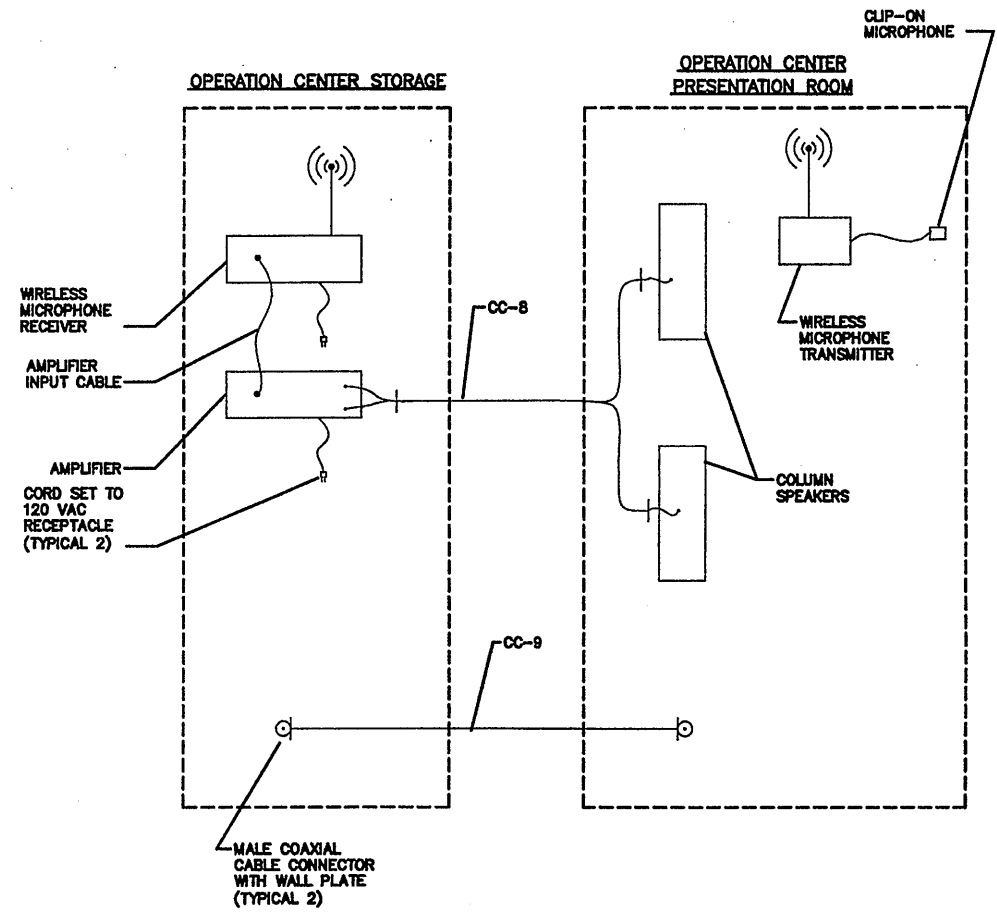


PRESENTATION ROOM AUDIO/VIDEO SYSTEMS SCHEMATIC
NOT TO SCALE

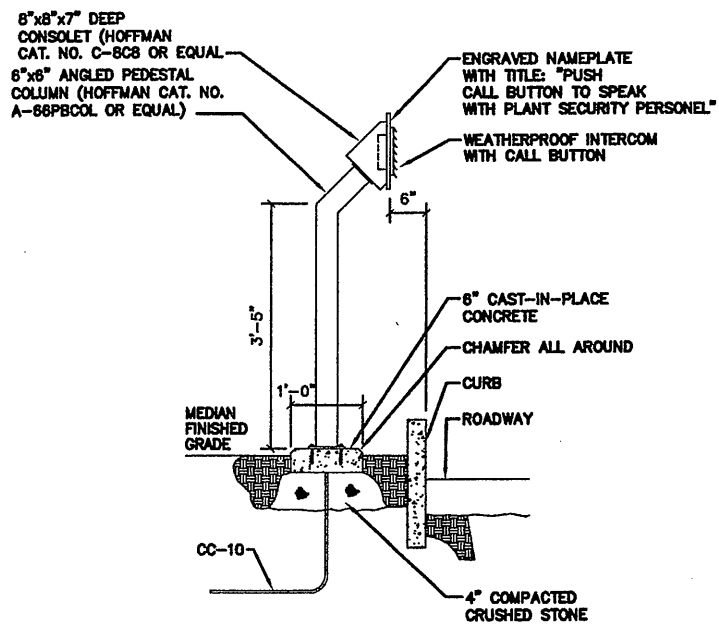

NORTH ENTRANCE GATE INTERCOM DETAIL
SCALE: 3/4"=1'-0"

NOTES:

- PRESENTATION ROOM AUDIO SYSTEM SHALL CONSIST OF WIRELESS MICROPHONE EQUIPMENT, AMPLIFIER AND COLUMN SPEAKERS. SYSTEM SHALL BE FURNISHED BY A SINGLE SUPPLIER WHO SHALL COORDINATE EQUIPMENT REQUIREMENTS, PROVIDE ADJUSTMENTS AND TEST ALL COMPONENTS. COMPONENTS SHALL BE AS FOLLOWS:
 - WIRELESS MICROPHONE EQUIPMENT SHALL INCLUDE CLIP-ON MICROPHONE, BATTERY POWERED TRANSMITTER, RECEIVER AND AMPLIFIER INPUT CABLE. EQUIPMENT SHALL BE MANUFACTURED BY SHURE "THE PRESENTER" UHF UT 14/85 OR EQUAL.
 - AMPLIFIER SHALL HAVE THREE INPUTS (ONE ACTIVE/TWO SPARE) 100 WATT OUTPUT, 0.1% MAXIMUM TOTAL HARMONIC DISTORTION, VOLUME CONTROL AND TONE CONTROL. MANUFACTURER SHALL BE RAULAND, BOGEN OR EQUAL.
 - COLUMN SPEAKERS SHALL EACH HAVE FOUR 5 INCH CONE SPEAKERS WITH MINIMUM FREQUENCY RESPONSE OF 80 TO 14,000 Hz, 8 OHM IMPEDANCE, PARTICLE BOARD ENCLOSURE, GRILLE CLOTH AND WALL MOUNTING BRACKET. MANUFACTURER SHALL BE RAULAND, BOGEN OR EQUAL.
- INTERCOM SYSTEM SHALL PROVIDE POINT-TO-POINT, TWO WAY VOICE COMMUNICATION, COMPONENTS SHALL BE AS FOLLOWS:
 - DESK MOUNTED INTERCOM SHALL HAVE SPEAKER/MICROPHONE, TOUCH PANEL SWITCHES, VOLUME CONTROL AND ALERT TONE (ACTIVATED BY REMOTE CALL BUTTON) MANUFACTURER SHALL BE 3M OR EQUAL.
 - PEDESTAL MOUNTED INTERCOM SHALL HAVE SPEAKER/MICROPHONE, CALL BUTTON AND WEATHERPROOF CONSTRUCTION. MANUFACTURER SHALL BE 3M OR EQUAL.
- LAN TERMINAL BOARD SHALL BE 8'-0" HIGH x 4'-0" WIDE x 3/4" THICK FIRE RATED PLYWOOD, SANDED, PRIMED AND PAINTED GREY.

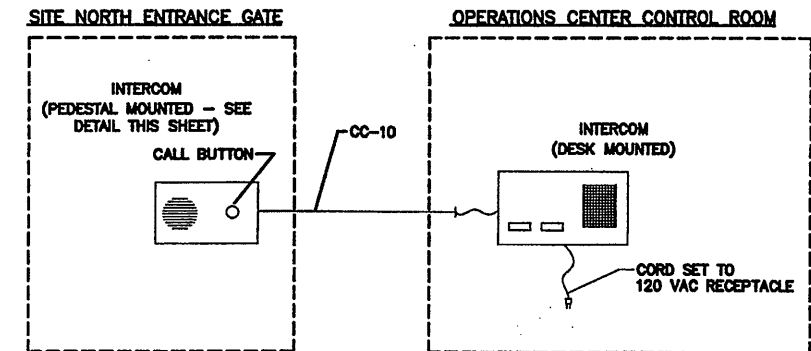

INTERCOM SYSTEM SCHEMATIC
NOT TO SCALE

RECORD DRAWING

THESE DRAWINGS HAVE BEEN REVISIONED TO REFLECT MAJOR CHANGES IF ANY, WHICH OCCURRED DURING CONSTRUCTION. REVISIONS ARE BASED UPON INFORMATION SUPPLIED BY CONTRACTOR.
DATE 10/21/05 FOR [Signature]

THIS DRAWING WAS PREPARED AT THE SCALE INDICATED IN THE TITLE BLOCK. INACCURACIES IN THE STATED SCALE MAY BE INTRODUCED WHEN DRAWINGS ARE REPRODUCED BY ANY MEANS. USE THE GRAPHIC SCALE BAR IN THE TITLE BLOCK TO DETERMINE THE ACTUAL SCALE OF THIS DRAWING.

03/23/01 OBG CRV
0859E608

NOT TO SCALE

NO ALTERATIONS PERMITTED HEREON EXCEPT AS PROVIDED UNDER SECTION 7209 SUBDIVISION 2 OF THE NEW YORK STATE EDUCATION LAW

| No. | Date | Revisions | Init |
|-----|----------|---------------------|-------------|
| 0 | 4/20/01 | ISSUED FOR APPROVAL | [Signature] |
| 1 | | AS BID | |
| 2 | 10/31/05 | RECORD DRAWING | |

In charge of ___ TEL ___
Designed by JJC
Drawn by CRV
Checked by WFH




ONONDAGA COUNTY • DEPARTMENT OF DRAINAGE AND SANITATION • SYRACUSE, NEW YORK
METROPOLITAN SYRACUSE WASTEWATER TREATMENT PLANT
STAGE III AMMONIA AND STAGE II PHOSPHORUS REMOVAL PROJECT
MISCELLANEOUS SCHEMATICS & DETAILS







File Number 00659
Date APRIL 2001
E-606
[Signature]

ELECTRICAL

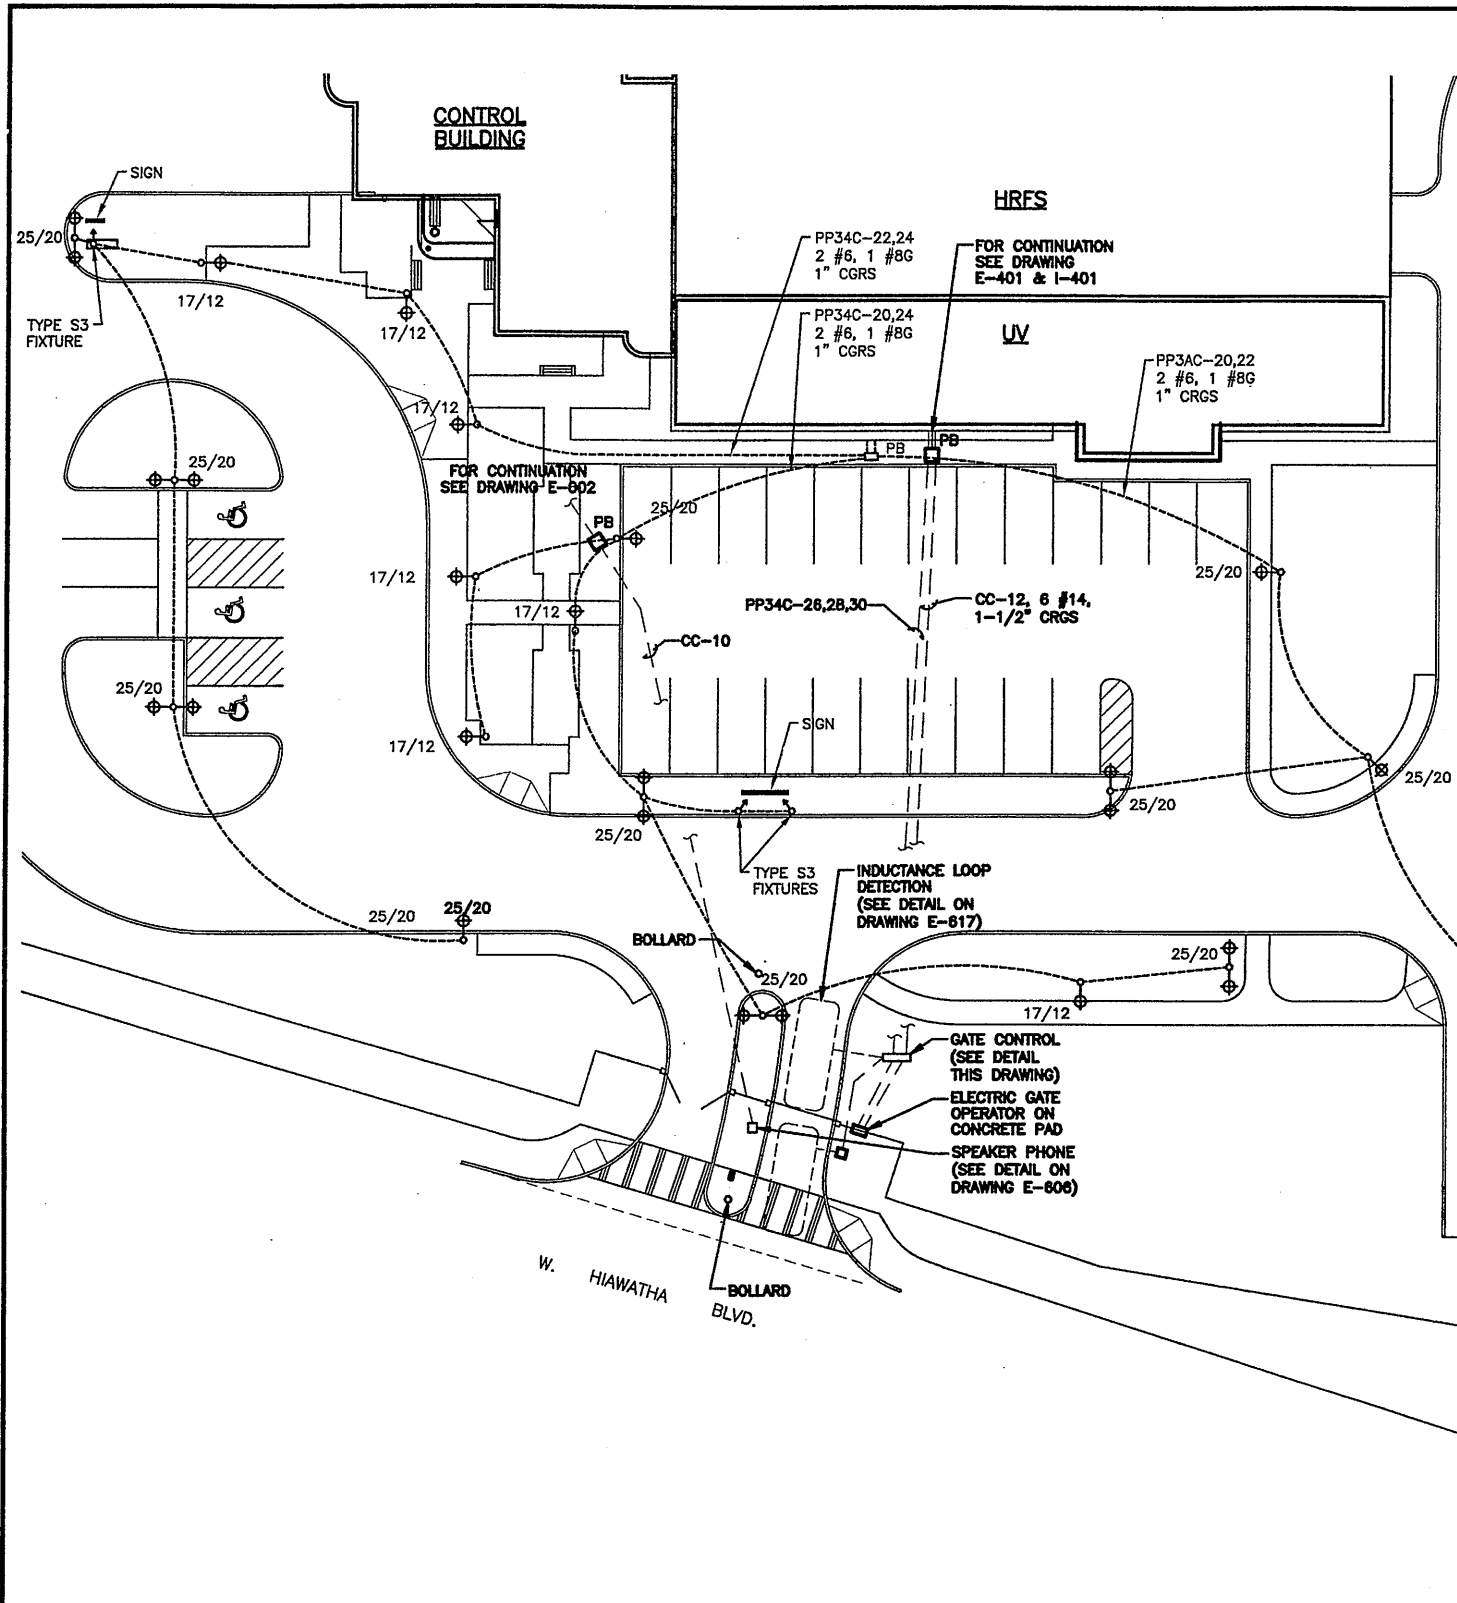

EXTERIOR LIGHTING SITE PLAN
 SCALE: 1"=20'-0"

NOTES:
 1. ROUTE ILLUMINATED SIGN CONDUIT & CONDUCTOR TO 18" SQUARE PVC JUNCTION BOXES MOUNTED FLUSH WITH GRADE AT SIGNS. EXTEND WIRING TO SIGNS AS NECESSARY.

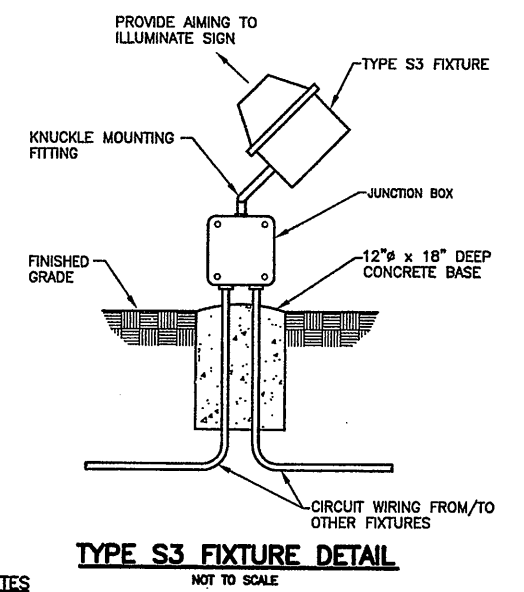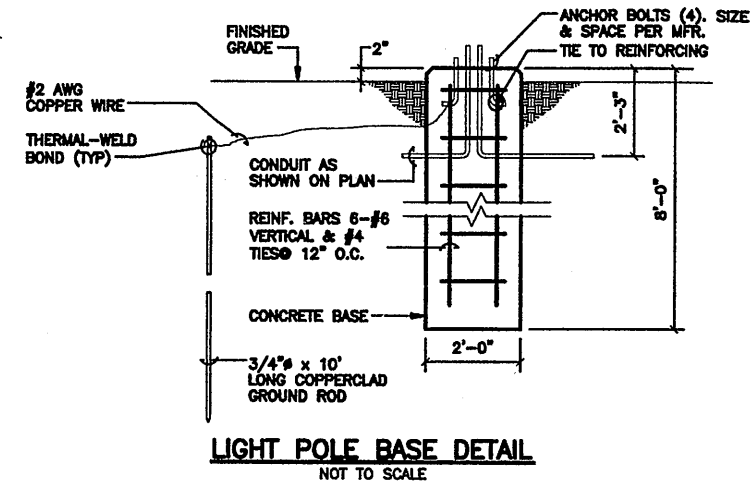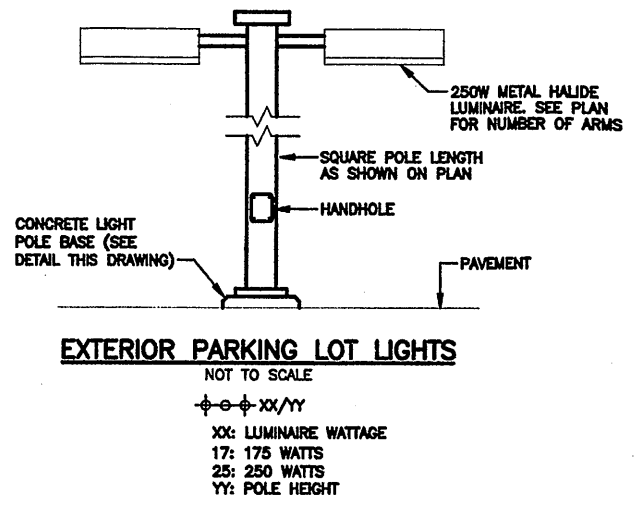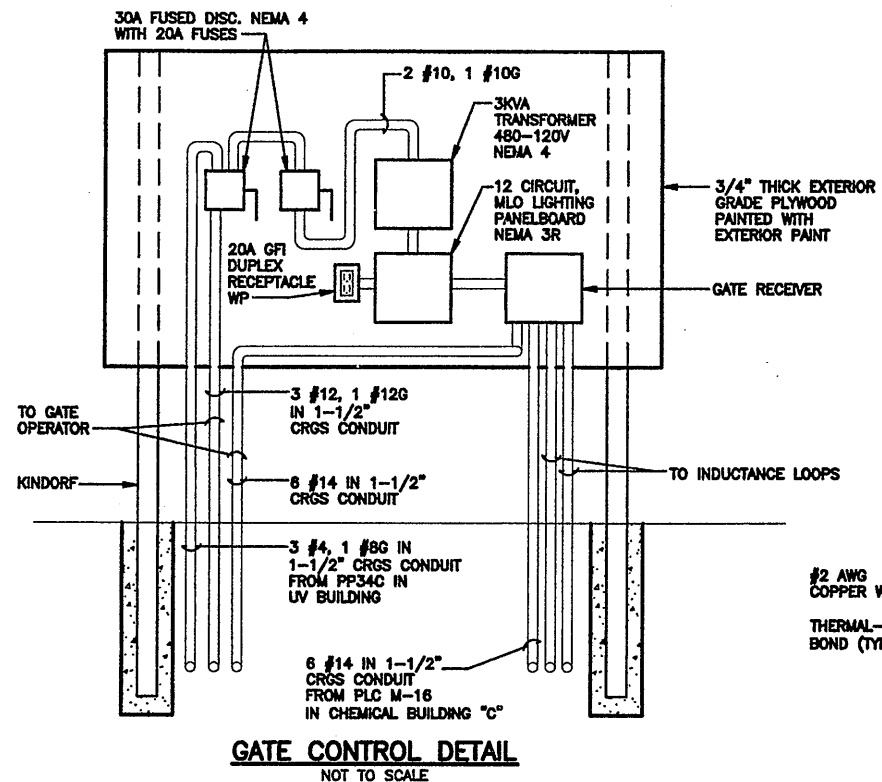


NOTES
 1. TYPE S3 FIXTURES SHALL BE ENCLOSED FLOODLIGHTS WITH DIE CAST HOUSING, TEMPERED GLASS LENS, DARK BRONZE FINISH, 70 WATT METAL HALIDE LAMP, 480 VAC HIGH POWER FACTOR BALLAST AND KNUCKLE MOUNTING FITTING. FIXTURE SHALL BE SUITABLE FOR WET AREAS. MANUFACTURER SHALL BE LUMARK SERIES BF OR EQUAL.

RECORD DRAWING
 THESE DRAWINGS HAVE BEEN REVISIONED TO REFLECT MAJOR CHANGES, IF ANY, WHICH OCCURRED DURING CONSTRUCTION. REVISIONS ARE BASED UPON INFORMATION SUPPLIED BY CONTRACTOR.
 DATE: 10/21/05 PER: [Signature]

THIS DRAWING WAS PREPARED AT THE SCALE INDICATED IN THE TITLE BLOCK. INACCURACIES IN THE STATED SCALE MAY BE INTRODUCED WHEN DRAWINGS ARE REPRODUCED BY ANY MEANS. USE THE GRAPHIC SCALE BAR IN THE TITLE BLOCK TO DETERMINE THE ACTUAL SCALE OF THIS DRAWING.

Layer: ON=*, OFF=*REF*
 X: 06596X02, X048.DWG
 4/6/01 BBL DCC
 05503000/0659E607.DWG

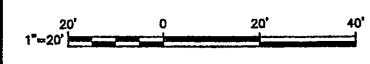

| No. | Date | Revisions | Init |
|-----|----------|---------------------|------|
| 0 | 4/20/01 | ISSUED FOR APPROVAL | llr |
| 1 | | AS BID | |
| 2 | 10/31/05 | RECORD DRAWING | |

In charge of TEL
 Designed by MEE
 Drawn by DCC
 Checked by WFH

ENVIRONMENTAL ENGINEERING ASSOCIATES, LLP
 SYRACUSE, NEW YORK


ONONDAGA COUNTY • DEPARTMENT OF DRAINAGE AND SANITATION • SYRACUSE, NEW YORK
 METROPOLITAN SYRACUSE WASTEWATER TREATMENT PLANT
 STAGE III AMMONIA AND STAGE II PHOSPHORUS REMOVAL PROJECT

EXTERIOR LIGHTING PLAN AND DETAILS


ELECTRICAL




File Number
 00659
 Date
 APRIL 2001
 E-607
 [Signature]

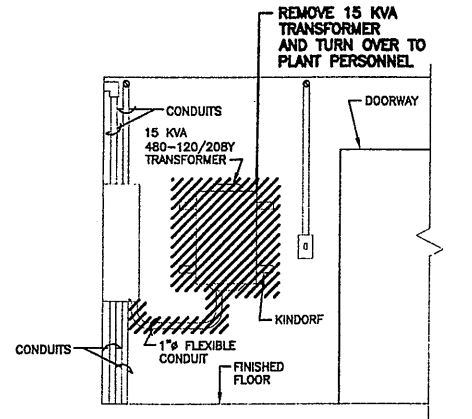


EXISTING CHEMICAL BUILDING A CONTROL ROOM DEMOLITION WEST ELEVATION
NOT TO SCALE

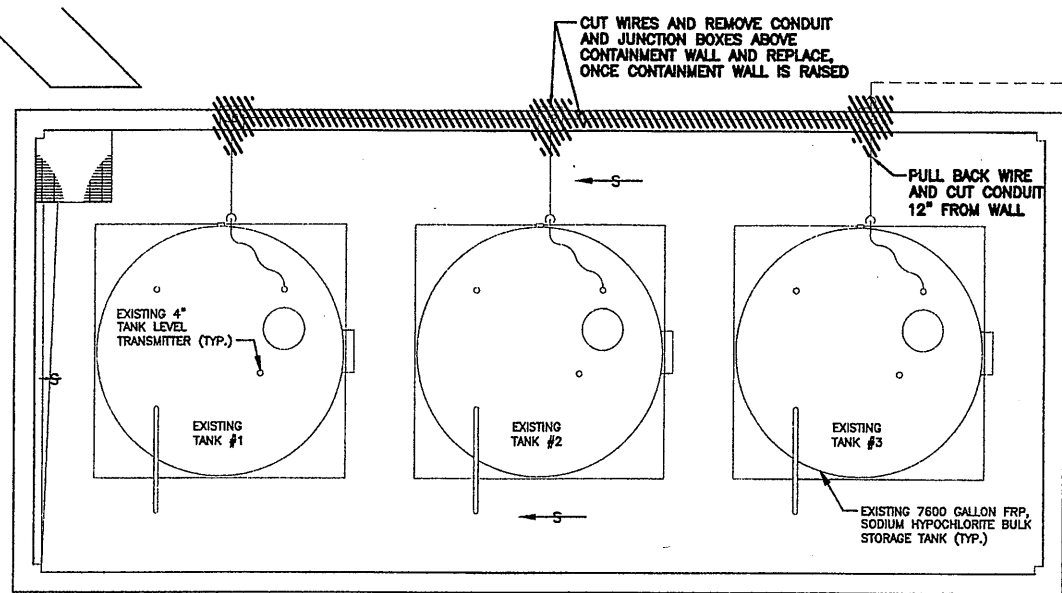


BULK STORAGE TANK AND CONTAINMENT AREA DEMOLITION PLAN
SCALE: 1/4"=1'-0"

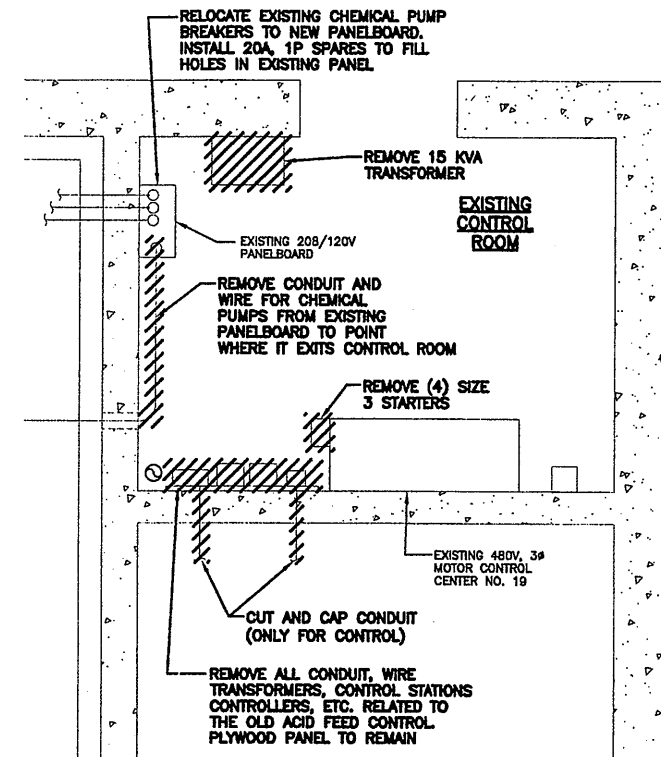


EXISTING CHEMICAL BUILDING A CONTROL ROOM DEMOLITION
SCALE: 1/2"=1'-0"

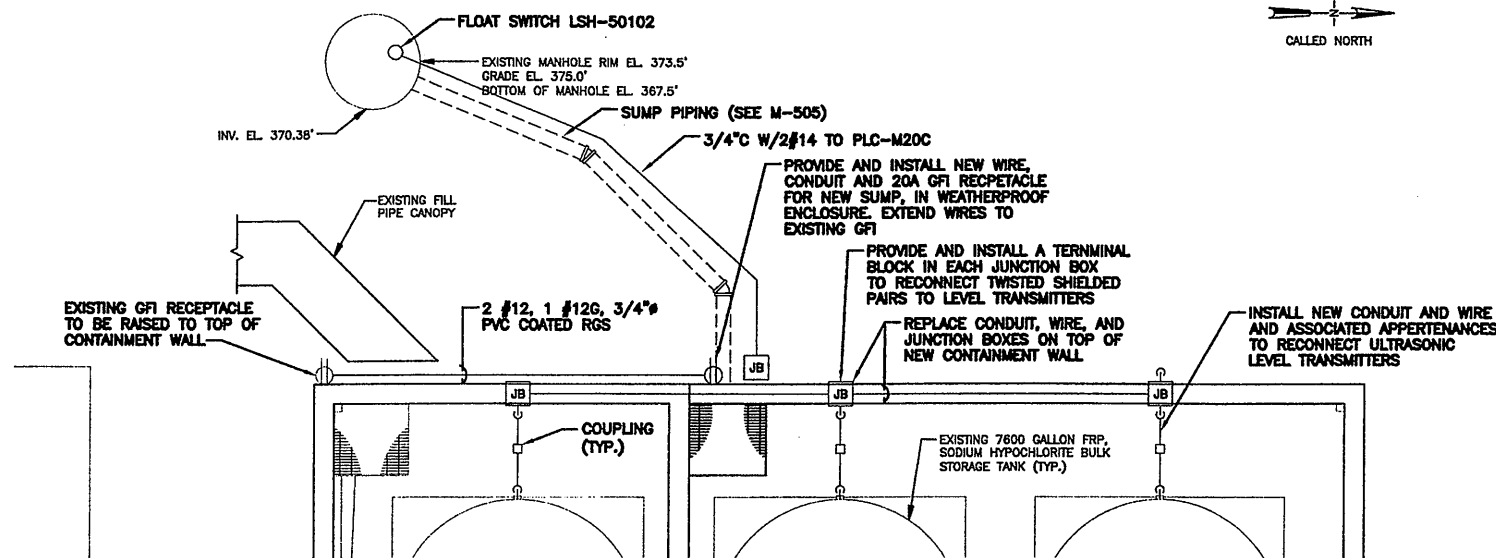

BULK STORAGE TANK AND CONTAINMENT AREA MODIFICATIONS
SCALE: 1/4"=1'-0"

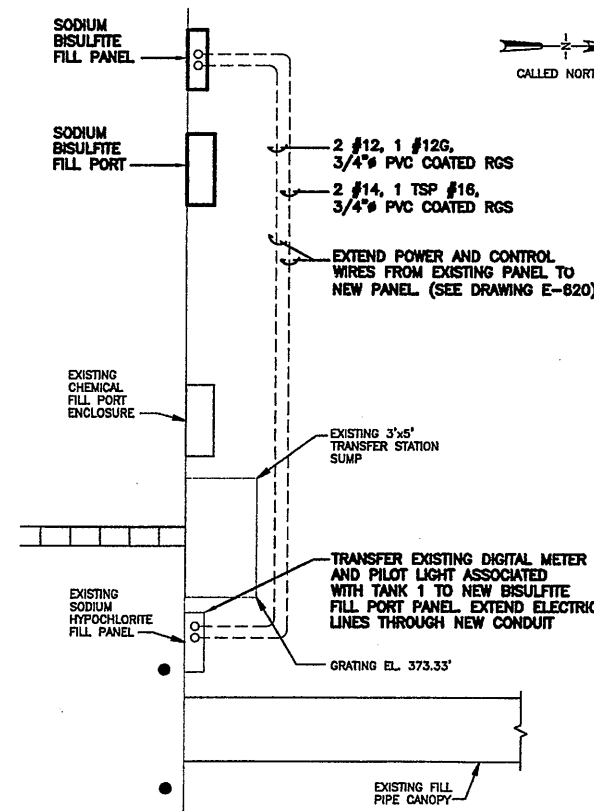

EXISTING TRANSFER STATION AREA MODIFICATIONS
SCALE: 1/4"=1'-0"

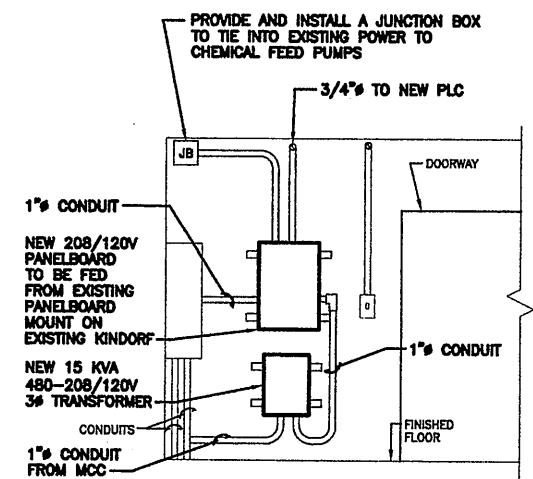

EXISTING CHEMICAL BUILDING A CONTROL ROOM MODIFICATIONS WEST ELEVATION
NOT TO SCALE

THESE DRAWINGS HAVE BEEN REVIEWED TO REFLECT MAJOR CHANGES IF ANY, WHICH OCCURRED DURING CONSTRUCTION. REVISIONS ARE BASED UPON INFORMATION SUPPLIED BY CONTRACTOR.
DATE: 10/21/05 PER: [Signature]

THIS DRAWING WAS PREPARED AT THE SCALE INDICATED IN THE TITLE BLOCK. INACCURACIES IN THE STATED SCALE MAY BE INTRODUCED WHEN DRAWINGS ARE REPRODUCED BY ANY MEANS. USE THE GRAPHIC SCALE BAR IN THE TITLE BLOCK TO DETERMINE THE ACTUAL SCALE OF THIS DRAWING.


Layer: ON=*, OFF=*REF*
4/4/01 BBL DCC
05503000/0859E608.DWG

| No. | Date | Revisions | Init |
|-----|----------|---------------------|------|
| 0 | 4/20/01 | ISSUED FOR APPROVAL | LLP |
| 1 | | AS BID | |
| 2 | 10/31/05 | RECORD DRAWING | |

In charge of TEL
Designed by MEE
Drawn by DCC
Checked by WFH




ONONDAGA COUNTY • DEPARTMENT OF DRAINAGE AND SANITATION • SYRACUSE, NEW YORK
METROPOLITAN SYRACUSE WASTEWATER TREATMENT PLANT
STAGE III AMMONIA AND STAGE II PHOSPHORUS REMOVAL PROJECT
BULK STORAGE TANK
BULK STORAGE & CONTROL ROOM DEMOLITION & MODIFICATIONS, & TRANSFER STATION MODIFICATIONS
ELECTRICAL

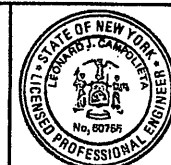

File Number
00659
Date
APRIL 2001
E-608
[Signature]


1/4"=1'-0"
NO ALTERATIONS PERMITTED HEREON EXCEPT AS PROVIDED UNDER SECTION 7209 SUBDIVISION 2 OF THE NEW YORK STATE EDUCATION LAW

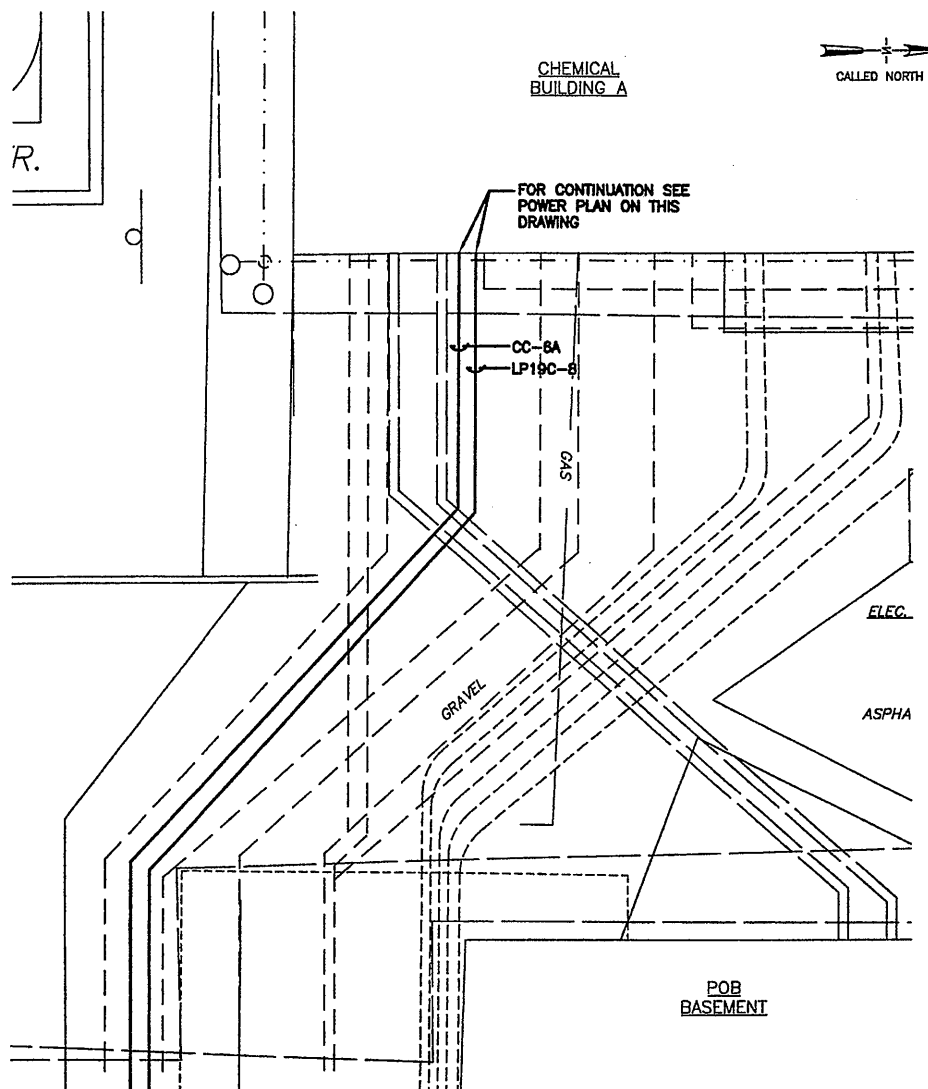

FOR CONTINUATION SEE DRAWING I-501

NOTE:
THE LOCATION OF UNDERGROUND UTILITIES AND OTHER UNDERGROUND STRUCTURES WERE OBTAINED BY FIELD MEASUREMENT WHERE POSSIBLE, OTHERWISE OBTAINED FROM OTHER SOURCES AND ARE APPROXIMATE ONLY. OTHER UNDERGROUND UTILITIES MAY EXIST, THE LOCATION OF WHICH ARE NOT KNOWN AT THIS TIME. THE CONTRACTOR SHALL UNDERTAKE MEASURES TO FIELD VERIFY SUCH UTILITIES.


YARD PIPING PARTIAL PLAN
SCALE: 3/8"=1'-0"

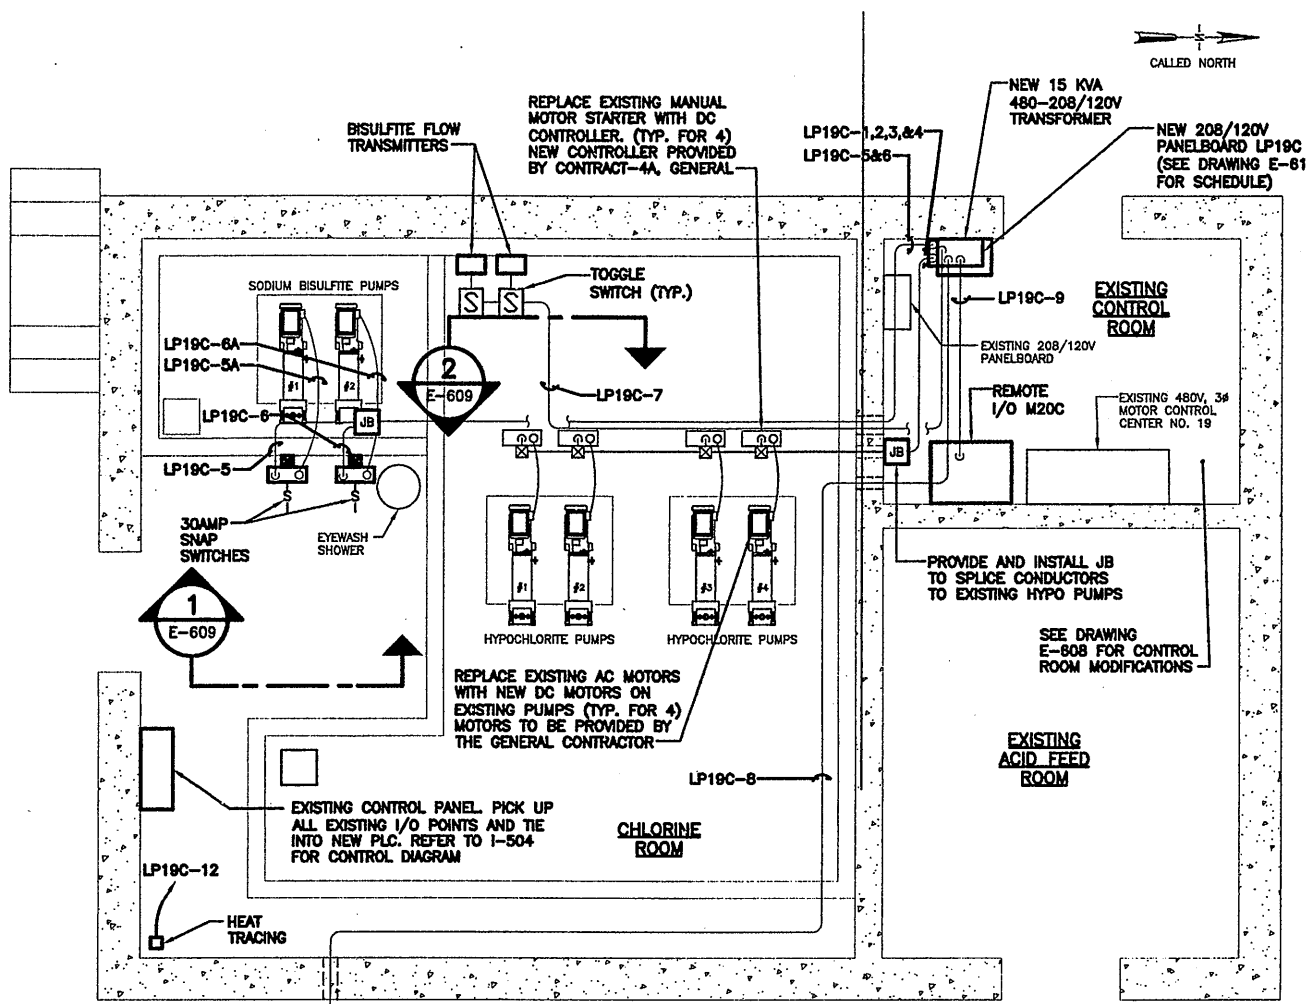


FOR CONTINUATION (SEE YARD PIPING DETAIL THIS DRAWING)

CHEMICAL BUILDING A POWER PLAN
SCALE: 3/8"=1'-0"

- NOTE:**
1. ALL CONDUITS SHALL BE 3/4"± PVC COATED RGS UNLESS INDICATED OTHERWISE.
 2. UTILIZE ONE EXISTING STOP LOCKOUT AND PROVIDE THREE NEW STOP LOCKOUTS FOR CONTROL OF EACH OF THE FOUR SODIUM HYPOCHLORITE PUMPS. THE EXISTING STOP LOCKOUT IS LOCATED ON THE EXTERIOR SOUTH WALL OF CHEMICAL BUILDING A AND IS PRESENTLY UTILIZED TO CONTROL ALL FOUR EXISTING SODIUM HYPOCHLORITE PUMPS. NEW STOP LOCKOUTS SHALL BE LOCATED ON THE EXTERIOR SOUTH WALL OF CHEMICAL BUILDING A ADJACENT TO THE EXISTING STOP LOCKOUT. REMOVE EXISTING CONDUCTOR FROM EXISTING CONDUIT ROUTED FROM EXISTING STOP LOCKOUT TO EXISTING PUMP CONTROLS. UTILIZE EXISTING CONDUIT TO THE EXTENT POSSIBLE WITH NEW 3/4" CONDUIT AS NECESSARY TO CONNECT NEW/EXISTING STOP LOCKOUTS AND SODIUM HYPOCHLORITE PUMP DC CONTROLLERS. PROVIDE 8-#10 CONDUCTORS IN NEW/EXISTING CONDUIT TO FACILITATE CONNECTIONS. STOP LOCKOUTS SHALL BE CONNECTED TO DISCONNECT THE 120VAC SUPPLY TO EACH PUMP DC CONTROLLER SUCH THAT STOP LOCKOUTS ARE FUNCTIONAL IN ALL MODES OF CONTROL.
 3. PROVIDE INSTALLATION AND CONNECTION OF CONTROL STATIONS FURNISHED WITH THE DC CONTROLLERS BY CONTRACT 4A-GENERAL. CONTROL STATIONS SHALL BE MOUNTED IMMEDIATELY ADJACENT TO THEIR RESPECTIVE DC CONTROLLER. WIRING FROM CONTROL STATIONS TO DC CONTROLLER SHALL BE 11 #14 IN 3/4" CONDUIT. FIELD VERIFY CONDUCTOR QUANTITY WITH EQUIPMENT AS FURNISHED.

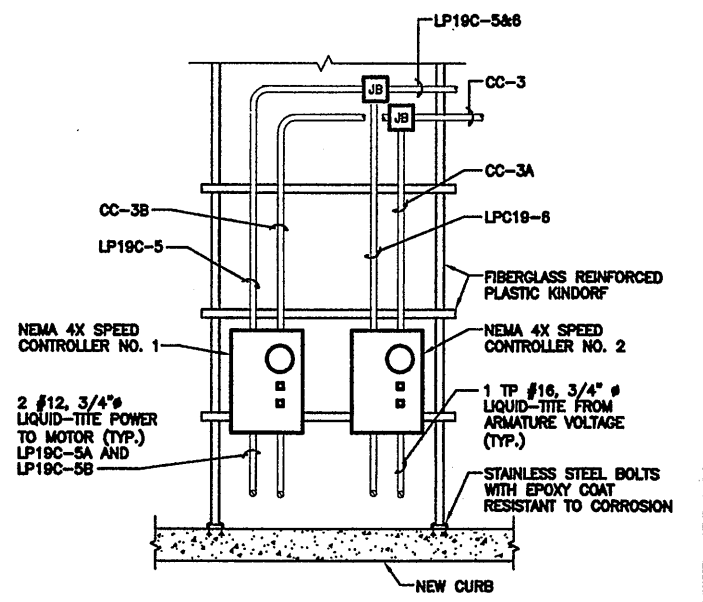

SECTION 1
SCALE: NOT TO SCALE E-609

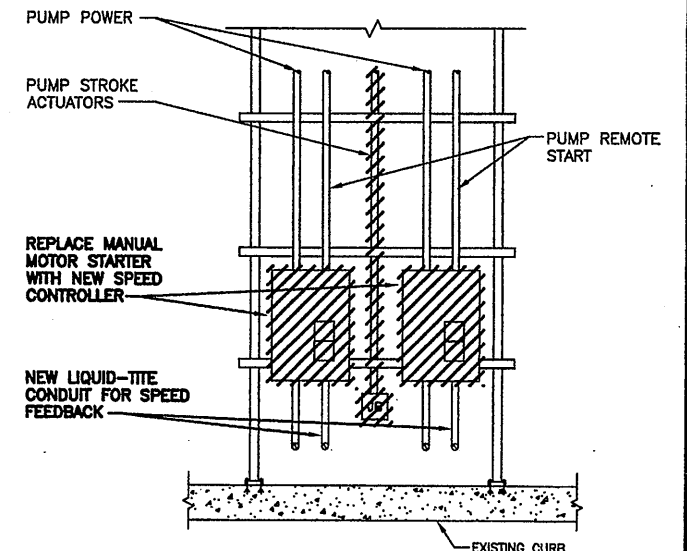

SECTION 2
SCALE: NOT TO SCALE E-609

RECORD DRAWING

THESE DRAWINGS HAVE BEEN REVIEWED TO REFLECT MAJOR CHANGES, IF ANY, WHICH OCCURRED DURING CONSTRUCTION. REVISIONS ARE SHOWN UPON INFORMATION SUPPLIED BY CONTRACTOR.
DATE: 10/21/01 FOR: Wampel

THIS DRAWING WAS PREPARED AT THE SCALE INDICATED IN THE TITLE BLOCK. INACCURACIES IN THE STATED SCALE MAY BE INTRODUCED WHEN DRAWINGS ARE REPRODUCED BY ANY MEANS. USE THE GRAPHIC SCALE BAR IN THE TITLE BLOCK TO DETERMINE THE ACTUAL SCALE OF THIS DRAWING.

Layer: ON=*; OFF=*REF*
4/4/01 BBL DCC
05503000/0659E609.DWG

| No. | Date | Revisions | Init |
|-----|----------|---------------------|------|
| 0 | 4/20/01 | ISSUED FOR APPROVAL | TEL |
| 1 | | AS BID | |
| 2 | 10/31/05 | RECORD DRAWING | |

In charge of TEL
Designed by MEE
Drawn by DCC
Checked by WFH




ONONDAGA COUNTY • DEPARTMENT OF DRAINAGE AND SANITATION • SYRACUSE, NEW YORK
METROPOLITAN SYRACUSE WASTEWATER TREATMENT PLANT
STAGE III AMMONIA AND STAGE II PHOSPHORUS REMOVAL PROJECT
**CHEMICAL BUILDING A
CHEMICAL BUILDING A POWER PLAN**




File Number: 00659
Date: APRIL 2001
E-609
Wampel

ELECTRICAL

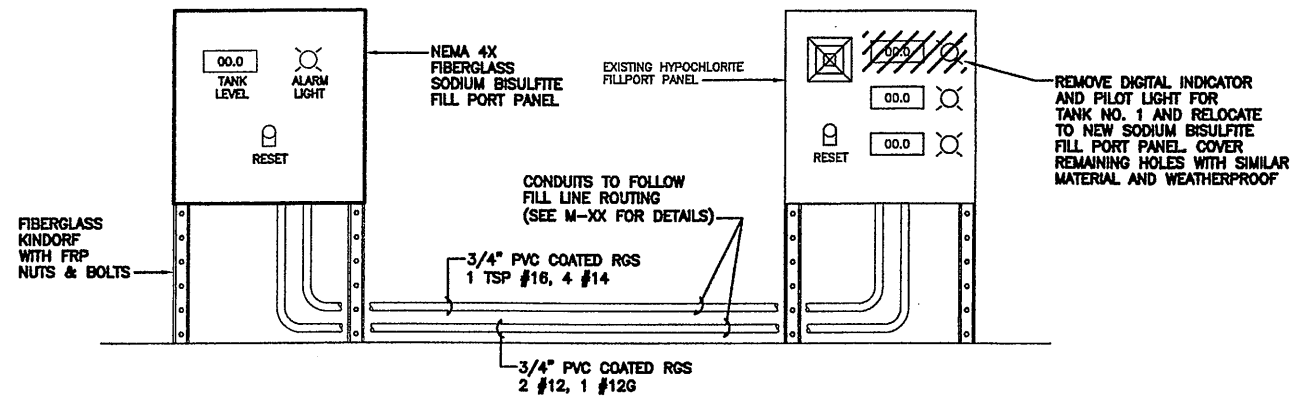


FILL PORT PANEL MODIFICATION DIAGRAM

NOT TO SCALE

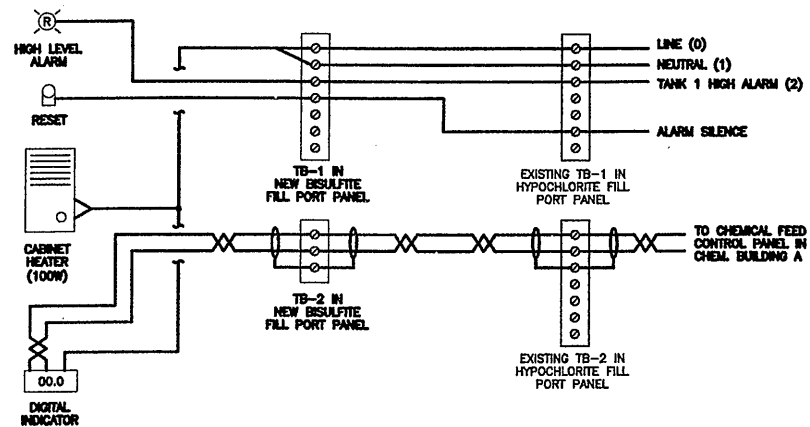

FILL PORT CONTROL WIRING MODIFICATIONS

NOT TO SCALE

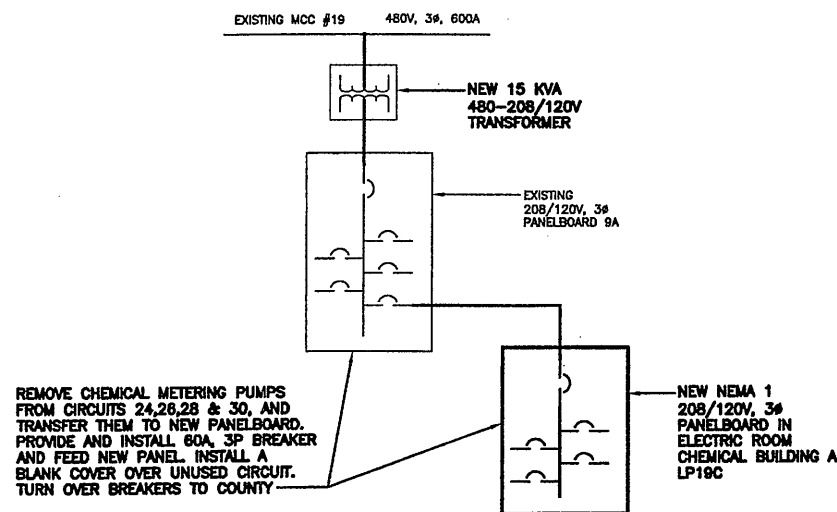

ONE-LINE DIAGRAM

NOT TO SCALE

| CIRCUIT BREAKER PANELBOARD - LP-19C | | | | | | | | | | SCHEDULE | | |
|--------------------------------------|---------------------------------|------------|-----------|-------|--------|-------|-------|-------|-----------|-------------------------------|---------------------------------|---------|
| LOCATION: CHEMICAL FEED BUILDING | | | | | | | | | | FEED FROM PANELBOARD PP-8A | | |
| MAIN BUS RATING: 60 AMPERES | | | | | | | | | | 208/120 VOLTS 3 PHASE, 4 WIRE | | |
| MINIMUM SHORTCIRCUIT: 10,000 AMPERES | | | | | | | | | | FEEDER CABLE 3 #8, 1 #10G | | |
| MAIN BREAKER TRIP: 100 AMPERES | | | | | | | | | | SURFACE MTD | | |
| ESTIMATED CONNECTED LOAD: 10.01 KVA | | | | | | | | | | | | |
| | | | | | | | | | | C/B | | |
| CKT NO. | DESCRIPTION | AMPS/POLES | LOAD TYPE | KVA | PH-A | PH-B | PH-C | KVA | LOAD TYPE | AMPS/POLES | DESCRIPTION | CKT NO. |
| 1 | HYPOCHLORITE PUMP NO. 1 (3/4HP) | 25/1P | MOTOR | 1.858 | 3.312 | | | 1.858 | MOTOR | 25/1P | HYPOCHLORITE PUMP NO. 2 (3/4HP) | 2 |
| 3 | HYPOCHLORITE PUMP NO. 3 (3/4HP) | 25/1P | MOTOR | 1.858 | | 3.312 | | 1.858 | MOTOR | 25/1P | HYPOCHLORITE PUMP NO. 4 (3/4HP) | 4 |
| 5 | DECHLOR. PUMP NO. 1 (3/4HP) | 25/1P | MOTOR | 1.858 | | | 3.312 | 1.858 | MOTOR | 25/1P | DECHLOR. PUMP NO. 2 (3/4HP) | 8 |
| 7 | BISULFITE FLOW METERS | 20/1P | INST | 0.030 | 0.050 | | | 0.020 | MOTOR | 20/1P | CARRIER WATER PUMP VALVES | 8 |
| 9 | REMOTE I/O PANEL M20C | 20/1P | INST | 0.020 | | 0.020 | | | | 20/1P | HEAT TRACE GFI | 10 |
| 11 | SPARE | 25/1P | | | | | 0.000 | | | 20/1P | HEAT TRACE GFI | 12 |
| 13 | SPARE | 20/1P | | | 0.000 | | | | | 20/1P | HEAT TRACE GFI | 14 |
| 15 | SPARE | 20/1P | | | | 0.000 | | | | 20/1P | SPARE | 16 |
| 17 | SPARE | 20/1P | | | | | 0.000 | | | 20/1P | SPARE | 18 |
| 19 | SPARE | 20/1P | | | 0.000 | | | | | 20/1P | SPARE | 20 |
| 21 | SPACE | | | | | | 0.000 | | | | SPACE | 22 |
| 23 | SPACE | | | | | | | 0.000 | | | SPACE | 24 |
| 25 | SPACE | | | | 0.000 | | | | | | SPACE | 26 |
| 27 | SPACE | | | | | 0.000 | | | | | SPACE | 28 |
| 29 | SPACE | | | | | | | 0.000 | | | SPACE | 30 |
| LOAD SUMMARY | | | | | 5.018 | 3.362 | 3.332 | 3.312 | 4.988 | | | |
| PANEL TOTAL KVA: | | | | | 10.008 | | | | | | | |

NOTE:

1. ALL CONDUCTORS TO BE 2 #12, 1 #12G IN 3/4-INCH PVC COATED CONDUIT, UNLESS OTHERWISE INDICATED ON POWER PLAN.
2. * CONDUCTORS TO BE 2 #10, 1 #10G IN 3/4-INCH PVC COATED CONDUIT.

RECORD DRAWING

THIS DRAWING HAS BEEN REVISIONED TO REFLECT MAKE CHANGES, IF ANY, WHICH OCCURRED DURING CONSTRUCTION. REVISIONS ARE BASED UPON INFORMATION SUPPLIED BY CONTRACTOR.

DATE: 10/21/05 FOR: [Signature]

THIS DRAWING WAS PREPARED AT THE SCALE INDICATED IN THE TITLE BLOCK. INACCURACIES IN THE STATED SCALE MAY BE INTRODUCED WHEN DRAWINGS ARE REPRODUCED BY ANY MEANS. USE THE GRAPHIC SCALE BAR IN THE TITLE BLOCK TO DETERMINE THE ACTUAL SCALE OF THIS DRAWING.

Layer: ON=*; OFF=*REF*

4/17/01 BBL DCC
05503000/0659E610.DWG

NOT TO SCALE


NO ALTERATIONS PERMITTED HEREON EXCEPT AS PROVIDED UNDER SECTION 7209 SUBDIVISION 2 OF THE NEW YORK STATE EDUCATION LAW

| No. | Date | Revisions | Init |
|-----|----------|---------------------|------|
| 0 | 4/20/01 | ISSUED FOR APPROVAL | Le |
| 1 | | AS BID | |
| 2 | 10/31/05 | RECORD DRAWING | |


In charge of --- TEL ---
Designed by --- MEE ---
Drawn by --- DCC ---
Checked by --- WFH ---

ENVIRONMENTAL ENGINEERING ASSOCIATES, LLP
SYRACUSE, NEW YORK

ONONDAGA COUNTY • DEPARTMENT OF DRAINAGE AND SANITATION • SYRACUSE, NEW YORK
METROPOLITAN SYRACUSE WASTEWATER TREATMENT PLANT
STAGE III AMMONIA AND STAGE II PHOSPHORUS REMOVAL PROJECT
CHEMICAL BUILDING A
**CHEMICAL FILL PORT MODIFICATIONS
AND ONE-LINE DIAGRAMS**
ELECTRICAL

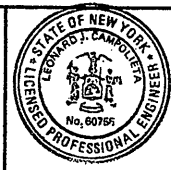


File Number
00659
Date
APRIL 2001
E-610
[Signature]

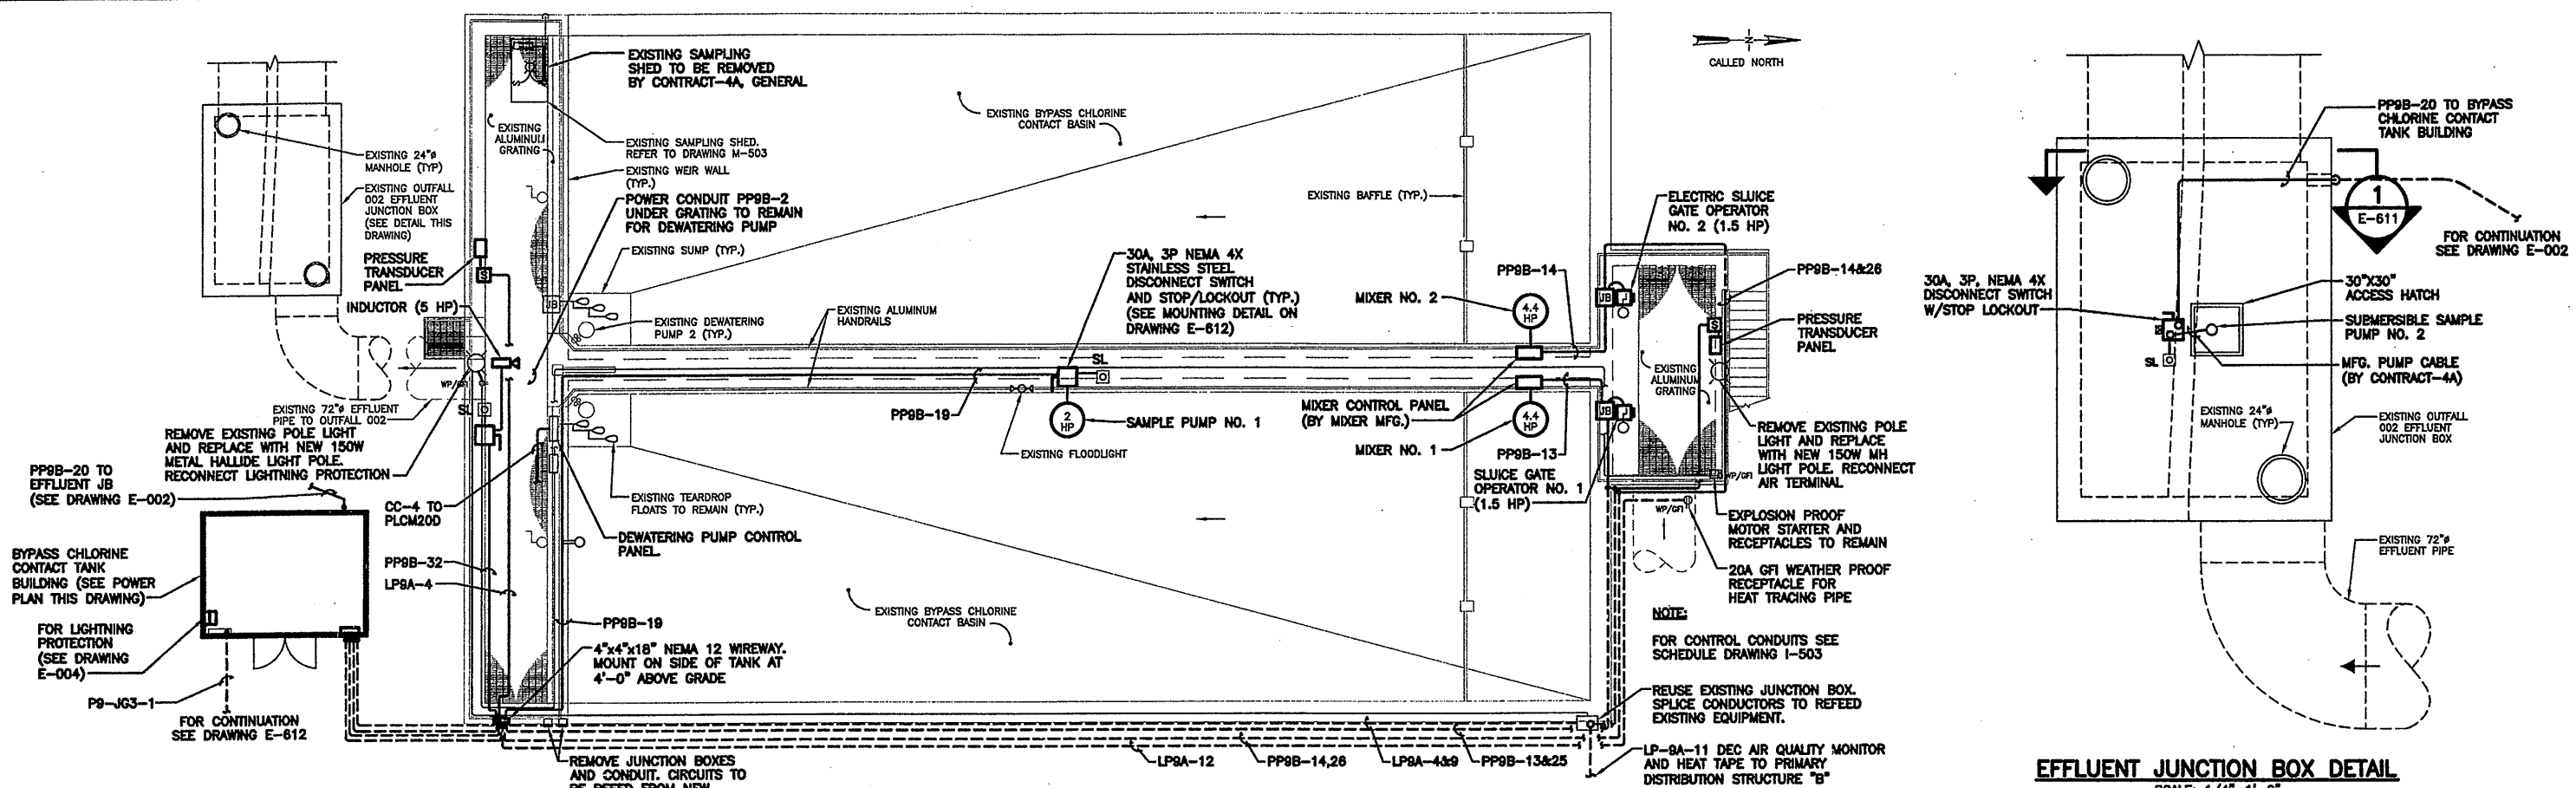

BYPASS CHLORINE CONTACT TANK PLAN
SCALE: 1/8"=1'-0"

EFFLUENT JUNCTION BOX DETAIL
SCALE: 1/4"=1'-0"

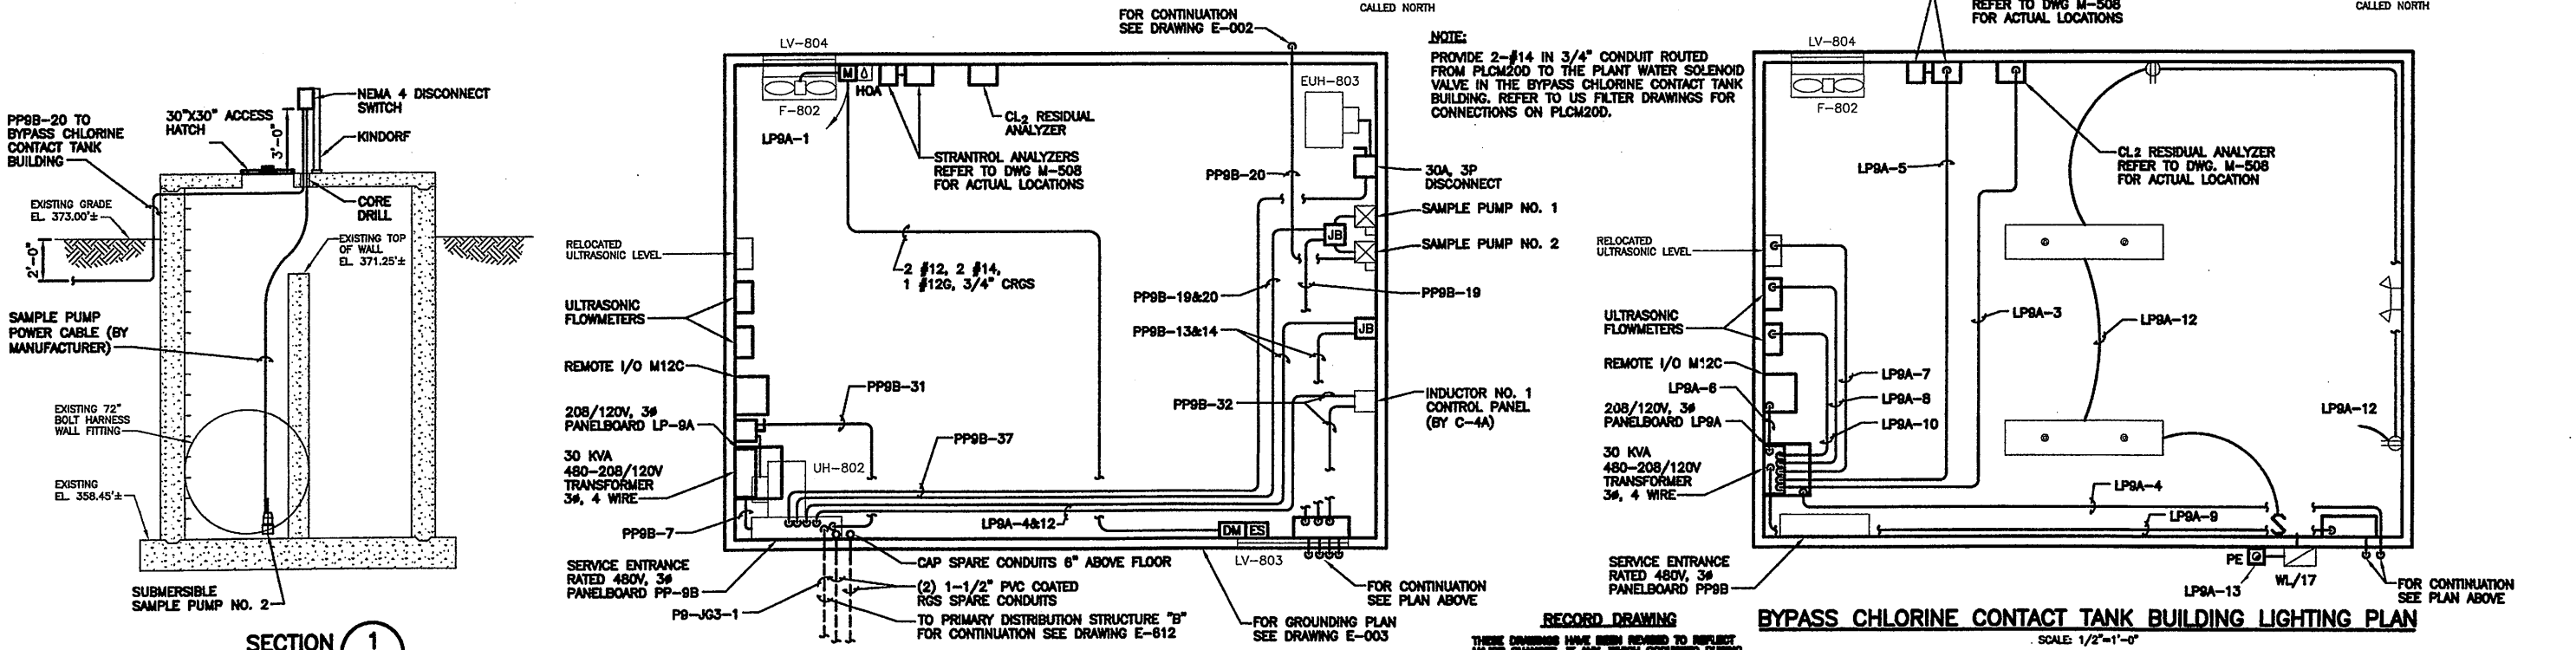

BYPASS CHLORINE CONTACT TANK BUILDING POWER PLAN
SCALE: 1/2"=1'-0"

BYPASS CHLORINE CONTACT TANK BUILDING LIGHTING PLAN
SCALE: 1/2"=1'-0"

Layer: ON=*, OFF=*REF*
X: 0659K042.DWG
4/5/01 BBL DCC
05503000/0659E811.DWG

SECTION 1
SCALE: 1/4"=1'-0" E-611

NO ALTERATIONS PERMITTED HEREON EXCEPT AS PROVIDED UNDER SECTION 7209 SUBDIVISION 2 OF THE NEW YORK STATE EDUCATION LAW

| No. | Date | Revisions | Init |
|-----|----------|---------------------|------|
| 0 | 4/20/01 | ISSUED FOR APPROVAL | DL |
| 1 | | AS BID | |
| 2 | 10/31/05 | RECORD DRAWING | |


In charge of TEL
Designed by MEE
Drawn by DCC
Checked by WFH

ENVIRONMENTAL ENGINEERING ASSOCIATES, LLP
SYRACUSE, NEW YORK


ONONDAGA COUNTY • DEPARTMENT OF DRAINAGE AND SANITATION • SYRACUSE, NEW YORK
METROPOLITAN SYRACUSE WASTEWATER TREATMENT PLANT
STAGE III AMMONIA AND STAGE II PHOSPHORUS REMOVAL PROJECT
BYPASS CHLORINE CONTACT TANK PLAN AND BUILDING PLANS
ELECTRICAL

File Number **00659**
Date **APRIL 2001**
E-611


THIS DRAWING WAS PREPARED AT THE SCALE INDICATED IN THE TITLE BLOCK. INACCURACIES IN THE STATED SCALE MAY BE INTRODUCED WHEN DRAWINGS ARE REPRODUCED BY ANY MEANS. USE THE GRAPHIC SCALE BAR IN THE TITLE BLOCK TO DETERMINE THE ACTUAL SCALE OF THIS DRAWING.

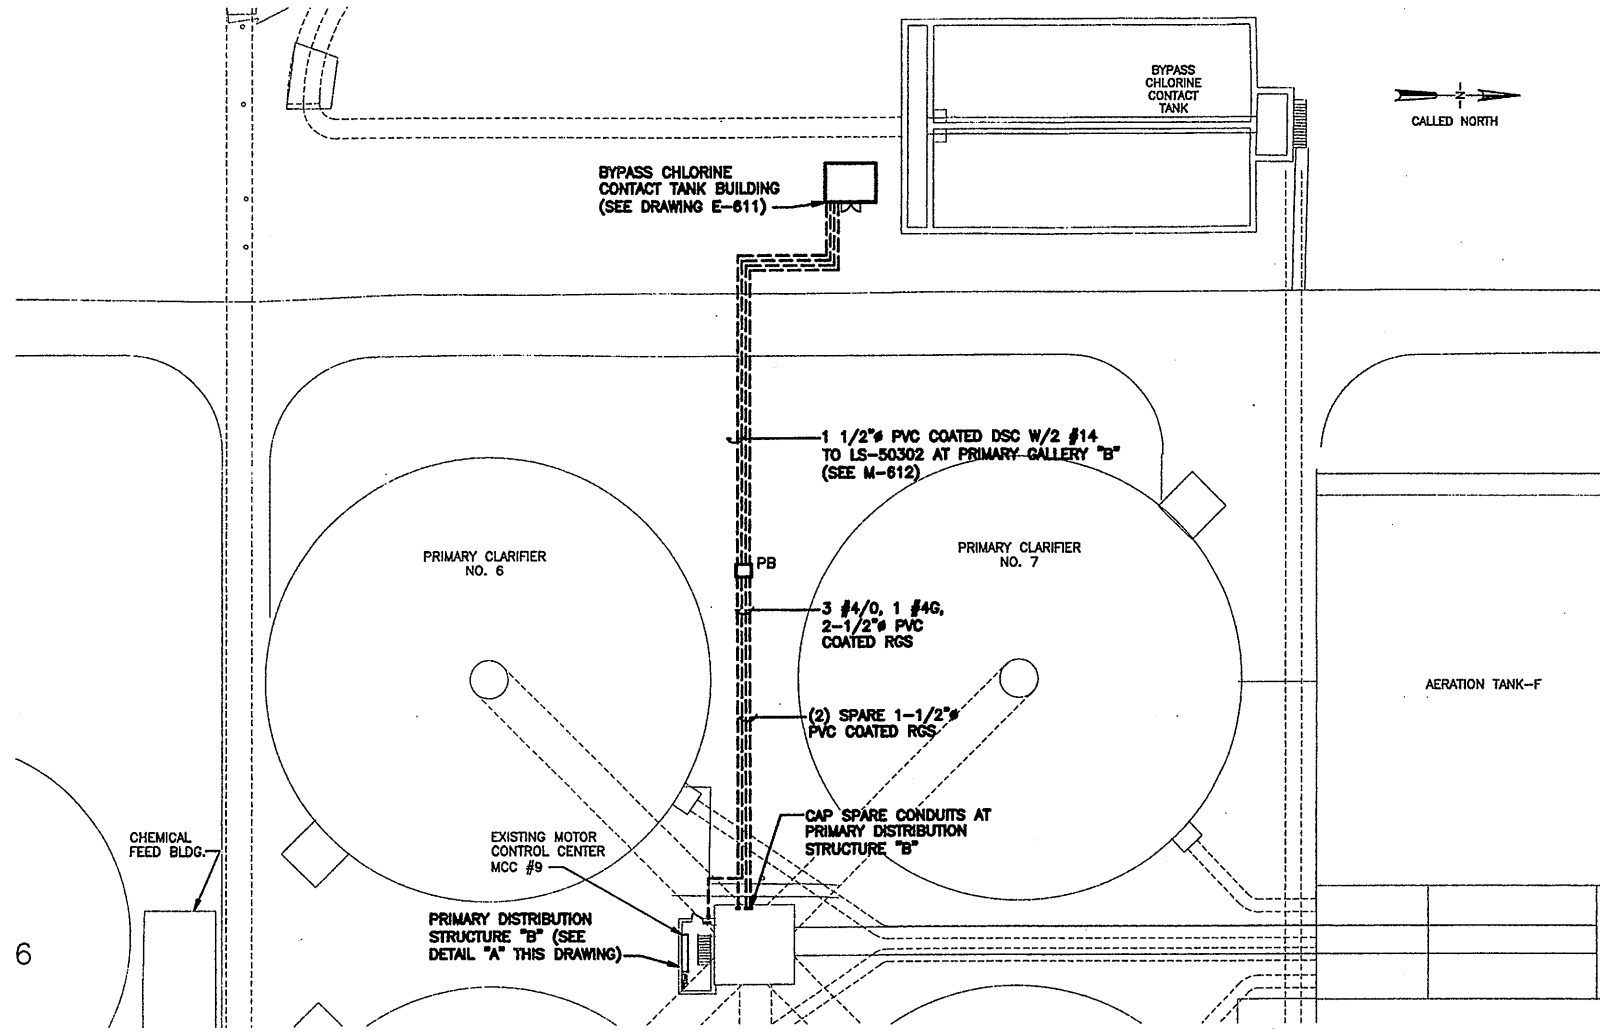


BYPASS CHLORINE CONTACT TANK POWER PLAN
SCALE: 1"=30'-0"

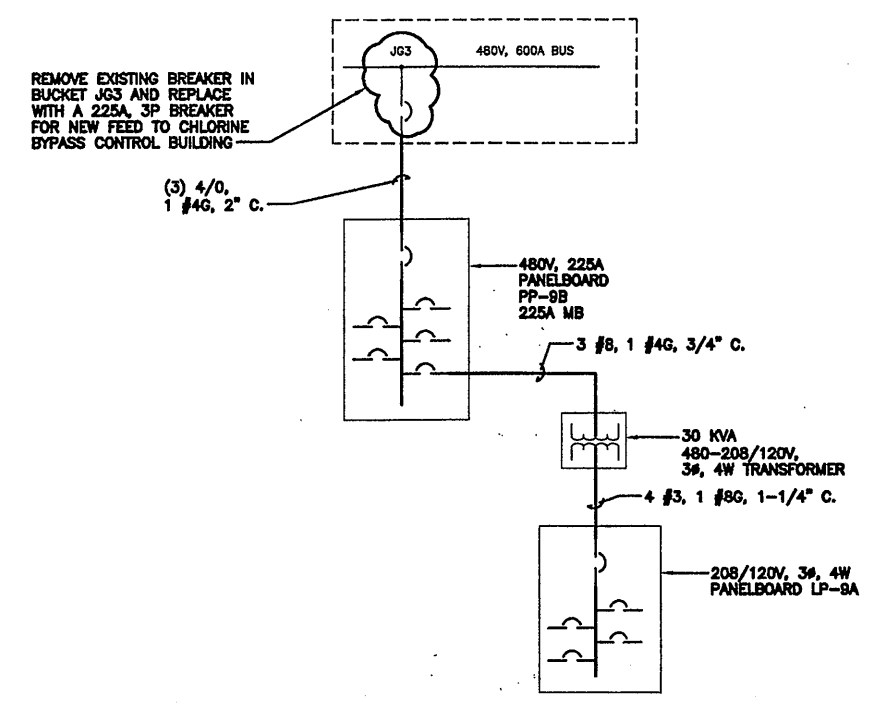


ONE-LINE DIAGRAM
NOT TO SCALE

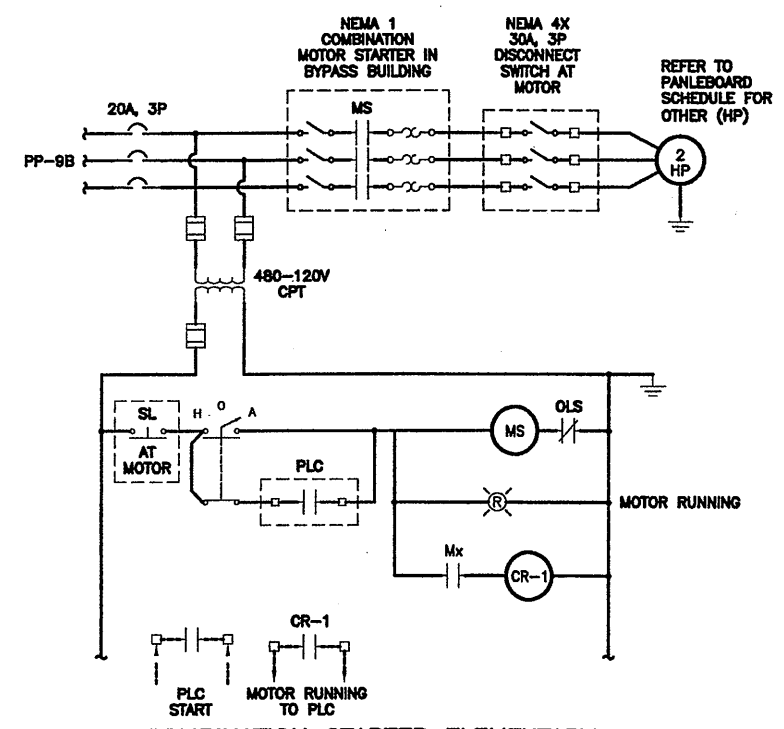

COMBINATION STARTER ELEMENTARY
NOT TO SCALE

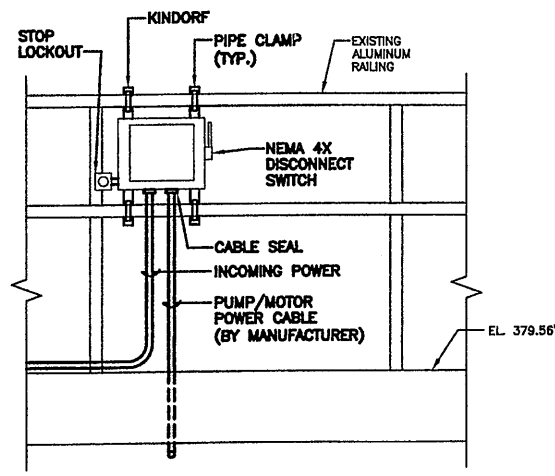

TYPICAL DISCONNECT SWITCH AND SL MOUNTING DETAIL
SCALE: 1/4"=1'-0"

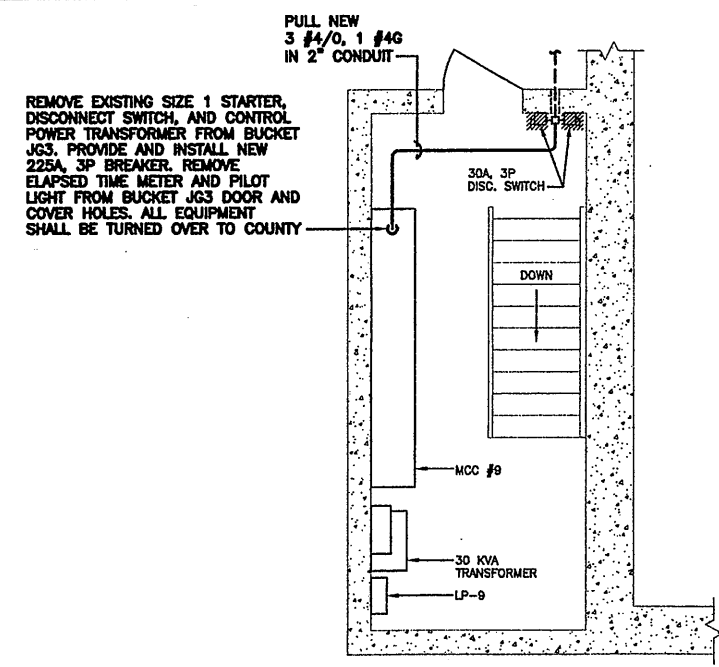


DETAIL "A"
SCALE: 1/4"=1'-0"

REMOVE EXISTING SIZE 1 STARTER, DISCONNECT SWITCH, AND CONTROL POWER TRANSFORMER FROM BUCKET JG3. PROVIDE AND INSTALL NEW 225A, 3P BREAKER. REMOVE ELAPSED TIME METER AND PILOT LIGHT FROM BUCKET JG3 DOOR AND COVER HOLES. ALL EQUIPMENT SHALL BE TURNED OVER TO COUNTY

RECORD DRAWING
THESE DRAWINGS HAVE BEEN REVISIONED TO REFLECT MAJOR CHANGES, IF ANY, WHICH OCCURRED DURING CONSTRUCTION. REVISIONS ARE BASED UPON INFORMATION SUPPLIED BY CONTRACTOR.
DATE: 10/21/05 PBR: [Signature]

THIS DRAWING WAS PREPARED AT THE SCALE INDICATED IN THE TITLE BLOCK. INACCURACIES IN THE STATED SCALE MAY BE INTRODUCED WHEN DRAWINGS ARE REPRODUCED BY ANY MEANS. USE THE GRAPHIC SCALE BAR IN THE TITLE BLOCK TO DETERMINE THE ACTUAL SCALE OF THIS DRAWING.

Layer: ON=*, OFF=*REF*
X: 0659GX02.DWG
4/4/01 EBL DCC
05503000/0659E612.DWG

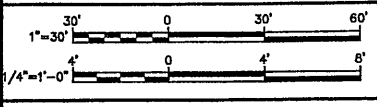

| No. | Date | Revisions | Init |
|-----|----------|---------------------|------|
| 0 | 4/20/01 | ISSUED FOR APPROVAL | TEL |
| 1 | | AS BID | |
| 2 | 10/31/05 | RECORD DRAWING | |


In charge of: TEL
Designed by: MEE
Drawn by: DCC
Checked by: WFH




ONONDAGA COUNTY • DEPARTMENT OF DRAINAGE AND SANITATION • SYRACUSE, NEW YORK
METROPOLITAN SYRACUSE WASTEWATER TREATMENT PLANT
STAGE III AMMONIA AND STAGE II PHOSPHORUS REMOVAL PROJECT
BYPASS CHLORINE CONTACT TANK
BYPASS CHLORINE CONTACT TANK
POWER PLAN AND DETAILS
ELECTRICAL



File Number: 00659
Date: APRIL 2001
E-612
[Signature]

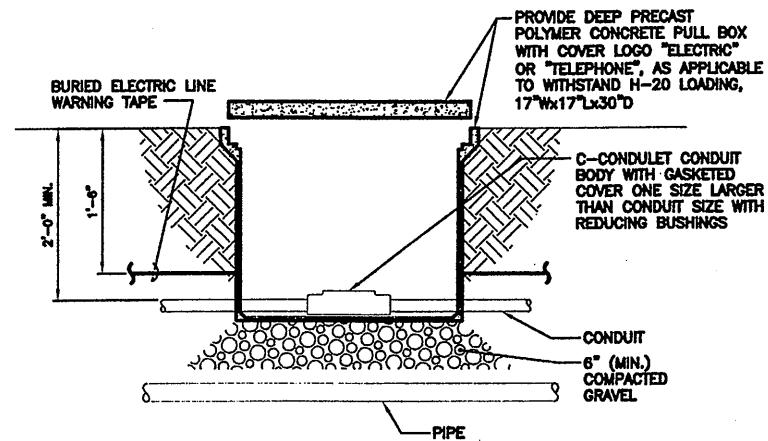

PULL BOX DETAIL (TYPICAL)

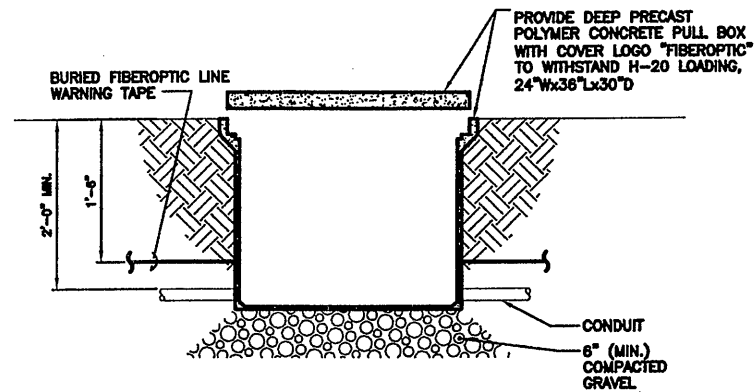

FIBEROPTIC PULL BOX DETAIL (TYP.)
NOT TO SCALE

| CIRCUIT BREAKER PANELBOARD - LP-9A | | | | | | | | | | SCHEDULE | | | |
|------------------------------------|--|-----------------------------|-----------|-------|-------|-------|---------------|-------|------------------|------------|---------------------------------|----------------------------------|----|
| LOCATION: | | BYPASS CL2 CONTACT BUILDING | | | | | FEED FROM: | | PANELBOARD PP-9A | | | | |
| MAIN BUS RATING: | | 225 | AMPERES | | | | 208/120 VOLTS | | 3 PHASE, 4 WIRE | | | | |
| MINIMUM SHORTCIRCUIT: | | 10,000 | AMPERES | | | | FEEDER CABLE | | 4 #3, 1 #8G | | | | |
| MAIN BREAKER TRIP: | | 100 | AMPERES | | | | SURFACE MTD | | | | | | |
| ESTIMATED CONNECTED LOAD: | | 3.736 | KVA | | | | | | | | | | |
| CB | | | | | | | CB | | | | | | |
| CKT. NO. | DESCRIPTION | AMPS/POLES | LOAD TYPE | KVA | PH-A | PH-B | PH-C | KVA | LOAD TYPE | AMPS/POLES | DESCRIPTION | CKT. NO. | |
| 1 | CL2 BYPASS BLDG VENTILATING (1/4 HP) | 20/1P | MOTOR | 0.698 | 0.998 | | | 0.300 | HEAT | 20/1P | NAH 503 HEAT TRACE | 2 | |
| 3 | AE/AIT-50306, CL2 RESIDUAL ANALYZER | 20/1P | INST | 0.150 | | 0.180 | | 0.030 | INST | 20/1P | PRESSURE TRANSDUCERS | 4 | |
| 5 | AE/AIT-50305, ORP (STRANTRON) PANEL | 20/1P | INST | 0.100 | | | 0.700 | 0.600 | INST | 20/1P | REMOTE I/O M12C | 8 | |
| 7 | CL2 BYPASS ULTRASONIC LEVEL (EXIST.) | 20/1P | INST | 0.100 | 0.200 | | | 0.100 | INST | 20/1P | FIT-50306, CL2 BYPASS FLOW TK 1 | 8 | |
| 9 | CL2 BYPASS TANK LIGHTS & RECP (EXIST.) | 20/1P | LT/RCPT | 0.960 | | 1.060 | | 0.100 | INST | 20/1P | FIT-50309, CL2 BYPASS FLOW TK 2 | 10 | |
| 11 | SPARE | 20/1P | | | | | | 0.600 | 0.600 | LT/RCPT | 20/1P | BYPASS CL2 BLDG LIGHTS & RECEIPT | 12 |
| 13 | SPARE | 20/1P | | | 0.000 | | | | | 20/1P | SPARE | 14 | |
| 15 | SPARE | 20/1P | | | | 0.000 | | | | 20/1P | SPARE | 16 | |
| 17 | SPARE | 20/1P | | | | | 0.000 | | | 20/1P | SPARE | 18 | |
| 19 | SPARE | 20/1P | | | 0.000 | | | | | 20/1P | SPARE | 20 | |
| 21 | SPARE | 20/1P | | | | 0.000 | | | | 20/1P | SPARE | 22 | |
| 23 | SPARE | 20/1P | | | | | 0.000 | | | 20/1P | SPARE | 24 | |
| 25 | SPARE | 20/1P | | | 0.000 | | | | | 20/1P | SPARE | 26 | |
| 27 | SPARE | 20/1P | | | | 0.000 | | | | 20/1P | SPARE | 28 | |
| 29 | SPARE | 20/1P | | | | | 0.000 | | | 20/1P | SPARE | 28 | |
| LOAD SUMMARY | | | | 2.008 | 1.196 | 1.240 | 1.300 | 1.730 | | | | | |
| PANEL TOTAL KVA: | | | | 3.736 | | | | | | | | | |

NOTES:

- ALL CONDUCTORS TO BE 2 #12, 1 #12G IN 3/4-INCH PVC COATED RIGID STEEL CONDUIT, UNLESS OTHERWISE INDICATED ON POWER PLAN.
- HEAT TRACE BRANCH CIRCUIT BREAKERS SHALL BE GFI TYPE.

| CIRCUIT BREAKER PANEL BOARD - PP-9B | | | | | | | | | | SCHEDULE | | |
|-------------------------------------|--------------------------------------|-----------------------------|-----------|--------|--------|--------|--------------------|--------|---------------|------------|-----------------------------------|----------|
| LOCATION: | | BYPASS CL2 CONTACT BUILDING | | | | | FEED FROM: | | MCC#9, JG3 | | | |
| MAIN BUS RATING: | | 225 | AMPERES | | | | 480 VOLT | | 3 PHASE 4WIRE | | | |
| MINIMUM SHORT CIRCUIT: | | 25,000 | AMPERES | | | | FEEDER CABLE SIZE: | | 3 #4, 1 #8G | | | |
| MAIN BREAKER TRIP: | | 225 | AMPERES | | | | NEMA 12 | | | | | |
| ESTIMATED CONNECTED LOAD: | | 44.56 | KVA | | | | SURFACE MOUNTED | | | | | |
| CB | | | | | | | CB | | | | | |
| CKT. NO. | DESCRIPTION | AMPS/POLES | LOAD TYPE | KVA | PH-A | PH-B | PH-C | KVA | LOAD TYPE | AMPS/POLES | DESCRIPTION | CKT. NO. |
| 1 | SPARE | 20 | | | 6.090 | | | | | 20 | SPARE | 2 |
| 3 | SPARE | 20 | | | | 6.090 | | | | 20 | SPARE | 4 |
| 5 | SPARE | 20 | | | | | 6.090 | | | 20 | SPARE | 6 |
| 7 | PANEL LP-9A SUB-FEED | 25 | LOAD | 1.196 | 1.196 | | | | | 20 | SPARE | 8 |
| 9 | SPARE | 20 | LOAD | 1.240 | | 1.240 | | | | 20 | SPARE | 10 |
| 11 | SPARE | 20 | LOAD | 1.300 | | | 1.300 | | | 20 | SPARE | 12 |
| 13 | BYPASS CL2 TK MIXER NO. 1 (4.4HP) | 20 | MOTOR | 2.104 | 4.208 | | | 2.104 | MOTOR | 20 | BYPASS CL2 TK MIXER NO. 2 (4.4HP) | 14 |
| 15 | SPARE | 20 | MOTOR | 2.104 | | 4.208 | | 2.104 | MOTOR | 20 | SPARE | 16 |
| 17 | SPARE | 20 | MOTOR | 2.104 | | | 4.208 | 2.104 | MOTOR | 20 | SPARE | 18 |
| 19 | SAMPLE PUMP NO. 1 (2 HP) | 20 | MOTOR | 0.941 | 1.882 | | | 0.941 | MOTOR | 20 | SAMPLE PUMP NO. 2 (2 HP) | 20 |
| 21 | SPARE | 20 | MOTOR | 0.941 | | 1.882 | | 0.941 | MOTOR | 20 | SPARE | 22 |
| 23 | SPARE | 20 | MOTOR | 0.941 | | | 1.882 | 0.941 | MOTOR | 20 | SPARE | 24 |
| 25 | SLUICE GATE NO. 1 (1.5 HP) | 20 | MOTOR | 0.830 | 1.660 | | | 0.830 | MOTOR | 20 | SLUICE GATE NO. 2 (1.5 HP) | 26 |
| 27 | SPARE | 20 | MOTOR | 0.830 | | 1.660 | | 0.830 | MOTOR | 20 | SPARE | 28 |
| 29 | SPARE | 20 | MOTOR | 0.830 | | | 1.660 | 0.830 | MOTOR | 20 | SPARE | 30 |
| 31 | ELECTRIC UNIT HEATER NO. 802 (7.5KW) | 20 | HEAT | 2.500 | 4.604 | | | 2.104 | MOTOR | 20 | INDUCTOR (7.5 HP) | 32 |
| 33 | SPARE | 20 | HEAT | 2.500 | | 4.604 | | 2.104 | MOTOR | 20 | SPARE | 34 |
| 35 | SPARE | 20 | HEAT | 2.500 | | | 4.604 | 2.104 | MOTOR | 20 | SPARE | 36 |
| 37 | ELECTRIC UNIT HEATER NO. 803 (7.5KW) | 20 | HEAT | 2.500 | 2.500 | | | | | 20 | SPARE | 38 |
| 39 | SPARE | 20 | HEAT | 2.500 | | 2.500 | | | | 20 | SPARE | 40 |
| 41 | SPARE | 20 | HEAT | 2.500 | | | 2.500 | | | 20 | SPARE | 42 |
| 43 | SPARE | 20 | | | 0.000 | | | | | 20 | SPARE | 44 |
| 45 | SPARE | 20 | | | | 0.000 | | | | 20 | SPARE | 46 |
| 47 | SPARE | 20 | | | | | 0.000 | | | 20 | SPARE | 48 |
| 49 | SPARE | 20 | | | 0.000 | | | | | 20 | SPARE | 50 |
| 51 | SPARE | 20 | | | | 0.000 | | | | 20 | SPARE | 52 |
| 53 | SPARE | 20 | | | | | 0.000 | | | 20 | SPARE | 54 |
| LOAD SUMMARY | | | | 26.625 | 14.854 | 14.854 | 14.854 | 17.937 | | | | |
| PANEL TOTAL KVA: | | | | 44.562 | | | | | | | | |

NOTE:

- ALL CONDUCTORS TO BE 3 #12, 1 #12G IN 3/4-INCH PVC COATED RIGID STEEL CONDUIT, UNLESS OTHERWISE INDICATED ON POWER PLAN.

RECORD DRAWING

THESE DRAWINGS HAVE BEEN REVIEWED TO REFLECT MAJOR CHANGES, IF ANY, WHICH OCCURRED DURING CONSTRUCTION. REVISIONS ARE BASED UPON INFORMATION SUPPLIED BY CONTRACTOR.

DWG: 10/21/05 PIR: [Signature]

THIS DRAWING WAS PREPARED AT THE SCALE INDICATED IN THE TITLE BLOCK. INACCURACIES IN THE STATED SCALE MAY BE INTRODUCED WHEN DRAWINGS ARE REPRODUCED BY ANY MEANS. USE THE GRAPHIC SCALE BAR IN THE TITLE BLOCK TO DETERMINE THE ACTUAL SCALE OF THIS DRAWING.

Layer: ON=*, OFF=*REF*

4/4/01 BBL DCC
05503000/0859E613.DWG

| No. | Date | Revisions | Init |
|-----|----------|---------------------|-------------|
| 0 | 4/20/01 | ISSUED FOR APPROVAL | [Signature] |
| 1 | | AS BID | |
| 2 | 10/31/05 | RECORD DRAWING | |


NO ALTERATIONS PERMITTED HEREON EXCEPT AS PROVIDED UNDER SECTION 7209 SUBDIVISION 2 OF THE NEW YORK STATE EDUCATION LAW

In charge of TEL
Designed by MEE
Drawn by DCC
Checked by WFH

ENVIRONMENTAL ENGINEERING ASSOCIATES, LLP
SYRACUSE, NEW YORK


ONONDAGA COUNTY • DEPARTMENT OF DRAINAGE AND SANITATION • SYRACUSE, NEW YORK
METROPOLITAN SYRACUSE WASTEWATER TREATMENT PLANT
STAGE III AMMONIA AND STAGE II PHOSPHORUS REMOVAL PROJECT
CHLORINE BYPASS BUILDING
PANEL SCHEDULES AND DETAIL
ELECTRICAL

File Number: 00659
Date: APRIL 2001
E-613
[Professional Engineer Seal]

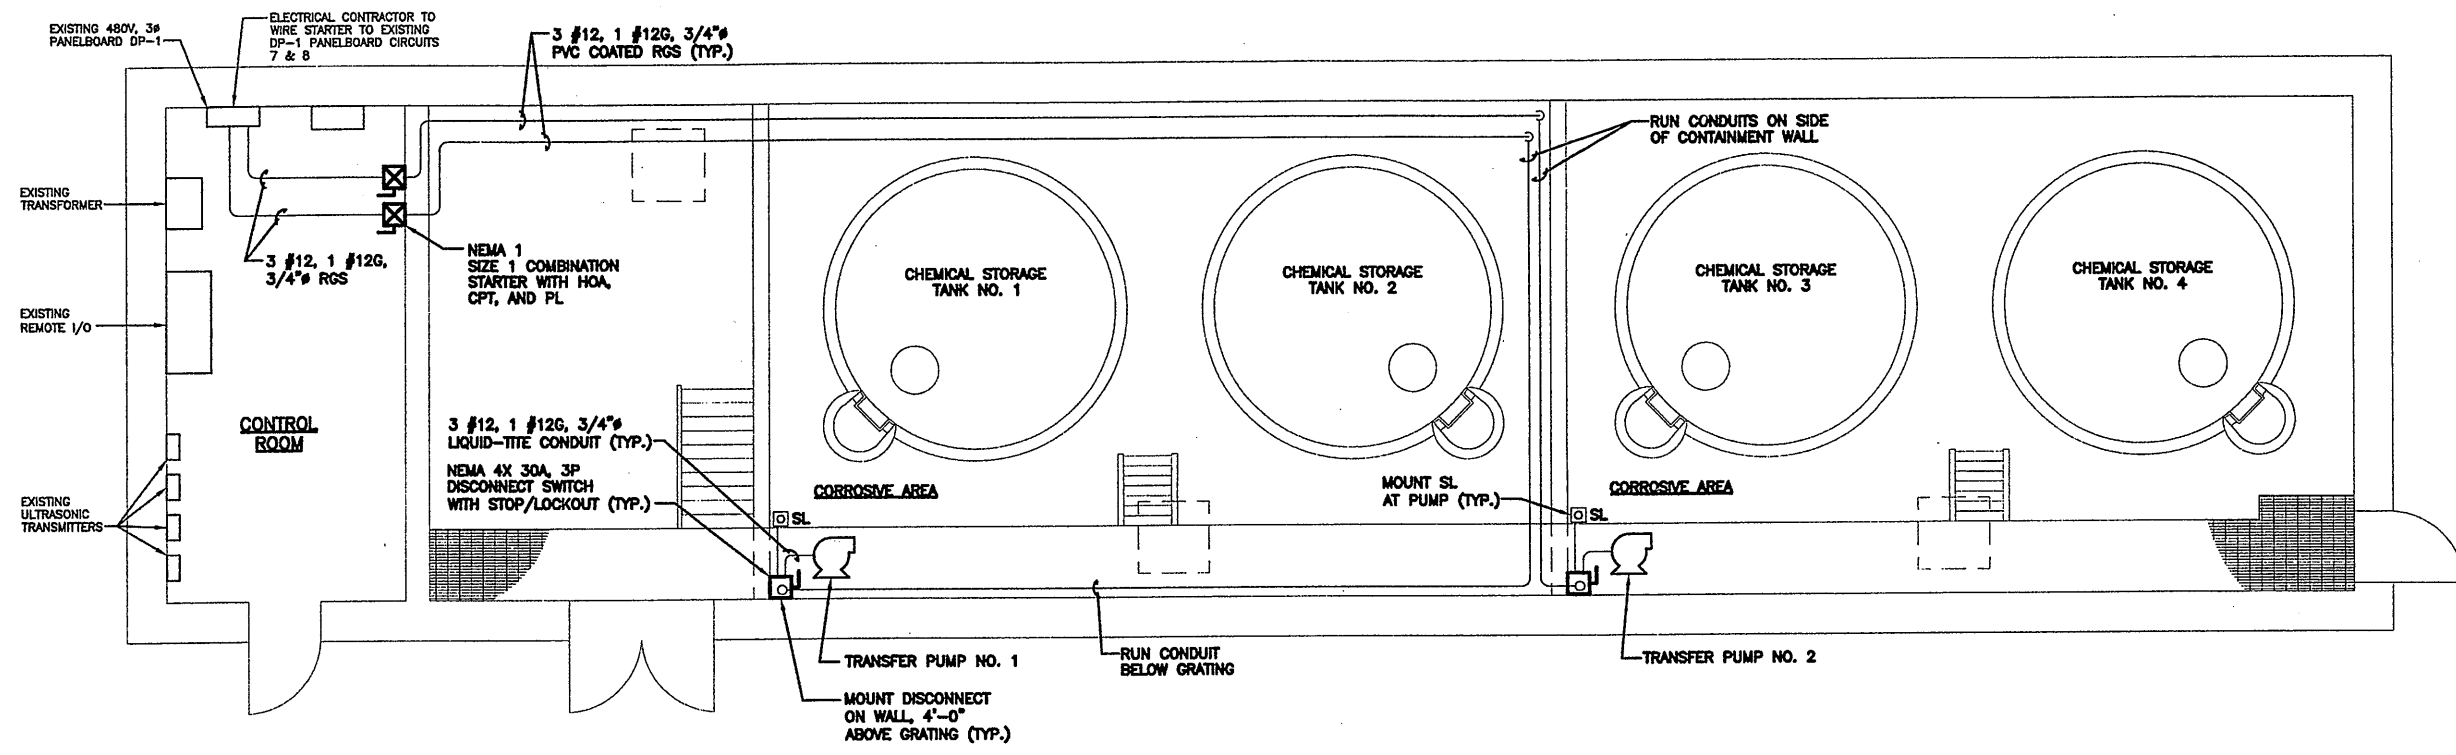

CHEMICAL BUILDING B POWER PLAN
SCALE=1/4"=1'-0"

Layer: ON=*, OFF=REF
X: 0659X051.DWG
4/4/01 BBL DCC
05503000/0659E614.DWG

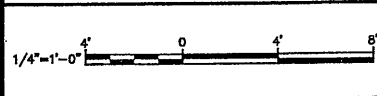

NO ALTERATIONS PERMITTED HEREON EXCEPT AS PROVIDED UNDER SECTION 7209 SUBDIVISION 2 OF THE NEW YORK STATE EDUCATION LAW

| No. | Date | Revisions | Init |
|-----|----------|---------------------|------|
| 0 | 4/20/01 | ISSUED FOR APPROVAL | Lk |
| 1 | | AS BID | |
| 2 | 10/31/05 | RECORD DRAWING | |

In charge of TEL
Designed by MEE
Drawn by DCC
Checked by WFH



ONONDAGA COUNTY • DEPARTMENT OF DRAINAGE AND SANITATION • SYRACUSE, NEW YORK
METROPOLITAN SYRACUSE WASTEWATER TREATMENT PLANT
STAGE III AMMONIA AND STAGE II PHOSPHORUS REMOVAL PROJECT
**CHEMICAL BUILDING B
POWER PLAN**






File Number
00659
Date
APRIL 2001
Wampel

E-614

RECORD DRAWING
THESE DRAWINGS HAVE BEEN REVISIONED TO REFLECT MAJOR CHANGES IF ANY, WHICH OCCURRED DURING CONSTRUCTION. REVISIONS ARE BASED UPON INFORMATION SUPPLIED BY CONTRACTOR.
DATE *10/26/05* FOR *Wampel*

THIS DRAWING WAS PREPARED AT THE SCALE INDICATED IN THE TITLE BLOCK. INACCURACIES IN THE STATED SCALE MAY BE INTRODUCED WHEN DRAWINGS ARE REPRODUCED BY ANY MEANS. USE THE GRAPHIC SCALE BAR IN THE TITLE BLOCK TO DETERMINE THE ACTUAL SCALE OF THIS DRAWING.

ELECTRICAL

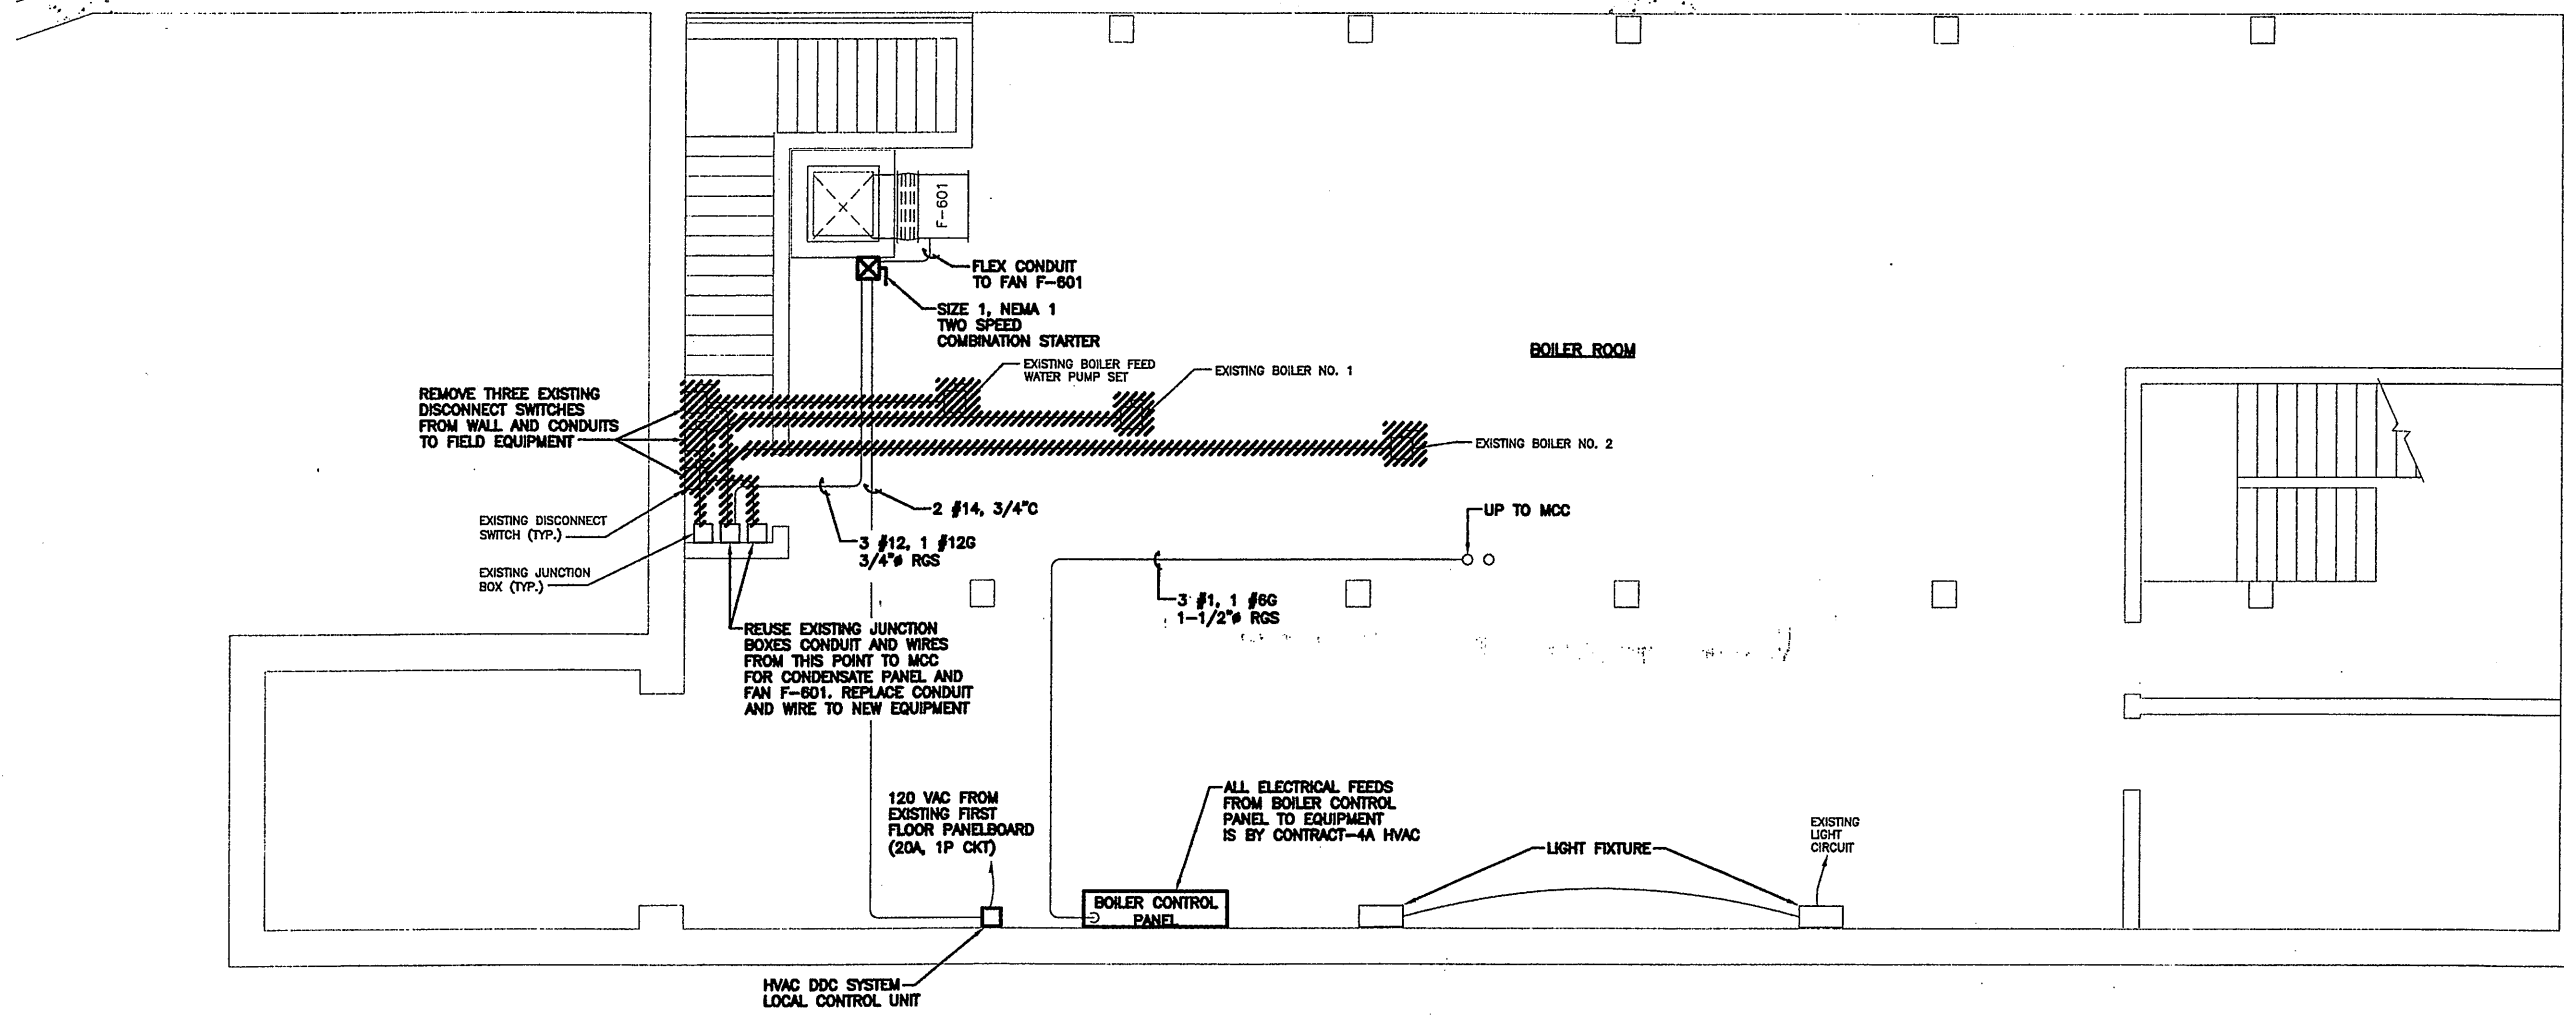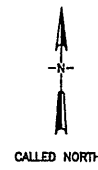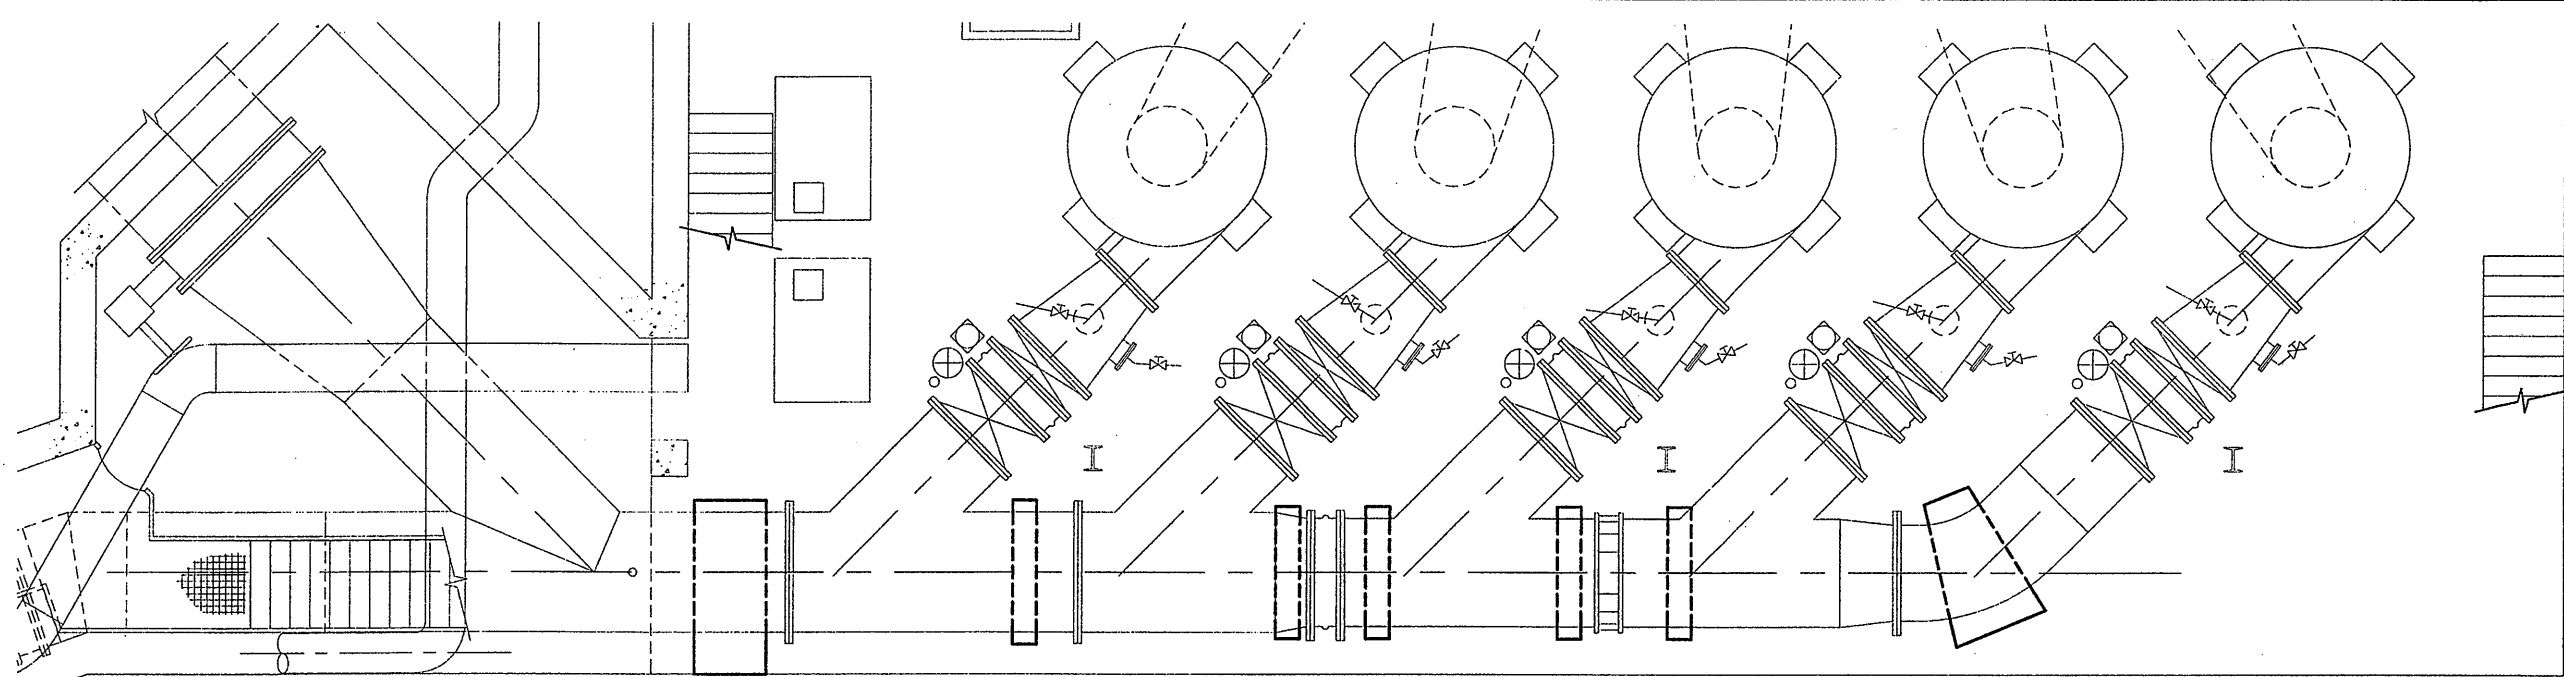


LOW LIFT PUMP STATION BASEMENT
SCALE: 1/4"=1'-0"

RECORD DRAWING
THESE CHANGES HAVE BEEN MADE TO REFLECT
MAJOR CHANGES OF ANY WHICH OCCURRED DURING
CONSTRUCTION. REVISIONS ARE BASED UPON
INFORMATION SUPPLIED BY CONTRACTOR.
DATE: 10/24/05 FOR: [Signature]


THIS DRAWING WAS PREPARED AT THE SCALE INDICATED IN THE
TITLE BLOCK. INACCURACIES IN THE STATED SCALE MAY BE
INTRODUCED WHEN DRAWINGS ARE REPRODUCED BY ANY MEANS.
USE THE GRAPHIC SCALE BAR IN THE TITLE BLOCK TO
DETERMINE THE ACTUAL SCALE OF THIS DRAWING.

Layer: ON=*, OFF=REF
N: 0659X051.DWG
4/4/01 BBL DCC
05503000/0659E615.DWG

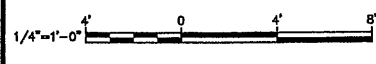

| No. | Date | Revisions | Init |
|-----|----------|---------------------|-------------|
| 0 | 4/20/01 | ISSUED FOR APPROVAL | [Signature] |
| 1 | | AS BID | |
| 2 | 10/31/05 | RECORD DRAWING | |

In charge of --- TEL ---
Designed by --- MEE ---
Drawn by --- DCC ---
Checked by --- WFH ---




ENVIRONMENTAL ENGINEERING ASSOCIATES, LLP
 SYRACUSE, NEW YORK

ONONDAGA COUNTY • DEPARTMENT OF DRAINAGE AND SANITATION • SYRACUSE, NEW YORK
 METROPOLITAN SYRACUSE WASTEWATER TREATMENT PLANT
 STAGE III AMMONIA AND STAGE II PHOSPHORUS REMOVAL PROJECT
LOW LIFT PUMP STATION BASEMENT
 ELECTRICAL




File Number
00659
Date
APRIL 2001
E-615
[Signature]

NO ALTERATIONS PERMITTED HEREON EXCEPT
AS PROVIDED UNDER SECTION 7209 SUBDIVISION
2 OF THE NEW YORK STATE EDUCATION LAW

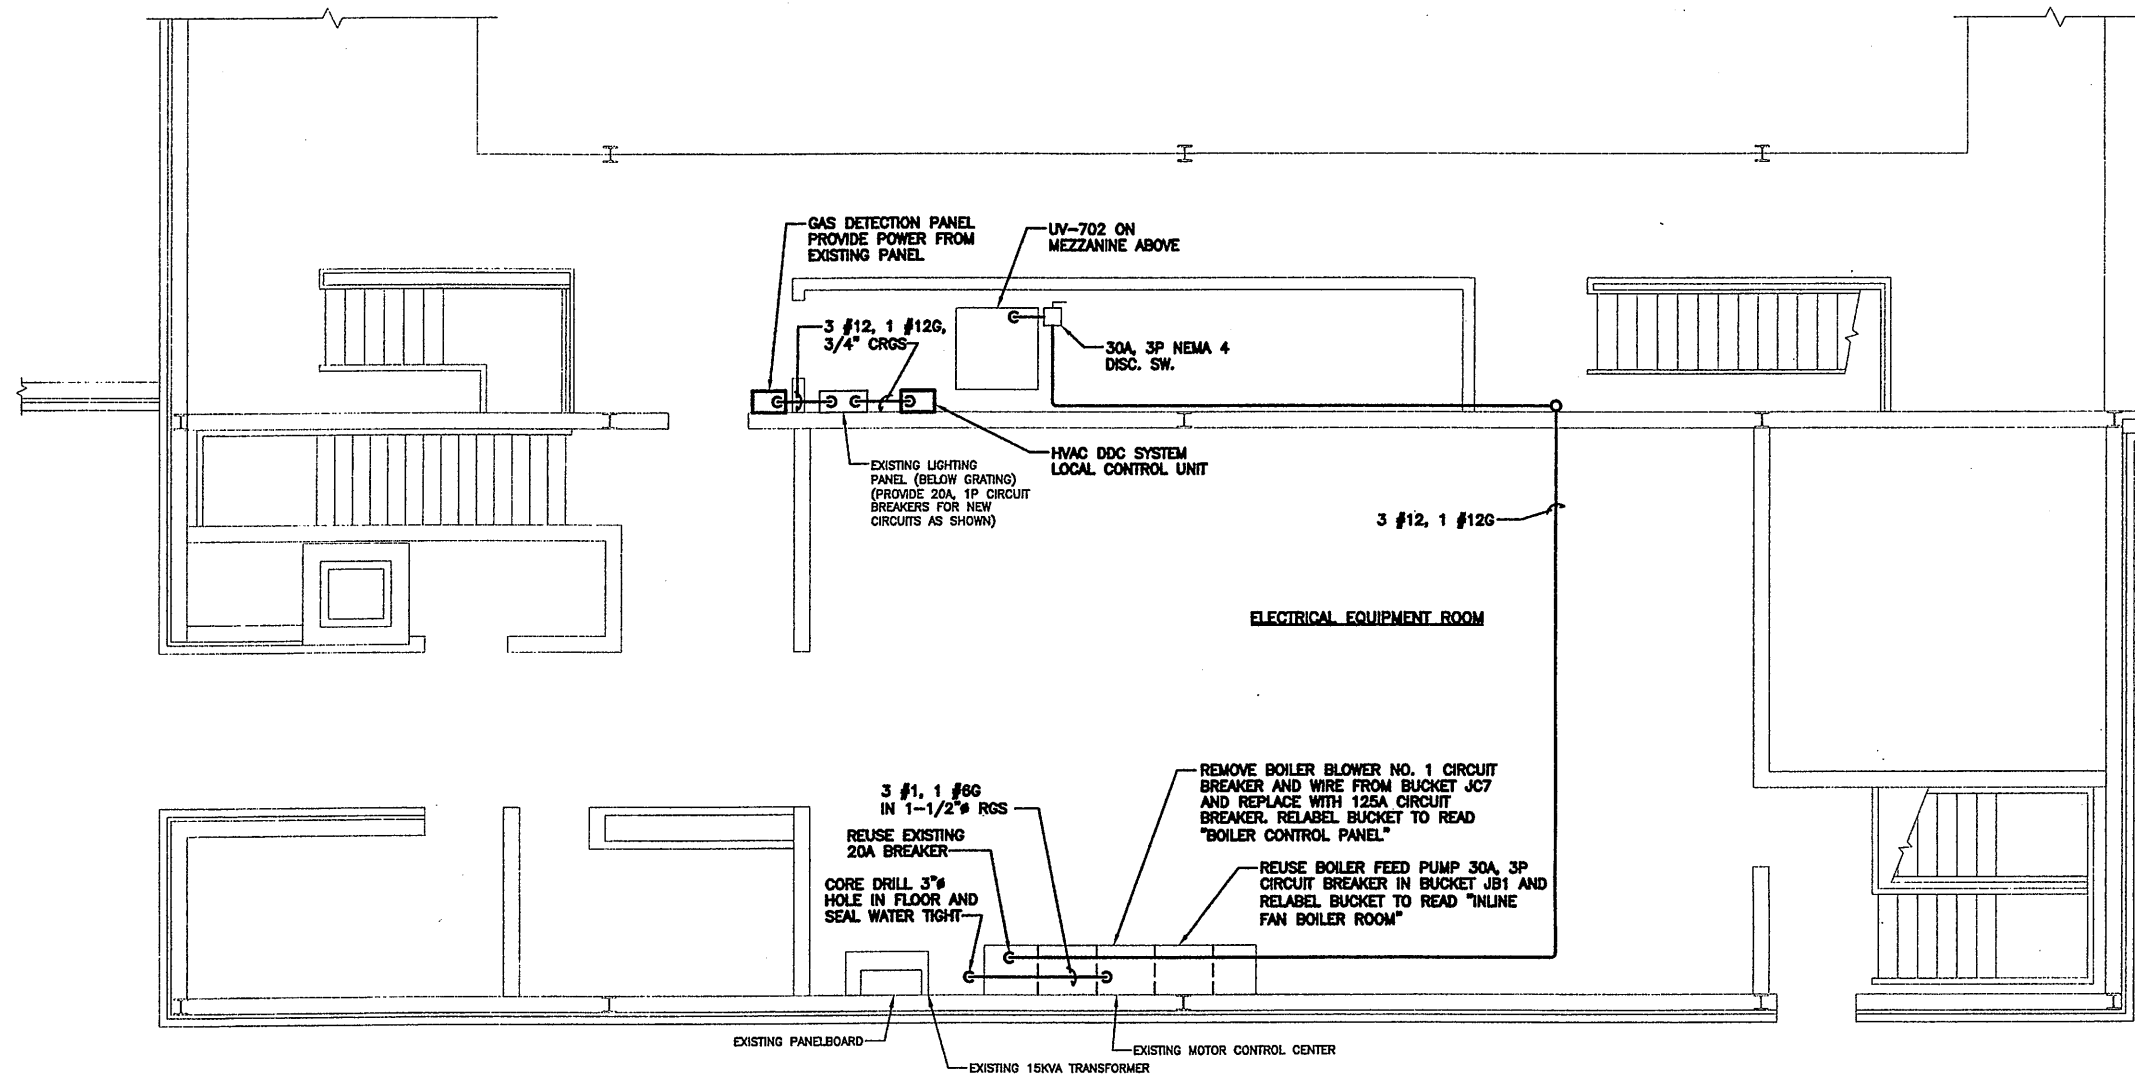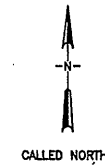

LOW LIFT PUMP STATION FIRST FLOOR
SCALE: 1/4"=1'-0"

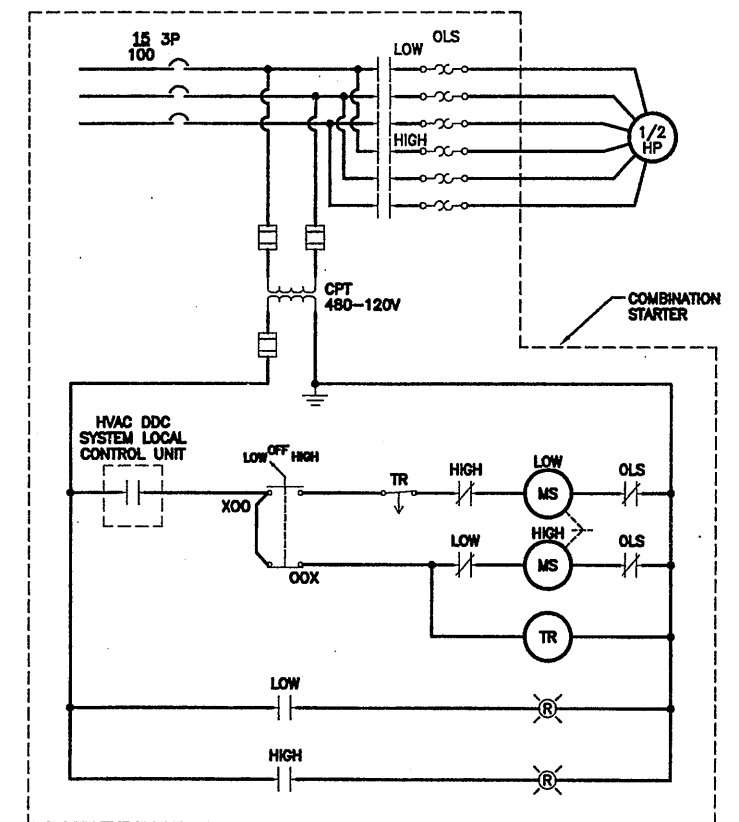

EXHAUST FAN F-601
NOT TO SCALE


RECORD DRAWING

THESE DRAWINGS HAVE BEEN REVISIONED TO REFLECT MAJOR CHANGES, IF ANY, WHICH OCCURRED DURING CONSTRUCTION. REVISIONS ARE BASED UPON INFORMATION SUPPLIED BY CONTRACTOR.

DATE: 10/20/05 FOR: Campbell

THIS DRAWING WAS PREPARED AT THE SCALE INDICATED IN THE TITLE BLOCK. INACCURACIES IN THE STATED SCALE MAY BE INTRODUCED WHEN DRAWINGS ARE REPRODUCED BY ANY MEANS. USE THE GRAPHIC SCALE BAR IN THE TITLE BLOCK TO DETERMINE THE ACTUAL SCALE OF THIS DRAWING.

Layer: ON=*, OFF=REF
X: 0659X051.DWG
4/4/01 BSL DCC
05503000/0659E616.DWG

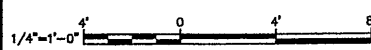

| No. | Date | Revisions | Init |
|-----|----------|---------------------|------|
| 0 | 4/20/01 | ISSUED FOR APPROVAL | LJK |
| 1 | | AS BID | |
| 2 | 10/31/05 | RECORD DRAWING | |

In charge of --- TEL
Designed by --- MEE
Drawn by --- DCC
Checked by --- WFH



ONONDAGA COUNTY • DEPARTMENT OF DRAINAGE AND SANITATION • SYRACUSE, NEW YORK
METROPOLITAN SYRACUSE WASTEWATER TREATMENT PLANT
STAGE III AMMONIA AND STAGE II PHOSPHORUS REMOVAL PROJECT
LOW LIFT PUMP STATION
LOW LIFT PUMP STATION FIRST FLOOR




File Number
00659

Date
APRIL 2001

E-616

Campbell

ELECTRICAL

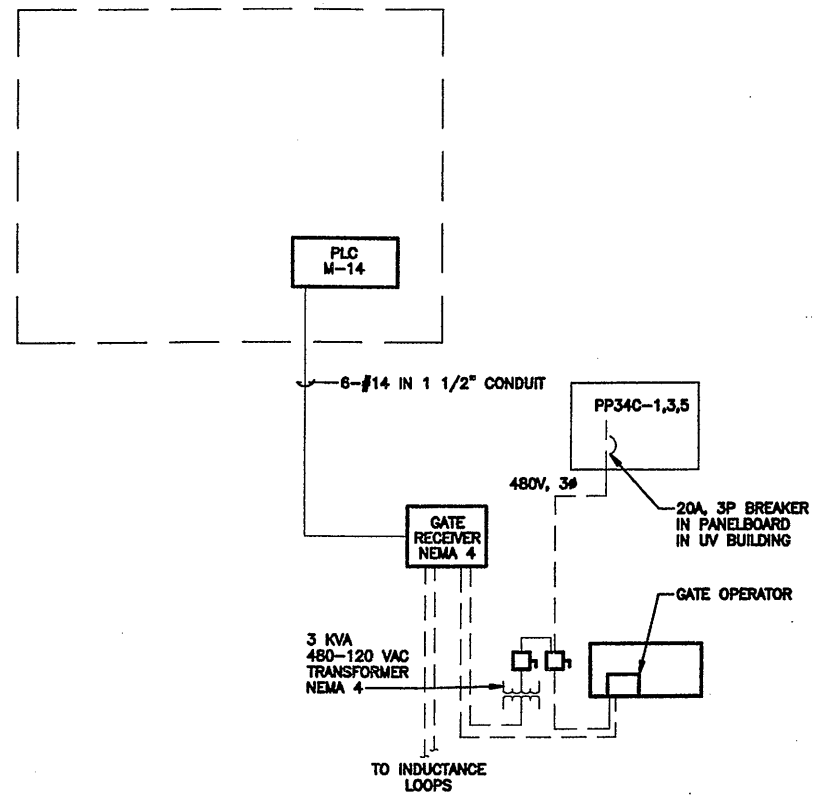

GATE OPERATOR SCHEMATIC
NOT TO SCALE

Layer: ON=*; OFF=*REF*
4/4/01 BBL DCC
05503000/0859E617.DWG

RECORD DRAWING

THESE DRAWINGS HAVE BEEN REVIEWED TO REFLECT
MATERIAL CHANGES, IF ANY, WHICH OCCURRED DURING
CONSTRUCTION. REVISIONS ARE BASED UPON
INFORMATION SUPPLIED BY CONTRACTOR.

DATE: 10/21/05 FOR: *[Signature]*

THIS DRAWING WAS PREPARED AT THE SCALE INDICATED IN THE
TITLE BLOCK. INACCURACIES IN THE STATED SCALE MAY BE
INTRODUCED WHEN DRAWINGS ARE REPRODUCED BY ANY MEANS.
USE THE GRAPHIC SCALE BAR IN THE TITLE BLOCK TO
DETERMINE THE ACTUAL SCALE OF THIS DRAWING.

NOT TO SCALE

NO ALTERATIONS PERMITTED HEREON EXCEPT
AS PROVIDED UNDER SECTION 7209 SUBDIVISION
2 OF THE NEW YORK STATE EDUCATION LAW

| No. | Date | Revisions | Init |
|-----|----------|---------------------|--------------------|
| 0 | 4/20/01 | ISSUED FOR APPROVAL | <i>[Signature]</i> |
| 1 | | AS BID | |
| 2 | 10/31/05 | RECORD DRAWING | |

In charge of --- TEL ---
Designed by --- MEE ---
Drawn by --- DCC ---
Checked by --- WFH ---

ENVIRONMENTAL ENGINEERING ASSOCIATES, LLP
SYRACUSE, NEW YORK

ONONDAGA COUNTY • DEPARTMENT OF DRAINAGE AND SANITATION • SYRACUSE, NEW YORK
METROPOLITAN SYRACUSE WASTEWATER TREATMENT PLANT
STAGE III AMMONIA AND STAGE II PHOSPHORUS REMOVAL PROJECT

GATE OPERATOR SCHEMATIC


ELECTRICAL

File Number
00659

Date
APRIL 2001

[Signature]


E-617

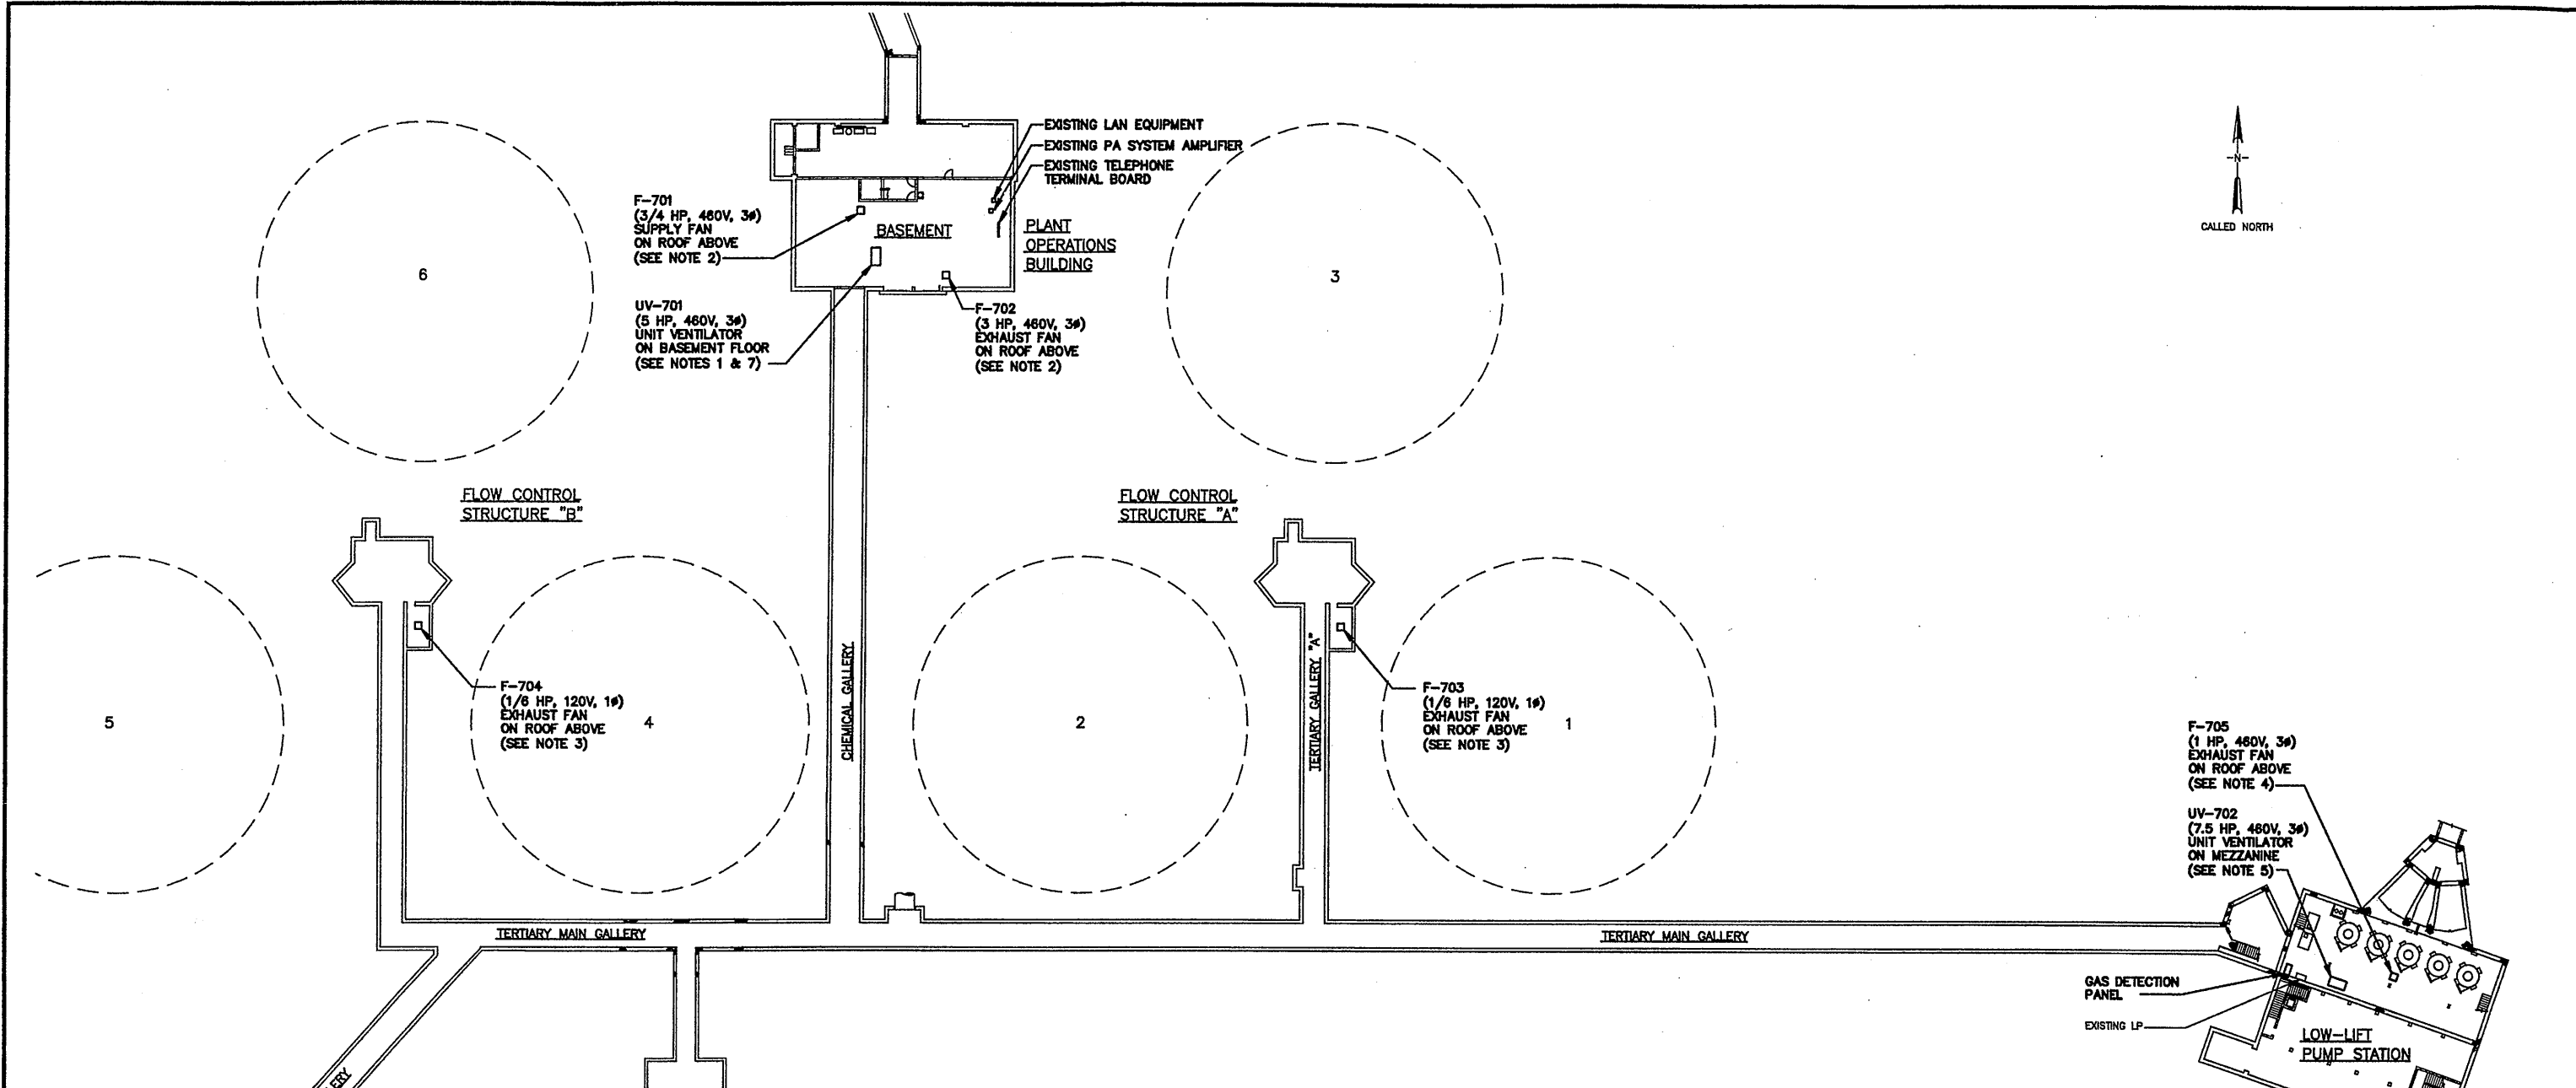

NOTES:

- CONNECT EXISTING DISCONNECT TO NEW UV-701. PROVIDE 3/12, 1/12G IN 3/4" FROM EXISTING DISCONNECT SWITCH TO UV-701. REPLACE EXISTING MOTOR STARTER OVERLOAD HEATER ELEMENTS AS NECESSARY. UNIT VENTILATOR UV-701 SHALL BE INTERLOCKED WITH FAN F-701. PROVIDE DUCT SMOKE DETECTOR CONNECTED TO EXISTING UV-701 STARTER TO STOP UV-701 UPON DETECTION OF SMOKE. PROVIDE 4/14 IN 3/4" FROM EXISTING UV-701 STARTER TO F-701 COMBINATION STARTER FOR INTERLOCK AND TO DUCT SMOKE DETECTOR.
- PROVIDE NEW NEMA 4, SIZE 1 COMBINATION STARTERS FOR FANS F-701 AND F-702. STARTERS SHALL BE FED FROM EXISTING MCC #18 IN PLANT OPERATIONS BUILDING FIRST FLOOR, ELECTRICAL ROOM. FURNISH AND INSTALL TWO NEW 15A, 3P BREAKERS IN MCC COMPARTMENTS. PROVIDE 3/12, 1/12G IN 3/4" FROM MCC #18 TO STARTERS AND FROM STARTERS TO FANS.
- PROVIDE POWER FOR EXHAUST FANS F-703 AND F-704 IN FLOW CONTROL STRUCTURES "A" AND "B". FEED POWER FROM EXISTING PANELBOARDS TO MANUAL STARTER AND WIRE TO MOTOR AND FAN DAMPER ACTUATOR ON ROOF. CIRCUITS SHALL BE 20A/1P WITH 2/12, 1/12G, IN 3/4"
- PROVIDE SIZE 1 STARTER IN EXISTING MCC #26 ON LOW LIFT PUMP STATION FIRST FLOOR FOR EXHAUST FAN F-705. PROVIDE 3/12, 1/12G, 4/14 IN 3/4" FROM MCC #26 TO F-705, STOP LOCKOUT, STOP/START AND DAMPER ACTUATOR.
- PROVIDE SIZE 1 STARTER IN EXISTING MCC #26 ON LOW LIFT PUMP STATION FIRST FLOOR FOR UNIT VENTILATOR UV-702. PROVIDE 3/12, 1/12G, 3/14 FROM MCC #26 TO UV-702, STOP LOCKOUT, HOA, DUCT SMOKE DETECTOR AND HVAC DDC SYSTEM LOCAL CONTROL UNIT.
- PROVIDE CONNECTION OF UV-701 AND UV-702 DUCT SMOKE DETECTORS TO EXISTING FIRE ALARM SYSTEMS IN THE PLANT OPERATIONS BUILDING AND LOW LIFT PUMP STATION RESPECTIVELY. CONDUIT AND CONDUCTOR SHALL BE PER EXISTING FIRE ALARM SYSTEM MANUFACTURER'S REQUIREMENTS. PROVIDE COORDINATION WITH EXISTING FIRE ALARM SYSTEM MANUFACTURERS.
- PROVIDE 120VAC TO UV-701 CONTROL PANEL FROM EXISTING PANELBOARD IN PLANT OPERATIONS BUILDING BASEMENT. CIRCUIT SHALL BE 20A/1P WITH 2/12, 1/12G IN 3/4".

Layer: ON="; OFF="REF"
 4/4/01 BBL DCC
 05503000/05503E701.dwg

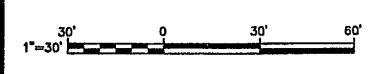

| No. | Date | Revisions | Init |
|-----|----------|---------------------|------|
| 0 | 4/20/01 | ISSUED FOR APPROVAL | TEL |
| 1 | | AS BID | |
| 2 | 10/31/05 | RECORD DRAWING | |

In charge of --- TEL ---
 Designed by --- TEL ---
 Drawn by --- DCC ---
 Checked by --- WFH ---

ENVIRONMENTAL ENGINEERING ASSOCIATES, LLP
 SYRACUSE, NEW YORK

ONONDAGA COUNTY • DEPARTMENT OF DRAINAGE AND SANITATION • SYRACUSE, NEW YORK
 METROPOLITAN SYRACUSE WASTEWATER TREATMENT PLANT
 STAGE III AMMONIA AND STAGE II PHOSPHORUS REMOVAL PROJECT

PARTIAL GALLERY PLAN


ELECTRICAL

RECORD DRAWING
 THESE CHANGES HAVE BEEN REVISED TO REFLECT MAJOR CHANGES, IF ANY, WHICH OCCURRED DURING CONSTRUCTION. REVISIONS ARE BASED UPON INFORMATION SUPPLIED BY CONTRACTOR.
 DATE 10/21/05 FOR [Signature]


THIS DRAWING WAS PREPARED AT THE SCALE INDICATED IN THE TITLE BLOCK. INACCURACIES IN THE STATED SCALE MAY BE INTRODUCED WHEN DRAWINGS ARE REPRODUCED BY ANY MEANS. USE THE GRAPHIC SCALE BAR IN THE TITLE BLOCK TO DETERMINE THE ACTUAL SCALE OF THIS DRAWING.




File Number
 00659
 Date
 APRIL 2001
 [Signature]
E-701

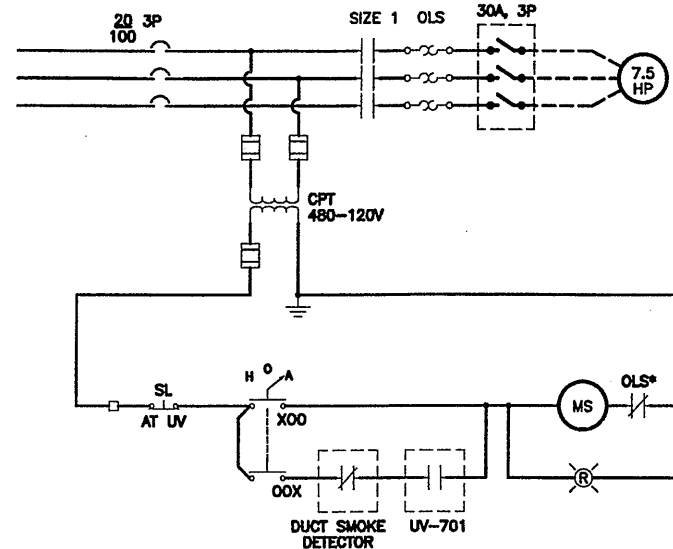


UNIT VENTILATOR UV-702
NOT TO SCALE

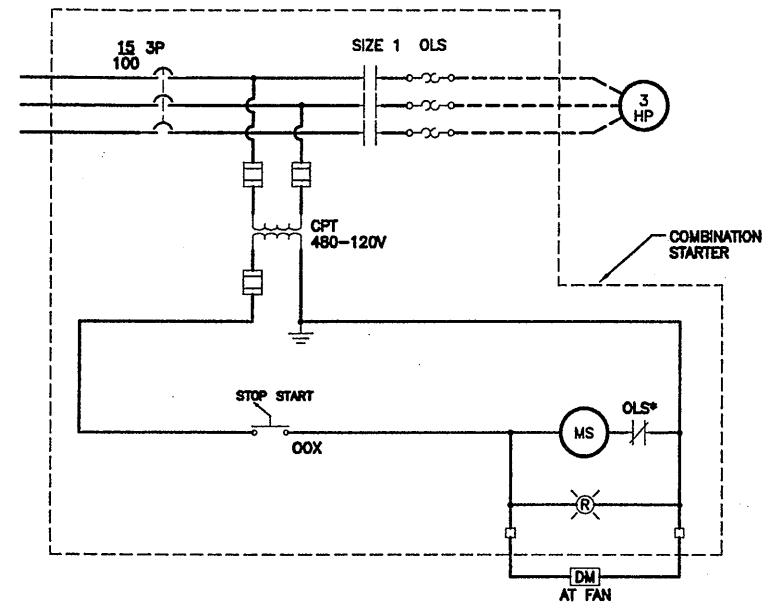

EXHAUST FAN F-702
NOT TO SCALE

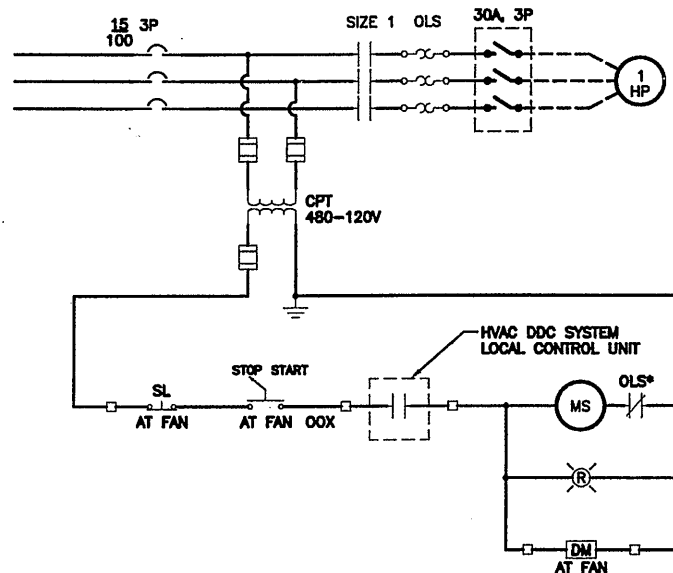

EXHAUST FAN F-705
NOT TO SCALE

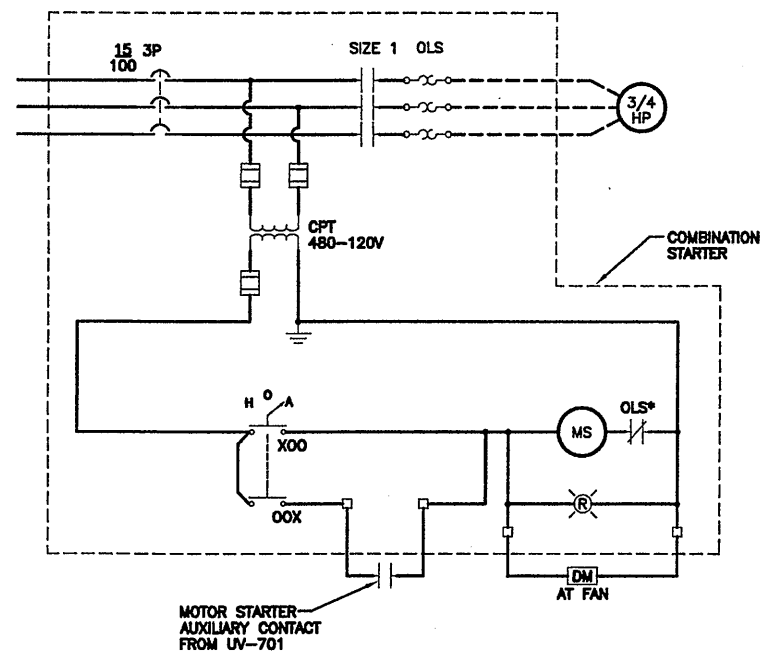

SUPPLY FAN F-701
NOT TO SCALE

Layer: ON=*, OFF=*REF*
04/03/01 OBG CRV
05503000/0659E214.DWG

RECORD DRAWING

THESE CHANGES HAVE BEEN MADE TO REFLECT
MAJOR CHANGES, IF ANY, WHICH OCCURRED DURING
CONSTRUCTION. REVISIONS ARE BASED UPON
INFORMATION SUPPLIED BY CONTRACTOR.

DATE: 10/31/05 FOR: R. Campbell

THIS DRAWING WAS PREPARED AT THE SCALE INDICATED IN THE
TITLE BLOCK. INACCURACIES IN THE STATED SCALE MAY BE
INTRODUCED WHEN DRAWINGS ARE REPRODUCED BY ANY MEANS.
USE THE GRAPHIC SCALE BAR IN THE TITLE BLOCK TO
DETERMINE THE ACTUAL SCALE OF THIS DRAWING.

NOT TO SCALE

| No. | Date | Revisions | Init |
|-----|----------|----------------|------|
| 0 | | AS BID | PLD |
| 1 | 10/31/05 | RECORD DRAWING | |

In charge of PLD
Designed by JJC
Drawn by CRV
Checked by PLD



ONONDAGA COUNTY • DEPARTMENT OF DRAINAGE AND SANITATION • SYRACUSE, NEW YORK
METROPOLITAN SYRACUSE WASTEWATER TREATMENT PLANT
STAGE III AMMONIA AND STAGE II PHOSPHORUS REMOVAL PROJECT
BAF COMPLEX
BAF ELEMENTARY DIAGRAMS



File Number
00659
Date
JULY 2001

E-702

ELECTRICAL

NO ALTERATIONS PERMITTED HEREON EXCEPT
AS PROVIDED UNDER SECTION 7209 SUBDIVISION
2 OF THE NEW YORK STATE EDUCATION LAW

SYMBOLS

| | |
|--|---------------------------------------|
| | ROOF VENTILATOR, EXHAUST |
| | RELIEF VENT - SUPPLY |
| | THERMOSTAT |
| | MOTOR OPERATOR |
| | ROUND DUCT PERFORATED SUPPLY DIFFUSER |
| | WALL PROPELLER FAN |
| | DUCT SECTION - NEGATIVE PRESSURE |
| | DUCT SECTION - EXHAUST HIDDEN |
| | DUCT SECTION - POSITIVE PRESSURE |
| | DUCT SECTION - SUPPLY HIDDEN |
| | MANUAL VOLUME DAMPER |
| | MOTOR OPERATED VOLUME DAMPER |
| | UNIT HEATER |
| | FIRE DAMPER |
| | VARIABLE AIR VOLUME BOX |
| | SUPPLY AIR REGISTER |
| | SUPPLY AIR DIFFUSER |
| | RETURN AIR REGISTER |
| | FLEX DUCT |
| | DIRECTION OF FLOW |
| | REDUCER / INCREASER |
| | TURNING VANE |
| | OPPOSED BLADE DAMPER |
| | LOUVER |
| | FLEXIBLE CONNECTION |
| | POINT OF CONNECTION |
| | BUTTERFLY VALVE |
| | BALANCE VALVE |
| | CHECK VALVE |
| | BALL VALVE |
| | GLOBE VALVE |
| | GATE VALVE |
| | 3 WAY VALVE |
| | TRIPLE-DUTY VALVE |
| | UNION |
| | STRAINER |
| | PRESSURE GAUGE |

ABBREVIATIONS

| | | | |
|------------|-------------------------------|--------|---|
| AD | ACCESS DOOR | HS | HUMIDITY SENSOR |
| A.F.F. | ABOVE FINISHED FLOOR | HVAC | HEATING, VENTILATING AND AIR CONDITIONING |
| AHU | AIR HANDLING UNIT | HW | HOT WATER |
| ALUM | ALUMINUM | HWR | HOT WATER RETURN |
| APD | AIR PRESSURE DROP | HWS | HOT WATER SUPPLY |
| APPROX | ATMOSPHERIC VENT | HX | HEAT EXCHANGER |
| ATV | ATMOSPHERIC VENT | I.D. | IDENTIFICATION |
| B | BOILER | KW | KILOWATT |
| BAF | BIOLOGICAL AERATED FILTER | KW | KILOWATT |
| BBD | BOILER BLOWDOWN | LAT | LEAVING AIR TEMPERATURE |
| BCCT | BYPASS CHLORINE CONTACT TANK | LBS. | POUNDS |
| B.O.D. | BOTTOM OF DUCT | LLPS | LOW-LIFT PUMP STATION |
| B.O.L. | BOTTOM OF LOUVER | LPC | LOW PRESSURE CONDENSATE |
| B.O.P. | BOTTOM OF PIPE | LPS | LOW PRESSURE STEAM |
| BTU | BRITISH THERMAL UNIT | LWT | LEAVING WATER TEMPERATURE |
| CAV | CONSTANT AIR VOLUME | LV | LOUVER |
| CFM | CUBIC FEET PER MINUTE | M | MOTOR |
| CFW | CHEMICAL FEED WATER | MAX. | MAXIMUM |
| CH | CHILLER | MEZZ | MEZZANINE |
| CHW | CHILLED WATER | MIN. | MINIMUM |
| CHWR | CHILLED WATER RETURN | MTD. | MOUNTED |
| CHWS | CHILLED WATER SUPPLY | MBH | THOUSAND BTUS PER HOUR |
| CL | CENTERLINE | MOD | MOTOR OPERATED DAMPER |
| CWR | CONDENSER WATER RETURN | MU | MAKE-UP WATER |
| CWS | CONDENSER WATER SUPPLY | NG | NATURAL GAS |
| COND | CONDENSATE | OA | OUTSIDE AIR |
| CORR. RES. | CORROSION RESISTANT | P | PUMP |
| Ø | DIAMETER | PC | PUMPED CONDENSATE |
| D | DEPTH | POB | PLANT OPERATIONS BUILDING |
| DB | DRY BULB | PPH | POUNDS PER HOUR |
| dBa | DECIBELS | PW | POTABLE WATER |
| DCW | DOMESTIC COLD WATER | PWR | POWER |
| DEG | DEGREE | RA | RETURN AIR |
| DG | DIGESTER GAS | RPM | REVOLUTIONS PER MINUTE |
| DIA. | DIAMETER | RET | RETURN |
| DN. | DOWN | REQ'D | REQUIRED |
| E.A.T. | ENTERING AIR TEMPERATURE | SA | SUPPLY AIR |
| EL. | ELEVATION | SEPS | SECONDARY EFFLUENT PUMP STATION |
| ELEC | ELECTRICAL | S.P. | STATIC PRESSURE |
| ENCL | ENCLOSURE | SPR | SPRING |
| ELH | ELECTRIC UNIT HEATER | SPS | STATIC PRESSURE SENSOR |
| E.W.T. | ENTERING WATER TEMPERATURE | SS | STAINLESS STEEL |
| EXH | EXHAUST | ST | STEAM TRAP |
| F | FAN | SW | SOFTENED WATER |
| FCS | FLOW CONTROL STRUCTURE | SQ | SQUARE |
| FD | FIRE DAMPER | TC | TEMPERATURE CONTROLS |
| F.F. | FINISHED FLOOR | TFCS | TERTIARY FLOW CONTROL STRUCTURE |
| FFM | FEET PER MINUTE | TS | TEMPERATURE SENSOR |
| FRP | FIBERGLASS REINFORCED PLASTIC | T-STAT | THERMOSTAT |
| FSOA | FAST-SLOW-OFF-AUTO SWITCH | TYP. | TYPICAL |
| GA | GAUGE | UH | UNIT HEATER |
| GHW | GLYCOL HOT WATER | VA | VENTILATION AIR |
| GHWL | GLYCOL/HOT WATER RETURN | VAV | VARIABLE-AIR-VOLUME |
| GHWL | GLYCOL/HOT WATER SUPPLY | VD | VOLUME DAMPER |
| GPM | GALLONS PER MINUTE | VFD | VARIABLE FREQUENCY DRIVE |
| H | HEIGHT | W | WIDTH |
| H2O | WATER | W/ | WITH |
| HCP | CIRCULATING PUMP | WB | WET BULB |
| HP | HORSEPOWER | WF | WALL FIN |
| HOA | HAND-OFF-AUTO SWITCH | W.G. | WATER GAUGE |
| HR | HOUR | W.P.D. | WATER PRESSURE DROP |
| HRFS | HIGH-RATE FLOCCULATED SETTING | | |

GENERAL NOTES

- FASTENERS ON THE UNDERSIDE OF PRECAST/PRESTRESSED CONCRETE MEMBERS (PLANKS OR DOUBLE TEE'S) WHICH SERVE FOR DIRECT ATTACHMENT OR FOR HANGERS OF MECHANICAL/ELECTRICAL EQUIPMENT, PIPING, CONDUIT, ETC., MAY NOT BE DRILLED OR SHOT IN THE VICINITY OF THE PRESTRESSING TENDONS. THIS MEANS THAT FASTENERS AT CONCRETE PLANKS CAN BE PLACED ONLY AT THE JOINTS BETWEEN UNITS. ANY INTERMEDIATE SUPPORTS NEEDED TO ACCOMPLISH THIS SHALL BE PROVIDED BY THE CONTRACTOR.
- ALL PIPE AND DUCT PENETRATIONS SHALL HAVE STEEL SLEEVES WITH WATERSTOPS AND MECHANICAL SEALS PROVIDED BY CONTRACT 4C-HVAC. THE HVAC CONTRACTOR WILL PROVIDE ALL THE STEEL SLEEVES REQUIRED FOR THEIR EQUIPMENT ALONG WITH PENETRATION LOCATIONS SO THAT THE GENERAL CONTRACTOR CAN PLACE THE SLEEVES PRIOR TO CONCRETE PLACEMENT. ALL PIPE AND DUCT PENETRATIONS PASSING THROUGH A CLASSIFIED ROOM INTO A NON-CLASSIFIED ROOM SHALL HAVE GAS-TIGHT WALL PENETRATIONS.
- REFER TO SHEET G-004 FOR PLANT SITE PLAN.

CHILLER SCHEDULE

| UNIT NO. | LOCATION | SERVICE | MOTOR | | | CAPACITY TONS | CHILLED WATER | | | | CONDENSER WATER | | | | NOTES |
|----------|-------------|-------------|-------|-------|-------|---------------|---------------|-----------|-----------|-----|-----------------|-----------|-----------|-----|-------|
| | | | KW | PHASE | VOLTS | | P.D. ft. hd. | EWT DEG F | LWT DEG F | GPM | P.D. ft. hd. | EWT DEG F | LWT DEG F | GPM | |
| CH-501 | OC214/OC215 | AHU-501,502 | 44.3 | 3 | 460 | 40 | 28.5 | 55 | 45 | 135 | 4.0 | 78 | 100.8 | 60 | 1 |

NOTES:

- BASED ON 50% PROPYLENE GLYCOL ON CHILLED WATER SIDE.

PUMP SCHEDULE

| TAG NO. | SERVICE | FLUID | FLOWRATE (GPM) | HEAD LOSS (FT H ₂ O) | ELECTRICAL | | | TYPE | DUTY | NOTES |
|---------|-------------------|-----------|----------------|---------------------------------|-------------|-----|------|--------------|-------------------------|-------|
| | | | | | VOLTS/PHASE | HP | RPM | | | |
| P-501 | REHEATS BASEBOARD | HOT WATER | 20 | 15 | 115/1 | 1/4 | 1750 | INLINE | PRIMARY | |
| P-502 | REHEATS BASEBOARD | HOT WATER | 20 | 15 | 115/1 | 1/4 | 1750 | INLINE | STAND-BY FOR P-501; 503 | |
| P-503 | HEAT EXCHANGER | HOT WATER | 22 | 10 | 115/1 | 1/4 | 1750 | INLINE | PRIMARY | |
| P-504 | AHU PREHEAT COILS | GHW | 41 | 20 | 460/3 | 1/2 | 1750 | INLINE | PRIMARY | 1 |
| P-505 | AHU PREHEAT COILS | GHW | 41 | 20 | 460/3 | 1/2 | 1750 | INLINE | STAND-BY | 1 |
| P-506 | AHU COOLING COILS | CHW | 135 | 85 | 460/3 | 10 | 3500 | BASE MOUNTED | PRIMARY | 2 |
| P-507 | AHU COOLING COILS | CHW | 135 | 85 | 460/3 | 10 | 3500 | BASE MOUNTED | STAND-BY | 2 |
| HCP-201 | BAF MECH RM | HOT WATER | 350 | 60 | 460/3 | 7.5 | 1750 | BASE MOUNTED | PRIMARY | 3, 4 |
| HCP-202 | BAF MECH RM | HOT WATER | 350 | 60 | 460/3 | 7.5 | 1750 | BASE MOUNTED | PRIMARY | 3, 4 |
| HCP-203 | BAF MECH RM | HOT WATER | 350 | 60 | 460/3 | 7.5 | 1750 | BASE MOUNTED | STAND-BY | 3, 4 |
| BFP-601 | LLPS BOILERS | FEEDWATER | 16 | 46 | 460/3 | 1/2 | 3500 | BASE MOUNTED | PRIMARY | 3 |
| BFP-602 | LLPS BOILERS | FEEDWATER | 16 | 46 | 460/3 | 1/2 | 3500 | BASE MOUNTED | PRIMARY | 3 |
| BFP-603 | LLPS BOILERS | FEEDWATER | 16 | 46 | 460/3 | 1/2 | 3500 | BASE MOUNTED | PRIMARY | 3 |
| BFP-604 | LLPS BOILERS | FEEDWATER | 16 | 46 | 460/3 | 1/2 | 3500 | BASE MOUNTED | STAND-BY | 3 |

NOTES:

- GHW CONTAINS 50% PROPYLENE GLYCOL.
- CHW CONTAINS 50% PROPYLENE GLYCOL.
- INVERTER-DUTY MOTOR.
- FLOW RATE AND PRESSURE TESTED IS FOR TWO PUMPS OPERATING IN PARALLEL.

HEAT EXCHANGER (HX) SCHEDULE

| TAG | HEAT TRANSFER BTU/HR | SHELL SIDE | | | | TUBE SIDE | | | | PHYSICAL DATA | | NOTES | | |
|--------|----------------------|------------|--|---------------------|-----------------|---------------|-------|--|-----------------|---------------|---------------|-------|------------------|----------------|
| | | FLUID | FOULING FACTOR (FT ² F ² HR/BTU) | FLOW RATE (GPM/PPH) | INLET (TEMP. F) | MAX. WPD (FT) | FLUID | FOULING FACTOR (FT ² F ² HR/BTU) | FLOW RATE (GPM) | EWT (F) | MAX. WPD (FT) | | MAXIMUM DIAMETER | MAXIMUM LENGTH |
| HX-201 | 5,100,000 | STEAM | 0.00052 | 5279 PPH | 218.5 | - | HW | 0.00052 | 349.3 | 170 | 2.0 | 7'-0" | 2 | |
| HX-501 | 321,249 | HW | 0.00056 | 22 GPM | 200 | 1.2 | GHW | 0.00056 | 35.6 | 140 | 5.9 | 0'-6" | 7'-0" | 1 |

NOTES:

- GLYCOL/HOT WATER CONTAINS 50% PROPYLENE GLYCOL.
- INLET STEAM PRESSURE VARIES FROM 2-7 PSIG.

REFER TO O & M MANUAL FOR UPDATED EQUIPMENT SCHEDULES

RECORD DRAWING

THESE DRAWINGS HAVE BEEN REVISED TO REFLECT MAJOR CHANGES, IF ANY, WHICH OCCURRED DURING CONSTRUCTION. REVISIONS ARE BASED UPON INFORMATION SUPPLIED BY CONTRACTOR.
DATE: 11/23/05 PER: G&K

THIS DRAWING WAS PREPARED AT THE SCALE INDICATED IN THE TITLE BLOCK. INACCURACIES IN THE STATED SCALE MAY BE INTRODUCED WHEN DRAWINGS ARE REPRODUCED BY ANY MEANS. USE THE GRAPHIC SCALE BAR IN THE TITLE BLOCK TO DETERMINE THE ACTUAL SCALE OF THIS DRAWING.

11/28/00 S&W CMS
...CONTRACT 2-5 HVAC\0659H001.DWG

| No. | Date | Revisions | Init |
|-----|---------|---------------------|------|
| 0 | 4/20/01 | ISSUED FOR APPROVAL | |
| 1 | | AS BID | |
| 2 | 1/30/05 | RECORD DRAWING | RCG |

In charge of --- DBP
Designed by --- DBP
Drawn by --- CMS
Checked by --- DBP



ONONDAGA COUNTY • DEPARTMENT OF DRAINAGE AND SANITATION • SYRACUSE, NEW YORK
METROPOLITAN SYRACUSE WASTEWATER TREATMENT PLANT
STAGE III AMMONIA AND STAGE II PHOSPHORUS REMOVAL PROJECT

ABBREVIATIONS, SYMBOLS & NOTES

HVAC



File Number
00659
Date
APRIL 2001
H-001

NO ALTERATIONS PERMITTED HEREON EXCEPT AS PROVIDED UNDER SECTION 7209 SUBDIVISION 2 OF THE NEW YORK STATE EDUCATION LAW

| UNIT ID. NO. | SERVES | SUPPLY AIR (CFM) | RETURN AIR (CFM) | OUTSIDE AIR (CFM) | PRESS. REQ'TS | | SUPPLY FAN MOTOR | | | RETURN FAN MOTOR | | | NOTES | |
|--------------|------------------|---------------------------|------------------|-------------------|---------------|--------------|------------------|-----|-------------|------------------|------|-------------|-------|---------|
| | | | | | EXT. (\"WG) | TOTAL (\"WG) | HP | RPM | VOLTS/PHASE | HP | RPM | VOLTS/PHASE | | |
| AHU-201 | BAF GALLERIES | FLOOR MOUNTED AIR HANDLER | 12,000 | 0-12,000 | 0-12,000 | 1.5 | 2.5 | 7.5 | 1275 | 460/3 | - | - | - | 1,4 |
| AHU-301 | CHEMICAL BLDG. C | ROOF MOUNTED AIR HANDLER | 12,000 | 4,000/8,000 | 4,000/8,000 | 0.5 | 1.5 | 7.5 | 1275 | 460/3 | 3.00 | 1400 | 460/3 | 1,2,3,4 |

- NOTES:
- UNITS ARE VENTILATION UNITS WITHOUT COILS.
 - PROVIDE AIRSIDE CORROSION RESISTANT EPOXY FINISH.
 - CONTROLS AND STARTERS BY CONTRACT 4C, HVAC.
 - UNIT TO SHUT DOWN WITH FIRE / SMOKE ALARM.

| UNIT ID. NO. | LOCATION | MIN. COOLING CAP. | | | COOLING COIL DATA | | | | | PREHEAT COIL DATA | | | | | OUTSIDE AIRFLOW (CFM) | | FAN | | FAN MOTOR | | NOTES |
|--------------|-------------|-------------------|--------------|----------------------|-------------------|-------------|---------|-----------|---------------------|-------------------|---------|-----------|-------------|-----------|-----------------------|----------------|-----|-------------|-----------|------|-----------|
| | | SENSIBLE BTU/HR | TOTAL BTU/HR | MAX. FACE VEL. (FPM) | MAX. APD | MAX. WPD | EWT (F) | TEMP RISE | NOMINAL CAP. (BTUH) | GPM | EWT (F) | TEMP DROP | MAX. WPD | MAX. APD | TOTAL AIRFLOW (CFM) | EXT. SP (\"WC) | HP | VOLTS/PHASE | RPM | | |
| AHU-501 | OC214/OC215 | 346,600 | 421,200 | 465 | 0.6\" WG | 11.4 ft. WG | 45 | 10 | 265,100 | 30 | 160 | 20 | 1.52 ft. WG | 0.06\" WG | 3000 | 14,000 | 1 | 15 | 460/3 | 644 | 1,2,4,5 |
| AHU-502 | OC214/OC215 | 38,600 | 45,000 | 545 | 0.75\" WG | 8.9 ft. WG | 45 | 10 | 47,300 | 5.3 | 160 | 20 | 0.70 ft. WG | 0.14\" WG | 700 | 1,500 | 1 | 2 | 460/3 | 1938 | 1,2,3,4,5 |

- NOTES:
- COIL DATA IS BASED ON 50% PROPYLENE GLYCOL.
 - PROVIDE INVERTER-DUTY MOTOR.
 - PROVIDE INLET GUIDE VANES.
 - PROVIDE EXTENDED BEARING LUBRICATION LINES.
 - UNIT TO SHUT DOWN WITH FIRE / SMOKE ALARM.

| UNIT ID. | BUILDING | SERVES ROOM NO. | TYPE OF EQUIPMENT | FAN | | | | ELECTRICAL | | | | CONTROLS | | | | NOTES |
|----------|------------------------|--------------------|-------------------------------------|--------|-----------|------------------|----------|--------------|------|-----------|-------------|----------------------|---------------------|-------------|-------|-------|
| | | | | DRIVE | CFM | EXT. S.P. (\"WG) | RPM | dBA OR SONES | HP | RPM | VOLTS/PHASE | INTERLOCKED WITH | CONTROLLED BY | PROVIDED BY | | |
| F-101 | SEC. EFF. PUMP STATION | ELECTRICAL ROOM | INLINE CENTRIFUGAL UPBLAST | BELT | 18000 | 0.375 | 884 | 70dBA | 5.0 | 1750 | 460/3 | LV-102, LV-104 | HOA SWITCH/T-STAT | ELEC/HVAC | 1, 8 | |
| F-102 | SEC. EFF. PUMP STATION | ELECTRICAL ROOM | INLINE CENTRIFUGAL UPBLAST | BELT | 18000 | 0.375 | 884 | 70dBA | 5.0 | 1750 | 460/3 | LV-101, LV-104 | HOA SWITCH/T-STAT | ELEC/HVAC | 1, 8 | |
| F-103 | SEC. EFF. PUMP STATION | ELECTRICAL ROOM | INLINE CENTRIFUGAL UPBLAST | BELT | 18000 | 0.375 | 884 | 70dBA | 5.0 | 1750 | 460/3 | LV-101, LV-103 | HOA SWITCH/T-STAT | ELEC/HVAC | 1, 8 | |
| F-104 | SEC. EFF. PUMP STATION | PUMP ROOM | INLINE CENTRIFUGAL UPBLAST | BELT | 10000 | 0.375 | 742 | 66dBA | 3.0 | 1750 | 460/3 | LV-106, LV-108 | HOA SWITCH/T-STAT | ELEC/HVAC | 1, 8 | |
| F-105 | SEC. EFF. PUMP STATION | PUMP ROOM | INLINE CENTRIFUGAL UPBLAST | BELT | 10000 | 0.375 | 742 | 66dBA | 3.0 | 1750 | 460/3 | LV-105, LV-108 | HOA SWITCH/T-STAT | ELEC/HVAC | 1, 8 | |
| F-106 | SEC. EFF. PUMP STATION | PUMP ROOM | INLINE CENTRIFUGAL UPBLAST | BELT | 10000 | 0.375 | 742 | 66dBA | 3.0 | 1750 | 460/3 | LV-105, LV-107 | HOA SWITCH/T-STAT | ELEC/HVAC | 1, 8 | |
| F-201 | BAF COMPLEX | MECHANICAL ROOM | ROOFTOP CENTRIFUGAL EXHAUST | BELT | 1670/2500 | 0.375 | 835 | 8.8 | 0.5 | 1200/1800 | 460/3 | LV-205 | F50A SWITCH/T-STAT | ELEC/HVAC | 3,5,8 | |
| F-202 | BAF COMPLEX | CORRIDOR | ROOFTOP CENTRIFUGAL EXHAUST | DIRECT | 500 | 0.375 | 1013 | 3.7 | 0.25 | 1725 | 120/1 | - | ON/OFF SWITCH | ELEC | 5 | |
| F-203 | BAF COMPLEX | BLOWER ROOM | VANE AXIAL HOODED EXHAUST | BELT | 30000 | 0.5 | 836 | 64dBA | 10.0 | 1800 | 460/3 | - | VFD/DDC SYSTEM | ELEC/HVAC | 1,4,8 | |
| F-204 | BAF COMPLEX | BLOWER ROOM | VANE AXIAL HOODED EXHAUST | BELT | 30000 | 0.5 | 836 | 64dBA | 10.0 | 1800 | 460/3 | - | VFD/DDC SYSTEM | ELEC/HVAC | 1,4,8 | |
| F-205 | BAF COMPLEX | ELECTRICAL ROOM | VANE AXIAL HOODED EXHAUST | BELT | 10000 | 0.5 | 840 | 58dBA | 3.0 | 1800 | 460/3 | LV-203, LV-204 | VFD/DDC SYSTEM | ELEC/HVAC | 1,4,8 | |
| F-206 | BAF COMPLEX | GALLERY | WALL-MTD. PROPELLER EXHAUST | BELT | 4000 | 0.375 | 1037 | 20.0 | 0.5 | 1725 | 460/3 | - | AHU-201 INTERLOCK | ELEC | 8 | |
| F-207 | BAF COMPLEX | GALLERY | WALL-MTD. PROPELLER EXHAUST | BELT | 4000 | 0.375 | 1037 | 20.0 | 0.5 | 1725 | 460/3 | - | AHU-201 INTERLOCK | ELEC | 8 | |
| F-208 | BAF COMPLEX | BAF | ROOFTOP CENTRIFUGAL EXHAUST | BELT | 22,500 | 0.125 | 340 | 18.1 | 5.0 | 1750 | 460/3 | BAF AERATION CONTROL | ELEC | 5,8 | | |
| F-209 | BAF COMPLEX | BAF | ROOFTOP CENTRIFUGAL EXHAUST | BELT | 22,500 | 0.125 | 340 | 18.1 | 5.0 | 1750 | 460/3 | BAF AERATION CONTROL | ELEC | 5,8 | | |
| F-210 | BAF COMPLEX | BAF | ROOFTOP CENTRIFUGAL EXHAUST | BELT | 22,500 | 0.125 | 340 | 18.1 | 5.0 | 1750 | 460/3 | BAF AERATION CONTROL | ELEC | 5,8 | | |
| F-211 | BAF COMPLEX | BAF | ROOFTOP CENTRIFUGAL EXHAUST | BELT | 22,500 | 0.125 | 340 | 18.1 | 5.0 | 1750 | 460/3 | BAF AERATION CONTROL | ELEC | 5,8 | | |
| F-212 | BAF COMPLEX | BAF | ROOFTOP CENTRIFUGAL EXHAUST | BELT | 22,500 | 0.125 | 340 | 18.1 | 5.0 | 1750 | 460/3 | BAF AERATION CONTROL | ELEC | 5,8 | | |
| F-213 | BAF COMPLEX | BAF | ROOFTOP CENTRIFUGAL EXHAUST | BELT | 22,500 | 0.125 | 340 | 18.1 | 5.0 | 1750 | 460/3 | BAF AERATION CONTROL | ELEC | 5,8 | | |
| F-214 | BAF COMPLEX | BAF | ROOFTOP CENTRIFUGAL EXHAUST | BELT | 22,500 | 0.125 | 340 | 18.1 | 5.0 | 1750 | 460/3 | BAF AERATION CONTROL | ELEC | 5,8 | | |
| F-215 | BAF COMPLEX | BAF | ROOFTOP CENTRIFUGAL EXHAUST | BELT | 22,500 | 0.125 | 340 | 18.1 | 5.0 | 1750 | 460/3 | BAF AERATION CONTROL | ELEC | 5,8 | | |
| F-216 | BAF COMPLEX | BAF | ROOFTOP CENTRIFUGAL EXHAUST | BELT | 22,500 | 0.125 | 340 | 18.1 | 5.0 | 1750 | 460/3 | BAF AERATION CONTROL | ELEC | 5,8 | | |
| F-301 | HRES COMPLEX | GALLERY | FILTERED IN-LINE CENTRIFUGAL | BELT | 6000 | 2.0 | 1088 | 5.0 | 0.75 | 1725 | 460/3 | - | ON/OFF SWITCH | ELEC | 1,6,8 | |
| F-302 | HRES COMPLEX | GALLERY | FILTERED IN-LINE CENTRIFUGAL | BELT | 6000 | 2.0 | 1088 | 5.0 | 0.75 | 1725 | 460/3 | - | ON/OFF SWITCH | ELEC | 1,6,8 | |
| F-303 | HRES COMPLEX | GALLERY | WALL-MTD. PROPELLER EXHAUST | BELT | 5000 | 0.38 | 878 | 18.6 | 0.5 | 1725 | 460/3 | F-302 | F-302 INTERLOCK | ELEC | 8 | |
| F-304 | HRES COMPLEX | GALLERY | WALL-MTD. PROPELLER EXHAUST | BELT | 3000 | 0.375 | 950 | 16.7 | 0.33 | 1725 | 460/3 | F-302 | F-302 INTERLOCK | ELEC | 8 | |
| F-305 | HRES COMPLEX | GALLERY | ROOFTOP CENTRIFUGAL EXHAUST | BELT | 5000 | 0.375 | 738 | 15.3 | 1.0 | 1725 | 460/3 | F-301 | F-301 INTERLOCK | ELEC | 5,8 | |
| F-306 | HRES COMPLEX | GALLERY | WALL-MTD. PROPELLER EXHAUST | BELT | 3000 | 0.375 | 950 | 16.7 | 0.33 | 1725 | 460/3 | F-301 | F-301 INTERLOCK | ELEC | 8 | |
| F-307 | HRES COMPLEX | HYDROCYCLONE RMS | FILTERED IN-LINE CENTRIFUGAL | BELT | 600 | 0.5 | 1280 | 8.3 | 0.25 | 1725 | 120/1 | LV-304 | ON/OFF SWITCH | ELEC | 1 | |
| F-308 | HRES COMPLEX | HYDROCYCLONE RMS | FILTERED IN-LINE CENTRIFUGAL | BELT | 600 | 0.5 | 1280 | 8.3 | 0.25 | 1725 | 120/1 | LV-305 | ON/OFF SWITCH | ELEC | 1 | |
| F-309 | CHEMICAL BUILDING C | ELECTRICAL ROOM | FILTERED IN-LINE CENTRIFUGAL | BELT | 300 | 0.5 | 1220 | 8.3 | 0.25 | 1725 | 120/1 | - | ON/OFF SWITCH | ELEC | 1 | |
| F-310 | CHEMICAL BUILDING C | CHEMICAL STORAGE | ROOF-TOP CENTRIF. UPBLAST EXHAUST | BELT | 4200/4800 | 0.375 | 860/1725 | 14.8 | 1.50 | 589 | 460/3 | AHU-301 | HIGH/LOW/OFF SWITCH | HVAC | 7,8 | |
| F-311 | HRES COMPLEX | HRES | ROOFTOP CENTRIFUGAL EXHAUST | BELT | 22,500 | 0.125 | 340 | 18.1 | 5.0 | 1750 | 460/3 | - | ON/OFF SWITCH | ELEC | 5,8 | |
| F-401 | UV DISINFECTION | UV DISINFECTION | FILTERED CENTRIFUGAL PENTHOUSE SUP. | BELT | 3600 | 1.50 | 1048 | 15.9 | 2.0 | 1725 | 460/3 | - | ON/OFF SWITCH | ELEC | 5,8 | |
| F-402 | UV DISINFECTION | STORAGE ROOM | WALL-MTD TRANSFER FAN | DIRECT | 255 | 0.25 | 1490 | 2.2 | 0.04 | 1490 | 120/1 | - | VAR. SPEED CONTROL | HVAC | | |
| F-403 | UV DISINFECTION | ELECTRICAL ROOM | WALL-MTD TRANSFER FAN | DIRECT | 255 | 0.25 | 1490 | 2.2 | 0.04 | 1490 | 120/1 | - | VAR. SPEED CONTROL | HVAC | | |
| F-501 | OPERATIONS CENTER | FLUME HOOD | FRP RADIAL FLUME EXHAUST | BELT | 950 | 0.75 | 1700 | NA | 1/2 | 1725 | 460/3 | - | VFD | ELEC | 2 | |
| F-502 | OPERATIONS CENTER | AHU-501 RETURN AIR | FRP CENTRIFUGAL BLOWER | BELT | 11,750 | 1.50 | 1788 | NA | 10 | 1725 | 480/3 | AHU-501:LV-501A:502A | VFD | VFD/T/C | 1,4,8 | |
| F-503 | OPERATIONS CENTER | REST ROOMS | ROOFTOP CENTRIFUGAL EXHAUST | DIRECT | 250 | 0.5 | 1715 | 7.3 | 1/8 | 1550 | 115/1 | - | DDC SYSTEM | T/C | 3, 5 | |
| F-504 | OPERATIONS CENTER | WOMANS LOCKERS | ROOFTOP CENTRIFUGAL EXHAUST | DIRECT | 400 | 0.5 | 1542 | 7.9 | 1/8 | 1550 | 115/1 | - | DDC SYSTEM | T/C | 3, 5 | |
| F-505 | OPERATIONS CENTER | MENS LOCKERS | ROOFTOP CENTRIFUGAL EXHAUST | BELT | 750 | 0.5 | 1685 | 10.1 | 1/4 | 1725 | 115/1 | - | DDC SYSTEM | T/C | 3, 5 | |
| F-506 | OPERATIONS CENTER | KITCHEN | ROOFTOP CENTRIFUGAL EXHAUST | DIRECT | 500 | 0.5 | 1509 | 10.1 | 1/8 | 1550 | 115/1 | - | DDC SYSTEM | T/C | 3, 5 | |
| F-507 | OPERATIONS CENTER | REST ROOMS | ROOFTOP CENTRIFUGAL EXHAUST | DIRECT | 800 | 0.25 | 1550 | 9 | 1/8 | 1550 | 115/1 | - | DDC SYSTEM | T/C | 3, 5 | |
| F-508 | OPERATIONS CENTER | MECH ROOM | ROOFTOP CENTRIFUGAL - UP BLAST | BELT | 3600 | 0.5 | 805 | 13.3 | 3/4 | 1725 | 480/3 | LV-501B, 502B | DDC SYSTEM | T/C | 8 | |
| F-509 | OPERATIONS CENTER | OC308 | ROOFTOP CENTRIFUGAL EXHAUST | DIRECT | 50 | 0.25 | 1180 | 3.2 | 1/25 | 1160 | 115/1 | - | DDC SYSTEM | T/C | 3, 5 | |
| F-601 | LOW LIFT PUMP STATION | BOILER ROOM | IN-LINE TUBE AXIAL | BELT | 2650/4000 | 0.375 | 1050 | 19.0 | 0.50 | 1725 | 460/3 | - | 2-SPEED SWITCH | ELEC | 1, 8 | |
| F-701 | POB | GALLERIES | FILTERED CENTRIFUGAL PENTHOUSE SUP. | BELT | 3,300 | 0.25 | | 0.75 | 1750 | 460/3 | UV-701 | UV-701 INTERLOCK | ELEC | 3,5,8 | | |
| F-702 | POB | BASEMENT | ROOFTOP CENTRIFUGAL EXHAUST | BELT | 6000 | 1.00 | 1080 | 24.0 | 3.0 | 1750 | 480/3 | - | ON/OFF SWITCH | ELEC | 3,5,8 | |
| F-703 | TFCS-A | GALLERIES | ROOFTOP CENTRIFUGAL EXHAUST | BELT | 1,200 | 0.25 | 985 | 8.5 | 1/8 | 1750 | 120/1 | - | ON/OFF SWITCH | ELEC | 3, 5 | |
| F-704 | TFCS-B | GALLERIES | ROOFTOP CENTRIFUGAL EXHAUST | BELT | 1,200 | 0.25 | 985 | 8.5 | 1/8 | 1750 | 120/1 | - | ON/OFF SWITCH | ELEC | 3, 5 | |
| F-705 | LOW LIFT PUMP STATION | PUMP ROOM | ROOFTOP CENTRIFUGAL EXHAUST | BELT | 4600 | 0.25 | 1055 | 18.7 | 1.0 | 1750 | 460/3 | - | ON/OFF SWITCH | ELEC | 3,5,8 | |
| F-801 | SUBSTA. BATTERY BLDG. | BATTERY ROOM | WALL-MTD PROPELLER EXHAUST | DIRECT | 250 | 0.25 | 1650 | 10.3 | 0.04 | 1650 | 120/1 | BATTERY SYS. | ON/OFF SWITCH | ELEC | | |
| F-802 | BCCT BUILDING | DECHLOR. ROOM | WALL-MTD PROPELLER EXHAUST | DIRECT | 500 | 0.375 | 1160 | 7.5 | 0.17 | 1160 | 120/1 | T-STAT | HOA SWITCH/T-STAT | ELEC/HVAC | | |

- NOTES:
- UNIT EXTERIOR FINISH TO BE LIGHT GREY EPOXY. SUBMIT COLOR CHART FOR APPROVAL.
 - FRP CONSTRUCTION.
 - MOTORIZED DAMPER.
 - INVERTER-DUTY MOTOR.
 - UNIT FINISH TO BE ALUMINUM MILL FINISH.
 - LISTED FAN STATIC PRESSURE IS TOTAL STATIC PRESSURE INCLUDING 0.75 W.G. EXTERNAL STATIC PRESSURE.
 - PROVIDE AIRSIDE CORROSION RESISTANT FINISH.
 - UNIT TO BE SHUT DOWN WITH FIRE / SMOKE ALARM.

| TAG | LOCATION | FAN | | FAN | | HEATING COIL | | | NOTES | |
|--------|----------|------------------|------------|-----|-------------|----------------|---------|---------|-------|-----------------------|
| | | SUPPLY AIR (CFM) | ESP (\"WC) | HP | VOLTS/PHASE | CAPACITY (MBH) | EAT (F) | LAT (F) | | STEAM PRESSURE (PSIG) |
| UV-701 | POB | 3,300 | 2.0 | 5.0 | 460/3 | 250 | 60 | -10 | 5 | 1 |
| UV-702 | LLPS | 10,000 | 2.0 | 7.5 | 460/3 | 759 | 60 | -10 | 5 | 1 |

- NOTES:
- UNIT TO SHUT DOWN WITH FIRE / SMOKE ALARM.

| TAG | SERVICE | INLET STEAM PRESSURE (PSIG) | DISCHARGE PRESSURE (PSIG) | CAPACITY (LB./HR) | TYPE OF TRAP |
|--------|-------------------|-----------------------------|---------------------------|-------------------|--------------|
| ST-201 | END OF MAIN DRIP | 5 | 2 | 250 | F & T |
| ST-202 | END OF MAIN DRIP | 5 | 2 | 100 | F & T |
| ST-203 | HX-201 | 2 | 0.5 | 5,500 | F & T |
| ST-204 | HX-210 DRIP | 2 | 0.5 | 100 | F & T |
| ST-601 | MAIN STEAM HEADER | 7.5 | 2 | 250 | F & T |
| ST-701 | UV-701 | 5 | 2 | 261 | F & T |
| ST-702 | DRIP | 5 | 2 | 50 | TD |
| ST-703 | DRIP | 5 | 2 | 50 | TD |
| ST-704 | UV-702 | 5 | 2 | 791 | F & T |
| ST-901 | END OF MAIN DRIP | 5 | 2 | 250 | IB |
| ST-902 | DRIP | 5 | 2 | 250 | F & T |

- NOTES:
- F & T = FLOAT & THERMOSTATIC TRAP.
 - TD = THERMODYNAMIC TRAP.
 - IB = INVERTED BUCKET TRAP.

LOUVER AND DAMPER SCHEDULE

| UNIT I.D. | BUILDING | ROOM NAME | EQUIPMENT TYPE | DIMENSIONS (W" X H" X D") | BLADE ANGLE | OPERATOR TYPE | | INTERLOCK WITH | NOTES |
|--------------|------------------------|---------------------|-------------------------------|---------------------------|-------------|--------------------------|-------|----------------|-------|
| | | | | | | VOLTS/PHASE | | | |
| LV-101 | SEC. EFF. PUMP STATION | ELECTRICAL ROOM | COMBINATION FIXED/OPERABLE | 56" X 112" X 6" | 45 | POWER OPEN/SPRING RETURN | 120/1 | F-102 & F-103 | 3,5 |
| LV-102 | SEC. EFF. PUMP STATION | ELECTRICAL ROOM | COMBINATION FIXED/OPERABLE | 56" X 112" X 6" | 45 | POWER OPEN/SPRING RETURN | 120/1 | F-101 | 3,5 |
| LV-103 | SEC. EFF. PUMP STATION | ELECTRICAL ROOM | COMBINATION FIXED/OPERABLE | 56" X 112" X 6" | 45 | POWER OPEN/SPRING RETURN | 120/1 | F-103 | 3,5 |
| LV-104 | SEC. EFF. PUMP STATION | ELECTRICAL ROOM | COMBINATION FIXED/OPERABLE | 56" X 112" X 6" | 45 | POWER OPEN/SPRING RETURN | 120/1 | F-101 & F-102 | 3,5 |
| LV-105 | SEC. EFF. PUMP STATION | PUMP ROOM | COMBINATION FIXED/OPERABLE | 56" X 56" X 6" | 45 | POWER OPEN/SPRING RETURN | 120/1 | F-105 & F-106 | 3,5 |
| LV-106 | SEC. EFF. PUMP STATION | PUMP ROOM | COMBINATION FIXED/OPERABLE | 56" X 56" X 6" | 45 | POWER OPEN/SPRING RETURN | 120/1 | F-104 | 3,5 |
| LV-107 | SEC. EFF. PUMP STATION | PUMP ROOM | COMBINATION FIXED/OPERABLE | 56" X 56" X 6" | 45 | POWER OPEN/SPRING RETURN | 120/1 | F-106 | 3,5 |
| LV-108 | SEC. EFF. PUMP STATION | PUMP ROOM | COMBINATION FIXED/OPERABLE | 56" X 56" X 6" | 45 | POWER OPEN/SPRING RETURN | 120/1 | F-104 & F-105 | 3,5 |
| LV-201 | BAF COMPLEX | BAF GALLERY | COMBINATION FIXED/OPERABLE | 32" X 32" X 4" | 45 | SELF-ACTING | -- | -- | 2,4 |
| LV-202 | BAF COMPLEX | BAF GALLERY | COMBINATION FIXED/OPERABLE | 32" X 32" X 4" | 45 | SELF-ACTING | -- | -- | 2,4 |
| LV-203LV-204 | BAF COMPLEX | ELECTRICAL ROOM | COMBINATION FIXED/OPERABLE | 96" X 54" X 4" | 45 | POWER OPEN/SPRING RETURN | 120/1 | F-205 | 3,5 |
| LV-205 | BAF COMPLEX | MECHANICAL ROOM | COMBINATION FIXED/OPERABLE | 72" X 24" X 4" | 45 | POWER OPEN/SPRING RETURN | 120/1 | F-201 | 3 |
| LV-301LV-303 | HRFS COMPLEX | HRFS GALLERIES | COMBINATION FIXED/SELF-ACTING | 32" X 32" X 4" | 45 | SELF-ACTING | -- | -- | 2,4 |
| LV-304 | HRFS COMPLEX | HYDROCYCLONE ENCL. | COMBINATION FIXED/OPERABLE | 16" X 16" X 4" | 45 | POWER OPEN/SPRING RETURN | 120/1 | F-307 | 2 |
| LV-305 | HRFS COMPLEX | HYDROCYCLONE ENCL. | COMBINATION FIXED/OPERABLE | 16" X 16" X 4" | 45 | POWER OPEN/SPRING RETURN | 120/1 | F-308 | 2 |
| LV-306LV-307 | CHEM. BLDG. C | ELECTRICAL ROOM | COMBINATION FIXED/OPERABLE | 24" X 24" X 4" | 45 | POWER OPEN/SPRING RETURN | 120/1 | F-309 | 3 |
| LV-401LV-402 | UV DISINFECTON | UV DISINFECTON ROOM | COMBINATION FIXED/OPERABLE | 24" X 24" X 4" | 45 | POWER OPEN/SPRING RETURN | 120/1 | F-401 | 1 |
| LV-501 | OPERATIONS CENTER | MECH. ROOM | COMBINATION FIXED/OPERABLE | 48" X 84" X 4" | 45 | POWER OPEN/SPRING RETURN | 120/1 | F-508 | 1 |
| LV-502 | OPERATIONS CENTER | MECH. ROOM | COMBINATION FIXED/OPERABLE | 48" X 84" X 4" | 45 | POWER OPEN/SPRING RETURN | 120/1 | F-508 | 1 |
| LV-503 | OPERATIONS CENTER | MAINT. ROOM | FIXED ONLY | 24" X 24" X 4" | 45 | | | | |
| LV-504 | OPERATIONS CENTER | MECH. ROOM | FIXED ONLY | 78" X 96" X 4" | 45 | | | | |
| LV-701 | LOW LIFT PUMP STATION | PUMP ROOM | COMBINATION FIXED/OPERABLE | 52" X 82" X 4" | 45 | POWER OPEN/SPRING RETURN | 120/1 | UV-702 | 6 |
| LV-702 | LOW LIFT PUMP STATION | PUMP ROOM | COMBINATION FIXED/OPERABLE | 52" X 82" X 4" | 45 | POWER OPEN/SPRING RETURN | 120/1 | UV-702 | 6 |
| LV-801 | SUBSTA. BATTERY BLDG. | BATTERY ROOM | COMBINATION FIXED/OPERABLE | 24" X 24" X 4" | 45 | POWER OPEN/SPRING RETURN | 120/1 | F-801 | 3 |
| LV-802 | SUBSTA. BATTERY BLDG. | BATTERY ROOM | COMBINATION FIXED/OPERABLE | 16" X 16" X 4" | 45 | SELF-ACTING | -- | -- | 4 |
| LV-803 | BOGT BLDG. | DECHLOR. ROOM | COMBINATION FIXED/OPERABLE | 32" X 32" X 4" | 45 | POWER OPEN/SPRING RETURN | 120/1 | F-802 | 2,3 |
| LV-804 | BOGT BLDG. | DECHLOR. ROOM | COMBINATION FIXED/OPERABLE | 21" X 21" X 4" | 45 | SELF-ACTING | -- | -- | 2,4 |

- NOTES:**
- OPERABLE DAMPER SHALL BE SPLIT HORIZONTALLY. TOP DAMPER SHALL BE 48" X 60", BOTTOM DAMPER SHALL BE 48" X 24".
 - UNIT, UNIT SUPPORTS AND ALL ASSOCIATED CONTROLS TO HAVE CORROSION RESISTANT CONSTRUCTION SUITABLE FOR ENVIRONMENTS SHOWN ON CONTRACT DRAWINGS AND AS SPECIFIED.
 - DAMPER OPERATOR SHALL BE CAPABLE OF OPENING AND CLOSING APPROVED DAMPER OR OPERABLE LOUVER.
 - VERIFY THAT ASSOCIATED WALL PROPELLER FAN IS COMPATIBLE WITH LOUVER DIMENSIONS AND SELF-ACTING DAMPER.
 - VERIFY THAT MOTOR OPERATOR TORQUE IS CAPABLE OF OPERATING LOUVER.
 - DIMENSIONS ARE APPROXIMATE. LOUVER SHALL BE INSTALLED IN PLACE OF EXISTING WINDOW PANE.

UNIT HEATER SCHEDULE

| UNIT I.D. | BUILDING | ROOM | EQUIPMENT TYPE | COIL DATA | | | AIR DATA | | | WATER DATA | | | MOTOR DATA | | | NOTES |
|--------------|------------------------|--------------------|-----------------------|-----------|------|-------------|----------|-------------|------|------------|----------|-------|------------|-------------|---|-------|
| | | | | (MEH) | (KW) | VOLTS/PHASE | CFM | E.A.T. (°F) | GPM | EWT (°F) | WPD (FT) | HP | RPM | VOLTS/PHASE | | |
| UH-101 | SEC. EFF. PUMP STATION | ELECTRICAL ROOM | STANDARD ELECTRIC | 34.1 | 10.0 | 460/3 | 650 | -- | -- | -- | 0.033 | 1600 | 460/1 | 2 | | |
| UH-102 | SEC. EFF. PUMP STATION | ELECTRICAL ROOM | STANDARD ELECTRIC | 34.1 | 10.0 | 460/3 | 650 | -- | -- | -- | 0.033 | 1600 | 460/1 | 2 | | |
| UH-103 | SEC. EFF. PUMP STATION | PUMP ROOM | STANDARD ELECTRIC | 34.1 | 10.0 | 460/3 | 650 | -- | -- | -- | 0.033 | 1600 | 460/1 | 2 | | |
| UH-104 | SEC. EFF. PUMP STATION | PUMP ROOM | STANDARD ELECTRIC | 34.1 | 10.0 | 460/3 | 650 | -- | -- | -- | 0.033 | 1600 | 460/1 | 2 | | |
| UH-201UH-202 | BAF COMPLEX | GALLERY | HORIZONTAL CORR. RES. | 49.0 | -- | -- | 1320 | 60 | 3.2 | 200 | 0.27 | 0.33 | 1725 | 460/3 | 1 | |
| UH-203UH-206 | BAF COMPLEX | GALLERY | HORIZONTAL CORR. RES. | 232.0 | -- | -- | 6000 | 60 | 15.5 | 200 | 0.62 | 1.5 | 1725 | 460/3 | 1 | |
| UH-207UH-208 | BAF COMPLEX | GALLERY | HORIZONTAL CORR. RES. | 49.0 | -- | -- | 1320 | 60 | 3.2 | 200 | 0.27 | 0.33 | 1725 | 460/3 | 1 | |
| UH-209 | BAF COMPLEX | GALLERY | CORR. RES. DOWNBLAST | 150.0 | -- | -- | 4560 | 60 | 10 | 200 | 0.34 | 0.75 | 1725 | 460/3 | 1 | |
| UH-210211 | BAF COMPLEX | MECHANICAL ROOM | STANDARD HOT WTR | 81.0 | -- | -- | 2010 | 60 | 8.4 | 200 | 3.2 | 0.125 | 1625 | 120/1 | | |
| UH-212212 | BAF COMPLEX | BLOWER ROOM | STANDARD HOT WTR | 62.5 | -- | -- | 1340 | 60 | 6.5 | 200 | 1.4 | 0.125 | 1625 | 120/1 | | |
| UH-215214 | BAF COMPLEX | ELECTRICAL ROOM | STANDARD HOT WTR | 44.8 | -- | -- | 1120 | 60 | 4.6 | 200 | 0.8 | 0.063 | 1625 | 120/1 | | |
| UH-301 | HRFS COMPLEX | INFLUENT GALLERY | CORR. RES. DOWNBLAST | 49.0 | -- | -- | 1320 | 60 | 3.2 | 200 | 0.27 | 0.33 | 1725 | 460/3 | 1 | |
| UH-302UH-303 | HRFS COMPLEX | INFLUENT GALLERY | CORR. RES. DOWNBLAST | 34.0 | -- | -- | 700 | 60 | 2.3 | 200 | 0.13 | 0.33 | 1725 | 460/3 | 1 | |
| UH-304 | HRFS COMPLEX | INFLUENT GALLERY | CORR. RES. DOWNBLAST | 49.0 | -- | -- | 1320 | 60 | 3.2 | 200 | 0.27 | 0.33 | 1725 | 460/3 | 1 | |
| UH-305UH-306 | HRFS COMPLEX | SOUTH GALLERY | CORR. RES. DOWNBLAST | 150.0 | -- | -- | 4560 | 60 | 10 | 200 | 0.34 | 0.75 | 1725 | 460/3 | 1 | |
| UH-308UH-312 | HRFS COMPLEX | NORTH GALLERY | CORR. RES. DOWNBLAST | 150.0 | -- | -- | 4560 | 60 | 10 | 200 | 0.34 | 0.75 | 1725 | 460/3 | 1 | |
| UH-313UH-316 | HRFS COMPLEX | EFFLUENT GALLERY | CORR. RES. DOWNBLAST | 34.0 | -- | -- | 700 | 60 | 2.3 | 200 | 0.13 | 0.33 | 1725 | 460/3 | 1 | |
| UH-317UH-322 | CHEMICAL BLDG. C | CHEMICAL STORAGE | CORR. RES. DOWNBLAST | 121.0 | -- | -- | 3900 | 60 | 8.1 | 200 | 0.28 | 0.75 | 1725 | 460/3 | 1 | |
| UH-323 | CHEMICAL BLDG. C | ELECTRICAL ROOM | STANDARD HOT WTR | 30.8 | -- | -- | 730 | 60 | 3.2 | 200 | 0.3 | 0.083 | 1550 | 120/1 | | |
| UH-324UH-325 | HRFS COMPLEX | HYDROCYCLONE ENCL. | CORR. RES. HORIZONTAL | 137.0 | -- | -- | 3900 | 60 | 13.7 | 200 | 0.75 | 0.75 | 1725 | 460/3 | 1 | |
| UH-401 | UV DISINFECTON | UV DISINFECTON | CORR. RES. DOWNBLAST | 121.0 | -- | -- | 3900 | 60 | 8.1 | 200 | 0.28 | 0.75 | 1725 | 460/3 | 1 | |
| UH-402 | UV DISINFECTON | UV DISINFECTON | CORR. RES. DOWNBLAST | 121.0 | -- | -- | 3900 | 60 | 8.1 | 200 | 0.28 | 0.75 | 1725 | 460/3 | 1 | |
| UH-403 | UV DISINFECTON | UV DISINFECTON | CORR. RES. DOWNBLAST | 121.0 | -- | -- | 3900 | 60 | 8.1 | 200 | 0.28 | 0.75 | 1725 | 460/3 | 1 | |
| UH-404 | UV DISINFECTON | UV DISINFECTON | CORR. RES. DOWNBLAST | 121.0 | -- | -- | 3900 | 60 | 8.1 | 200 | 0.28 | 0.75 | 1725 | 460/3 | 1 | |
| UH-405 | UV DISINFECTON | STORAGE ROOM | STANDARD HOT WTR | 18.6 | -- | -- | 370 | 60 | 1.7 | 200 | 0.6 | 0.02 | 1550 | 120/1 | | |
| UH-406 | UV DISINFECTON | ELECTRIC ROOM | STANDARD HOT WTR | 18.6 | -- | -- | 370 | 60 | 1.7 | 200 | 0.6 | 0.02 | 1550 | 120/1 | | |
| UH-501 | OPERATIONS CENTER | MECH. ROOM | STANDARD HOT WTR | 5.0 | -- | -- | 0.5 | 200 | 1.0 | 0.2 | 1550 | 120/1 | | | | |
| UH-801 | SUBSTA. BATTERY BLDG. | BATTERY ROOM | STANDARD ELECTRIC | 42.7 | 12.5 | 460/3 | 630 | -- | -- | -- | 0.05 | 1600 | 460/1 | 2 | | |
| UH-802UH-803 | BOGT BLDG. | DECHLOR. ROOM | STANDARD ELECTRIC | 25.6 | 7.5 | 460/3 | 530 | -- | -- | -- | 0.05 | 1600 | 460/1 | 2 | | |

- NOTES:**
- UNIT, UNIT SUPPORTS AND ALL ASSOCIATED CONTROLS TO HAVE CORROSION RESISTANT CONSTRUCTION SUITABLE FOR ENVIRONMENTS SHOWN ON CONTRACT DRAWINGS AND AS SPECIFIED.
 - CONTROL POWER CONDUCTORS AND CONDUIT FROM UNIT HEATER CONTROLS TO CONTROLLING THERMOSTAT SHALL BE PROVIDED AND INSTALLED BY CONTRACT 4C.

11/28/00 S&W CMS
 \CONTRACT 2-5\HVAC\0659H001.DWG

| No. | Date | Revisions | Init |
|-----|---------|---------------------|------|
| 0 | 4/20/01 | ISSUED FOR APPROVAL | |
| 1 | | AS BID | |
| 2 | 1/30/05 | RECORD DRAWING | RCC |

In charge of --- DBP
 Designed by --- DBP
 Drawn by --- CMS
 Checked by --- DBP



NO ALTERATIONS PERMITTED HEREON EXCEPT AS PROVIDED UNDER SECTION 7209 SUBDIVISION 2 OF THE NEW YORK STATE EDUCATION LAW

VAV BOX SCHEDULE

| TAG | SPACES SERVED | TYPE OF CONTROL | MINIMUM PRIMARY AIRFLOW CFM | DESIGN PRIMARY AIRFLOW CFM | UNIT AIRFLOW CFM | REHEAT COIL LOAD BTU/HR | REHEAT COIL HOT WATER FLOW GPM | REHEAT COIL HOT WATER TEMP DEG F | REHEAT COIL MAX HEAD LOSS/FT | MAX NC | MOTOR HP | VOLTS/PH | NOTES |
|---------|---------------------|--|-----------------------------|----------------------------|------------------|-------------------------|--------------------------------|----------------------------------|------------------------------|--------|----------|----------|-------|
| VAV-501 | OC101 | FAN POWERED CAV WITH HOT WATER REHEAT COIL | 250 | 1,054 | 1,253 | 27,900 | 1.86 | 30.0 | 2.0 | 30.0 | 1/3 | 120/1 | |
| VAV-502 | OC102, OC202 | CAV WITH HOT WATER REHEAT COIL | 400 | 1,097 | 1,097 | 23,800 | 1.59 | 30.0 | 2.0 | 30.0 | N/A | N/A | |
| VAV-503 | OC104 | CAV WITH HOT WATER REHEAT COIL | 50 | 114 | 114 | 1,600 | 0.11 | 30.0 | 2.0 | 30.0 | N/A | N/A | |
| VAV-504 | OC106 | VAV WITH HOT WATER REHEAT COIL | 150 | 600 | 600 | 7,900 | 0.53 | 30.0 | 2.0 | 30.0 | N/A | N/A | |
| VAV-505 | OC107 | VAV WITH HOT WATER REHEAT COIL | 250 | 900 | 900 | 6,600 | 0.44 | 30.0 | 2.0 | 30.0 | N/A | N/A | |
| VAV-506 | OC109 | VAV WITH HOT WATER REHEAT COIL | 80 | 238 | 238 | 400 | 0.03 | 30.0 | 2.0 | 30.0 | N/A | N/A | |
| VAV-507 | OC110, OC114 | VAV WITH HOT WATER REHEAT COIL | 80 | 208 | 208 | 1,500 | 0.10 | 30.0 | 2.0 | 30.0 | N/A | N/A | |
| VAV-508 | OC113, OC210, OC309 | FAN POWERED CAV WITH HOT WATER REHEAT COIL | 80 | 14 | 304 | 6,600 | 0.44 | 30.0 | 2.0 | 30.0 | 1/10 | 120/1 | |
| VAV-509 | OC201 | FAN POWERED CAV WITH HOT WATER REHEAT COIL | 400 | 974 | 974 | 19,800 | 1.33 | 30.0 | 2.0 | 30.0 | 1/3 | 120/1 | |
| VAV-510 | OC203, OC209 | FAN POWERED CAV WITH HOT WATER REHEAT COIL | 80 | 378 | 378 | 5,300 | 0.35 | 30.0 | 2.0 | 30.0 | 1/10 | 120/1 | |
| VAV-511 | OC204, OC205, OC206 | CAV WITH HOT WATER REHEAT COIL | 120 | 400 | 400 | 1,700 | 0.11 | 30.0 | 2.0 | 30.0 | N/A | N/A | |
| VAV-512 | OC207, OC208 | FAN POWERED CAV WITH HOT WATER REHEAT COIL | 600 | 2,806 | 2,806 | 24,000 | 1.60 | 30.0 | 2.0 | 30.0 | 3/4 | 120/1 | |
| VAV-513 | OC211, OC212, OC213 | CAV WITH HOT WATER REHEAT COIL | 200 | 749 | 749 | 300 | 0.02 | 30.0 | 2.0 | 30.0 | N/A | N/A | |
| VAV-514 | OC301, OC302 | CAV WITH HOT WATER REHEAT COIL | 120 | 608 | 608 | 13,200 | 0.88 | 30.0 | 2.0 | 30.0 | N/A | N/A | |
| VAV-515 | OC303 | FAN POWERED CAV WITH HOT WATER REHEAT COIL | 150 | 526 | 526 | 9,300 | 0.62 | 30.0 | 2.0 | 30.0 | 1/4 | 120/1 | |
| VAV-516 | OC304 | VAV WITH HOT WATER REHEAT COIL | 200 | 950 | 950 | 2,400 | 0.18 | 30.0 | 2.0 | 30.0 | N/A | N/A | |
| VAV-517 | OC305 | VAV WITH HOT WATER REHEAT COIL | 100 | 342 | 342 | 3,100 | 0.21 | 30.0 | 2.0 | 30.0 | N/A | N/A | |
| VAV-518 | OC306 | FAN POWERED CAV WITH HOT WATER REHEAT COIL | 980 | 2,070 | 2,070 | 38,200 | 2.55 | 30.0 | 2.0 | 30.0 | 3/4 | 120/1 | |
| VAV-519 | OC311, OC307 | VAV WITH HOT WATER REHEAT COIL | 100 | 307 | 307 | 3,600 | 0.24 | 30.0 | 2.0 | 30.0 | N/A | N/A | |
| VAV-520 | OC312 | FAN POWERED CAV WITH HOT WATER REHEAT COIL | 160 | 491 | 491 | 5,800 | 0.37 | 30.0 | 2.0 | 30.0 | 1/4 | 120/1 | |
| VAV-521 | OC313 | VAV WITH HOT WATER REHEAT COIL | 250 | 853 | 853 | 14,100 | 0.94 | 30.0 | 2.0 | 30.0 | N/A | N/A | |








- NOTES:**
- VAV BOX SHALL HAVE SAME MANUFACTURER AS FUMEHOOD VAV CONTROL DAMPER.

RELIEF VENT SCHEDULE

| UNIT I.D. | BUILDING | SERVES ROOM | EQUIPMENT TYPE | THROAT DIMENSIONS (W" X H") | AR FLOW (CFM) | DAMPER OPERATOR TYPE | VOLTS/PHASE | INTERLOCK WITH | NOTES |
|--------------|--------------------|--------------------|---------------------------|-----------------------------|---------------|-----------------------|-------------|-----------------|-------|
| RV-201RV-202 | BAF COMPLEX | PLENUM ROOM | LOUVERED PENTHOUSE SUPPLY | 96" X 96" | 46,000 | -- | -- | -- | 1 |
| RV-301RV-302 | HRFS COMPLEX | HRFS GALLERIES | LOUVERED PENTHOUSE SUPPLY | 36" X 36" | 6000 | -- | -- | -- | 1 |
| RV-303RV-304 | HRFS COMPLEX | HYDROCYCLONE ENCL. | LOUVERED PENTHOUSE SUPPLY | 14" X 14" | 600 | -- | -- | -- | 1 |
| RV-501 | OPERATIONS CENTER | MECH. ROOM | LOUVERED PENTHOUSE INTAKE | 120" X 48" | 15,000 | PWR. OPEN/PWR. CLOSE | 120/1 | TO | 1 |
| RV-501RV502 | LOW LIFT PUMP STA. | BOILER ROOM | LOUVERED PENTHOUSE SUPPLY | 48" X 48" | 4000 | PWR. OPEN/SPR. RETURN | 120/1 | BOILERS & F-601 | 1,2 |
| RV-603 | LOW LIFT PUMP STA. | BOILER ROOM | LOUVERED PENTHOUSE EXH. | 42" X 42" | 4000 | -- | -- | -- | 1,2,3 |

- NOTES:**
- UNIT FINISH TO BE CLEAR ANODIZED.
 - UNIT TO BE SUPPORTED BY MASONRY CURB BY OTHERS. COORDINATE FOR CURB CAP DIMENSIONS.
 - INTERNALLY BLANK OFF THREE SIDES OF RELIEF VENT TO ALLOW EXHAUST ON SOUTH SIDE OF UNIT ONLY.

REFER TO O & M MANUAL FOR UPDATED EQUIPMENT SCHEDULES

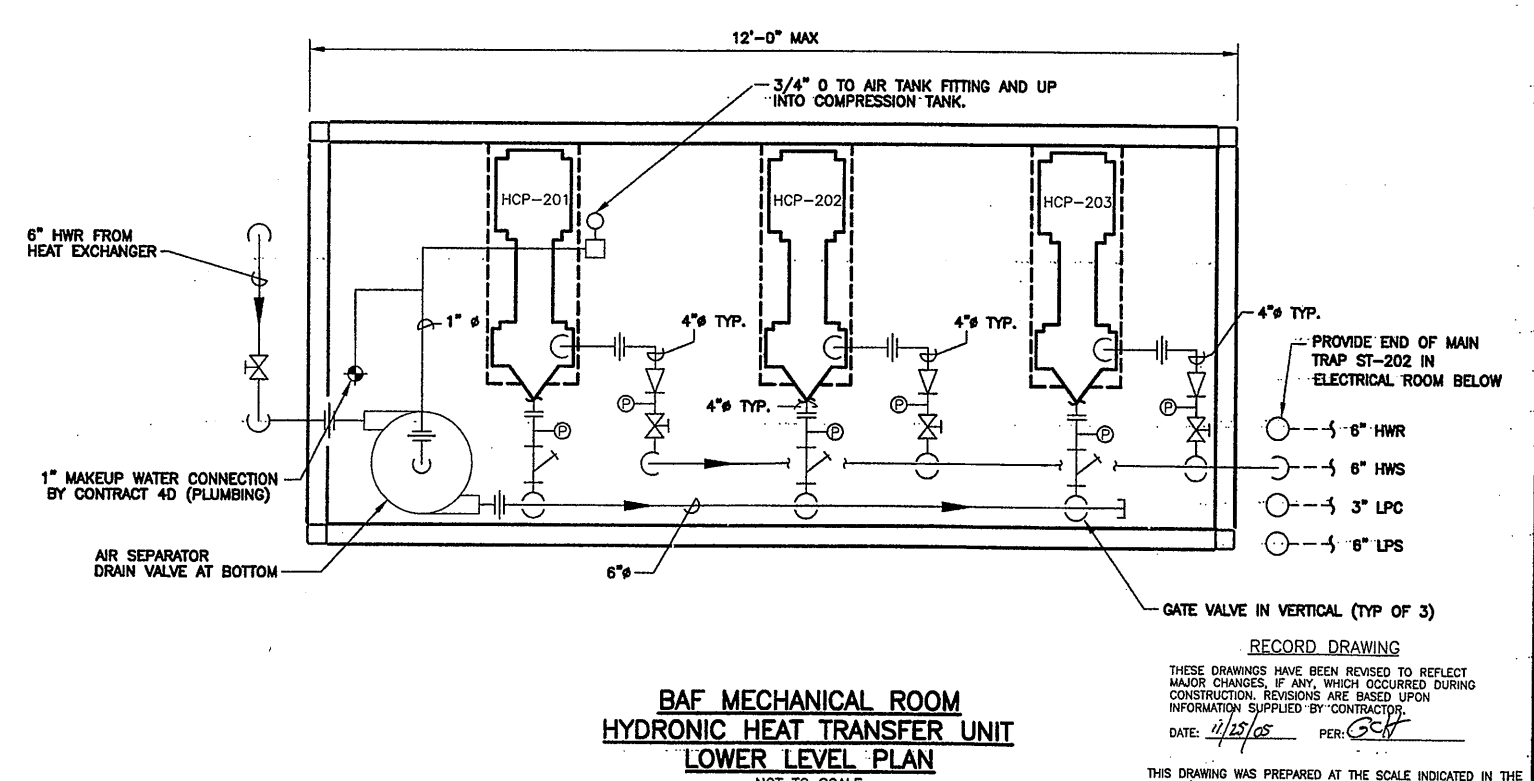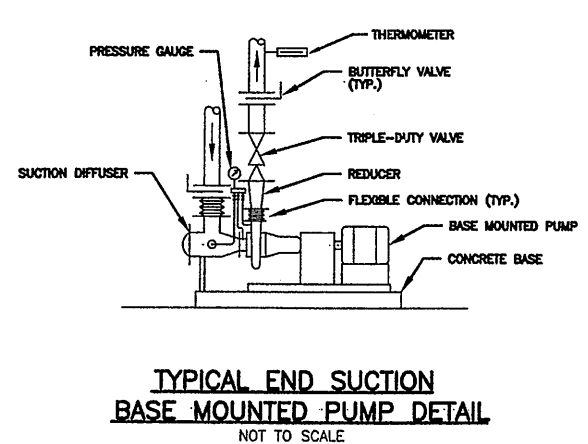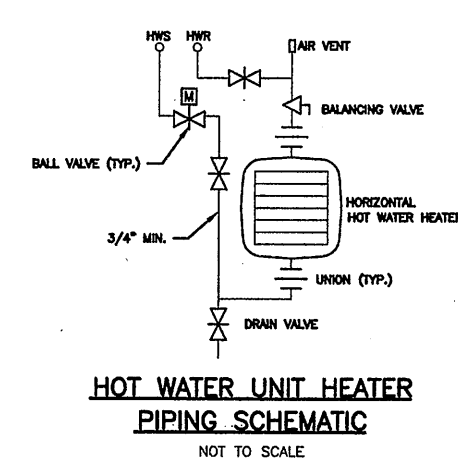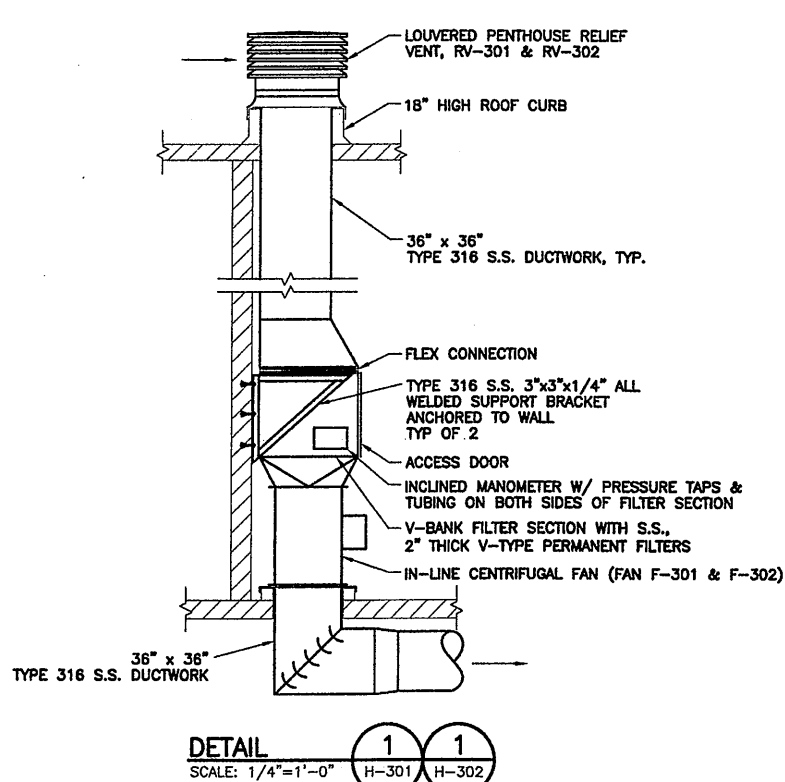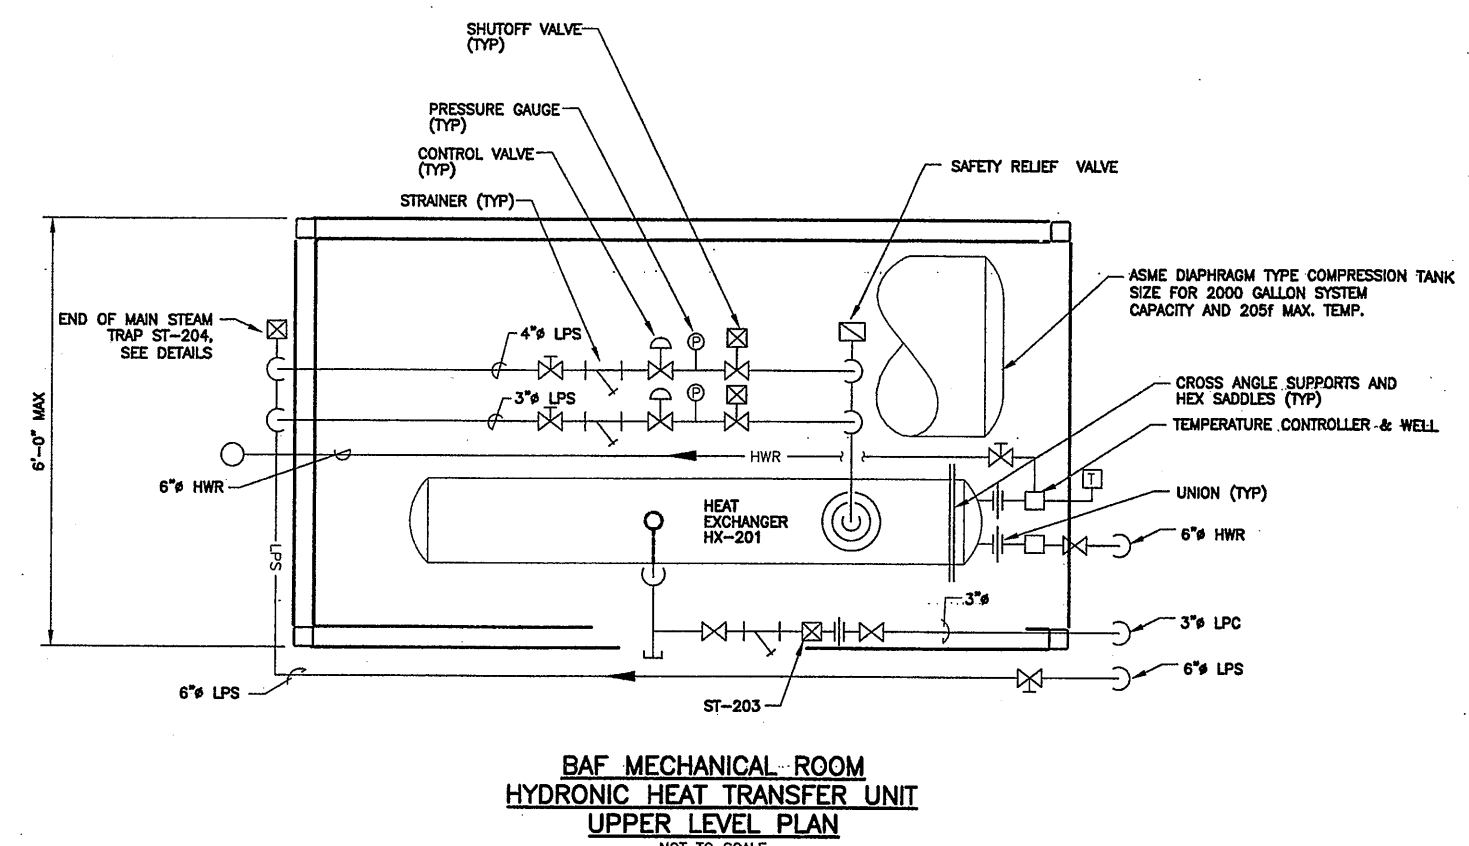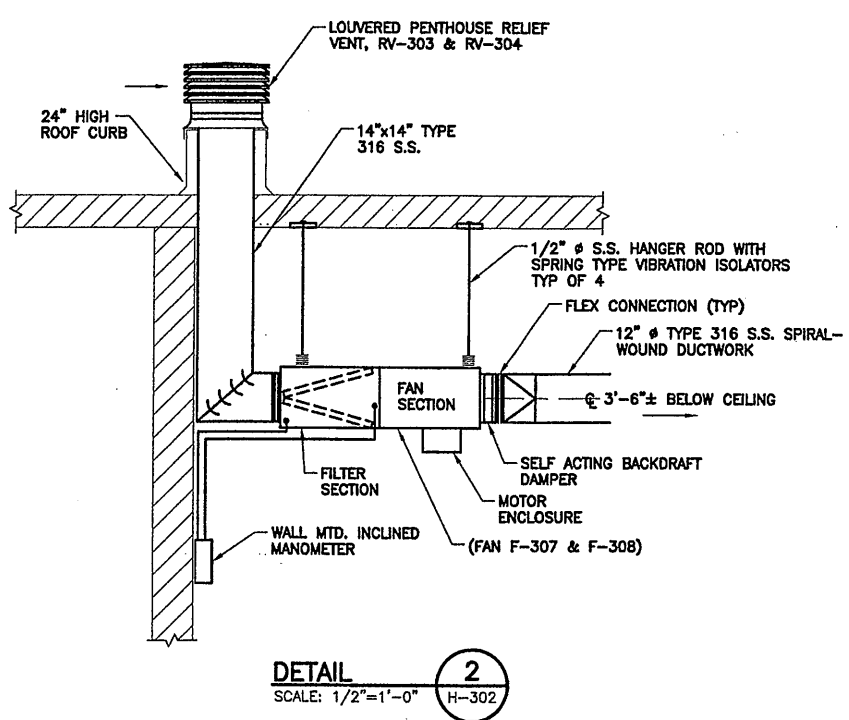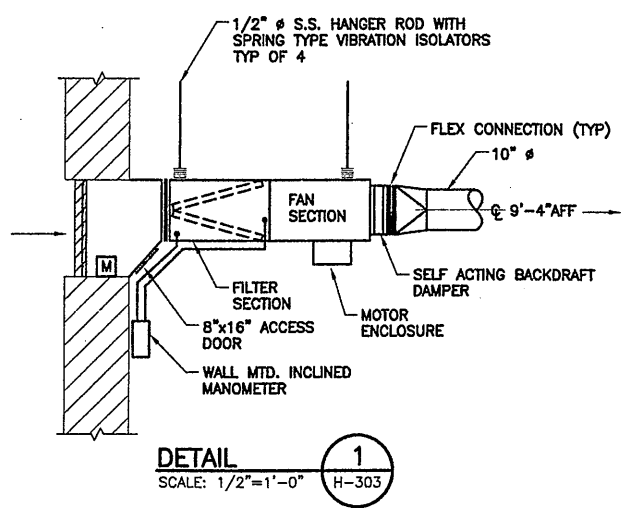

RECORD DRAWING
THESE DRAWINGS HAVE BEEN REVISED TO REFLECT MAJOR CHANGES, IF ANY, WHICH OCCURRED DURING CONSTRUCTION. REVISIONS ARE BASED UPON INFORMATION SUPPLIED BY CONTRACTOR.
DATE: 4/25/05 PER: GCH
THIS DRAWING WAS PREPARED AT THE SCALE INDICATED IN THE TITLE BLOCK. INACCURACIES IN THE STATED SCALE MAY BE INTRODUCED WHEN DRAWINGS ARE REPRODUCED BY ANY MEANS. USE THE GRAPHIC SCALE BAR IN THE TITLE BLOCK TO DETERMINE THE ACTUAL SCALE OF THIS DRAWING.

11/28/00 S&W TWA
...CONTRACT 2-5\HVAC\0659H004.DWG

| No. | Date | Revisions | Init |
|-----|---------|---------------------|------|
| 0 | 4/20/01 | ISSUED FOR APPROVAL | |
| 1 | | AS BID | |
| 2 | 1/30/05 | RECORD DRAWING | RCG |

In charge of... DBP
Designed by... DBP
Drawn by... CMS
Checked by... DBP


ENVIRONMENTAL ENGINEERING ASSOCIATES, LLP
SYRACUSE, NEW YORK

ONONDAGA COUNTY • DEPARTMENT OF DRAINAGE AND SANITATION • SYRACUSE, NEW YORK
METROPOLITAN SYRACUSE WASTEWATER TREATMENT PLANT
STAGE III AMMONIA AND STAGE II PHOSPHORUS REMOVAL PROJECT

SCHEMATICS AND DETAILS
HVAC


File Number: 00659
Date: APRIL 2001
H-004
Professional Engineer Seal: STATE OF NEW YORK, JEROME C. HOOP, No. 67864

NO ALTERATIONS PERMITTED HEREON EXCEPT AS PROVIDED UNDER SECTION 7209 SUBDIVISION 2 OF THE NEW YORK STATE EDUCATION LAW

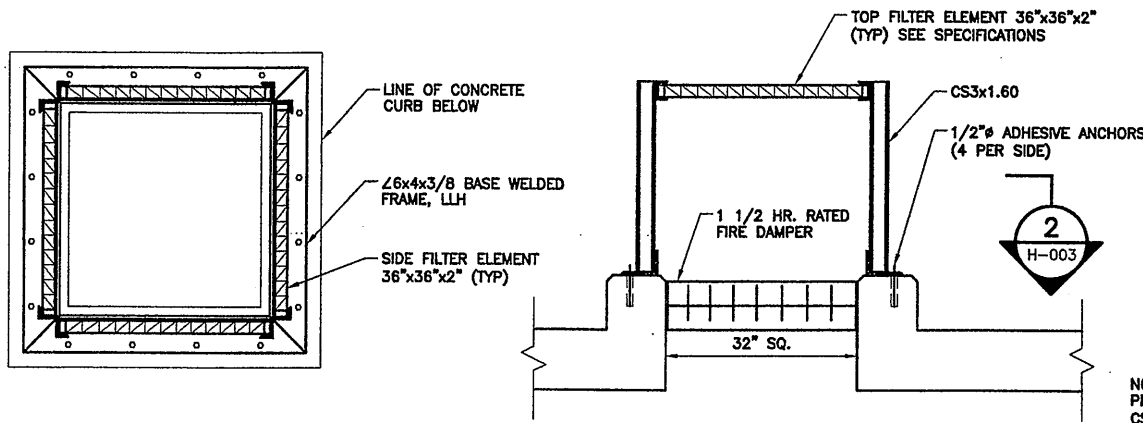


SECTION 2
SCALE: 3/4"=1'-0" H-003


SECTION 1
SCALE: 3/4"=1'-0" H-003

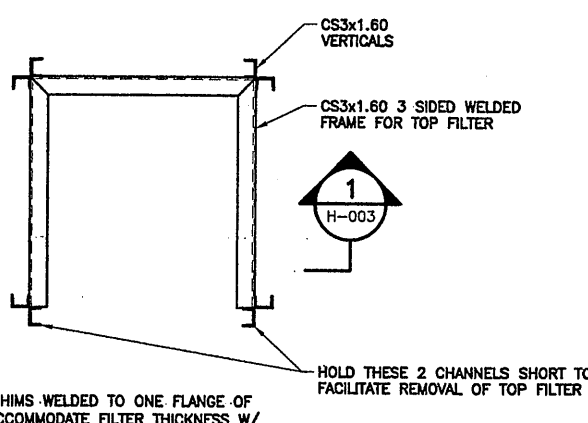


TOP VIEW - WELDED ALUM. FILTER FRAME
SCALE: 3/4"=1'-0"

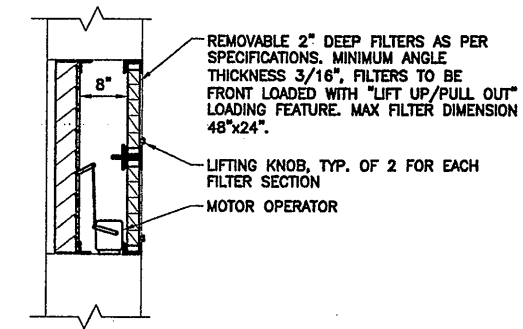


TYPICAL FILTERED INLET LOUVER INSTALLATION DETAIL
N.T.S.

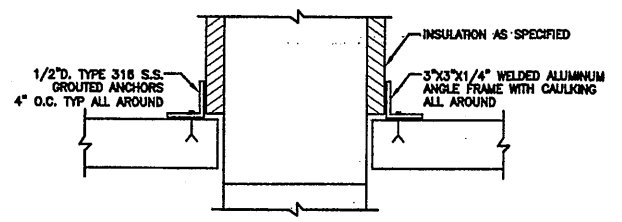


DUCT THROUGH FLOOR PENETRATION DETAIL
NOT TO SCALE

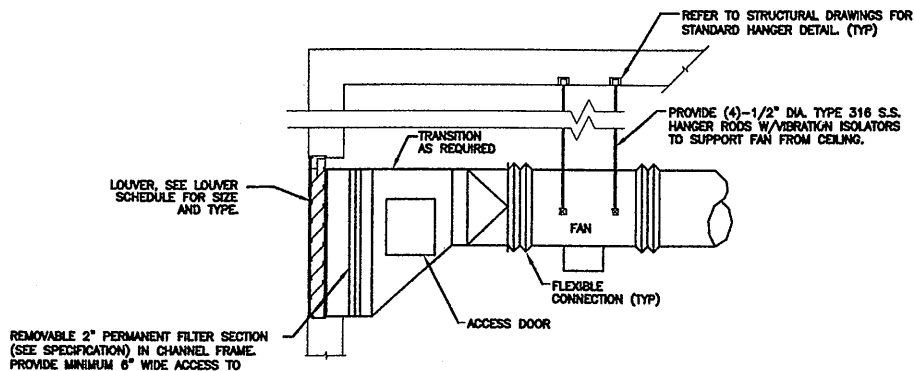


INLINE SUPPLY FAN MOUNTING DETAIL
NOT TO SCALE

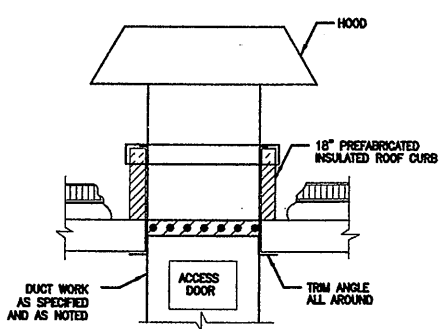


VANE AXIAL HOODED ROOFTOP EXHAUST FAN
NOT TO SCALE

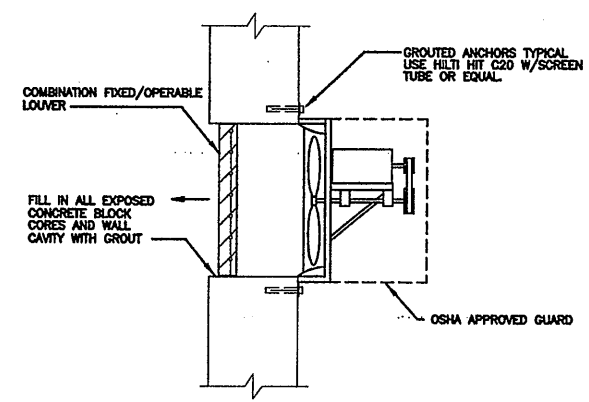


WALL MOUNTED PROPELLER EXHAUST FAN MOUNTING DETAIL
NOT TO SCALE

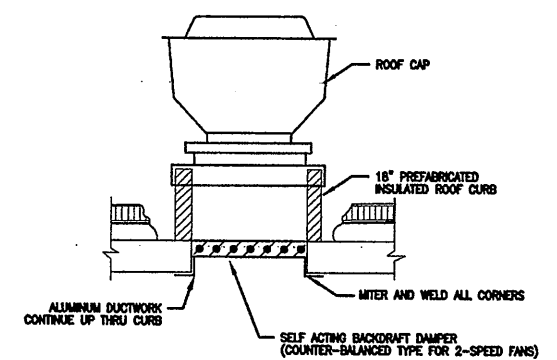


TYPICAL ROOFTOP CENTRIFUGAL EXHAUST FAN
NOT TO SCALE

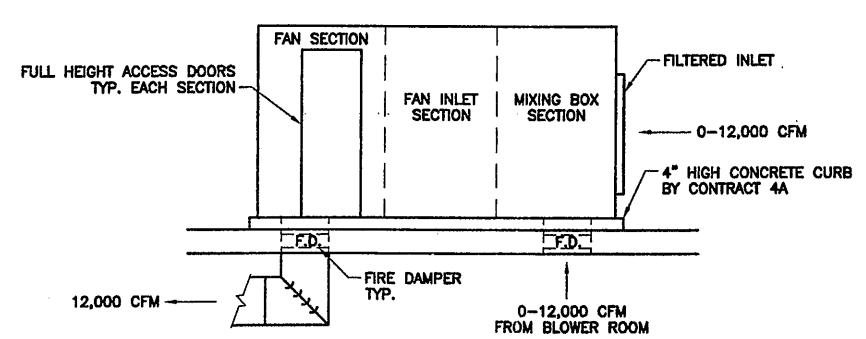

AHU-201 INSTALLATION DETAIL
SCALE: 1/4"=1'-0"

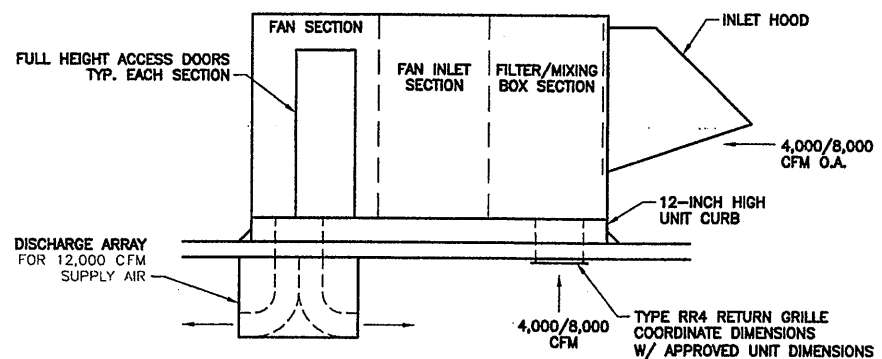

AHU-301 INSTALLATION DETAIL
SCALE: 1/4"=1'-0"

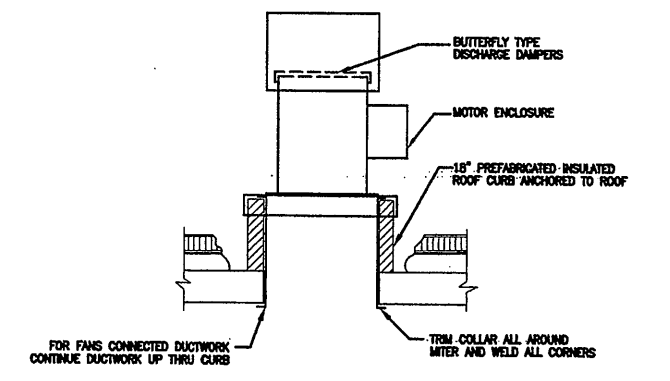

ROOFTOP INLINE CENTRIFUGAL EXHAUST FAN DETAIL
NOT TO SCALE

RECORD DRAWING

THESE DRAWINGS HAVE BEEN REVISED TO REFLECT MAJOR CHANGES, IF ANY, WHICH OCCURRED DURING CONSTRUCTION. REVISIONS ARE REPRODUCED BY ANY MEANS, INFORMATION SUPPLIED BY CONTRACTOR.
DATE: 11/23/05 PER: SCB

THIS DRAWING WAS PREPARED AT THE SCALE INDICATED IN THE TITLE BLOCK. INACCURACIES IN THE STATED SCALE MAY BE INTRODUCED WHEN DRAWINGS ARE REPRODUCED BY ANY MEANS. USE THE GRAPHIC SCALE BAR IN THE TITLE BLOCK TO DETERMINE THE ACTUAL SCALE OF THIS DRAWING.

11/28/00 S&W CMS
CONTRACT 2-5/HVAC/0659H003.DWG

| No. | Date | Revisions | Init |
|-----|---------|---------------------|------|
| 0 | 4/20/01 | ISSUED FOR APPROVAL | |
| 1 | | AS BID | |
| 2 | 1/30/05 | RECORD DRAWING | RCG |


In charge of -- DBP
Designed by -- DBP
Drawn by -- CMS
Checked by -- DBP



ONONDAGA COUNTY • DEPARTMENT OF DRAINAGE AND SANITATION • SYRACUSE, NEW YORK
METROPOLITAN SYRACUSE WASTEWATER TREATMENT PLANT
STAGE III AMMONIA AND STAGE II PHOSPHORUS REMOVAL PROJECT

SCHEMATICS AND DETAILS


HVAC

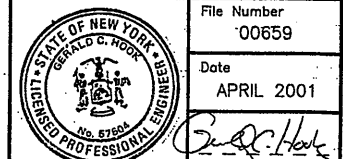


File Number 00659
Date APRIL 2001

H-005


NO ALTERATIONS PERMITTED HEREON EXCEPT AS PROVIDED UNDER SECTION 7209 SUBDIVISION 2 OF THE NEW YORK STATE EDUCATION LAW

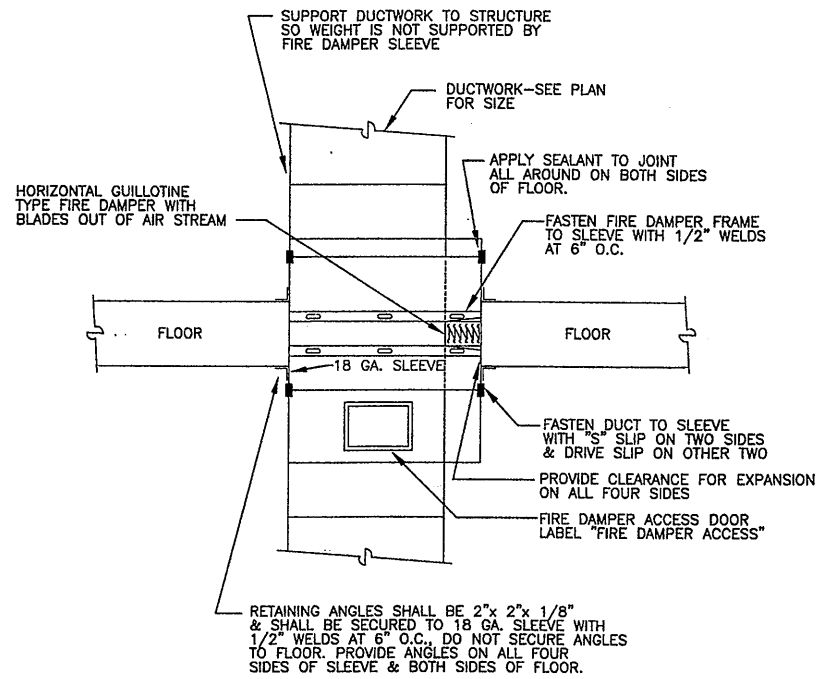


FIRE DAMPER AT FLOOR DETAIL
NOT TO SCALE

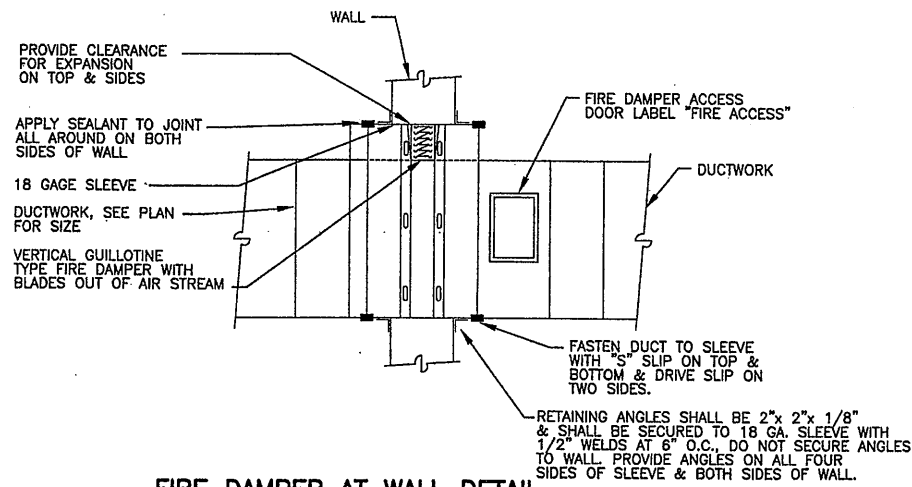

FIRE DAMPER AT WALL DETAIL
NOT TO SCALE

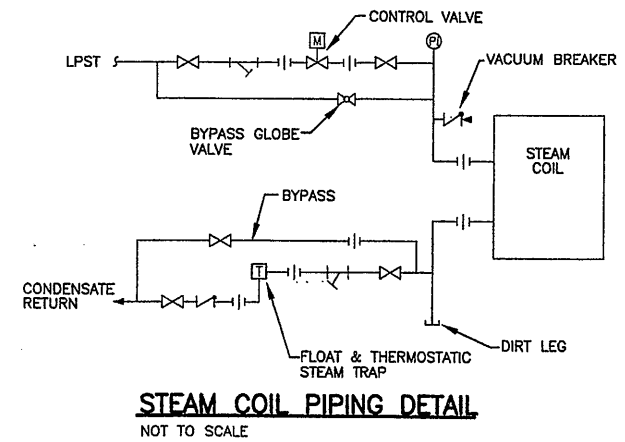


STEAM COIL PIPING DETAIL
NOT TO SCALE

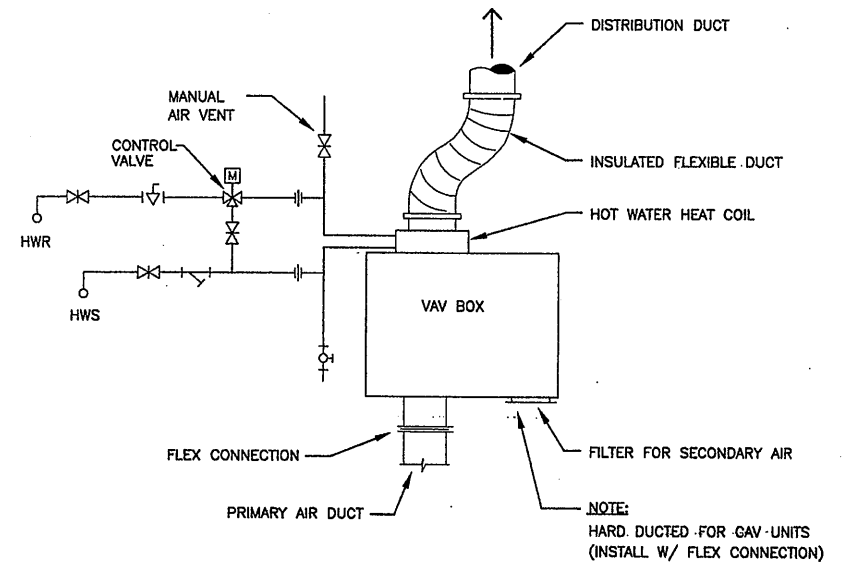


VAV BOX DETAIL
NOT TO SCALE

NOTES:
1. FAN-POWERED VAV BOX SHOWN. STANDARD VAV BOX AND CONSTANT-VOLUME VAV BOX DETAILS SHALL BE SIMILAR.

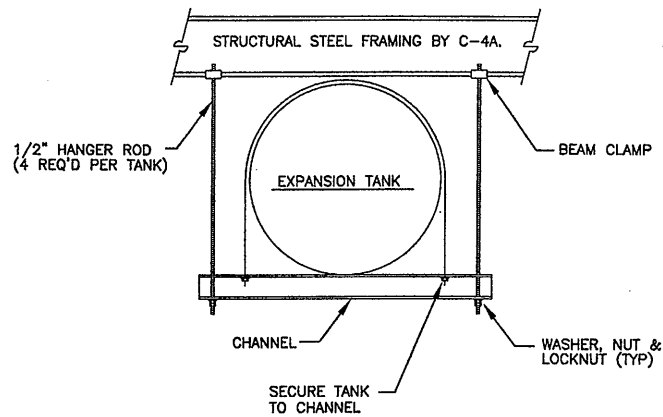


EXPANSION TANK SUPPORT DETAIL
NOT TO SCALE

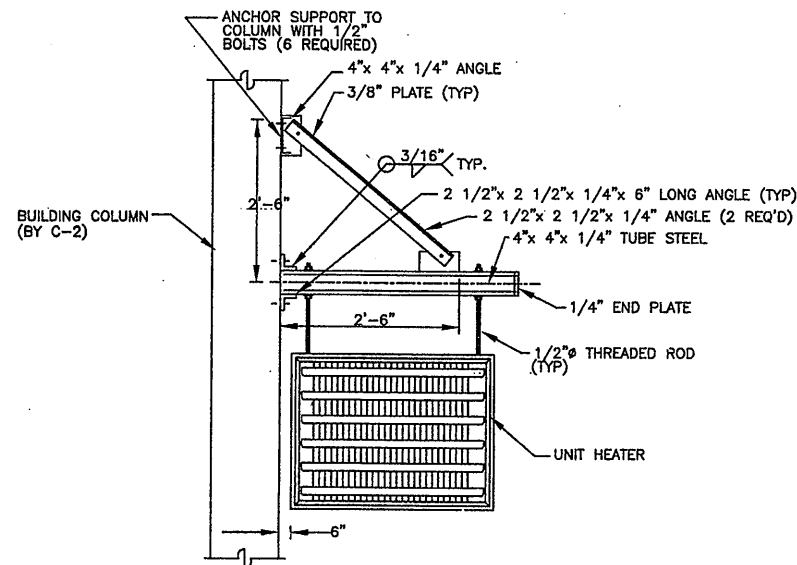


UNIT HEATER SUPPORT DETAIL
NOT TO SCALE

NOTES:
1. FOR UNIT HEATER IN OPERATIONS CENTER MECHANICAL ROOM.

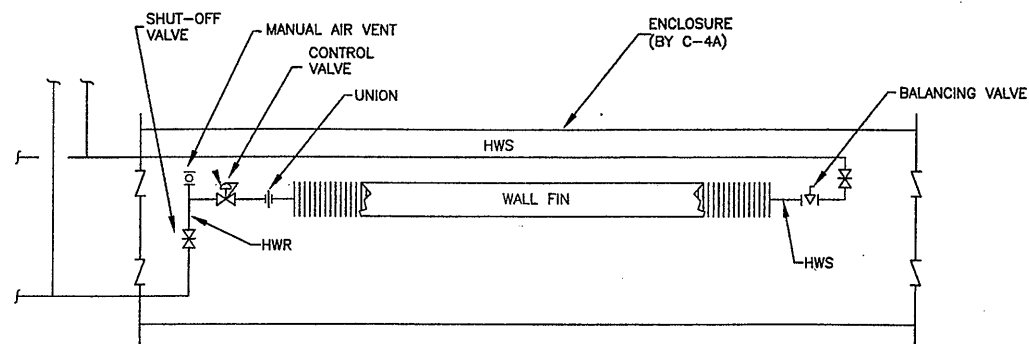

FIN TUBE RADIATION PIPING DETAIL
NOT TO SCALE

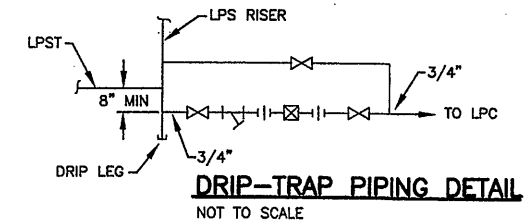

NOTES:
1. DRIP LEG SHALL BE FULL SIZE OF LPST LINE.

RECORD DRAWING

THESE DRAWINGS HAVE BEEN REVISED TO REFLECT MAJOR CHANGES, IF ANY, WHICH OCCURRED DURING CONSTRUCTION. REVISIONS ARE BASED UPON INFORMATION SUPPLIED BY CONTRACTOR.

DATE: 1/27/05 PER: GCH

THIS DRAWING WAS PREPARED AT THE SCALE INDICATED IN THE TITLE BLOCK. INACCURACIES IN THE STATED SCALE MAY BE INTRODUCED WHEN DRAWINGS ARE REPRODUCED BY ANY MEANS. USE THE GRAPHIC SCALE BAR IN THE TITLE BLOCK TO DETERMINE THE ACTUAL SCALE OF THIS DRAWING.

Layer: ON=*; OFF=*REF*
07/17/00 OBG JAS
00659H006

| No. | Date | Revisions | Init |
|-----|---------|---------------------|------|
| 0 | 4/20/01 | ISSUED FOR APPROVAL | |
| 1 | | AS BID | |
| 2 | 1/30/05 | RECORD DRAWING | RCG |

In charge of --- DPB ---
Designed by --- SWM ---
Drawn by --- KJL ---
Checked by --- SWM ---

ENVIRONMENTAL ENGINEERING ASSOCIATES, LLP
SYRACUSE, NEW YORK

ONONDAGA COUNTY • DEPARTMENT OF DRAINAGE AND SANITATION • SYRACUSE, NEW YORK
METROPOLITAN SYRACUSE WASTEWATER TREATMENT PLANT
STAGE III AMMONIA AND STAGE II PHOSPHORUS REMOVAL PROJECT

DETAILS

HVAC




File Number
00659

Date
APRIL 2001

H-006

NO ALTERATIONS PERMITTED HEREON EXCEPT AS PROVIDED UNDER SECTION 7209 SUBDIVISION 2 OF THE NEW YORK STATE EDUCATION LAW

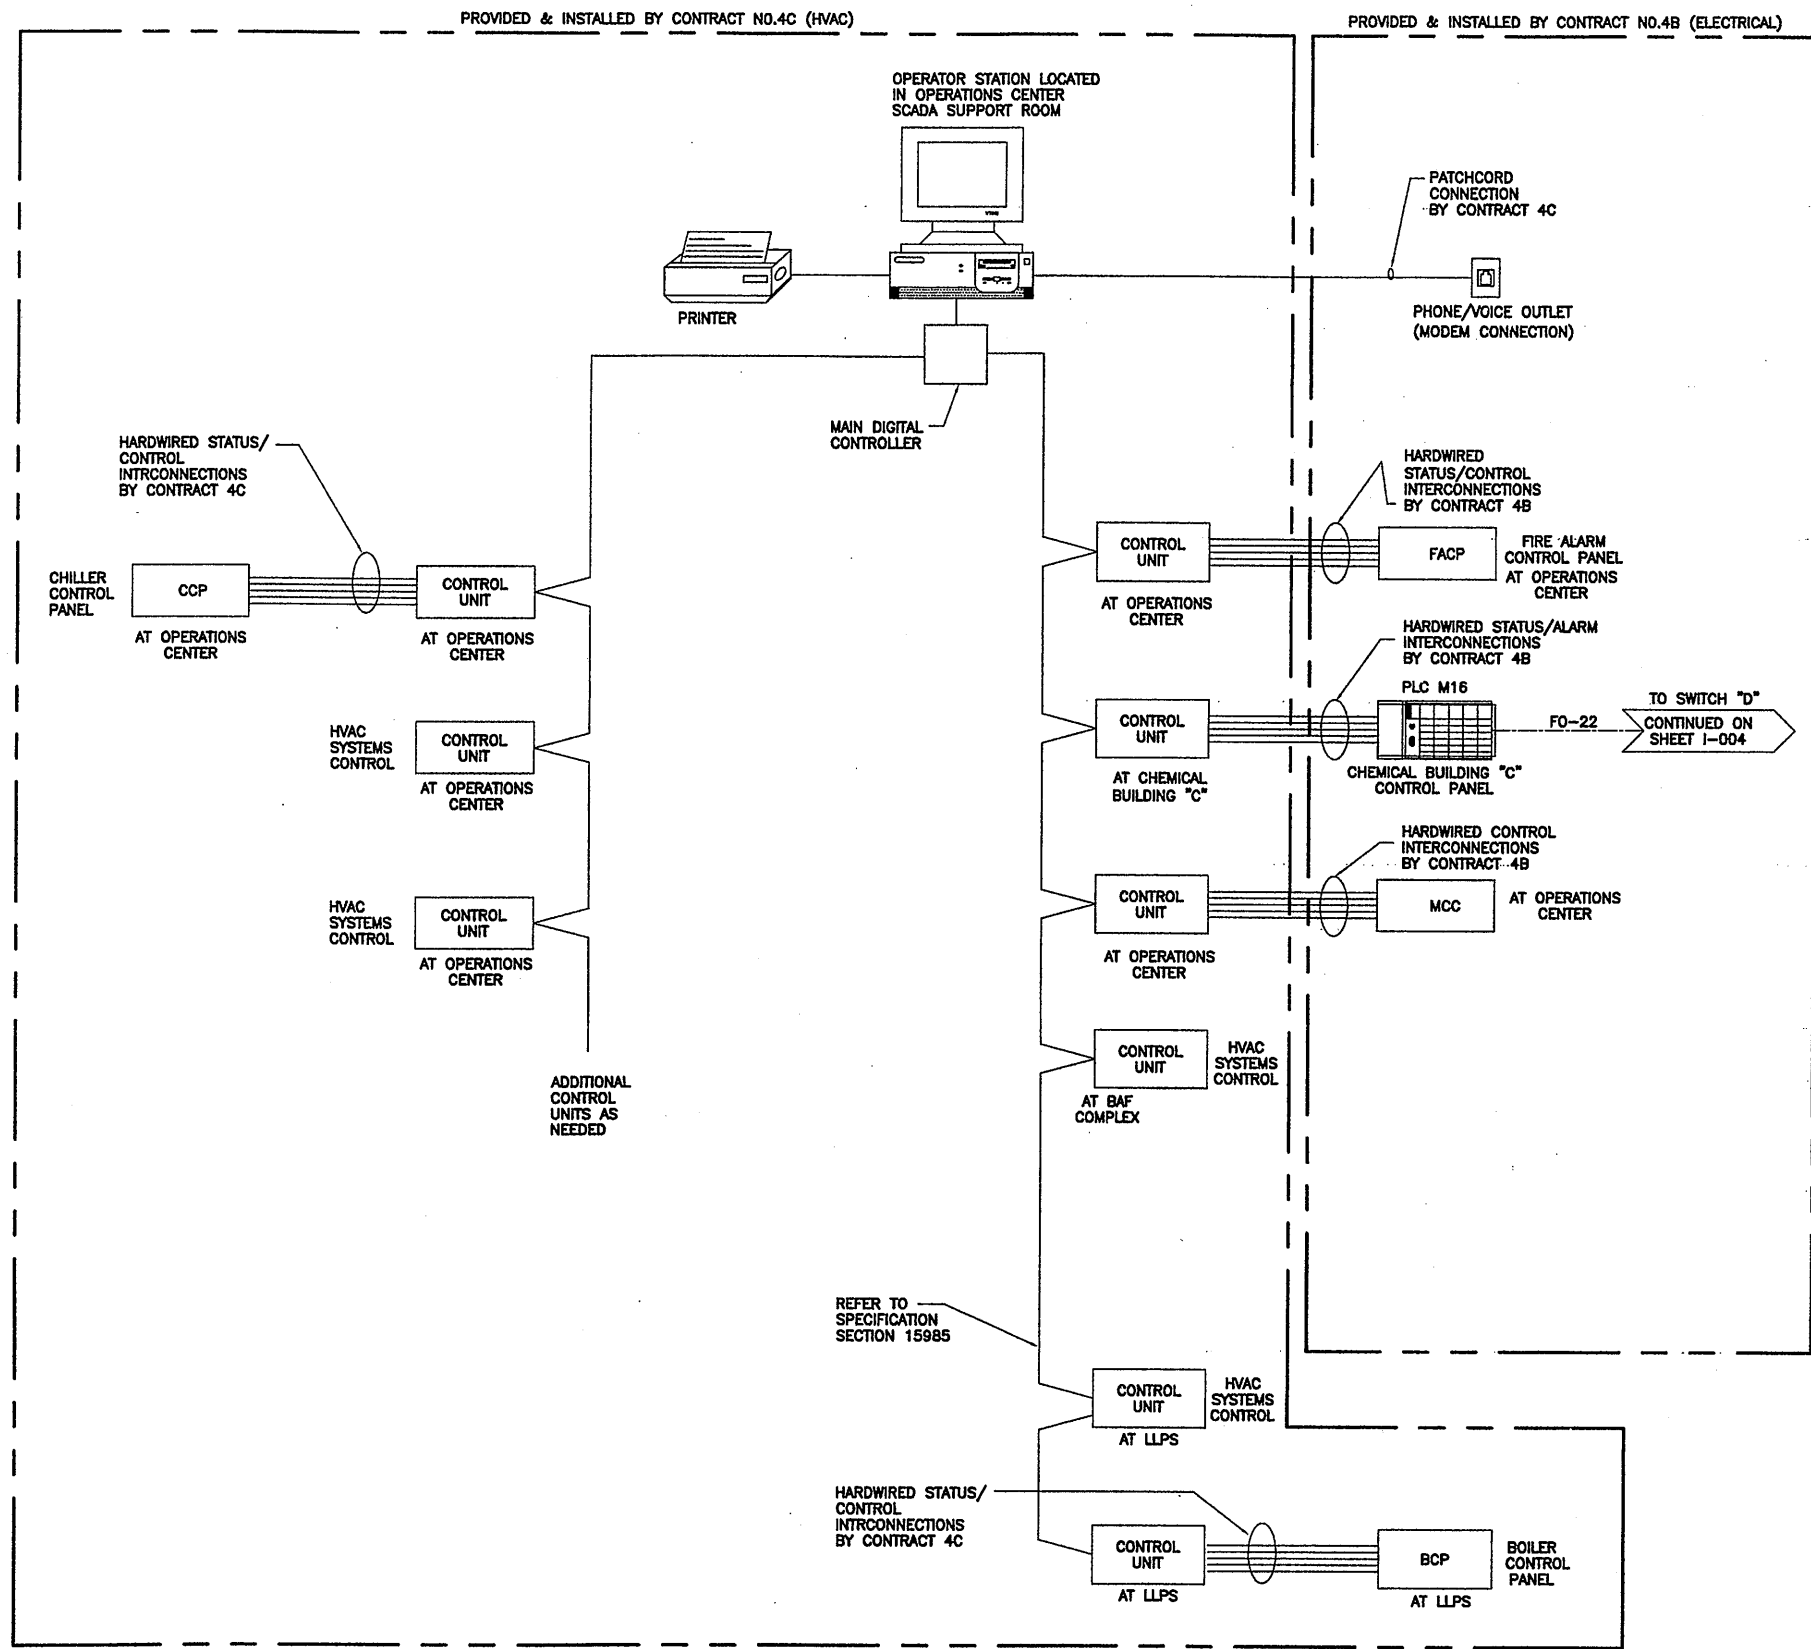

- HVAC DIRECT CONTROL (DDC) SCADA SUBSYSTEM SCOPE OF WORK**
1. THIS SCOPE OF WORK IS INTENDED TO SUMMARIZE THE REQUIREMENTS OF THE SPECIFICATION AND DRAWINGS. THE CONTRACTOR IS REQUIRED TO PROVIDE AND INSTALL ALL EQUIPMENT, SOFTWARE, AND APPURTENANCES SHOWN AND/OR REQUIRED FOR A COMPLETE OPERATING SYSTEM.
 2. THE BUILDING MANAGEMENT SUPERVISORY CONTROL AND DATA ACQUISITION SYSTEM SHALL BE A SEPARATE STAND-ALONE SYSTEM PROVIDED AND INSTALLED BY CONTRACT 4C - HVAC. THE BUILDING-MANAGEMENT SYSTEM SHALL INTERFACE WITH THE OVERALL PLANTWIDE SCADA SYSTEM THROUGH A HARDWIRED INTERCONNECTION TO BE PROVIDED AND INSTALLED BY CONTRACT 4B - ELECTRICAL, AS SHOWN.
 3. PROVIDE HARDWIRED INTERCONNECTION BETWEEN PLC M16 AND BUILDING MANAGEMENT LOCAL CONTROL UNIT, AS SHOWN.
 4. ACTUAL BUILDING MANAGEMENT SYSTEM COMPONENTS AND CONNECTIONS SHALL BE AS SPECIFIED UNDER DIVISION 15 AND SHOWN ON "H" SHEETS.
 5. SIMPLICITY BASED ALARM AND STATUS SCREENS FOR MONITORED POINTS AND ALARMS SHALL BE RESIDENT ON EACH WORKSTATION WITHIN OPERATIONS CENTER CONTROL ROOM.
 6. PROVIDE, INSTALL, STARTUP, TEST, AND PROVIDE TRAINING ASSOCIATED INTERCONNECTION OF PLANTWIDE SCADA SYSTEM AND DIRECT DIGITAL CONTROL SYSTEM.
 7. DDC SYSTEM (HVAC) OIT IS TO BE LOCATED IN THE OPERATION CENTER SCADA SUPPORT ROOM.
 8. ACTUAL HVAC DDC SYSTEM COMPONENTS AND CONNECTIONS SHALL BE AS SPECIFIED UNDER DIVISION 15 AND SHOWN ON "H" SHEETS.
 9. REFER TO DRAWING G-004 FOR PLANT LAYOUT AND BUILDING LOCATIONS.

LEGEND

LLPS- LOW-LIFT PUMP STATION
MCC- MOTOR CONTROL CENTER
PLC- PROGRAMMABLE LOGIC CONTROLLER
SCADA- SUPERVISORY CONTROL AND DATA ACQUISITION

KEY:

----- FIBER OPTIC CABLE (FO)
————— COPPER CABLE

REFER TO O & M MANUAL FOR UPDATED HVAC CONTROL SYSTEM ARCHITECTURE

RECORD DRAWING
THESE DRAWINGS HAVE BEEN REVISED TO REFLECT MAJOR CHANGES, IF ANY, WHICH OCCURRED DURING CONSTRUCTION. REVISIONS ARE BASED UPON INFORMATION SUPPLIED BY CONTRACTOR.

THIS DRAWING WAS PREPARED AT THE SCALE INDICATED IN THE TITLE BLOCK. INACCURACIES IN THE STATED SCALE MAY BE INTRODUCED WHEN DRAWINGS ARE REPRODUCED BY ANY MEANS. USE THE GRAPHIC SCALE BAR IN THE TITLE BLOCK TO DETERMINE THE ACTUAL SCALE OF THIS DRAWING.

02/15/01 OBG JAS
00659H007

| No. | Date | Revisions | Init |
|-----|---------|---------------------|------|
| 0 | 4/20/01 | ISSUED FOR APPROVAL | |
| 1 | | AS BID | |
| 2 | 1/30/05 | RECORD DRAWING | RCG |

In charge of — DBP
Designed by — SWM
Drawn by — KJL
Checked by — SWM



ONONDAGA COUNTY • DEPARTMENT OF DRAINAGE AND SANITATION • SYRACUSE, NEW YORK
METROPOLITAN SYRACUSE WASTEWATER TREATMENT PLANT
STAGE III AMMONIA AND STAGE II PHOSPHORUS REMOVAL PROJECT

HVAC CONTROL SYSTEM ARCHITECTURE



File Number
'00659
Date
APRIL 2001


H-007

NO ALTERATIONS PERMITTED HEREON EXCEPT AS PROVIDED UNDER SECTION 7209 SUBDIVISION 2 OF THE NEW YORK STATE EDUCATION LAW


HVAC

NOTE 1. FOR FANS F-101, 102 & 103, PROVIDE 1/2" DEEP GALVANIZED STEEL DRIP PAN UNDER EACH FAN. DRIP PAN DIMENSIONS SHALL BE 8" GREATER THAN ROOF PENETRATION DIMENSION. PROVIDE 2x2 1/2" STEEL ANGLE FRAME ALL AROUND. ATTACH FRAME TO BOTTOM CORD OF ROOF JOISTS. CROSS BREAK DRIP PAN BASES TO PREVENT BREATHING.

NOTE 2. FAN LOCATIONS HAVE CHANGED AND LOUVER DIMENSIONS HAVE CHANGED.

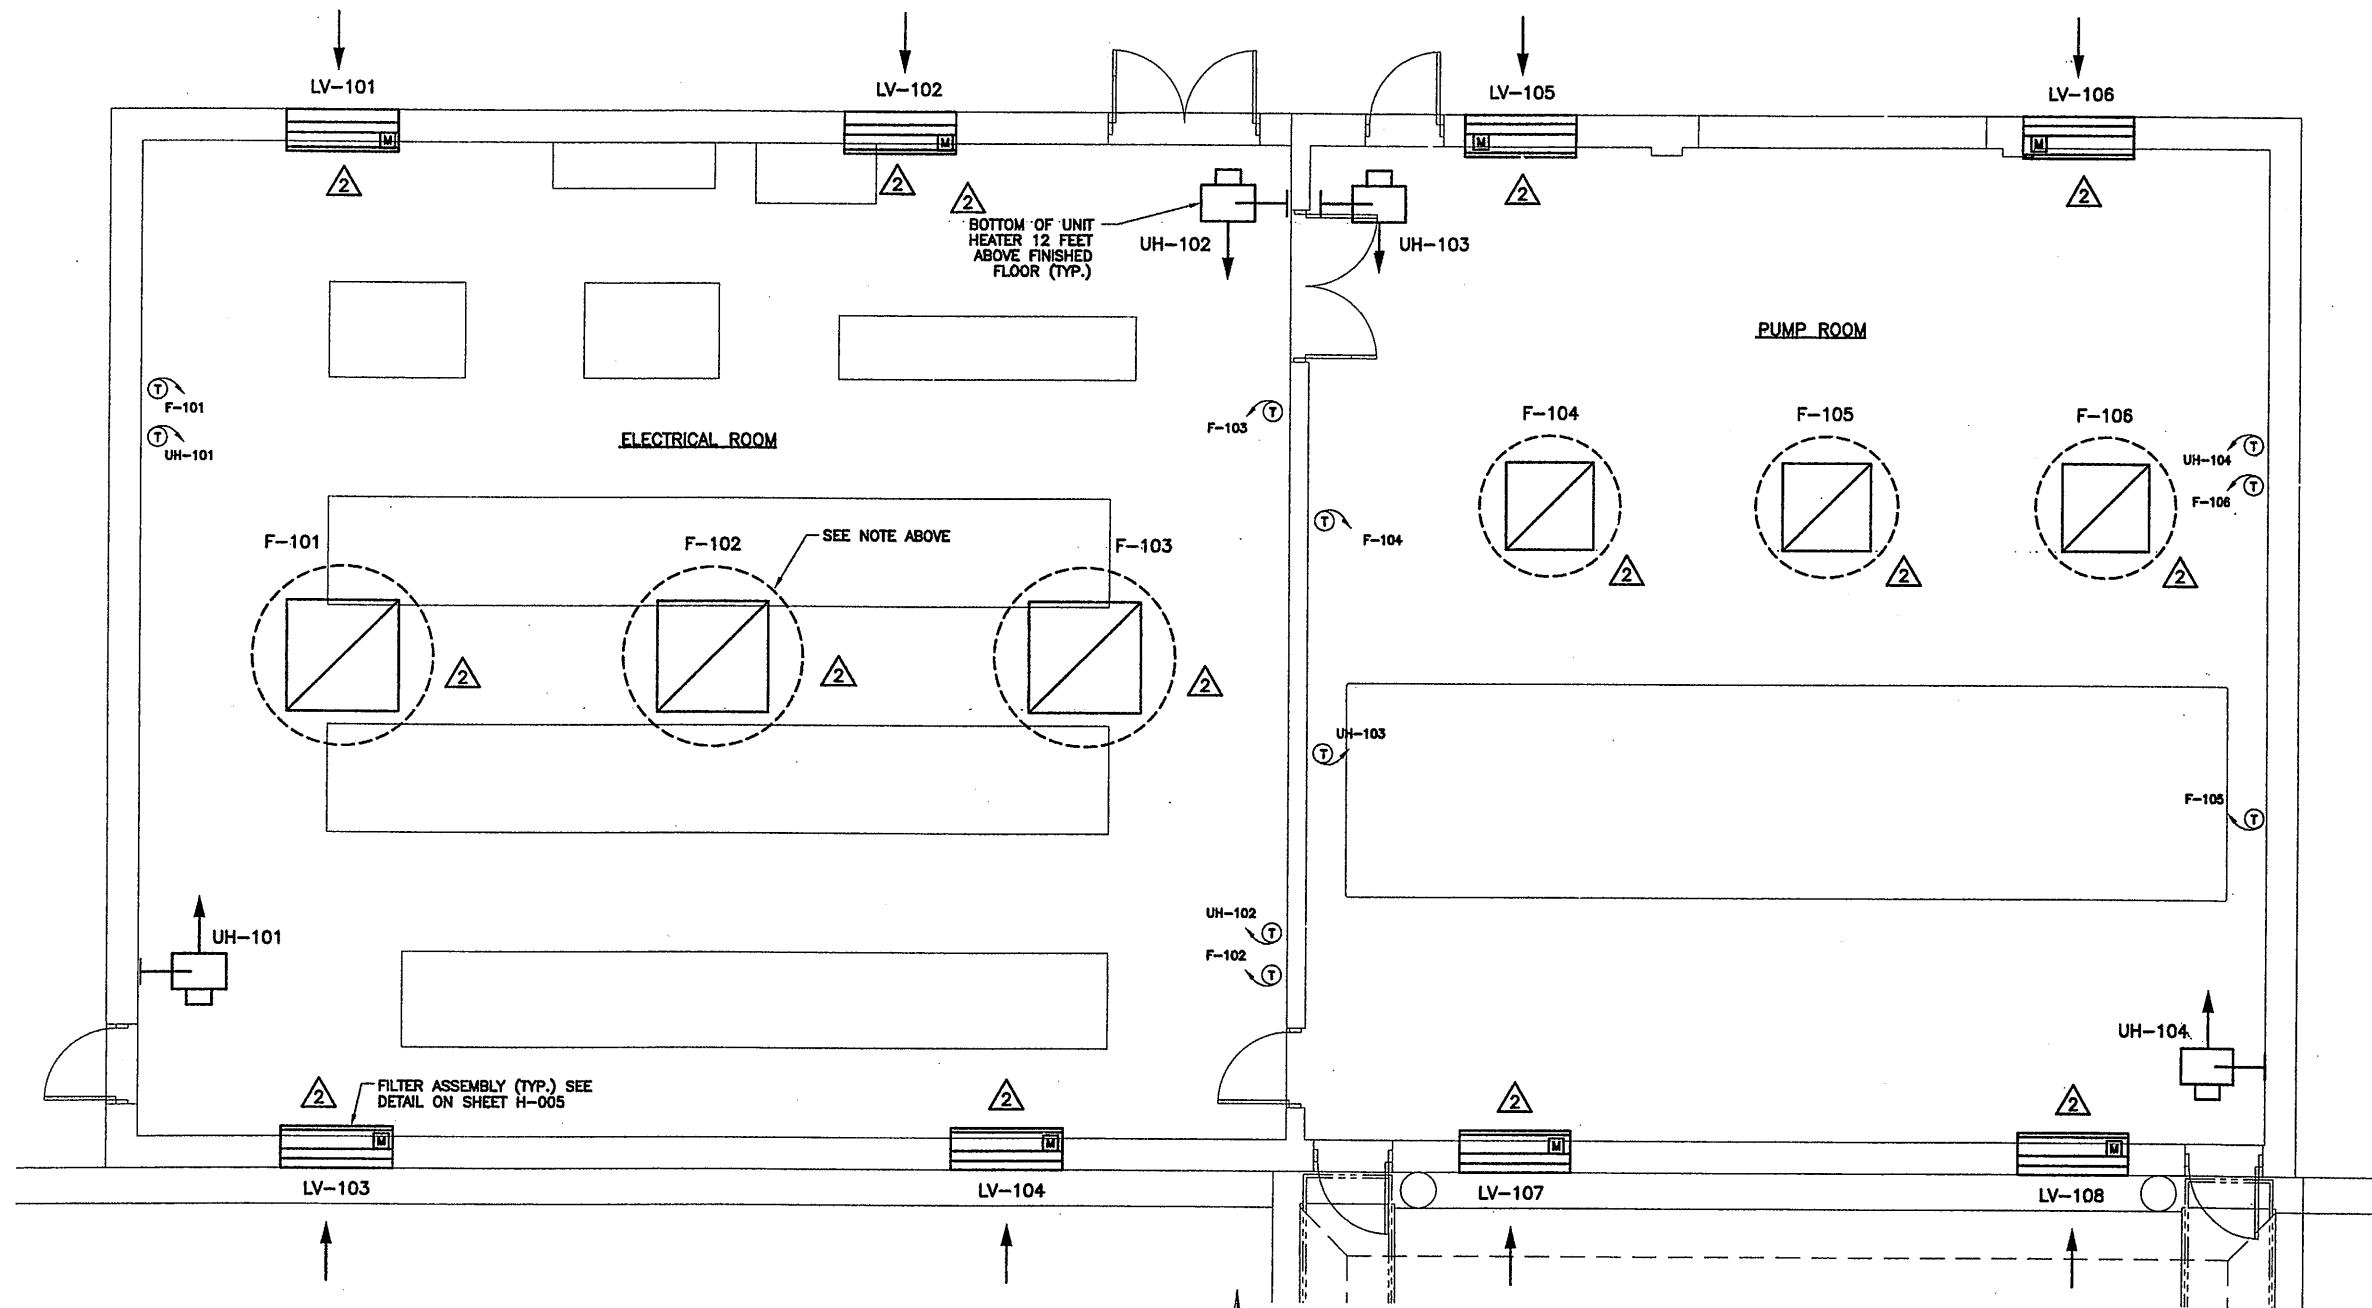

0659X101
11/28/00 SW CMS
...CONTRACT 2-5\HVAC\0659H101.DWG

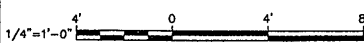

NO ALTERATIONS PERMITTED HEREON EXCEPT AS PROVIDED UNDER SECTION 7209 SUBDIVISION 2 OF THE NEW YORK STATE EDUCATION LAW

| No. | Date | Revisions | Init |
|-----|---------|---------------------------------|------|
| 0 | 4/20/01 | ISSUED FOR APPROVAL | |
| 1 | 6/26/01 | AS BID | |
| 2 | 3/22/02 | REVISED FOR MODIFICATION 4C-001 | |
| 3 | 1/30/03 | RECORD DRAWING | RCG |

In charge of --- DBP
Designed by --- DBP
Drawn by --- CMS
Checked by --- DBP



ONONDAGA COUNTY • DEPARTMENT OF DRAINAGE AND SANITATION • SYRACUSE, NEW YORK
METROPOLITAN SYRACUSE WASTEWATER TREATMENT PLANT
STAGE III AMMONIA AND STAGE II PHOSPHORUS REMOVAL PROJECT
**SECONDARY EFFLUENT PUMP STATION
HVAC PLAN**

HVAC

THESE DRAWINGS HAVE BEEN REVISED TO REFLECT MAJOR CHANGES, IF ANY, WHICH OCCURRED DURING CONSTRUCTION. REVISIONS ARE BASED UPON INFORMATION SUPPLIED BY CONTRACTOR.
DATE: 1/23/05 PER: GSH

THIS DRAWING WAS PREPARED AT THE SCALE INDICATED IN THE TITLE BLOCK. INACCURACIES IN THE STATED SCALE MAY BE INTRODUCED WHEN DRAWINGS ARE REPRODUCED BY ANY MEANS. USE THE GRAPHIC SCALE BAR IN THE TITLE BLOCK TO DETERMINE THE ACTUAL SCALE OF THIS DRAWING.




File Number
00659


Date
APRIL 2001

H-101


Gerald C. Hook

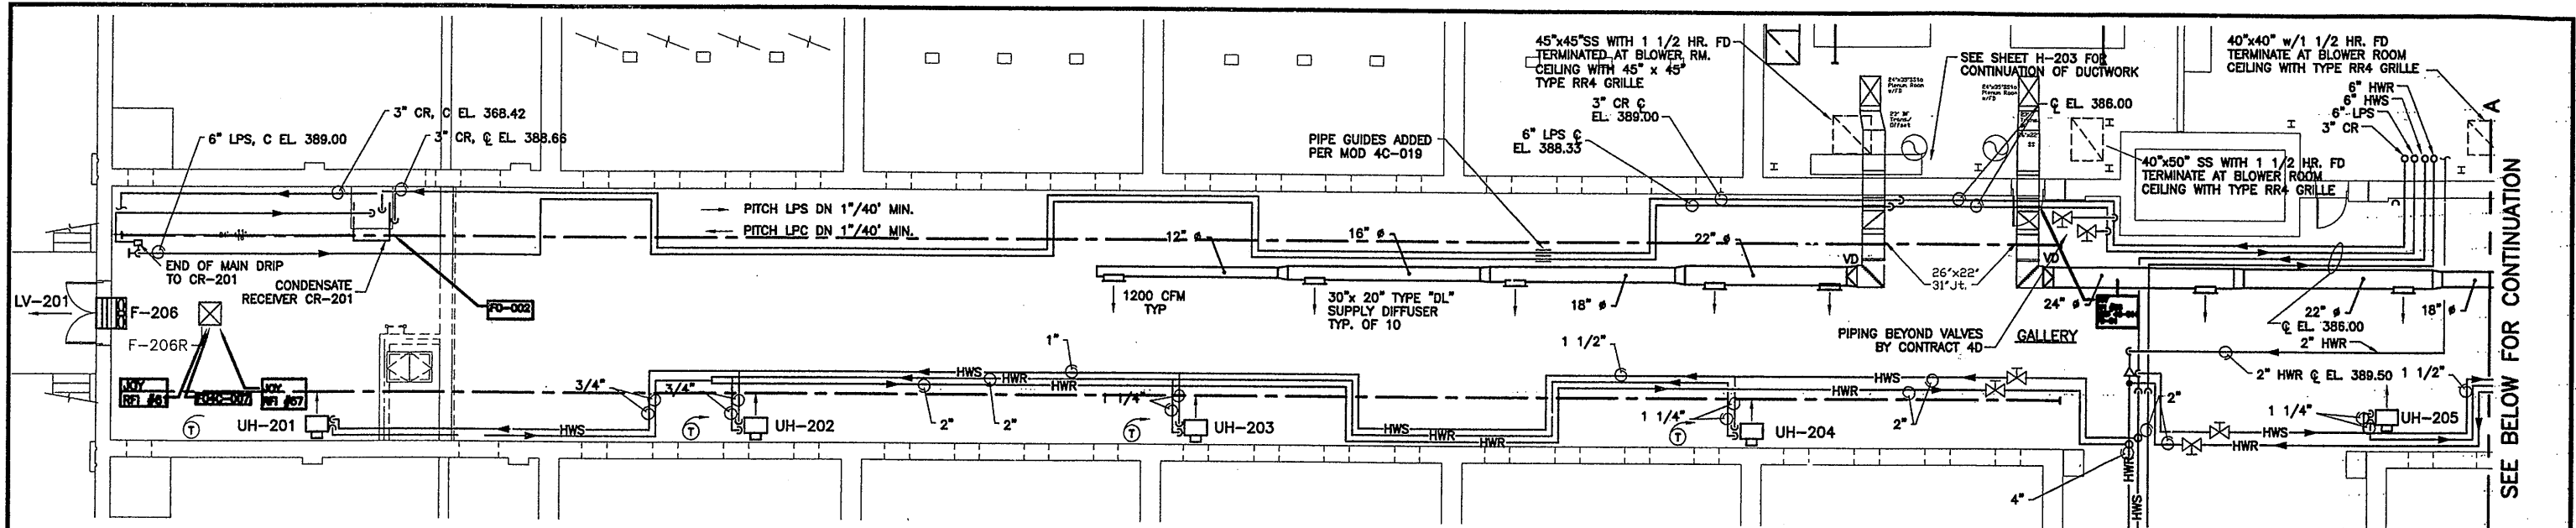


BAF GALLERY PARTIAL PLAN
SCALE: 1/8"=1'-0"

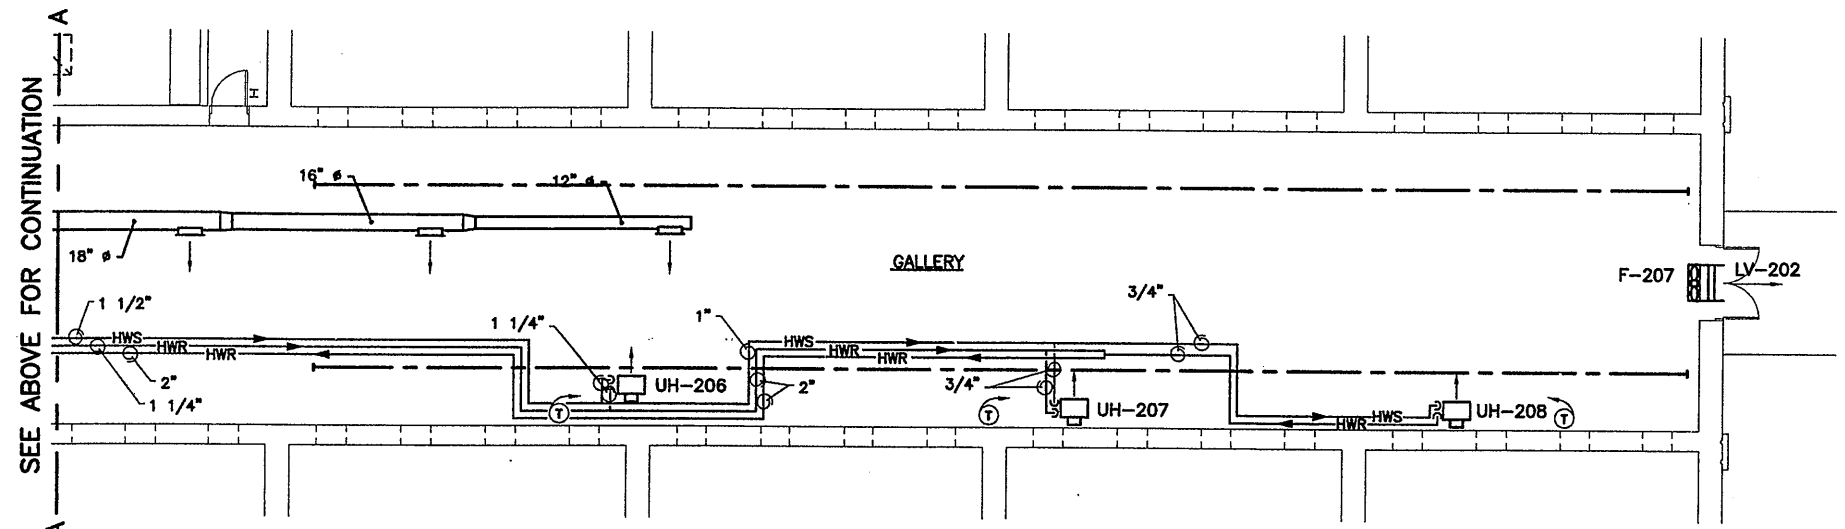

BAF GALLERY PARTIAL PLAN
SCALE: 1/8"=1'-0"

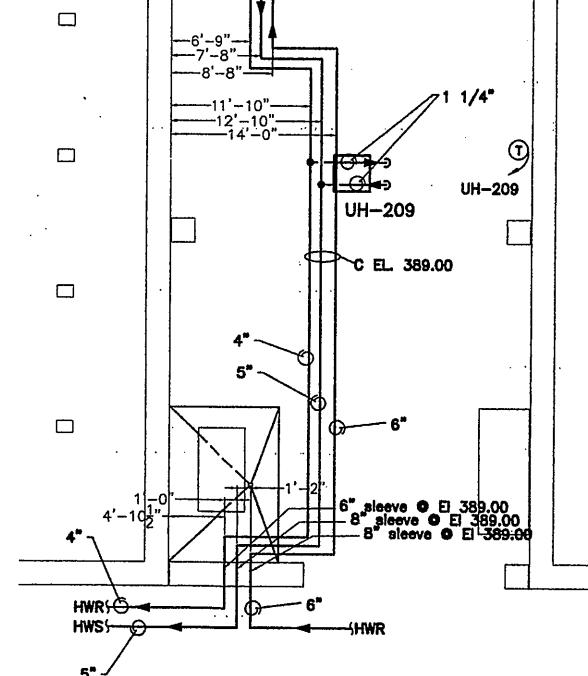

SEE SHEET H-301 FOR CONTINUATION

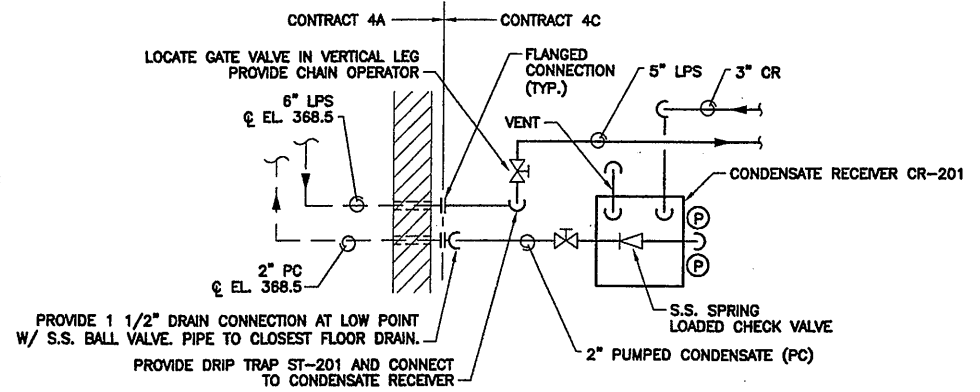

CONDENSATE RECEIVER DETAIL
NO SCALE

RECORD DRAWING
THESE DRAWINGS HAVE BEEN REVISED TO REFLECT MAJOR CHANGES, IF ANY, WHICH OCCURRED DURING CONSTRUCTION. REVISIONS ARE BASED UPON INFORMATION SUPPLIED BY CONTRACTOR.
DATE: 4/23/05 PER: SCLH

THIS DRAWING WAS PREPARED AT THE SCALE INDICATED IN THE TITLE BLOCK. INACCURACIES IN THE STATED SCALE MAY BE INTRODUCED WHEN DRAWINGS ARE REPRODUCED BY ANY MEANS. USE THE GRAPHIC SCALE BAR IN THE TITLE BLOCK TO DETERMINE THE ACTUAL SCALE OF THIS DRAWING.

0659X202
11/28/00 S&W CMS
...CONTRACT 2-5\HVAC\0659H201.DWG

NO ALTERATIONS PERMITTED HEREON EXCEPT AS PROVIDED UNDER SECTION 7209 SUBDIVISION 2 OF THE NEW YORK STATE EDUCATION LAW

| No. | Date | Revisions | Init |
|-----|----------|---------------------|------|
| 0 | 4/20/01 | ISSUED FOR APPROVAL | |
| 1 | | AS BID | |
| 2 | 11/30/05 | RECORD DRAWING | RCG |


In charge of DBP
Designed by DBP
Drawn by CMS/JRH
Checked by DBP



ONONDAGA COUNTY • DEPARTMENT OF DRAINAGE AND SANITATION • SYRACUSE, NEW YORK
METROPOLITAN SYRACUSE WASTEWATER TREATMENT PLANT
STAGE III AMMONIA AND STAGE II PHOSPHORUS REMOVAL PROJECT
BIOLOGICAL AERATED FILTERS (BAF) COMPLEX
BAF GALLERY PARTIAL PLAN



File Number
00659
Date
APRIL 2001
H-201
Gerald C. Hoot

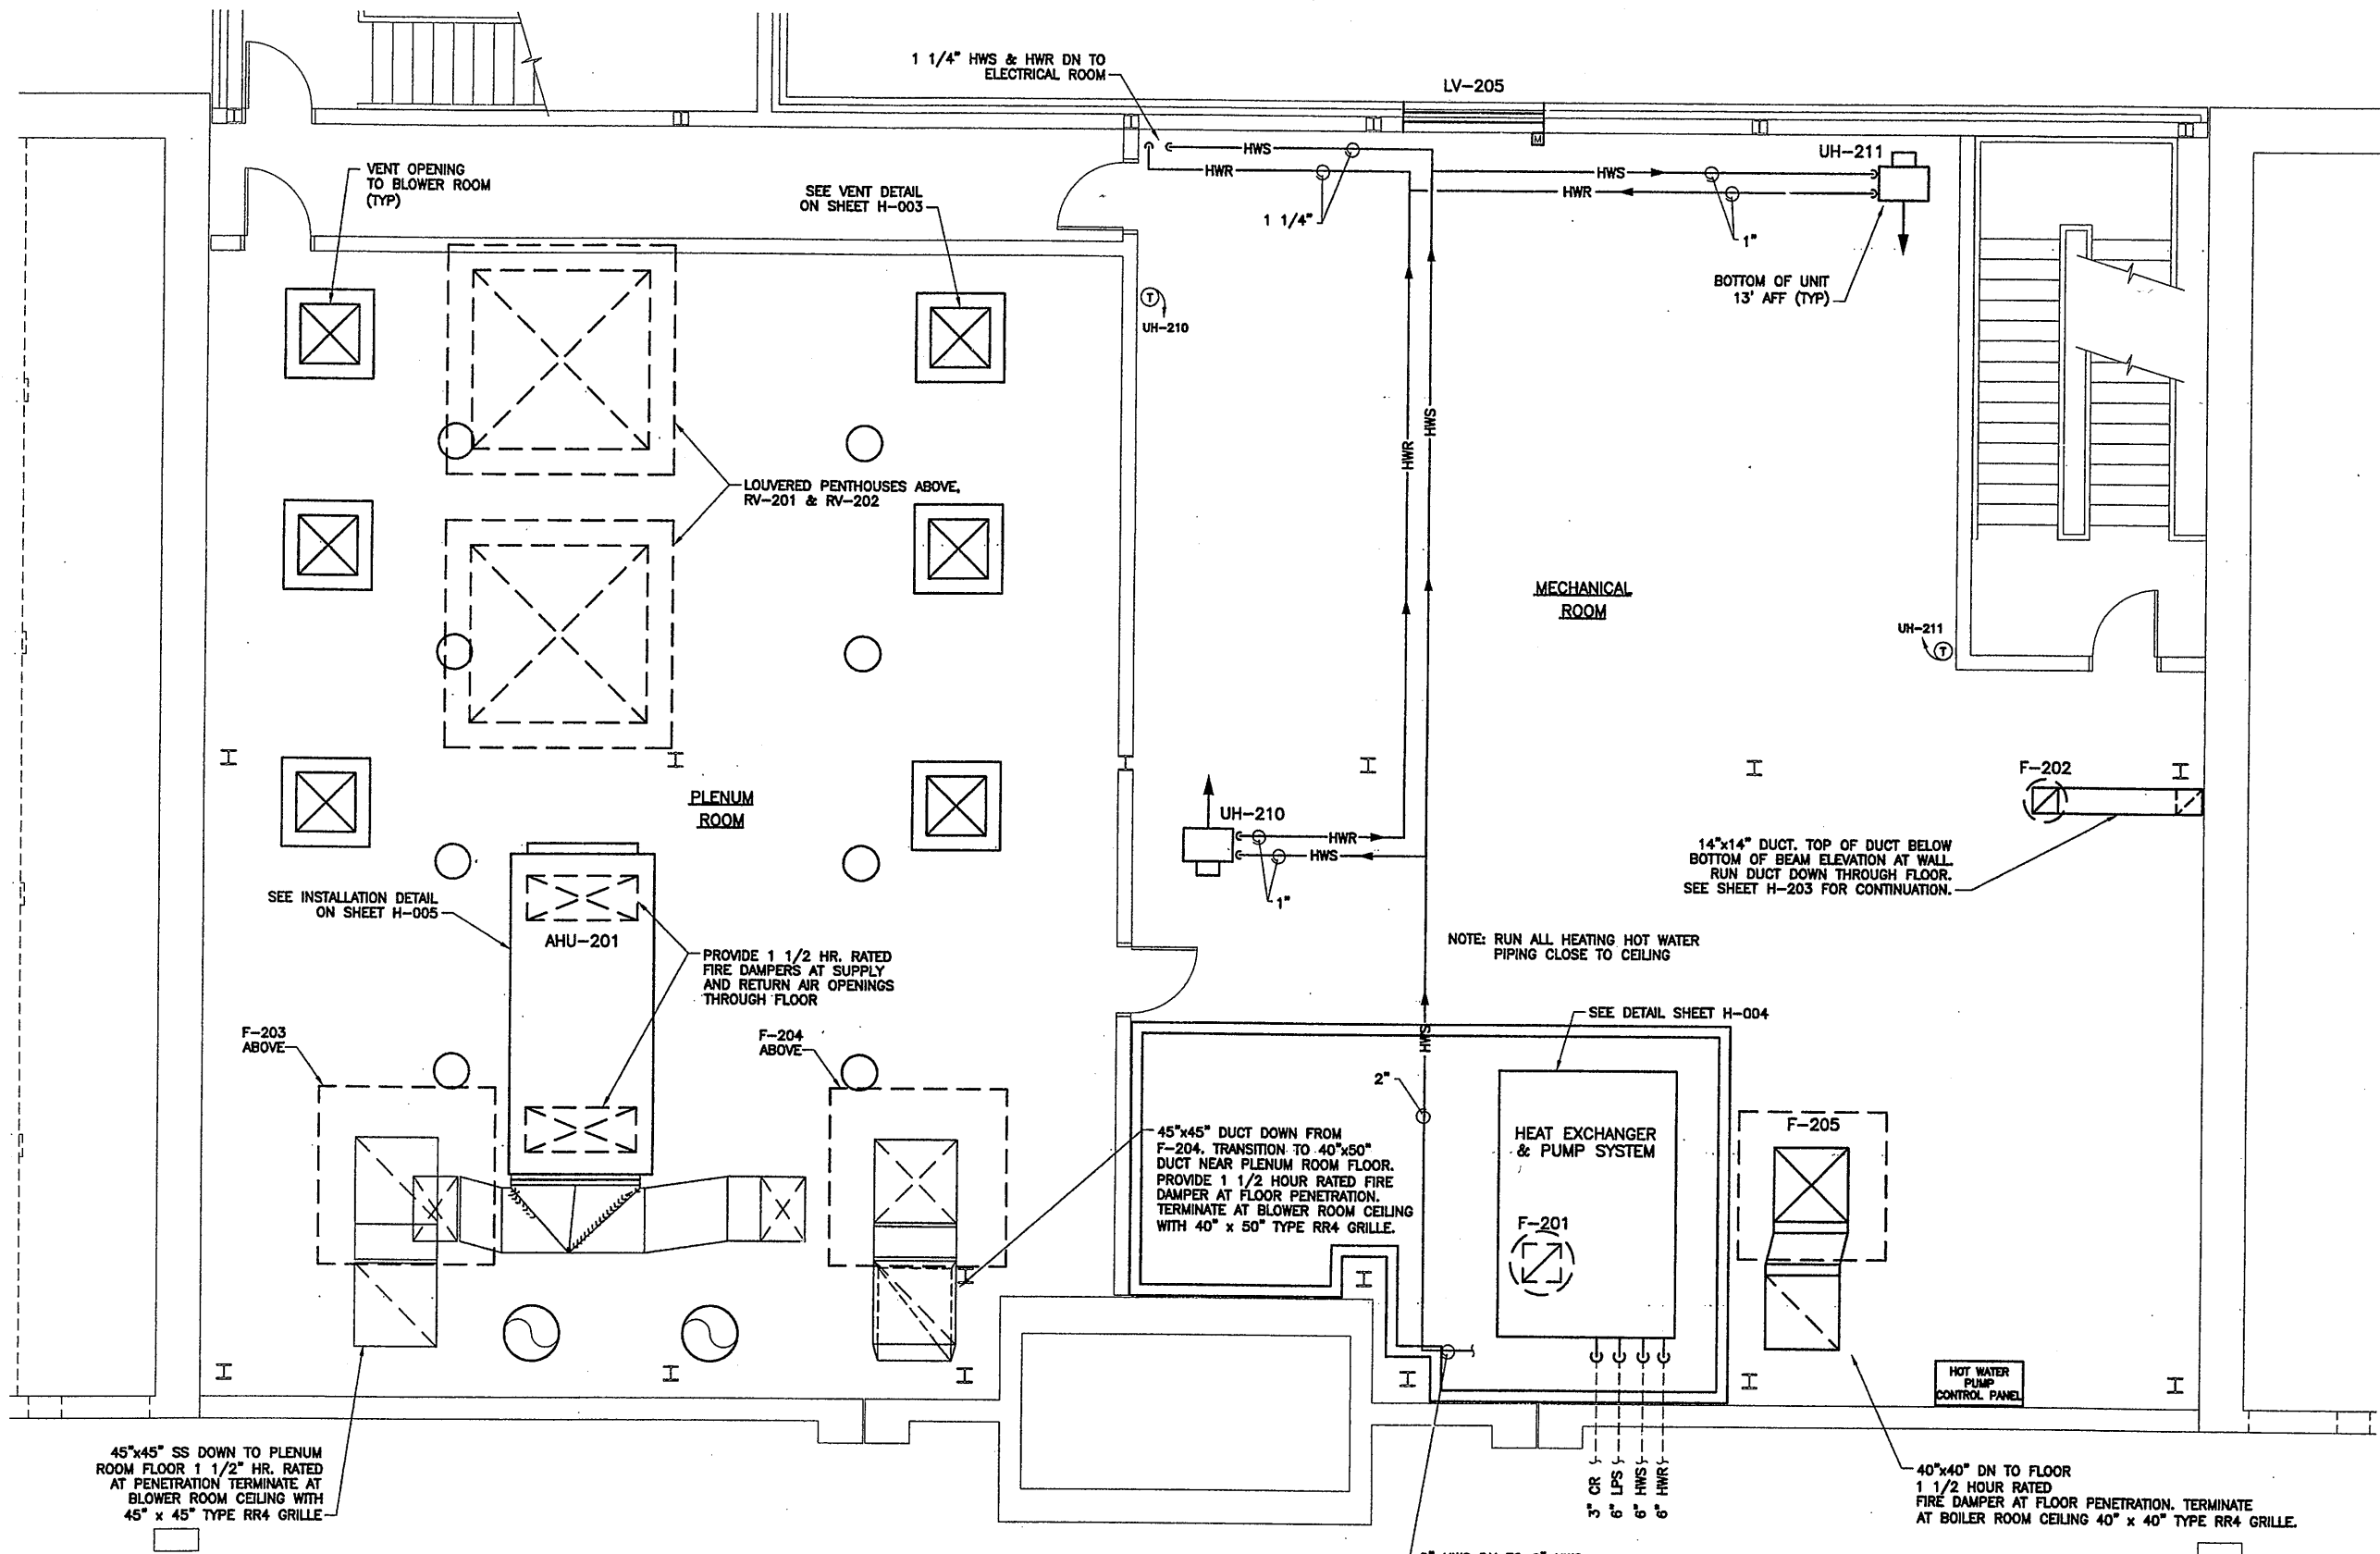

PLENUM ROOM & MECHANICAL ROOM PARTIAL PLAN
SCALE: 1/4"=1'-0"

RECORD DRAWING

THESE DRAWINGS HAVE BEEN REVISED TO REFLECT MAJOR CHANGES, IF ANY, WHICH OCCURRED DURING CONSTRUCTION. REVISIONS ARE BASED UPON INFORMATION SUPPLIED BY CONTRACTOR.
DATE: 11/23/05 PER: GAT

THIS DRAWING WAS PREPARED AT THE SCALE INDICATED IN THE TITLE BLOCK. INACCURACIES IN THE STATED SCALE MAY BE INTRODUCED WHEN DRAWINGS ARE REPRODUCED BY ANY MEANS. USE THE GRAPHIC SCALE BAR IN THE TITLE BLOCK TO DETERMINE THE ACTUAL SCALE OF THIS DRAWING.

0659X202
11/28/00 S&W CMS
CONTRACT 2-5\HVAC\0659H202.DWG

1/4"=1'-0"
NO ALTERATIONS PERMITTED HEREON EXCEPT AS PROVIDED UNDER SECTION 7209 SUBDIVISION 2 OF THE NEW YORK STATE EDUCATION LAW

| No. | Date | Revisions | Init |
|-----|---------|---------------------|------|
| 0 | 4/20/01 | ISSUED FOR APPROVAL | |
| 1 | | AS BID | |
| 2 | 1/30/05 | RECORD DRAWING | RCG |


In charge of -- DBP
Designed by -- DBP
Drawn by -- CMS
Checked by -- DBP



ONONDAGA COUNTY • DEPARTMENT OF DRAINAGE AND SANITATION • SYRACUSE, NEW YORK
METROPOLITAN SYRACUSE WASTEWATER TREATMENT PLANT
STAGE III AMMONIA AND STAGE II PHOSPHORUS REMOVAL PROJECT
BIOLOGICAL AERATED FILTERS (BAF) COMPLEX
PLENUM ROOM & MECHANICAL ROOM PARTIAL PLAN
HVAC



File Number: 00659
Date: APRIL 2001
H-202

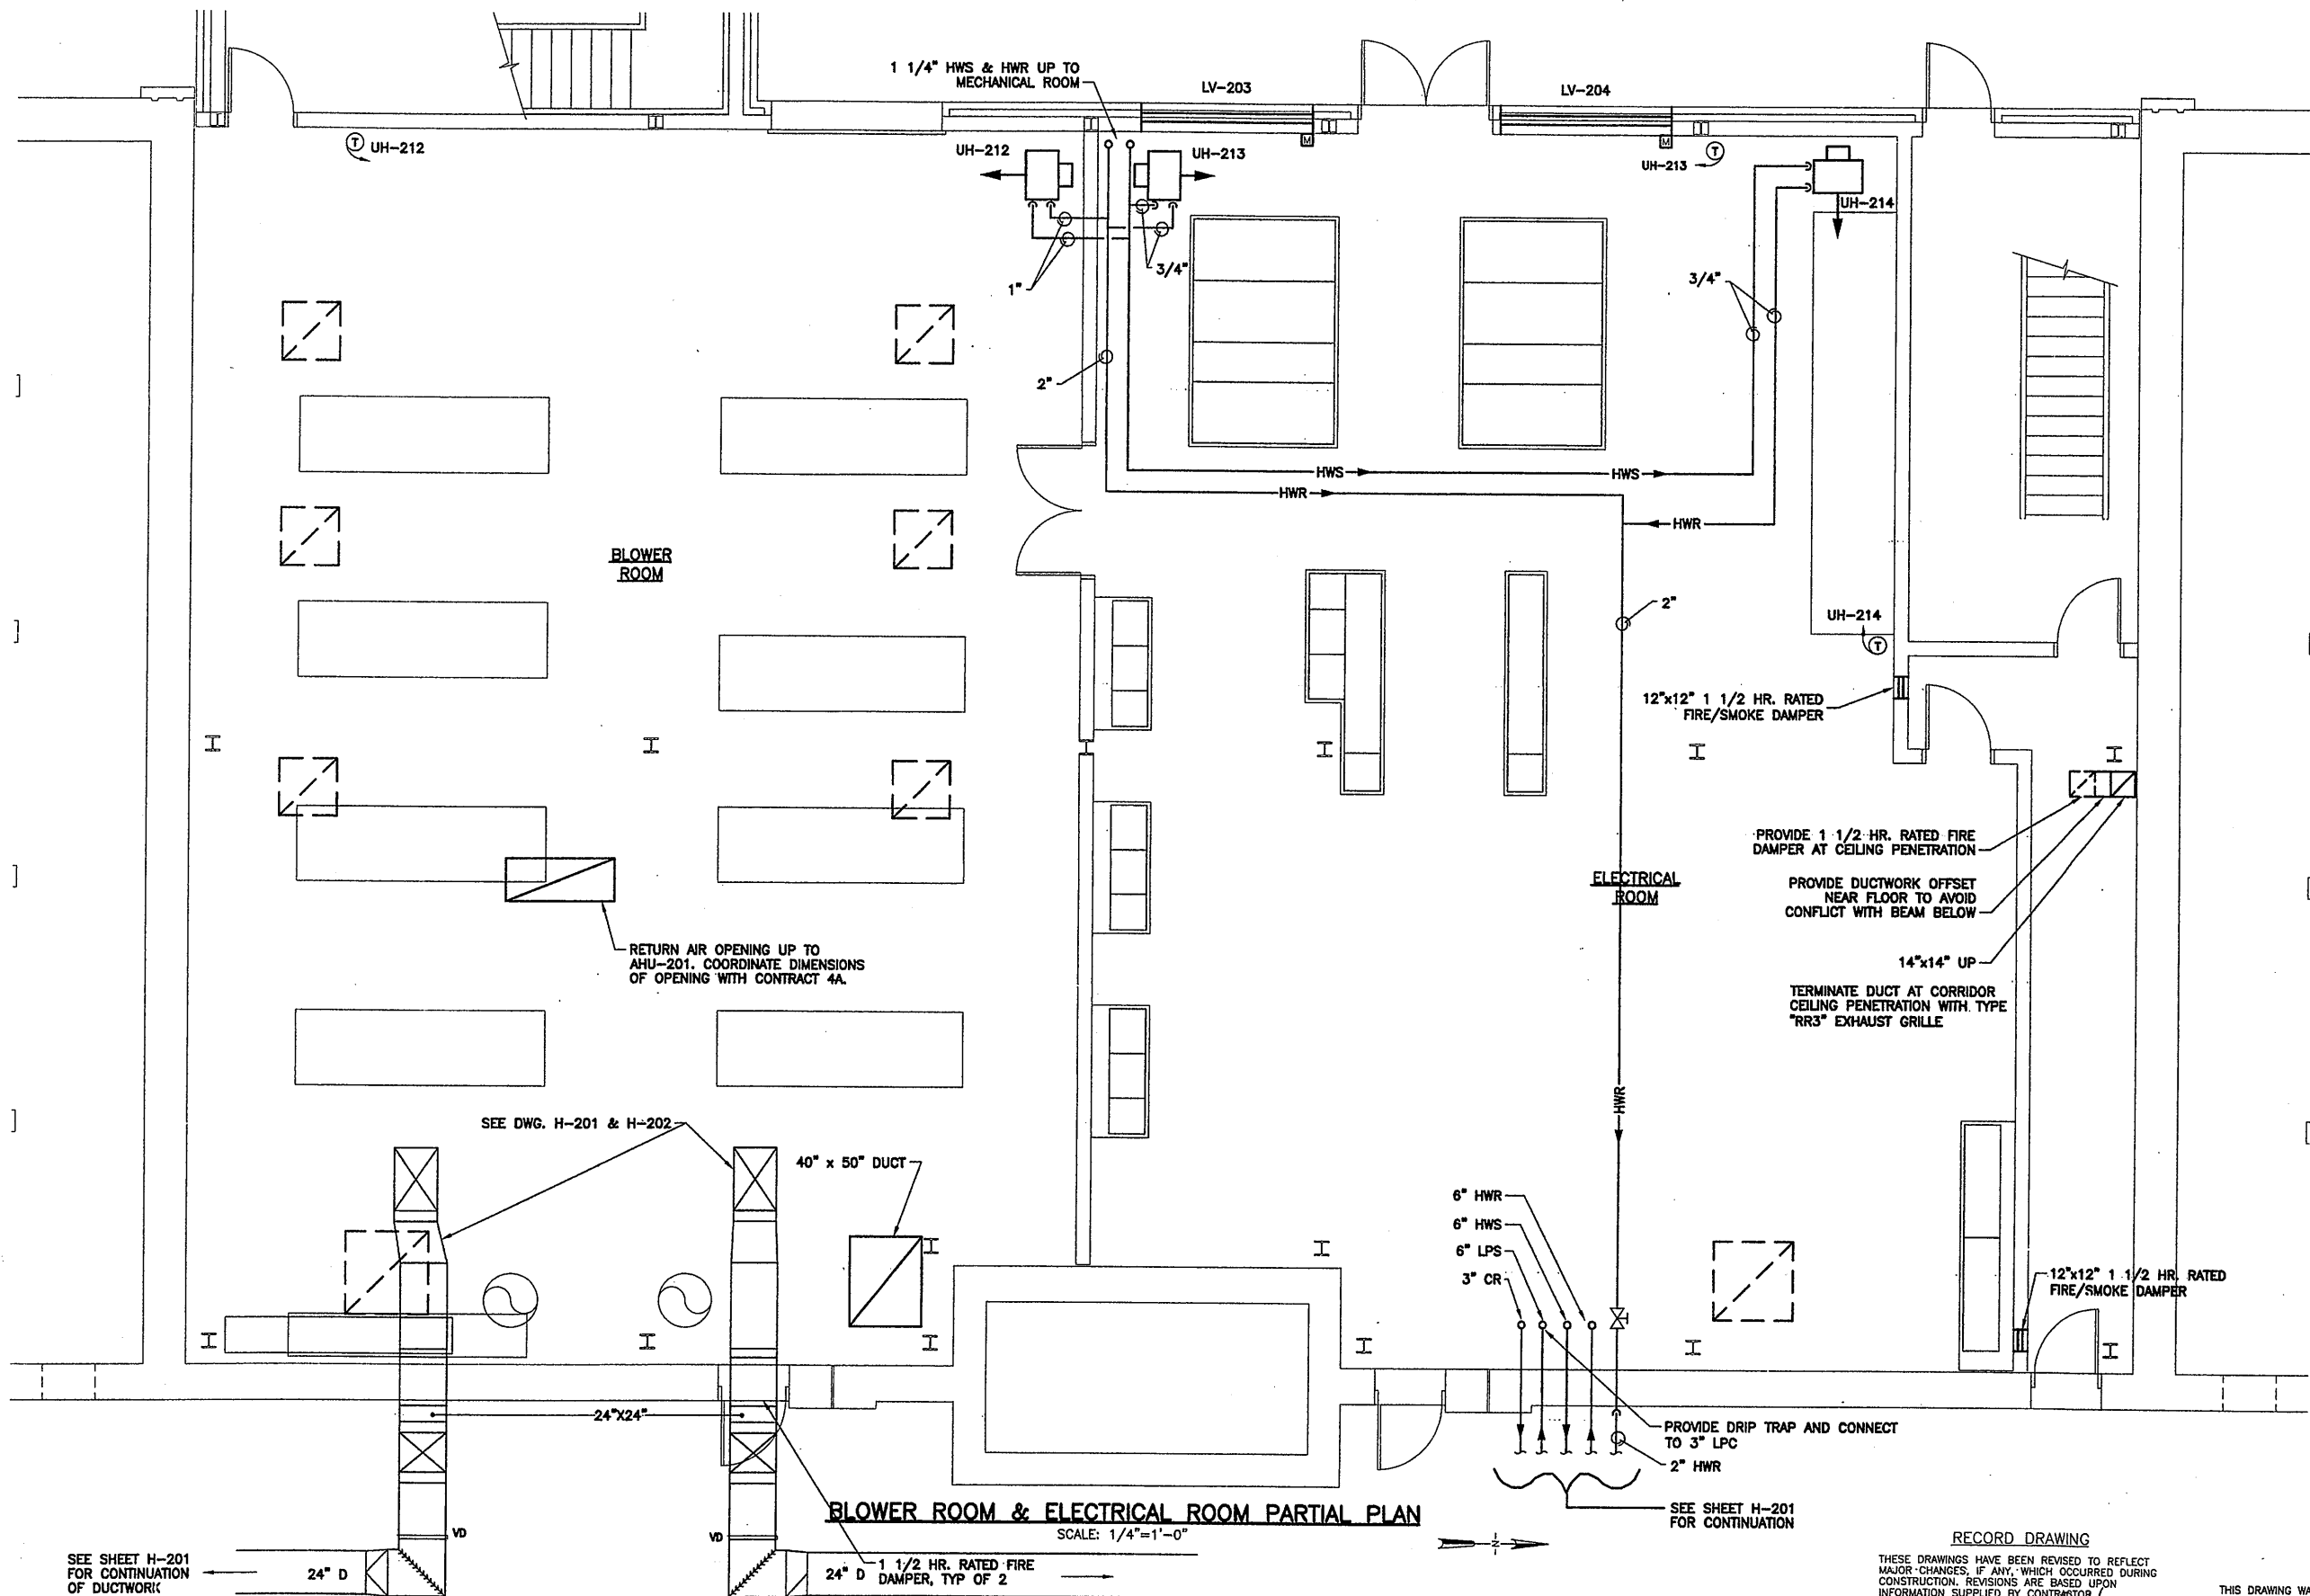

BLOWER ROOM & ELECTRICAL ROOM PARTIAL PLAN
SCALE: 1/4"=1'-0"

SEE SHEET H-201 FOR CONTINUATION OF DUCTWORK


SEE SHEET H-201 FOR CONTINUATION

RECORD DRAWING

THESE DRAWINGS HAVE BEEN REVISED TO REFLECT MAJOR CHANGES, IF ANY, WHICH OCCURRED DURING CONSTRUCTION. REVISIONS ARE BASED UPON INFORMATION SUPPLIED BY CONTRACTOR.
DATE: 11/23/05 PER: GCH

THIS DRAWING WAS PREPARED AT THE SCALE INDICATED IN THE TITLE BLOCK. INACCURACIES IN THE STATED SCALE MAY BE INTRODUCED WHEN DRAWINGS ARE REPRODUCED BY ANY MEANS. USE THE GRAPHIC SCALE BAR IN THE TITLE BLOCK TO DETERMINE THE ACTUAL SCALE OF THIS DRAWING.

0659X201
11/28/00 S&W CMS
CONTRACT 2-5 HVAC\0659H203.DWG

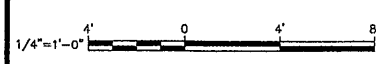

| No. | Date | Revisions | Init |
|-----|---------|---------------------|------|
| 0 | 4/20/01 | ISSUED FOR APPROVAL | |
| 1 | | AS BID | |
| 2 | 1/30/05 | RECORD DRAWING | RCG |

In charge of... DBP
Designed by... DBP
Drawn by... CMS
Checked by... DBP





ONONDAGA COUNTY • DEPARTMENT OF DRAINAGE AND SANITATION • SYRACUSE, NEW YORK
METROPOLITAN SYRACUSE WASTEWATER TREATMENT PLANT
STAGE III AMMONIA AND STAGE II PHOSPHORUS REMOVAL PROJECT
BIOLOGICAL AERATED FILTERS (BAF) COMPLEX
BLOWER ROOM AND ELECTRICAL ROOM PARTIAL PLAN
HVAC



File Number 00659
Date APRIL 2001

H-203

GCH

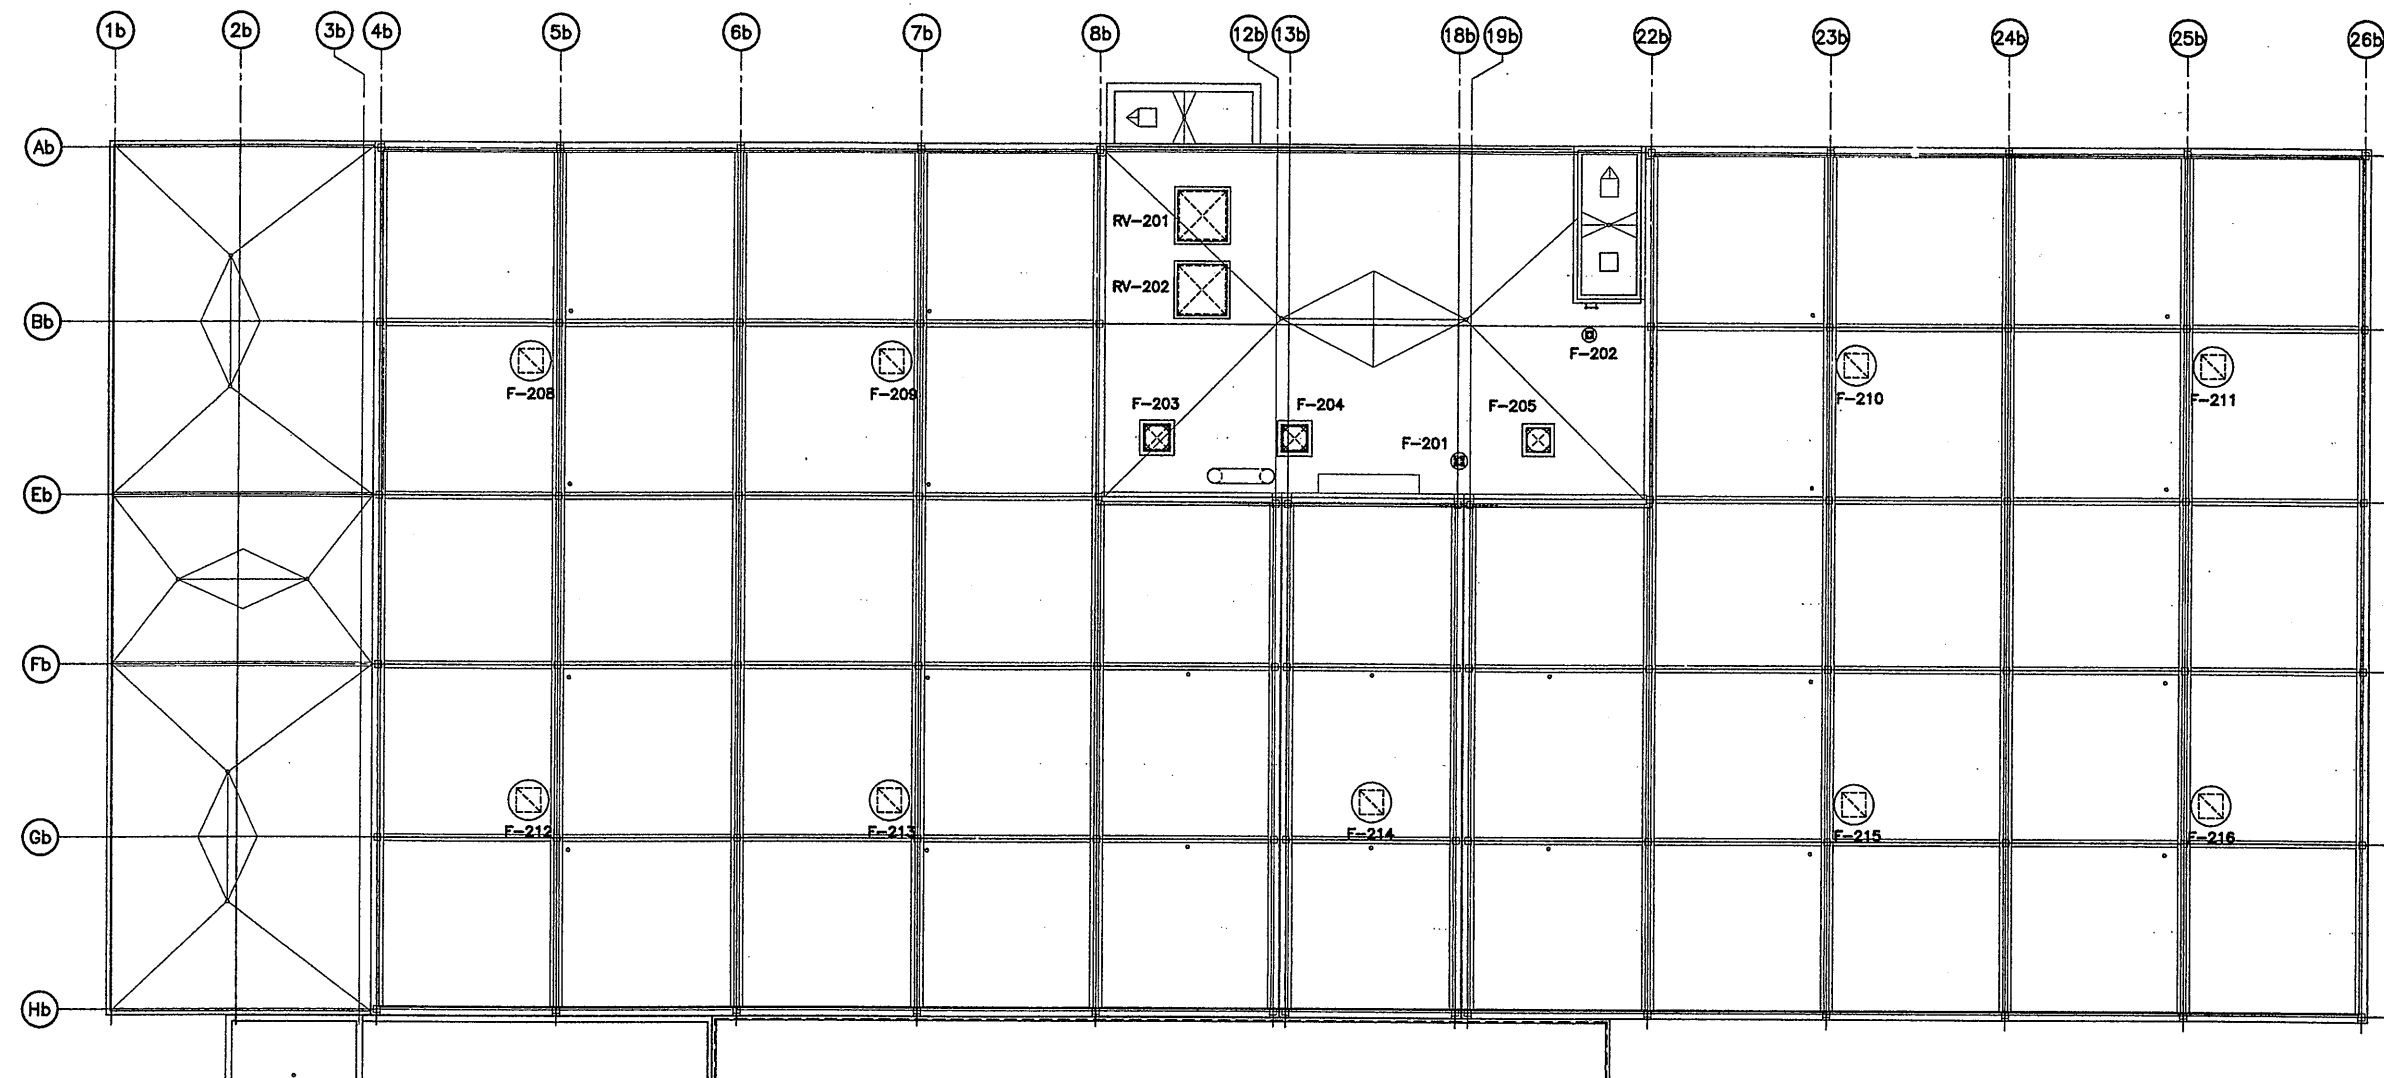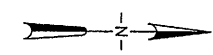

ROOF PLAN
SCALE: 1"=16'-0"

NOTE:

- COORDINATE SIZE AND LOCATION OF ROOF OPENINGS WITH CONTRACT 4A.


RECORD DRAWING

THESE DRAWINGS HAVE BEEN REVISED TO REFLECT MAJOR CHANGES, IF ANY, WHICH OCCURRED DURING CONSTRUCTION. REVISIONS ARE BASED UPON INFORMATION SUPPLIED BY CONTRACTOR.

DATE: _____ PER: _____

THIS DRAWING WAS PREPARED AT THE SCALE INDICATED IN THE TITLE BLOCK. INACCURACIES IN THE STATED SCALE MAY BE INTRODUCED WHEN DRAWINGS ARE REPRODUCED BY ANY MEANS. USE THE GRAPHIC SCALE BAR IN THE TITLE BLOCK TO DETERMINE THE ACTUAL SCALE OF THIS DRAWING.

0659H204

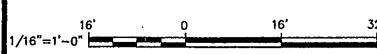

NO ALTERATIONS PERMITTED HEREON EXCEPT AS PROVIDED UNDER SECTION 7209 SUBDIVISION 2 OF THE NEW YORK STATE EDUCATION LAW

| No. | Date | Revisions | Init |
|-----|---------|----------------|------|
| 1 | | AS BID | |
| 2 | 1/30/05 | RECORD DRAWING | RCC |

In charge of _____
Designed by _____
Drawn by _____
Checked by _____



ONONDAGA COUNTY • DEPARTMENT OF DRAINAGE AND SANITATION • SYRACUSE, NEW YORK
METROPOLITAN SYRACUSE WASTEWATER TREATMENT PLANT
STAGE III AMMONIA AND STAGE II PHOSPHORUS REMOVAL PROJECT

**BAF COMPLEX
ROOF PLAN**

HVAC




File Number
00659
Date
JUNE 2001

H-204

Handwritten signature

MATCHLINE - SEE SHEET H-201 FOR CONTINUATION

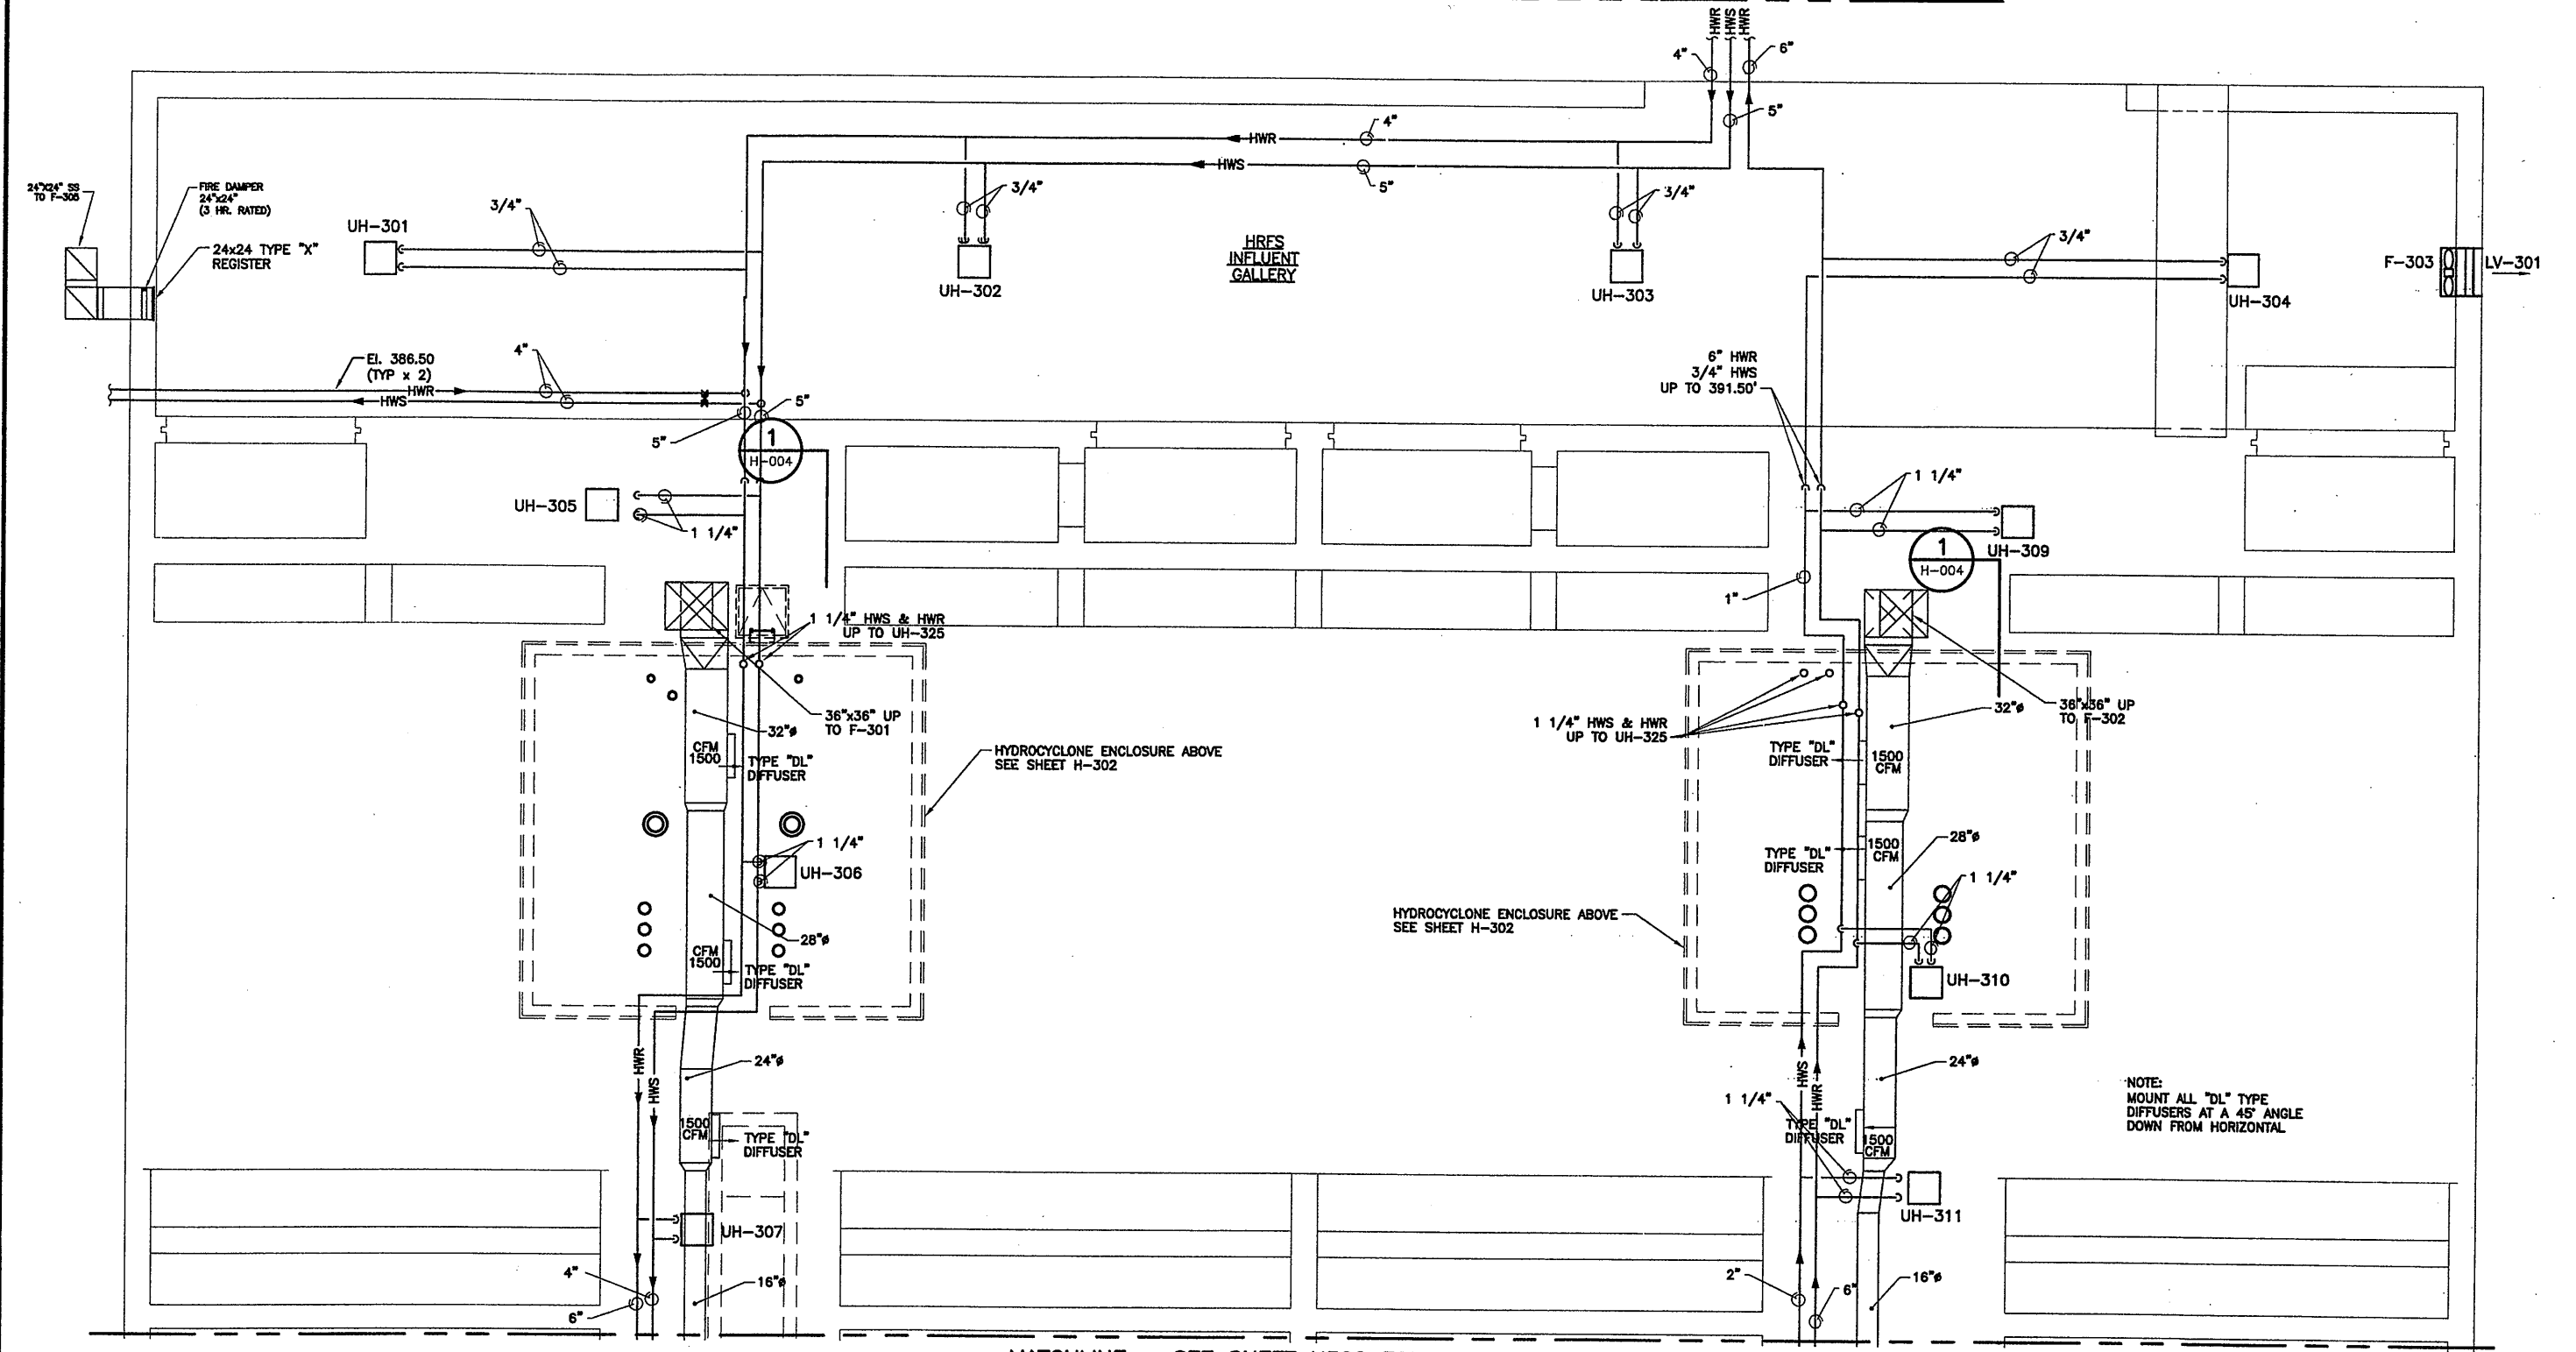

MATCHLINE - SEE SHEET H302 FOR CONTINUATION

HRFS GALLERY PARTIAL PLAN
SCALE: 3/16"=1'-0"

NOTE:
MOUNT ALL "DL" TYPE
DIFFUSERS AT A 45° ANGLE
DOWN FROM HORIZONTAL

0559X301
11/28/00 S&W CMS
...CONTRACT 2-5\HVAC\0659H301.DWG

| No. | Date | Revisions | Init |
|-----|---------|---------------------|------|
| 0 | 4/20/01 | ISSUED FOR APPROVAL | RCG |
| 1 | 1/30/05 | AS BID | |

In charge of - DBP
Designed by - DBP
Drawn by - CMS/JRH
Checked by - DBP



ONONDAGA COUNTY • DEPARTMENT OF DRAINAGE AND SANITATION • SYRACUSE, NEW YORK
METROPOLITAN SYRACUSE WASTEWATER TREATMENT PLANT
STAGE III AMMONIA AND STAGE II PHOSPHORUS REMOVAL PROJECT
HIGH-RATE FLOCCULATED SETTLING (HRFS) COMPLEX
HRFS GALLERY PARTIAL PLAN



File Number
00659
Date
APRIL 2001

H-301

RECORD DRAWING


THESE DRAWINGS HAVE BEEN REVISED TO REFLECT
MAJOR CHANGES, IF ANY, WHICH OCCURRED DURING
CONSTRUCTION. REVISIONS ARE BASED UPON
INFORMATION SUPPLIED BY CONTRACTOR.
DATE: 1/27/05 PER: GCH

THIS DRAWING WAS PREPARED AT THE SCALE INDICATED IN THE
TITLE BLOCK. INACCURACIES IN THE STATED SCALE MAY BE
INTRODUCED WHEN DRAWINGS ARE REPRODUCED BY ANY MEANS.
USE THE GRAPHIC SCALE BAR IN THE TITLE BLOCK TO
DETERMINE THE ACTUAL SCALE OF THIS DRAWING.

NO ALTERATIONS PERMITTED HEREON EXCEPT
AS PROVIDED UNDER SECTION 7209 SUBDIVISION
2 OF THE NEW YORK STATE EDUCATION LAW


HVAC

MATCHLINE - SEE SHEET H301 FOR CONTINUATION

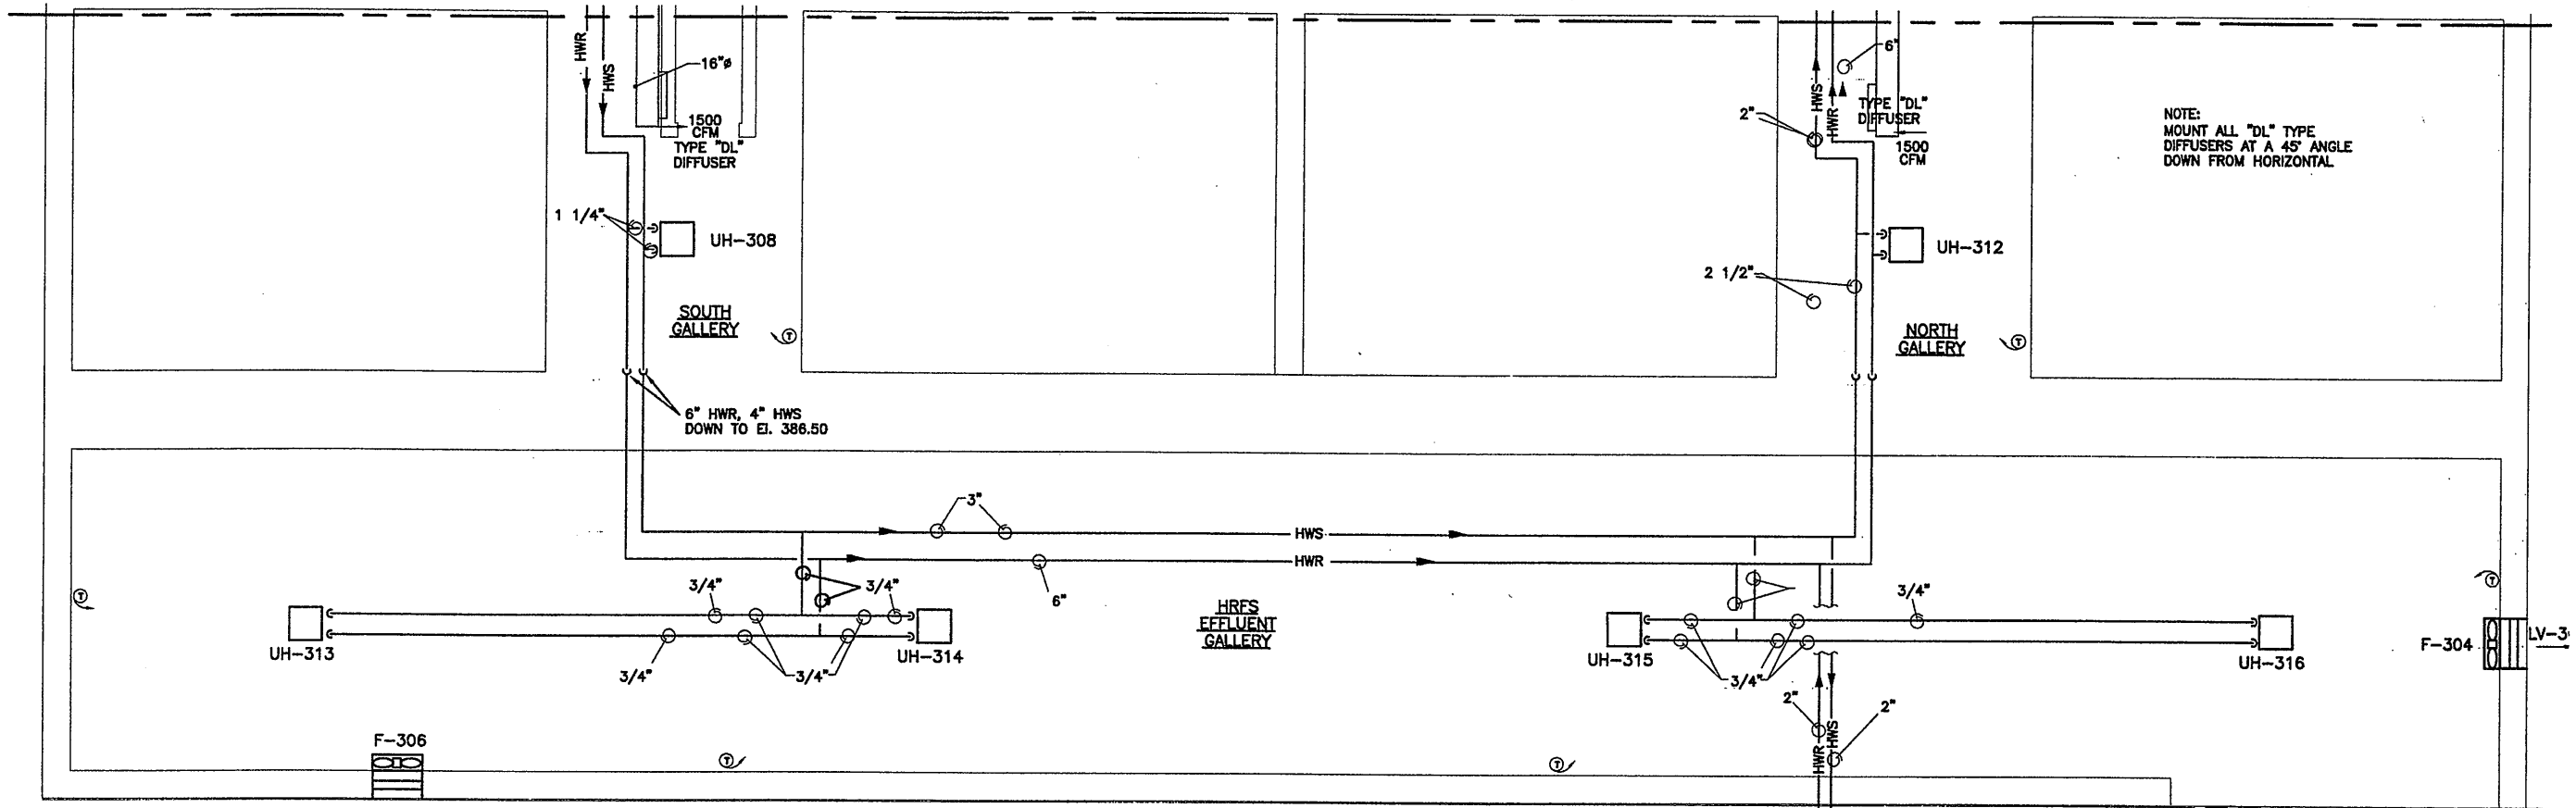


HRFS GALLERY PARTIAL PLAN
SCALE: 3/16"=1'-0"

MATCHLINE - SEE SHEET H401 FOR CONTINUATION

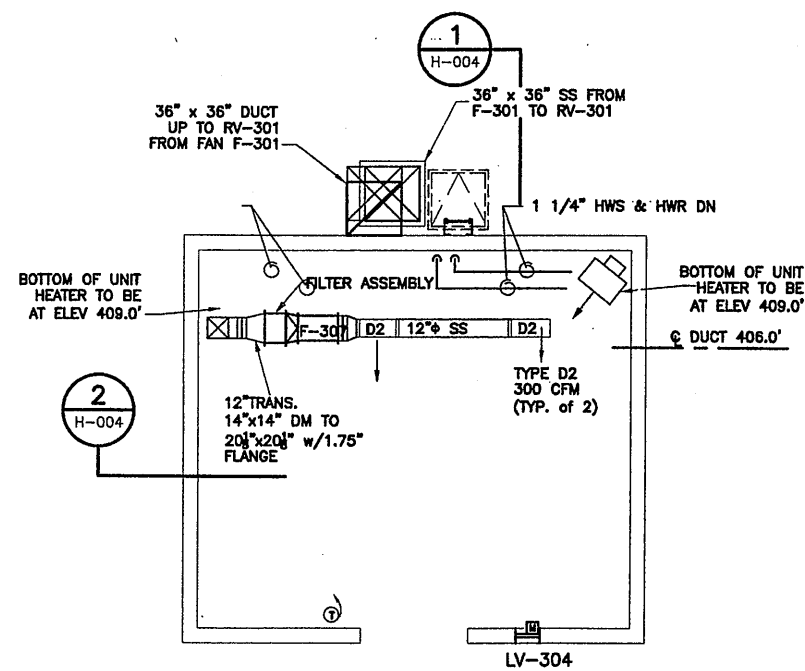

HYDROCYCLONE ENCLOSURE PARTIAL PLAN (SOUTH)
SCALE: 3/16"=1'-0"

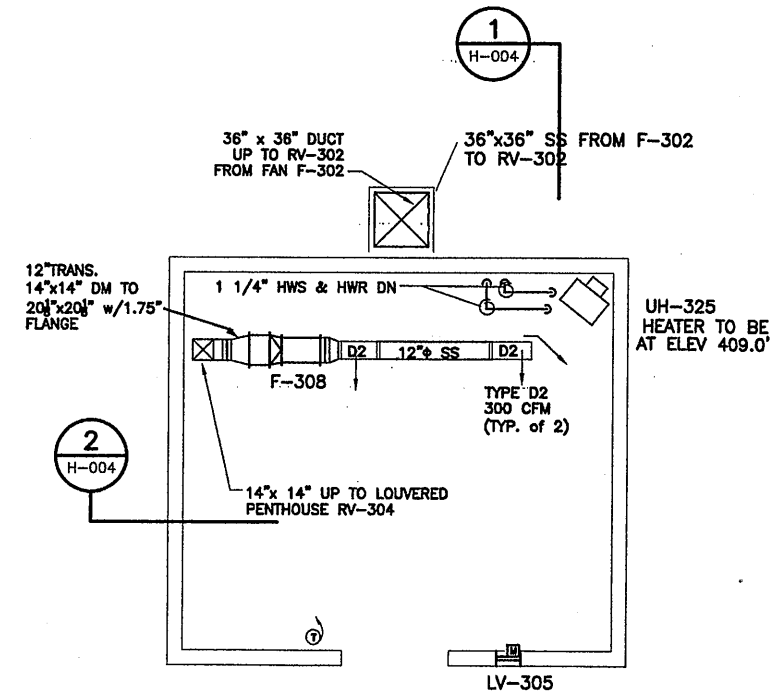

HYDROCYCLONE ENCLOSURE PARTIAL PLAN (NORTH)
SCALE: 3/16"=1'-0"

RECORD DRAWING

THESE DRAWINGS HAVE BEEN REVISED TO REFLECT MAJOR CHANGES, IF ANY, WHICH OCCURRED DURING CONSTRUCTION. REVISIONS ARE BASED UPON INFORMATION SUPPLIED BY CONTRACTOR.

DATE: 4/23/05 PER: CHT

THIS DRAWING WAS PREPARED AT THE SCALE INDICATED IN THE TITLE BLOCK. INACCURACIES IN THE STATED SCALE MAY BE INTRODUCED WHEN DRAWINGS ARE REPRODUCED BY ANY MEANS. USE THE GRAPHIC SCALE BAR IN THE TITLE BLOCK TO DETERMINE THE ACTUAL SCALE OF THIS DRAWING.

0659H301
11/28/00 S&W CMS
..\\CONTRACT 2-5\\HVAC\\0659H302.DWG



| No. | Date | Revisions | Init |
|-----|---------|---------------------|------|
| 0 | 3/30/01 | ISSUED FOR APPROVAL | |
| 1 | | AS BID | |
| 2 | 1/30/05 | RECORD DRAWING | RCG |

In charge of DBP
Designed by DBP
Drawn by CMS/JRH
Checked by DBP



ONONDAGA COUNTY • DEPARTMENT OF DRAINAGE AND SANITATION • SYRACUSE, NEW YORK
METROPOLITAN SYRACUSE WASTEWATER TREATMENT PLANT
STAGE III AMMONIA AND STAGE II PHOSPHORUS REMOVAL PROJECT
HIGH-RATE FLOCCULATED SETTLING (HRFS) COMPLEX
HRFS GALLERY PARTIAL PLAN




File Number
00659

Date
APRIL 2001

H-302

HVAC

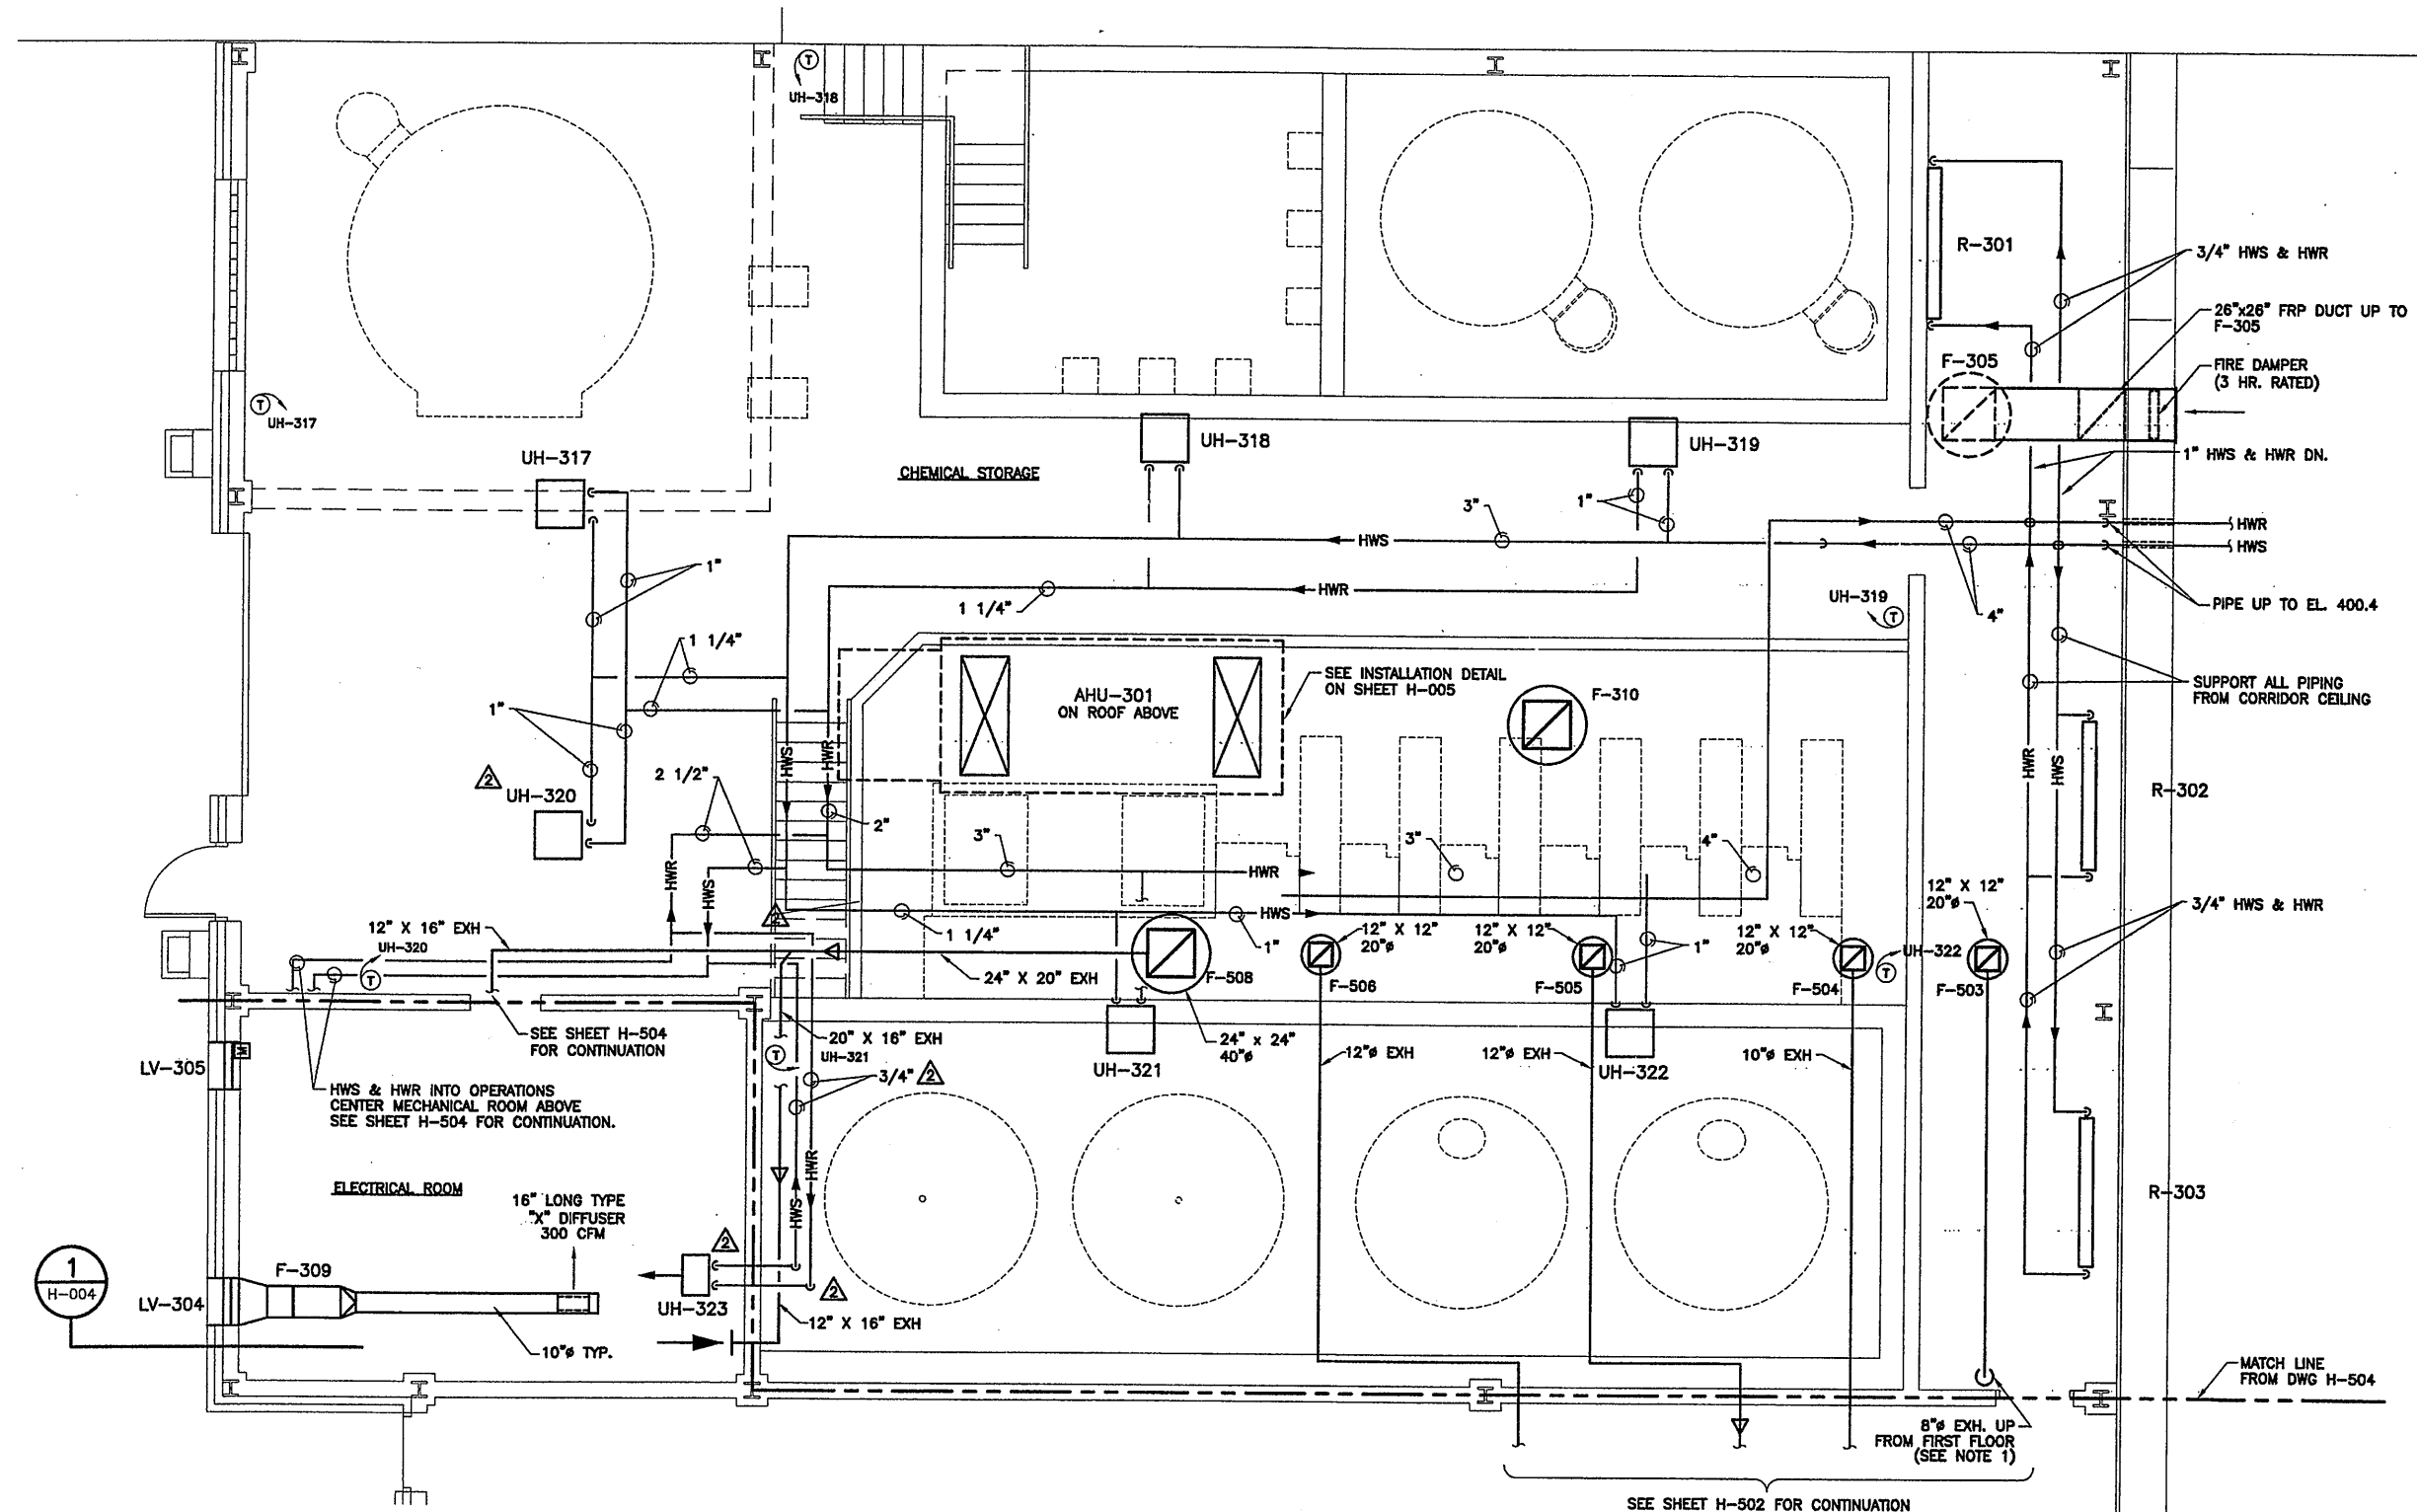

CHEMICAL BUILDING C PLAN
SCALE: 1/4"=1'-0"

NOTE:
1. PROVIDE 3 HR FD WITH ACCESS DOOR AT PENETRATION THRU CORRIDOR CEILING.

REVISION INCLUDES, BUT IS NOT LIMITED TO, RELOCATION OF UNIT HEATER UH-320 AND REVISED PIPING LAYOUT TO UNIT HEATER UH-323.

RECORD DRAWING
THESE DRAWINGS HAVE BEEN REVISED TO REFLECT MAJOR CHANGES, IF ANY, WHICH OCCURRED DURING CONSTRUCTION. REVISIONS ARE BASED UPON INFORMATION SUPPLIED BY CONTRACTOR.
DATE: 4/23/05 PER: [Signature]

THIS DRAWING WAS PREPARED AT THE SCALE INDICATED IN THE TITLE BLOCK. INACCURACIES IN THE STATED SCALE MAY BE INTRODUCED WHEN DRAWINGS ARE REPRODUCED BY ANY MEANS. USE THE GRAPHIC SCALE BAR IN THE TITLE BLOCK TO DETERMINE THE ACTUAL SCALE OF THIS DRAWING.

0659X501
11/28/00 S&W CMS
CONTRACT 2-5\HVAC\0659H303.DWG

| No. | Date | Revisions | Init |
|-----|---------|---------------------------------|------|
| 0 | 4/20/01 | ISSUED FOR APPROVAL | |
| 1 | 6/26/01 | AS BID | |
| 2 | 3/22/01 | REVISED FOR MODIFICATION 4C-002 | RCG |
| 3 | 1/30/05 | RECORD DRAWING | |

In charge of DBP
Designed by DBP
Drawn by CMS/JRH
Checked by DBP




ONONDAGA COUNTY • DEPARTMENT OF DRAINAGE AND SANITATION • SYRACUSE, NEW YORK
METROPOLITAN SYRACUSE WASTEWATER TREATMENT PLANT
STAGE III AMMONIA AND STAGE II PHOSPHORUS REMOVAL PROJECT
HIGH-RATE FLOCCULATED SETTLING (HRFS) COMPLEX
CHEMICAL BUILDING C PLAN



File Number
00659
Date
APRIL 2001
H-303
[Signature]

1/4"=1'-0"
NO ALTERATIONS PERMITTED HEREON EXCEPT AS PROVIDED UNDER SECTION 7209 SUBDIVISION 2 OF THE NEW YORK STATE EDUCATION LAW

HVAC

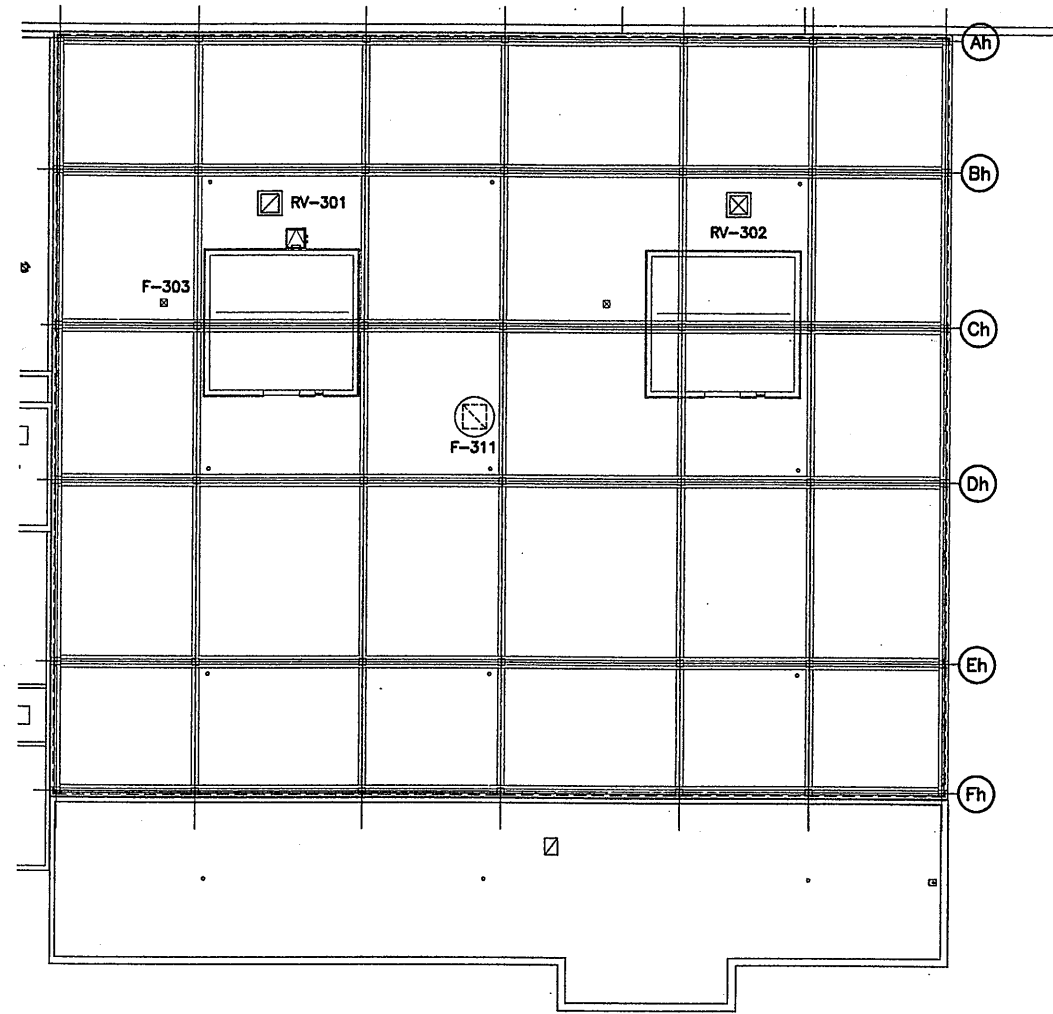

NOTE:

1. COORDINATE SIZE AND LOCATION OF ROOF OPENING WITH CONTRACT 4A.

ROOF PLAN
SCALE: 1"=16'-0"


RECORD DRAWING

THESE DRAWINGS HAVE BEEN REVISED TO REFLECT MAJOR CHANGES, IF ANY, WHICH OCCURRED DURING CONSTRUCTION. REVISIONS ARE BASED UPON INFORMATION SUPPLIED BY CONTRACTOR.

DATE: _____ PER: _____

THIS DRAWING WAS PREPARED AT THE SCALE INDICATED IN THE TITLE BLOCK. INACCURACIES IN THE STATED SCALE MAY BE INTRODUCED WHEN DRAWINGS ARE REPRODUCED BY ANY MEANS. USE THE GRAPHIC SCALE BAR IN THE TITLE BLOCK TO DETERMINE THE ACTUAL SCALE OF THIS DRAWING.


0659H304

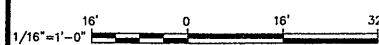

NO ALTERATIONS PERMITTED HEREON EXCEPT AS PROVIDED UNDER SECTION 7209 SUBDIVISION 2 OF THE NEW YORK STATE EDUCATION LAW

| No. | Date | Revisions | Init |
|-----|---------|----------------|------|
| 0 | | AS-BID | |
| 1 | 1/30/05 | RECORD DRAWING | RCG |


In charge of _____
 Designed by _____
 Drawn by _____
 Checked by _____

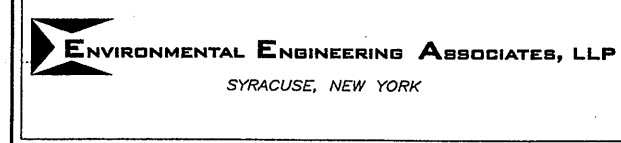

ONONDAGA COUNTY • DEPARTMENT OF DRAINAGE AND SANITATION • SYRACUSE, NEW YORK
 METROPOLITAN SYRACUSE WASTEWATER TREATMENT PLANT
 STAGE III AMMONIA AND STAGE II PHOSPHORUS REMOVAL PROJECT

**HRFS
ROOF PLAN**


HVAC

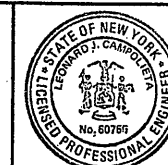



File Number
00659
Date
JUNE 2001
Leonard J. Campbell

H-304


SEE SHEET H302 FOR CONTINUATION

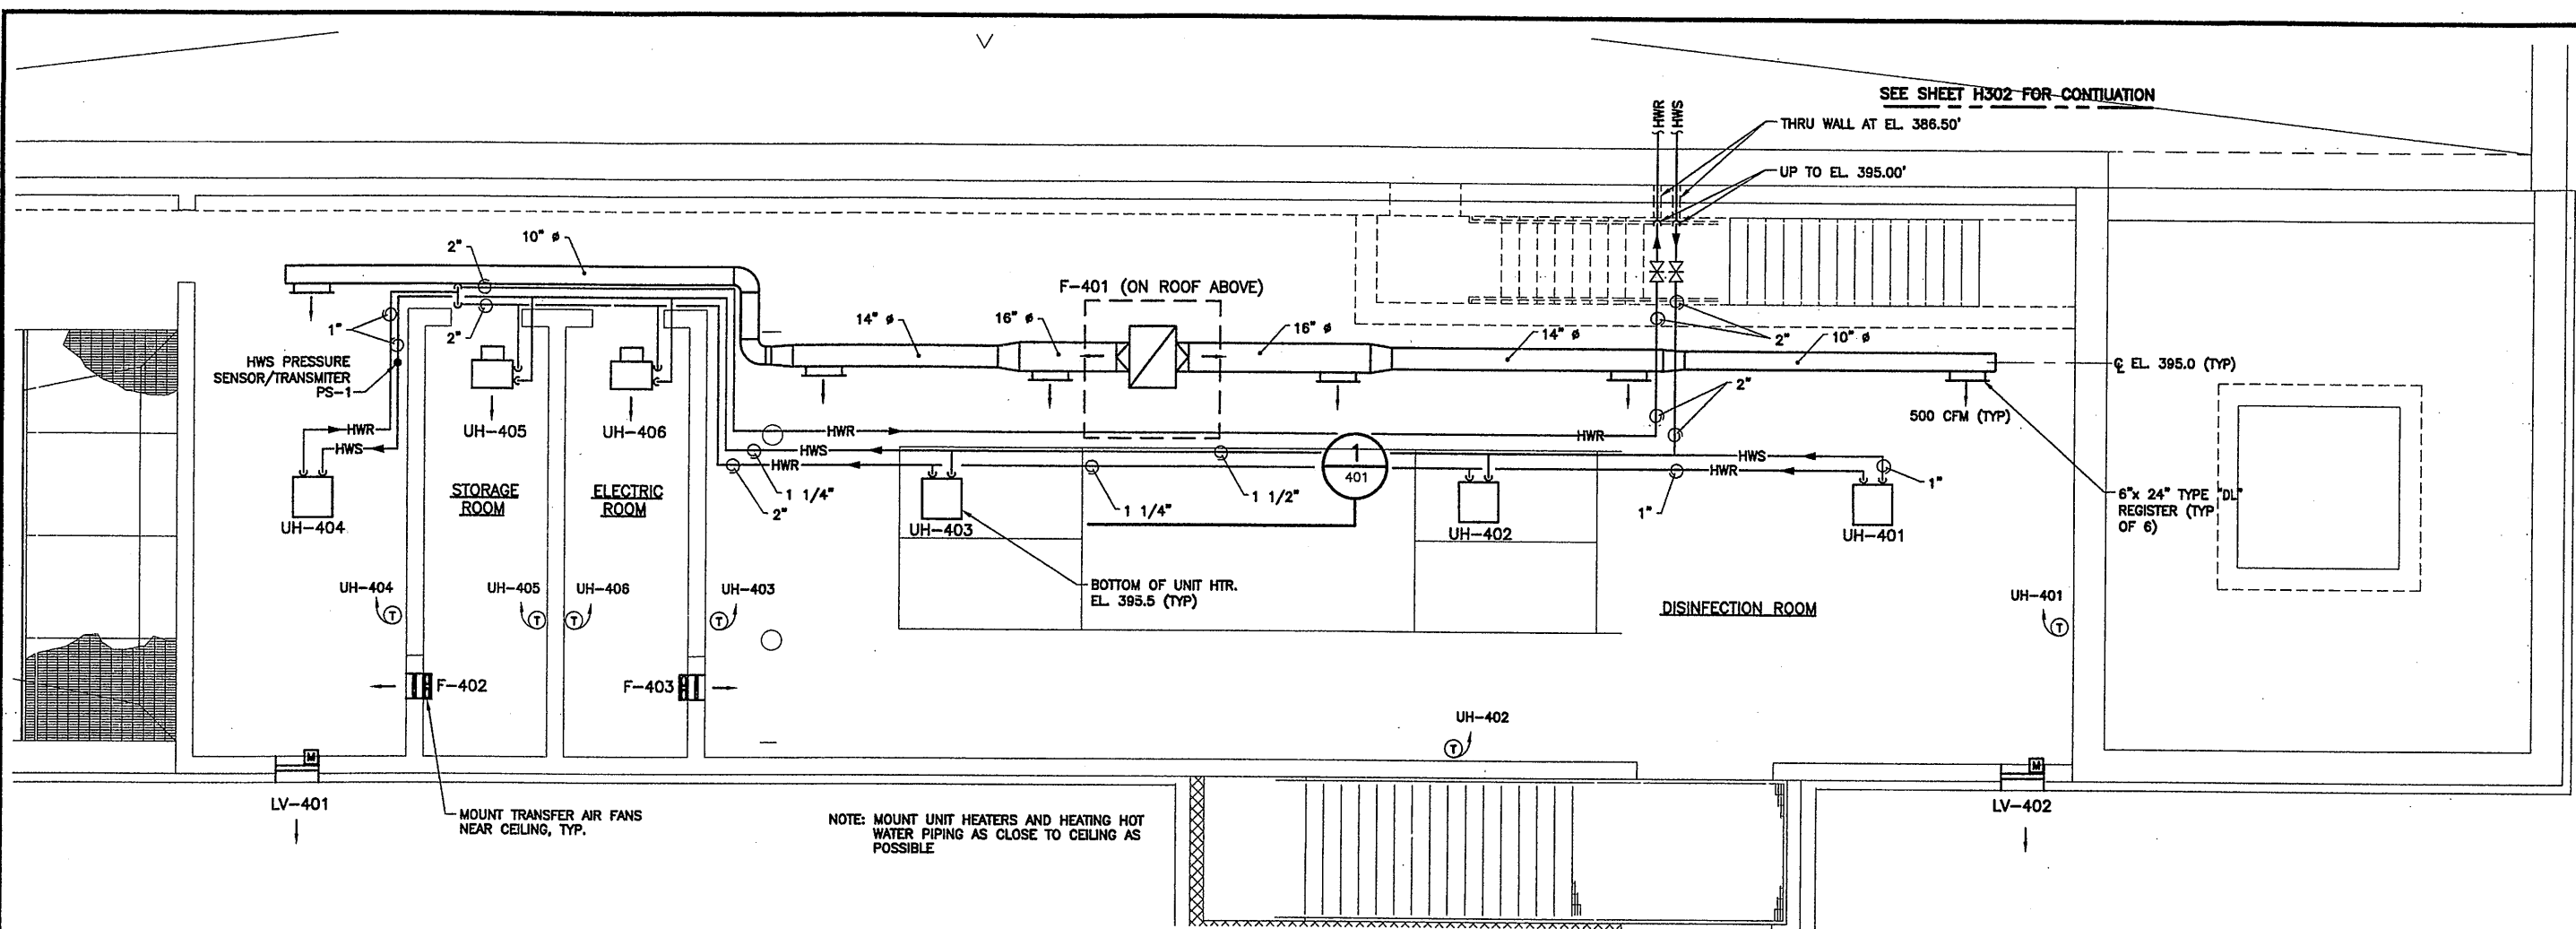

PLAN
SCALE: 1/4"=1'-0"

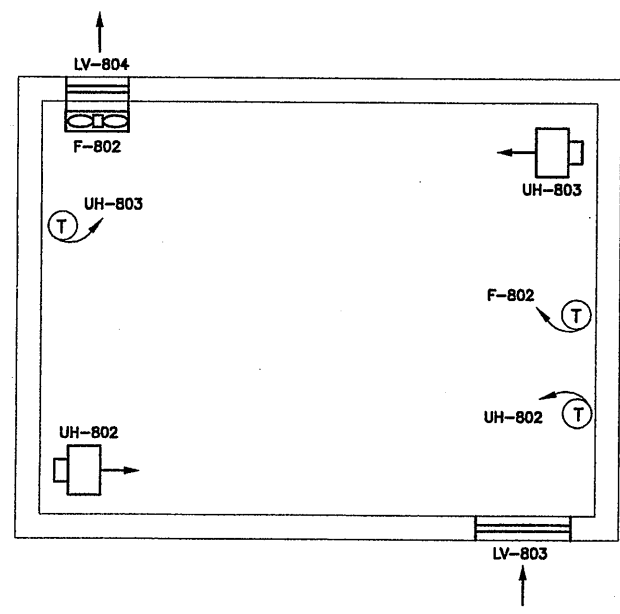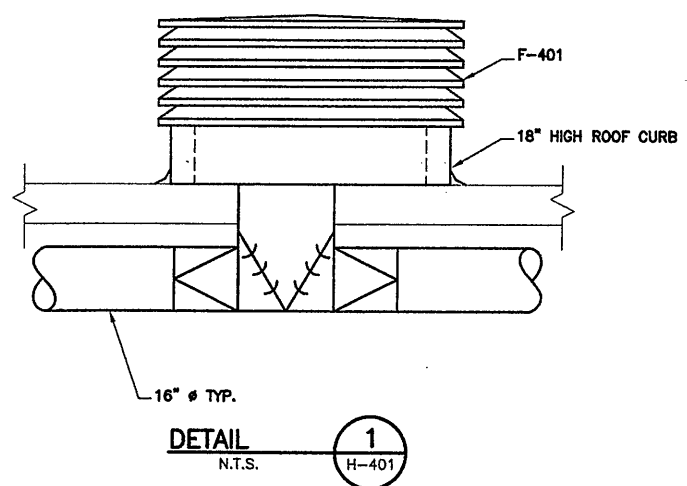

BYPASS CHLORINE CONTACT TANK BUILDING
SCALE: 3/8"=1'-0"

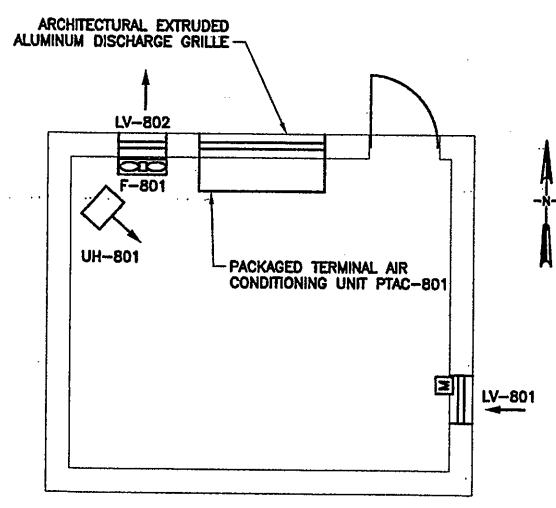

BATTERY SUBSTATION BUILDING
SCALE: 3/8"=1'-0"

RECORD DRAWING

THESE DRAWINGS HAVE BEEN REVISED TO REFLECT MAJOR CHANGES, IF ANY, WHICH OCCURRED DURING CONSTRUCTION. REVISIONS ARE BASED UPON INFORMATION SUPPLIED BY CONTRACTOR.
DATE: 4/23/05 PER: GCH

THIS DRAWING WAS PREPARED AT THE SCALE INDICATED IN THE TITLE BLOCK. INACCURACIES IN THE STATED SCALE MAY BE INTRODUCED WHEN DRAWINGS ARE REPRODUCED BY ANY MEANS. USE THE GRAPHIC SCALE BAR IN THE TITLE BLOCK TO DETERMINE THE ACTUAL SCALE OF THIS DRAWING.

0659X401
11/28/00 SW CMS
CONTRACT 2-5\HVAC\0659H401.DWG

| | |
|------------|---------|
| 1/4"=1'-0" | 0 4' 8' |
| 3/8"=1'-0" | 0 3' 6' |

| No. | Date | Revisions | Init |
|-----|---------|---------------------|------|
| 0 | 4/20/01 | ISSUED FOR APPROVAL | |
| 1 | | AS BID | |
| 2 | 1/30/05 | RECORD DRAWING | RCG |

In charge of DBP
Designed by DBP
Drawn by CMS/JRH
Checked by DBP

ENVIRONMENTAL ENGINEERING ASSOCIATES, LLP
SYRACUSE, NEW YORK


ONONDAGA COUNTY • DEPARTMENT OF DRAINAGE AND SANITATION • SYRACUSE, NEW YORK
METROPOLITAN SYRACUSE WASTEWATER TREATMENT PLANT
STAGE III AMMONIA AND STAGE II PHOSPHORUS REMOVAL PROJECT
ULTRAVIOLET DISINFECTION/PARSHALL FLUME STRUCTURE
PLAN, SECTIONS, AND DETAILS



File Number 00659
Date APRIL 2001


H-401

HVAC

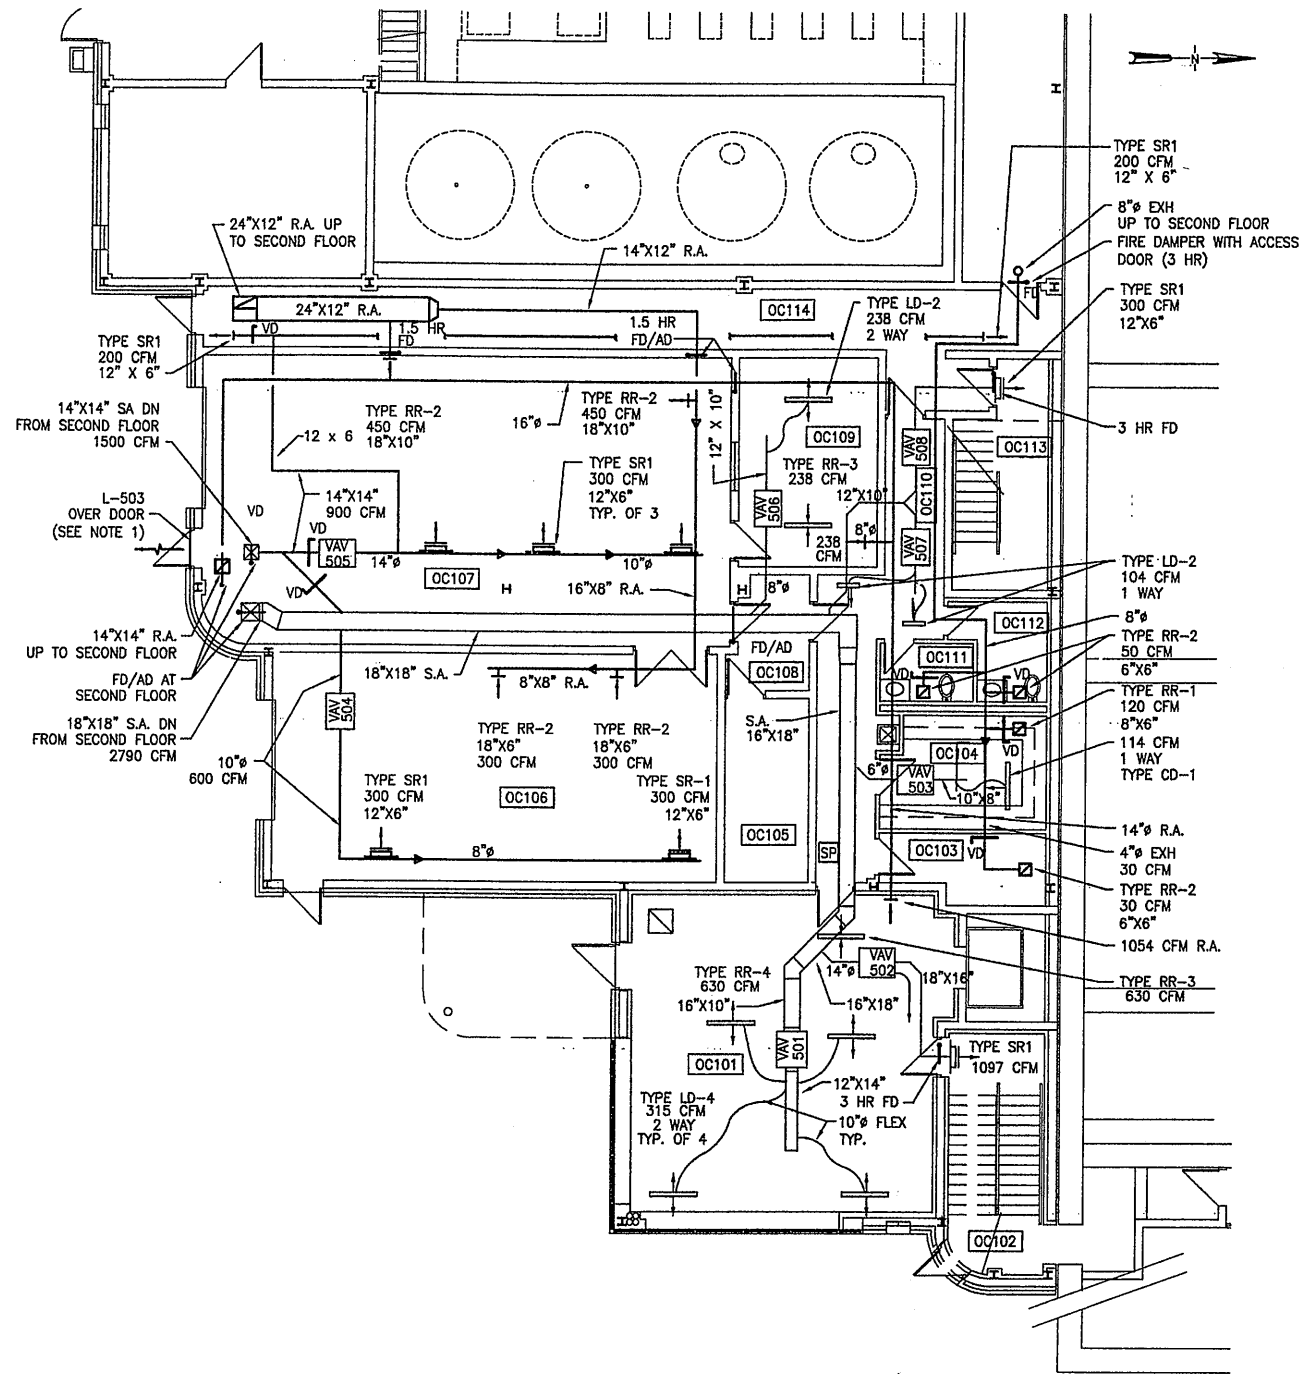

FIRST FLOOR DUCTING PLAN
1/8"=1'-0"

NOTES:
1. BLANK OFF LOUVER LV-503 WITH SHEETMETAL PAINTED BLACK. INSULATE WITH 2" THICK FIBER GLASS BOARD WITH FRK FACING.

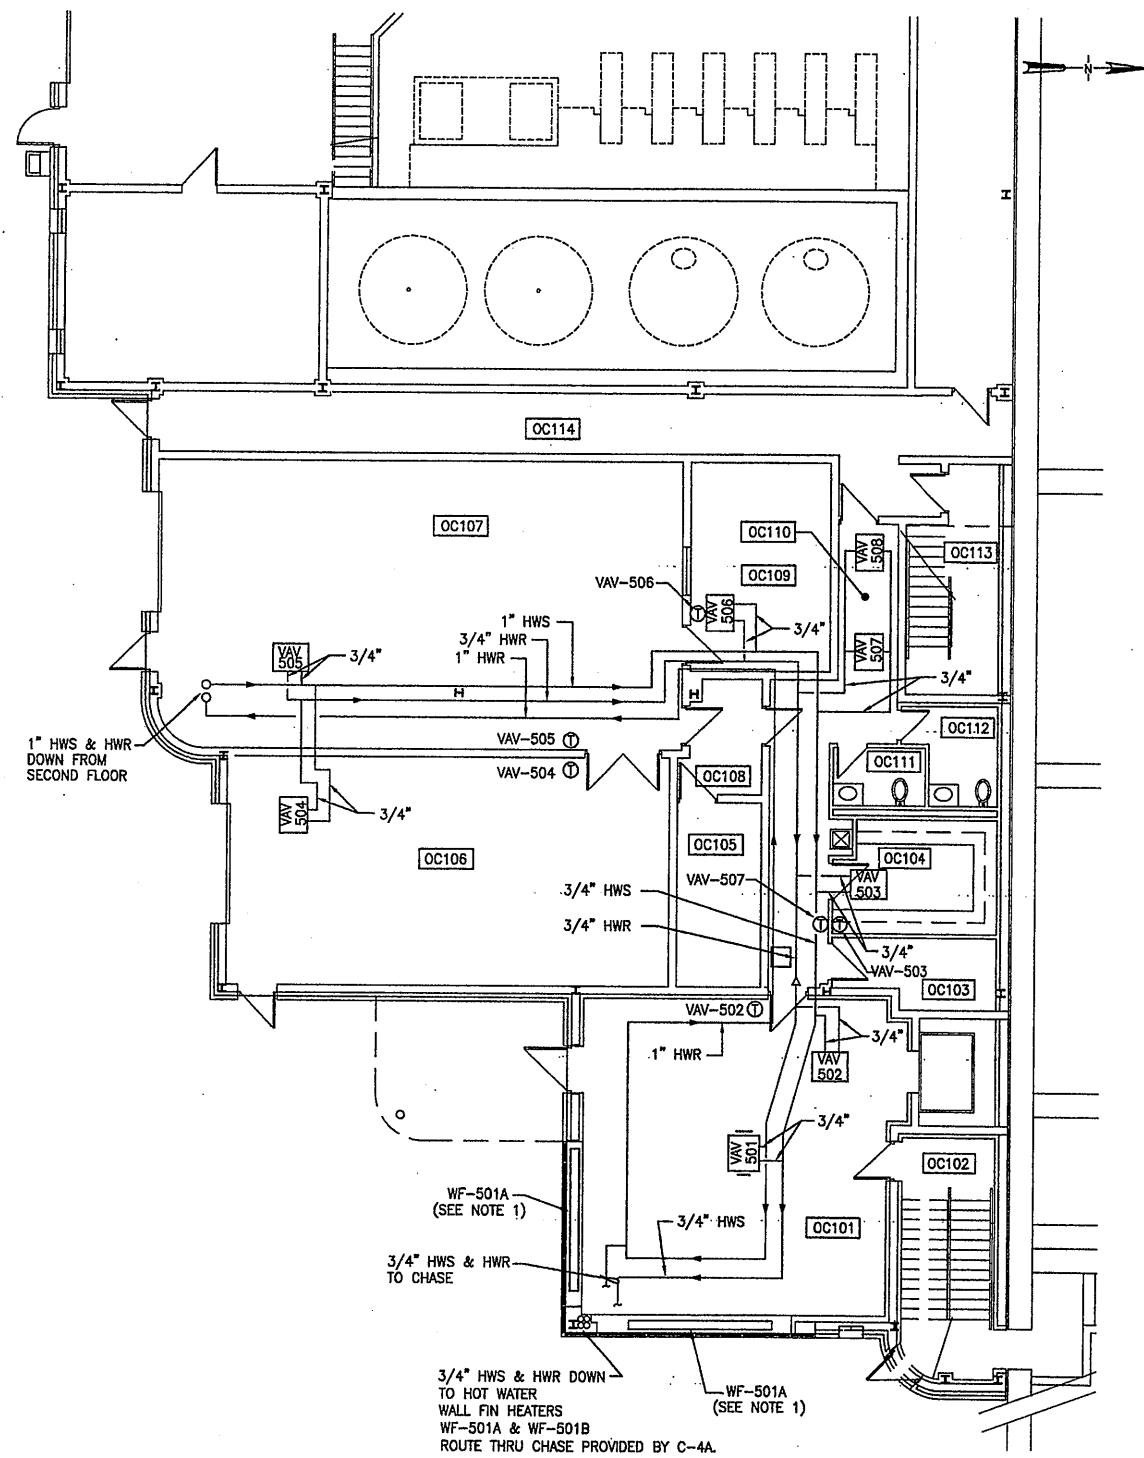

FIRST FLOOR PIPING PLAN
1/8"=1'-0"

NOTES:
1. MOUNT WALL FIN IN ENCLOSURE PROVIDED BY C-4A.

RECORD DRAWING

THESE DRAWINGS HAVE BEEN REVISED TO REFLECT MAJOR CHANGES, IF ANY, WHICH OCCURRED DURING CONSTRUCTION. REVISIONS ARE BASED UPON INFORMATION SUPPLIED BY CONTRACTOR.

DATE: _____ PER: _____

THIS DRAWING WAS PREPARED AT THE SCALE INDICATED IN THE TITLE BLOCK. INACCURACIES IN THE STATED SCALE MAY BE INTRODUCED WHEN DRAWINGS ARE REPRODUCED BY ANY MEANS. USE THE GRAPHIC SCALE BAR IN THE TITLE BLOCK TO DETERMINE THE ACTUAL SCALE OF THIS DRAWING.

02/08/01 OBG KJL
00659H501

| No. | Date | Revisions | Init |
|-----|----------|---------------------|------|
| 0 | 4/20/01 | ISSUED FOR APPROVAL | |
| 1 | | AS-BID | |
| 2 | 11/30/05 | RECORD DRAWING | RCG |

NO ALTERATIONS PERMITTED HEREON EXCEPT AS PROVIDED UNDER SECTION 7209 SUBDIVISION 2 OF THE NEW YORK STATE EDUCATION LAW

In charge of DPB
Designed by CJP
Drawn by KJL
Checked by SWM



ONONDAGA COUNTY • DEPARTMENT OF DRAINAGE AND SANITATION • SYRACUSE, NEW YORK
METROPOLITAN SYRACUSE WASTEWATER TREATMENT PLANT
STAGE III AMMONIA AND STAGE II PHOSPHORUS REMOVAL PROJECT
OPERATIONS CENTER
FIRST FLOOR PLANS


HEATING VENTILATING & AIR CONDITIONING



File Number
00659
Date
APRIL 2001


H-501

[Signature]

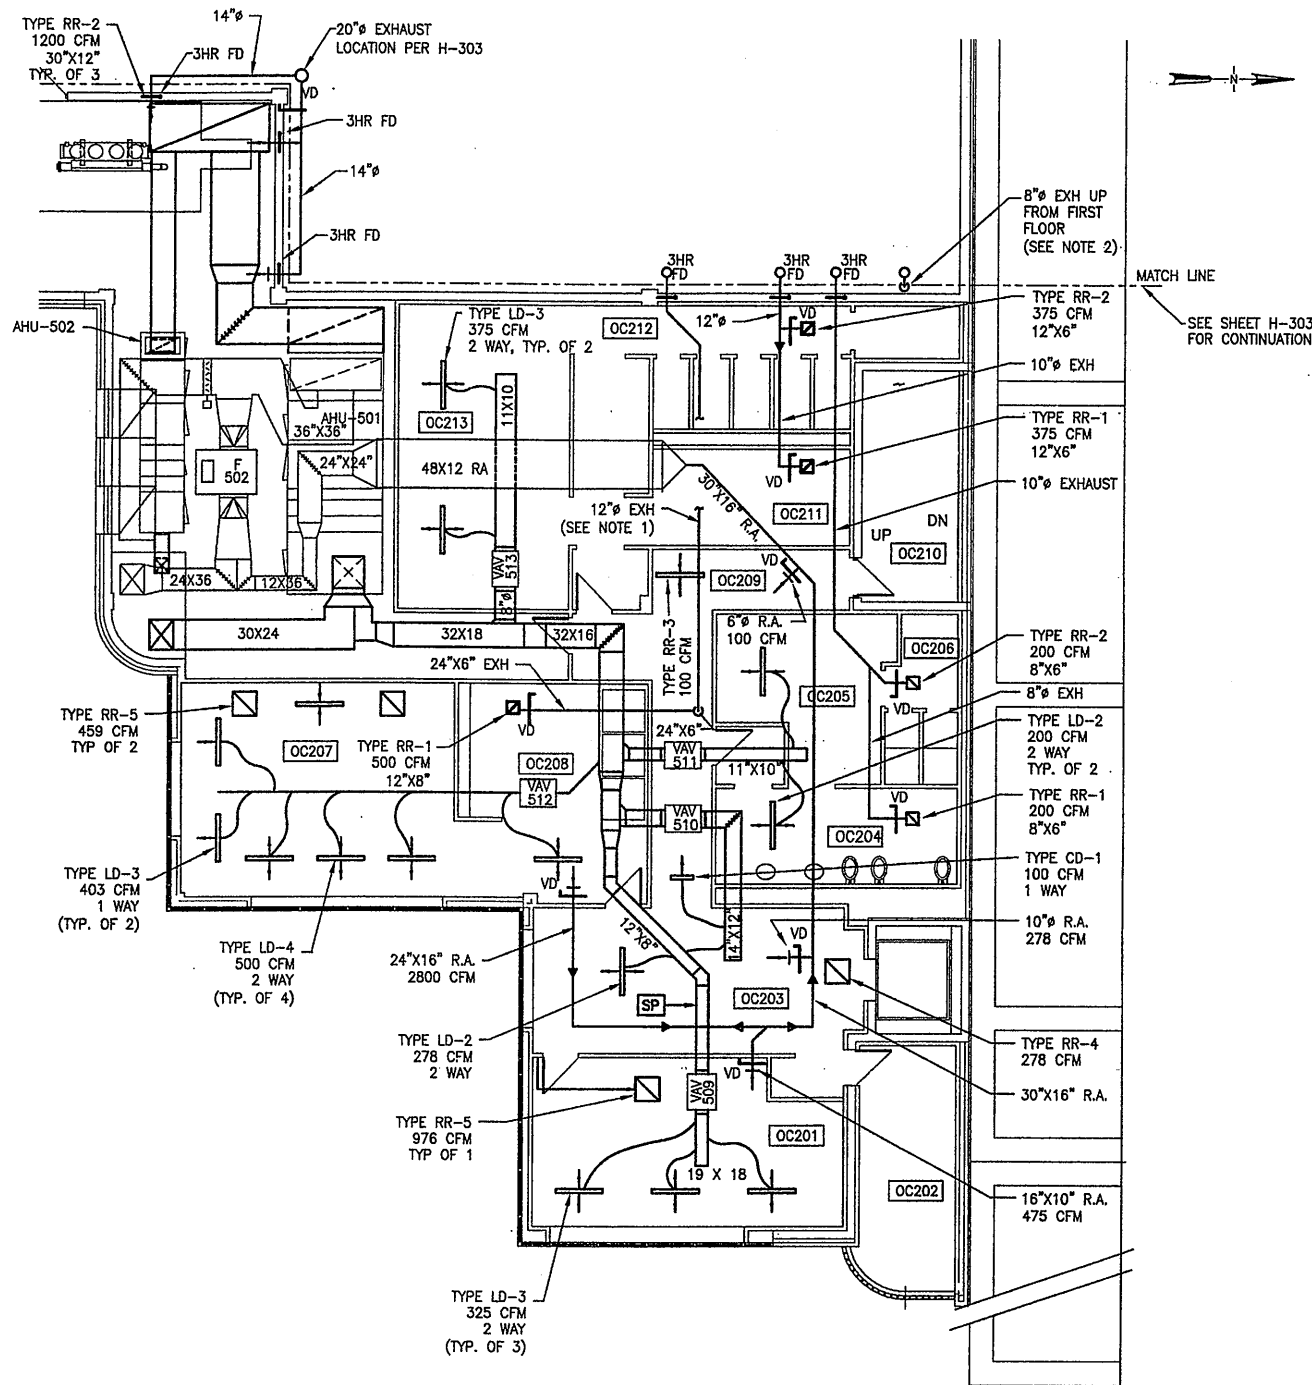

SECOND FLOOR DUCTING PLAN
1/8"=1'-0"

- NOTE:
 1. ROUTE EXHAUST DUCT THROUGH OPEN-WEB JOISTS.
 2. PROVIDE 3 HR FD WITH ACCESS DOOR AT PENETRATION THRU CORRIDOR CEILING.

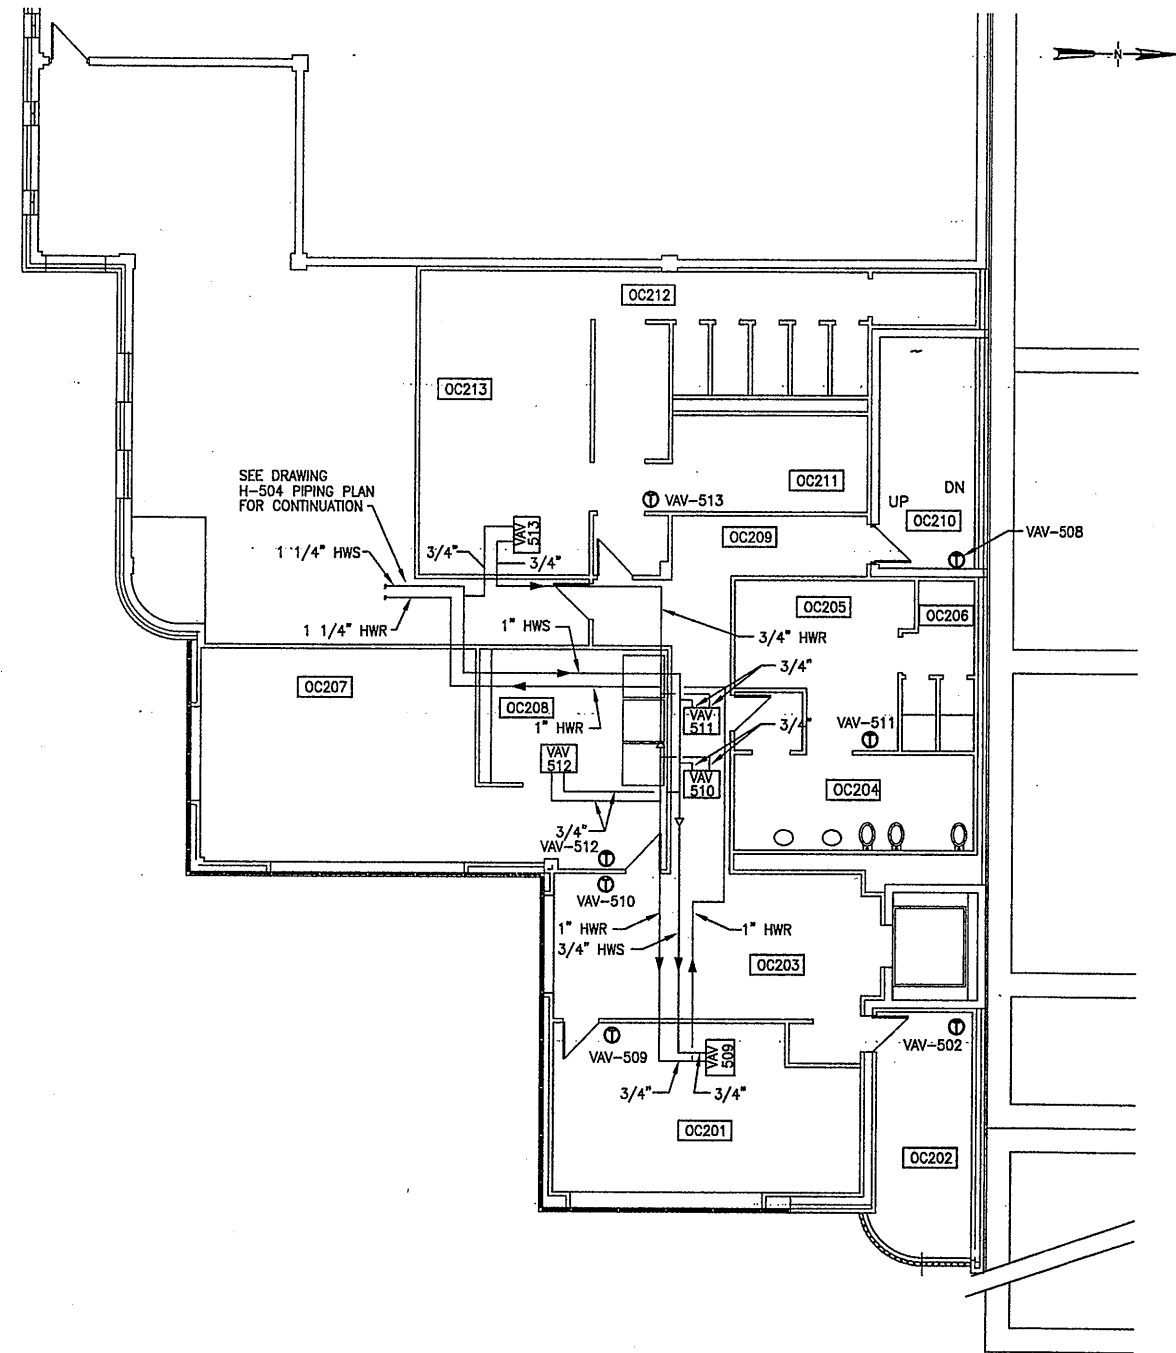

SECOND FLOOR PIPING PLAN
1/8"=1'-0"

02/08/01 OBG KJL
00659H502

RECORD DRAWING

THESE DRAWINGS HAVE BEEN REVISED TO REFLECT MAJOR CHANGES, IF ANY, WHICH OCCURRED DURING CONSTRUCTION. REVISIONS ARE BASED UPON INFORMATION SUPPLIED BY CONTRACTOR.

DATE: _____ PER: _____

THIS DRAWING WAS PREPARED AT THE SCALE INDICATED IN THE TITLE BLOCK. INACCURACIES IN THE STATED SCALE MAY BE INTRODUCED WHEN DRAWINGS ARE REPRODUCED BY ANY MEANS. USE THE GRAPHIC SCALE BAR IN THE TITLE BLOCK TO DETERMINE THE ACTUAL SCALE OF THIS DRAWING.



| No. | Date | Revisions | Init |
|-----|---------|---------------------|------|
| 0 | 4/20/01 | ISSUED FOR APPROVAL | |
| 1 | | AS-BID | |
| 2 | XX/XX | RECORD DRAWING | RCG |

In charge of DPB
 Designed by CJP
 Drawn by KJL
 Checked by SWM



ONONDAGA COUNTY • DEPARTMENT OF DRAINAGE AND SANITATION • SYRACUSE, NEW YORK
 METROPOLITAN SYRACUSE WASTEWATER TREATMENT PLANT
 STAGE III AMMONIA AND STAGE II PHOSPHORUS REMOVAL PROJECT
OPERATIONS CENTER
SECOND FLOOR PLANS

HEATING VENTILATING & AIR CONDITIONING




File Number
00659


Date
APRIL 2001

[Signature]

H-502

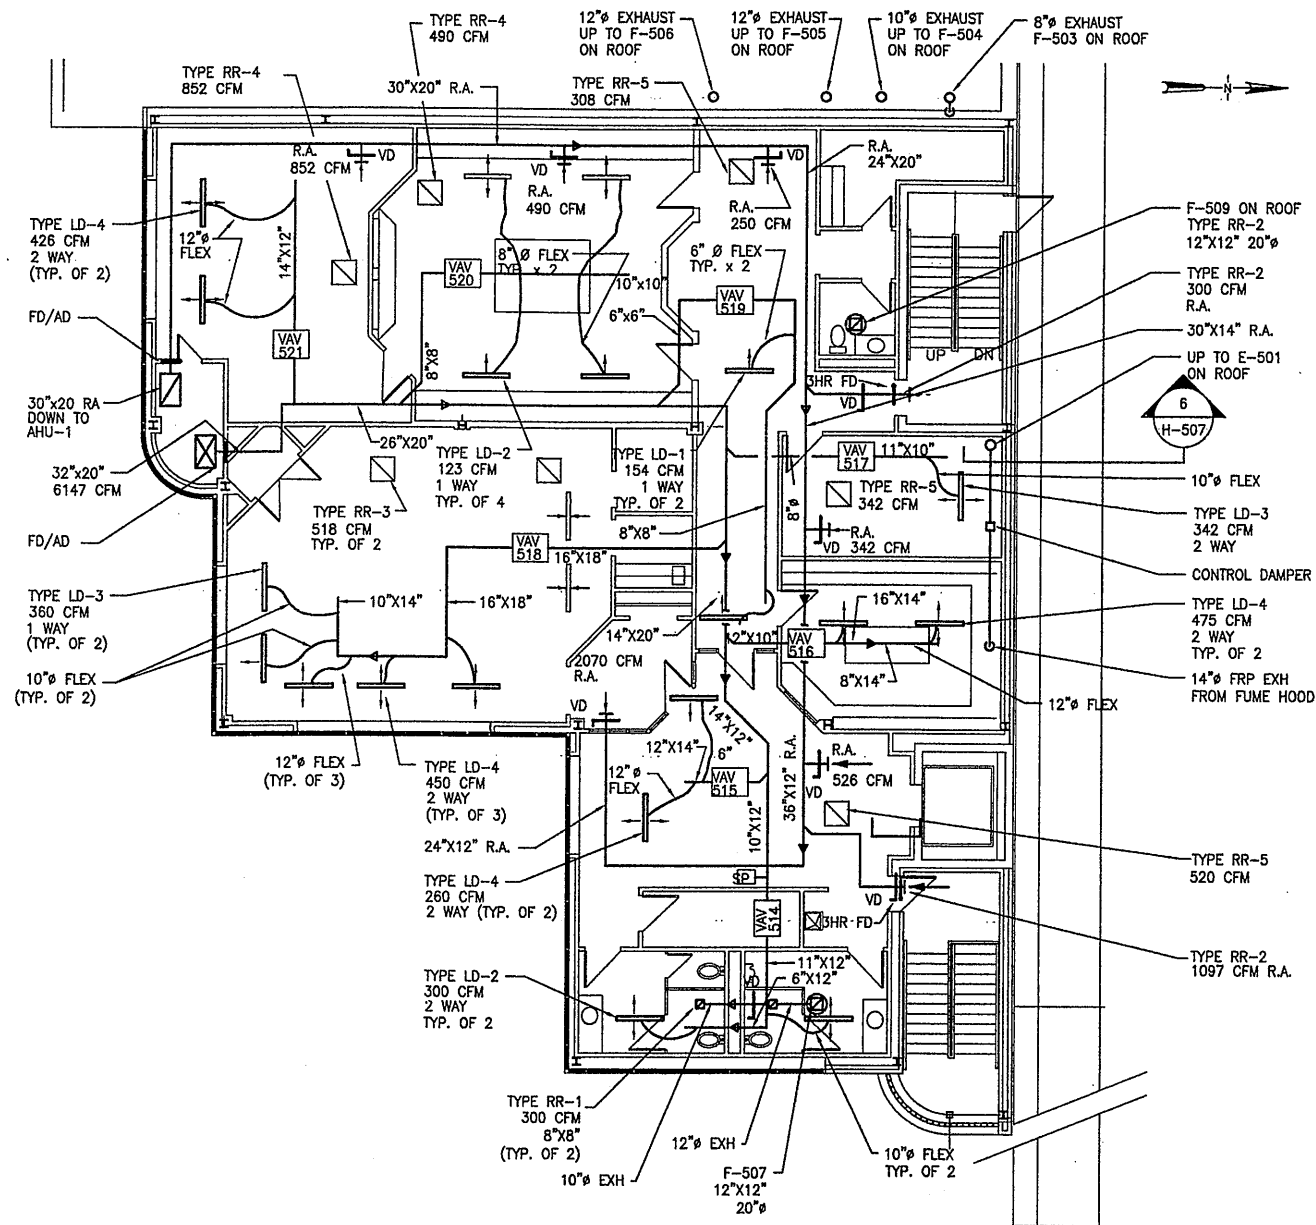

THIRD FLOOR DUCTING PLAN
1/8"=1'-0"

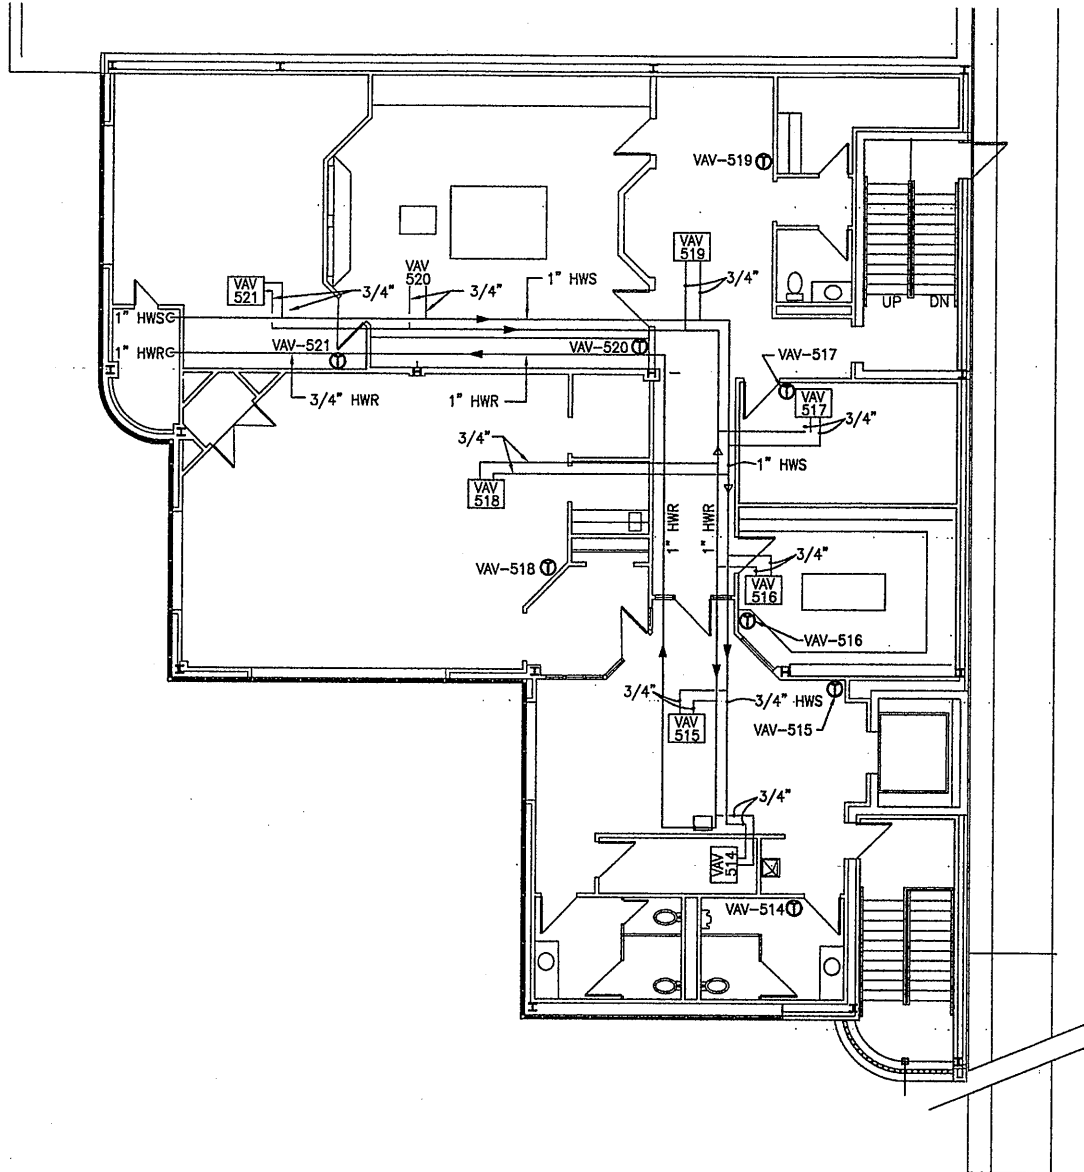

THIRD FLOOR PIPING PLAN
1/8"=1'-0"

02/13/01 OBG KJL
00658H503

RECORD DRAWING

THESE DRAWINGS HAVE BEEN REVISED TO REFLECT MAJOR CHANGES, IF ANY, WHICH OCCURRED DURING CONSTRUCTION. REVISIONS ARE BASED UPON INFORMATION SUPPLIED BY CONTRACTOR.

DATE: _____ PER: _____

THIS DRAWING WAS PREPARED AT THE SCALE INDICATED IN THE TITLE BLOCK. INACCURACIES IN THE STATED SCALE MAY BE INTRODUCED WHEN DRAWINGS ARE REPRODUCED BY ANY MEANS. USE THE GRAPHIC SCALE BAR IN THE TITLE BLOCK TO DETERMINE THE ACTUAL SCALE OF THIS DRAWING.

1/8"=1'-0"

NO ALTERATIONS PERMITTED HEREON EXCEPT AS PROVIDED UNDER SECTION 7209 SUBDIVISION 2 OF THE NEW YORK STATE EDUCATION LAW


| No. | Date | Revisions | Init |
|-----|---------|---------------------|------|
| 0 | 4/20/01 | ISSUED FOR APPROVAL | |
| 1 | | AS-BID | |
| 2 | 1/30/03 | RECORD DRAWING | RCG |

In charge of DPB
 Designed by CJP
 Drawn by KJL
 Checked by SWM

ENVIRONMENTAL ENGINEERING ASSOCIATES, LLP
SYRACUSE, NEW YORK

ONONDAGA COUNTY • DEPARTMENT OF DRAINAGE AND SANITATION • SYRACUSE, NEW YORK
 METROPOLITAN SYRACUSE WASTEWATER TREATMENT PLANT
 STAGE III AMMONIA AND STAGE II PHOSPHORUS REMOVAL PROJECT
OPERATIONS CENTER
THIRD FLOOR PLANS
 HEATING VENTILATING & AIR CONDITIONING


File Number 00659
 Date APRIL 2001
H-503
Campolunghi

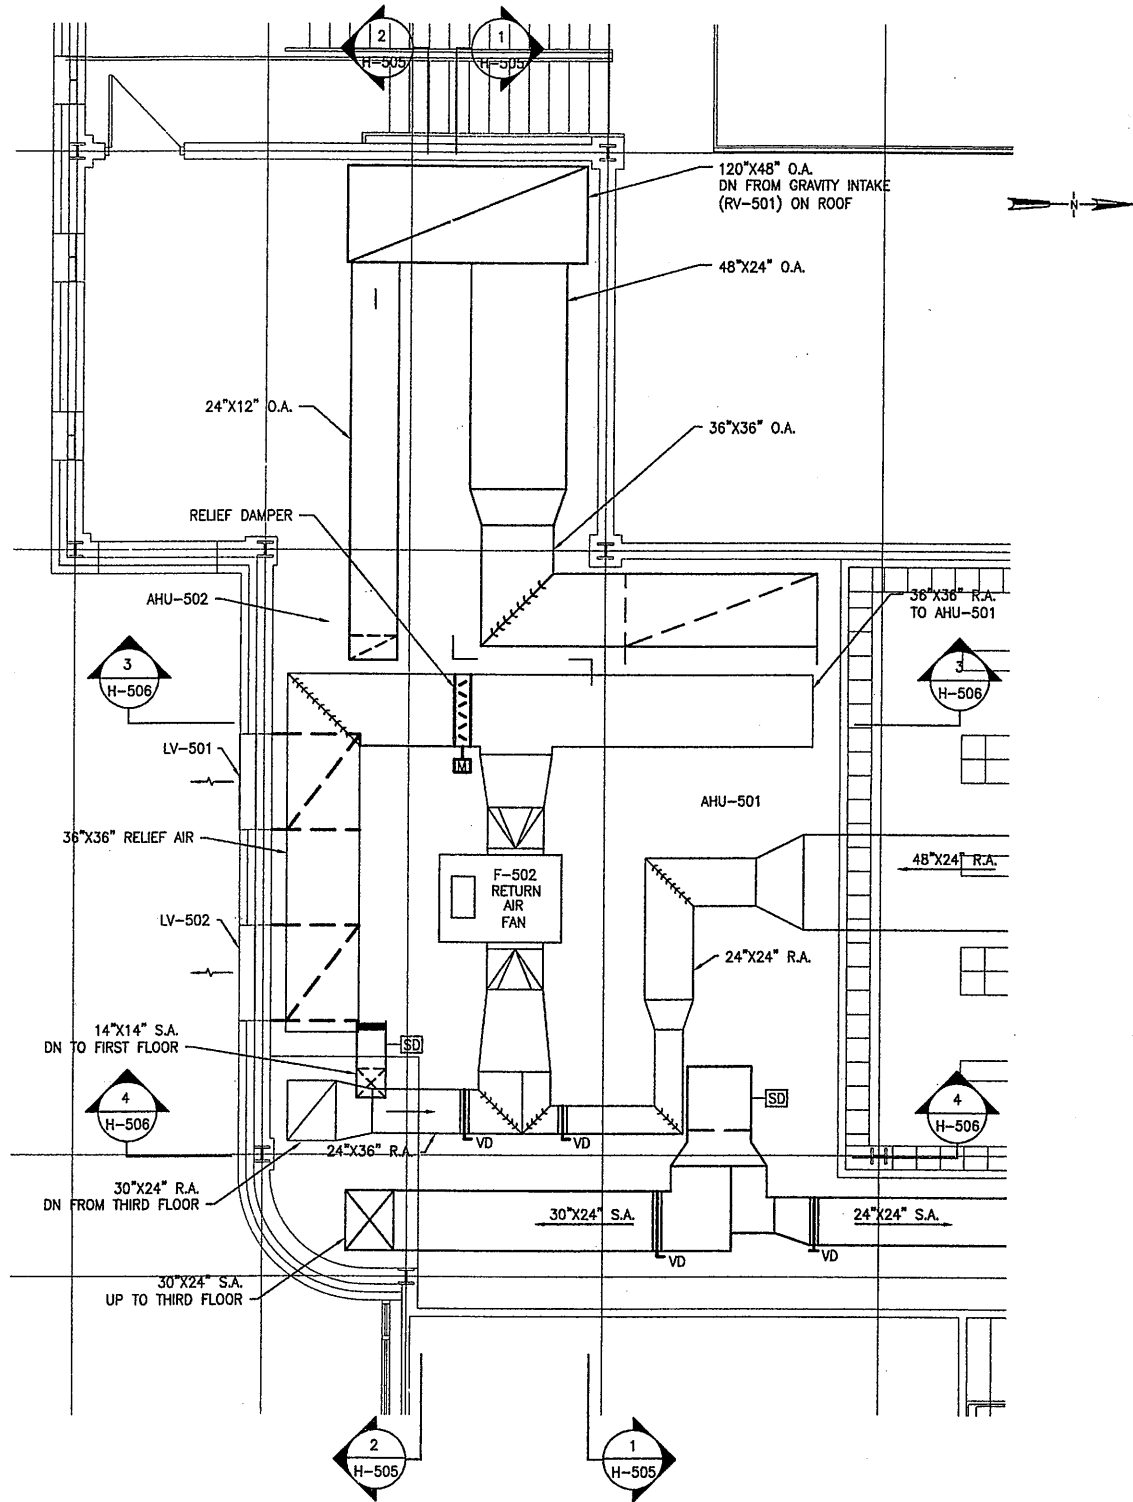

MECHANICAL ROOM DUCTING PLAN

1/4"=1'-0"

NOTE:
1. ROUTE DUCTWORK AS HIGH AS POSSIBLE.

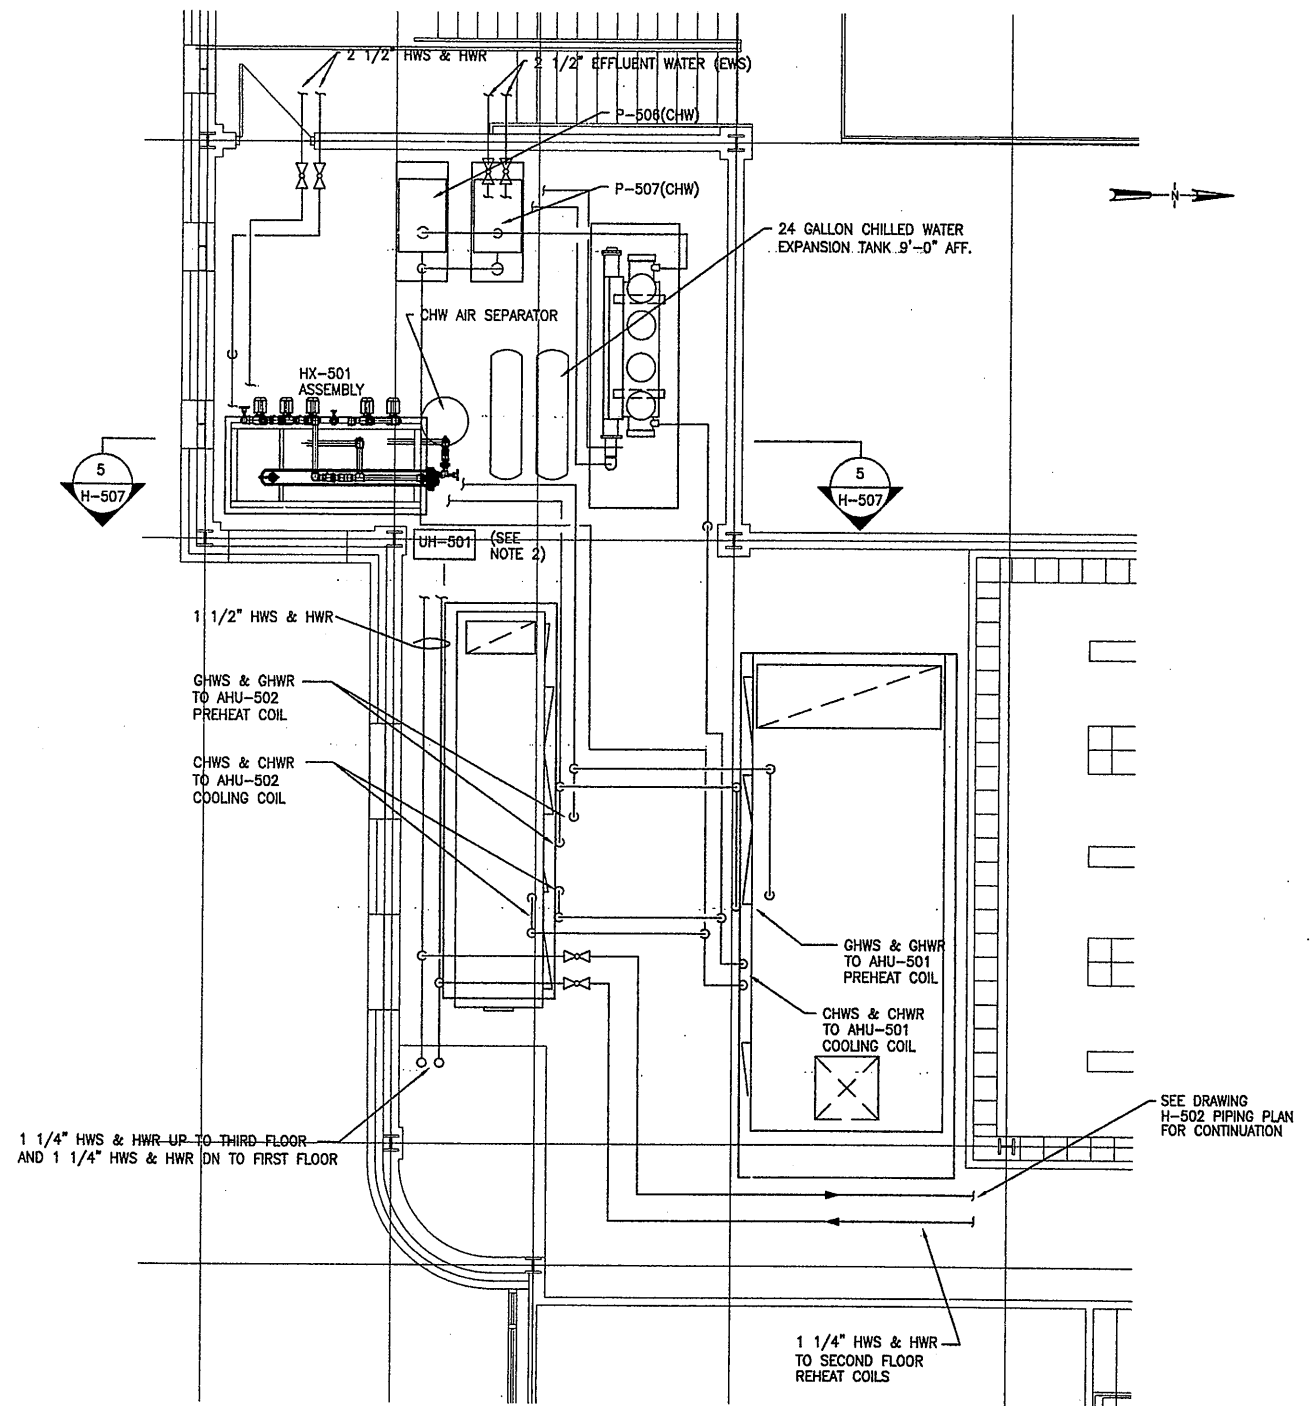

MECHANICAL ROOM PIPING PLAN

1/4"=1'-0"

NOTE:
1. SEE PIPING SCHEMATICS FOR DETAILED PIPING COMPONENTS AND SIZES.
2. CONNECT HWS & HWR TO UH-501.


RECORD DRAWING

THESE DRAWINGS HAVE BEEN REVISED TO REFLECT MAJOR CHANGES, IF ANY, WHICH OCCURRED DURING CONSTRUCTION. REVISIONS ARE BASED UPON INFORMATION SUPPLIED BY CONTRACTOR.

DATE: _____ PER: _____

THIS DRAWING WAS PREPARED AT THE SCALE INDICATED IN THE TITLE BLOCK. INACCURACIES IN THE STATED SCALE MAY BE INTRODUCED WHEN DRAWINGS ARE REPRODUCED BY ANY MEANS. USE THE GRAPHIC SCALE BAR IN THE TITLE BLOCK TO DETERMINE THE ACTUAL SCALE OF THIS DRAWING.

02/13/01 OBG KJL
00659H504

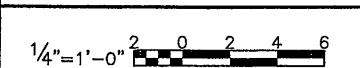

| No. | Date | Revisions | Init |
|-----|---------|---------------------------------|------|
| 0 | 4/20/01 | ISSUED FOR APPROVAL | |
| 1 | 7/11/01 | AS-BID | |
| 2 | 3/20/02 | REVISED FOR MODIFICATION 4C.002 | |
| 3 | 1/30/03 | RECORD DRAWING | RCG |

In charge of DPB
Designed by CJP
Drawn by KJL
Checked by SWM



ONONDAGA COUNTY • DEPARTMENT OF DRAINAGE AND SANITATION • SYRACUSE, NEW YORK
METROPOLITAN SYRACUSE WASTEWATER TREATMENT PLANT
STAGE III AMMONIA AND STAGE II PHOSPHORUS REMOVAL PROJECT
OPERATIONS CENTER
MECHANICAL ROOM PLANS

HEATING VENTILATING & AIR CONDITIONING




File Number
00659


Date
APRIL 2001

H-504

Wampol

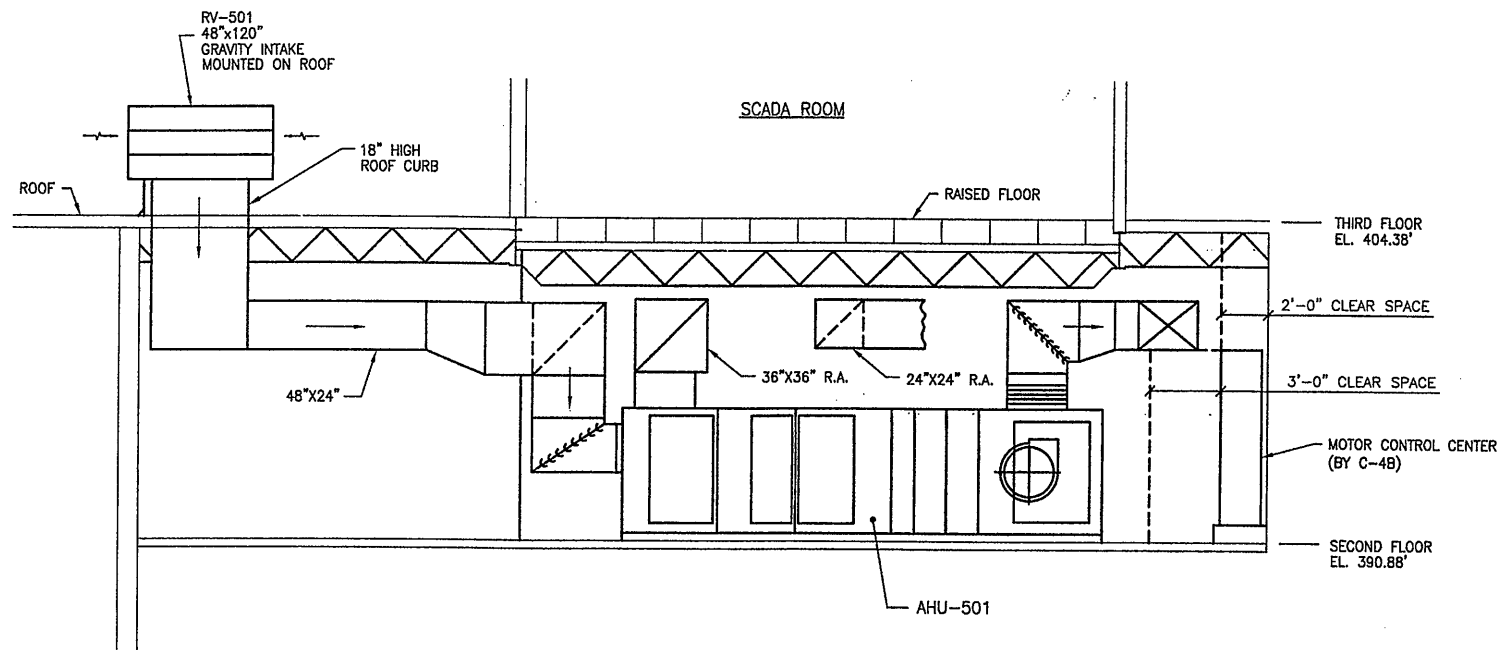

SECTION 1
1/4"=1'-0" H-504

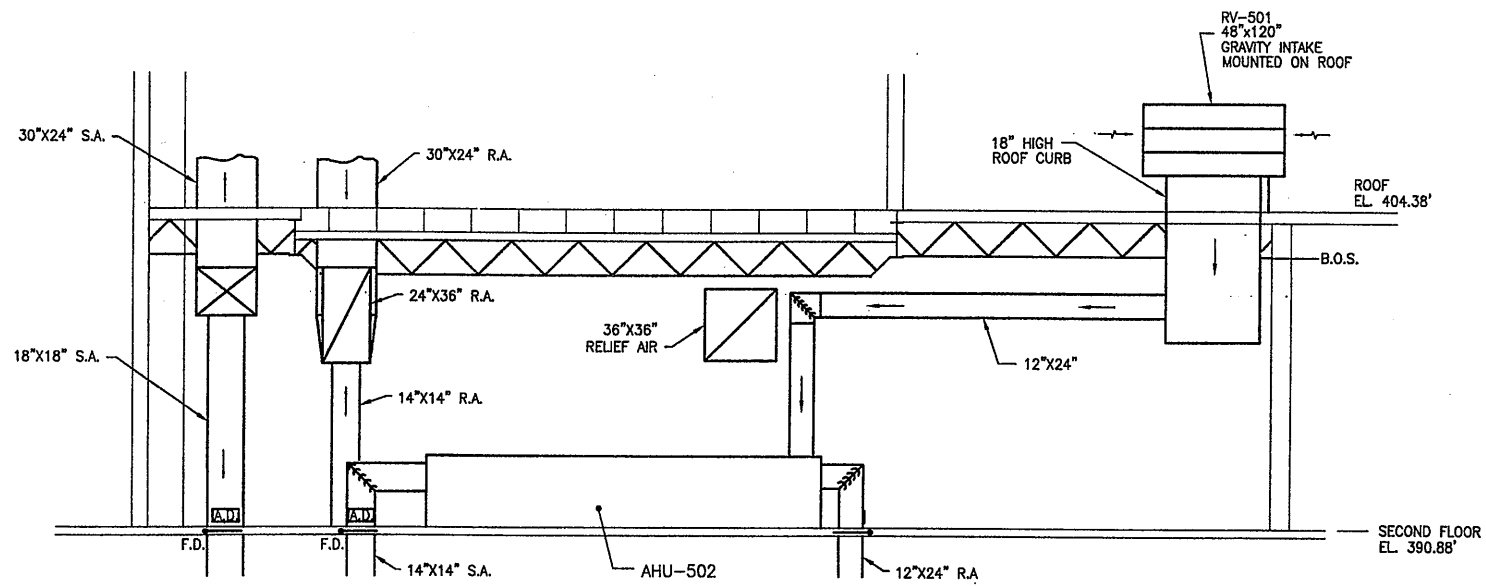

SECTION 2
1/4"=1'-0" H-504

02/13/01 OBG KJL
00659H505

RECORD DRAWING

THESE DRAWINGS HAVE BEEN REVISED TO REFLECT MAJOR CHANGES, IF ANY, WHICH OCCURRED DURING CONSTRUCTION. REVISIONS ARE BASED UPON INFORMATION SUPPLIED BY CONTRACTOR.

DATE: _____ PER: _____

THIS DRAWING WAS PREPARED AT THE SCALE INDICATED IN THE TITLE BLOCK. INACCURACIES IN THE STATED SCALE MAY BE INTRODUCED WHEN DRAWINGS ARE REPRODUCED BY ANY MEANS. USE THE GRAPHIC SCALE BAR IN THE TITLE BLOCK TO DETERMINE THE ACTUAL SCALE OF THIS DRAWING.

1/4"=1'-0"

NO ALTERATIONS PERMITTED HEREON EXCEPT AS PROVIDED UNDER SECTION 7209 SUBDIVISION 2 OF THE NEW YORK STATE EDUCATION LAW



| No. | Date | Revisions | Init |
|-----|---------|---------------------|------|
| 0 | 4/20/01 | ISSUED FOR APPROVAL | |
| 1 | | AS-BID | |
| 2 | 1/30/05 | RECORD DRAWING | RCG |

In charge of DPB
 Designed by CJP
 Drawn by KJL
 Checked by SWM

ENVIRONMENTAL ENGINEERING ASSOCIATES, LLP
 SYRACUSE, NEW YORK

ONONDAGA COUNTY • DEPARTMENT OF DRAINAGE AND SANITATION • SYRACUSE, NEW YORK
 METROPOLITAN SYRACUSE WASTEWATER TREATMENT PLANT
 STAGE III AMMONIA AND STAGE II PHOSPHORUS REMOVAL PROJECT
OPERATIONS CENTER SECTIONS
 HEATING VENTILATING & AIR CONDITIONING

File Number 00659
 Date APRIL 2001
 Signature: Leonard J. Camporeale
H-505

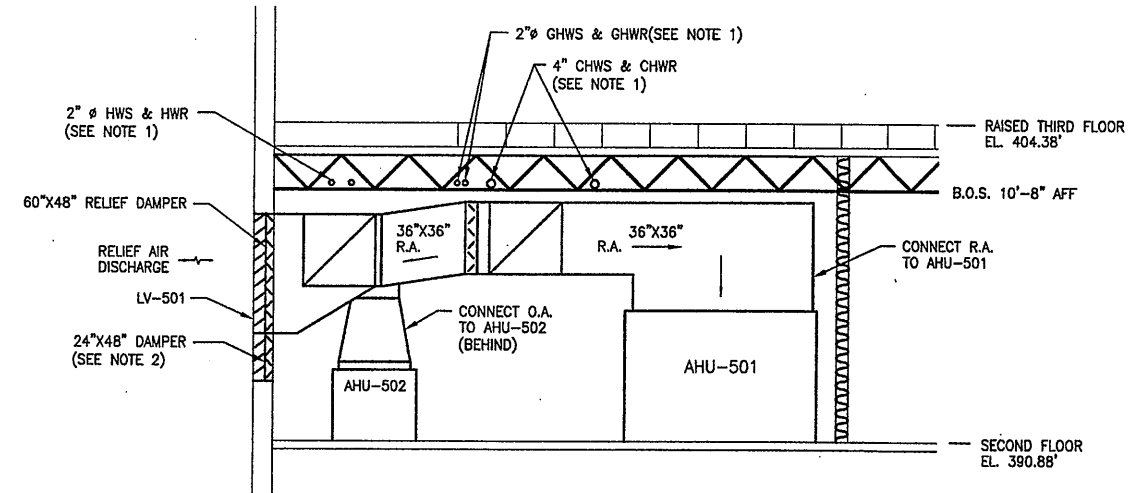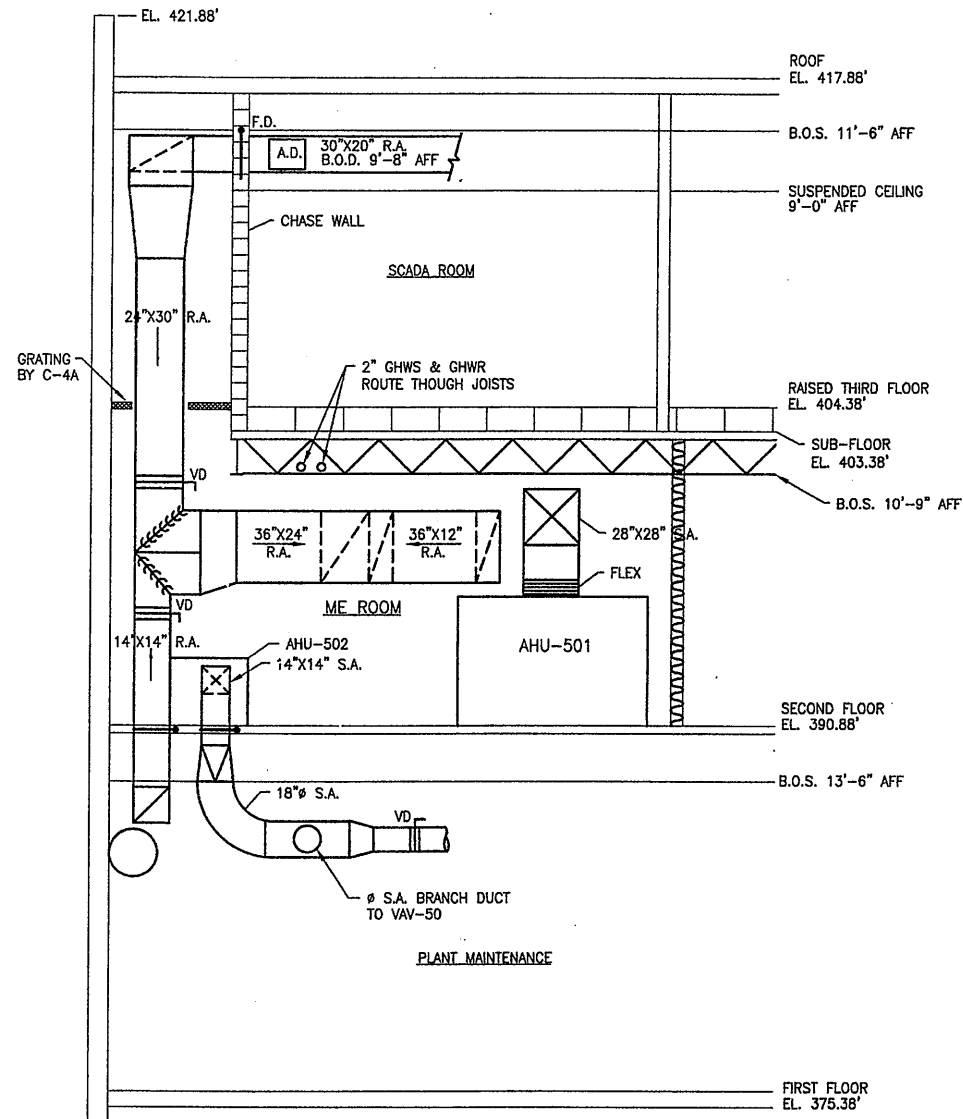

SECTION 3
1/4"=1'-0" H-504

- NOTES:
 1. ROUTE PIPING THROUGH OPEN-WEB JOISTS.
 2. MECH. ROOM VENTILATION DAMPER

SECTION 4
1/4"=1'-0" H-504

- NOTE:
 1. RAISED THIRD FLOOR IN SCADA ROOM AND CONTROL ROOM. REFER TO ARCHITECTURAL AND STRUCTURAL DRAWINGS.


02/13/01 OBG KJL
00659H506

RECORD DRAWING

THESE DRAWINGS HAVE BEEN REVISED TO REFLECT MAJOR CHANGES, IF ANY, WHICH OCCURRED DURING CONSTRUCTION. REVISIONS ARE BASED UPON INFORMATION SUPPLIED BY CONTRACTOR.

DATE: _____ PER: _____

THIS DRAWING WAS PREPARED AT THE SCALE INDICATED IN THE TITLE BLOCK. INACCURACIES IN THE STATED SCALE MAY BE INTRODUCED WHEN DRAWINGS ARE REPRODUCED BY ANY MEANS. USE THE GRAPHIC SCALE BAR IN THE TITLE BLOCK TO DETERMINE THE ACTUAL SCALE OF THIS DRAWING.

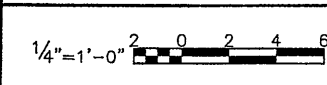

| No. | Date | Revisions | Init |
|-----|---------|---------------------|------|
| 0 | 4/20/01 | ISSUED FOR APPROVAL | |
| 1 | | AS-BID | |
| 2 | 1/30/03 | RECORD DRAWING | RCG |

In charge of DPB
 Designed by CJP
 Drawn by KJL
 Checked by SWM



ONONDAGA COUNTY • DEPARTMENT OF DRAINAGE AND SANITATION • SYRACUSE, NEW YORK
 METROPOLITAN SYRACUSE WASTEWATER TREATMENT PLANT
 STAGE III AMMONIA AND STAGE II PHOSPHORUS REMOVAL PROJECT
 OPERATIONS CENTER
 SECTIONS




File Number
00659
Date
APRIL 2001

H-506

HVAC


ROOF EL. 404.38'

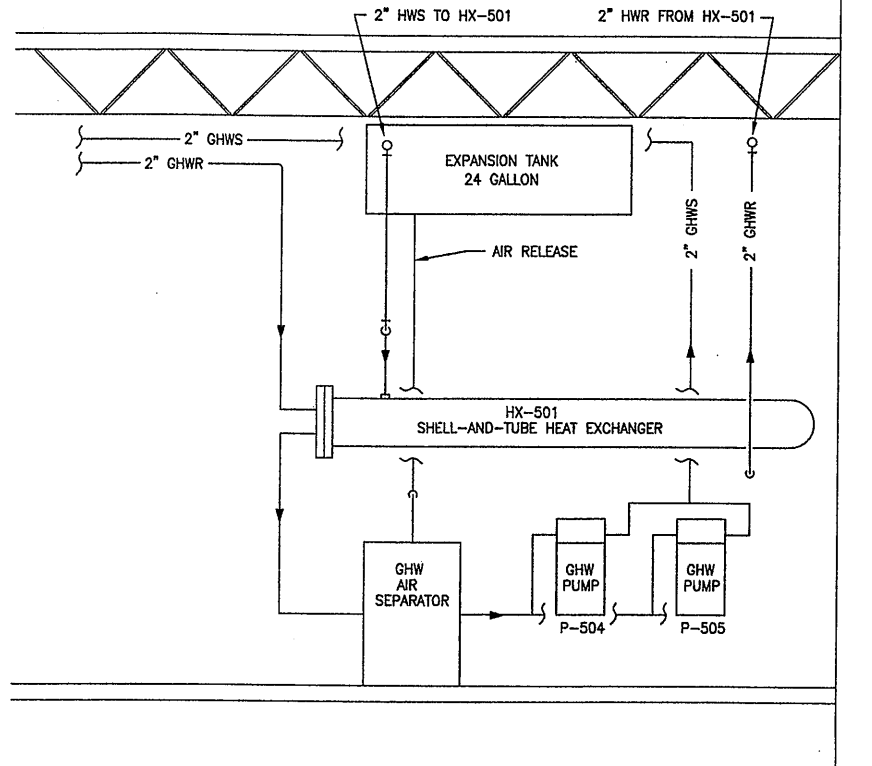

SECTION 5
1/2"=1'-0" H-504

NOTES:

1. SEE PIPING SCHEMATIC (DWG H-508) FOR DETAILED PIPING COMPONENTS AND SIZES.
2. PROVIDE STRUCTURAL STEEL FRAMEWORK TO SUPPORT HX-501 AT 5'-0" AFF.

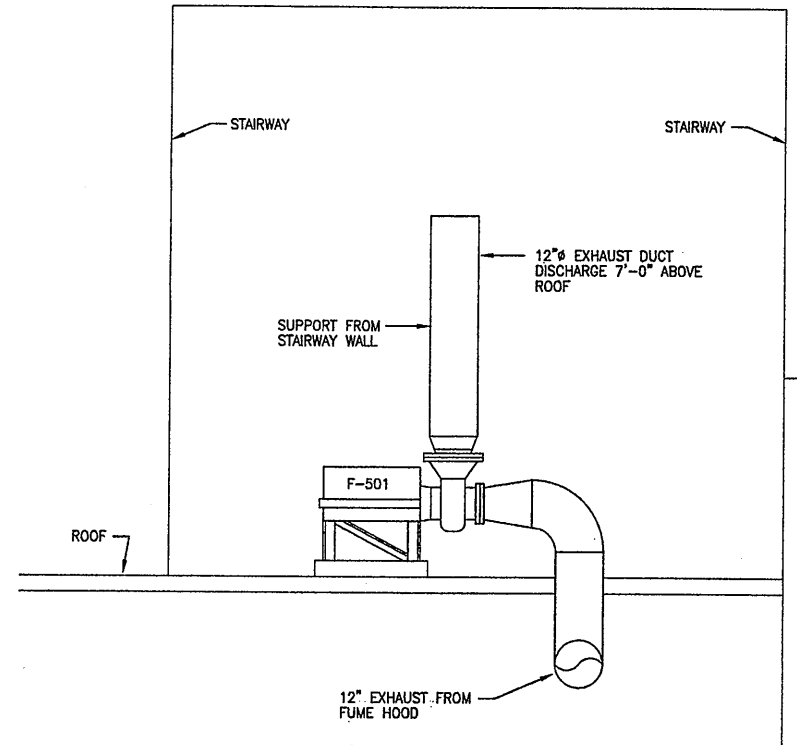

SECTION 6
1/2"=1'-0" H-503


02/13/01 OBG KJL
00659H507

RECORD DRAWING

THESE DRAWINGS HAVE BEEN REVISED TO REFLECT MAJOR CHANGES, IF ANY, WHICH OCCURRED DURING CONSTRUCTION. REVISIONS ARE BASED UPON INFORMATION SUPPLIED BY CONTRACTOR.

DATE: _____ PER: _____

THIS DRAWING WAS PREPARED AT THE SCALE INDICATED IN THE TITLE BLOCK. INACCURACIES IN THE STATED SCALE MAY BE INTRODUCED WHEN DRAWINGS ARE REPRODUCED BY ANY MEANS. USE THE GRAPHIC SCALE BAR IN THE TITLE BLOCK TO DETERMINE THE ACTUAL SCALE OF THIS DRAWING.

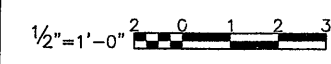

| No. | Date | Revisions | Init |
|-----|----------|---------------------|------|
| 0 | 4/20/01 | ISSUED FOR APPROVAL | |
| 1 | | AS-BID | |
| 2 | 11/30/03 | RECORD DRAWING | RCG |

In charge of DPB
Designed by CJP
Drawn by KJL
Checked by SWM



ONONDAGA COUNTY • DEPARTMENT OF DRAINAGE AND SANITATION • SYRACUSE, NEW YORK
METROPOLITAN SYRACUSE WASTEWATER TREATMENT PLANT
STAGE III AMMONIA AND STAGE II PHOSPHORUS REMOVAL PROJECT
OPERATIONS CENTER SECTIONS

HEATING VENTILATING & AIR CONDITIONING




File Number 00659
Date APRIL 2001

H-507

Handwritten signature


NO ALTERATIONS PERMITTED HEREON EXCEPT AS PROVIDED UNDER SECTION 7209 SUBDIVISION 2 OF THE NEW YORK STATE EDUCATION LAW

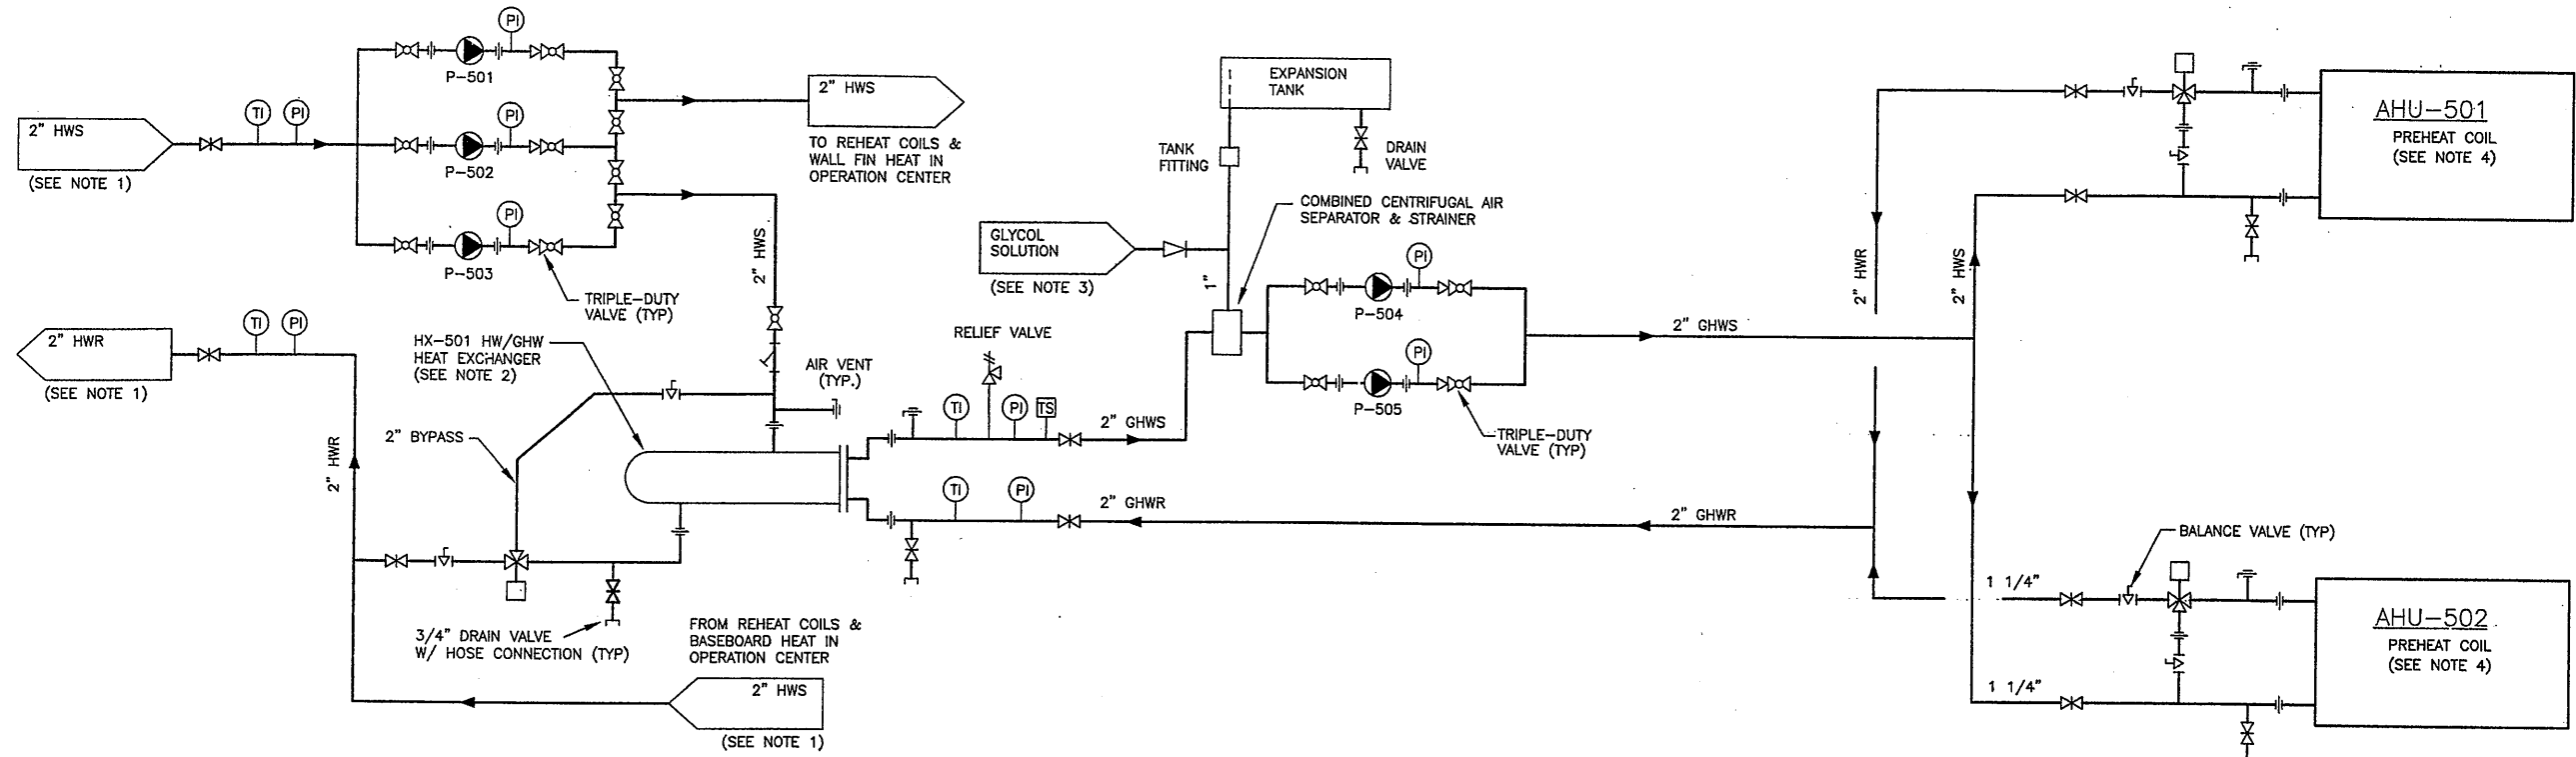

HOT WATER SYSTEM NOTES:

1. HOT WATER FROM STEAM-TO-HOT-WATER HEAT EXCHANGER LOCATED IN MECHANICAL ROOM.
2. ARRANGE HEAT EXCHANGER PIPING TO FACILITATE TUBE REMOVAL.
3. REFER TO CHILLED WATER PIPING SCHEMATIC FOR SOURCE OF GLYCOL SOLUTION.
4. ARRANGE PIPING TO FACILITATE COIL REMOVAL FROM AHU.
5. GLYCOL HOT WATER SYSTEM SHALL CONTAIN A SOLUTION OF 50% PROPYLENE GLYCOL AND 50% WATER.

OPERATIONS CENTER HOT WATER SYSTEM SCHEMATIC
NOT TO SCALE

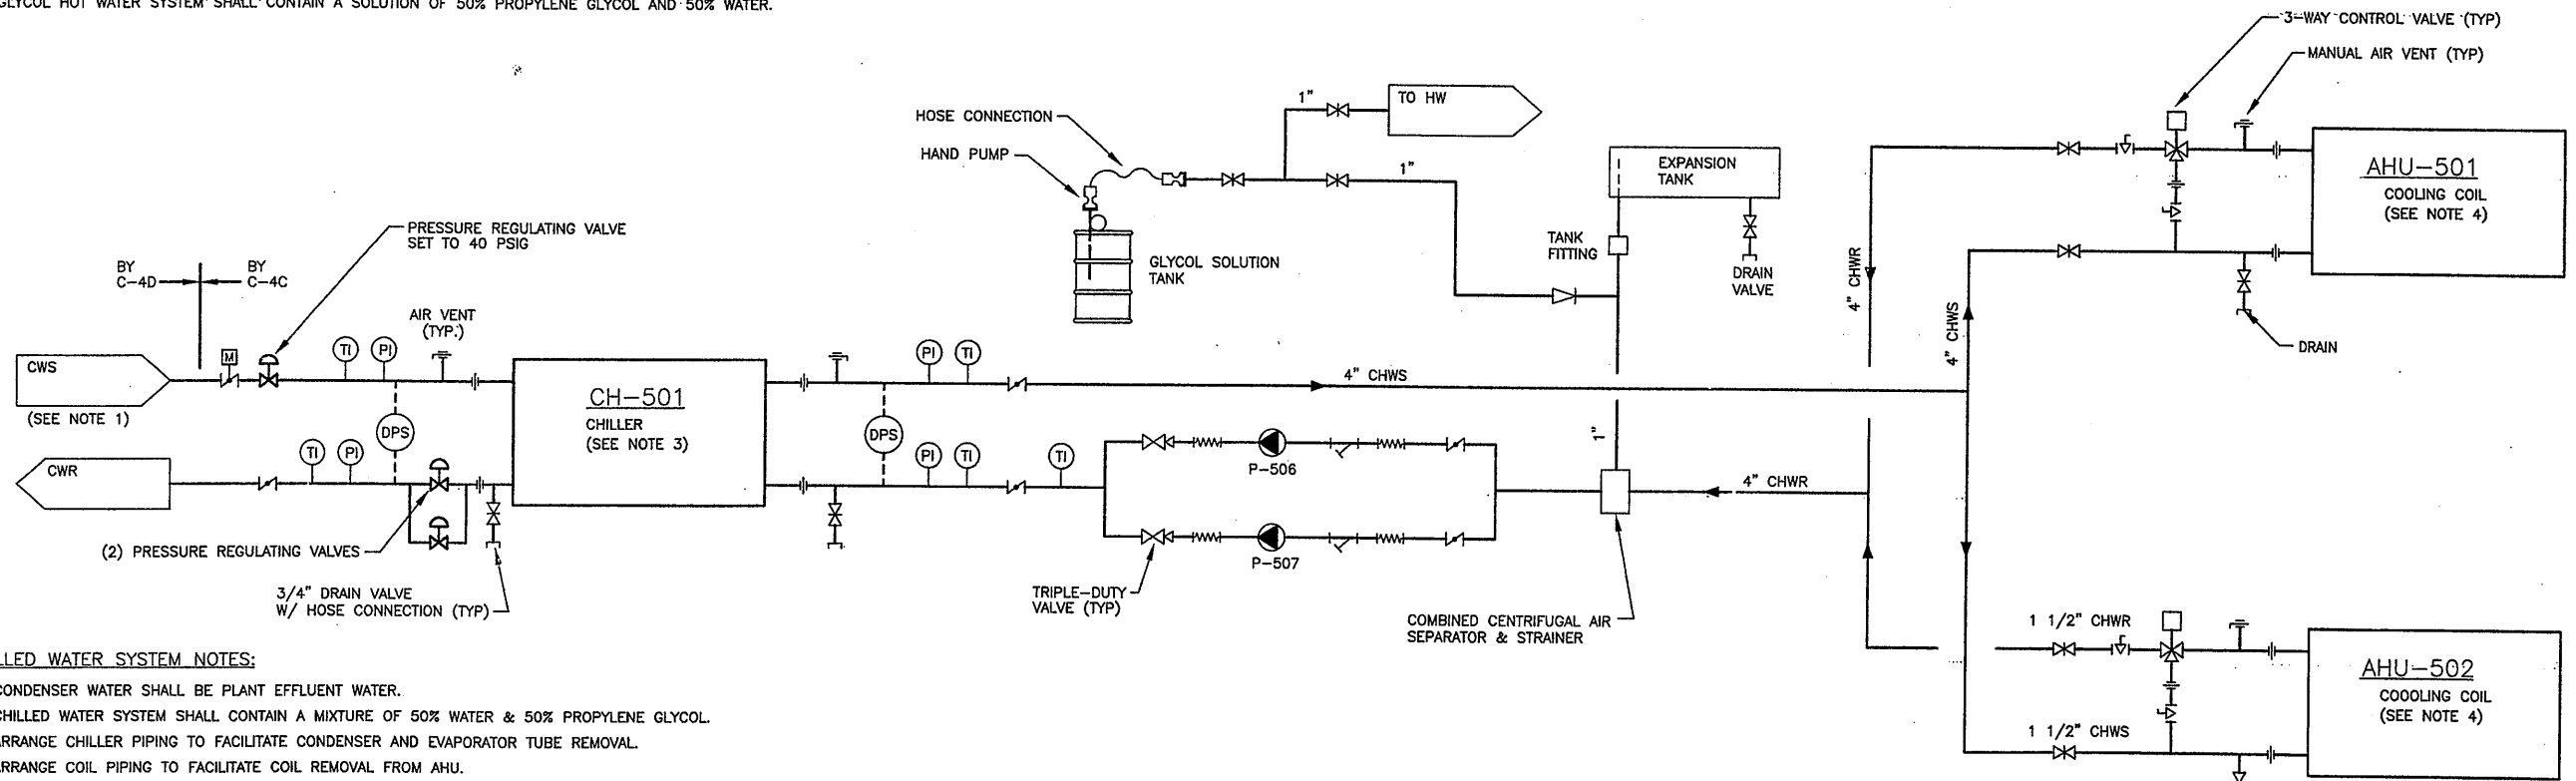

CHILLED WATER SYSTEM NOTES:

1. CONDENSER WATER SHALL BE PLANT EFFLUENT WATER.
2. CHILLED WATER SYSTEM SHALL CONTAIN A MIXTURE OF 50% WATER & 50% PROPYLENE GLYCOL.
3. ARRANGE CHILLER PIPING TO FACILITATE CONDENSER AND EVAPORATOR TUBE REMOVAL.
4. ARRANGE COIL PIPING TO FACILITATE COIL REMOVAL FROM AHU.

CHILLED WATER SYSTEM SCHEMATIC
NOT TO SCALE

RECORD DRAWING
THESE DRAWINGS HAVE BEEN REVISED TO REFLECT MAJOR CHANGES, IF ANY, WHICH OCCURRED DURING CONSTRUCTION. REVISIONS ARE BASED UPON INFORMATION SUPPLIED BY CONTRACTOR.
DATE: _____ PER: _____

THIS DRAWING WAS PREPARED AT THE SCALE INDICATED IN THE TITLE BLOCK. INACCURACIES IN THE STATED SCALE MAY BE INTRODUCED WHEN DRAWINGS ARE REPRODUCED BY ANY MEANS. USE THE GRAPHIC SCALE BAR IN THE TITLE BLOCK TO DETERMINE THE ACTUAL SCALE OF THIS DRAWING.

02/15/01 OBG JAS
00659H508

| No. | Date | Revisions | Init |
|-----|----------|---------------------|------|
| 0 | 4/20/01 | ISSUED FOR APPROVAL | |
| 1 | | AS-BID | |
| 2 | 11/30/03 | RECORD DRAWING | RCG |

In charge of DPB
Designed by CJP
Drawn by KJL
Checked by SWM



ONONDAGA COUNTY • DEPARTMENT OF DRAINAGE AND SANITATION • SYRACUSE, NEW YORK
METROPOLITAN SYRACUSE WASTEWATER TREATMENT PLANT
STAGE III AMMONIA AND STAGE II PHOSPHORUS REMOVAL PROJECT

**OPERATIONS CENTER
PIPING SYSTEM SCHEMATICS**
HVAC




File Number
00659

Date
APRIL 2001

H-508

NO ALTERATIONS PERMITTED HEREON EXCEPT AS PROVIDED UNDER SECTION 7209 SUBDIVISION 2 OF THE NEW YORK STATE EDUCATION LAW

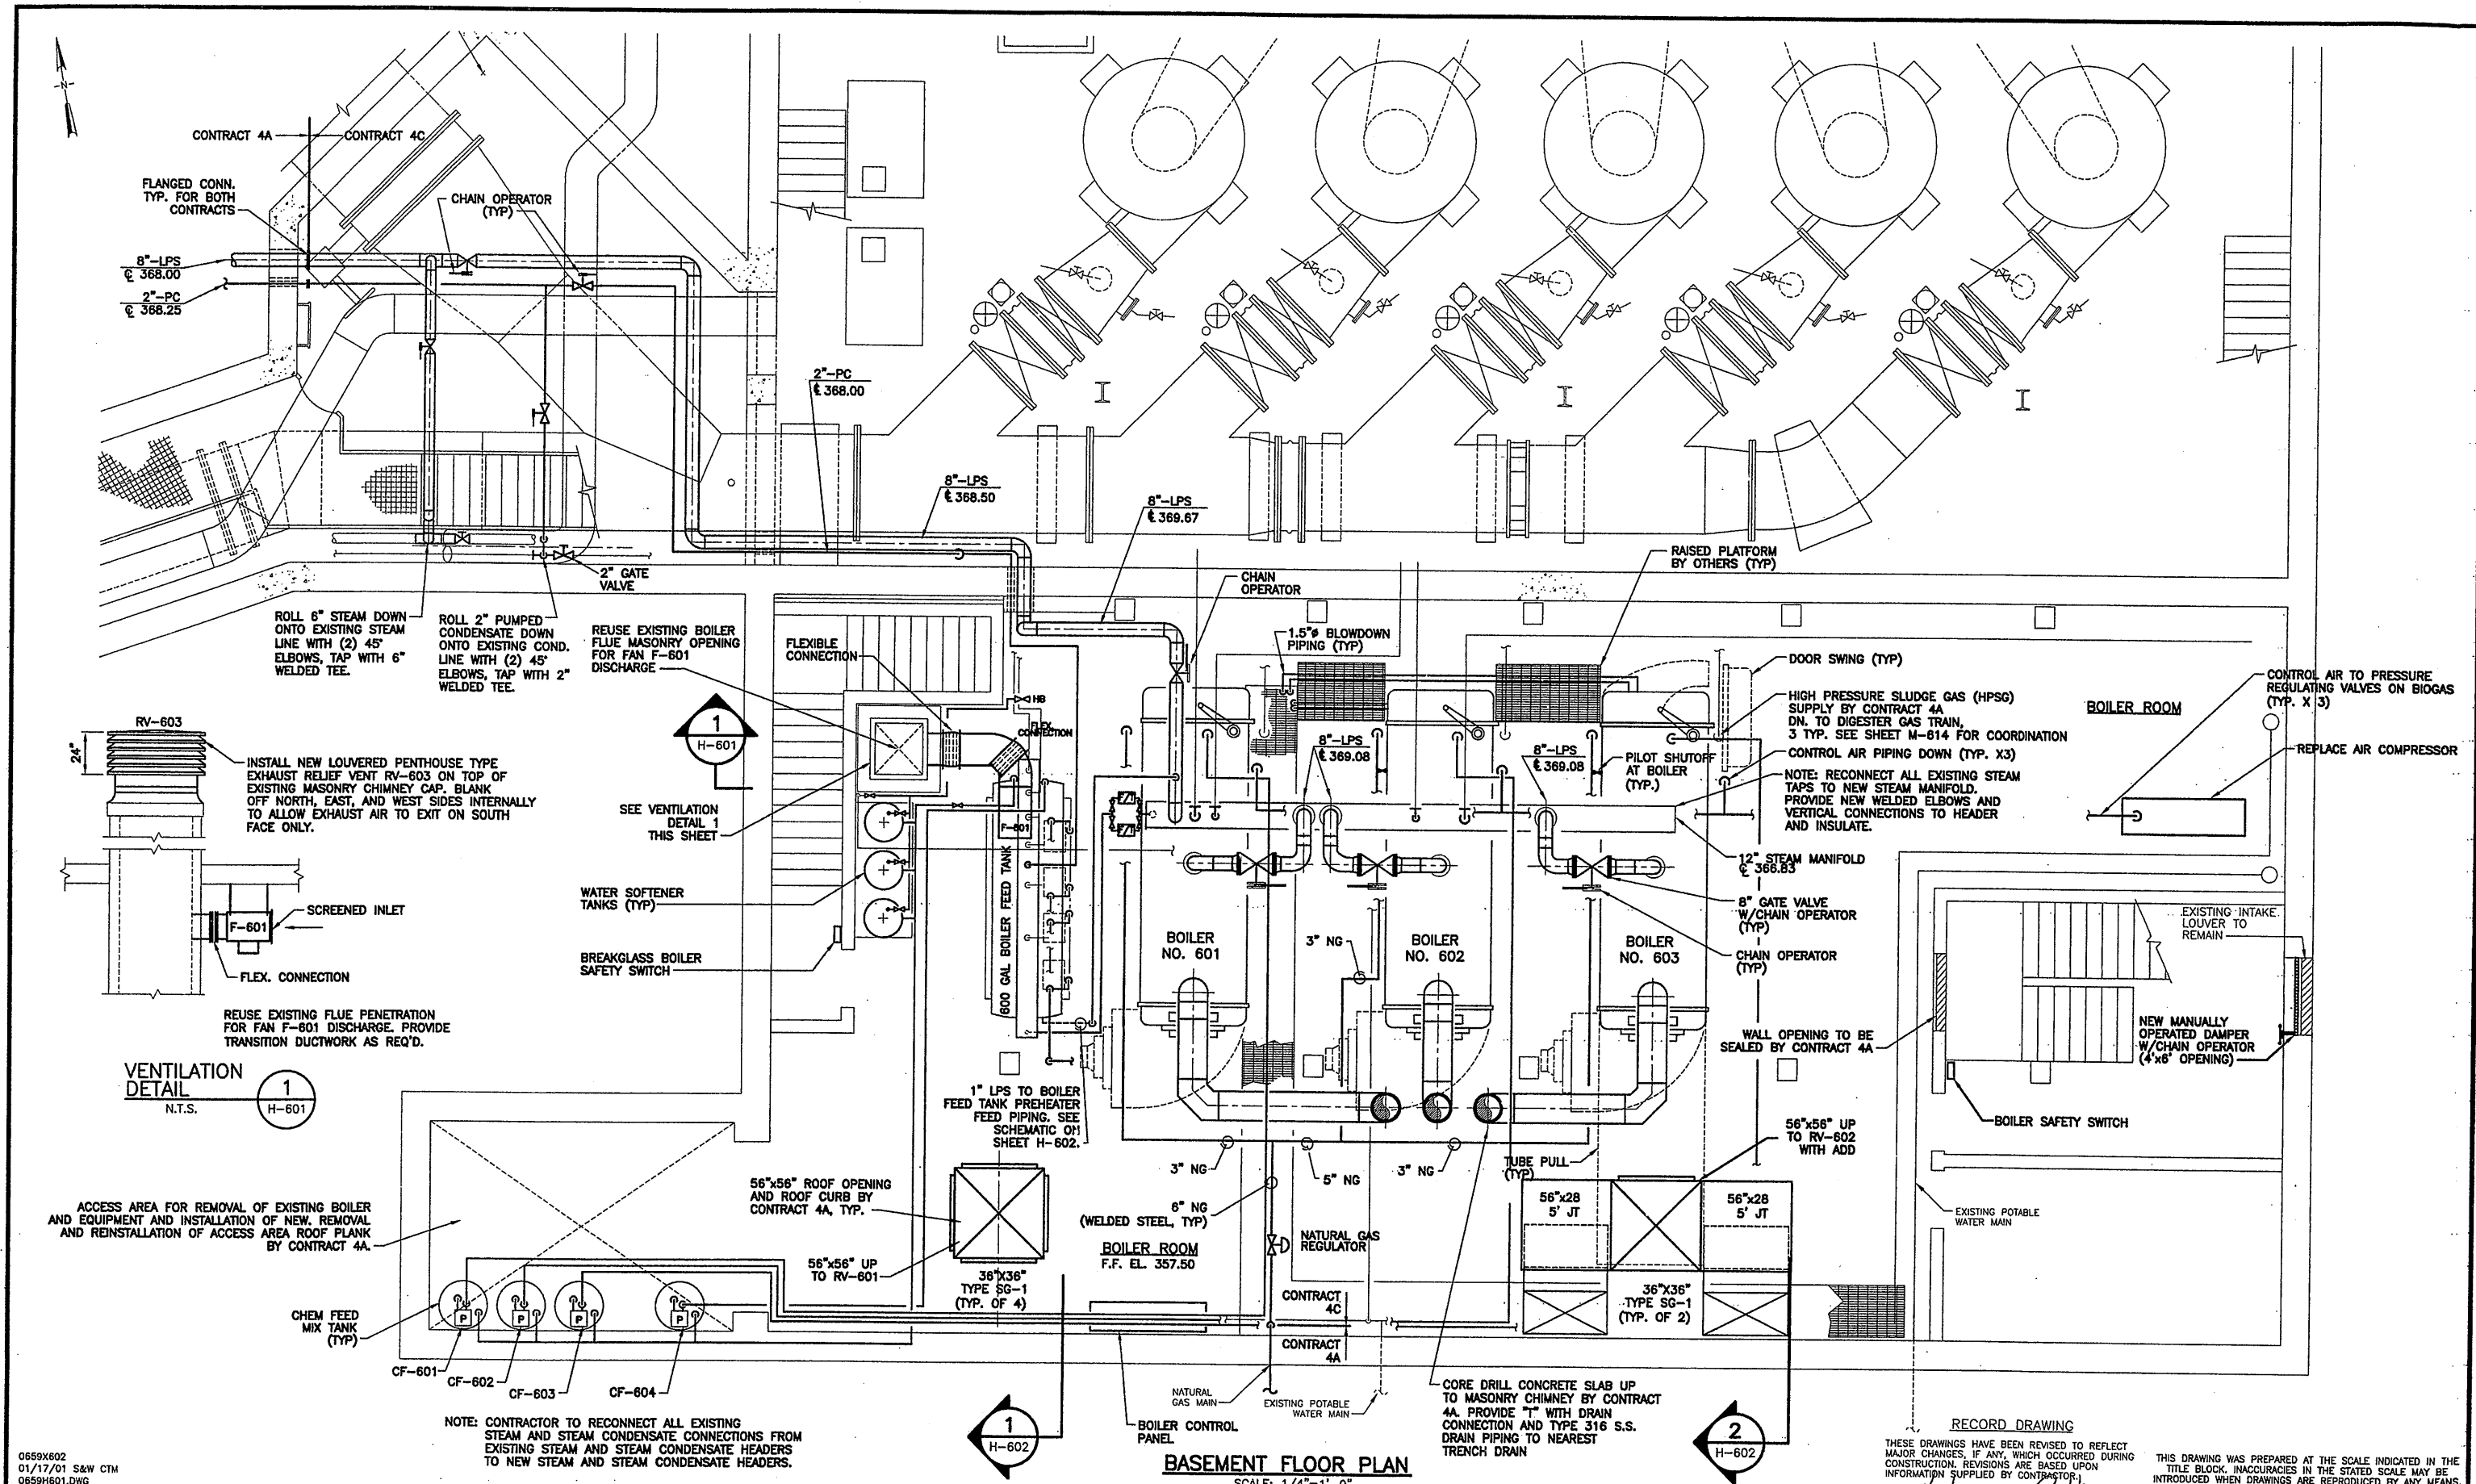

0659X602
01/17/01 S&W CTM
0659H601.DWG

NO ALTERATIONS PERMITTED HEREON EXCEPT AS PROVIDED UNDER SECTION 7209 SUBDIVISION 2 OF THE NEW YORK STATE EDUCATION LAW

| No. | Date | Revisions | Init |
|-----|----------|---------------------|------|
| 0 | 4/20/01 | ISSUED FOR APPROVAL | |
| 1 | | AS BID | |
| 2 | 11/30/05 | RECORD DRAWING | RCG |

In charge of DBP
Designed by DBP
Drawn by CTM/CMS/JRH
Checked by DBP


ENVIRONMENTAL ENGINEERING ASSOCIATES, LLP
SYRACUSE, NEW YORK

ONONDAGA COUNTY • DEPARTMENT OF DRAINAGE AND SANITATION • SYRACUSE, NEW YORK
METROPOLITAN SYRACUSE WASTEWATER TREATMENT PLANT
STAGE III AMMONIA AND STAGE II PHOSPHORUS REMOVAL PROJECT
LOW LIFT PUMP STATION
BASEMENT FLOOR PLAN




RECORD DRAWING
THESE DRAWINGS HAVE BEEN REVISED TO REFLECT MAJOR CHANGES, IF ANY, WHICH OCCURRED DURING CONSTRUCTION. REVISIONS ARE BASED UPON INFORMATION SUPPLIED BY CONTRACTOR.
DATE: 1/23/05 PER: GCH

THIS DRAWING WAS PREPARED AT THE SCALE INDICATED IN THE TITLE BLOCK. INACCURACIES IN THE STATED SCALE MAY BE INTRODUCED WHEN DRAWINGS ARE REPRODUCED BY ANY MEANS. USE THE GRAPHIC SCALE BAR IN THE TITLE BLOCK TO DETERMINE THE ACTUAL SCALE OF THIS DRAWING.


File Number: 00659
Date: APRIL 2001
H-601

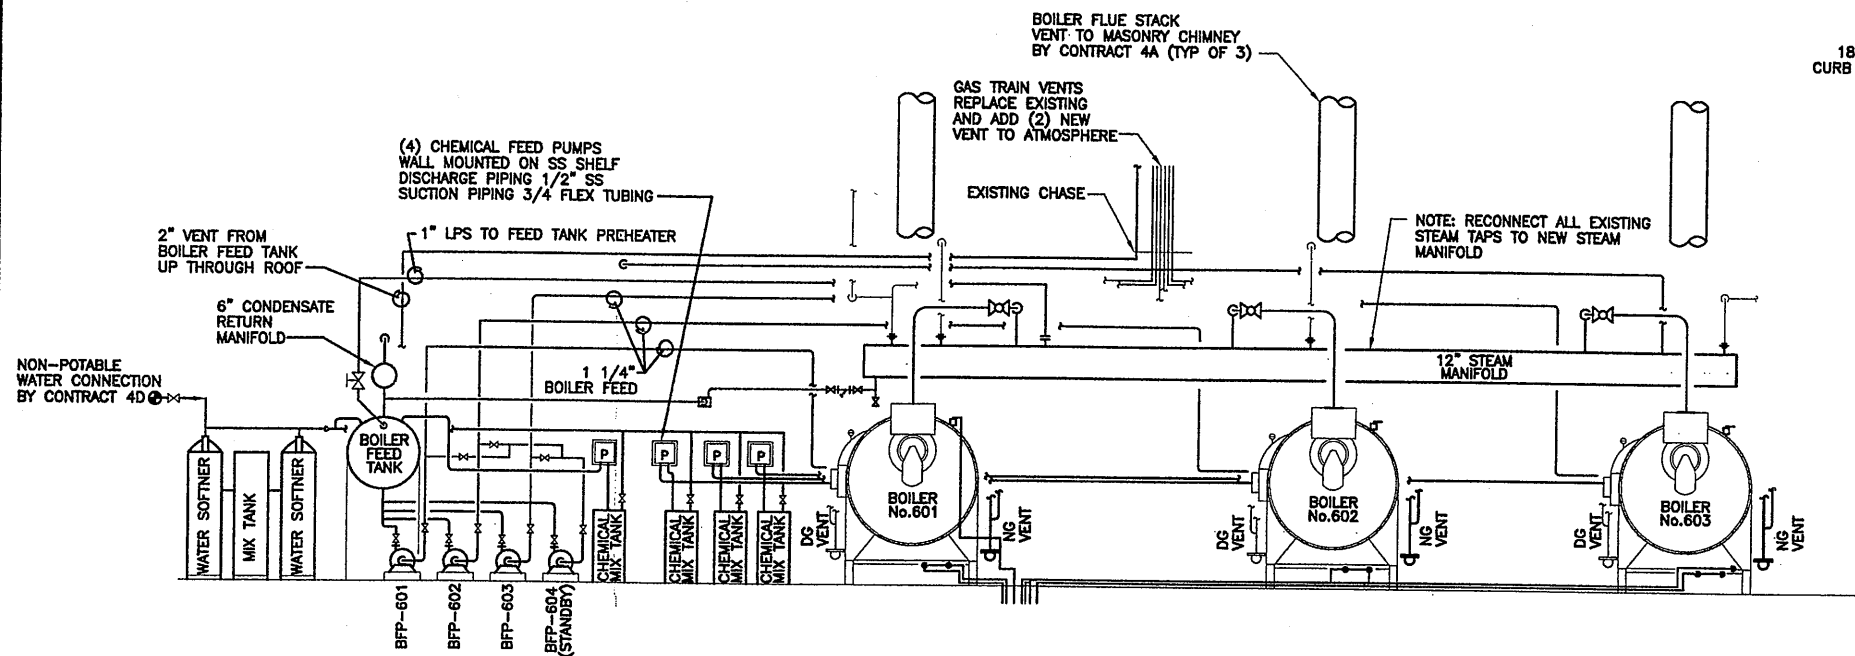


BOILER PROCESS DIAGRAM
SCALE: 1/4"=1'-0"

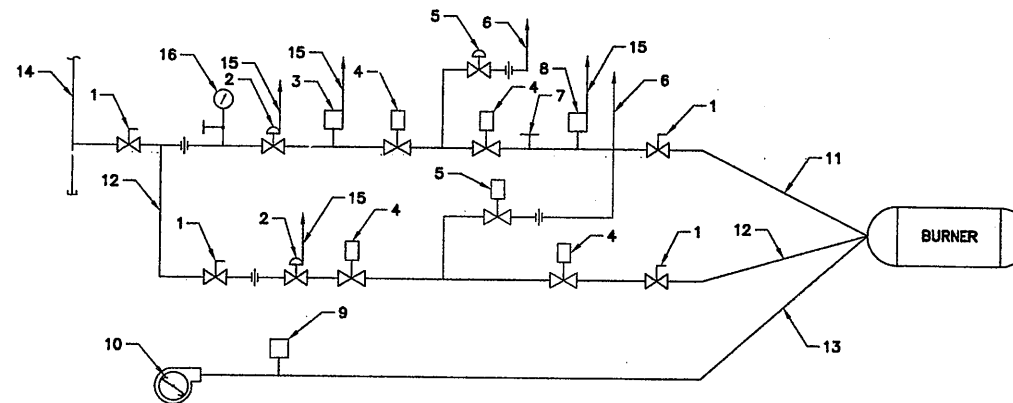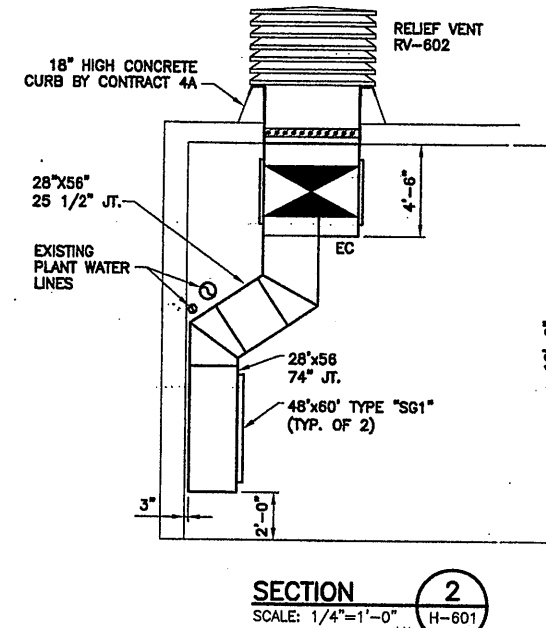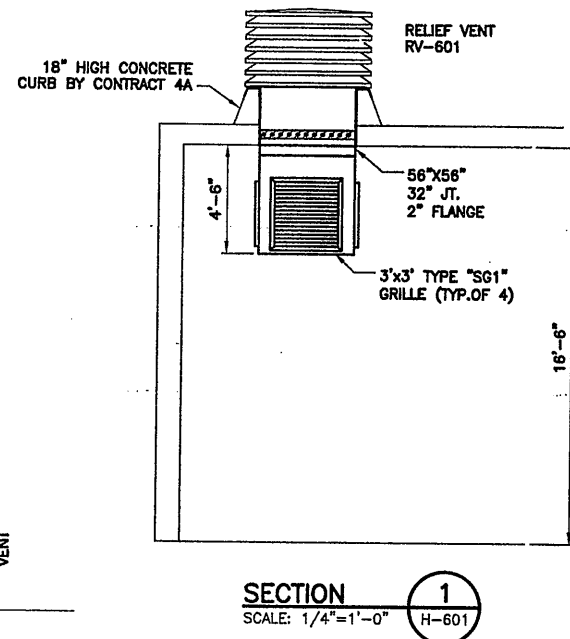

- LEGEND**
- 1 GAS COCK
 - 2 PRESSURE REGULATOR
 - 3 LOW GAS PRESSURE SWITCH
 - 4 SAFETY SHUTOFF VALVE
 - 5 NORMALLY OPEN VENT VALVE
 - 6 VENT TO OUTSIDE
 - 7 TEST CONNECTION
 - 8 HIGH GAS PRESSURE SWITCH
 - 9 COMBUSTION AIR PRESSURE SWITCH
 - 10 COMBUSTION AIR BLOWER
 - 11 MAIN GAS FUEL LINE
 - 12 PILOT GAS FUEL LINE (NATURAL GAS ONLY)
 - 13 COMBUSTION AIR
 - 14 GAS SUPPLY
 - 15 REGULATOR AND PRESSURE SWITCH VENTS
 - 16 PRESSURE GAUGE WITH COCK (INCHES OF W.C.)

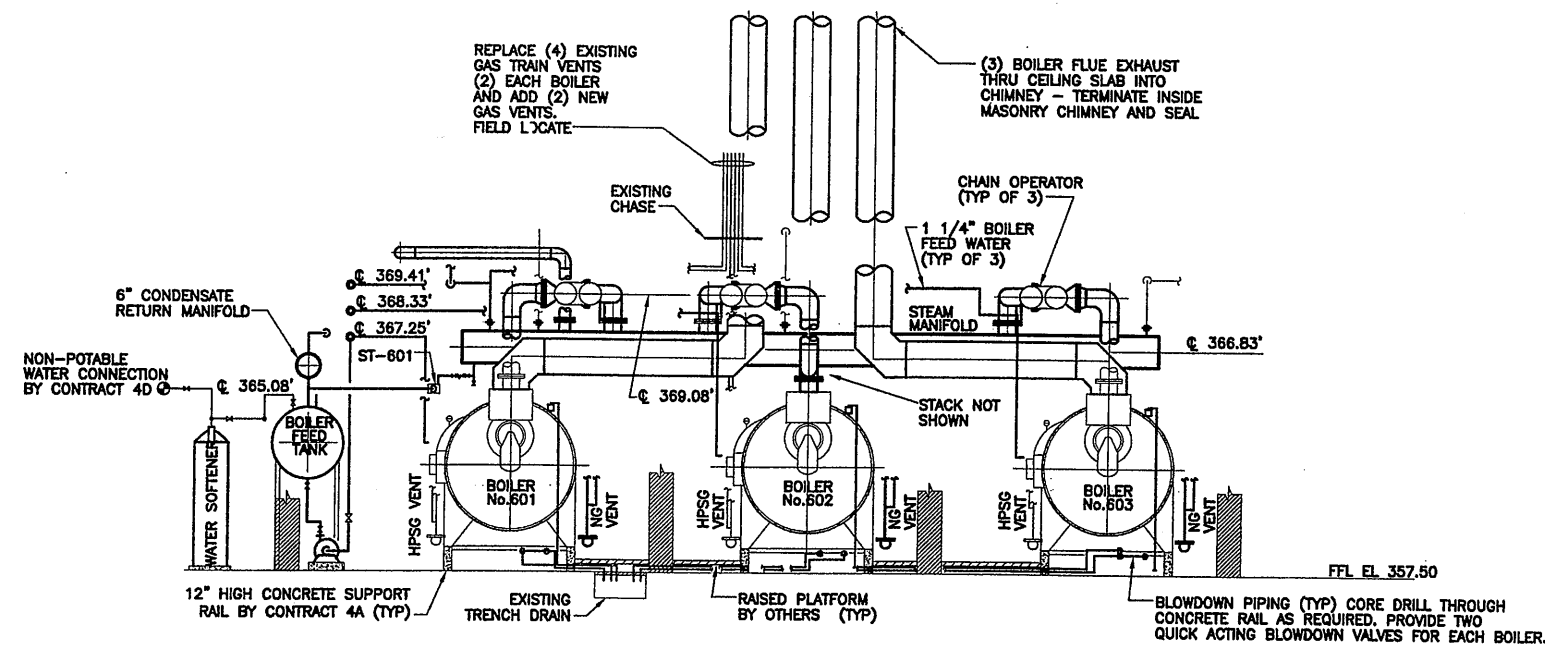

ELEVATION LOOKING NORTH - BOILERS STEAM MANIFOLD
SCALE: 1/4"=1'-0"

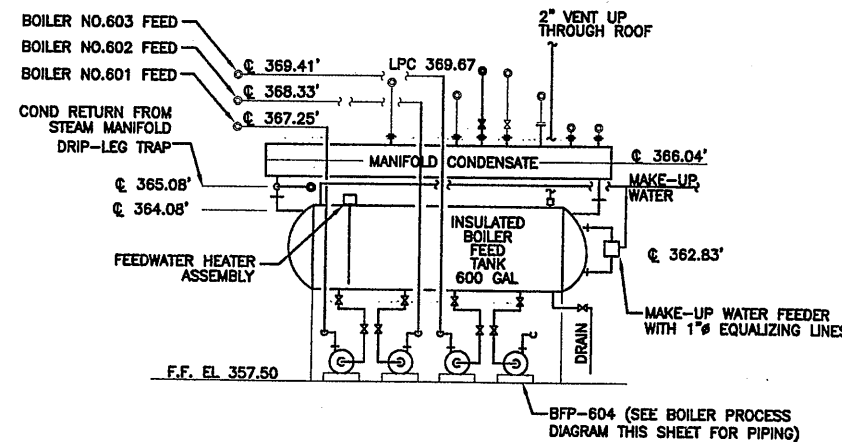

ELEVATION LOOKING WEST - BOILER FEED TANK
SCALE: 1/4"=1'-0"

0659X602
01/17/01 S&W CTM
CONTRACT 2-5\HVAC\0659H602.DWG

| No. | Date | Revisions | Init |
|-----|----------|----------------------------|------|
| 0 | 4/20/01 | ISSUED FOR APPROVAL AS BID | |
| 1 | | | |
| 2 | 11/30/08 | RECORD DRAWING | RCG |

In charge of DBP
Designed by DBP
Drawn by CMS/JRH
Checked by DBP

ENVIRONMENTAL ENGINEERING ASSOCIATES, LLP
SYRACUSE, NEW YORK


ONONDAGA COUNTY • DEPARTMENT OF DRAINAGE AND SANITATION • SYRACUSE, NEW YORK
METROPOLITAN SYRACUSE WASTEWATER TREATMENT PLANT
STAGE III AMMONIA AND STAGE II PHOSPHORUS REMOVAL PROJECT
LOW LIFT PUMP STATION
ELEVATIONS, SCHEMATICS AND DETAILS



RECORD DRAWING
THESE DRAWINGS HAVE BEEN REVISED TO REFLECT MAJOR CHANGES, IF ANY, WHICH OCCURRED DURING CONSTRUCTION. REVISIONS ARE BASED UPON INFORMATION SUPPLIED BY CONTRACTOR.
DATE: 11/23/08 PER: JCH


File Number: 00659
Date: APRIL 2001
H-602

NO ALTERATIONS PERMITTED HEREON EXCEPT AS PROVIDED UNDER SECTION 7209 SUBDIVISION 2 OF THE NEW YORK STATE EDUCATION LAW

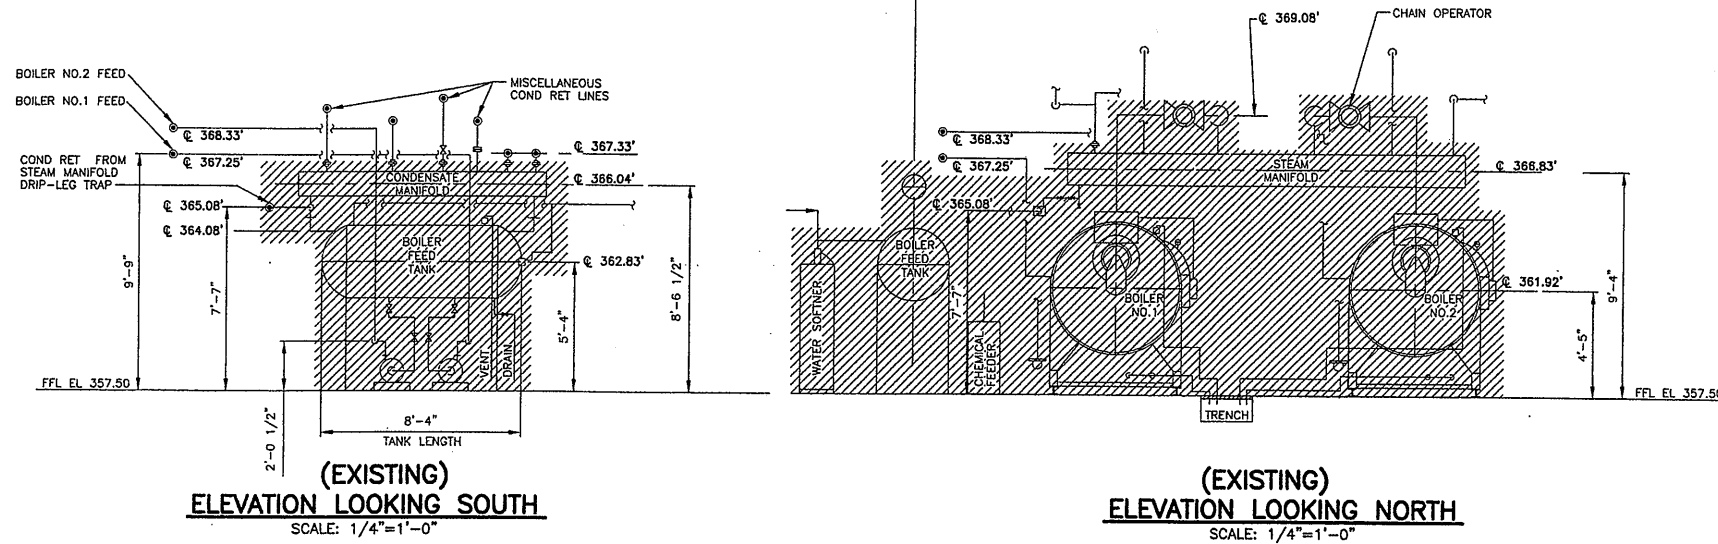

NOTE: CONTRACTOR TO RECONNECT ALL EXISTING STEAM AND STEAM CONDENSATE CONNECTIONS FROM EXISTING STEAM AND STEAM CONDENSATE HEADERS TO NEW STEAM AND STEAM CONDENSATE HEADERS.

LEGEND
 INDICATES EQUIPMENT TO BE DEMOLISHED

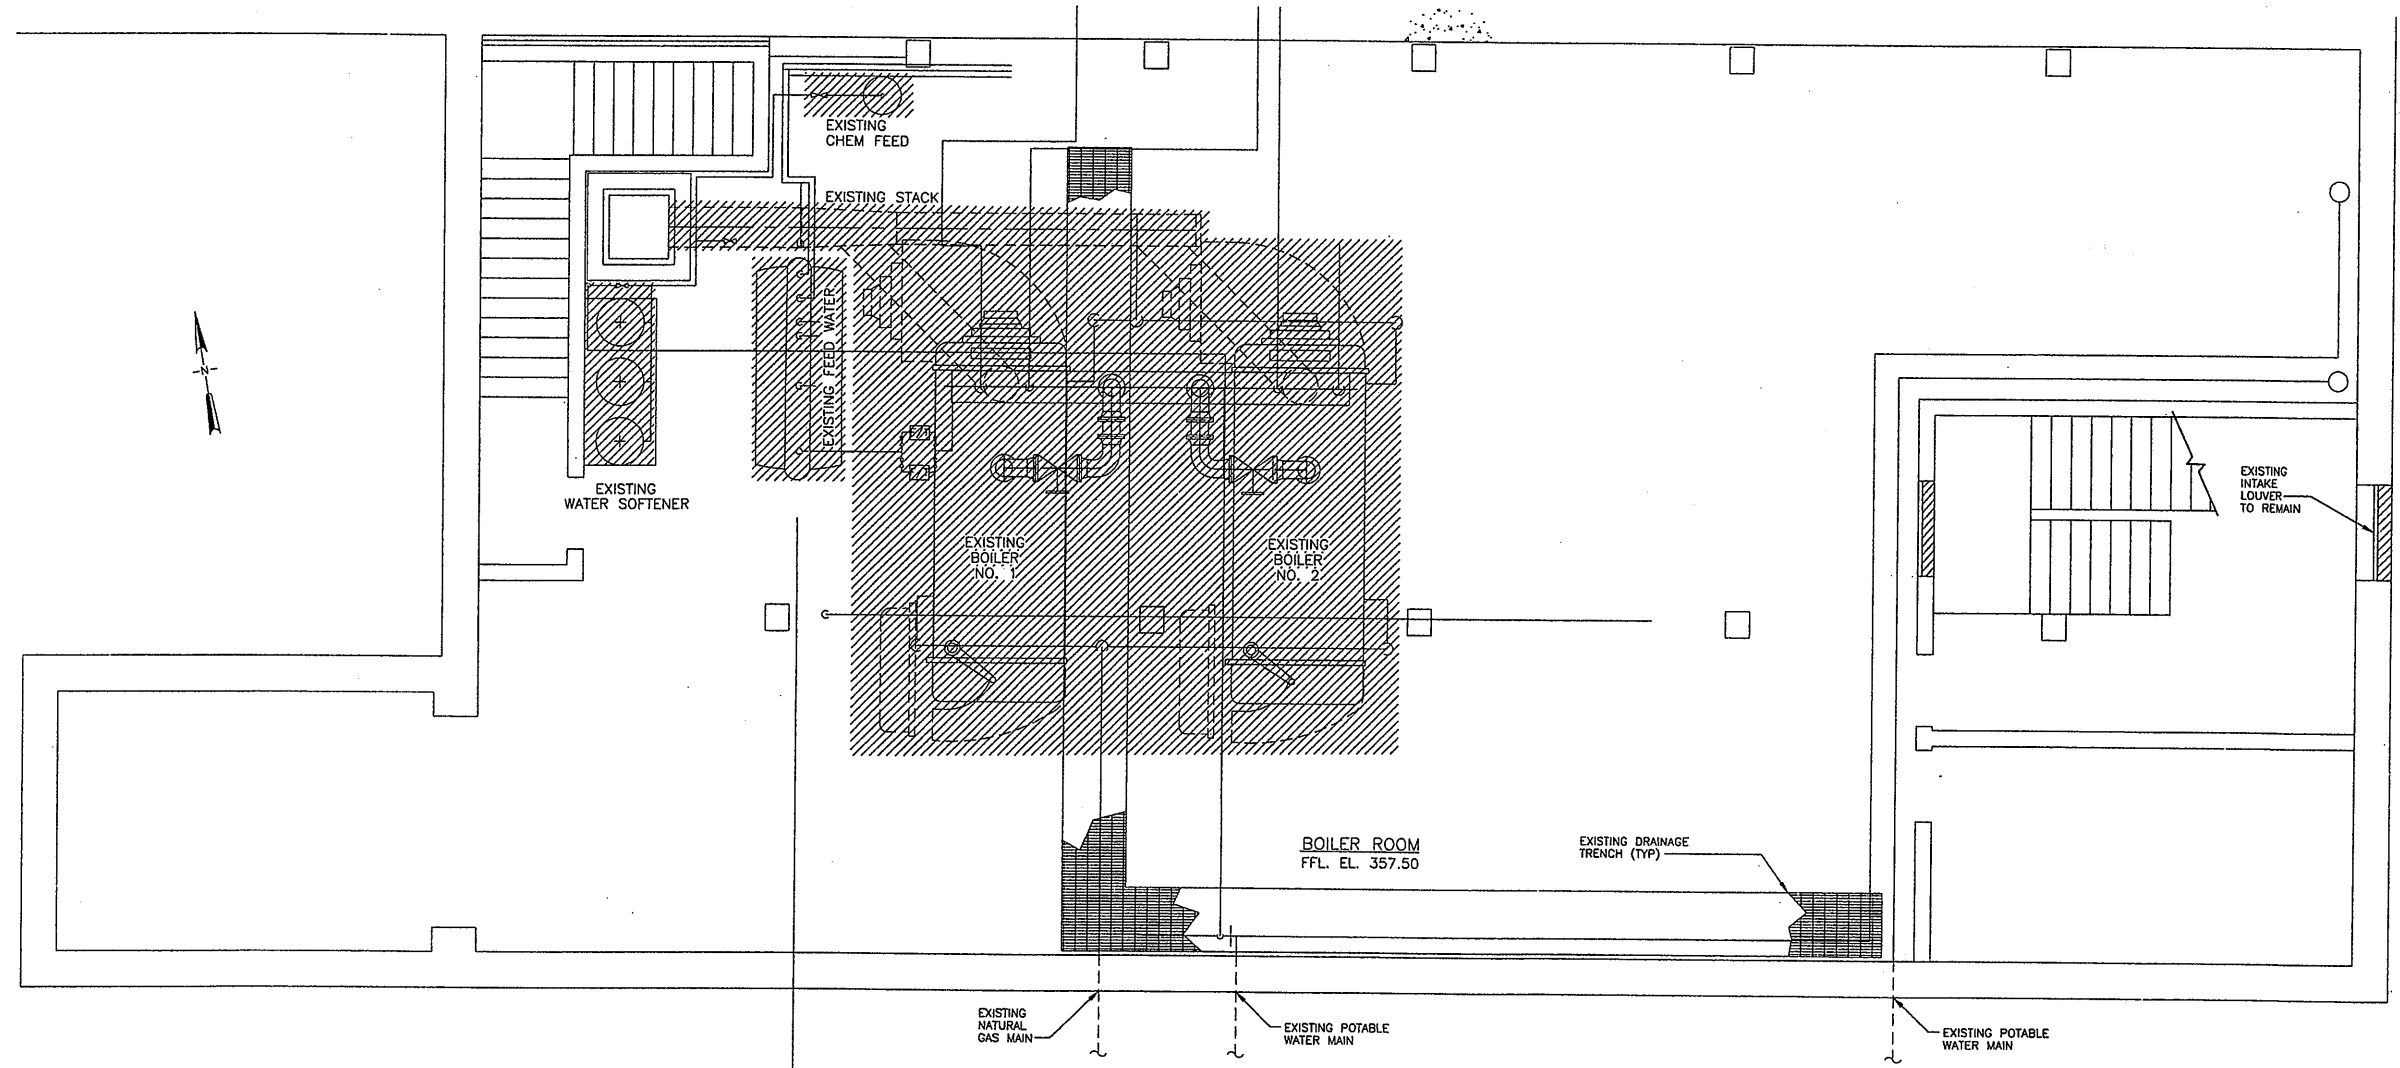

BASEMENT FLOOR PLAN - DEMOLITION
 SCALE: 1/4"=1'-0"

RECORD DRAWING
 THESE DRAWINGS HAVE BEEN REVISED TO REFLECT MAJOR CHANGES, IF ANY, WHICH OCCURRED DURING CONSTRUCTION. REVISIONS ARE BASED UPON INFORMATION SUPPLIED BY CONTRACTOR.
 DATE: 11/23/05 PER: GCH

THIS DRAWING WAS PREPARED AT THE SCALE INDICATED IN THE TITLE BLOCK. INACCURACIES IN THE STATED SCALE MAY BE INTRODUCED WHEN DRAWINGS ARE REPRODUCED BY ANY MEANS. USE THE GRAPHIC SCALE BAR IN THE TITLE BLOCK TO DETERMINE THE ACTUAL SCALE OF THIS DRAWING.

0659H602
 01/17/01 S&W CTH
 CONTRACT 2-5 HVAC\0659H601.DWG

NO ALTERATIONS PERMITTED HEREON EXCEPT AS PROVIDED UNDER SECTION 7209 SUBDIVISION 2 OF THE NEW YORK STATE EDUCATION LAW

| No. | Date | Revisions | Init |
|-----|----------|---------------------|------|
| 0 | 4/20/01 | ISSUED FOR APPROVAL | |
| 1 | | AS BID | |
| 2 | 11/30/05 | RECORD DRAWING | RCG |

In charge of - DBP
 Designed by - DBP
 Drawn by - CMS
 Checked by - DBP



ENVIRONMENTAL ENGINEERING ASSOCIATES, LLP
 SYRACUSE, NEW YORK

ONONDAGA COUNTY • DEPARTMENT OF DRAINAGE AND SANITATION • SYRACUSE, NEW YORK
 METROPOLITAN SYRACUSE WASTEWATER TREATMENT PLANT
 STAGE III AMMONIA AND STAGE II PHOSPHORUS REMOVAL PROJECT
LOW LIFT PUMP STATION
BASEMENT DEMOLITION PLAN
 HVAC

STATE OF NEW YORK
 SEYMOUR C. ROCK
 LICENSED PROFESSIONAL ENGINEER
 No. 57604

File Number: 00659
 Date: APRIL 2001
 H-603

David C. Hord

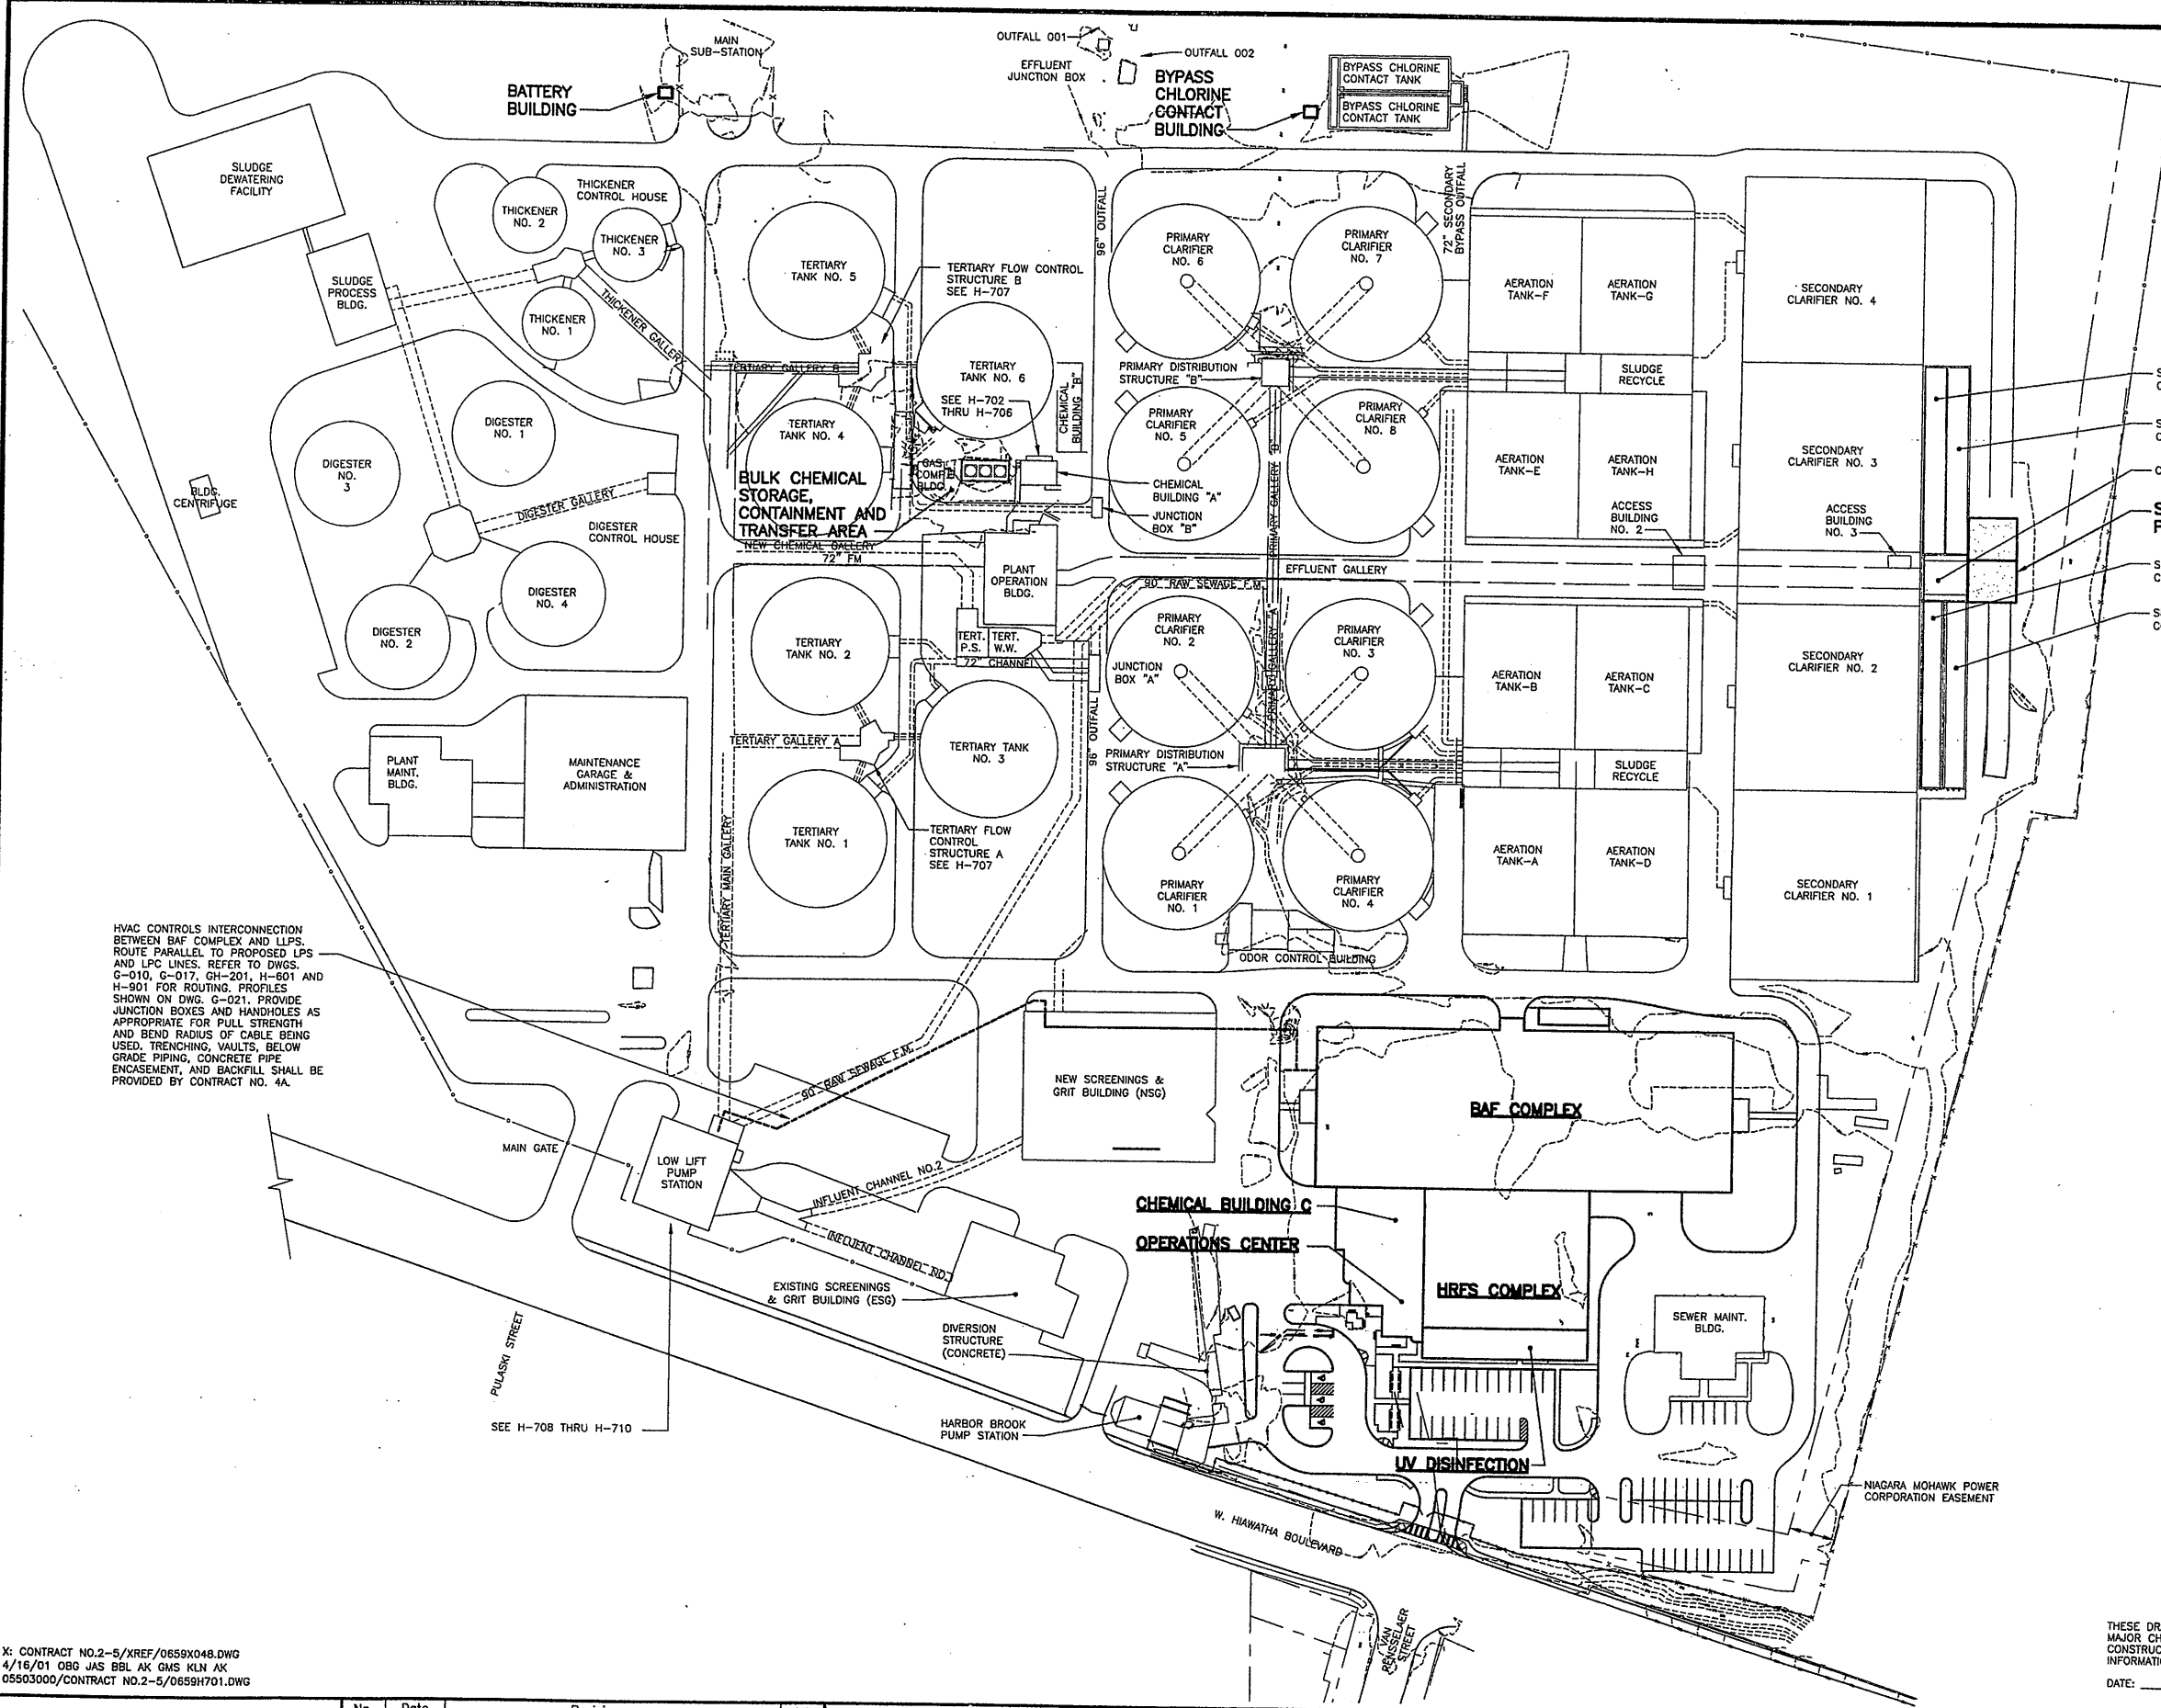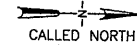

- SECONDARY CHLORINE CONTACT TANK #B3
- SECONDARY CHLORINE CONTACT TANK #B4
- COLLECTION CHAMBER
- SECONDARY EFFLUENT PUMPING STATION
- SECONDARY CHLORINE CONTACT TANK #A1
- SECONDARY CHLORINE CONTACT TANK #A2


HVAC CONTROLS INTERCONNECTION BETWEEN BAF COMPLEX AND LLPS. ROUTE PARALLEL TO PROPOSED LPS AND LPC LINES. REFER TO DWGS. G-010, G-017, GH-201, H-801 AND H-901 FOR ROUTING. PROFILES SHOWN ON DWG. G-021. PROVIDE JUNCTION BOXES AND HANDHOLES AS APPROPRIATE FOR PULL STRENGTH AND BEND RADIUS OF CABLE BEING USED. TRENCHING, VAULTS, BELOW GRADE PIPING, CONCRETE PIPE ENCASEMENT, AND BACKFILL SHALL BE PROVIDED BY CONTRACT NO. 4A.

RECORD DRAWING

THESE DRAWINGS HAVE BEEN REVISED TO REFLECT MAJOR CHANGES, IF ANY, WHICH OCCURRED DURING CONSTRUCTION. REVISIONS ARE BASED UPON INFORMATION SUPPLIED BY CONTRACTOR.
DATE: _____ PER: _____

THIS DRAWING WAS PREPARED AT THE SCALE INDICATED IN THE TITLE BLOCK. INACCURACIES IN THE STATED SCALE MAY BE INTRODUCED WHEN DRAWINGS ARE REPRODUCED BY ANY MEANS. USE THE GRAPHIC SCALE BAR IN THE TITLE BLOCK TO DETERMINE THE ACTUAL SCALE OF THIS DRAWING.

X: CONTRACT NO.2-5/XREF/0659X048.DWG
4/16/01 OBG JAS BBL AK GMS KLN AK
05503000/CONTRACT NO.2-5/0659H701.DWG

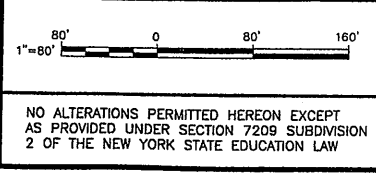

| No. | Date | Revisions | Init |
|-----|---------|----------------|------|
| 0 | | AS-BID | |
| 1 | 1/30/08 | RECORD DRAWING | RCG |

In charge of DPB
Designed by SWM
Drawn by KJL
Checked by SWM




ONONDAGA COUNTY • DEPARTMENT OF DRAINAGE AND SANITATION • SYRACUSE, NEW YORK
METROPOLITAN SYRACUSE WASTEWATER TREATMENT PLANT
STAGE III AMMONIA AND STAGE II PHOSPHORUS REMOVAL PROJECT

**GALLERIES VENTILATION
PLANT OPERATIONS BUILDING
PROPOSED SITE PLAN**


HVAC



File Number
00659
Date
APRIL 2001
W. J. [Signature]
H-701

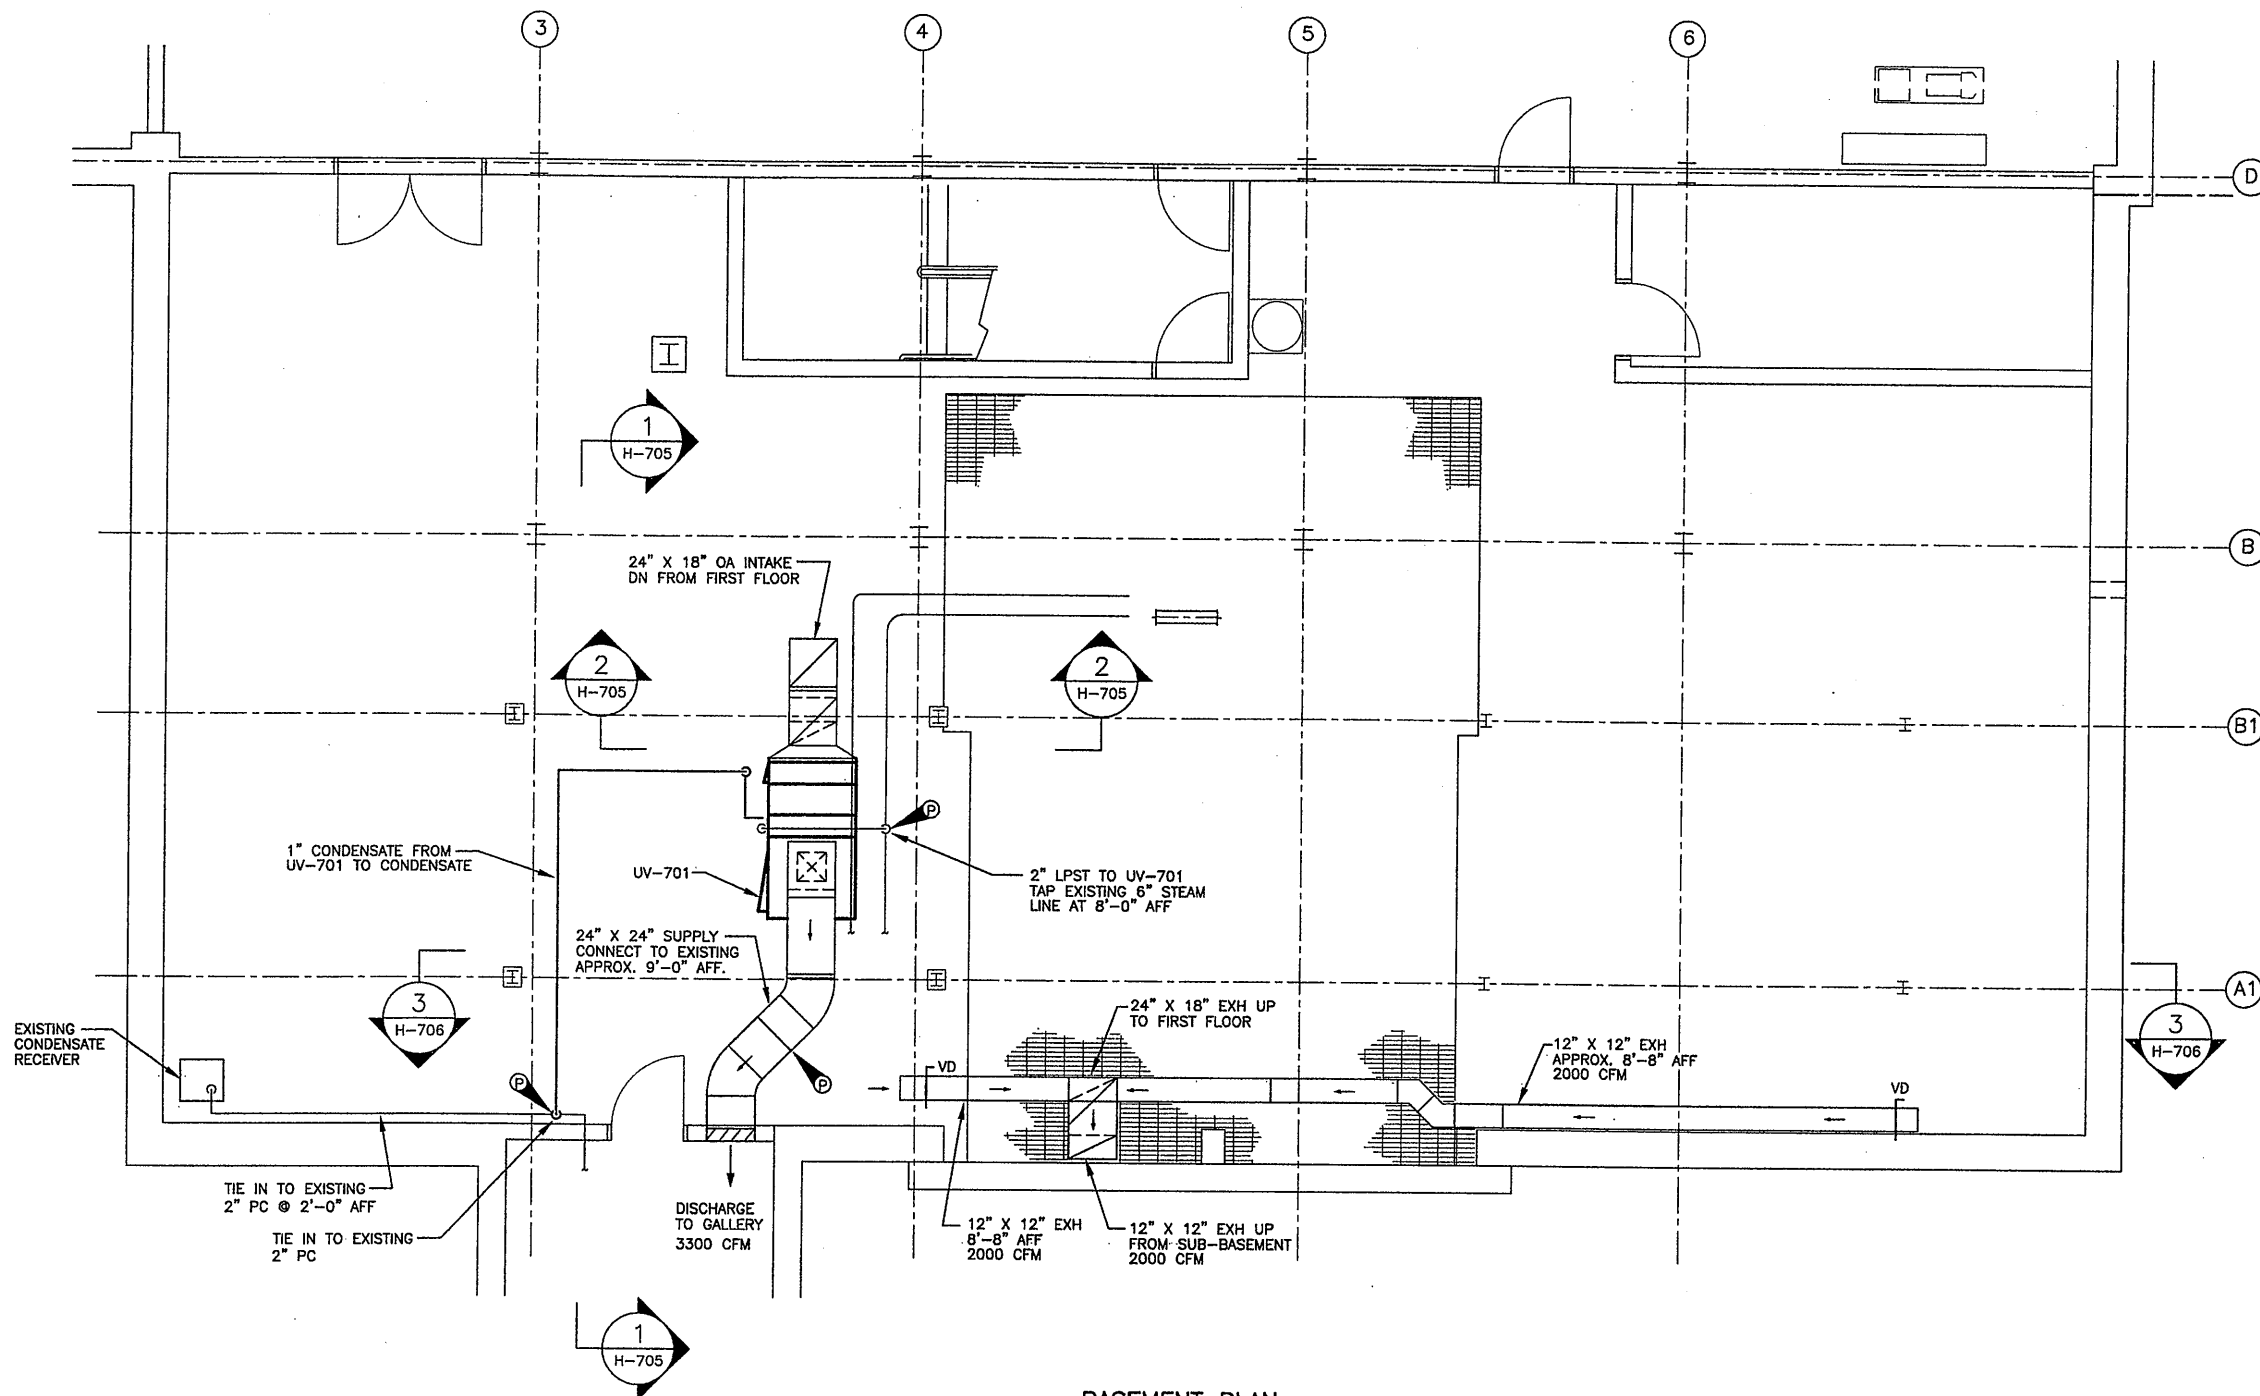

BASEMENT PLAN
1/4"=1'-0"

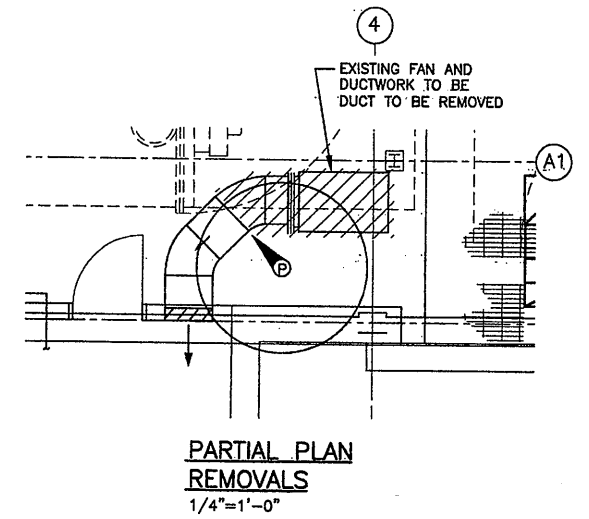


RECORD DRAWING

THESE DRAWINGS HAVE BEEN REVISED TO REFLECT MAJOR CHANGES, IF ANY, WHICH OCCURRED DURING CONSTRUCTION. REVISIONS ARE BASED UPON INFORMATION SUPPLIED BY CONTRACTOR.

THIS DRAWING WAS PREPARED AT THE SCALE INDICATED IN THE TITLE BLOCK. INACCURACIES IN THE STATED SCALE MAY BE INTRODUCED WHEN DRAWINGS ARE REPRODUCED BY ANY MEANS. USE THE GRAPHIC SCALE BAR IN THE TITLE BLOCK TO DETERMINE THE ACTUAL SCALE OF THIS DRAWING.

02/13/01 OBG KJL
00659H702

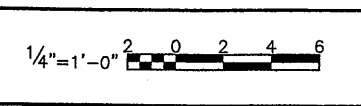

| No. | Date | Revisions | Init |
|-----|---------|---------------------|------|
| 0 | 4/20/01 | ISSUED FOR APPROVAL | |
| 1 | | AS-BID | |
| 2 | 1/30/03 | RECORD DRAWING | RCG |

In charge of DPB
Designed by SWM
Drawn by KJL
Checked by SWM




ONONDAGA COUNTY • DEPARTMENT OF DRAINAGE AND SANITATION • SYRACUSE, NEW YORK
METROPOLITAN SYRACUSE WASTEWATER TREATMENT PLANT
STAGE III AMMONIA AND STAGE II PHOSPHORUS REMOVAL PROJECT
**GALLERIES VENTILATION
PLANT OPERATIONS BUILDING
BASEMENT PLAN**
HVAC



File Number
00659
Date
APRIL 2001

H-702

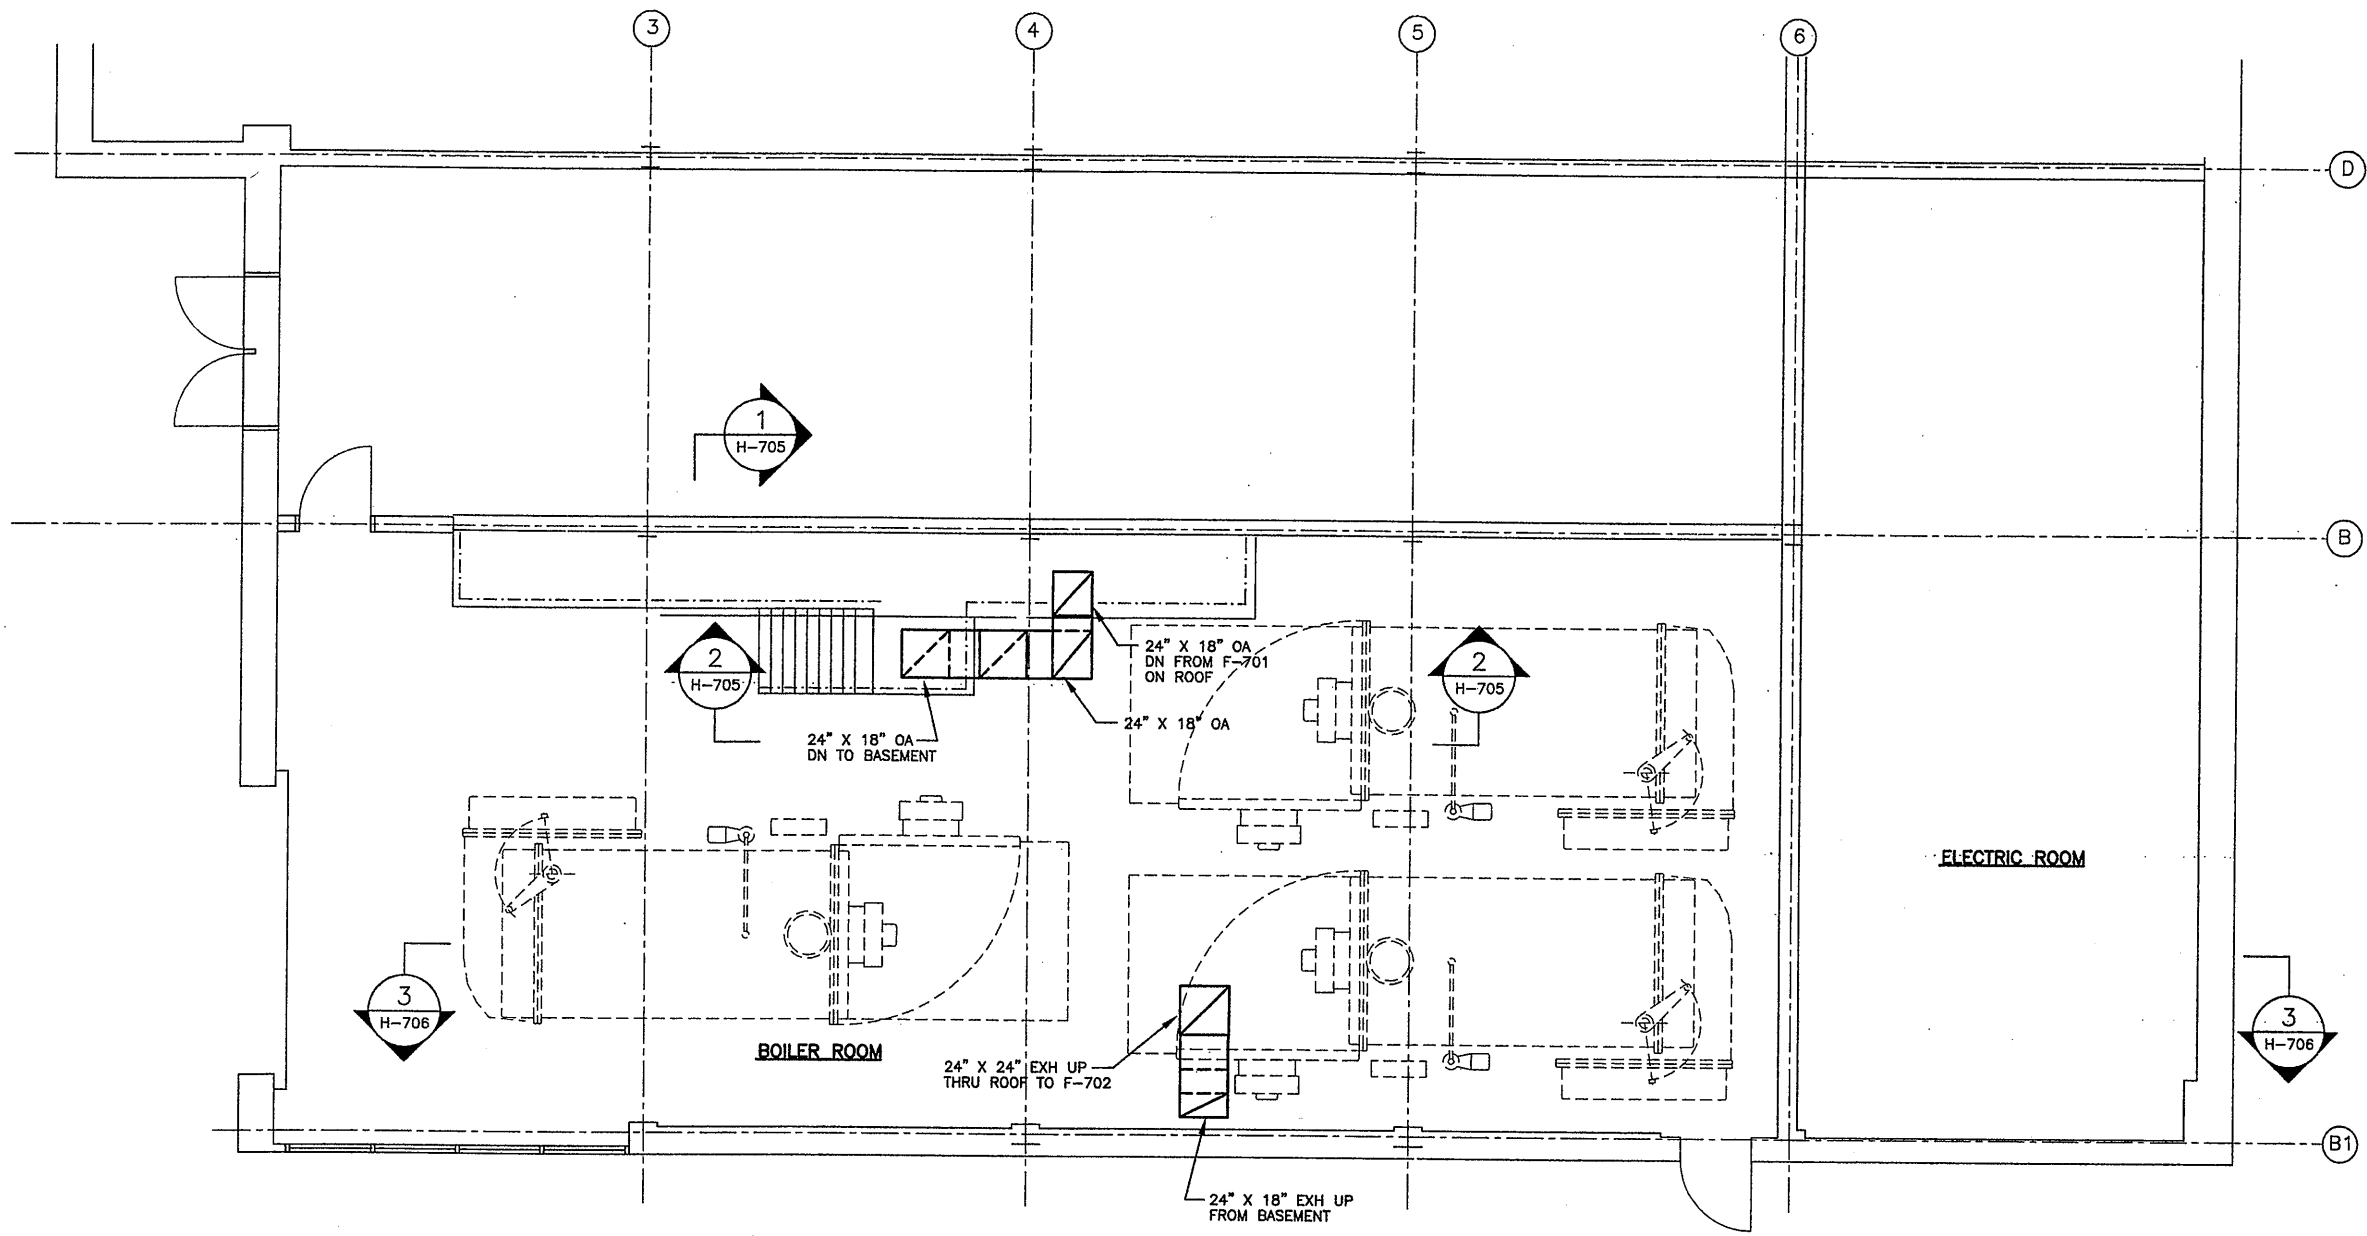


FIRST FLOOR PLAN
1/4"=1'-0"

RECORD DRAWING

THESE DRAWINGS HAVE BEEN REVISED TO REFLECT MAJOR CHANGES, IF ANY, WHICH OCCURRED DURING CONSTRUCTION. REVISIONS ARE BASED UPON INFORMATION SUPPLIED BY CONTRACTOR.

THIS DRAWING WAS PREPARED AT THE SCALE INDICATED IN THE TITLE BLOCK. INACCURACIES IN THE STATED SCALE MAY BE INTRODUCED WHEN DRAWINGS ARE REPRODUCED BY ANY MEANS. USE THE GRAPHIC SCALE BAR IN THE TITLE BLOCK TO DETERMINE THE ACTUAL SCALE OF THIS DRAWING.

02/13/01 OBG KJL
00659H703

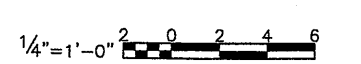

NO ALTERATIONS PERMITTED HEREON EXCEPT AS PROVIDED UNDER SECTION 7209 SUBDIVISION 2 OF THE NEW YORK STATE EDUCATION LAW

| No. | Date | Revisions | Init |
|-----|---------|---------------------|------|
| 0 | 4/20/01 | ISSUED FOR APPROVAL | |
| 1 | | AS-BID | |
| 2 | 1/30/05 | RECORD DRAWING | RCG |

In charge of DPB
Designed by SWM
Drawn by KJL
Checked by SWM



ONONDAGA COUNTY • DEPARTMENT OF DRAINAGE AND SANITATION • SYRACUSE, NEW YORK
METROPOLITAN SYRACUSE WASTEWATER TREATMENT PLANT
STAGE III AMMONIA AND STAGE II PHOSPHORUS REMOVAL PROJECT

**GALLERIES VENTILATION
PLANT OPERATIONS BUILDING
FIRST FLOOR PLAN**


HVAC



File Number
00659
Date
APRIL 2001

H-703

Wampole

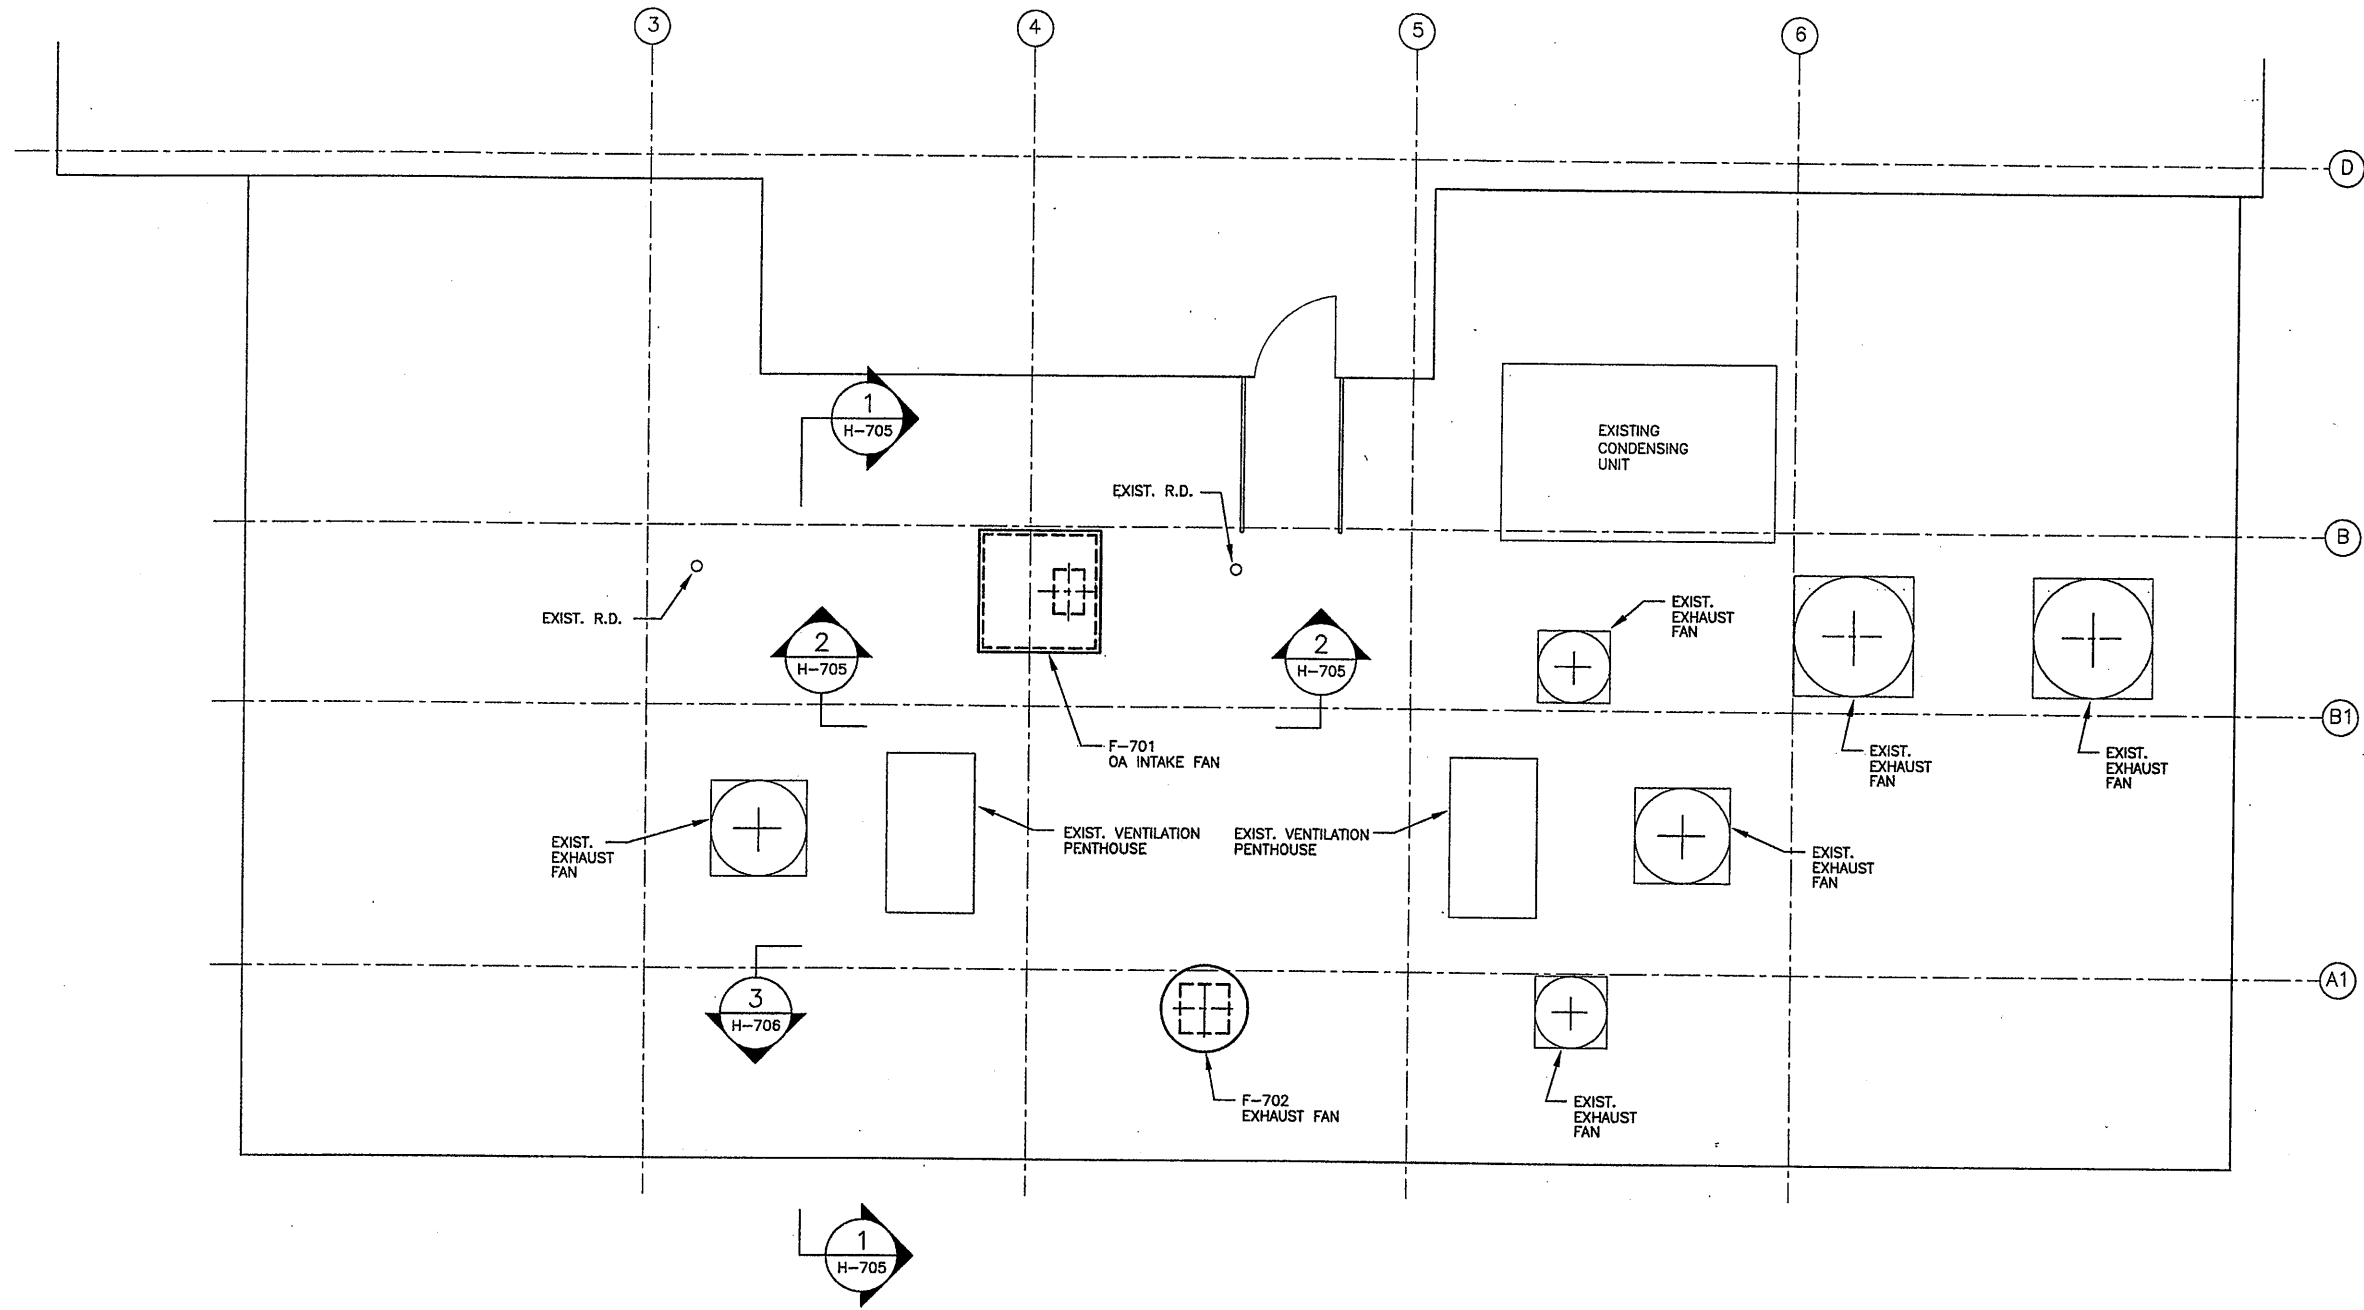

NOTES:
1. SEE ROOF CURB DETAIL DRAWING H-005 FOR FAN MOUNTING.


ROOF PLAN
1/4"=1'-0"

RECORD DRAWING

THESE DRAWINGS HAVE BEEN REVISED TO REFLECT MAJOR CHANGES, IF ANY, WHICH OCCURRED DURING CONSTRUCTION. REVISIONS ARE BASED UPON INFORMATION SUPPLIED BY CONTRACTOR.

THIS DRAWING WAS PREPARED AT THE SCALE INDICATED IN THE TITLE BLOCK. INACCURACIES IN THE STATED SCALE MAY BE INTRODUCED WHEN DRAWINGS ARE REPRODUCED BY ANY MEANS. USE THE GRAPHIC SCALE BAR IN THE TITLE BLOCK TO DETERMINE THE ACTUAL SCALE OF THIS DRAWING.

02/13/01 086 KJL
00659H704

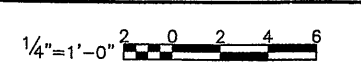

| No. | Date | Revisions | Init |
|-----|----------|---------------------|------|
| 0 | 4/20/01 | ISSUED FOR APPROVAL | |
| 1 | | AS-BID | |
| 2 | 11/30/05 | RECORD DRAWING | RCG |

In charge of DPB
Designed by SWM
Drawn by KJL
Checked by SWM




ONONDAGA COUNTY • DEPARTMENT OF DRAINAGE AND SANITATION • SYRACUSE, NEW YORK
METROPOLITAN SYRACUSE WASTEWATER TREATMENT PLANT
STAGE III AMMONIA AND STAGE II PHOSPHORUS REMOVAL PROJECT
GALLERIES VENTILATION
PLANT OPERATIONS BUILDING
ROOF PLAN
HVAC



File Number
00659
Date
APRIL 2001

H-704

L. Ruppel

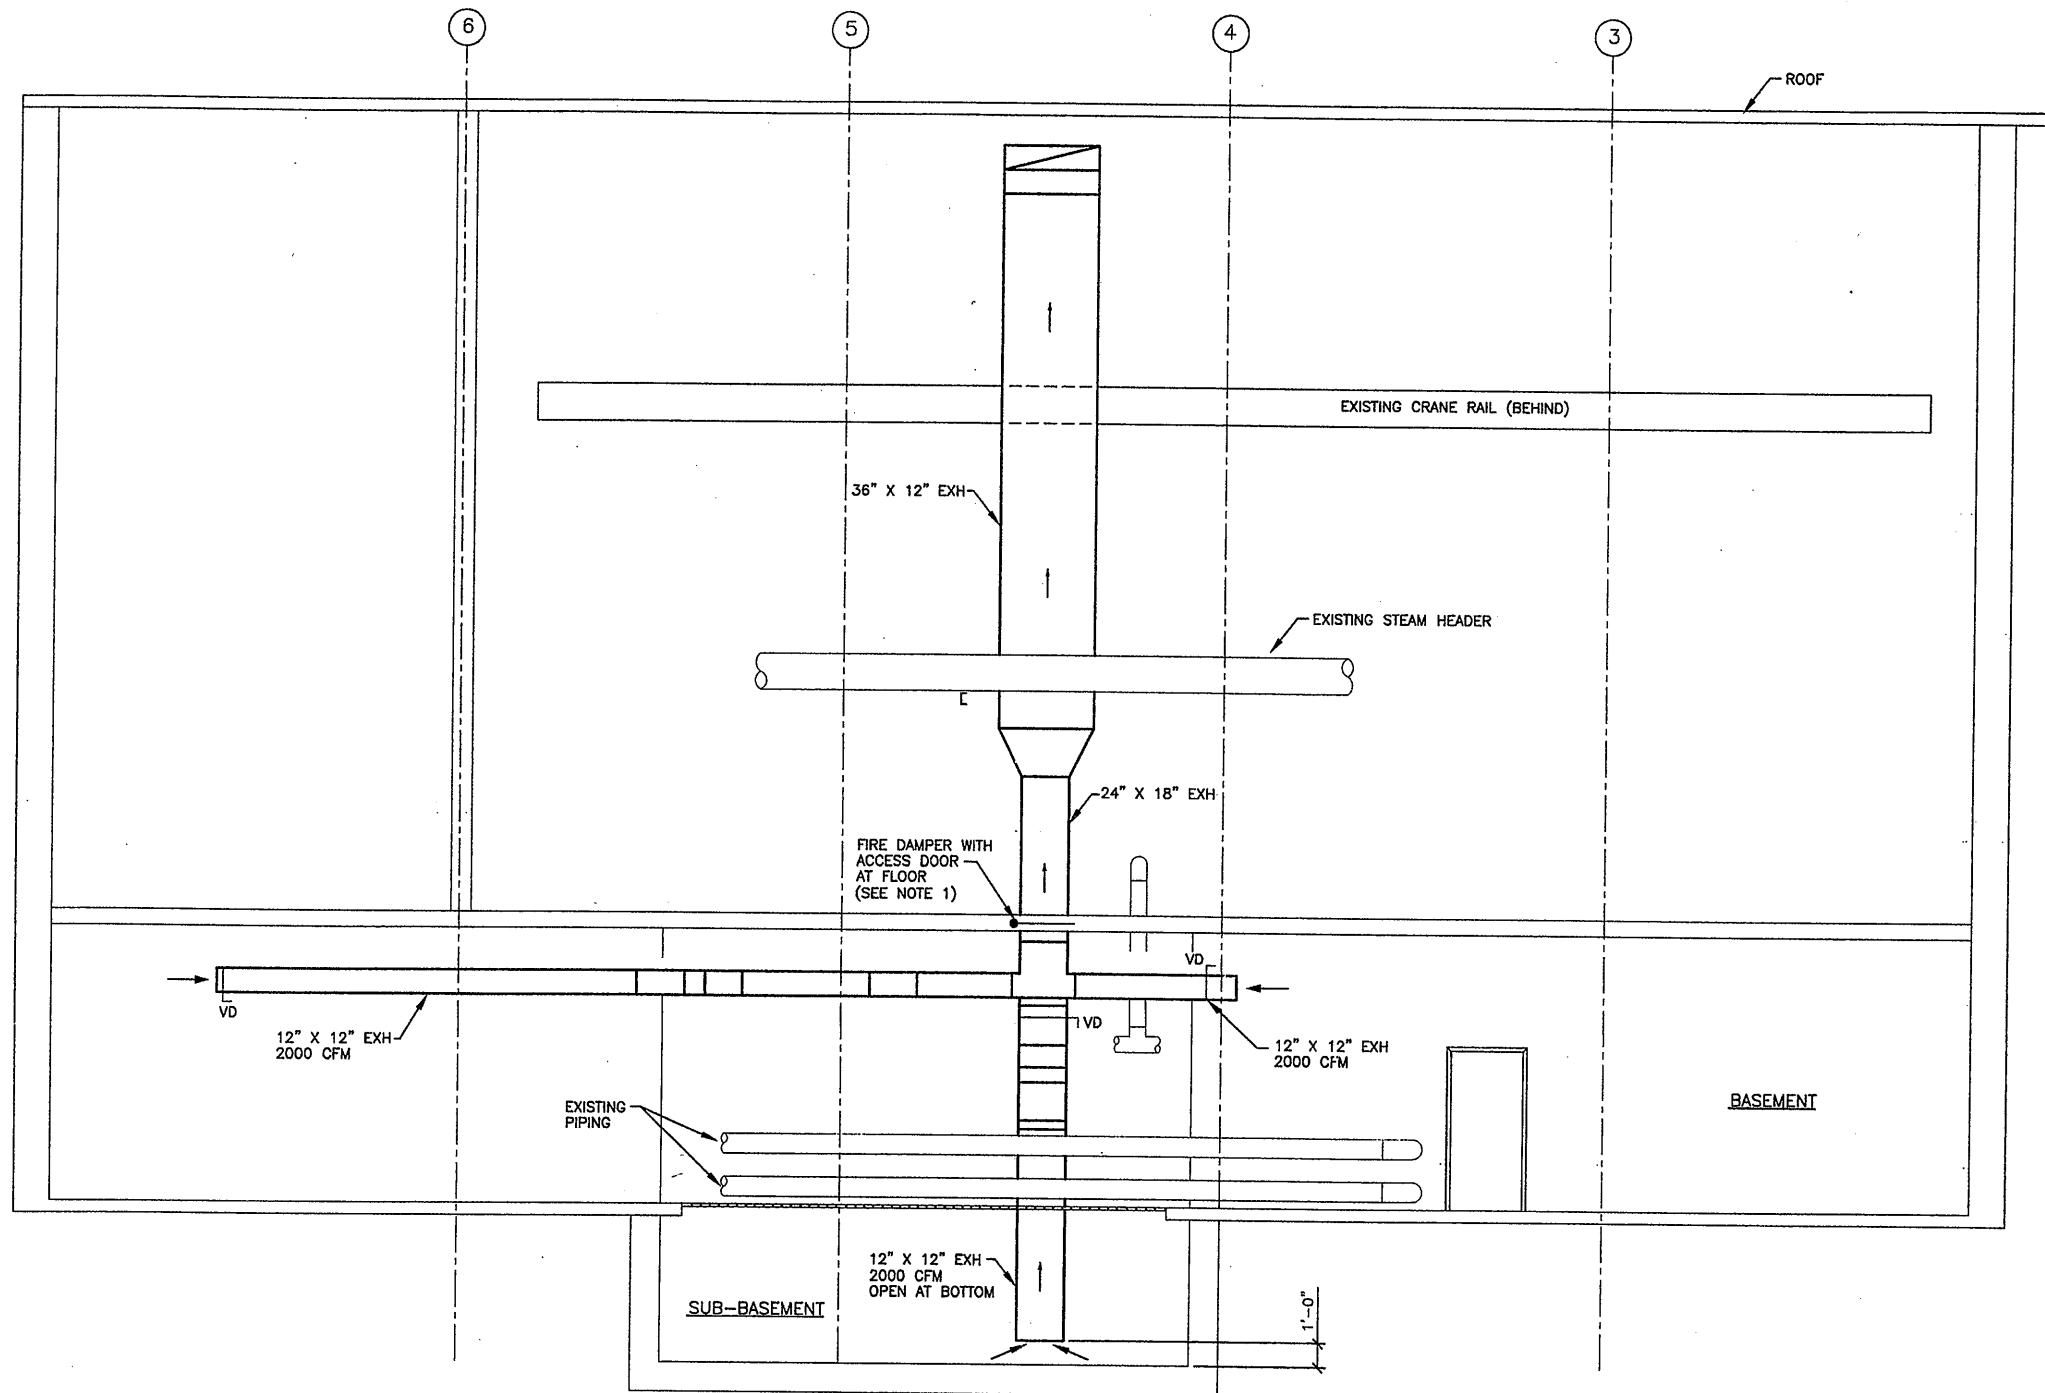

SECTION 3 3 3
1/4"=1'-0" H-702 H-703 H-704

NOTES:
1. COORDINATE FLOOR PENETRATION SIZE AND LOCATION WITH CONTRACT 4A.

RECORD DRAWING

THESE DRAWINGS HAVE BEEN REVISED TO REFLECT MAJOR CHANGES, IF ANY, WHICH OCCURRED DURING CONSTRUCTION. REVISIONS ARE BASED UPON INFORMATION SUPPLIED BY CONTRACTOR.

THIS DRAWING WAS PREPARED AT THE SCALE INDICATED IN THE TITLE BLOCK. INACCURACIES IN THE STATED SCALE MAY BE INTRODUCED WHEN DRAWINGS ARE REPRODUCED BY ANY MEANS. USE THE GRAPHIC SCALE BAR IN THE TITLE BLOCK TO DETERMINE THE ACTUAL SCALE OF THIS DRAWING.

DATE: _____ PER: _____

02/13/01 OBG JAS
00659H706

1/4"=1'-0"

| No. | Date | Revisions | Init |
|-----|----------|---------------------|------|
| 0 | 4/20/01 | ISSUED FOR APPROVAL | |
| 1 | | AS-BID | |
| 2 | 11/30/05 | RECORD DRAWING | RCG |

In charge of DPB
Designed by SWM
Drawn by KJL
Checked by SWM

ENVIRONMENTAL ENGINEERING ASSOCIATES, LLP
SYRACUSE, NEW YORK

ONONDAGA COUNTY • DEPARTMENT OF DRAINAGE AND SANITATION • SYRACUSE, NEW YORK
METROPOLITAN SYRACUSE WASTEWATER TREATMENT PLANT
STAGE III AMMONIA AND STAGE II PHOSPHORUS REMOVAL PROJECT
**GALLERIES VENTILATION
PLANT OPERATIONS BUILDING
SECTION**
HVAC




File Number
00659

Date
APRIL 2001

H-706


W. K. J. [Signature]

NO ALTERATIONS PERMITTED HEREON EXCEPT AS PROVIDED UNDER SECTION 7209 SUBDIVISION 2 OF THE NEW YORK STATE EDUCATION LAW

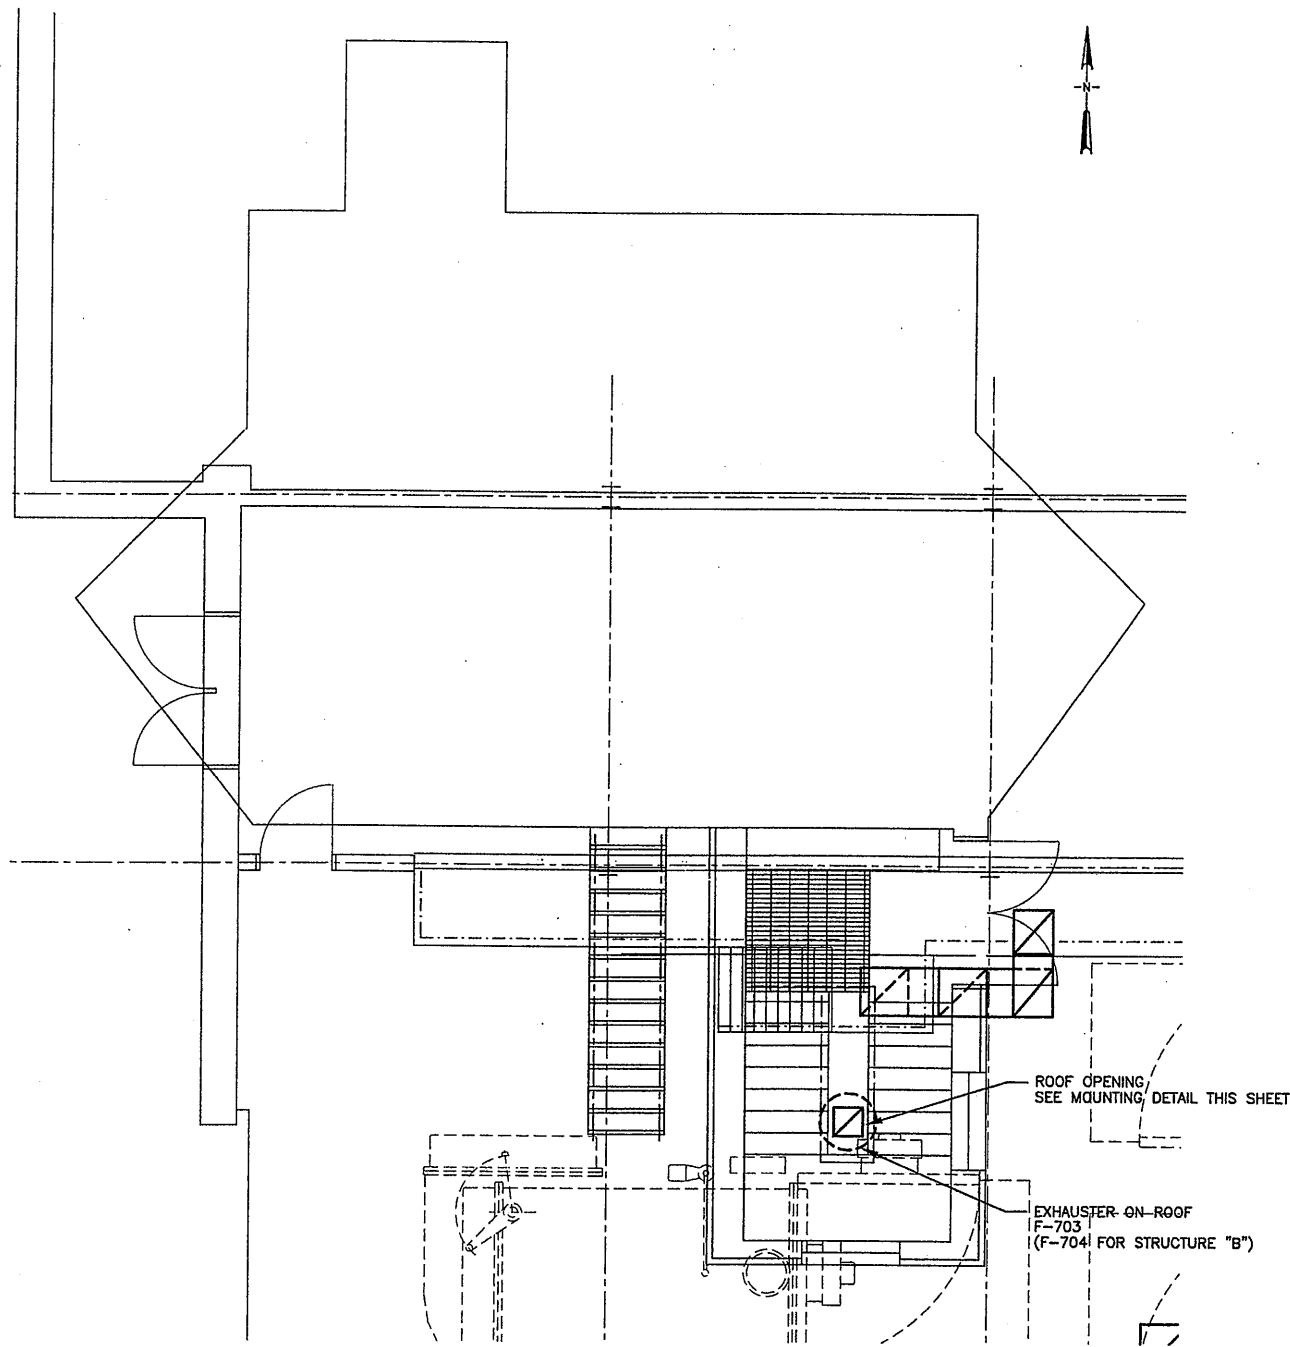


TERTIARY FLOW CONTROL STRUCTURE "A" PLAN
TERTIARY FLOW CONTROL STRUCTURE "B" PLAN (SIMILAR)
 1/4"=1'-0"

NOTE: SEE KEY PLAN H-701 FOR LOCATIONS

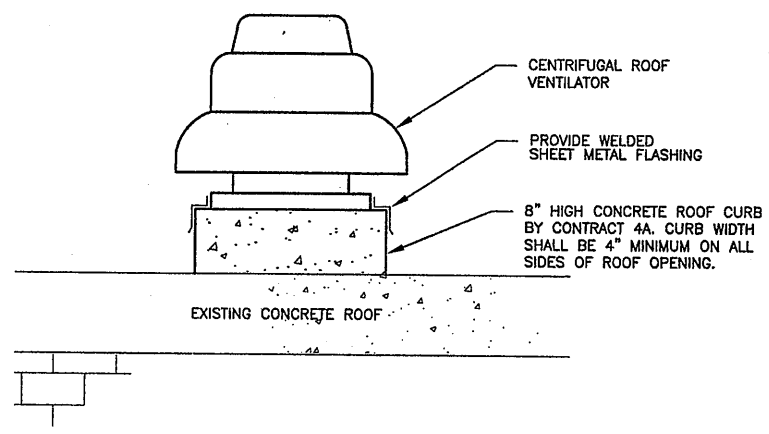

TECS FAN MOUNTING DETAIL
 1"=1'-0"

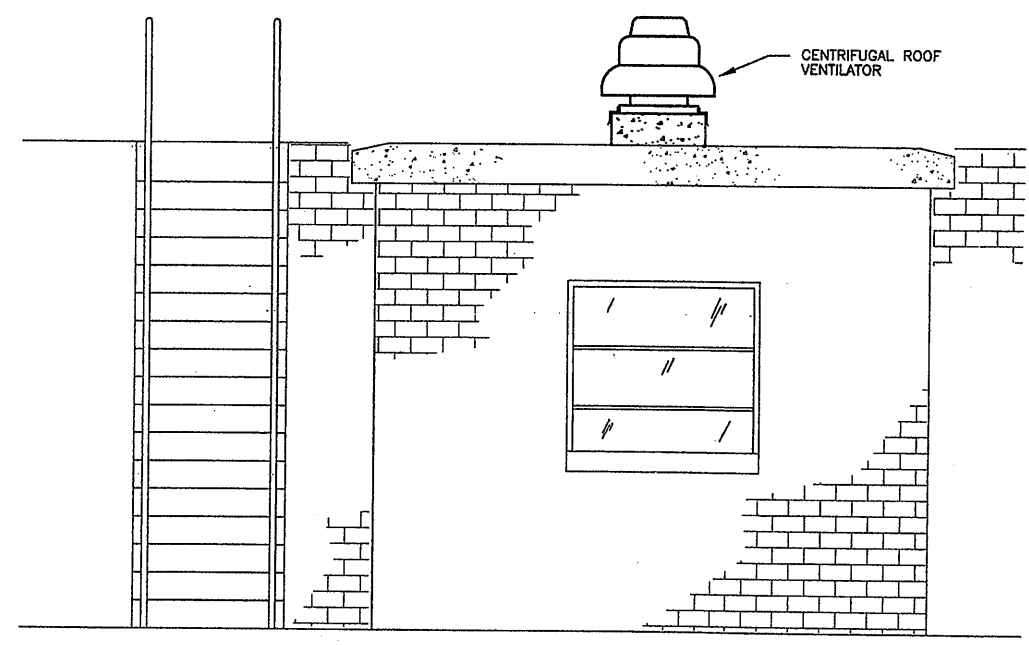

ELEVATION LOOKING NORTH
 1"=1'-0"

DRAWING NOTE:
 1. COORDINATE ROOF OPENINGS AND CURB SIZES WITH CONTRACT NUMBER 4A.

RECORD DRAWING

THESE DRAWINGS HAVE BEEN REVISED TO REFLECT MAJOR CHANGES, IF ANY, WHICH OCCURRED DURING CONSTRUCTION. REVISIONS ARE BASED UPON INFORMATION SUPPLIED BY CONTRACTOR.
 DATE: _____ PER: _____

THIS DRAWING WAS PREPARED AT THE SCALE INDICATED IN THE TITLE BLOCK. INACCURACIES IN THE STATED SCALE MAY BE INTRODUCED WHEN DRAWINGS ARE REPRODUCED BY ANY MEANS. USE THE GRAPHIC SCALE BAR IN THE TITLE BLOCK TO DETERMINE THE ACTUAL SCALE OF THIS DRAWING.

02/019/00 OBG KJL
 00659H707

| No. | Date | Revisions | Init |
|-----|----------|---------------------|------|
| 0 | 4/20/01 | ISSUED FOR APPROVAL | |
| 1 | | AS-BID | |
| 2 | 11/30/05 | RECORD DRAWING | RCC |

In charge of DPB
 Designed by SWM
 Drawn by KJL
 Checked by SWM



NO ALTERATIONS PERMITTED HEREON EXCEPT AS PROVIDED UNDER SECTION 7209 SUBDIVISION 2 OF THE NEW YORK STATE EDUCATION LAW


ONONDAGA COUNTY • DEPARTMENT OF DRAINAGE AND SANITATION • SYRACUSE, NEW YORK
 METROPOLITAN SYRACUSE WASTEWATER TREATMENT PLANT
 STAGE III AMMONIA AND STAGE II PHOSPHORUS REMOVAL PROJECT

GALLERIES VENTILATION
TERTIARY FLOW CONTROL STRUCTURES
EQUIPMENT PLAN & DETAIL
 HVAC



File Number
 00659
 Date
 APRIL 2001
blampert

H-707

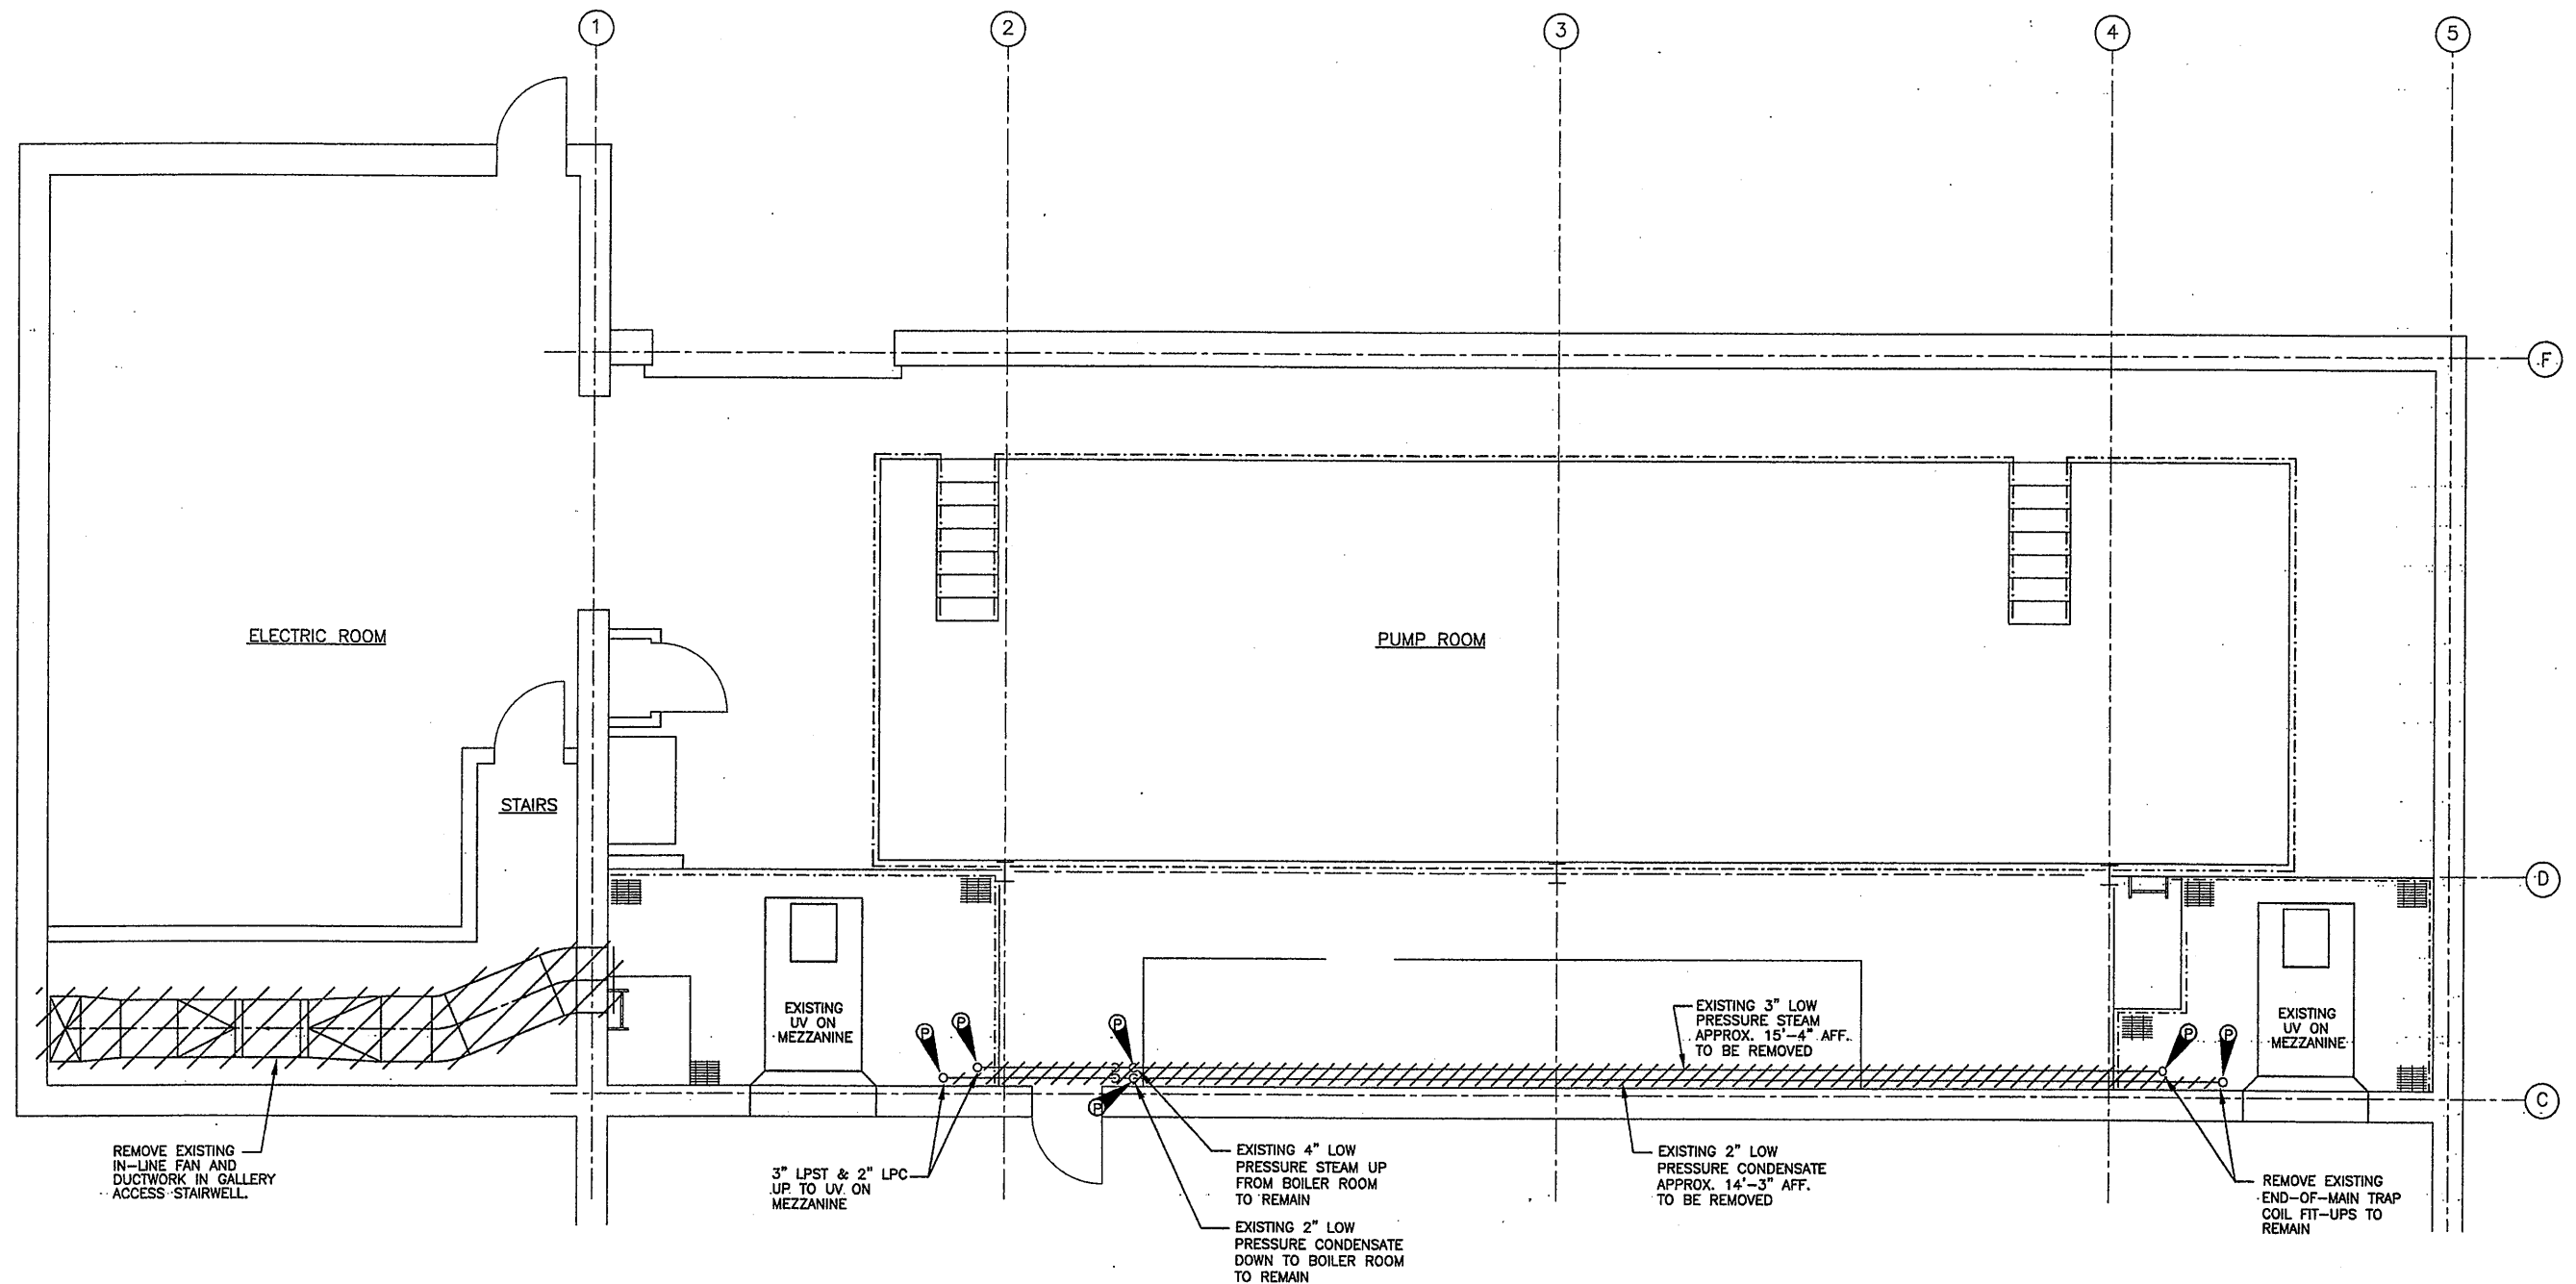

MEZZANINE LEVEL PLAN
1/4"=1'-0"

RECORD DRAWING

THESE DRAWINGS HAVE BEEN REVISED TO REFLECT MAJOR CHANGES, IF ANY, WHICH OCCURRED DURING CONSTRUCTION. REVISIONS ARE BASED UPON INFORMATION SUPPLIED BY CONTRACTOR.

DATE: _____ PER: _____

THIS DRAWING WAS PREPARED AT THE SCALE INDICATED IN THE TITLE BLOCK. INACCURACIES IN THE STATED SCALE MAY BE INTRODUCED WHEN DRAWINGS ARE REPRODUCED BY ANY MEANS. USE THE GRAPHIC SCALE BAR IN THE TITLE BLOCK TO DETERMINE THE ACTUAL SCALE OF THIS DRAWING.

07/17/00 OBG JAS
00659H708

| No. | Date | Revisions | Init |
|-----|---------|---------------------|------|
| 0 | 4/20/01 | ISSUED FOR APPROVAL | |
| 1 | | AS-BID | |
| 2 | 1/30/03 | RECORD DRAWING | RCG |

In charge of DPB
Designed by SWM
Drawn by KJL
Checked by SWM


ENVIRONMENTAL ENGINEERING ASSOCIATES, LLP
SYRACUSE, NEW YORK

ONONDAGA COUNTY • DEPARTMENT OF DRAINAGE AND SANITATION • SYRACUSE, NEW YORK
METROPOLITAN SYRACUSE WASTEWATER TREATMENT PLANT
STAGE III AMMONIA AND STAGE II PHOSPHORUS REMOVAL PROJECT
**GALLERIES VENTILATION
LOW-LIFT PUMP STATION
REMOVALS PLAN**
HVAC




File Number
00659
Date
APRIL 2001
L. Campolustro

H-708

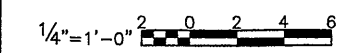

NO ALTERATIONS PERMITTED HEREON EXCEPT AS PROVIDED UNDER SECTION 7209 SUBDIVISION 2 OF THE NEW YORK STATE EDUCATION LAW

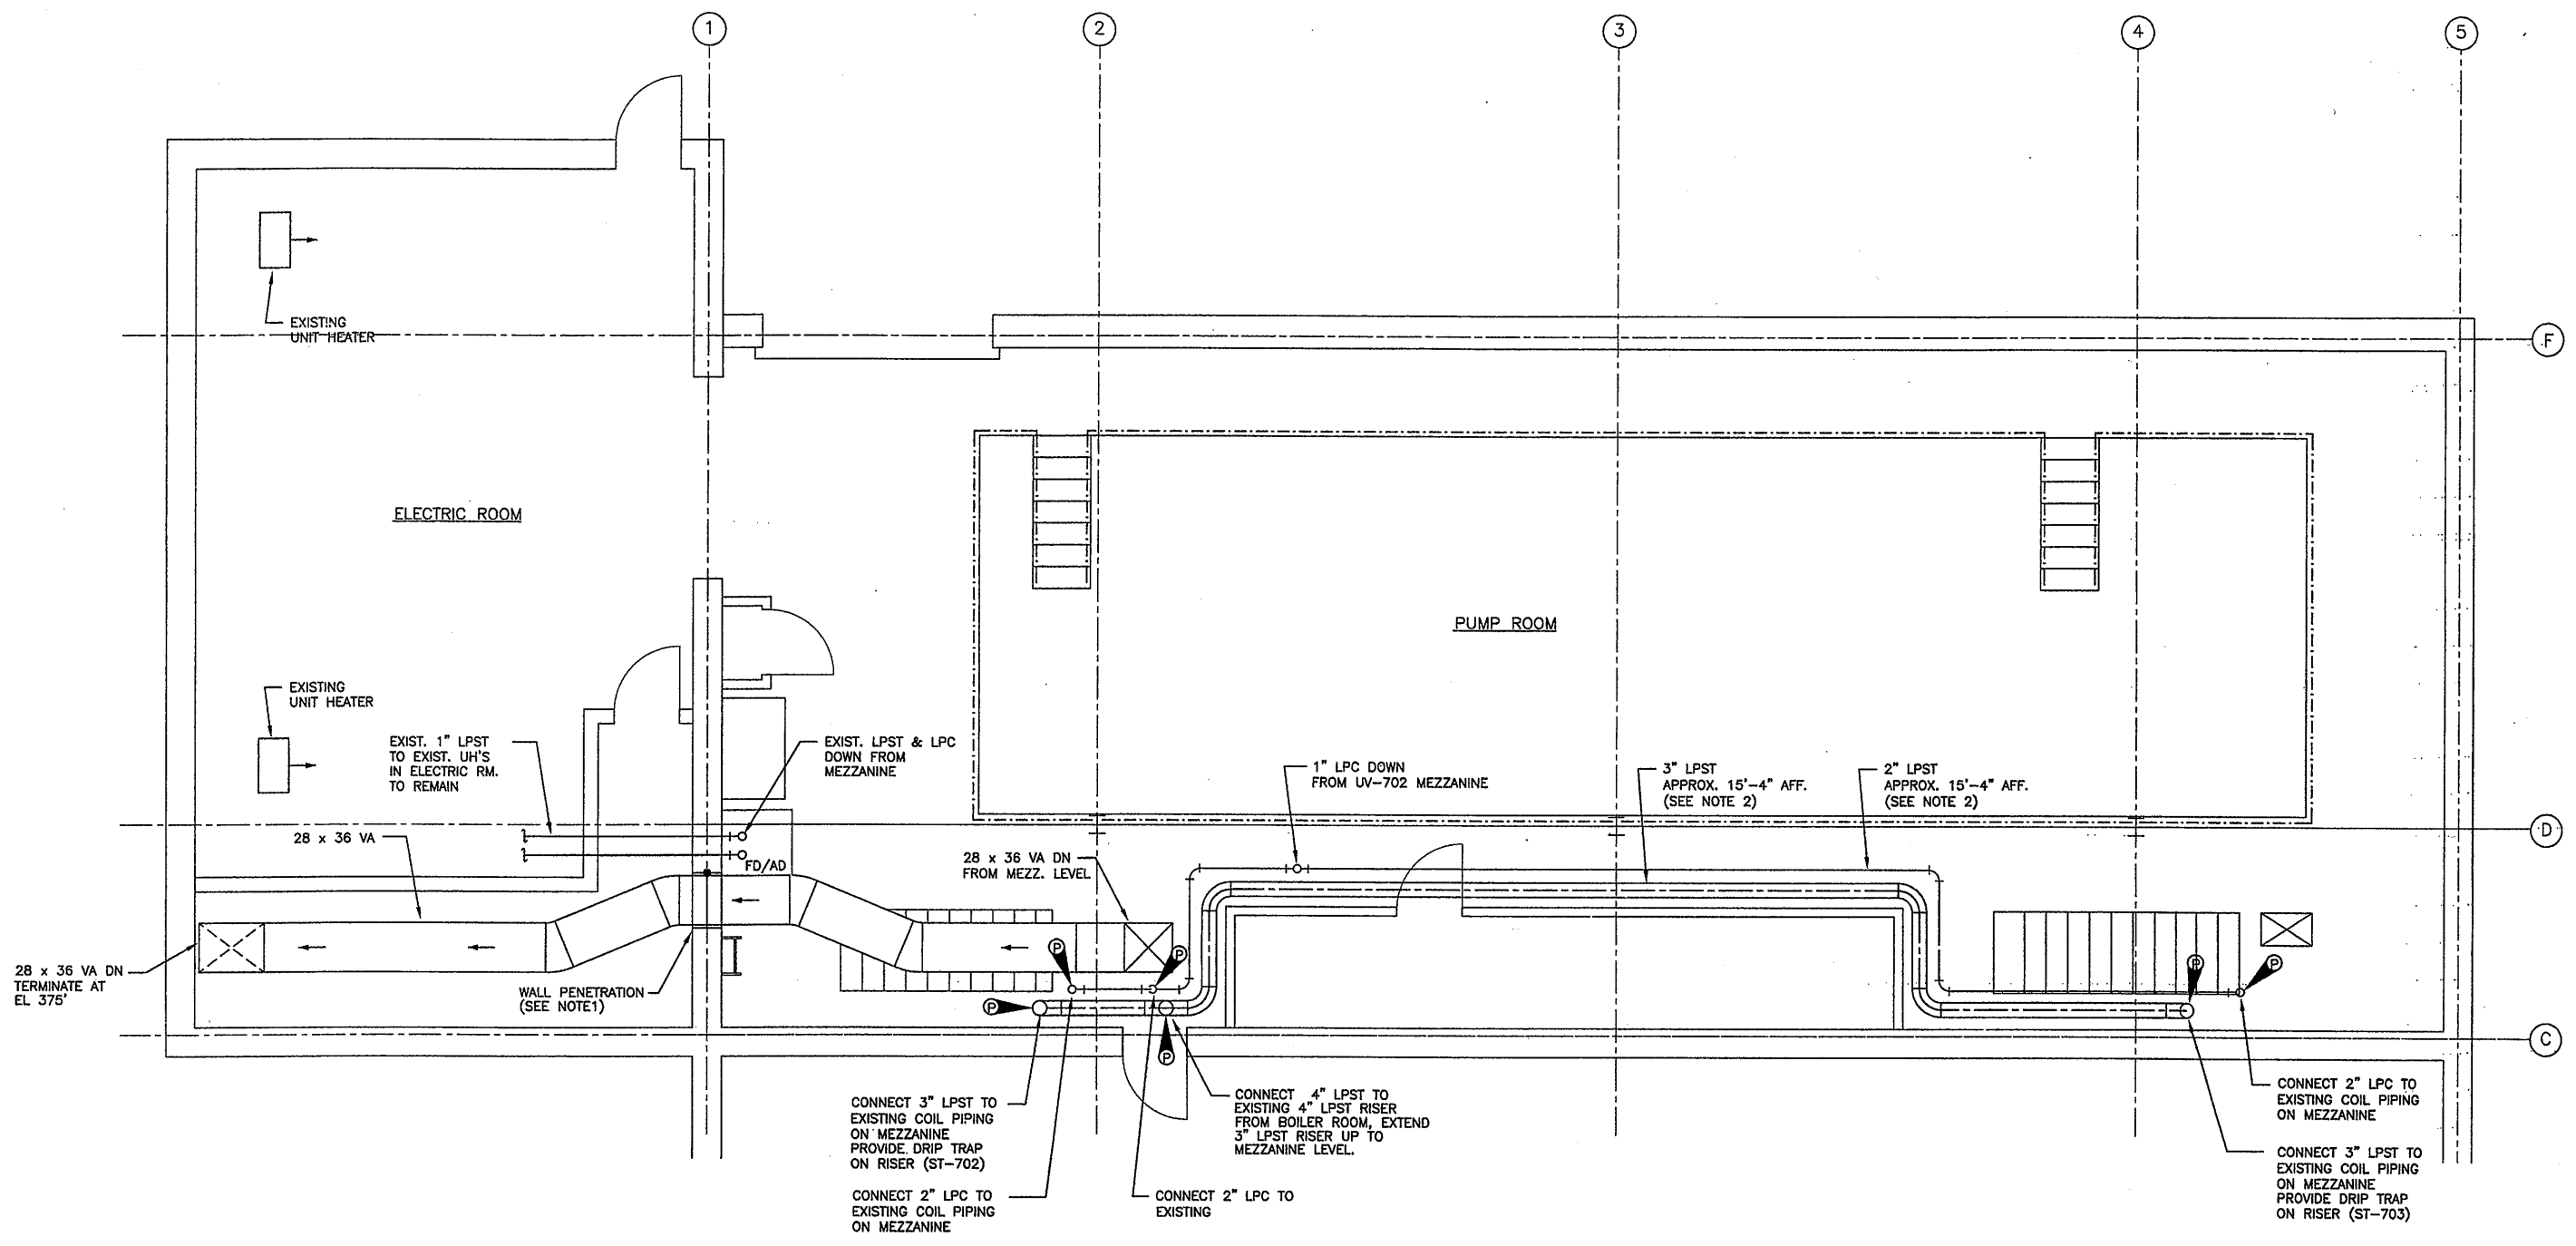

FIRST FLOOR PLAN
1/4"=1'-0"

- NOTES:**
1. WALL PENETRATION BY CONTRACT 4A. COORDINATE SIZE AND LOCATION.
 2. SUSPEND PIPING FROM MEZZANINE FRAMING ABOVE.

RECORD DRAWING

THESE DRAWINGS HAVE BEEN REVISED TO REFLECT MAJOR CHANGES, IF ANY, WHICH OCCURRED DURING CONSTRUCTION. REVISIONS ARE BASED UPON INFORMATION SUPPLIED BY CONTRACTOR.
DATE: _____ PER: _____

THIS DRAWING WAS PREPARED AT THE SCALE INDICATED IN THE TITLE BLOCK. INACCURACIES IN THE STATED SCALE MAY BE INTRODUCED WHEN DRAWINGS ARE REPRODUCED BY ANY MEANS. USE THE GRAPHIC SCALE BAR IN THE TITLE BLOCK TO DETERMINE THE ACTUAL SCALE OF THIS DRAWING.

07/17/00 OBG JAS
00659H709

1/4"=1'-0"

NO ALTERATIONS PERMITTED HEREON EXCEPT AS PROVIDED UNDER SECTION 7209 SUBDIVISION 2 OF THE NEW YORK STATE EDUCATION LAW

| No. | Date | Revisions | Init |
|-----|----------|---------------------|------|
| 0 | 4/20/01 | ISSUED FOR APPROVAL | |
| 1 | | AS-BID | |
| 2 | 11/30/03 | RECORD DRAWING | RCG |

In charge of DPB
Designed by SWM
Drawn by KJL
Checked by SWM

ENVIRONMENTAL ENGINEERING ASSOCIATES, LLP
SYRACUSE, NEW YORK

ONONDAGA COUNTY • DEPARTMENT OF DRAINAGE AND SANITATION • SYRACUSE, NEW YORK
METROPOLITAN SYRACUSE WASTEWATER TREATMENT PLANT
STAGE III AMMONIA AND STAGE II PHOSPHORUS REMOVAL PROJECT
**GALLERIES VENTILATION
LOW-LIFT PUMP STATION
FIRST FLOOR PLAN**
HVAC




File Number
00659

Date
APRIL 2001

H-709

[Signature]

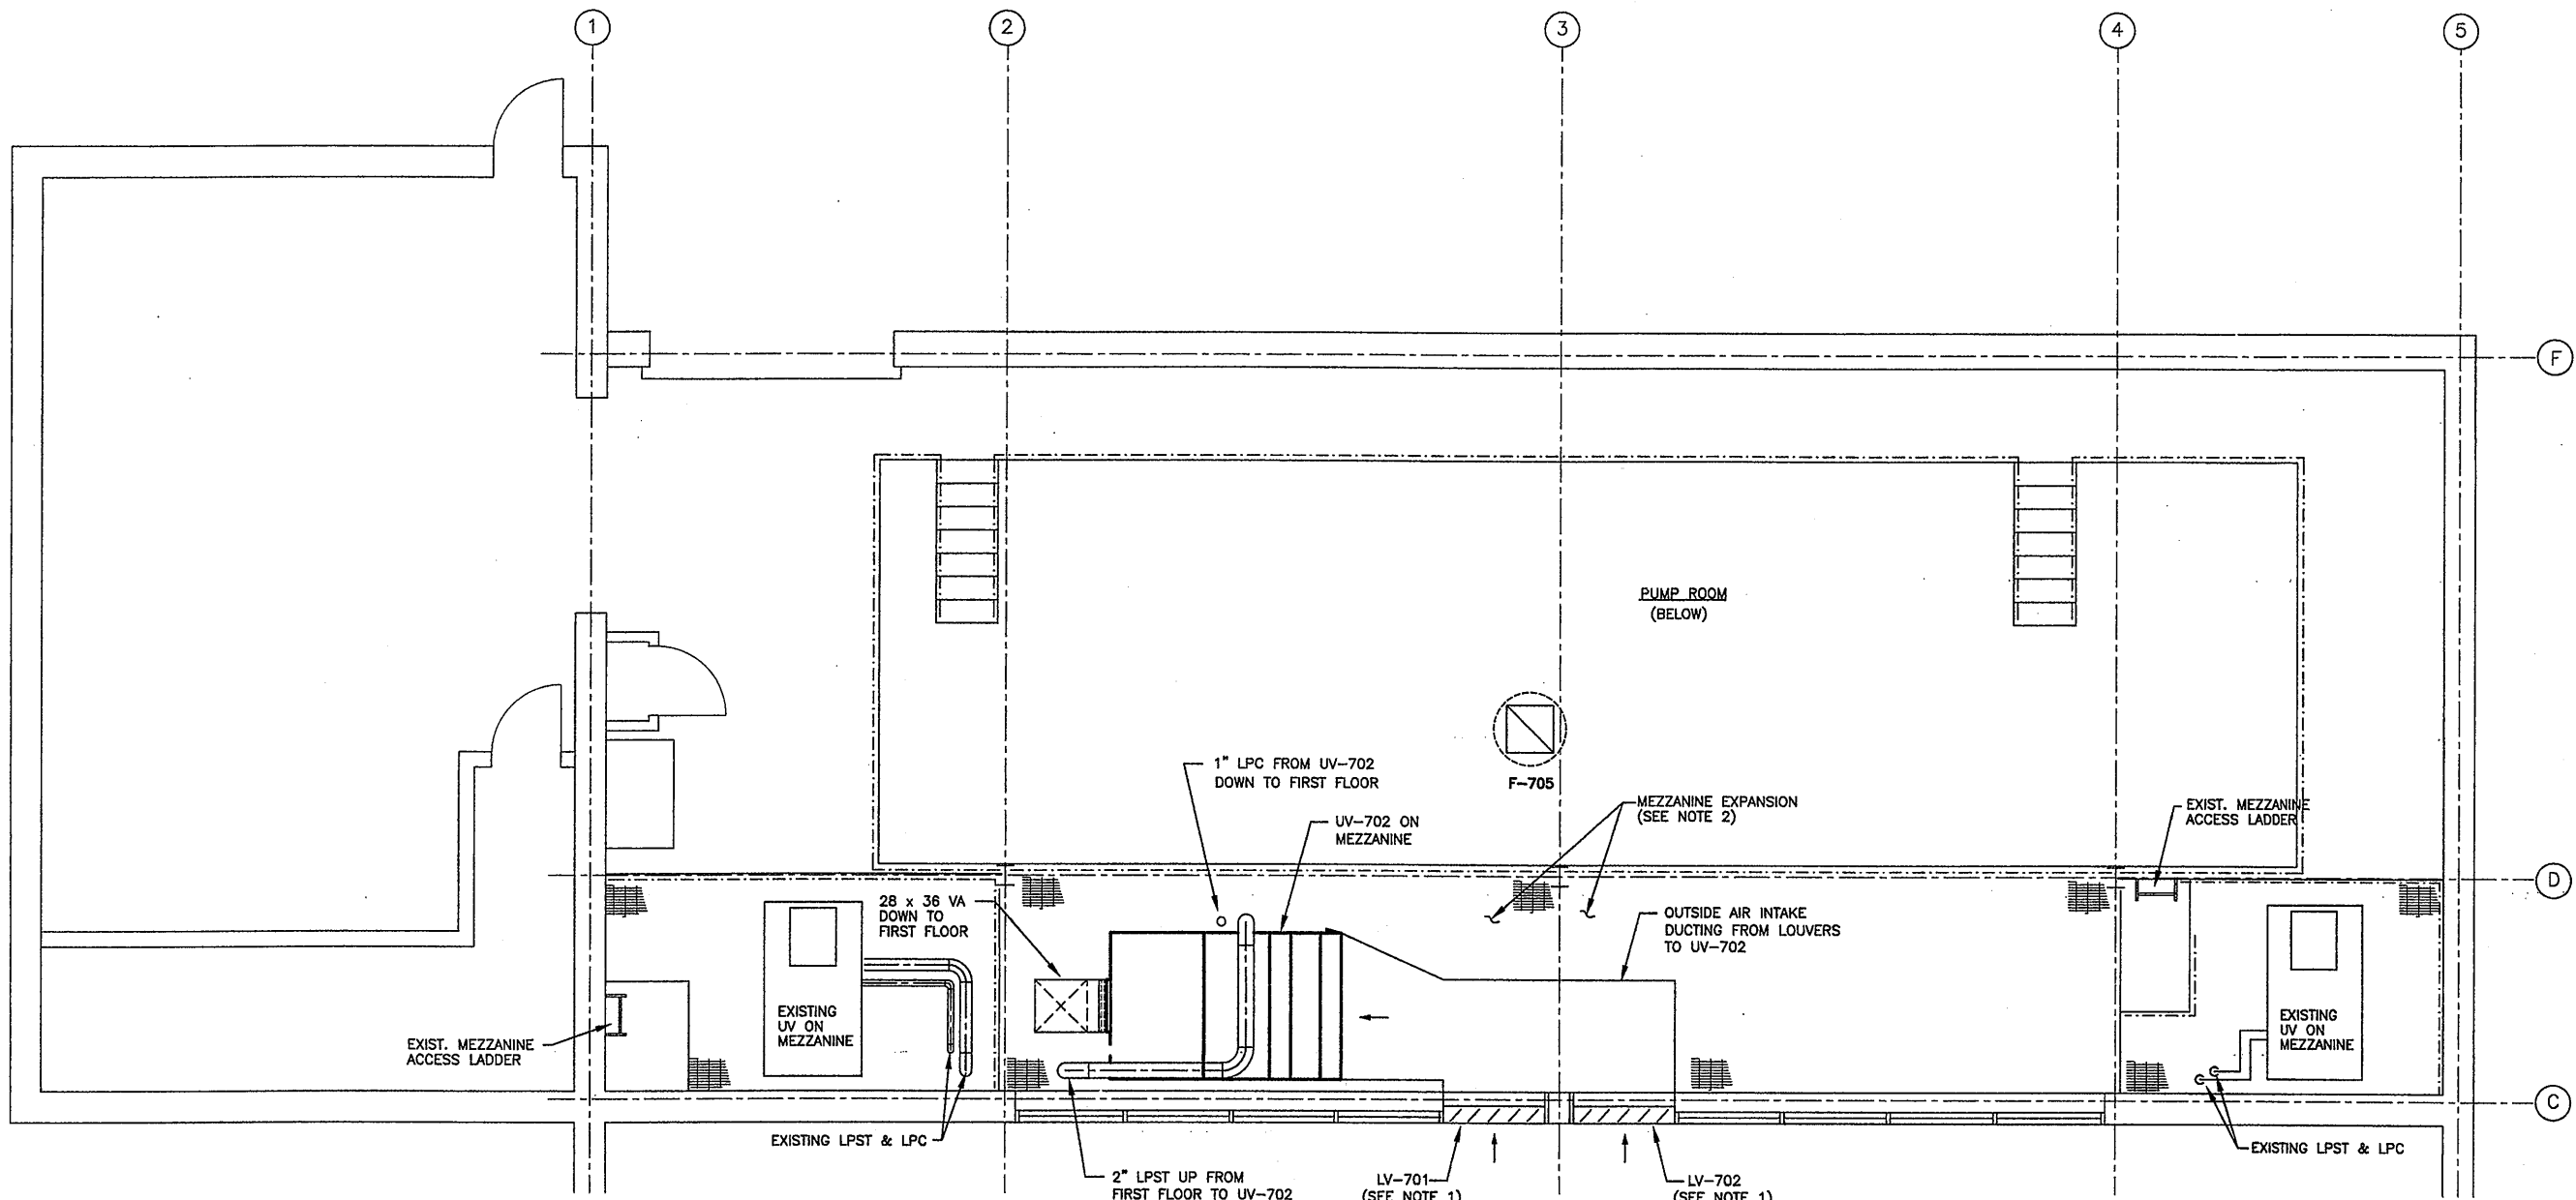

MEZZANINE LEVEL PLAN
1/4"=1'-0"

- NOTES:**
1. REMOVE EXISTING GLASS PANE (APPROX 53" X 82") AND INSTALL LOUVER.
 2. MEZZANINE EXPANSION BY CONTRACT 4A. COORDINATE LOCATIONS AND SIZES OF EQUIPMENT SUPPORT FRAMING AND MEZZANINE PENETRATIONS.

RECORD DRAWING

THESE DRAWINGS HAVE BEEN REVISED TO REFLECT MAJOR CHANGES, IF ANY, WHICH OCCURRED DURING CONSTRUCTION. REVISIONS ARE BASED UPON INFORMATION SUPPLIED BY CONTRACTOR.
DATE: _____ PER: _____

THIS DRAWING WAS PREPARED AT THE SCALE INDICATED IN THE TITLE BLOCK. INACCURACIES IN THE STATED SCALE MAY BE INTRODUCED WHEN DRAWINGS ARE REPRODUCED BY ANY MEANS. USE THE GRAPHIC SCALE BAR IN THE TITLE BLOCK TO DETERMINE THE ACTUAL SCALE OF THIS DRAWING.

07/17/00 OBG JAS
00659H710

1/4"=1'-0"

NO ALTERATIONS PERMITTED HEREON EXCEPT AS PROVIDED UNDER SECTION 7209 SUBDIVISION 2 OF THE NEW YORK STATE EDUCATION LAW

| No. | Date | Revisions | Init |
|-----|----------|---------------------|------|
| 0 | 4/20/01 | ISSUED FOR APPROVAL | |
| 1 | | AS-BID | |
| 2 | 11/30/09 | RECORD DRAWING | RCG |

In charge of — DPB
Designed by — SWM
Drawn by — KJL
Checked by — SWM

ENVIRONMENTAL ENGINEERING ASSOCIATES, LLP
SYRACUSE, NEW YORK


ONONDAGA COUNTY • DEPARTMENT OF DRAINAGE AND SANITATION • SYRACUSE, NEW YORK
METROPOLITAN SYRACUSE WASTEWATER TREATMENT PLANT
STAGE III AMMONIA AND STAGE II PHOSPHORUS REMOVAL PROJECT

**LOW-LIFT PUMP STATION
MEZZANINE PLAN**
HVAC

File Number
00659

Date
APRIL 2001

H-710

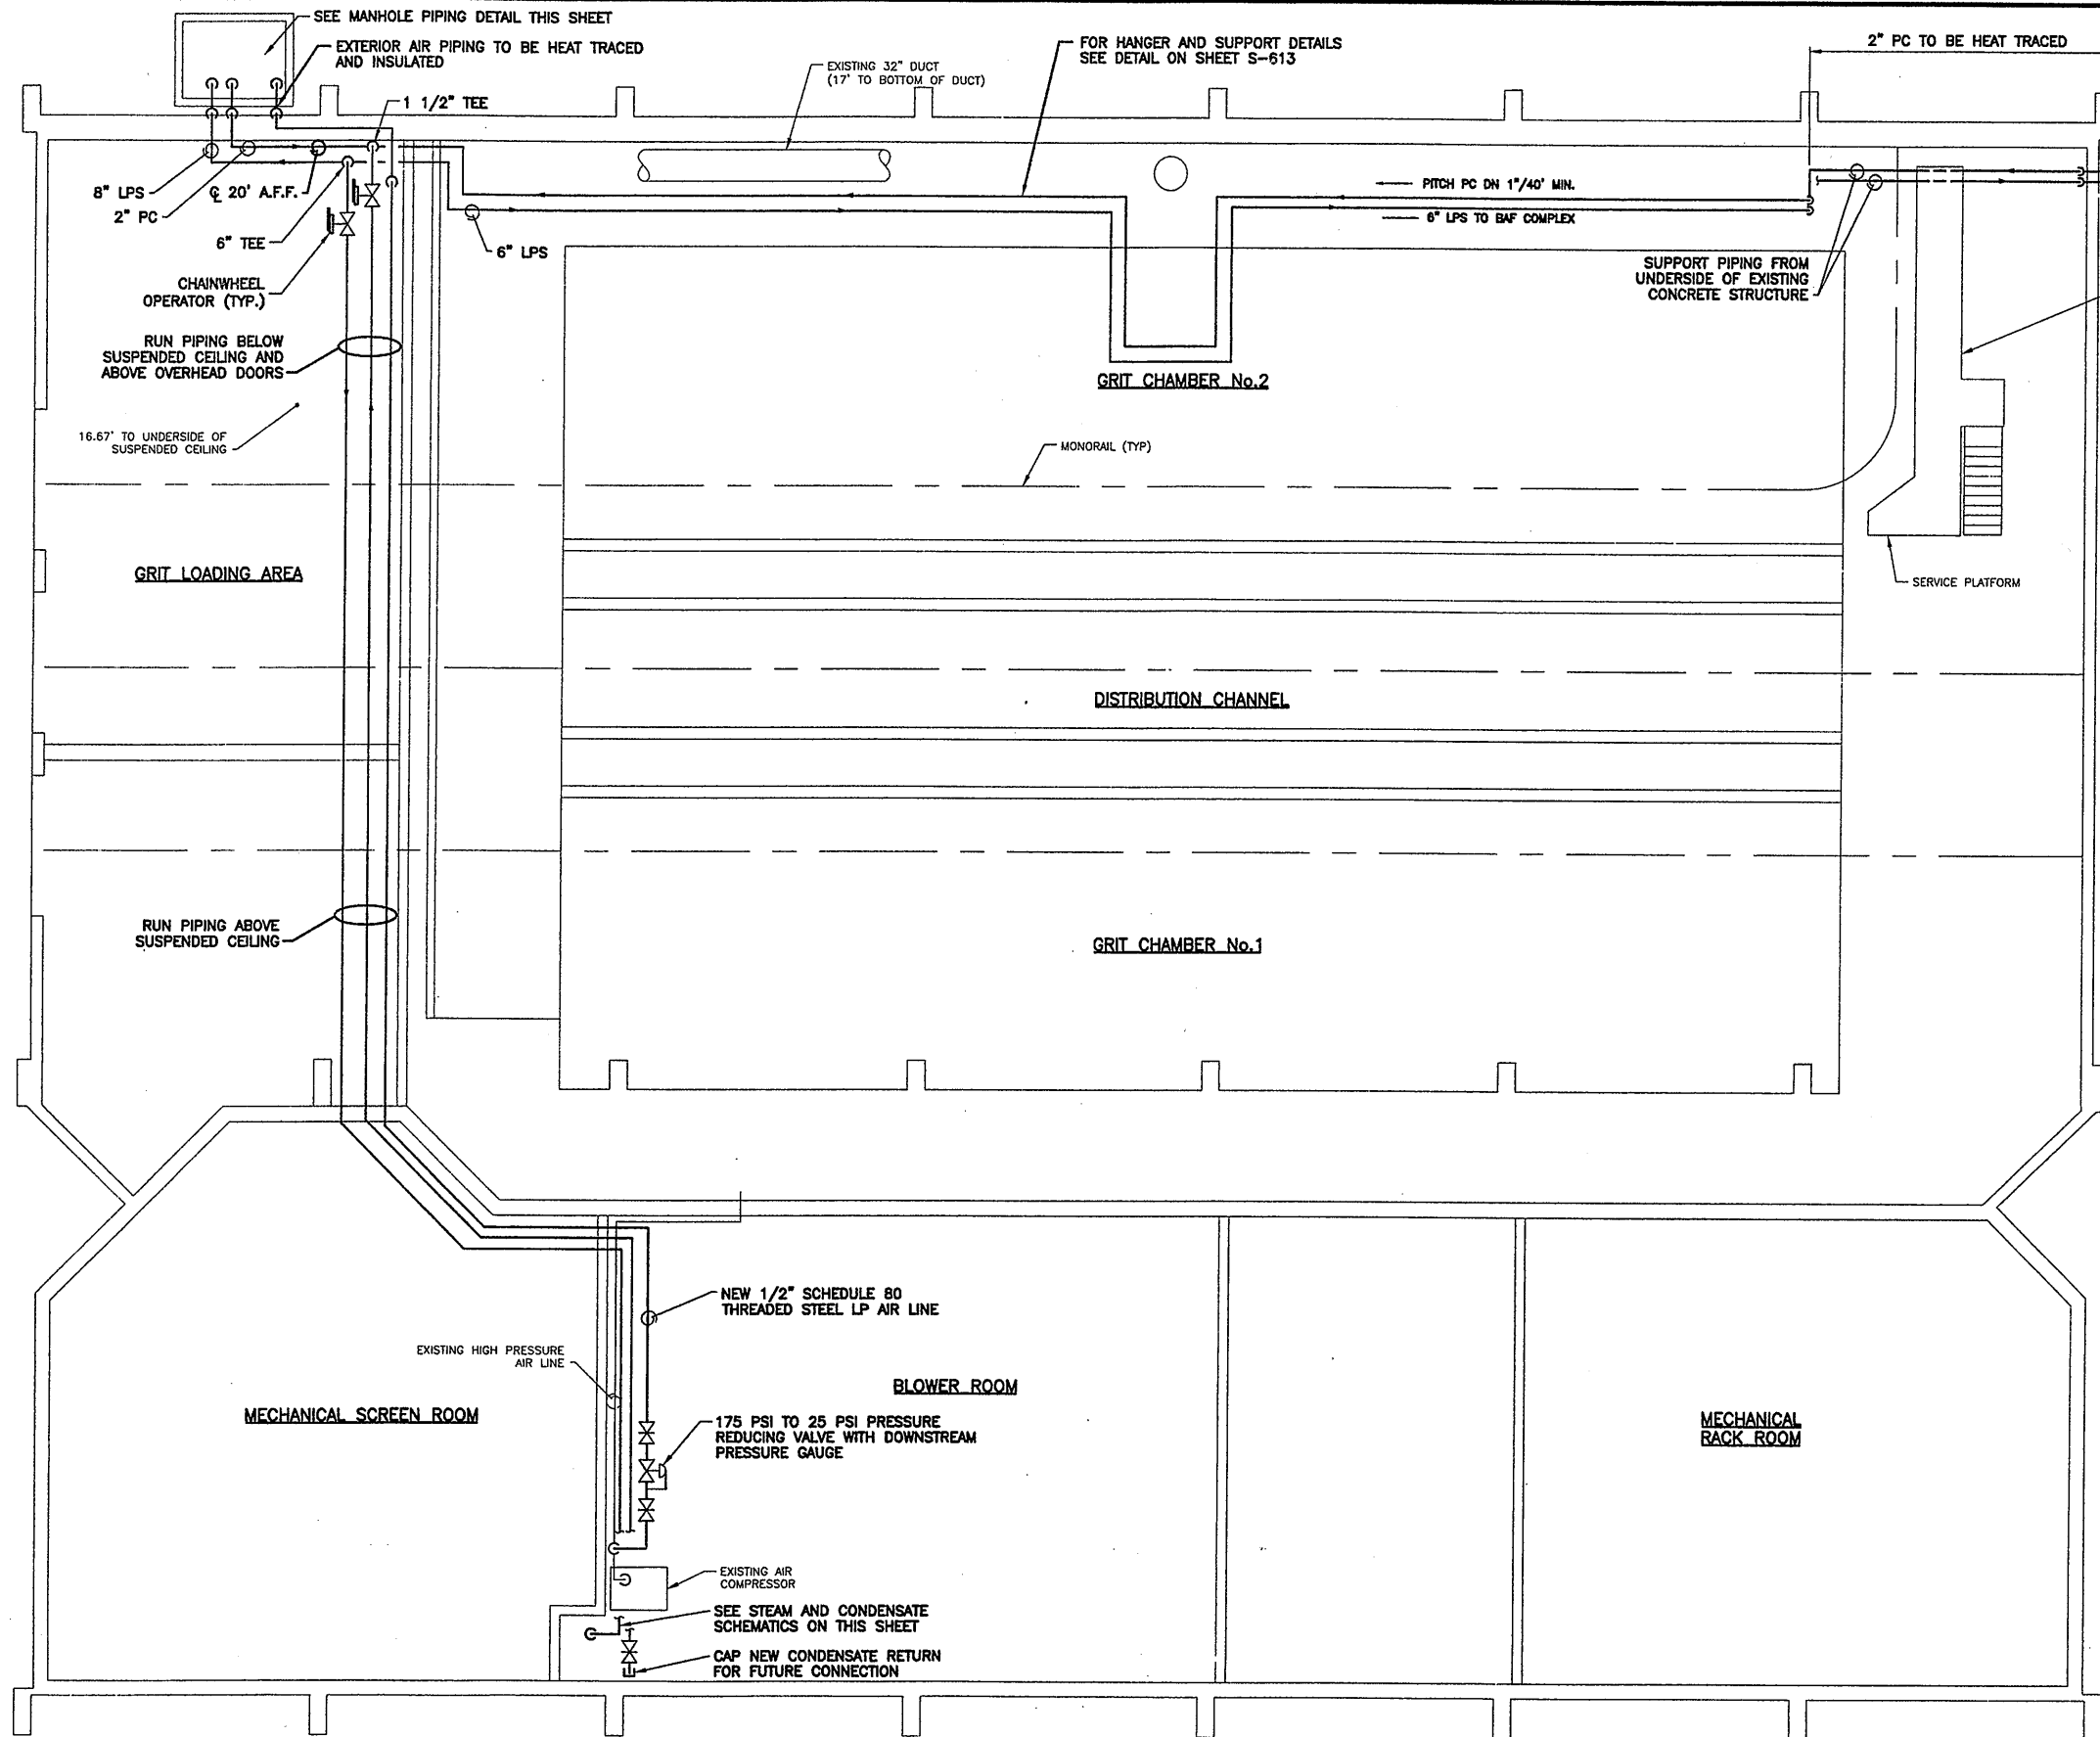

NOTE: HEAT TRACING TO BE 3 WATTS/FT., SELF REGULATING IN ACCORDANCE WITH SPECIFICATION SECTION 15770.


2\"/>

2\"/>


6\"/>

TERMINATE 2\"/>

BOTTOM OF SUPPORT SLAB AT 13'-8"

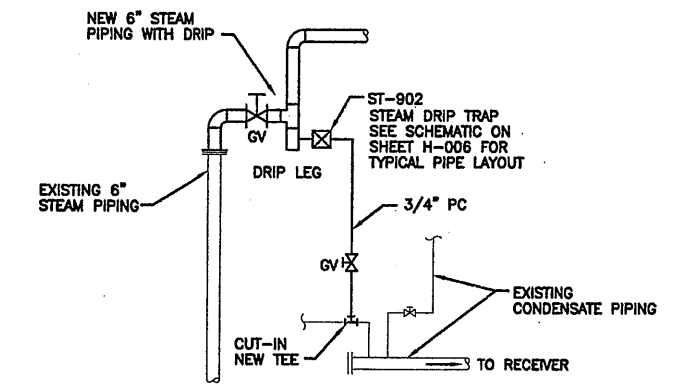

STEAM CONNECTION AND CONDENSATE PIPING SCHEMATIC
NOT TO SCALE

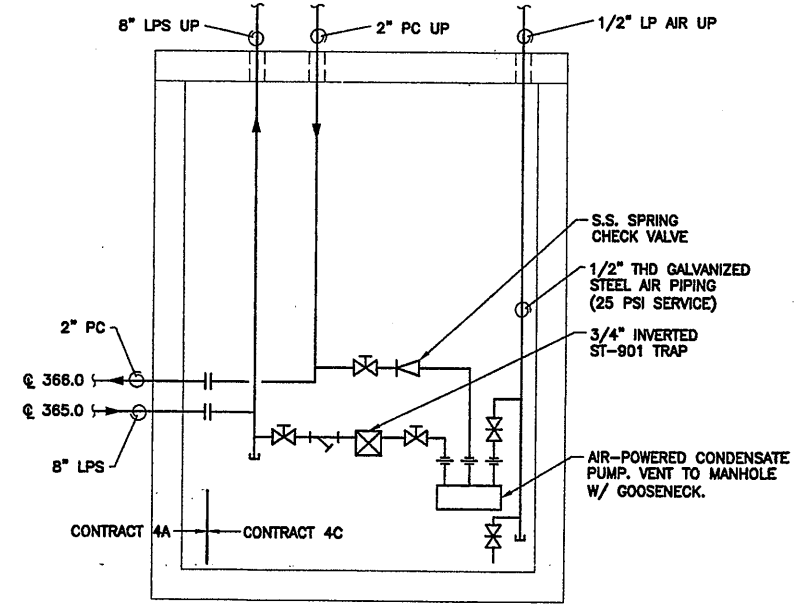

STEAM & CONDENSATE MANHOLE PIPING SCHEMATIC
NOT TO SCALE

RECORD DRAWING


THESE DRAWINGS HAVE BEEN REVISED TO REFLECT MAJOR CHANGES, IF ANY, WHICH OCCURRED DURING CONSTRUCTION. REVISIONS ARE BASED UPON INFORMATION SUPPLIED BY CONTRACTOR.

DATE: 11/23/05 PER: GCH

THIS DRAWING WAS PREPARED AT THE SCALE INDICATED IN THE TITLE BLOCK. INACCURACIES IN THE STATED SCALE MAY BE INTRODUCED WHEN DRAWINGS ARE REPRODUCED BY ANY MEANS. USE THE GRAPHIC SCALE BAR IN THE TITLE BLOCK TO DETERMINE THE ACTUAL SCALE OF THIS DRAWING.

NEW SCREENING AND GRIT BUILDING PLAN
SCALE: 1/8"=1'-0"

03/19/00 S&W CMS
CONTRACT 2-5\HVAC\0659H901.DWG

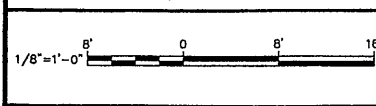

| No. | Date | Revisions | Init |
|-----|----------|---------------------|------|
| 0 | 4/20/01 | ISSUED FOR APPROVAL | |
| 1 | | AS BID | |
| 2 | 11/30/05 | RECORD DRAWING | RCG |

In charge of DBP
Designed by DBP
Drawn by CMS/JRH
Checked by DBP

ENVIRONMENTAL ENGINEERING ASSOCIATES, LLP
SYRACUSE, NEW YORK

ONONDAGA COUNTY • DEPARTMENT OF DRAINAGE AND SANITATION • SYRACUSE, NEW YORK
METROPOLITAN SYRACUSE WASTEWATER TREATMENT PLANT
STAGE III AMMONIA AND STAGE II PHOSPHORUS REMOVAL PROJECT
NEW SCREENING AND GRIT BUILDING
NEW SCREENING AND GRIT BUILDING PLAN

File Number
00659

Date
APRIL 2001

H-901

Professional Engineer Seal: STATE OF NEW YORK, GERALD C. HOEL, No. 8750A, LICENSED PROFESSIONAL ENGINEER

HVAC

PIPE AND FITTING SYMBOLS

- COLD WATER PIPING
- HOT WATER PIPING
- HOT WATER RECIRCULATION PIPING
- VENT PIPING
- SOIL PIPING
- STORM DRAINAGE
- SYSTEM RISER
- PIPING ANCHOR
- PIPE UP
- PIPE DOWN
- PIPE TEE DOWN
- PIPE TEE DOWN
- FLUSHING CAP CONN.
- CAP CONNECTION
- CLEAN OUT
- STRAINER
- WYE
- UNION
- PRESSURE GAGE
- WATER HAMMER ARRESTOR
- PIPE CROSS OVER (NO CONN.)

VALVE AND GATE SYMBOLS

- CHECK VALVE
- GATE VALVE N/O
- GATE VALVE N/C
- GATE VALVE W/TAMPER SWITCH
- BALL VALVE
- AUTOMATIC 2-POSITION SUPPLY VALVE
- THERMOSTATIC CONTROLLER VALVE
- GLOBE VALVE
- PRESSURE REDUCING VALVE
- RPZ BACKFLOW VALVE
- HOSE BIBB
- NON FREEZE HOSE BIBB
- DECK HYDRANT
- BALANCE VALVE
- ALL LINES VALVED

MISCELLANEOUS SYMBOLS

- WATER CLOSET FLUSH VALVE TYPE (NUMBER INDICATES TYPE)
- LAVATORY (NUMBER INDICATES TYPE)
- SINK (NUMBER INDICATES TYPE)
- MOP SINK BASIN (NUMBER INDICATES TYPE)
- SHOWER (NUMBER INDICATES TYPE)
- FLOOR DRAIN (LETTER INDICATES TYPE)
- ROOF DRAIN (LETTER INDICATES TYPE)
- DECK PLATE CLEAN OUT
- FLOW DIRECTION
- EMERGENCY EYEWASH/SHOWER UNIT
- POINT OF CONNECTION BETWEEN EXISTING WORK TO REMAIN & NEW WORK
- KEYED NOTE

ABBREVEATIONS

- A.F.F. ABOVE FINISHED FLOOR
- BLDG. BUILDING
- CONN. CONNECTION
- CONT. CONTINUED
- CO CLEAN OUT
- CW COLD WATER
- DEPT. DEPARTMENT
- DH DECK HYDRANT
- DHW DOMESTIC HOT WATER
- DN DOWN
- DPCO DECK PLATE CLEAN OUT
- D/W/V DRAIN/WASTE/VENT
- ELEV. ELEVATOR
- EEWS EMERGENCY EYE WASH AND SHOWER
- EWC ELECTRIC WATER COOLER
- EWS EFFLUENT WATER SYSTEM
- FD FLOOR DRAIN
- FFE FINISHED FLOOR ELEVATION
- FLR. FLOOR
- GCO GRADE CLEAN OUT
- HB HOSE BIBB
- HW HOT WATER
- HWR HOT WATER RETURN
- I.D. IDENTIFICATION
- INV. INVERT
- LAV LAVATORY
- LPC LOW PRESSURE CONDENSATE
- LPS LOW PRESSURE STEAM
- MAINT. MAINTENANCE
- MIN. MINIMUM REQUIREMENT
- MSB MOP SINK BASIN
- MTD. MOUNTED
- N.I.C. NOT IN CONTRACT
- N/O NORMALLY OPEN
- N/C NORMALLY CLOSED
- NFHB NON FREEZING HOSE BIBB
- PLPC PUMPED LOW PRESSURE CONDENSATE
- PW POTABLE WATER
- P.I.V. POST INDICATOR VALVE
- PLW PLANT WATER
- PRESS. PRESSURE
- PRV PRESSURE REDUCING VALVE
- PSI POUNDS PER SQUARE INCH
- RD ROOF DRAIN
- SAN SANITARY
- SH SHOWER
- SK SINK
- SS SERVICE SINK
- ST STORM PIPE
- TBD TO BE DETERMINED
- TS TAMPER SWITCH
- TYP TYPICAL
- W WASTE
- W/ WITH
- WC WATER CLOSET
- WHA WATER HAMMER ARRESTOR
- VTR VENT THROUGH ROOF
- V VENT

GENERAL NOTES

- A. PROVIDE ALL CUTTING, PATCHING AND FIRESTOPPING REQUIRED TO ACCOMPLISH WORK SHOWN. PATCH AND SEAL OPENINGS TO MATCH ADJACENT WALLS, FLOORS, CEILINGS, ETC. UNLESS OTHERWISE INDICATED. CONCEAL ALL WORK IN FINISHED AREAS UNLESS OTHERWISE INDICATED OR DIRECTED BY ARCHITECT.
- B. CONTRACTOR SHALL FIELD VERIFY ALL LOCATIONS, DIMENSIONS AND EXISTING CONDITIONS (PIPING, RISERS, STRUCTURAL ELEMENTS, ETC.) PRIOR TO STARTING WORK. CONTRACTOR SHALL COORDINATE INSTALLATION OF EQUIPMENT, PIPING WITH EXISTING CONDITIONS. PROVIDE FITTINGS, PIPING, OFFSETS, ELEVATION CHANGES, ETC. TO MINIMIZE CONFLICTS WITH EXISTING CONDITIONS. CONTRACTOR SHALL REROUTE PIPING THAT WILL BE IN CONFLICT WITH OTHER TRADES.
- C. CONTRACTOR SHALL PROVIDE ALL SLEEVES, CORE DRILLING, WATER, SMOKE AND FIRE SEALING OF PIPING PENETRATIONS THROUGH WALLS AND FLOORS.
- D. ALL VALVES W/ CENTER OF SHAFT 6 1/2 FT. OR HIGHER FROM THE OPERATING FLOOR SHALL BE EQUIPPED W/CHAIN & WHEEL OPERATORS.

RECORD DRAWING

THESE DRAWINGS HAVE BEEN REVISED TO REFLECT MAJOR CHANGES, IF ANY, WHICH OCCURRED DURING CONSTRUCTION. REVISIONS ARE BASED UPON INFORMATION SUPPLIED BY CONTRACTOR.

DATE: _____ PER: _____

THIS DRAWING WAS PREPARED AT THE SCALE INDICATED IN THE TITLE BLOCK. INACCURACIES IN THE STATED SCALE MAY BE INTRODUCED WHEN DRAWINGS ARE REPRODUCED BY ANY MEANS. USE THE GRAPHIC SCALE BAR IN THE TITLE BLOCK TO DETERMINE THE ACTUAL SCALE OF THIS DRAWING.

06/27/01 RAB AJK/FJS
0659P001

NO SCALE

| No. | Date | Revisions | Init |
|-----|---------|---------------------|------|
| 0 | 4/20/01 | ISSUED FOR APPROVAL | |
| 1 | | AS BID | |
| 3 | 1/05 | FOR RECORD | |

In charge of FJS
 Designed by FJS
 Drawn by AJK
 Checked by FJS

ENVIRONMENTAL ENGINEERS ASSOCIATES, LLP
SYRACUSE, NEW YORK

RAM-TECH ENGINEERS, P.C.
CONSULTING ENGINEERS
SYRACUSE, NY 13204





ONONDAGA COUNTY • DEPARTMENT OF DRAINAGE AND SANITATION • SYRACUSE, NEW YORK
METROPOLITAN SYRACUSE WASTEWATER TREATMENT PLANT
STAGE III AMMONIA AND STAGE II PHOSPHORUS REMOVAL PROJECT

SYMBOL LIST & NOTES



PLUMBING

File Number
00659
Date
APRIL 2001

P-001

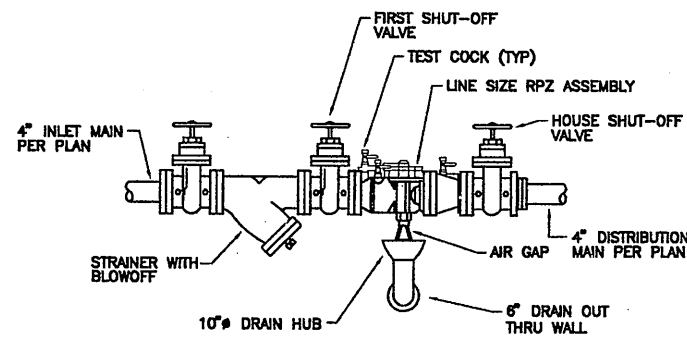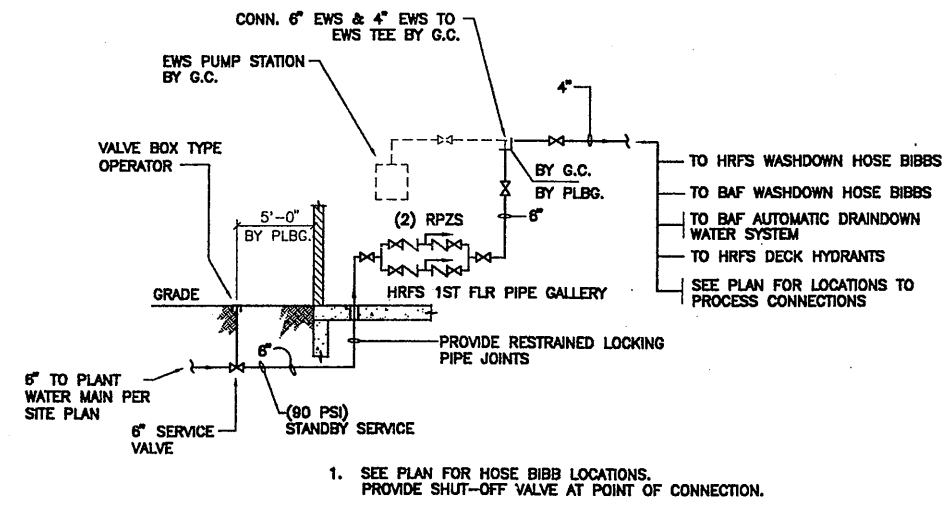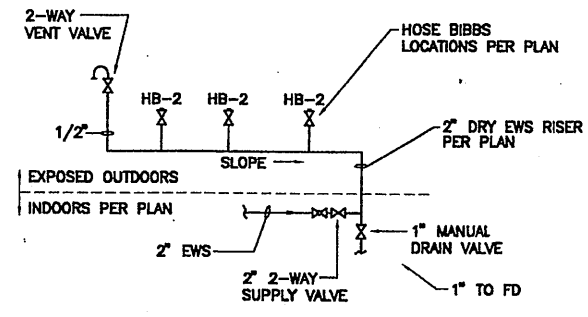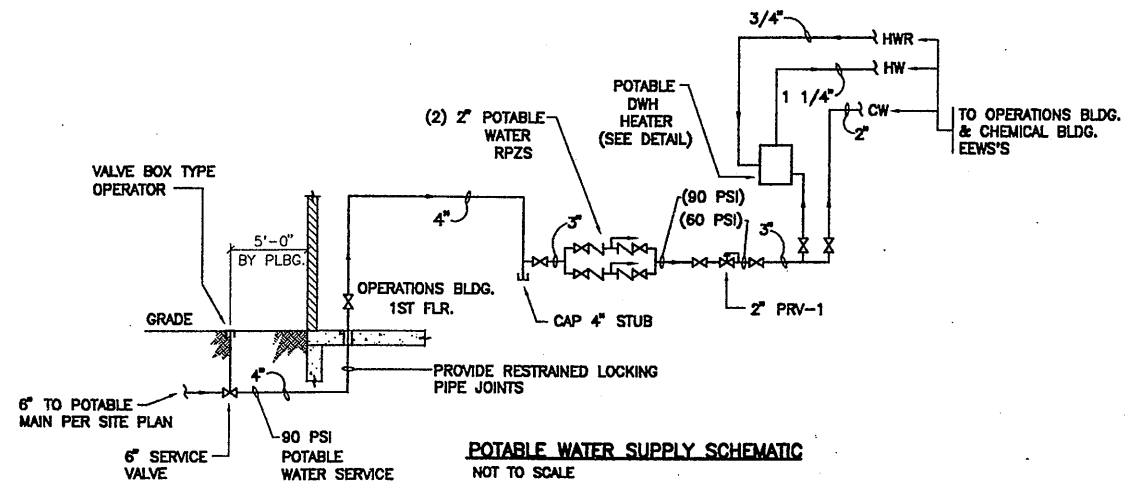

4" RPZ DETAIL NOT TO SCALE
 1. FOR 6" SIZE RPZ, PROVIDE 12" DRAIN HUB ON 8" DRAIN LINE OUT

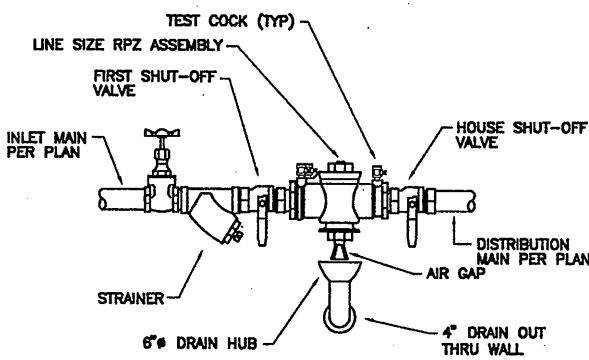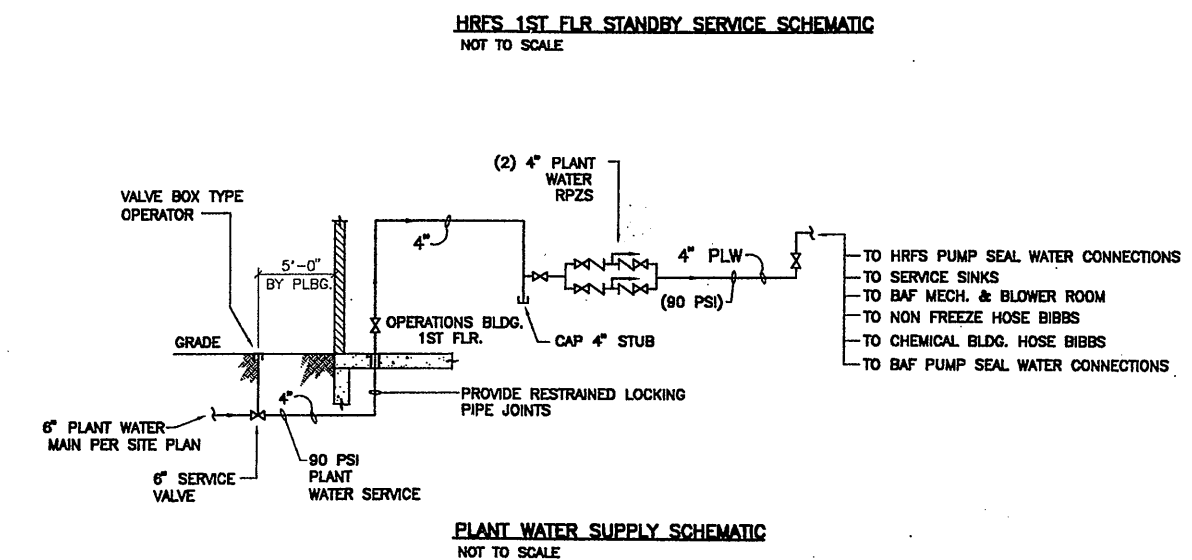

2" RPZ DETAIL NOT TO SCALE

| PLUMBING FIXTURE CONNECTION SCHEDULE | | | | | | | | | |
|--------------------------------------|--|----------------------------------|----------------------------|--|------|------------|---------|----------|--------------|
| MARK | TYPE | MATERIAL | TRIM | NOTES | CW | HW | PLW/EWS | SAN | VENT |
| WC-1 | Wall Hung Water Closet | Vitreous China | Flush Valve | ---- | 1" | --- | --- | 4" | 2" |
| WC-2 | HCP Wall Hung Water Closet | Vitreous China | Flush Valve | Mount at HCP Height | 1" | --- | --- | 4" | 2" |
| UR-1 | Wall Hung Urinal | Vitreous China | Flush Valve | ---- | 3/4" | --- | --- | 2" | 1 1/2" |
| UR-2 | HCP Wall Hung Urinal | Vitreous China | Flush Valve | Mount at HCP Height | 3/4" | --- | --- | 2" | 1 1/2" |
| L-1 | Countertop Lavatory 20" x 17" Oval | Vitreous China | Metering Faucet | ---- | 1/2" | 1/2" | --- | 1 1/2" | 1 1/2" |
| L-2 | HCP Countertop Lavatory 20" x 17" Oval | Vitreous China | HCP Metering Faucet | Mount at HCP Height | 1/2" | 1/2" | --- | 1 1/2" | 1 1/2" |
| SK-1 | Single Basin Countertop Sink 25" x 22" | Stainless Steel | Mixing Faucet | ---- | 1/2" | 1/2" | --- | 1 1/2" | 1 1/2" |
| SK-2 | Dual Basin Countertop Kitchen Sink 33" x 22" | Stainless Steel | Mixing Faucet w/hand spray | ---- | 1/2" | 1/2" | --- | 1 1/2" | 1 1/2" |
| SK-3 | Hand Sink 15" x 15" size | Stainless Steel | Mixing Faucet | ---- | 1/2" | 1/2" | --- | 1 1/2" | 1 1/2" |
| MSB-1 | Mop Basin 24" x 24" Size | Molded Stone | Service Faucet w/hose | ---- | 1/2" | 1/2" | --- | 3" | 1 1/2" |
| MSB-2 | Mop Basin 24" x 36" Size | Molded Stone | Service Faucet w/hose | ---- | 1/2" | 1/2" | --- | 3" | 1 1/2" |
| EWC-1 | HCP Electric Water Cooler | Stainless Steel | - | Mount at HCP Height | 1/2" | --- | --- | 1 1/2" | 1 1/2" |
| SH-1 | Shower Valve & Head | C.P. Brass | Mixing Valve | Includes floor Drain | 1/2" | 1/2" | --- | FD-1 | ---- |
| SH-2 | HCP Shower Valve & Head | C.P. Brass | Mixing Valve & Hand Hose | Includes floor Drain | 1/2" | 1/2" | --- | FD-1 | ---- |
| SS-2 | Wall Hung Service Sink | Cast Iron | Service Faucet | Point of use electric water heater 7" Aff. | --- | --- | --- | 3/4" | 3" |
| EEWS | Pedestal Emergency Shower & Eye Wash | ABS Plastic | Stay Open Valve Assembly | Includes Floor Drain & Tempered Water | 1" | 1/2" Temp. | --- | --- | ---- |
| DH-1 | Deck Hydrant | Bronze | Vacuum Breaker | ---- | --- | --- | --- | 3/4" | ---- |
| NFHB-1 | Non Freeze Hose Bibb Wall Hydrant | Bronze Valve Stainless Steel Box | Vacuum Breaker | Nom. 3' Above Grade | --- | --- | --- | 3/4" | ---- |
| NFHB-2 | Non Freeze Hose Bibb Wall Hydrant | Bronze Valve Stainless Steel Box | Vacuum Breaker | Nom. 3' Above FFE | --- | --- | --- | 1 1/2" | ---- |
| HB-1 | Hose Bibb | C.P. Bronze | Vacuum Breaker | Nom. 24" Aff. | 3/4" | --- | --- | --- | ---- |
| HB-2 | Plant Hose Bibb | Hose End Threaded Ball Valve | Cap & Chain | Nom. 3' Aff. | --- | --- | --- | 1" | ---- |
| FD-1 | 7" Diameter | Nickle Bronze | - | ---- | --- | --- | --- | 3" or 4" | 1 1/2" or 2" |
| FD-2 | 7" Diameter | Nickle Bronze | Funnel | For Indirect Waste | --- | --- | --- | 3" or 4" | 1 1/2" or 2" |
| FD-3 | 11" Diameter | Coated Cast Iron | - | ---- | --- | --- | --- | 4" | 1 1/2" or 2" |
| FD-4 | 11" Diameter | Coated Cast Iron | Funnel | For Indirect Waste | --- | --- | --- | 4" | 1 1/2" or 2" |
| FD-5 | 11" Diameter | Coated Cast Iron | Sediment Bracket | ---- | --- | --- | --- | 4" | 1 1/2" or 2" |



RECORD DRAWING
 THESE DRAWINGS HAVE BEEN REVISED TO REFLECT MAJOR CHANGES, IF ANY, WHICH OCCURRED DURING CONSTRUCTION. REVISIONS ARE BASED UPON INFORMATION SUPPLIED BY CONTRACTOR.
 DATE: _____ PER: _____

THIS DRAWING WAS PREPARED AT THE SCALE INDICATED IN THE TITLE BLOCK. INACCURACIES IN THE STATED SCALE MAY BE INTRODUCED WHEN DRAWINGS ARE REPRODUCED BY ANY MEANS. USE THE GRAPHIC SCALE BAR IN THE TITLE BLOCK TO DETERMINE THE ACTUAL SCALE OF THIS DRAWING.

06/27/01 RAB AJK/FJS
 0659P002

| | | | | |
|----------|-----|---------|---------------------|------|
| NO SCALE | No. | Date | Revisions | Init |
| | 0 | 4/20/01 | ISSUED FOR APPROVAL | |
| | 1 | | AS BID | |
| | 3 | 1/05 | FOR RECORD | |

In charge of FJS
 Designed by FJS
 Drawn by AJK
 Checked by FJS

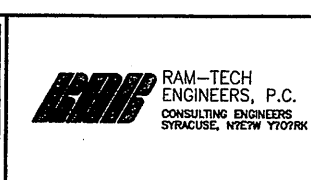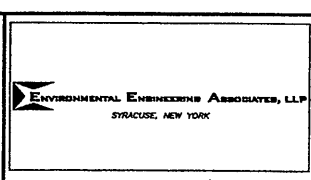


ONONDAGA COUNTY • DEPARTMENT OF DRAINAGE AND SANITATION • SYRACUSE, NEW YORK
 METROPOLITAN SYRACUSE WASTEWATER TREATMENT PLANT
 STAGE III AMMONIA AND STAGE II PHOSPHORUS REMOVAL PROJECT

| | |
|-------------|------------|
| File Number | 00659 |
| Date | APRIL 2001 |
| | P-002 |

SCHEDULES/SCHEMATICS

PLUMBING

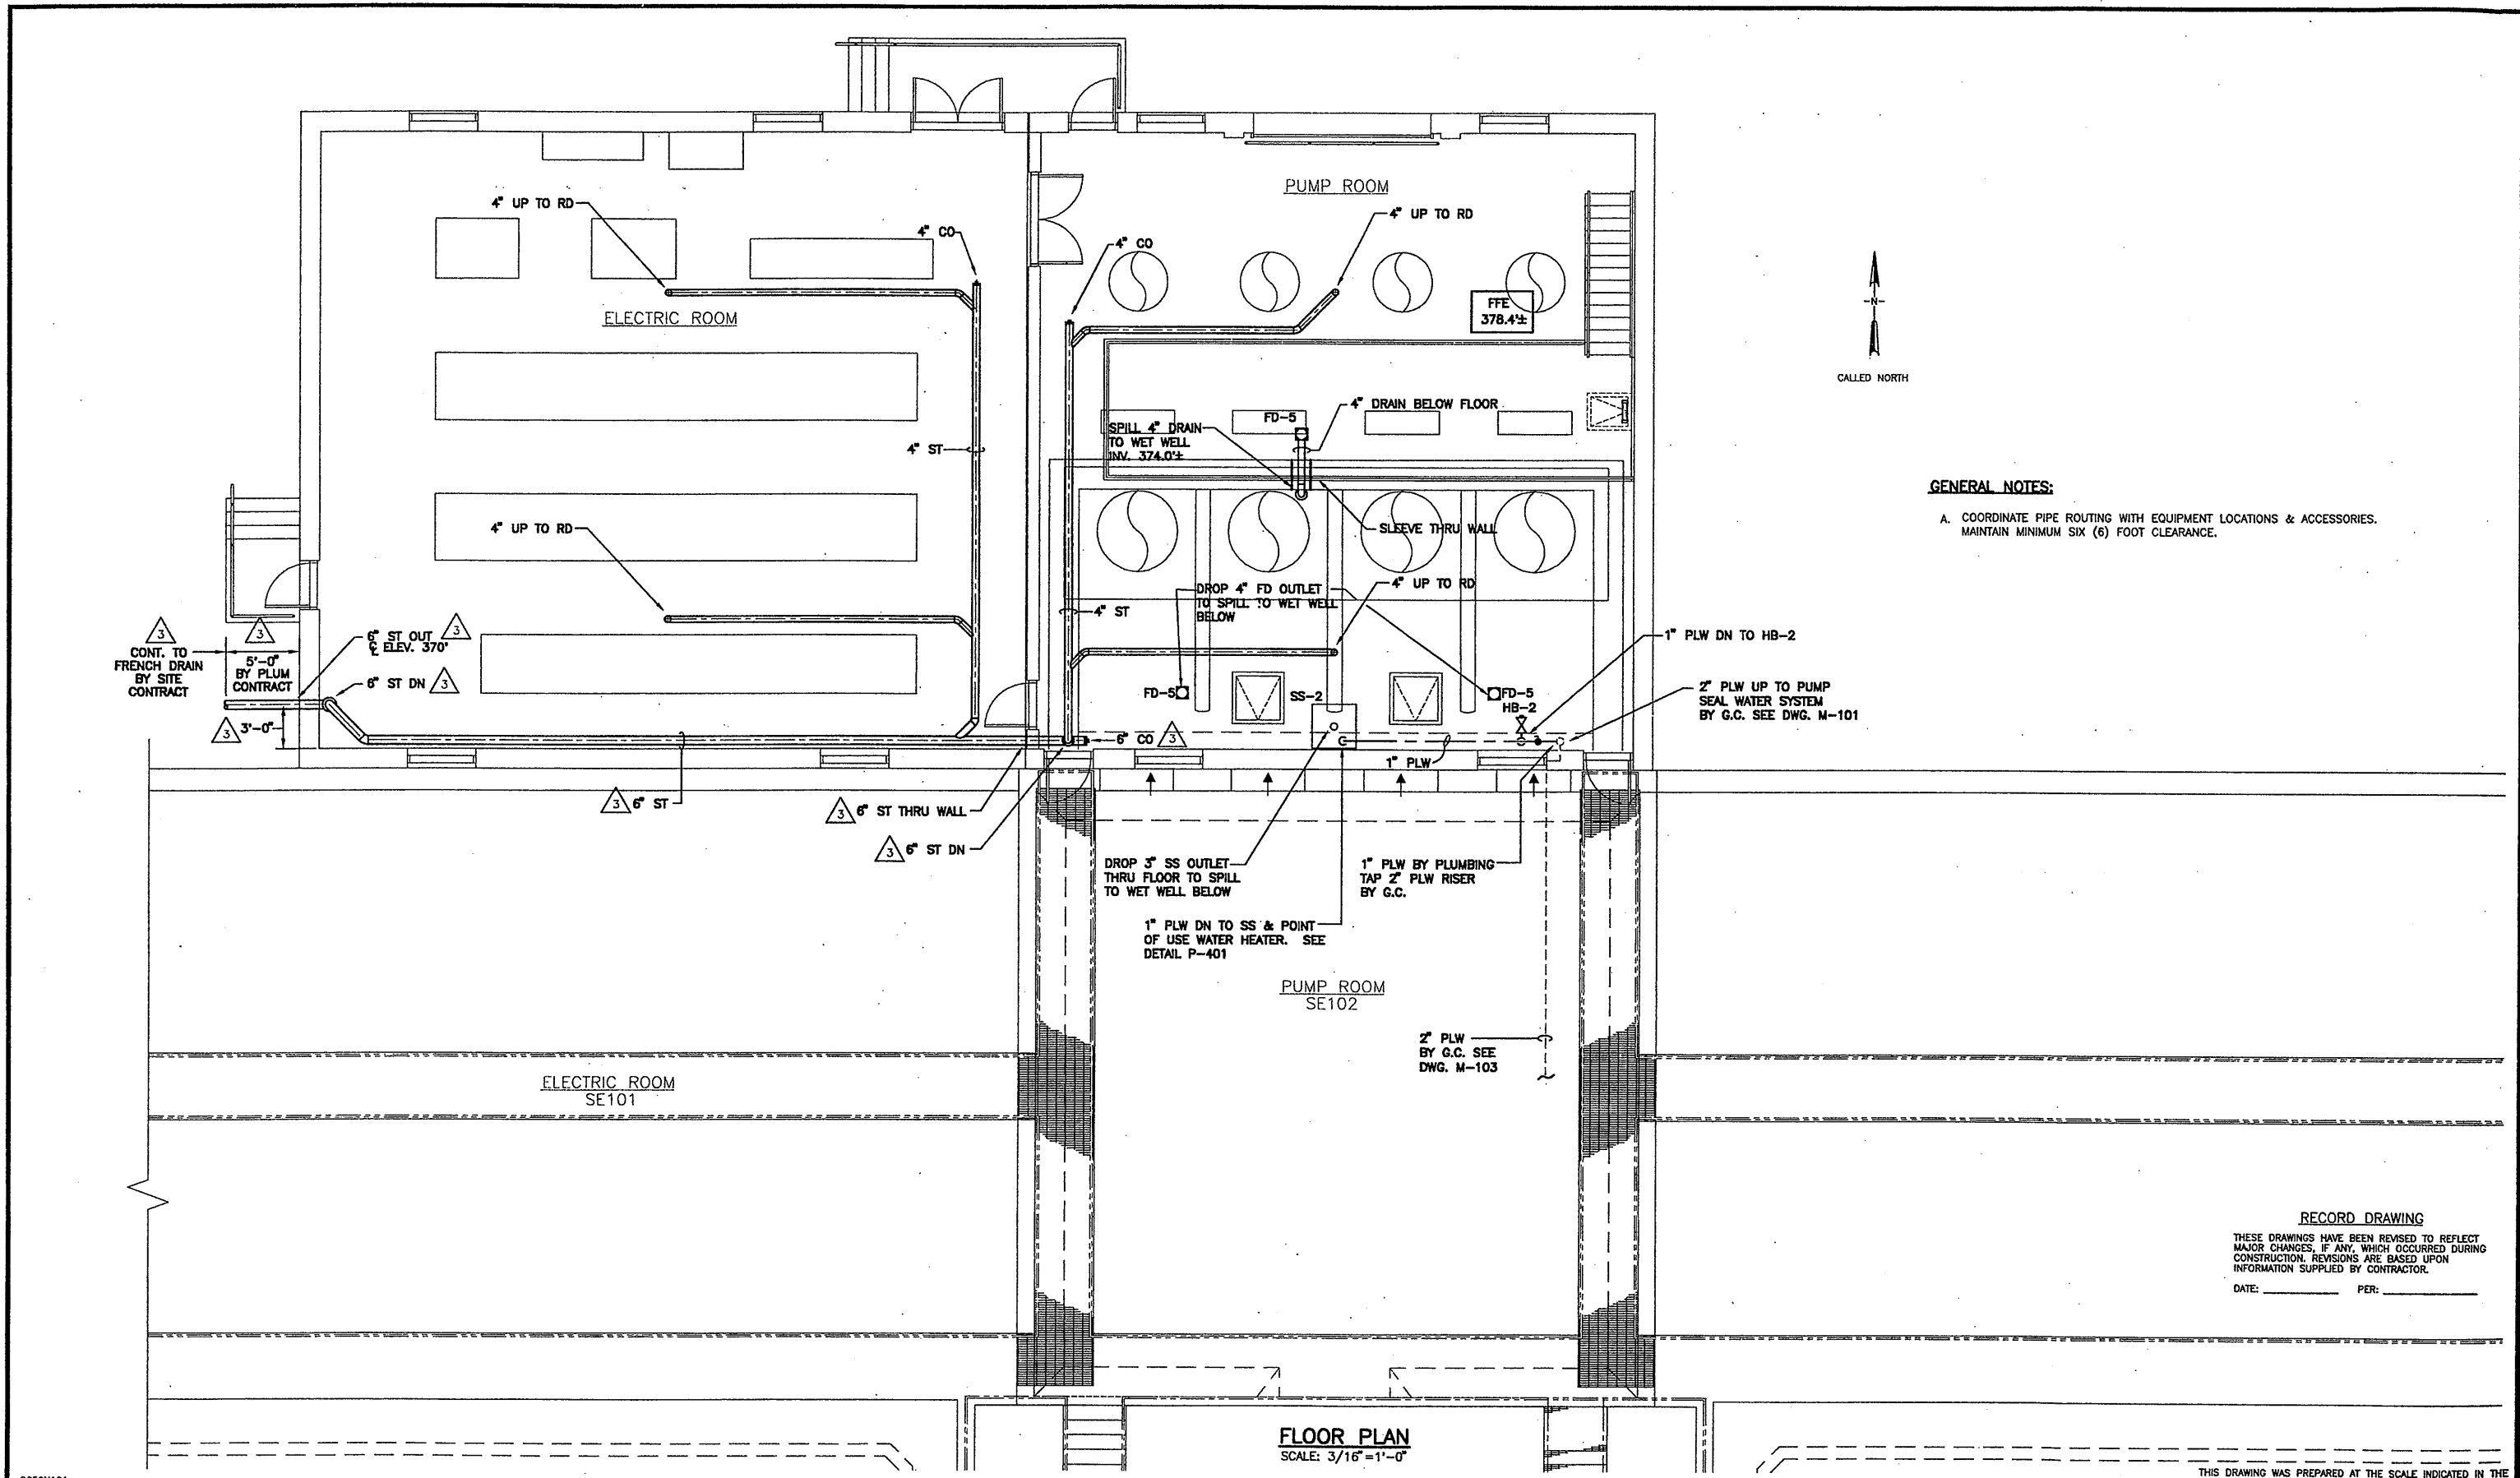

GENERAL NOTES:

A. COORDINATE PIPE ROUTING WITH EQUIPMENT LOCATIONS & ACCESSORIES. MAINTAIN MINIMUM SIX (6) FOOT CLEARANCE.

RECORD DRAWING

THESE DRAWINGS HAVE BEEN REVISED TO REFLECT MAJOR CHANGES, IF ANY, WHICH OCCURRED DURING CONSTRUCTION. REVISIONS ARE BASED UPON INFORMATION SUPPLIED BY CONTRACTOR.

DATE: _____ PER: _____

FLOOR PLAN
SCALE: 3/16"=1'-0"

0659X101
06/27/01 RAB AJK/FJS
0659P101

NO ALTERATIONS PERMITTED HEREON EXCEPT AS PROVIDED UNDER SECTION 7209 SUBDIVISION 2 OF THE NEW YORK STATE EDUCATION LAW

| No. | Date | Revisions | Init |
|-----|----------|---------------------------------|------|
| 0 | 4/20/01 | ISSUED FOR APPROVAL | |
| 1 | | AS BID | |
| 2 | 10/18/01 | ROOF DRAINAGE | |
| 3 | 3/22/02 | REVISED FOR MODIFICATION 4D-001 | |
| 4 | 1/05 | FOR RECORD | |

In charge of **FJS**
Designed by **FJS**
Drawn by **AJK**
Checked by **FJS**

ENVIRONMENTAL ENGINEERS ASSOCIATES, LLP
SYRACUSE, NEW YORK



RAM-TECH ENGINEERS, P.C.
CONSULTING ENGINEERS
SYRACUSE, NEW YORK

ONONDAGA COUNTY • DEPARTMENT OF DRAINAGE AND SANITATION • SYRACUSE, NEW YORK
METROPOLITAN SYRACUSE WASTEWATER TREATMENT PLANT
STAGE III AMMONIA AND STAGE II PHOSPHORUS REMOVAL PROJECT
SECONDARY EFFLUENT PUMPING STATION FLOOR PLAN

File Number
00659
Date
APRIL 2001

P-101

CALLED NORTH

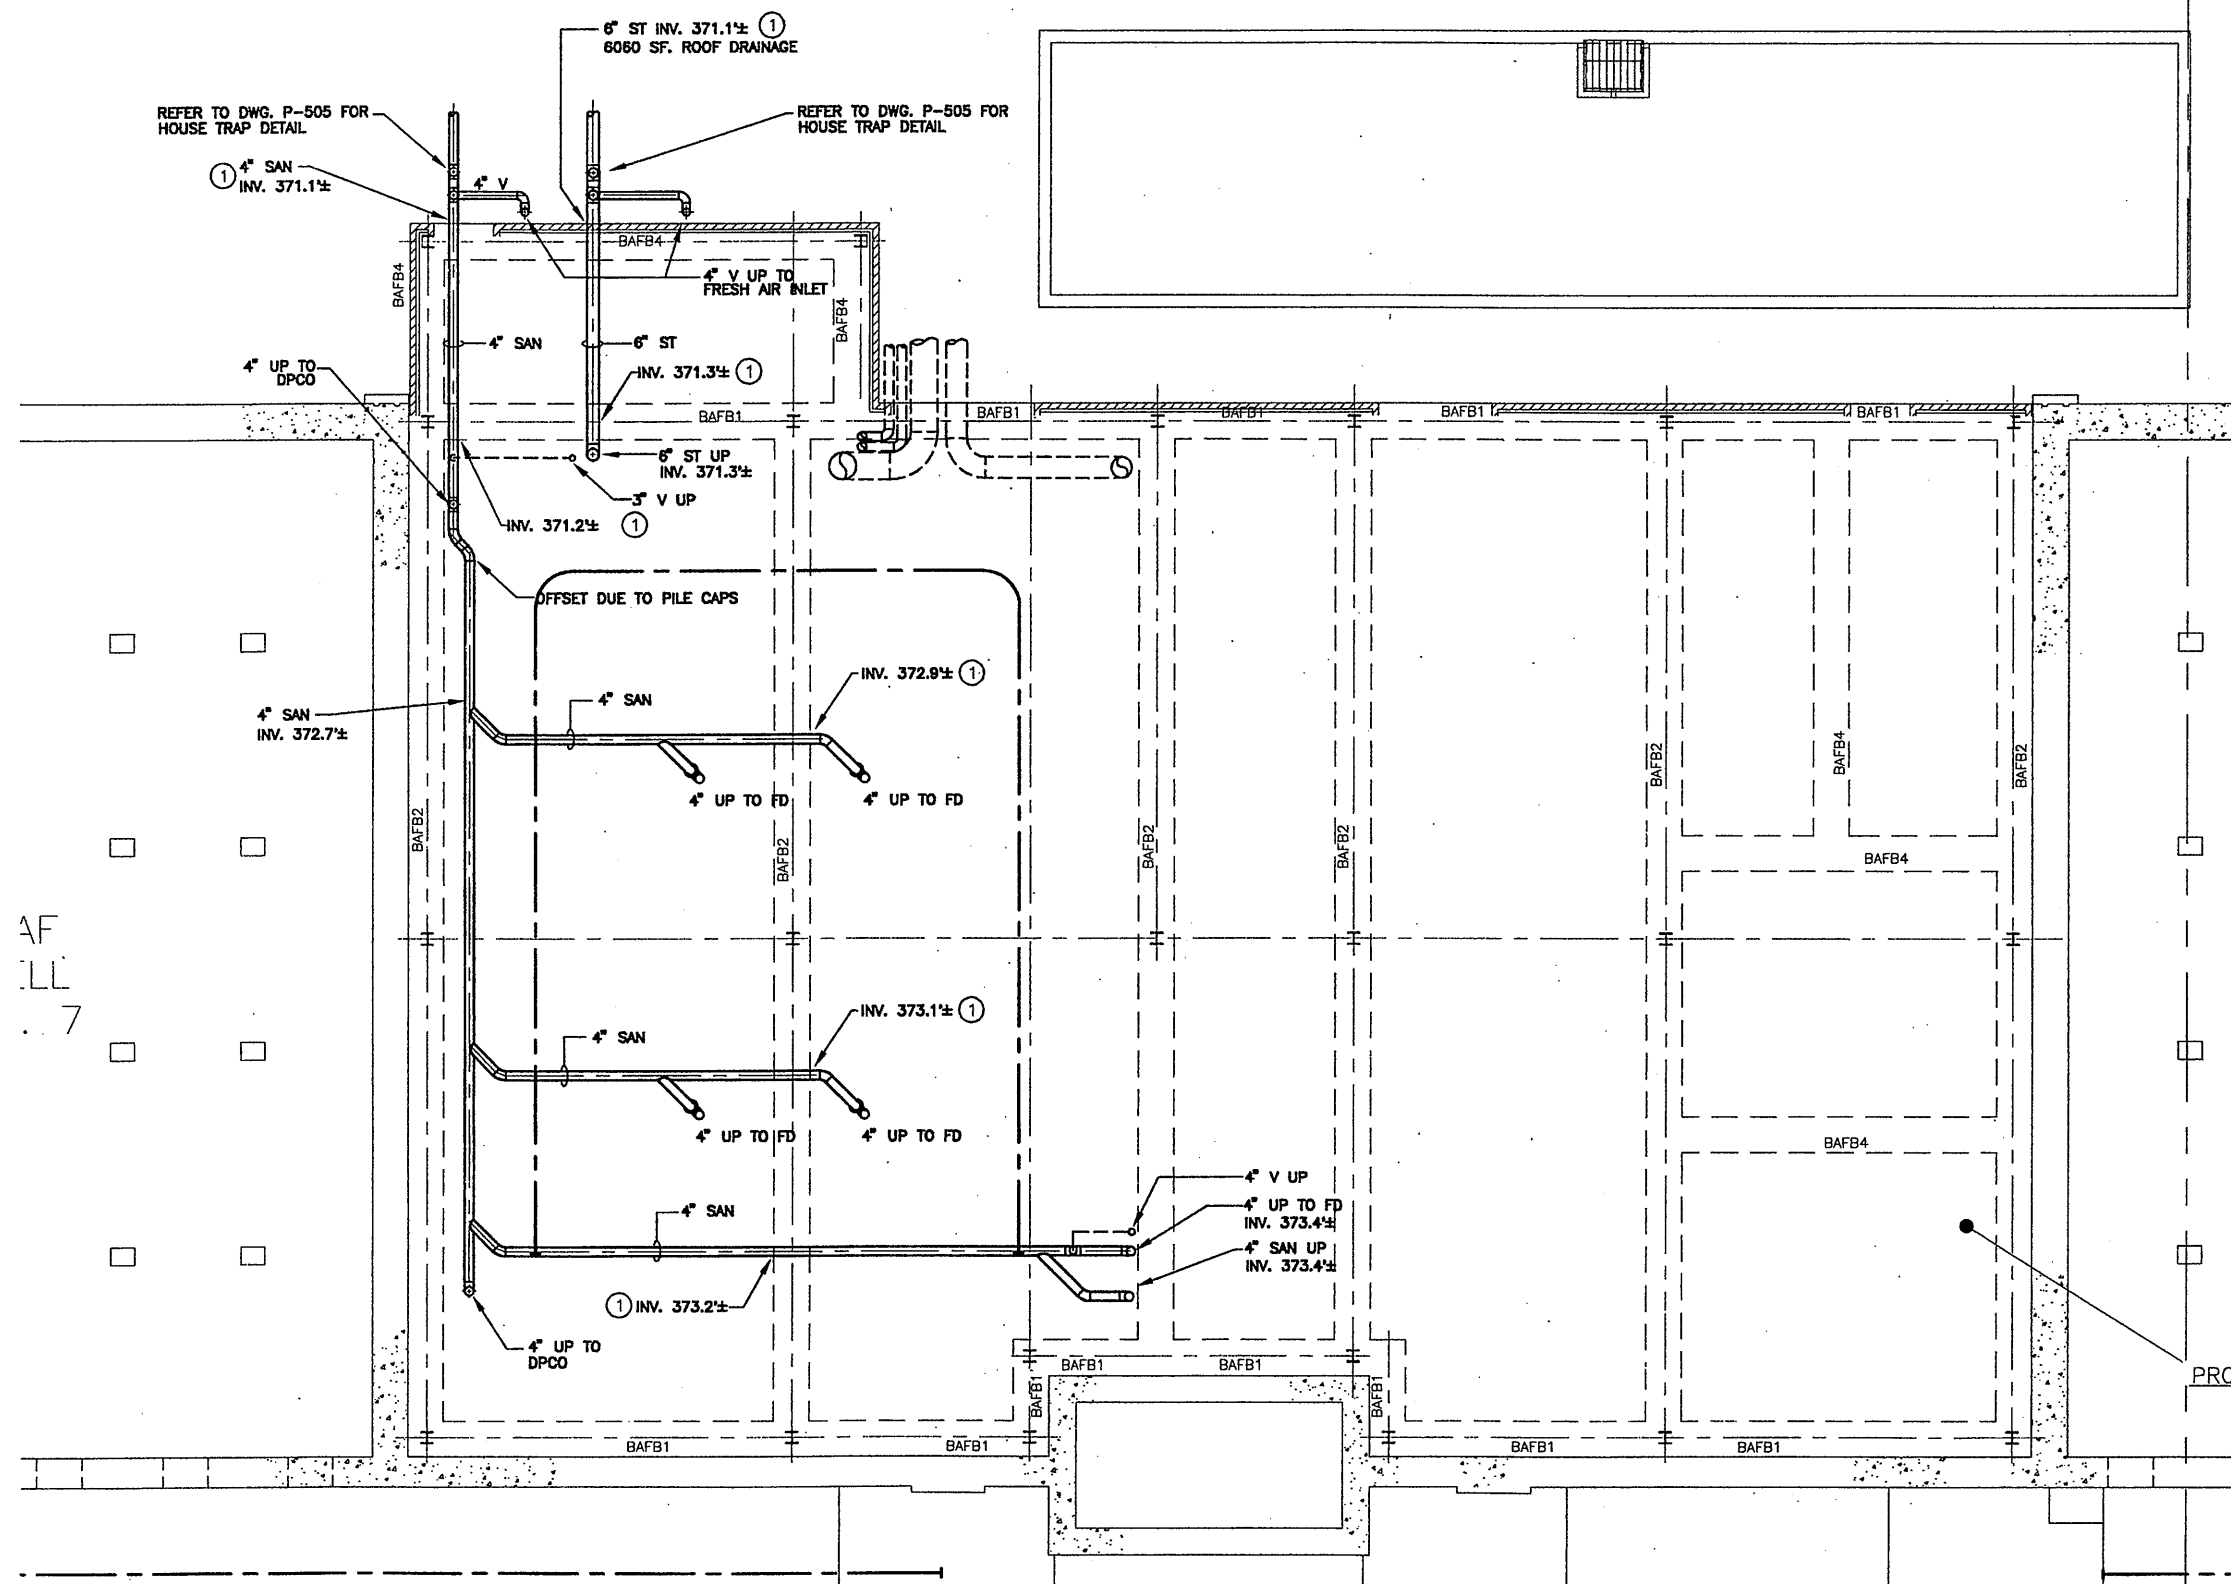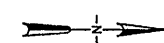

AF
ILL
7

GENERAL NOTES:

A. PIPING INVERTS ARE PER APPROXIMATELY ±1/2" NOMINAL CONSTRUCTION TOLERANCES & ARE BASED ON 1ST FLOOR ELEVATION OF 375.38'. VERIFY ALL FIELD CONDITIONS BEFORE STARTING WORK.

KEYED NOTES: #

- SLEEVE ALL GRADE BEAM PENETRATIONS. PROVIDE SLEEVES ALONG CENTERLINE OF PIPING PENETRATION. SIZE SLEEVE AS FOLLOWS:
 - 4" ST; USE 8" SLEEVE
 - 6" ST; USE 10" SLEEVE

RECORD DRAWING

THESE DRAWINGS HAVE BEEN REVISED TO REFLECT MAJOR CHANGES, IF ANY, WHICH OCCURRED DURING CONSTRUCTION. REVISIONS ARE BASED UPON INFORMATION SUPPLIED BY CONTRACTOR.

DATE: _____ PER: _____



THIS DRAWING WAS PREPARED AT THE SCALE INDICATED IN THE TITLE BLOCK. INACCURACIES IN THE STATED SCALE MAY BE INTRODUCED WHEN DRAWINGS ARE REPRODUCED BY ANY MEANS. USE THE GRAPHIC SCALE BAR IN THE TITLE BLOCK TO DETERMINE THE ACTUAL SCALE OF THIS DRAWING.

0659X201
05/27/01 RAB AJK/FJS
0659P200

NO ALTERATIONS PERMITTED HEREON EXCEPT AS PROVIDED UNDER SECTION 7209 SUBDIVISION 2 OF THE NEW YORK STATE EDUCATION LAW

| No. | Date | Revisions | Init |
|-----|------|------------|------|
| 0 | | AS BID | |
| 1 | 1/05 | FOR RECORD | |

In charge of FJS
 Designed by FJS
 Drawn by AJK
 Checked by FJS

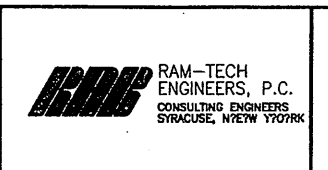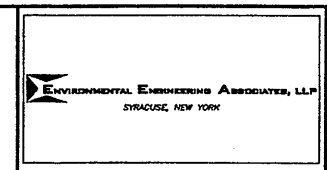



ONONDAGA COUNTY • DEPARTMENT OF DRAINAGE AND SANITATION • SYRACUSE, NEW YORK
 METROPOLITAN SYRACUSE WASTEWATER TREATMENT PLANT
 STAGE III AMMONIA AND STAGE II PHOSPHORUS REMOVAL PROJECT
BIOLOGICAL AERATED FILTERS (BAF) COMPLEX
FOUNDATION PLAN

PLUMBING

File Number
00659

Date
JULY 2001

P-200

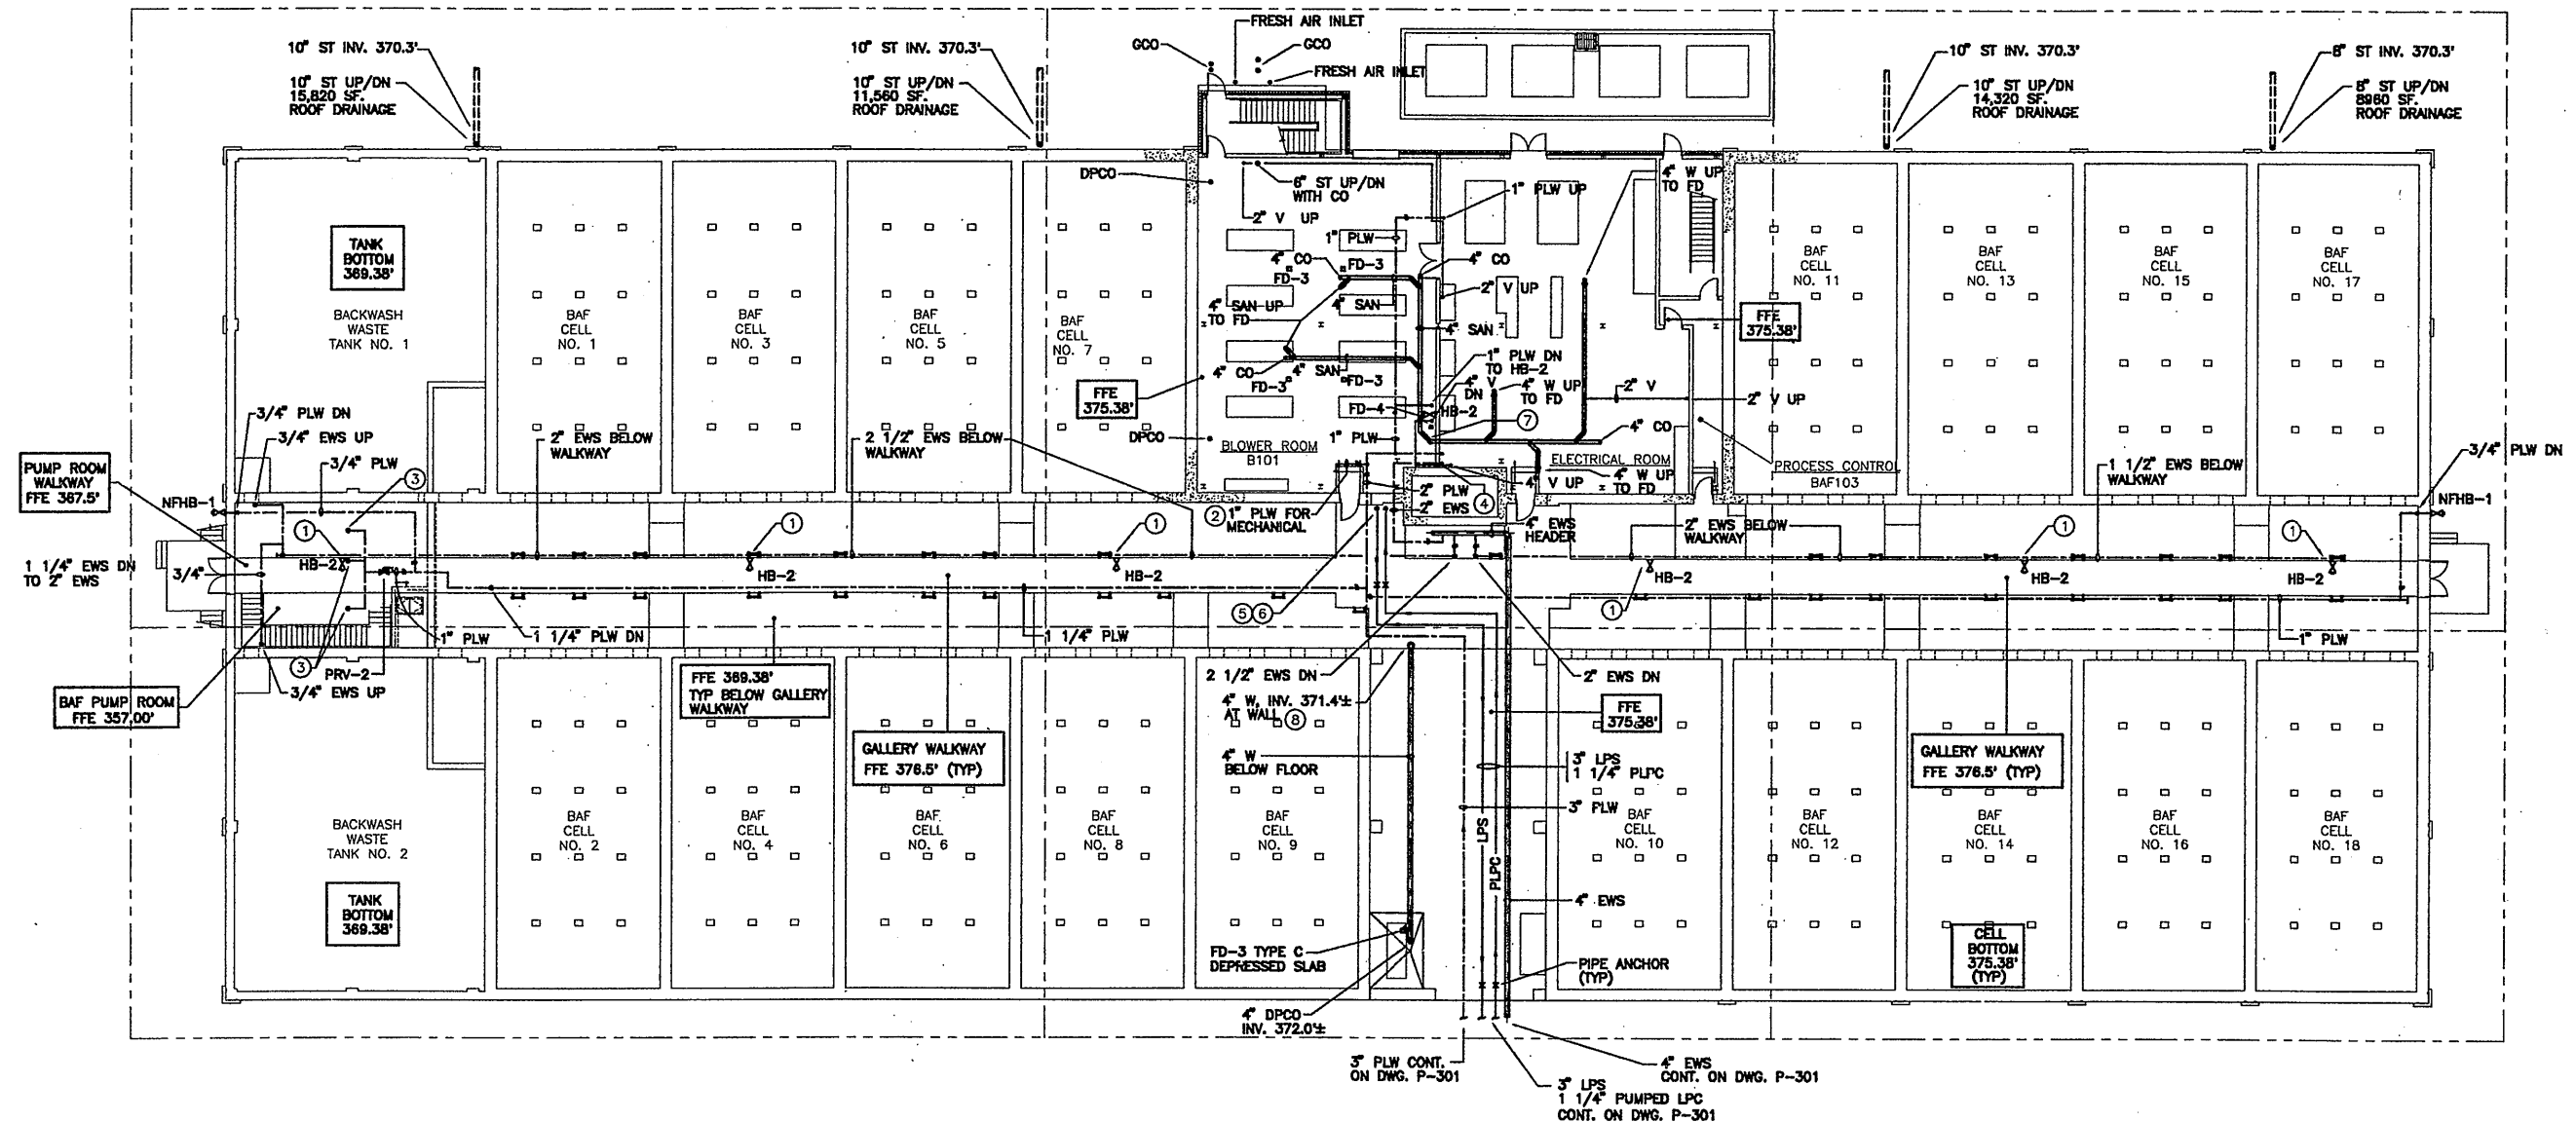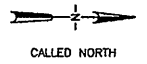

FIRST FLOOR PLAN
SCALE: 1/16" = 1'-0"

- KEYED NOTES:** ①
- CONNECT 1" EFFLUENT WATER (EWS) TO HB-2. LOCATE HOSE BIBB AT WALKWAY HANDRAIL. INSTALL HOSE END OUTLET OF HOSE BIBB ± 6" BELOW TOP RAIL OF WALKWAY HANDRAIL.
 - CAP 1" PLW STUB FOR CONTINUATION BY OTHERS.
 - CONNECT 3/4" PLANT WATER (PLW) WITH SHUTOFF VALVE TO SEAL WATER SYSTEM CONNECTION AT BACKWASH WASTE TRANSFER PUMPS.
 - 2" EWS UP TO DRAINDOWN SYSTEM, AND 1" PLW UP TO SAMPLING AREA.
 - DROP 1 1/4" PUMPED LPC (PLPC) TO CONNECT TO LPC MAIN TAP BY HVAC, SEE DWG. H-201.
 - DROP 3" LPS TO CONNECT TO LPS MAIN TAP BY HVAC. SEE DWG. H-201.
 - 4" SAN DN, CONTINUED ON DWG. P-200.
 - SPILL 4" W WITH DOWNTURNED ELBOW TO TRENCH DRAIN AT GALLERY FLOOR. AVOID PROCESS AIR PIPING.

RECORD DRAWING
THESE DRAWINGS HAVE BEEN REVISED TO REFLECT MAJOR CHANGES, IF ANY, WHICH OCCURRED DURING CONSTRUCTION. REVISIONS ARE BASED UPON INFORMATION SUPPLIED BY CONTRACTOR.
DATE: _____ PER: _____

THIS DRAWING WAS PREPARED AT THE SCALE INDICATED IN THE TITLE BLOCK. INACCURACIES IN THE STATED SCALE MAY BE INTRODUCED WHEN DRAWINGS ARE REPRODUCED BY ANY MEANS. USE THE GRAPHIC SCALE BAR IN THE TITLE BLOCK TO DETERMINE THE ACTUAL SCALE OF THIS DRAWING.

0659X201
06/27/01 RAB AJK/FJS
0659P201

1/16" = 1'-0"
NO ALTERATIONS PERMITTED HEREON EXCEPT AS PROVIDED UNDER SECTION 7209 SUBDIVISION 2 OF THE NEW YORK STATE EDUCATION LAW

| No. | Date | Revisions | Init |
|-----|---------|---------------------|------|
| 0 | 4/20/01 | ISSUED FOR APPROVAL | |
| 1 | | AS BID | |
| 3 | 1/05 | FOR RECORD | |

In charge of FJS
Designed by FJS
Drawn by AJK
Checked by FJS



ENVIRONMENTAL ENGINEERS ASSOCIATES, LLP
SYRACUSE, NEW YORK

RAM-TECH ENGINEERS, P.C.
CONSULTING ENGINEERS
SYRACUSE, NEW YORK

ONONDAGA COUNTY • DEPARTMENT OF DRAINAGE AND SANITATION • SYRACUSE, NEW YORK
METROPOLITAN SYRACUSE WASTEWATER TREATMENT PLANT
STAGE III AMMONIA AND STAGE II PHOSPHORUS REMOVAL PROJECT
BIOLOGICAL AERATED FILTERS (BAF) COMPLEX
FIRST FLOOR PLAN

| | |
|----------------------|--------------|
| File Number 00659 | P-201 |
| Date APRIL 2001 | |

PLUMBING

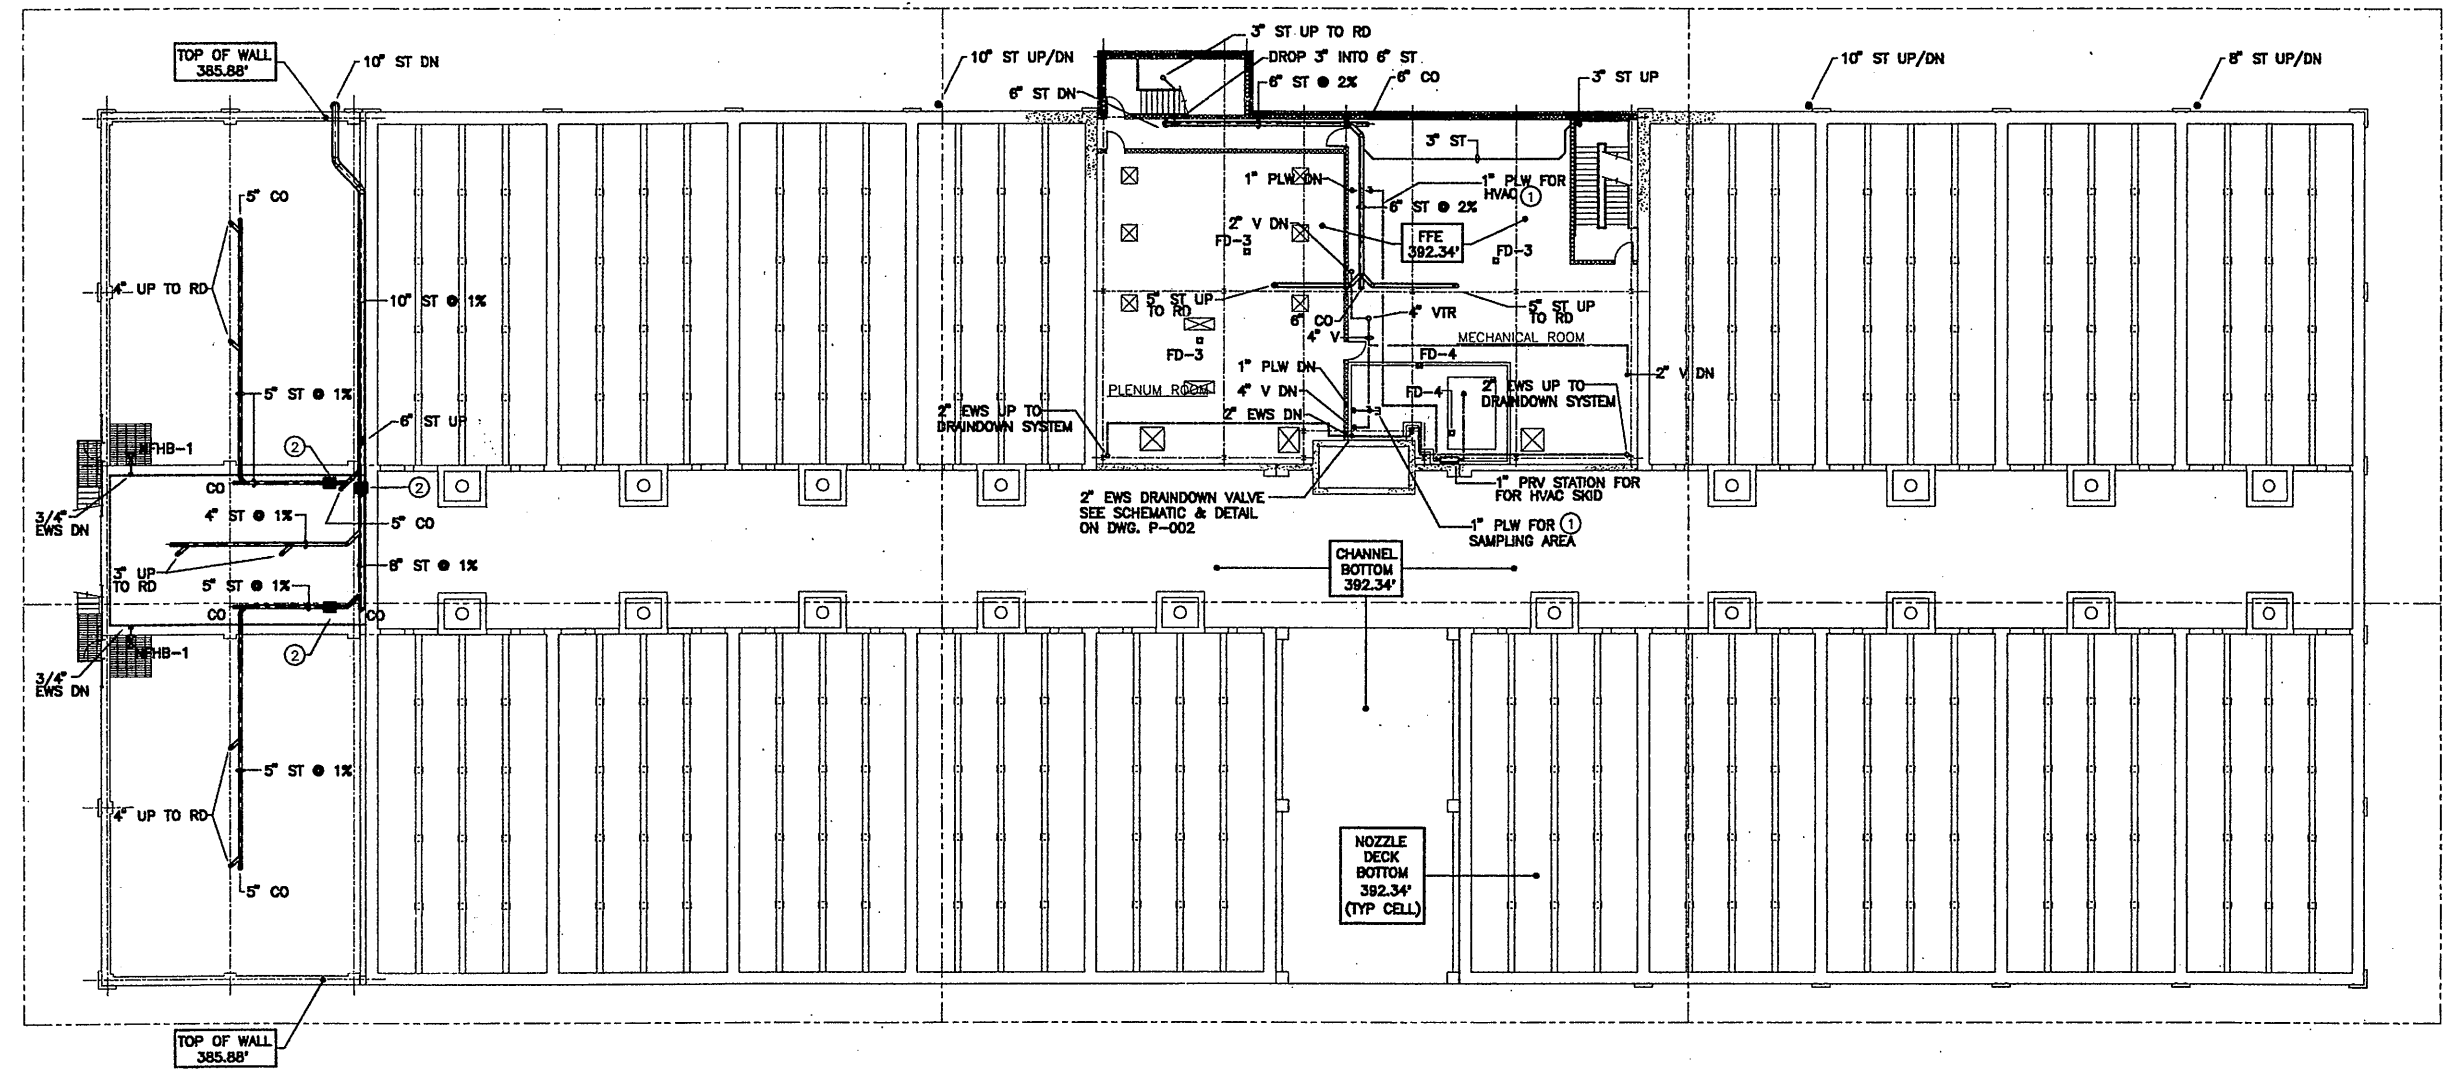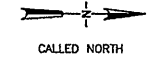

SECOND FLOOR PLAN
SCALE: 1/16" = 1'-0"

KEYED NOTES: #

1. CAP 1" PLW STUB FOR CONTINUATION BY OTHERS.
2. HEAT TRACING SECTION ELECTRIC THERMOSTAT & ACCESSORIES PER SPEC.

RECORD DRAWING

THESE DRAWINGS HAVE BEEN REVISED TO REFLECT MAJOR CHANGES, IF ANY, WHICH OCCURRED DURING CONSTRUCTION. REVISIONS ARE BASED UPON INFORMATION SUPPLIED BY CONTRACTOR.

DATE: _____ PER: _____



THIS DRAWING WAS PREPARED AT THE SCALE INDICATED IN THE TITLE BLOCK. INACCURACIES IN THE STATED SCALE MAY BE INTRODUCED WHEN DRAWINGS ARE REPRODUCED BY ANY MEANS. USE THE GRAPHIC SCALE BAR IN THE TITLE BLOCK TO DETERMINE THE ACTUAL SCALE OF THIS DRAWING.

0659X202
06/27/01 RAB AJK/FJS
0659P202

NO ALTERATIONS PERMITTED HEREON EXCEPT AS PROVIDED UNDER SECTION 7209 SUBDIVISION 2 OF THE NEW YORK STATE EDUCATION LAW

| No. | Date | Revisions | Init |
|-----|---------|---------------------|------|
| 0 | 4/20/01 | ISSUED FOR APPROVAL | |
| 1 | | AS BID | |
| 3 | 1/05 | FOR RECORD | |

In charge of FJS
Designed by FJS
Drawn by AJK
Checked by FJS

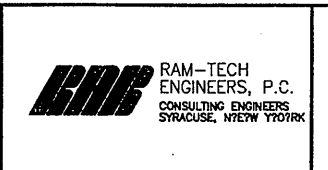
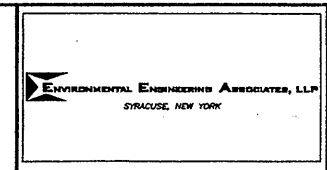


ONONDAGA COUNTY • DEPARTMENT OF DRAINAGE AND SANITATION • SYRACUSE, NEW YORK
METROPOLITAN SYRACUSE WASTEWATER TREATMENT PLANT
STAGE III AMMONIA AND STAGE II PHOSPHORUS REMOVAL PROJECT
BIOLOGICAL AERATED FILTERS (BAF) COMPLEX
SECOND FLOOR PLAN

PLUMBING

| |
|----------------------|
| File Number 00659 |
| Date APRIL 2001 |

P-202

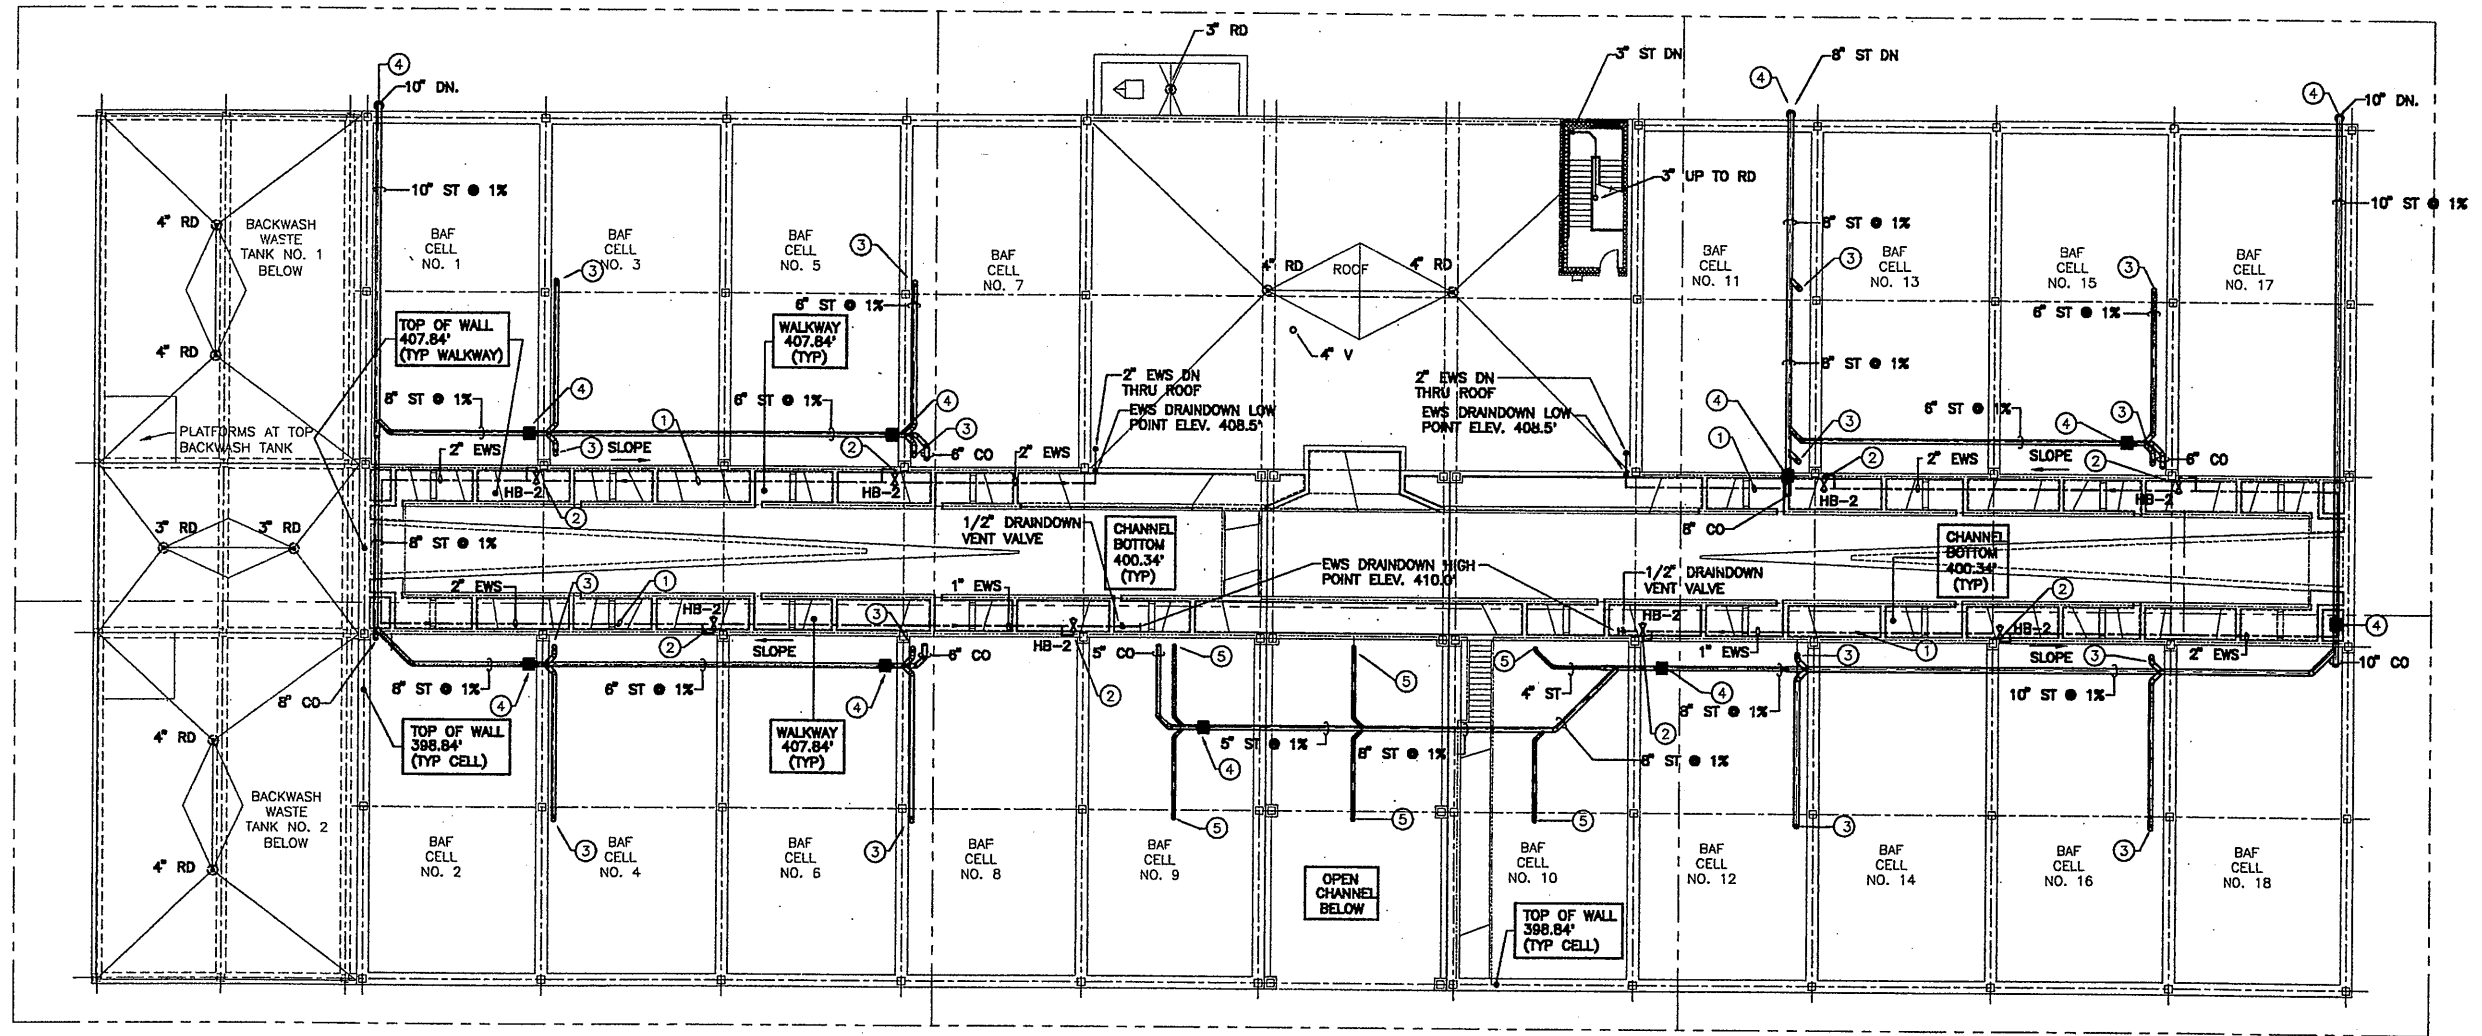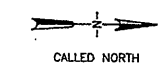

UPPER LEVEL PLAN
SCALE: 1/16" = 1'-0"

KEYED NOTES: #

1. RUN EXPOSED DRAINDOWN EWS PIPING AT SLOPE PER DRAWING BACK TO RISER.
2. CONNECT 1" EWS TO HB-2. LOCATE HOSE BIBB AT WALKWAY HANDRAIL. INSTALL HOSE END OUTLET OF HOSE BIBB ±6" BELOW TOP OF HANDRAIL.
3. 6" ST UP TO ROOF DRAIN.
4. HEAT TRACING SECTION ELECTRIC CIRCUIT CONNECTION WITH THERMOSTAT & ACCESSORIES PER SPEC.
5. 4" ST UP TO ROOF DRAIN.
6. 6" ST

RECORD DRAWING

THESE DRAWINGS HAVE BEEN REVISED TO REFLECT MAJOR CHANGES, IF ANY, WHICH OCCURRED DURING CONSTRUCTION. REVISIONS ARE BASED UPON INFORMATION SUPPLIED BY CONTRACTOR.

DATE: _____ PER: _____


THIS DRAWING WAS PREPARED AT THE SCALE INDICATED IN THE TITLE BLOCK. INACCURACIES IN THE STATED SCALE MAY BE INTRODUCED WHEN DRAWINGS ARE REPRODUCED BY ANY MEANS. USE THE GRAPHIC SCALE BAR IN THE TITLE BLOCK TO DETERMINE THE ACTUAL SCALE OF THIS DRAWING.

0569X203
06/27/01 RAB AJK/FJS
0569P203

NO ALTERATIONS PERMITTED HEREON EXCEPT AS PROVIDED UNDER SECTION 7209 SUBDIVISION 2 OF THE NEW YORK STATE EDUCATION LAW

| No. | Date | Revisions | Init |
|-----|---------|---------------------------------|------|
| 0 | 4/20/01 | ISSUED FOR APPROVAL | |
| 1 | | AS BID | |
| 2 | 3/25/03 | REVISED FOR REVIEW | |
| 3 | 4/9/03 | RFL-17 | |
| 4 | 4/14/03 | REVISED PER MODIFICATION 4D-009 | |
| 5 | 1/05 | FOR RECORD | |



In charge of FJS
Designed by FJS
Drawn by AJK
Checked by FJS

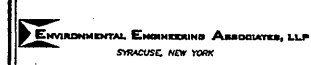

ONONDAGA COUNTY • DEPARTMENT OF DRAINAGE AND SANITATION • SYRACUSE, NEW YORK
METROPOLITAN SYRACUSE WASTEWATER TREATMENT PLANT
STAGE III AMMONIA AND STAGE II PHOSPHORUS REMOVAL PROJECT
BIOLOGICAL AREATED FILTERS (BAF) COMPLEX
UPPER LEVEL PLAN

PLUMBING

File Number
00659
Date
APRIL 2001
P-203

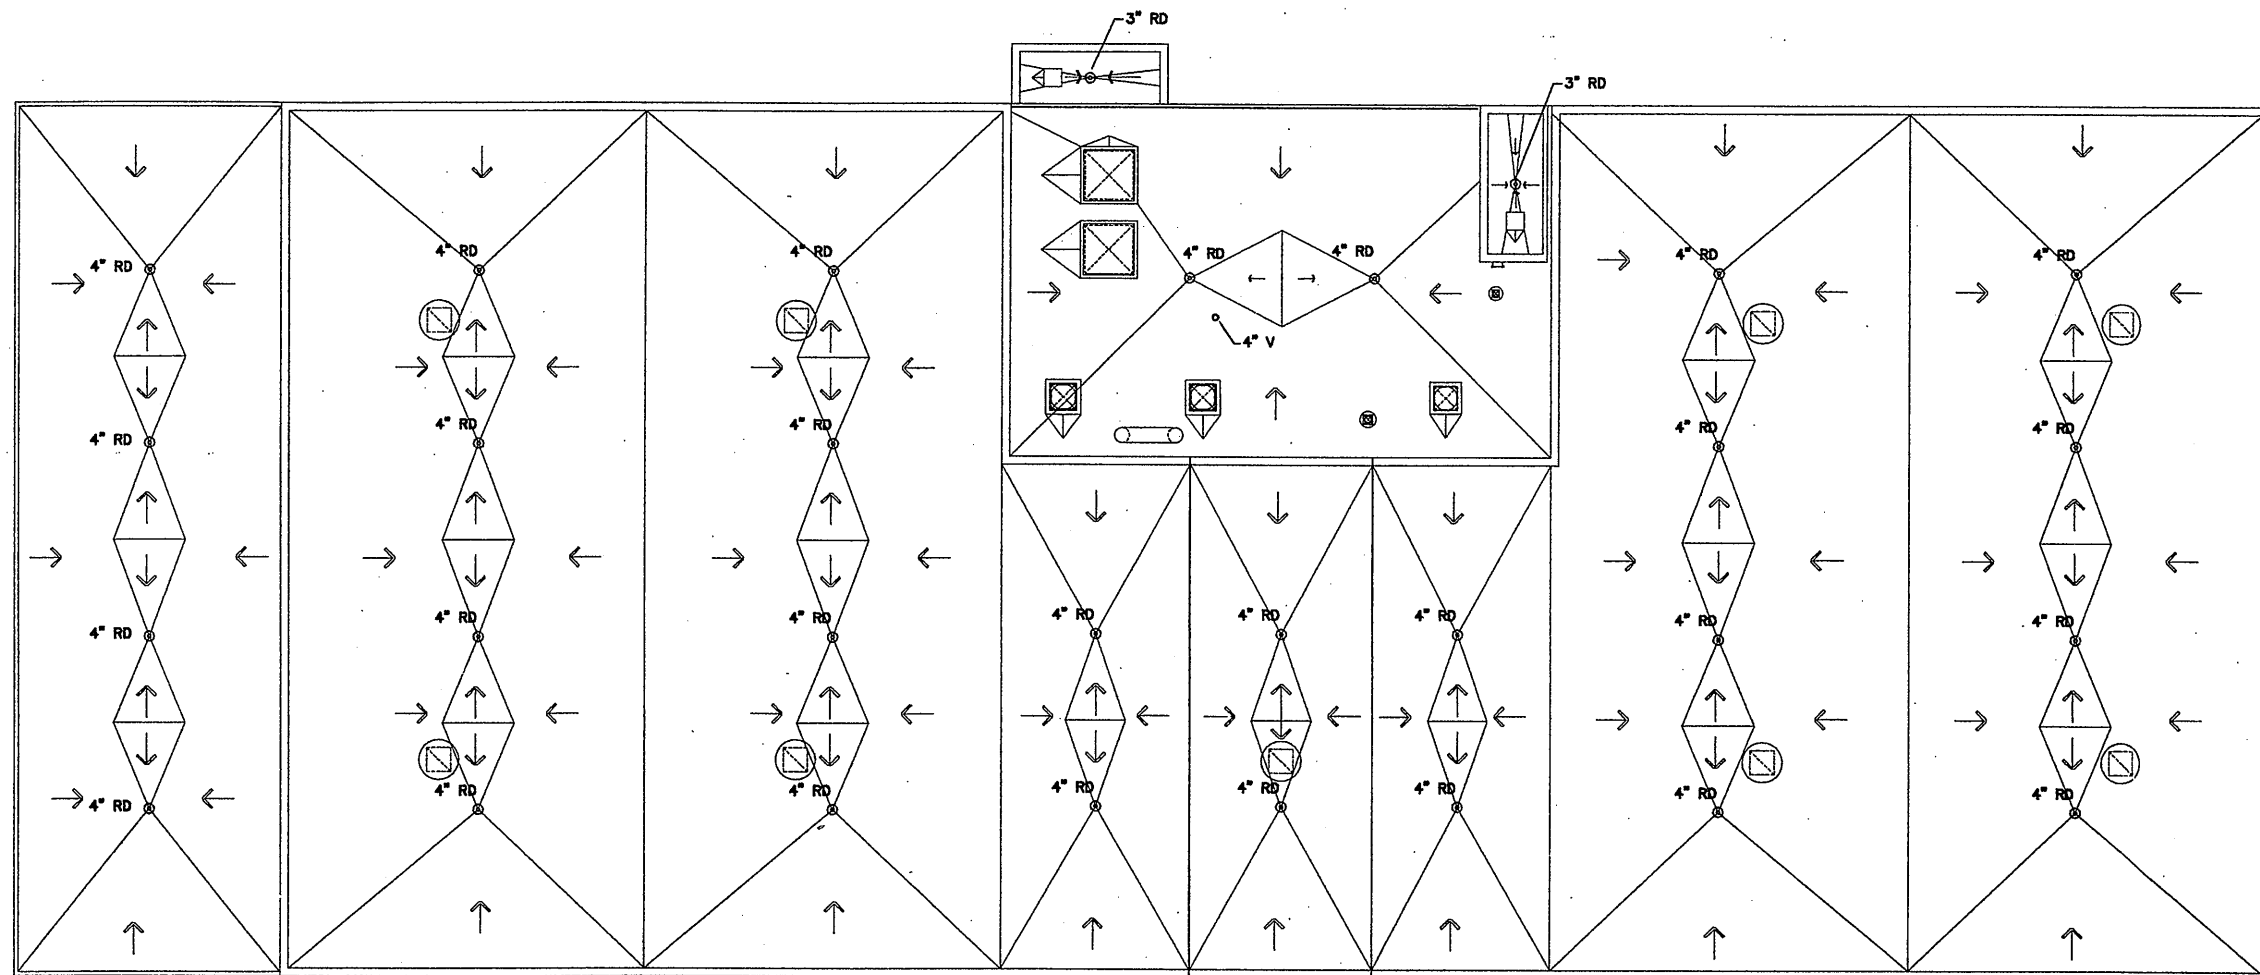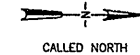

COMPOSITE ROOF PLAN
SCALE: 1/16"=1'-0"

KEYED NOTES: #

1. REFER TO RESPECTIVE GENERAL CONSTRUCTION DRAWINGS FOR ROOF ELEVATIONS.

RECORD DRAWING

THESE DRAWINGS HAVE BEEN REVISED TO REFLECT MAJOR CHANGES, IF ANY, WHICH OCCURRED DURING CONSTRUCTION. REVISIONS ARE BASED UPON INFORMATION SUPPLIED BY CONTRACTOR.



DATE: _____ PER: _____

THIS DRAWING WAS PREPARED AT THE SCALE INDICATED IN THE TITLE BLOCK. INACCURACIES IN THE STATED SCALE MAY BE INTRODUCED WHEN DRAWINGS ARE REPRODUCED BY ANY MEANS. USE THE GRAPHIC SCALE BAR IN THE TITLE BLOCK TO DETERMINE THE ACTUAL SCALE OF THIS DRAWING.

06/27/01 RAB AJK/FJS
0569P204

| No. | Date | Revisions | Init |
|-----|------|------------|------|
| 0 | | AS BID | |
| 1 | 1/05 | FOR RECORD | |
| | | | |
| | | | |
In charge of FJS
Designed by FJS
Drawn by AJK
Checked by FJS

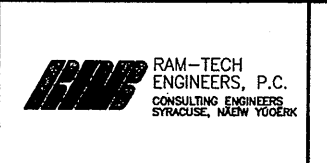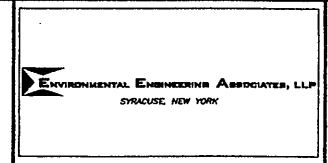




ONONDAGA COUNTY • DEPARTMENT OF DRAINAGE AND SANITATION • SYRACUSE, NEW YORK
METROPOLITAN SYRACUSE WASTEWATER TREATMENT PLANT
STAGE III AMMONIA AND STAGE II PHOSPHORUS REMOVAL PROJECT
BIOLOGICAL AREATED FILTERS (BAF) COMPLEX
COMPOSITE ROOF PLAN

| | |
|----------------------|-------|
| File Number 00659 | P-204 |
| Date JULY 2001 | |
| | |

PLUMBING

NO ALTERATIONS PERMITTED HEREON EXCEPT AS PROVIDED UNDER SECTION 7209 SUBDIVISION 2 OF THE NEW YORK STATE EDUCATION LAW

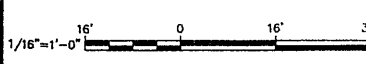

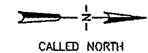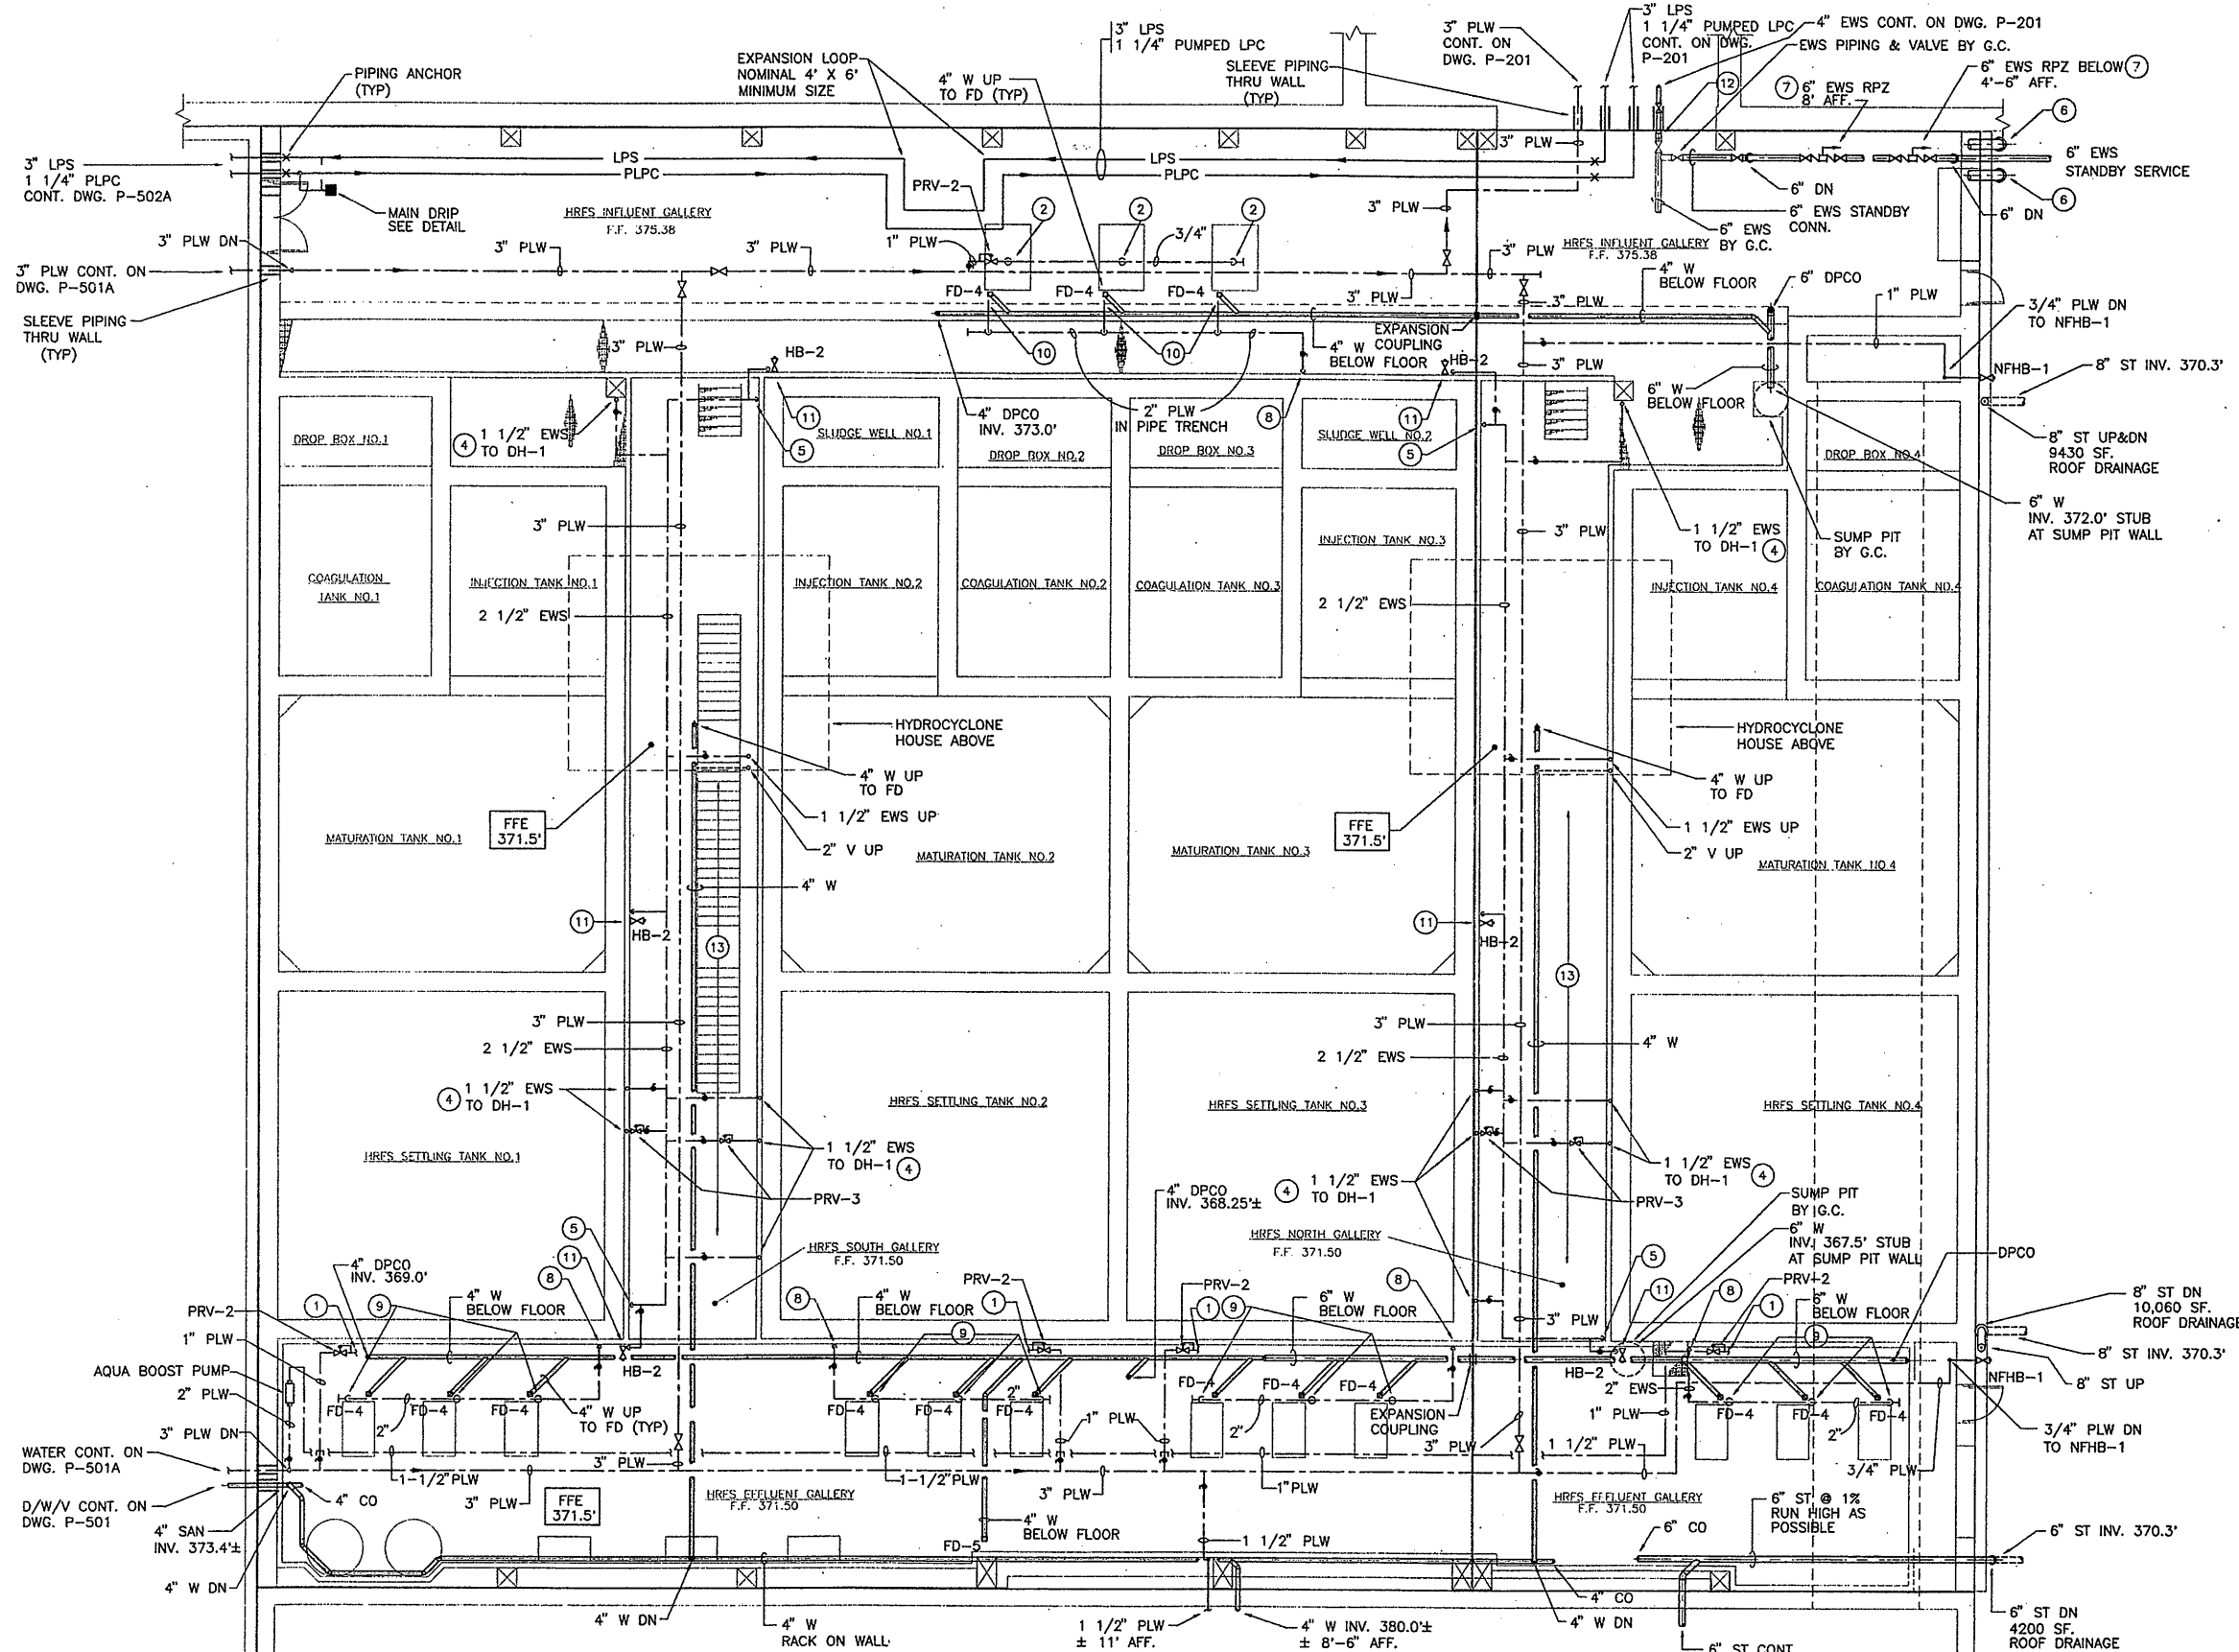

- KEYED NOTES:** #
- CONNECT 3/4" PLANT WATER (PLW) WITH SHUTOFF VALVE TO SEAL WATER SYSTEM CONNECTION AT SAND RECIRCULATION PUMPS.
 - CONNECT 3/4" PLANT WATER (PLW) WITH SHUTOFF VALVE TO 2" SEAL WATER SYSTEM CONNECTION AT SLUDGE TRANSFER PUMPS.
 - CONNECT 1/2" DRAIN TO 1/8" DH-1 DRAIN OUTLET. SPILL TO 12" ABOVE GUTTER DRAIN. SEE DETAIL ON DWG. P-506.
 - 2 1/2" EWS DN. CONNECT TO 2 1/2" TAP ON EWS MAIN PIPING BY G.C.
 - 10" RPZ DRAIN THRU WALL 2'-0" AFF. TO EXTERIOR WALL DOWN TURNED ELBOW.
 - RACK RPZ'S AT HEIGHT INDICATED. PROVIDE FLOOR STAND SUPPORTS.
 - 2" EWS DN. CONNECT TO 2" TAP ON EWS MAIN PIPING BY G.C.
 - CONNECT 1 1/2" EFFLUENT WATER (EWS) TO FLUSHING WATER SYSTEM CONNECTION AT SAND RECIRCULATION PUMPS.
 - CONNECT 1 1/2" EFFLUENT WATER (EWS) TO FLUSHING WATER SYSTEM CONNECTION AT SLUDGE TRANSFER PUMPS.
 - 1" EWS DN TO HB-2 4'-0" AFF.
 - CONNECT 4" EWS TO 4" TAP ON EWS MAIN PIPING BY G.C.
 - AVOID HVAC DUCTWORK IN THIS AREA.

FLOOR PLAN
SCALE: 1/8" = 1'-0"

RECORD DRAWING
THESE DRAWINGS HAVE BEEN REVISED TO REFLECT MAJOR CHANGES, IF ANY, WHICH OCCURRED DURING CONSTRUCTION. REVISIONS ARE BASED UPON INFORMATION SUPPLIED BY CONTRACTOR.
DATE: _____ PER: _____

THIS DRAWING WAS PREPARED AT THE SCALE INDICATED IN THE TITLE BLOCK. INACCURACIES IN THE STATED SCALE MAY BE INTRODUCED WHEN DRAWINGS ARE REPRODUCED BY ANY MEANS. USE THE GRAPHIC SCALE BAR IN THE TITLE BLOCK TO DETERMINE THE ACTUAL SCALE OF THIS DRAWING.

0659X301
06/27/01 RAB AJK/FJS
0659P301

| No. | Date | Revisions | Init |
|-----|---------|---------------------|------|
| 0 | 4/20/01 | ISSUED FOR APPROVAL | |
| 1 | | AS BID | |
| 2 | 1/05 | FOR RECORD | |

In charge of FJS
Designed by FJS
Drawn by AJK
Checked by FJS

ENVIRONMENTAL ENGINEERS ASSOCIATES, LLP
SYRACUSE, NEW YORK

RAM-TECH ENGINEERS, P.C.
CONSULTING ENGINEERS
SYRACUSE, NEW YORK



ONONDAGA COUNTY • DEPARTMENT OF DRAINAGE AND SANITATION • SYRACUSE, NEW YORK
METROPOLITAN SYRACUSE WASTEWATER TREATMENT PLANT
STAGE III AMMONIA AND STAGE II PHOSPHORUS REMOVAL PROJECT
HIGH RATE FLOCCULATED SETTLING (HRFS) COMPLEX
HRFS GALLERY - FIRST FLOOR PLAN

File Number
00659
Date
APRIL 2001

P-301

NO ALTERATIONS PERMITTED HEREON EXCEPT AS PROVIDED UNDER SECTION 7209 SUBDIVISION 2 OF THE NEW YORK STATE EDUCATION LAW

PLUMBING

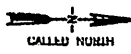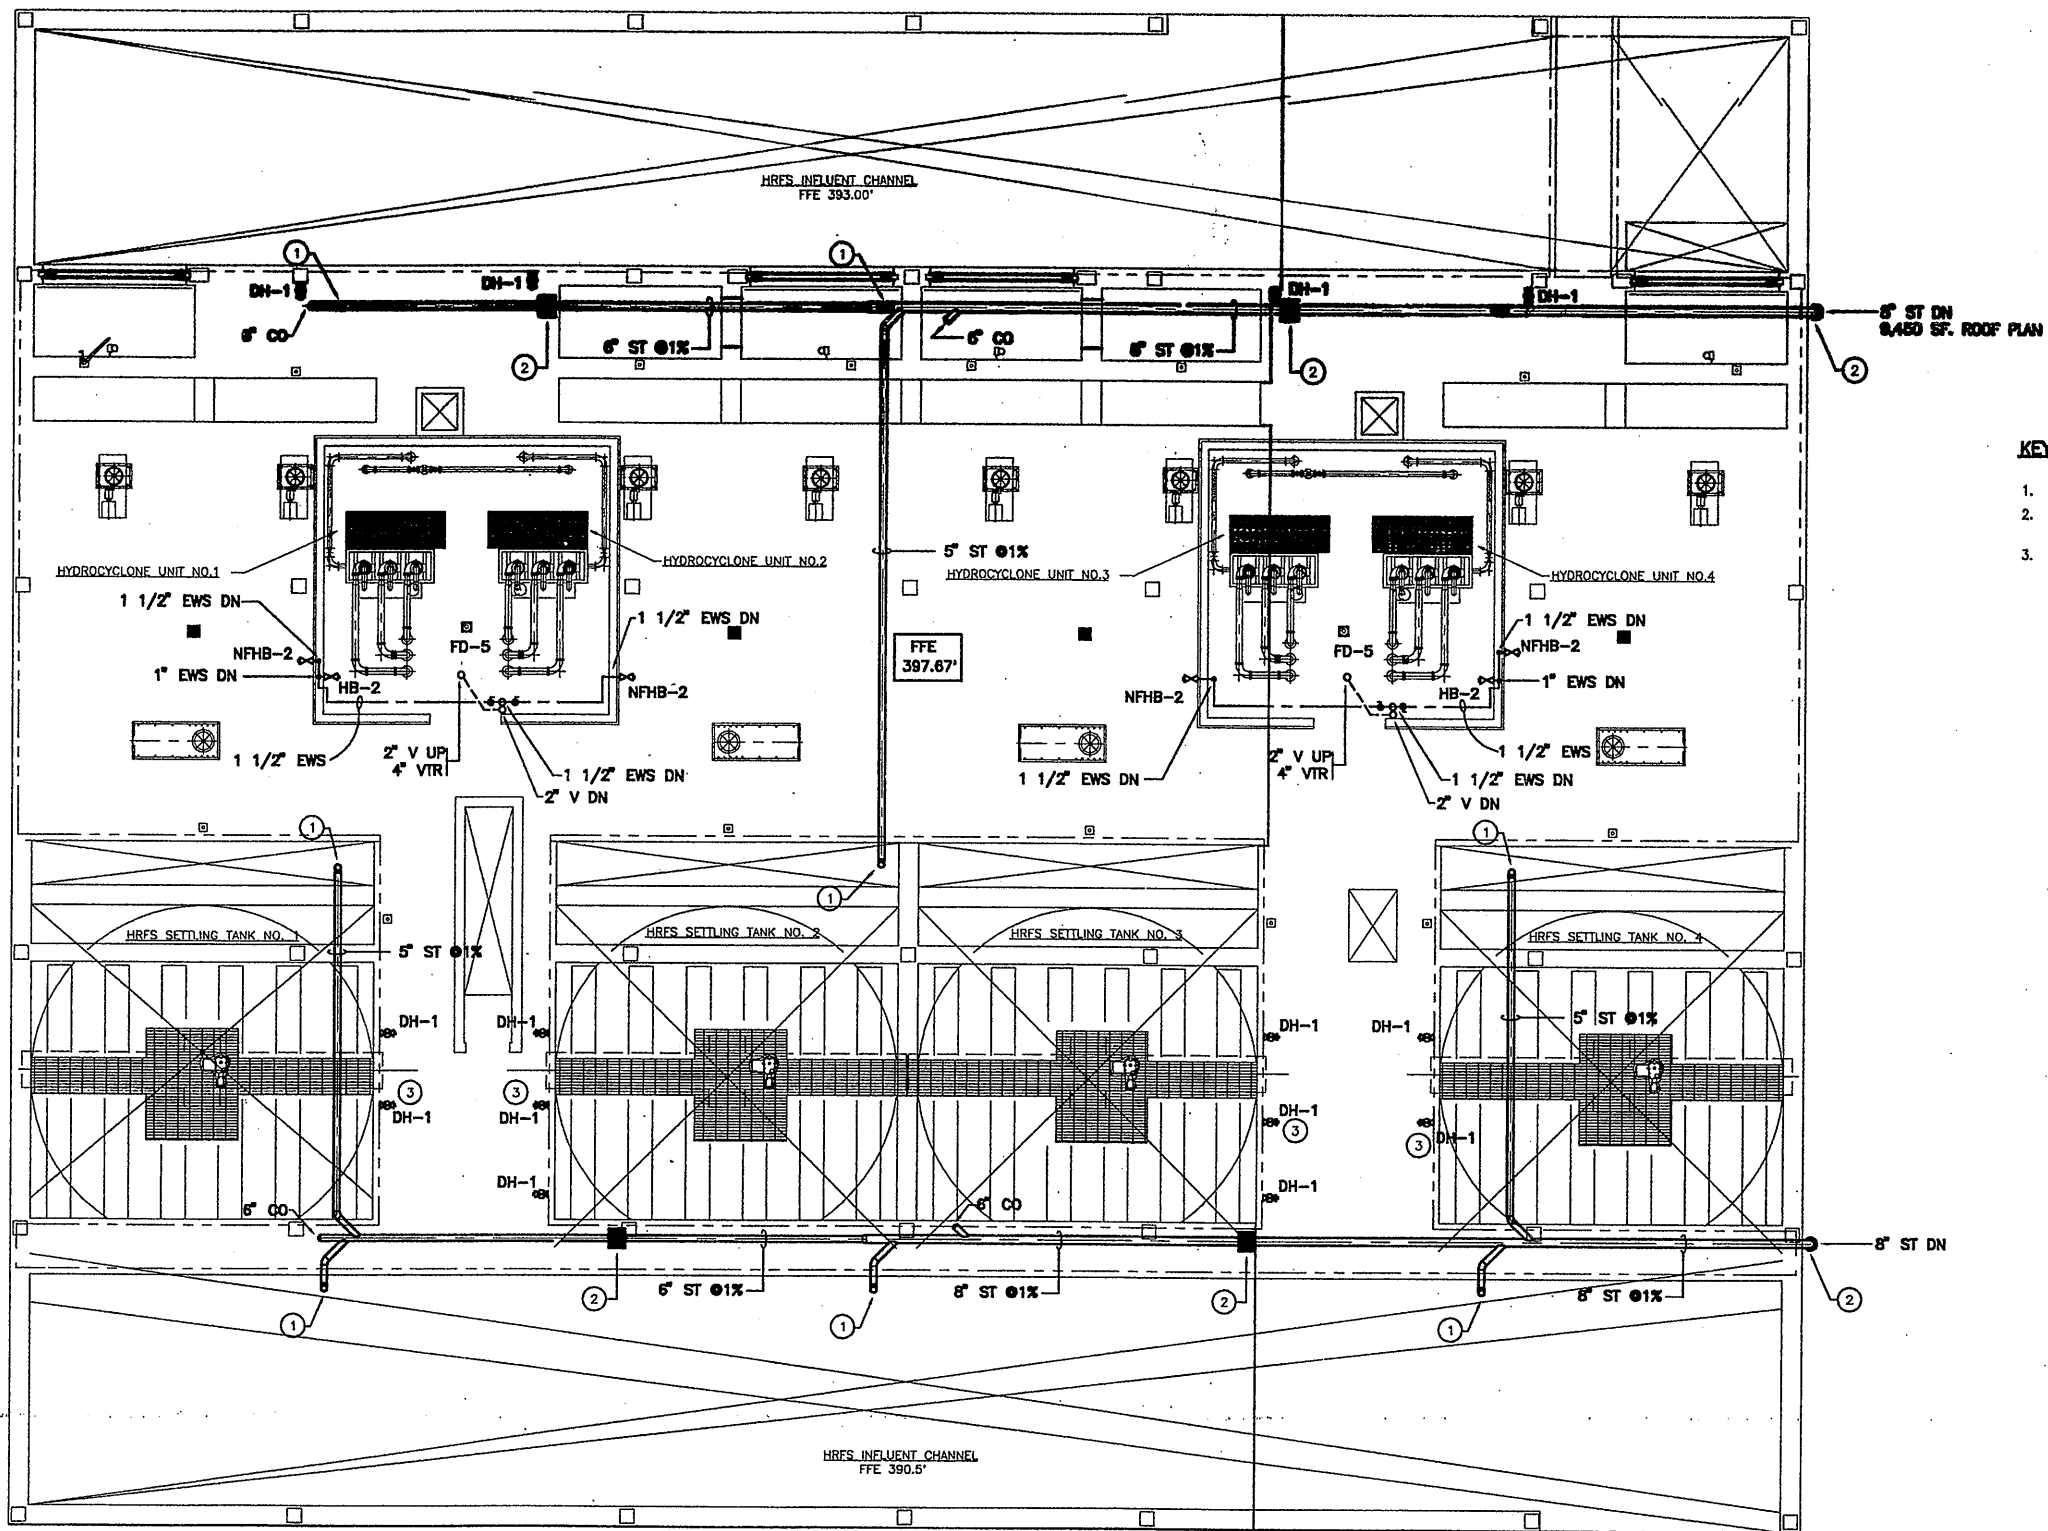

KEYED NOTES: (#)

1. 5" ST UP TO ROOF DRAIN.
2. HEAT TRACING SECTION ELECTRIC CIRCUIT CONNECTION W/ THERMOSTAT & ACCESSORIES PER SPEC.
3. LOW PRESSURE (30 PSI) DECK HYDRANT DH-1. CONNECT TO 1 1/2" EWS FROM PRV-3 OUTLET AS SHOWN ON DRAWING P-301.

FLOOR PLAN
SCALE: 1/8" = 1'-0"


LV BLDG. ROOF
399.0'

RECORD DRAWING

THESE DRAWINGS HAVE BEEN REVISED TO REFLECT MAJOR CHANGES, IF ANY, WHICH OCCURRED DURING CONSTRUCTION. REVISIONS ARE BASED UPON INFORMATION SUPPLIED BY CONTRACTOR.
DATE: _____ PER: _____

THIS DRAWING WAS PREPARED AT THE SCALE INDICATED IN THE TITLE BLOCK. INACCURACIES IN THE STATED SCALE MAY BE INTRODUCED WHEN DRAWINGS ARE REPRODUCED BY ANY MEANS. USE THE GRAPHIC SCALE BAR IN THE TITLE BLOCK TO DETERMINE THE ACTUAL SCALE OF THIS DRAWING.


0659x302/0659x303/0659x071
06/27/01 RAB AJK/FJS
0659F302

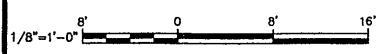

NO ALTERATIONS PERMITTED HEREON EXCEPT AS PROVIDED UNDER SECTION 7209 SUBDIVISION 2 OF THE NEW YORK STATE EDUCATION LAW

| No. | Date | Revisions | Init |
|-----|---------|---------------------|------|
| 0 | 4/20/01 | ISSUED FOR APPROVAL | |
| 1 | | AS BID | |
| 2 | 1/05 | FOR RECORD | |

In charge of FJS
Designed by FJS
Drawn by AJK
Checked by FJS


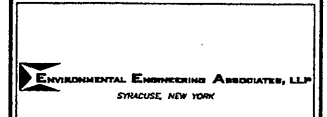


ONONDAGA COUNTY • DEPARTMENT OF DRAINAGE AND SANITATION • SYRACUSE, NEW YORK
METROPOLITAN SYRACUSE WASTEWATER TREATMENT PLANT
STAGE III AMMONIA AND STAGE II PHOSPHORUS REMOVAL PROJECT
HIGH RATE FLOCCULATED SETTLING (HRFS) COMPLEX
HRFS GALLERY - SECOND FLOOR PLAN

PLUMBING

File Number
00659
Date
APRIL 2001

P-302

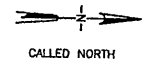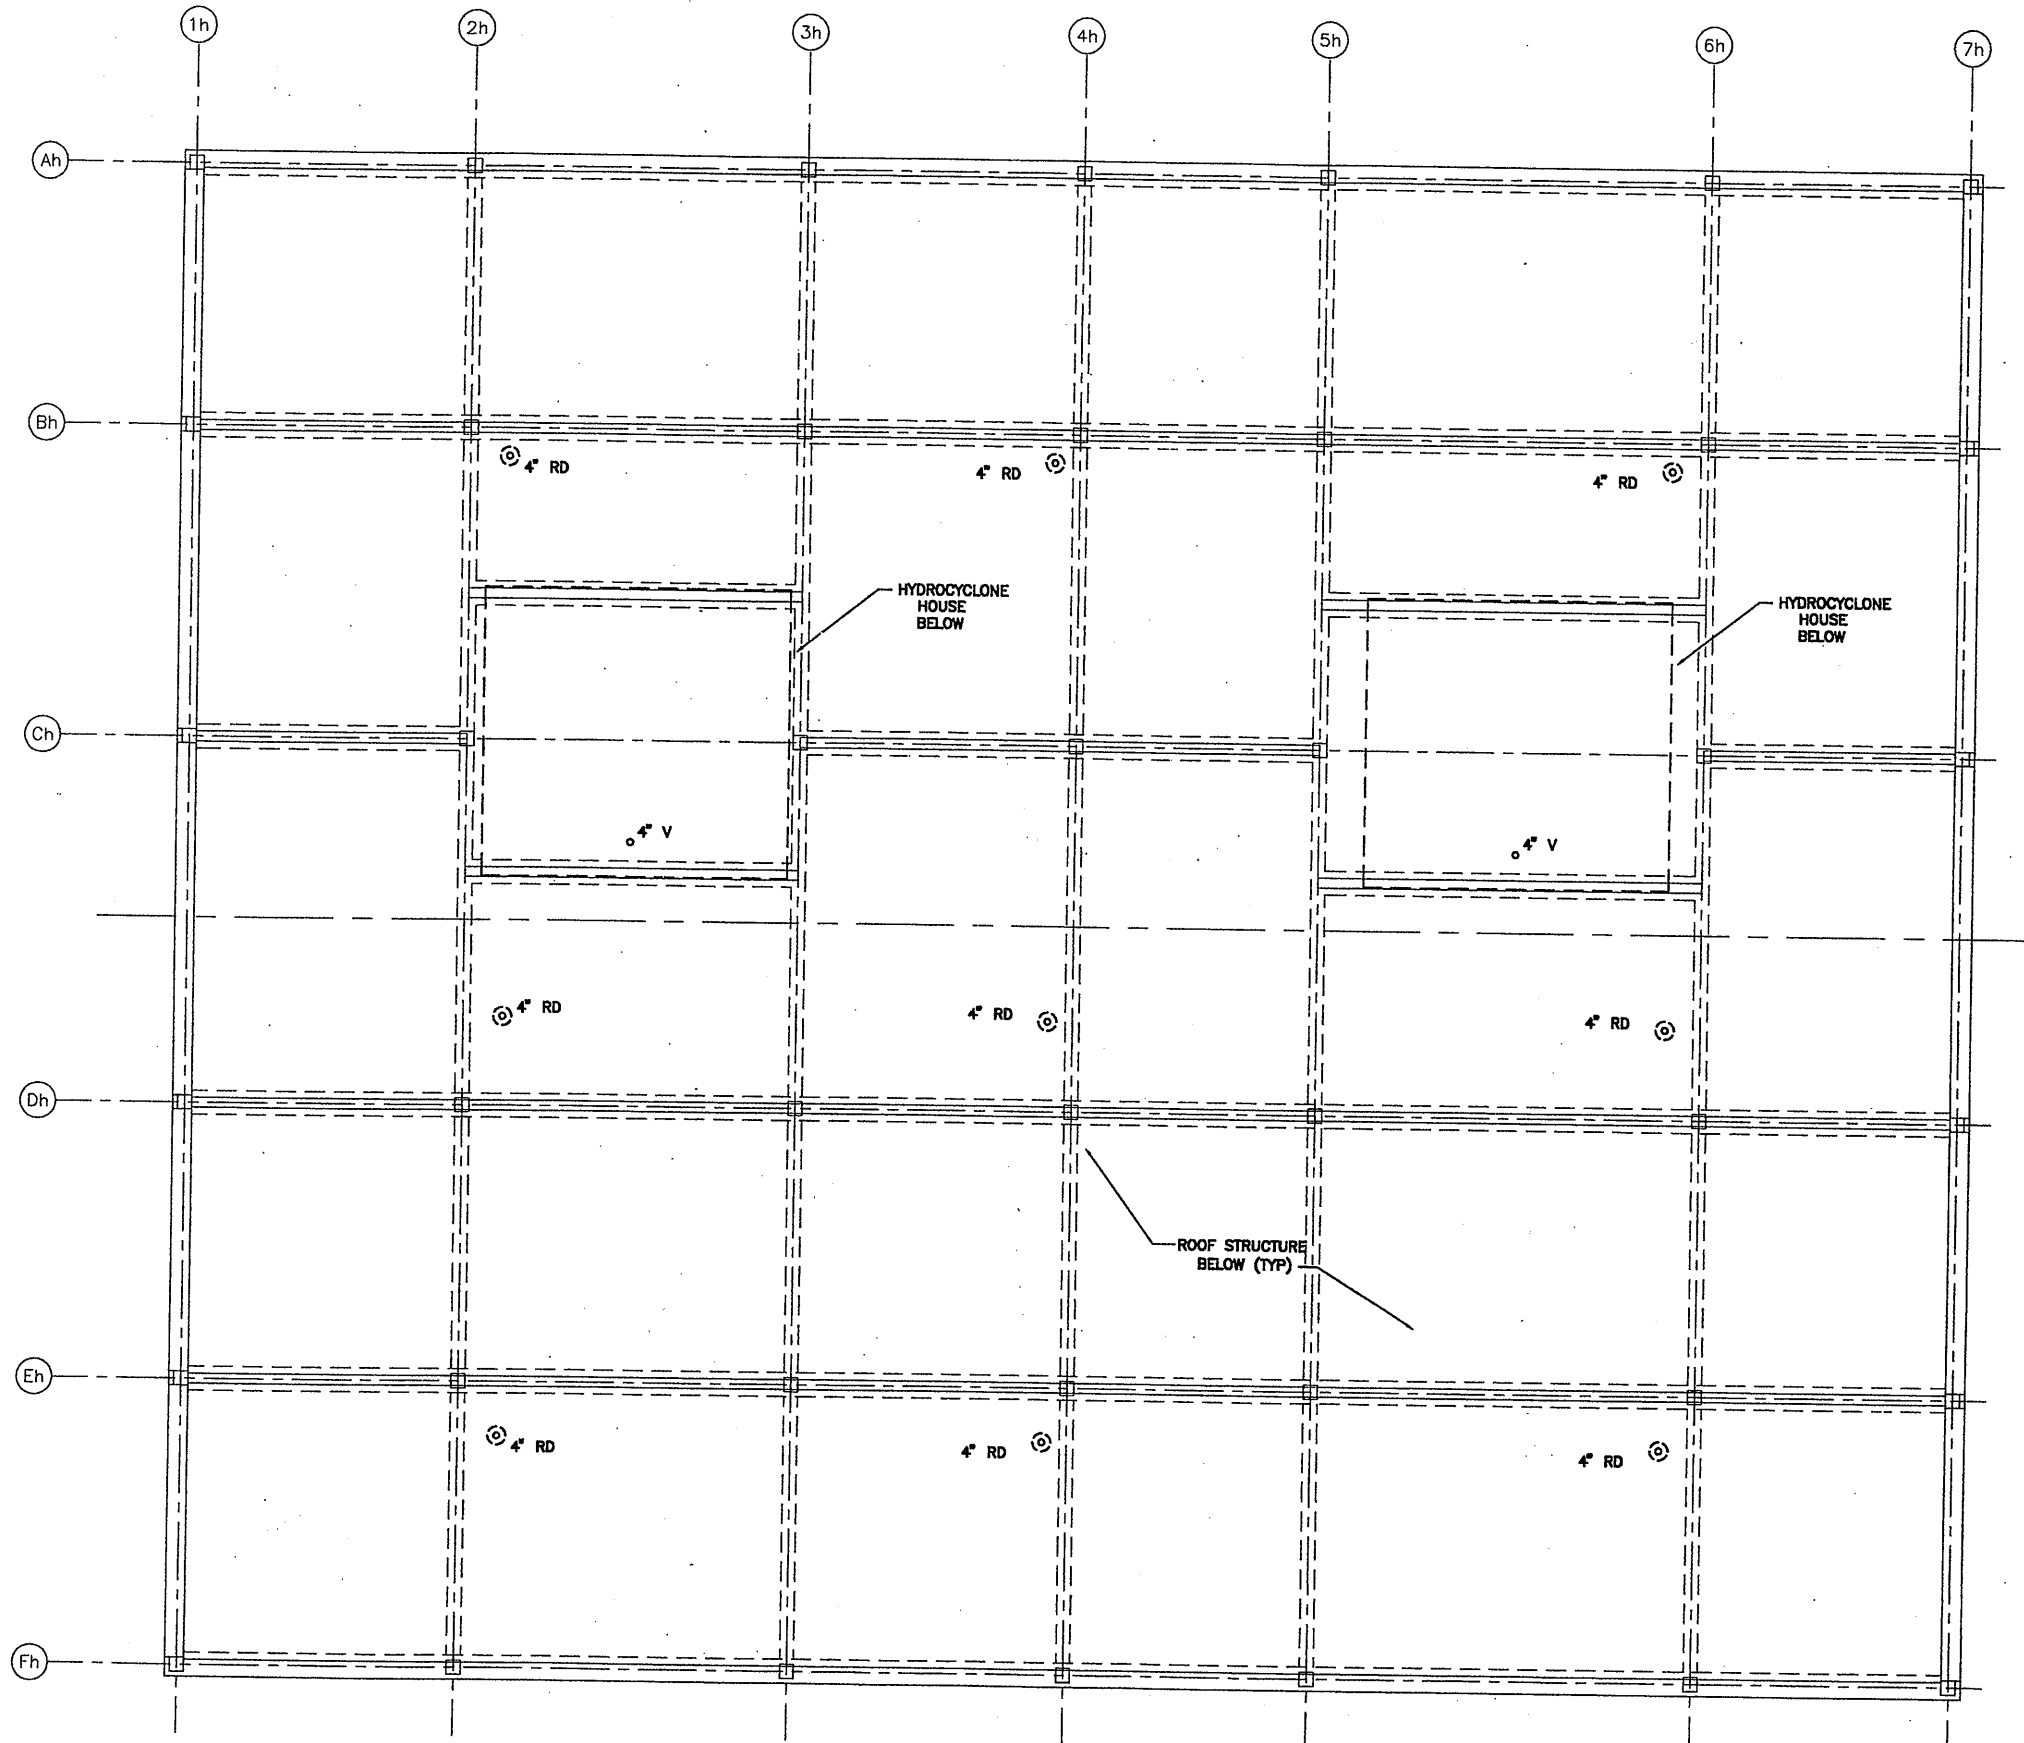

RECORD DRAWING
 THESE DRAWINGS HAVE BEEN REVISED TO REFLECT MAJOR CHANGES, IF ANY, WHICH OCCURRED DURING CONSTRUCTION. REVISIONS ARE BASED UPON INFORMATION SUPPLIED BY CONTRACTOR.
 DATE: _____ PER: _____


THIS DRAWING WAS PREPARED AT THE SCALE INDICATED IN THE TITLE BLOCK. INACCURACIES IN THE STATED SCALE MAY BE INTRODUCED WHEN DRAWINGS ARE REPRODUCED BY ANY MEANS. USE THE GRAPHIC SCALE BAR IN THE TITLE BLOCK TO DETERMINE THE ACTUAL SCALE OF THIS DRAWING.

0659X303
 06/27/01 RAB AJK/FJS
 0659P303

NO ALTERATIONS PERMITTED HEREON EXCEPT AS PROVIDED UNDER SECTION 7209 SUBDIVISION 2 OF THE NEW YORK STATE EDUCATION LAW

| No. | Date | Revisions | Init |
|-----|---------|---------------------|------|
| 0 | 4/20/01 | ISSUED FOR APPROVAL | |
| 1 | | AS BID | |
| 2 | 1/05 | FOR RECORD | |


In. charge of FJS
 Designed by FJS
 Drawn by AJK
 Checked by FJS

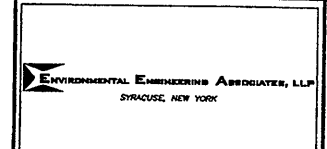


ONONDAGA COUNTY • DEPARTMENT OF DRAINAGE AND SANITATION • SYRACUSE, NEW YORK
 METROPOLITAN SYRACUSE WASTEWATER TREATMENT PLANT
 STAGE III AMMONIA AND STAGE II PHOSPHORUS REMOVAL PROJECT
HIGH RATE FLOCCULATED SETTLING (HRFS) COMPLEX
HRFS GALLERY - ROOF PLAN

| |
|----------------------|
| File Number 00659 |
| Date APRIL 2001 |

P-303

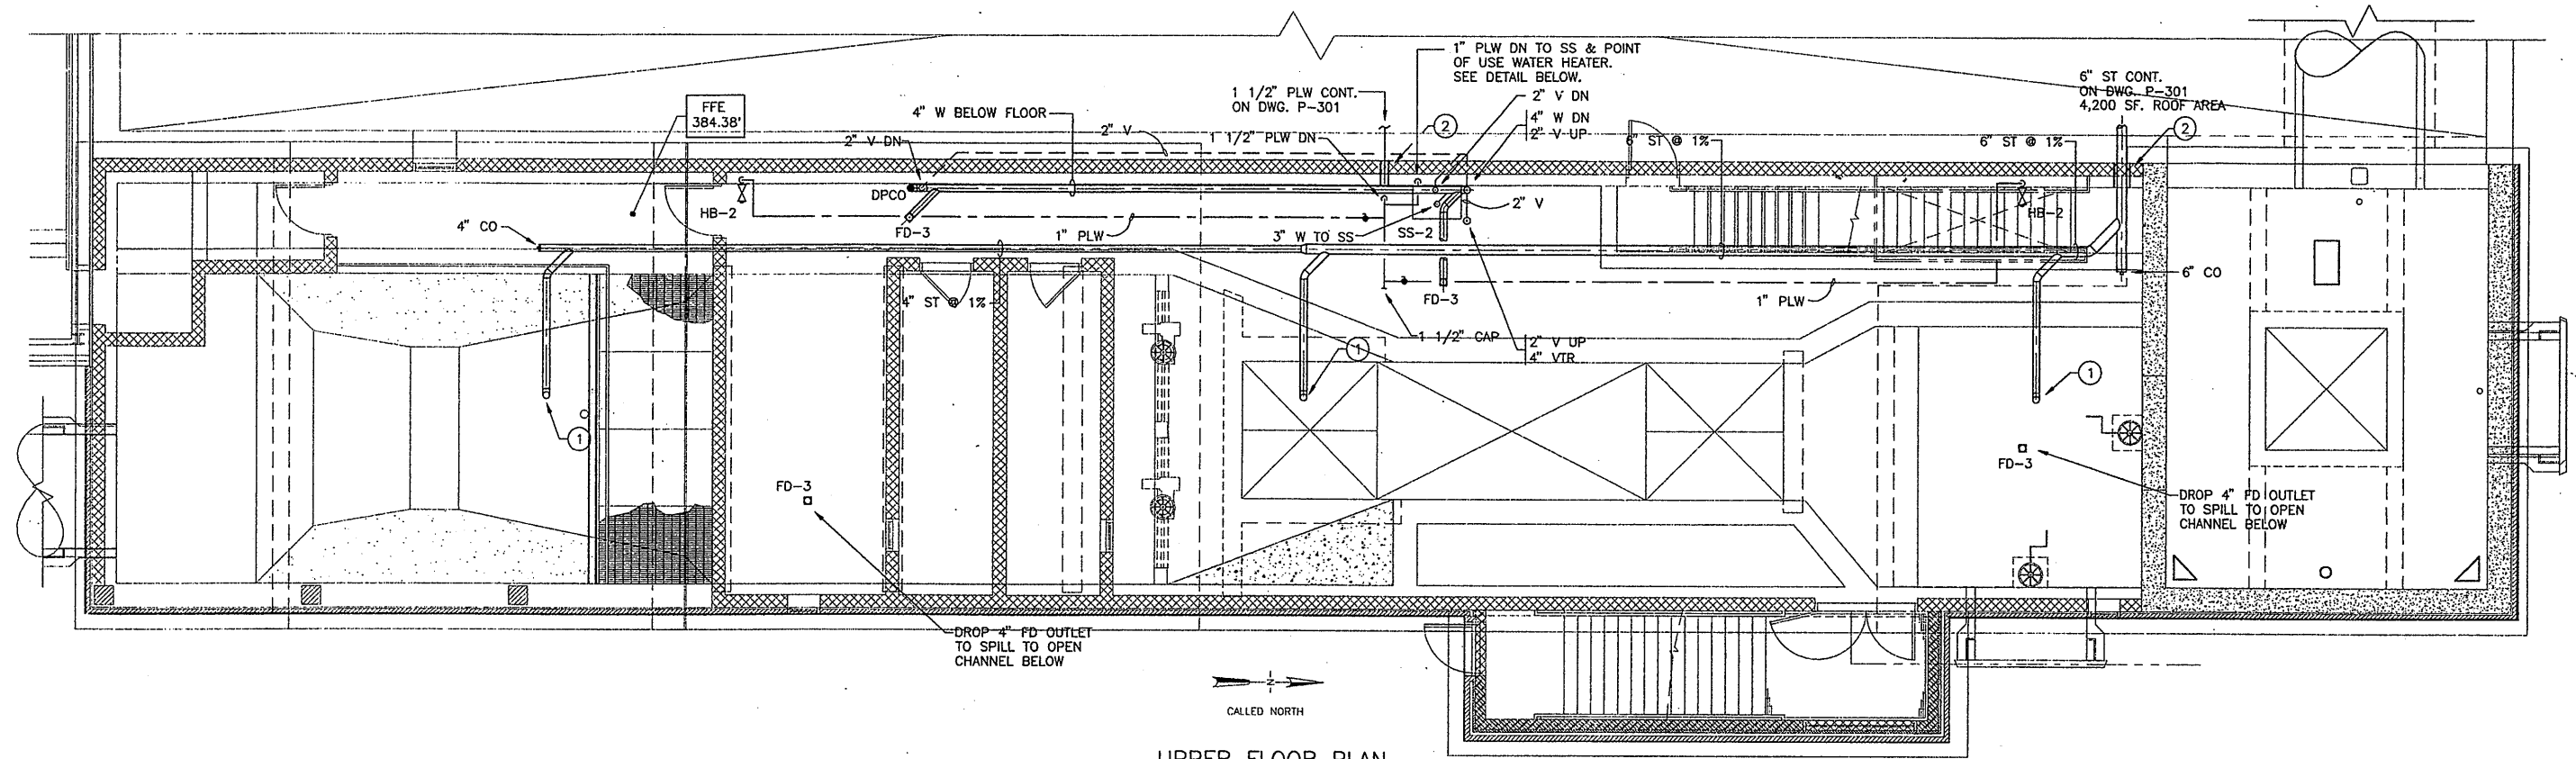


UPPER FLOOR PLAN
SCALE: 3/16" = 1'-0"

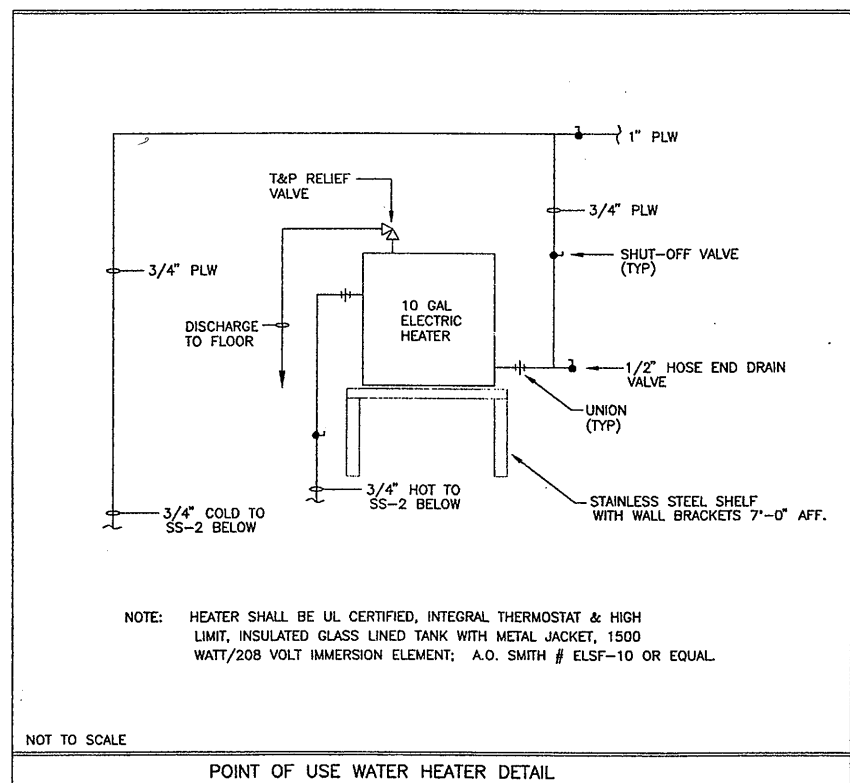

NOTE: HEATER SHALL BE UL CERTIFIED, INTEGRAL THERMOSTAT & HIGH LIMIT, INSULATED GLASS LINED TANK WITH METAL JACKET, 1500 WATT/208 VOLT IMMERSION ELEMENT; A.O. SMITH # ELSF-10 OR EQUAL.

NOT TO SCALE

POINT OF USE WATER HEATER DETAIL

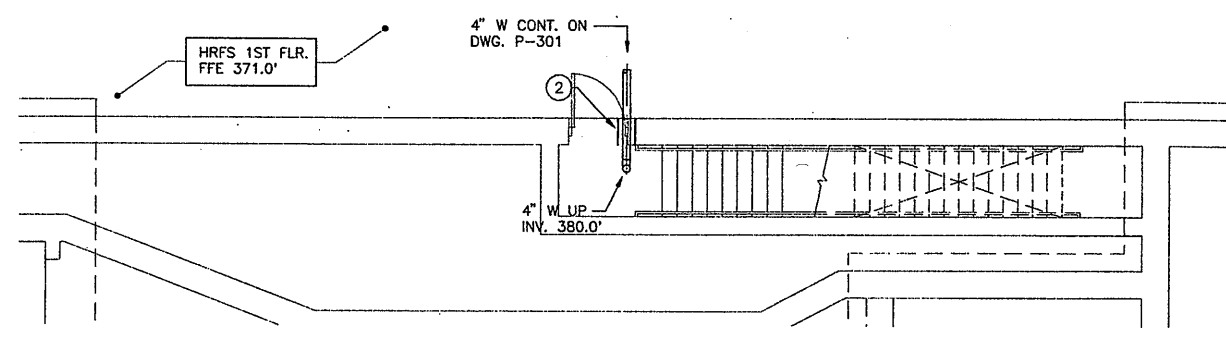

LOWER FLOOR PLAN
SCALE: 3/16" = 1'-0"

KEYED NOTES: #

- 4" ST UP TO ROOF DRAIN.
- SLEEVE PIPING THRU WALL.

RECORD DRAWING

THESE DRAWINGS HAVE BEEN REVISED TO REFLECT MAJOR CHANGES, IF ANY, WHICH OCCURRED DURING CONSTRUCTION. REVISIONS ARE BASED UPON INFORMATION SUPPLIED BY CONTRACTOR.

DATE: _____ PER: _____

THIS DRAWING WAS PREPARED AT THE SCALE INDICATED IN THE TITLE BLOCK. INACCURACIES IN THE STATED SCALE MAY BE INTRODUCED WHEN DRAWINGS ARE REPRODUCED BY ANY MEANS. USE THE GRAPHIC SCALE BAR IN THE TITLE BLOCK TO DETERMINE THE ACTUAL SCALE OF THIS DRAWING.

0659X401/0659X402
06/27/01 RAB AJK/FJS
0659P401

3/16" = 1'-0"
NO ALTERATIONS PERMITTED HEREON EXCEPT AS PROVIDED UNDER SECTION 7209 SUBDIVISION 2 OF THE NEW YORK STATE EDUCATION LAW

| No. | Date | Revisions | Init |
|-----|---------|---------------------|------|
| 0 | 4/20/01 | ISSUED FOR APPROVAL | |
| 1 | | AS BID | |
| 2 | 1/05 | FOR RECORD | |



In charge of -- FJS
Designed by -- FJS
Drawn by -- AJK
Checked by -- FJS

ENVIRONMENTAL ENGINEERS ASSOCIATES, LLP
SYRACUSE, NEW YORK

RAM-TECH ENGINEERS, P.C.
CONSULTING ENGINEERS
SYRACUSE, NY 13204

ONONDAGA COUNTY • DEPARTMENT OF DRAINAGE AND SANITATION • SYRACUSE, NEW YORK
METROPOLITAN SYRACUSE WASTEWATER TREATMENT PLANT
STAGE III AMMONIA AND STAGE II PHOSPHORUS REMOVAL PROJECT
UV DISINFECTION
UV DISINFECTION/PARSHALL FLUME
PLAN AND ROOF PLAN
PLUMBING

File Number
00659
Date
APRIL 2001
P-401

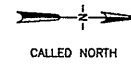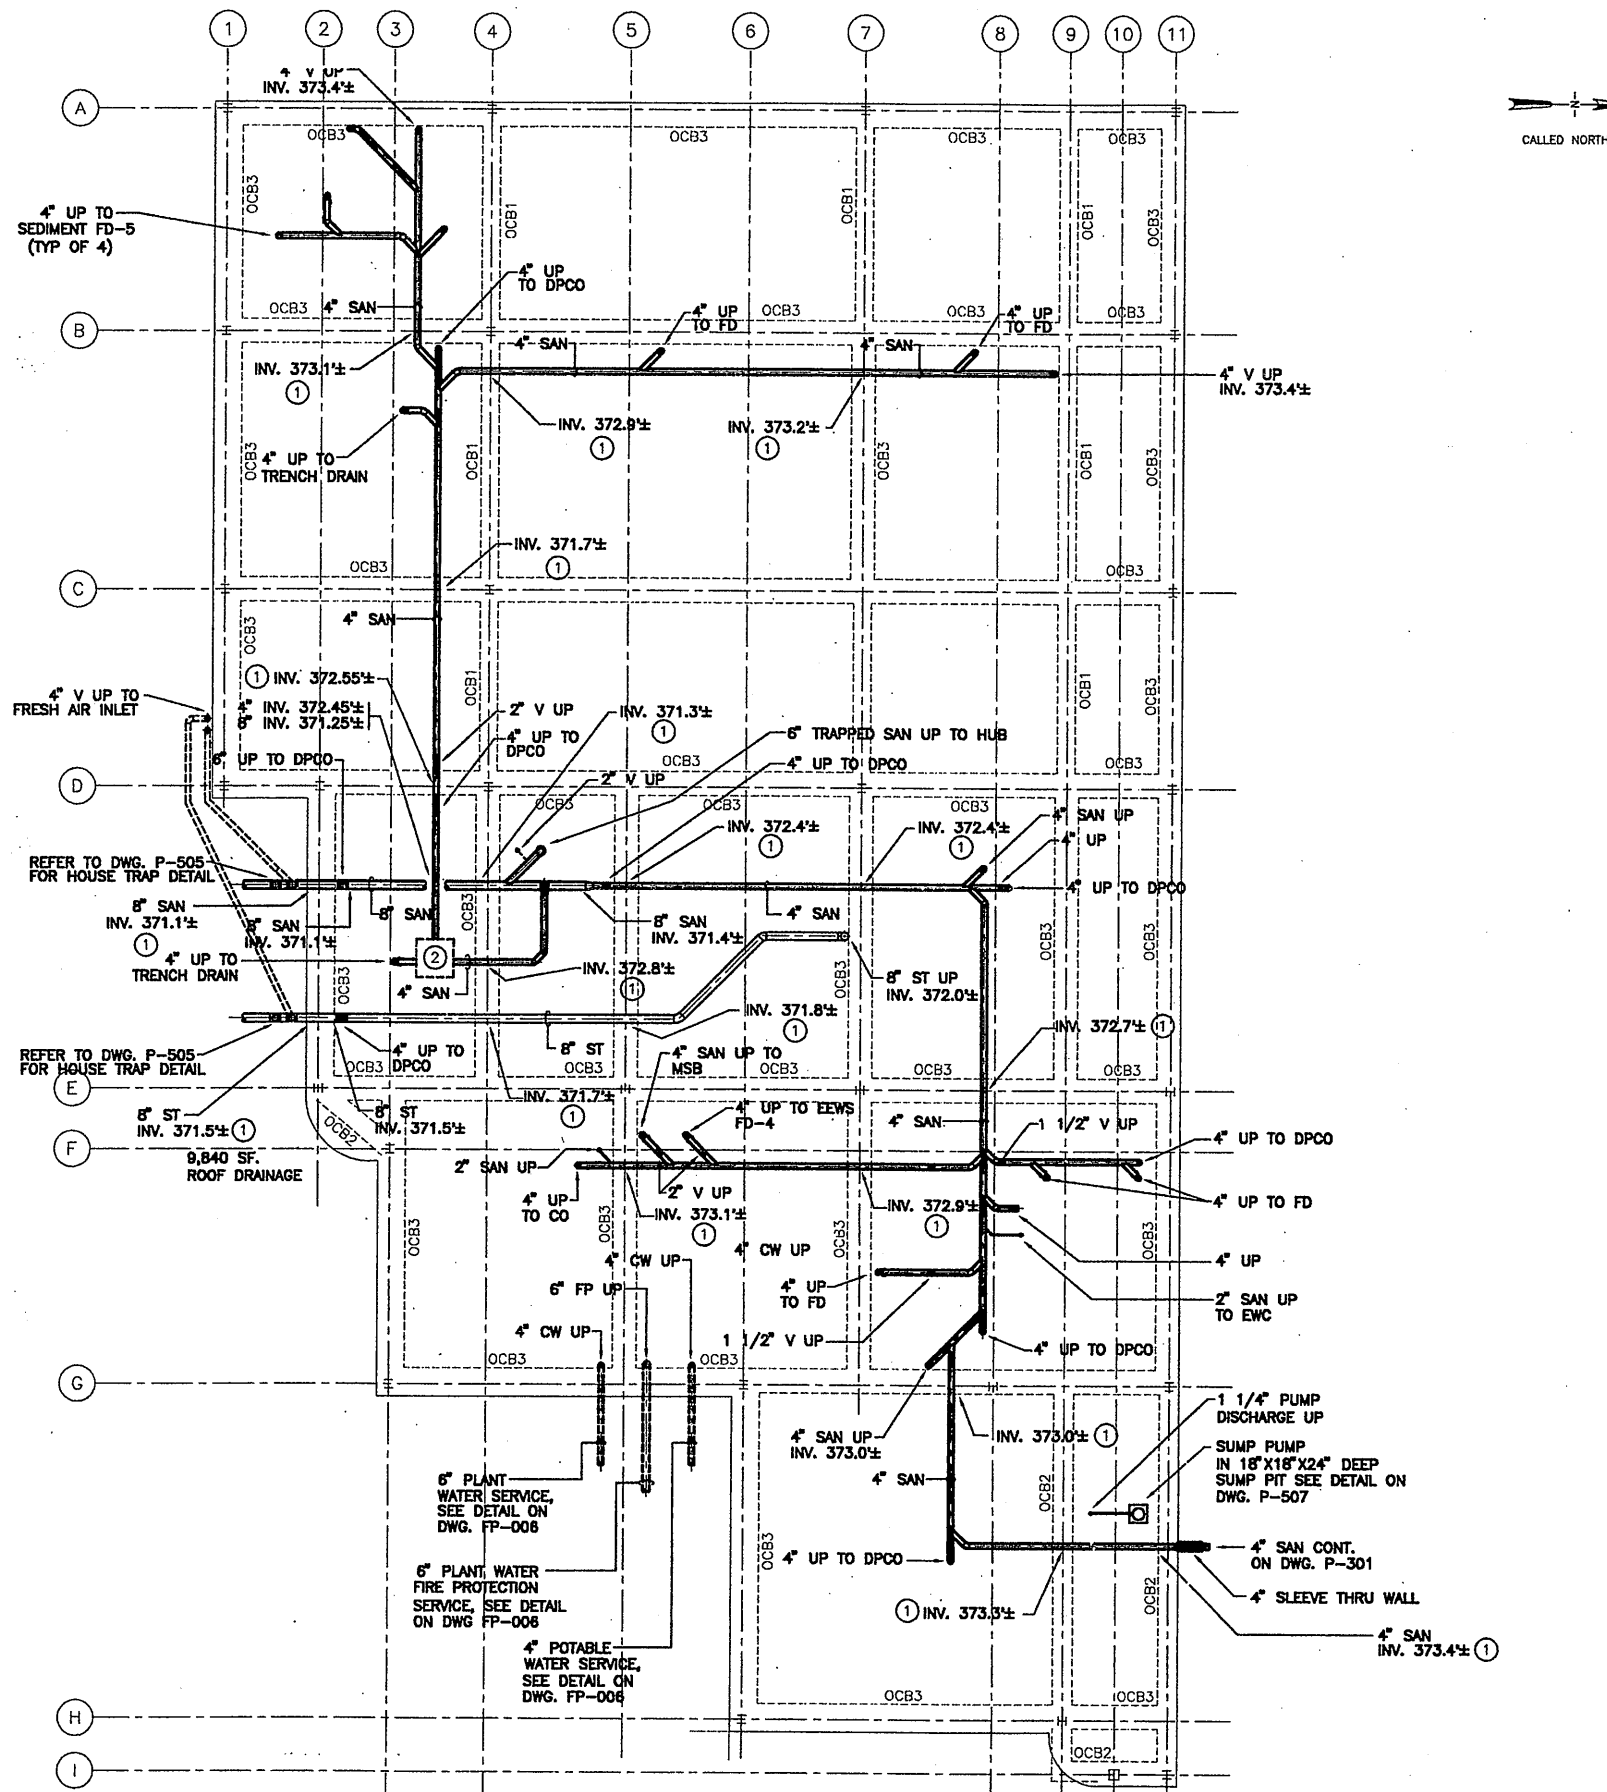

GENERAL NOTES:

A. PIPING INVERTS ARE PER APPROXIMATELY $\pm 1/2$ " NOMINAL CONSTRUCTION TOLERANCES & ARE BASED ON 1ST FLOOR ELEVATION OF 375.38'. VERIFY ALL FIELD CONDITIONS BEFORE STARTING WORK.

KEYED NOTES: #

- SLEEVE ALL GRADE BEAM PENETRATIONS. PROVIDE SLEEVES ALONG CENTERLINE OF PIPING PENETRATION. SIZE SLEEVE AS FOLLOWS:
 - 4" SAN; USE 8" SLEEVE
 - 6" SAN; USE 10" SLEEVE
 - 8" SAN & ST; USE 12" SLEEVE
- PROVIDE SEDIMENT INTERCEPTOR 3'-0" X 3'-0" X 5'-0" DEEP W/ GRATED OPEN COVER, SEE DETAIL ON DWG. P-507.

RECORD DRAWING

THESE DRAWINGS HAVE BEEN REVISED TO REFLECT MAJOR CHANGES, IF ANY, WHICH OCCURRED DURING CONSTRUCTION. REVISIONS ARE BASED UPON INFORMATION SUPPLIED BY CONTRACTOR.

DATE: _____ PER: _____

THIS DRAWING WAS PREPARED AT THE SCALE INDICATED IN THE TITLE BLOCK. INACCURACIES IN THE STATED SCALE MAY BE INTRODUCED WHEN DRAWINGS ARE REPRODUCED BY ANY MEANS. USE THE GRAPHIC SCALE BAR IN THE TITLE BLOCK TO DETERMINE THE ACTUAL SCALE OF THIS DRAWING.


0659x501
06/27/01 RAB AJK/FJS
0659P500

1/8"=1'-0"

NO ALTERATIONS PERMITTED HEREON EXCEPT AS PROVIDED UNDER SECTION 7209 SUBDIVISION 2 OF THE NEW YORK STATE EDUCATION LAW


| No. | Date | Revisions | Init |
|-----|---------|---------------------|------|
| 0 | 4/20/01 | ISSUED FOR APPROVAL | |
| 1 | | AS BID | |
| 2 | 1/05 | FOR RECORD | |

In charge of - FJS
Designed by - FJS
Drawn by - AJK
Checked by - FJS

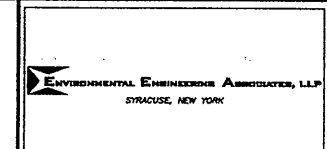

ONONDAGA COUNTY • DEPARTMENT OF DRAINAGE AND SANITATION • SYRACUSE, NEW YORK
METROPOLITAN SYRACUSE WASTEWATER TREATMENT PLANT
STAGE III AMMONIA AND STAGE II PHOSPHORUS REMOVAL PROJECT
OPERATIONS CENTER - FOUNDATION PLAN
PLUMBING PLAN - DRAIN/WASTE/VENT

| | |
|-------------|------------|
| File Number | 00659 |
| Date | APRIL 2001 |
| | P-500 |

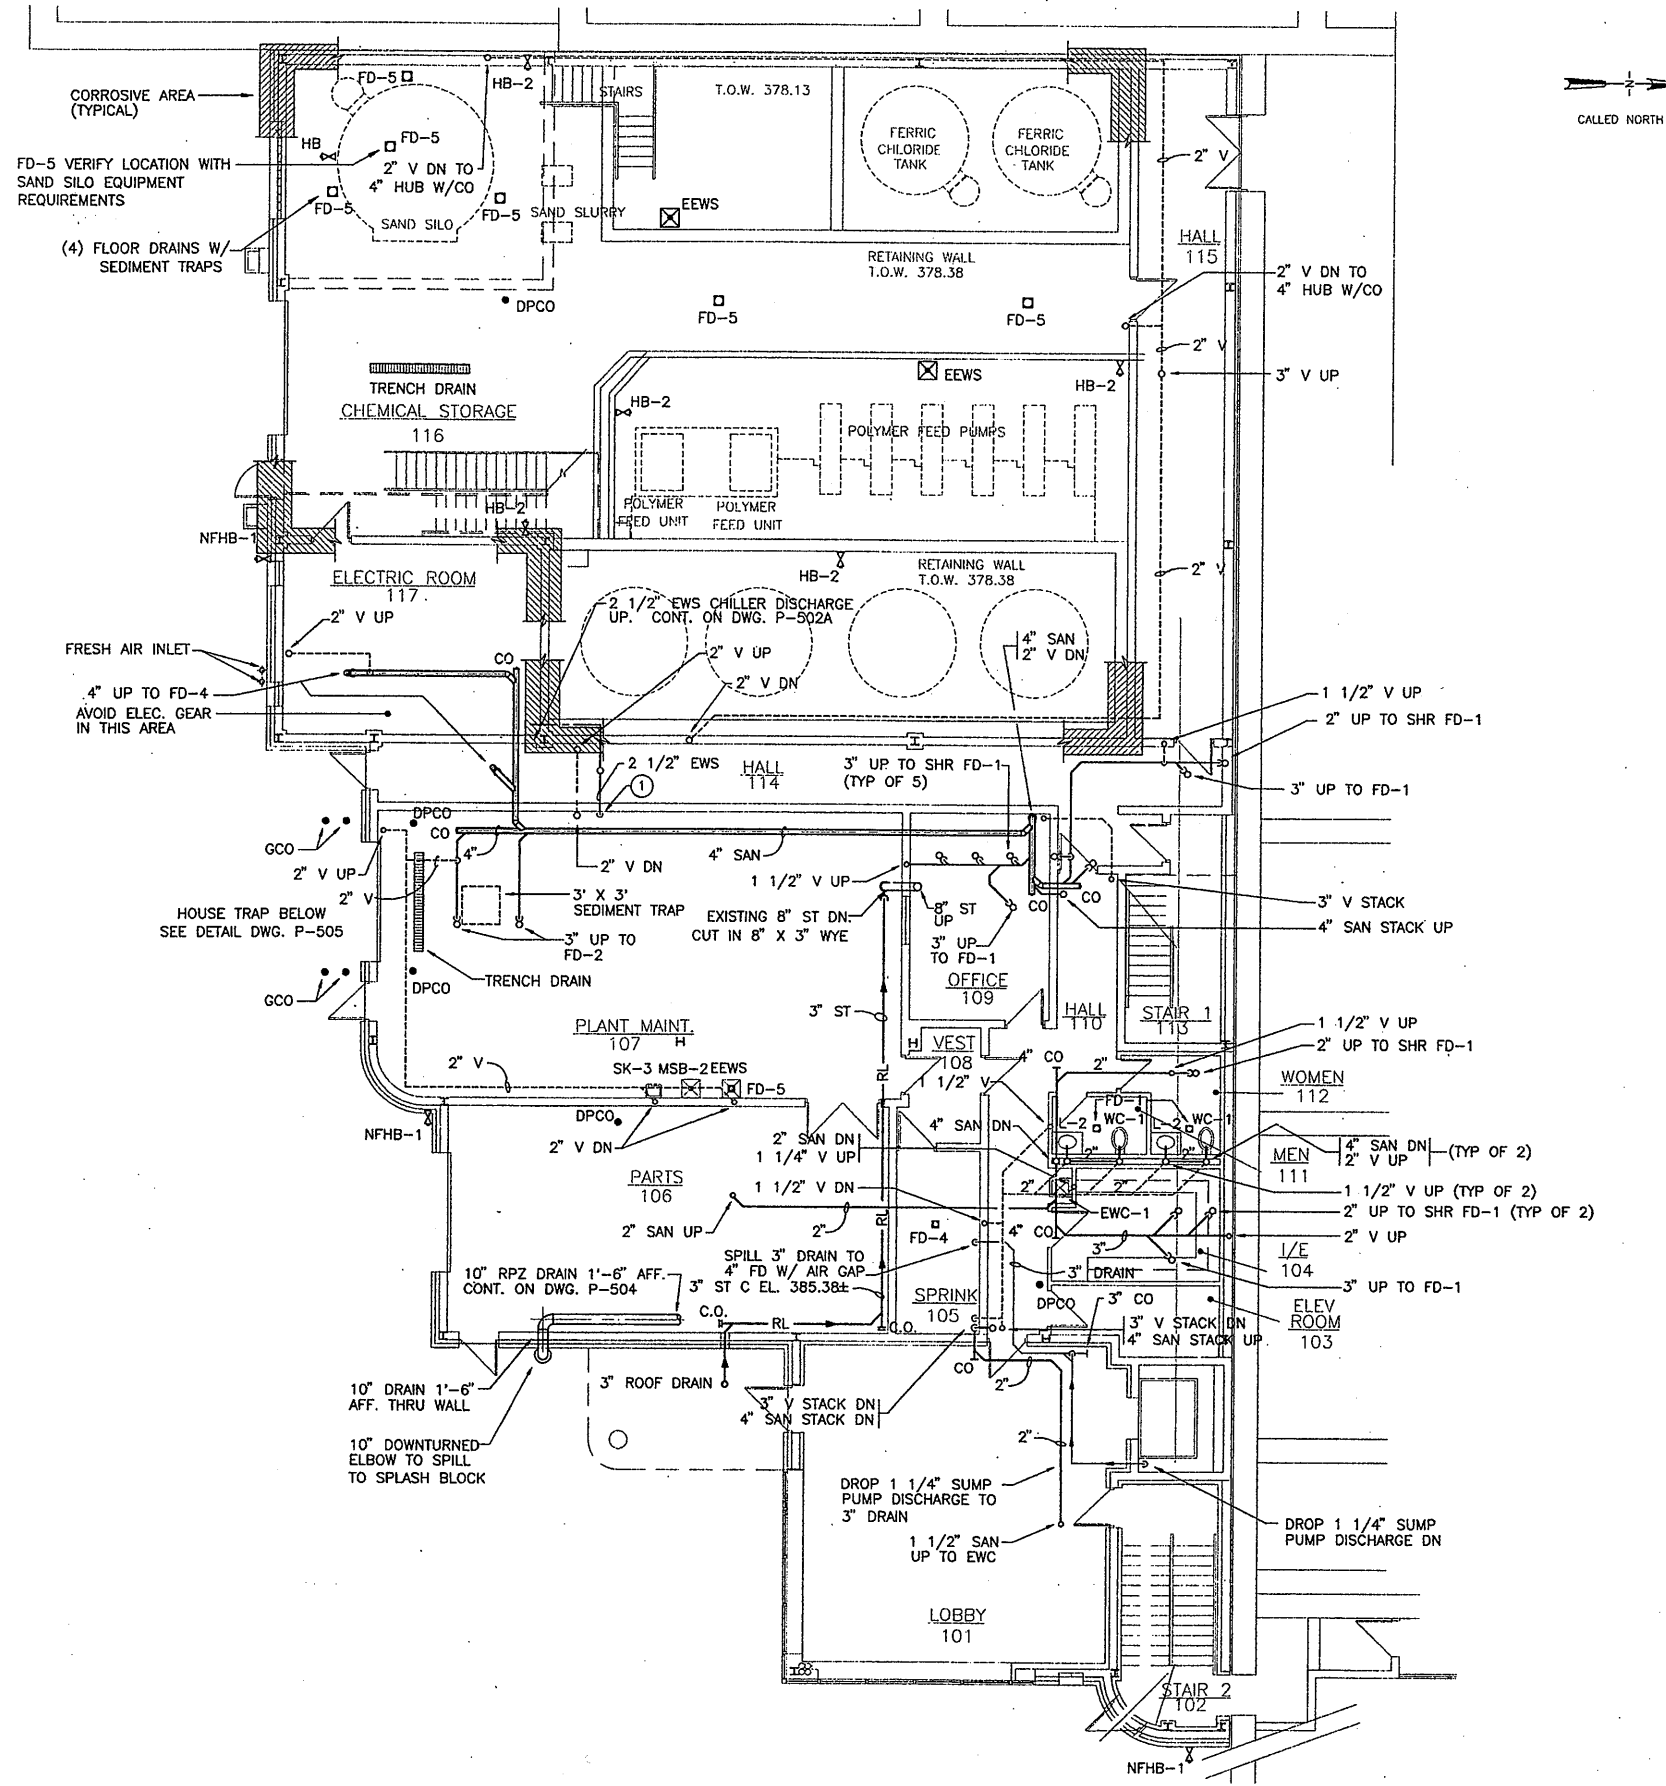

KEYED NOTES: (1)

1. DROP 2 1/2" EWS CHILLER DISCHARGE TO 6" TRAPPED SAN HUB WITH AIR GAP. PROVIDE MINIMUM 12" HIGH PERFORATED STAINLESS STEEL SPLASH GUARD ALL AROUND HUB.

RECORD DRAWING

THESE DRAWINGS HAVE BEEN REVISED TO REFLECT MAJOR CHANGES, IF ANY, WHICH OCCURRED DURING CONSTRUCTION. REVISIONS ARE BASED UPON INFORMATION SUPPLIED BY CONTRACTOR.

DATE: _____ PER: _____

THIS DRAWING WAS PREPARED AT THE SCALE INDICATED IN THE TITLE BLOCK. INACCURACIES IN THE STATED SCALE MAY BE INTRODUCED WHEN DRAWINGS ARE REPRODUCED BY ANY MEANS. USE THE GRAPHIC SCALE BAR IN THE TITLE BLOCK TO DETERMINE THE ACTUAL SCALE OF THIS DRAWING.



0659P501
06/27/01 RAB AJK/FJS
0659P501

1/8"=1'-0"

NO ALTERATIONS PERMITTED HEREON EXCEPT AS PROVIDED UNDER SECTION 7209 SUBDIVISION 2 OF THE NEW YORK STATE EDUCATION LAW

| No. | Date | Revisions | Init |
|-----|---------|---------------------|------|
| 0 | 4/20/01 | ISSUED FOR APPROVAL | |
| 1 | | AS BID | |
| 2 | 1/05 | FOR RECORD | |



In charge of FJS
Designed by FJS
Drawn by AJK
Checked by FJS

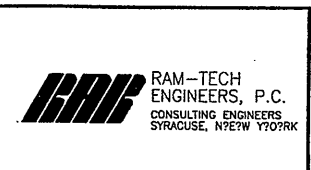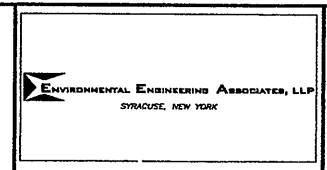

ONONDAGA COUNTY • DEPARTMENT OF DRAINAGE AND SANITATION • SYRACUSE, NEW YORK
METROPOLITAN SYRACUSE WASTEWATER TREATMENT PLANT
STAGE III AMMONIA AND STAGE II PHOSPHORUS REMOVAL PROJECT
OPERATIONS CENTER - FIRST FLOOR
PLUMBING PLAN - DRAIN/WASTE/VENT


PLUMBING

File Number 00659
Date APRIL 2001
P-501

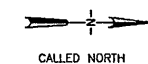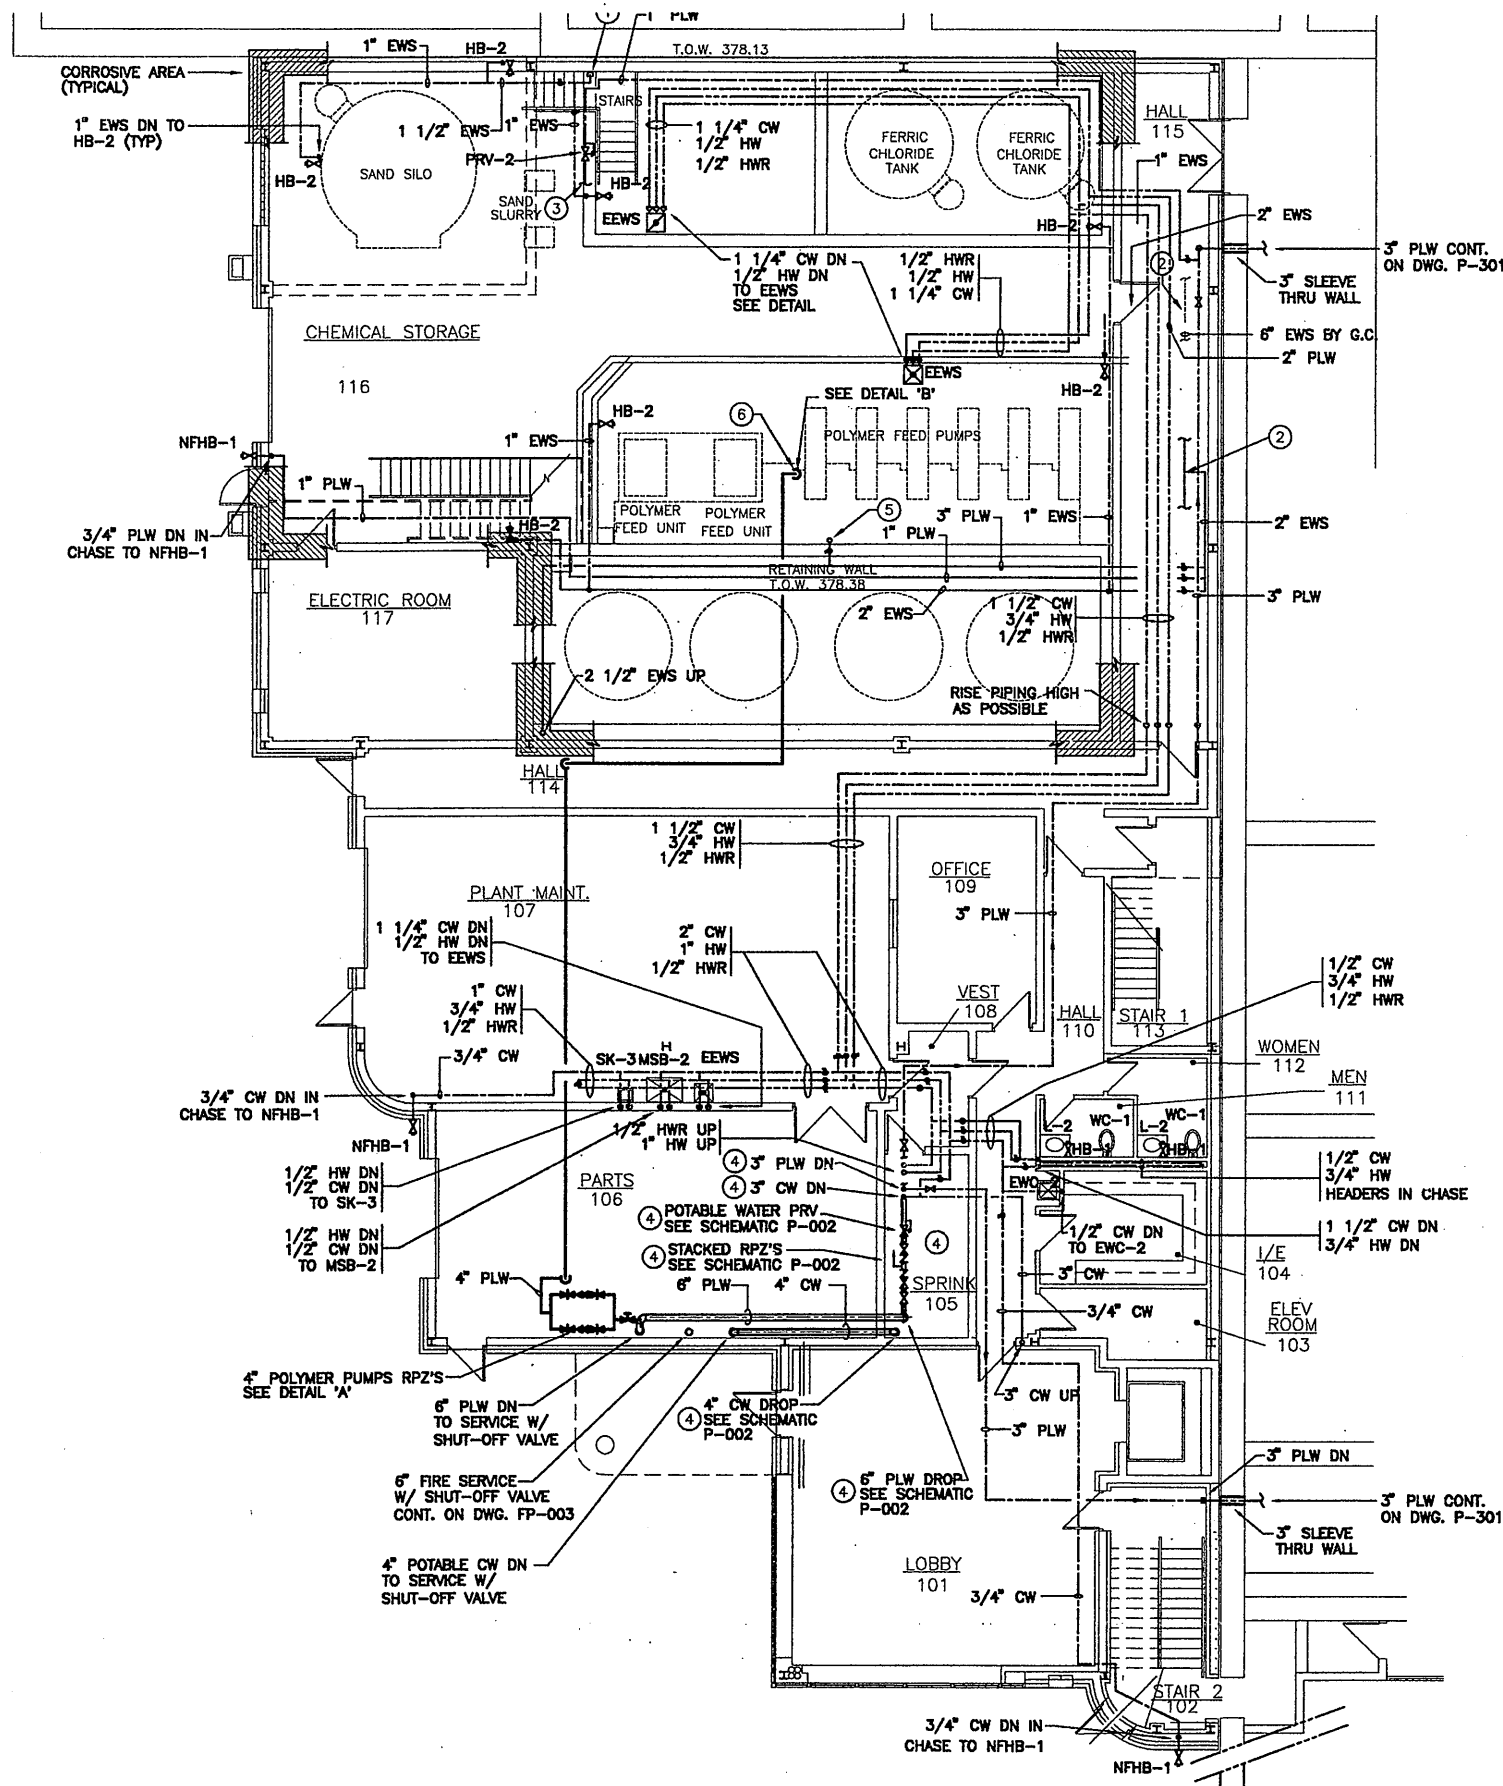


KEYED NOTES: ①

1. 2" EWS DN. CONNECT TO 2" TAP ON EWS MAIN PIPING BY G.C.
2. 2" EWS, CONNECT TO 2" TAP ON EWS MAIN PIPING BY G.C.
3. CONNECT 3/4" PLANT WATER (PLW) WITH SHUTOFF VALVE TO SEAL WATER SYSTEM CONNECTION AT SAND SLURRY PUMPS.
4. SEE DRAWING P-504 FOR ENLARGED SPRINKLER ROOM PLAN.
5. 2 1/2" EWS DN. CONNECT TO 2 1/2" TAP ON EWS MAIN PIPING BY G.C.
6. 4" PLW TIE TO 6" EWE PIPING BY G.C.

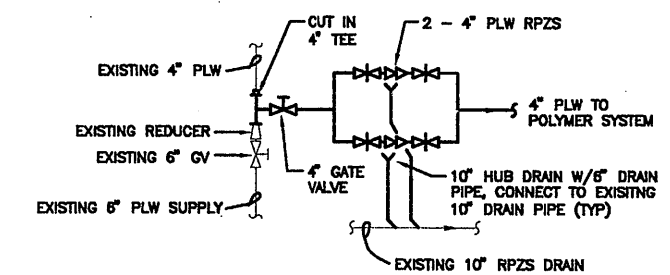

DETAIL-A
NOT TO SCALE

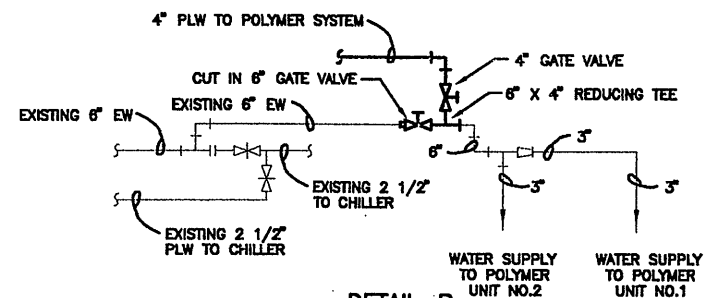

DETAIL-B
NOT TO SCALE

RECORD DRAWING

THESE DRAWINGS HAVE BEEN REVISED TO REFLECT MAJOR CHANGES, IF ANY, WHICH OCCURRED DURING CONSTRUCTION. REVISIONS ARE BASED UPON INFORMATION SUPPLIED BY CONTRACTOR.


DATE: _____ PER: _____

THIS DRAWING WAS PREPARED AT THE SCALE INDICATED IN THE TITLE BLOCK. INACCURACIES IN THE STATED SCALE MAY BE INTRODUCED WHEN DRAWINGS ARE REPRODUCED BY ANY MEANS. USE THE GRAPHIC SCALE BAR IN THE TITLE BLOCK TO DETERMINE THE ACTUAL SCALE OF THIS DRAWING.



| No. | Date | Revisions | Init |
|-----|---------|---------------------|------|
| 0 | 4/20/01 | ISSUED FOR APPROVAL | |
| 1 | | AS BID | |
| 2 | 1/05 | FOR RECORD | |

In charge of _____ FJS
 Designed by _____ FJS
 Drawn by _____ AJK
 Checked by _____ FJS


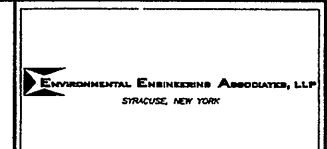


ONONDAGA COUNTY • DEPARTMENT OF DRAINAGE AND SANITATION • SYRACUSE, NEW YORK
 METROPOLITAN SYRACUSE WASTEWATER TREATMENT PLANT
 STAGE III AMMONIA AND STAGE II PHOSPHORUS REMOVAL PROJECT
OPERATIONS CENTER - FIRST FLOOR
PLUMBING PLAN - WATER

File Number
00659
 Date
APRIL 2001
P-501A

NO ALTERATIONS PERMITTED HEREON EXCEPT AS PROVIDED UNDER SECTION 7209 SUBDIVISION 2 OF THE NEW YORK STATE EDUCATION LAW

PLUMBING

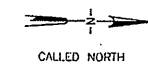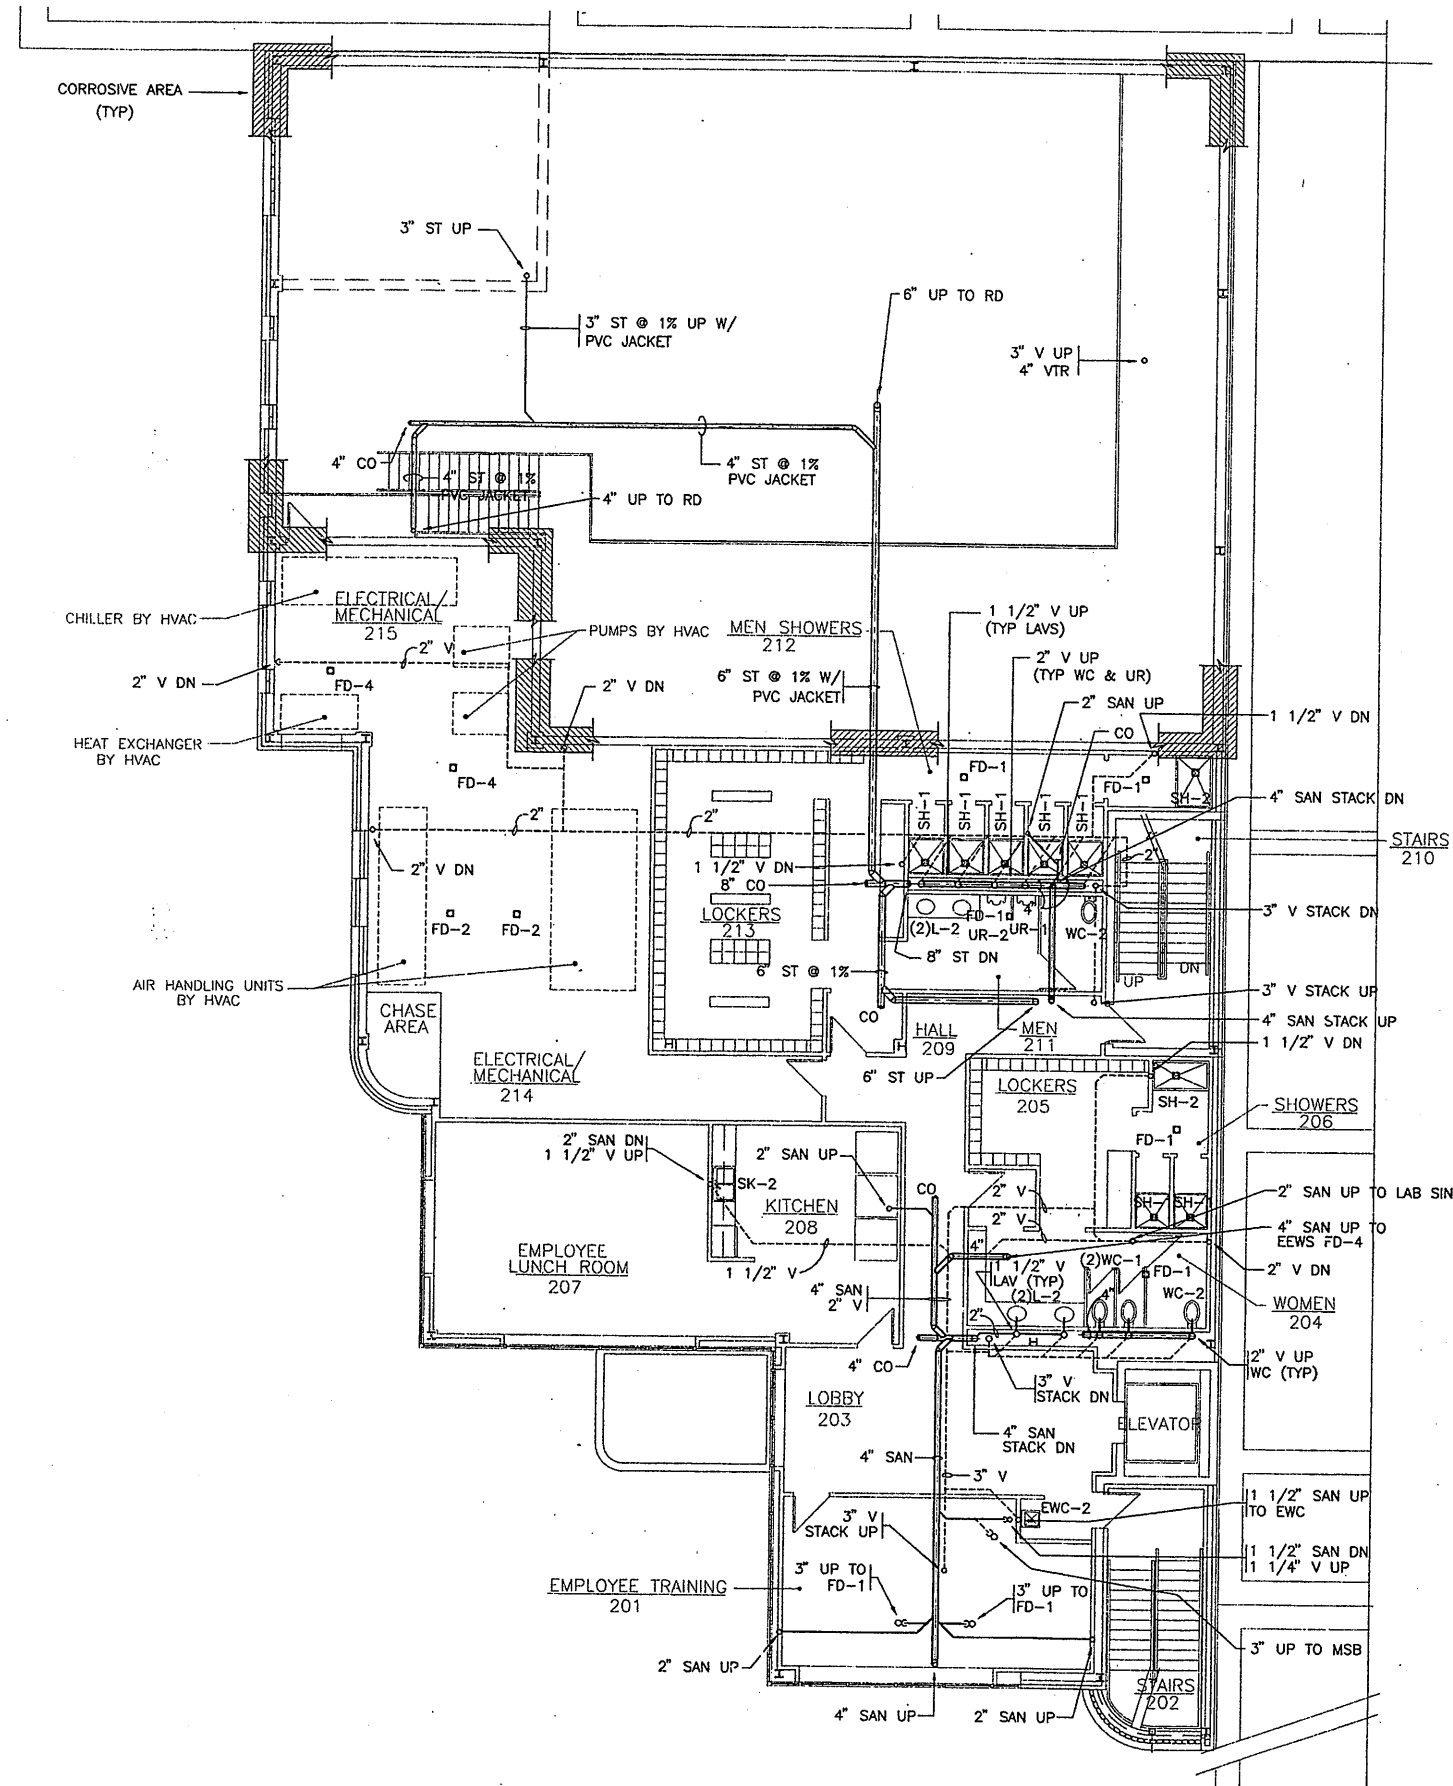

RECORD DRAWING
 THESE DRAWINGS HAVE BEEN REVISED TO REFLECT MAJOR CHANGES, IF ANY, WHICH OCCURRED DURING CONSTRUCTION. REVISIONS ARE BASED UPON INFORMATION SUPPLIED BY CONTRACTOR.
 DATE: _____ PER: _____


THIS DRAWING WAS PREPARED AT THE SCALE INDICATED IN THE TITLE BLOCK. INACCURACIES IN THE STATED SCALE MAY BE INTRODUCED WHEN DRAWINGS ARE REPRODUCED BY ANY MEANS. USE THE GRAPHIC SCALE BAR IN THE TITLE BLOCK TO DETERMINE THE ACTUAL SCALE OF THIS DRAWING.

0659X502
 06/27/01 RAB AJK/FJS
 0659P502

NO ALTERATIONS PERMITTED HEREON EXCEPT AS PROVIDED UNDER SECTION 7209 SUBDIVISION 2 OF THE NEW YORK STATE EDUCATION LAW

| No. | Date | Revisions | Init |
|-----|---------|---------------------|------|
| 0 | 4/20/01 | ISSUED FOR APPROVAL | |
| 1 | | AS BID | |
| 2 | 1/05 | FOR RECORD | |


In charge of FJS
 Designed by FJS
 Drawn by AJK
 Checked by FJS

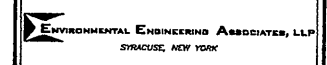

ONONDAGA COUNTY • DEPARTMENT OF DRAINAGE AND SANITATION • SYRACUSE, NEW YORK
 METROPOLITAN SYRACUSE WASTEWATER TREATMENT PLANT
 STAGE III AMMONIA AND STAGE II PHOSPHORUS REMOVAL PROJECT
OPERATIONS CENTER - SECOND FLOOR
PLUMBING PLAN - DRAIN/WASTE/VENT

| | |
|-------------|------------|
| File Number | 00659 |
| Date | APRIL 2001 |
| | P-502 |

PLUMBING

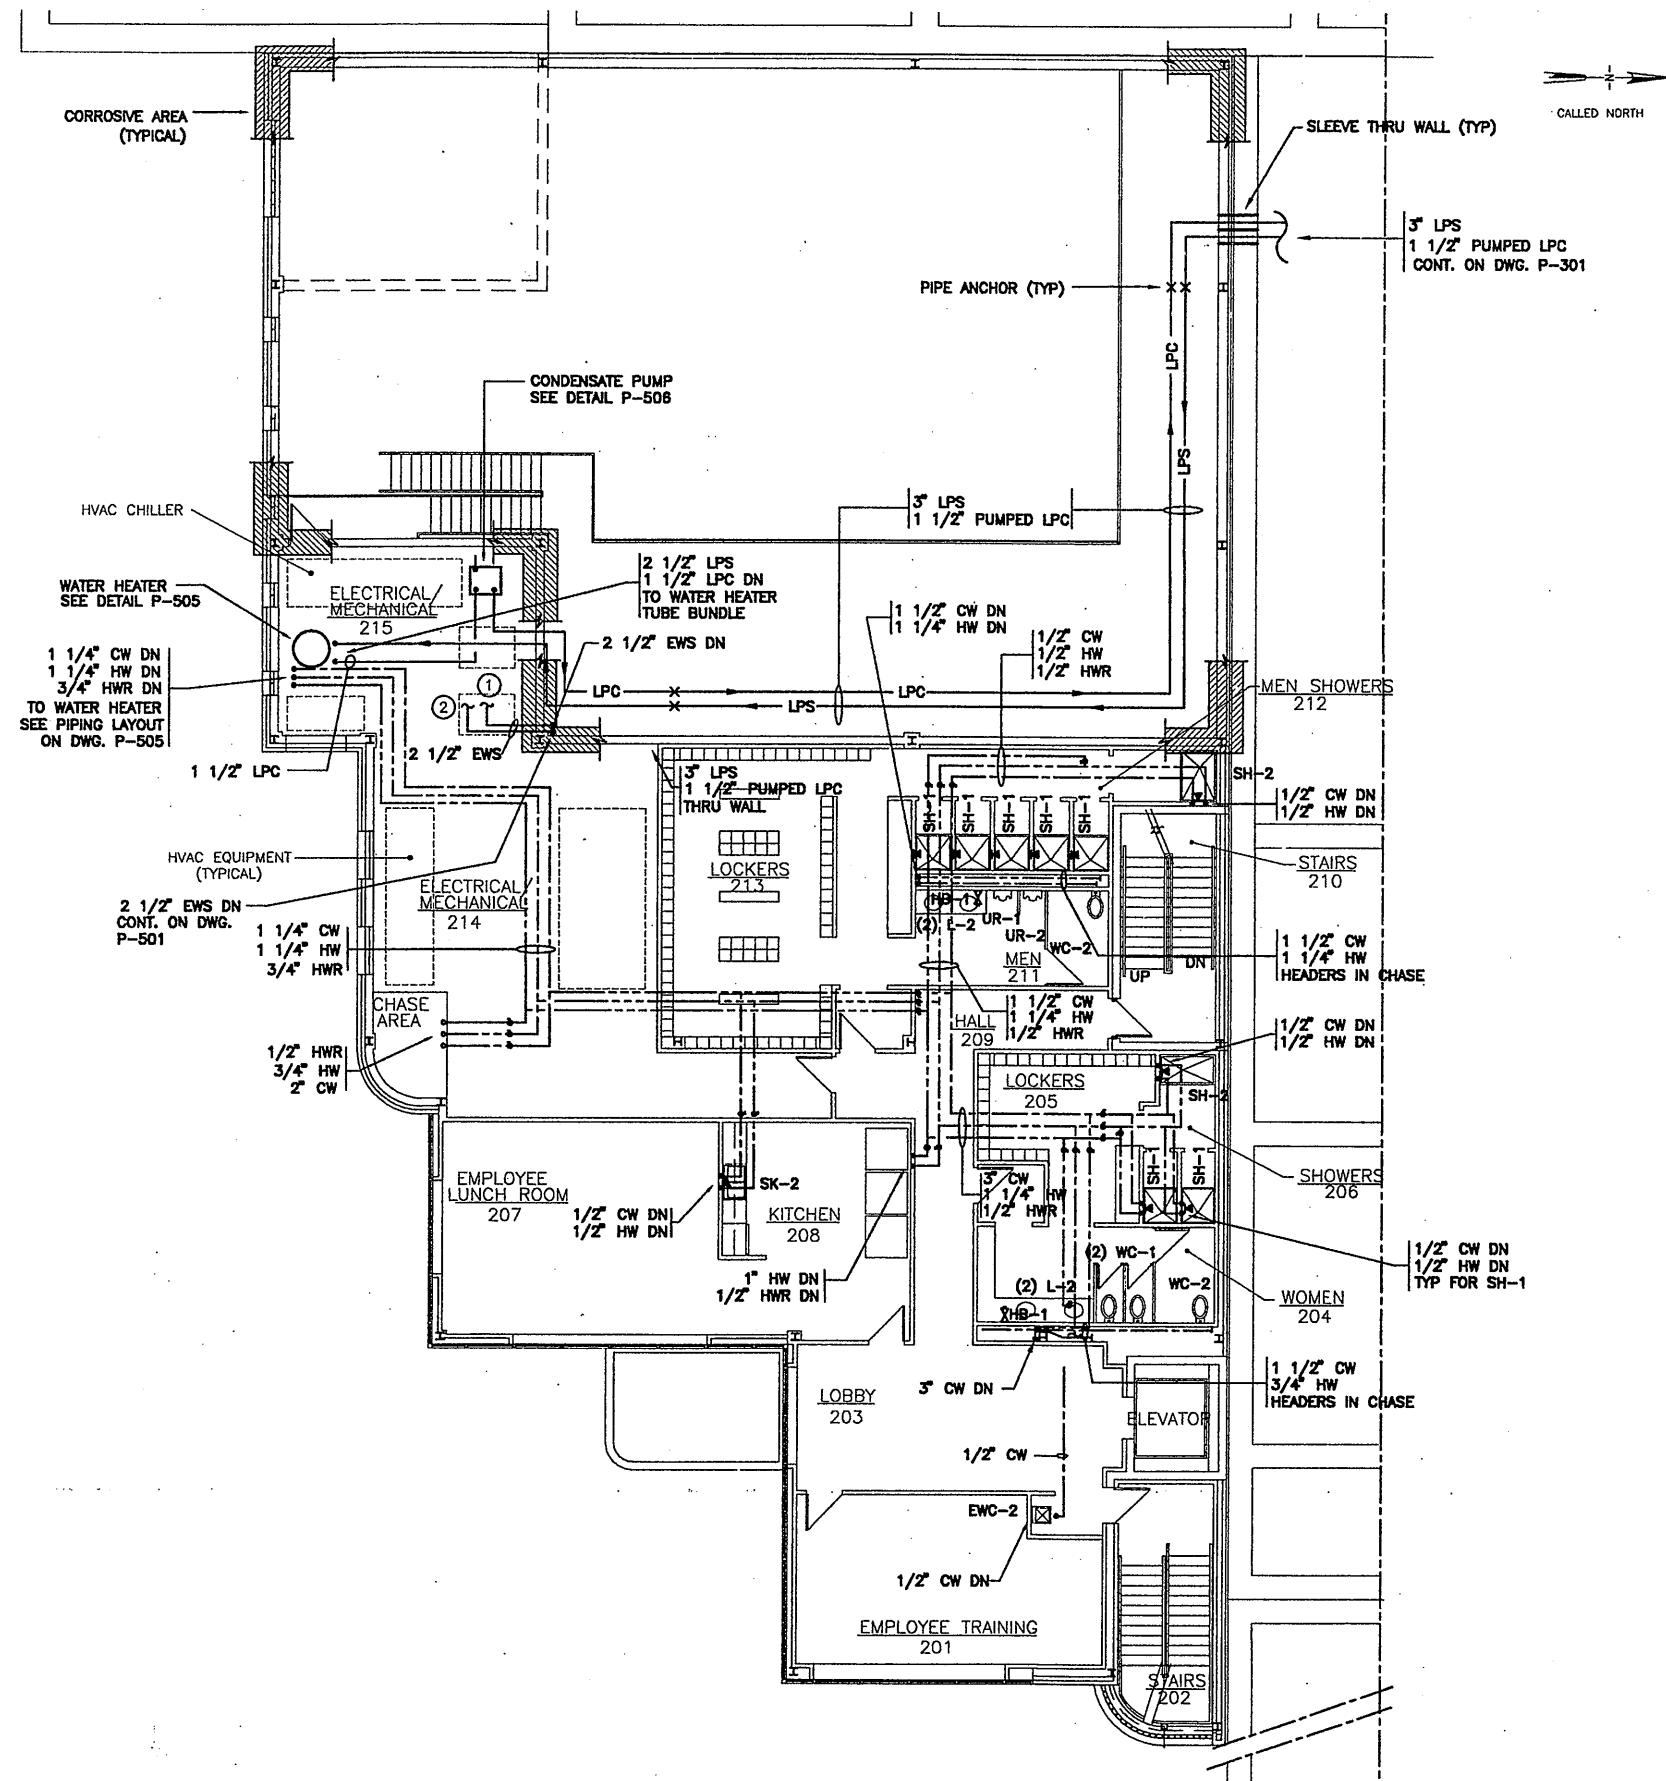

KEYED NOTES: (#)

1. CONNECT 2 1/2" EWS WITH SHUT-OFF VALVE TO 4" HVAC PIPING AT CHILLER CONDENSER INLET. SEE DWG. H-504.
2. CONNECT 2 1/2" EWS WITH SHUT-OFF VALVE TO 4" HVAC PIPING AT CHILLER CONDENSER OUTLET. SEE DWG. H-504.


RECORD DRAWING

THESE DRAWINGS HAVE BEEN REVISED TO REFLECT MAJOR CHANGES, IF ANY, WHICH OCCURRED DURING CONSTRUCTION. REVISIONS ARE BASED UPON INFORMATION SUPPLIED BY CONTRACTOR.

DATE: _____ PER: _____


THIS DRAWING WAS PREPARED AT THE SCALE INDICATED IN THE TITLE BLOCK. INACCURACIES IN THE STATED SCALE MAY BE INTRODUCED WHEN DRAWINGS ARE REPRODUCED BY ANY MEANS. USE THE GRAPHIC SCALE BAR IN THE TITLE BLOCK TO DETERMINE THE ACTUAL SCALE OF THIS DRAWING.

0659X502
06/27/01 RAB AJK/FJS
0659P502A

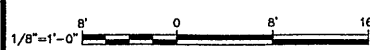

| No. | Date | Revisions | Init |
|-----|---------|---------------------|------|
| 0 | 4/20/01 | ISSUED FOR APPROVAL | |
| 1 | | AS BID | |
| 2 | 1/05 | FOR RECORD | |

In charge of FJS
 Designed by FJS
 Drawn by AJK
 Checked by FJS

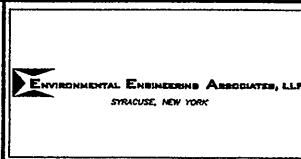


ONONDAGA COUNTY • DEPARTMENT OF DRAINAGE AND SANITATION • SYRACUSE, NEW YORK
 METROPOLITAN SYRACUSE WASTEWATER TREATMENT PLANT
 STAGE III AMMONIA AND STAGE II PHOSPHORUS REMOVAL PROJECT
OPERATIONS CENTER - SECOND FLOOR
PLUMBING PLAN - WATER

File Number
00659
Date
APRIL 2001


P-502A

NO ALTERATIONS PERMITTED HEREON EXCEPT AS PROVIDED UNDER SECTION 7209 SUBDIVISION 2 OF THE NEW YORK STATE EDUCATION LAW

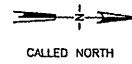

KEYED NOTES: #


1. CONNECT 2" SAN W/ P-TRAP, TO KITCHENETTE FURNISHED BY G.C.
2. VERIFY FIXTURE WITH OWNER.

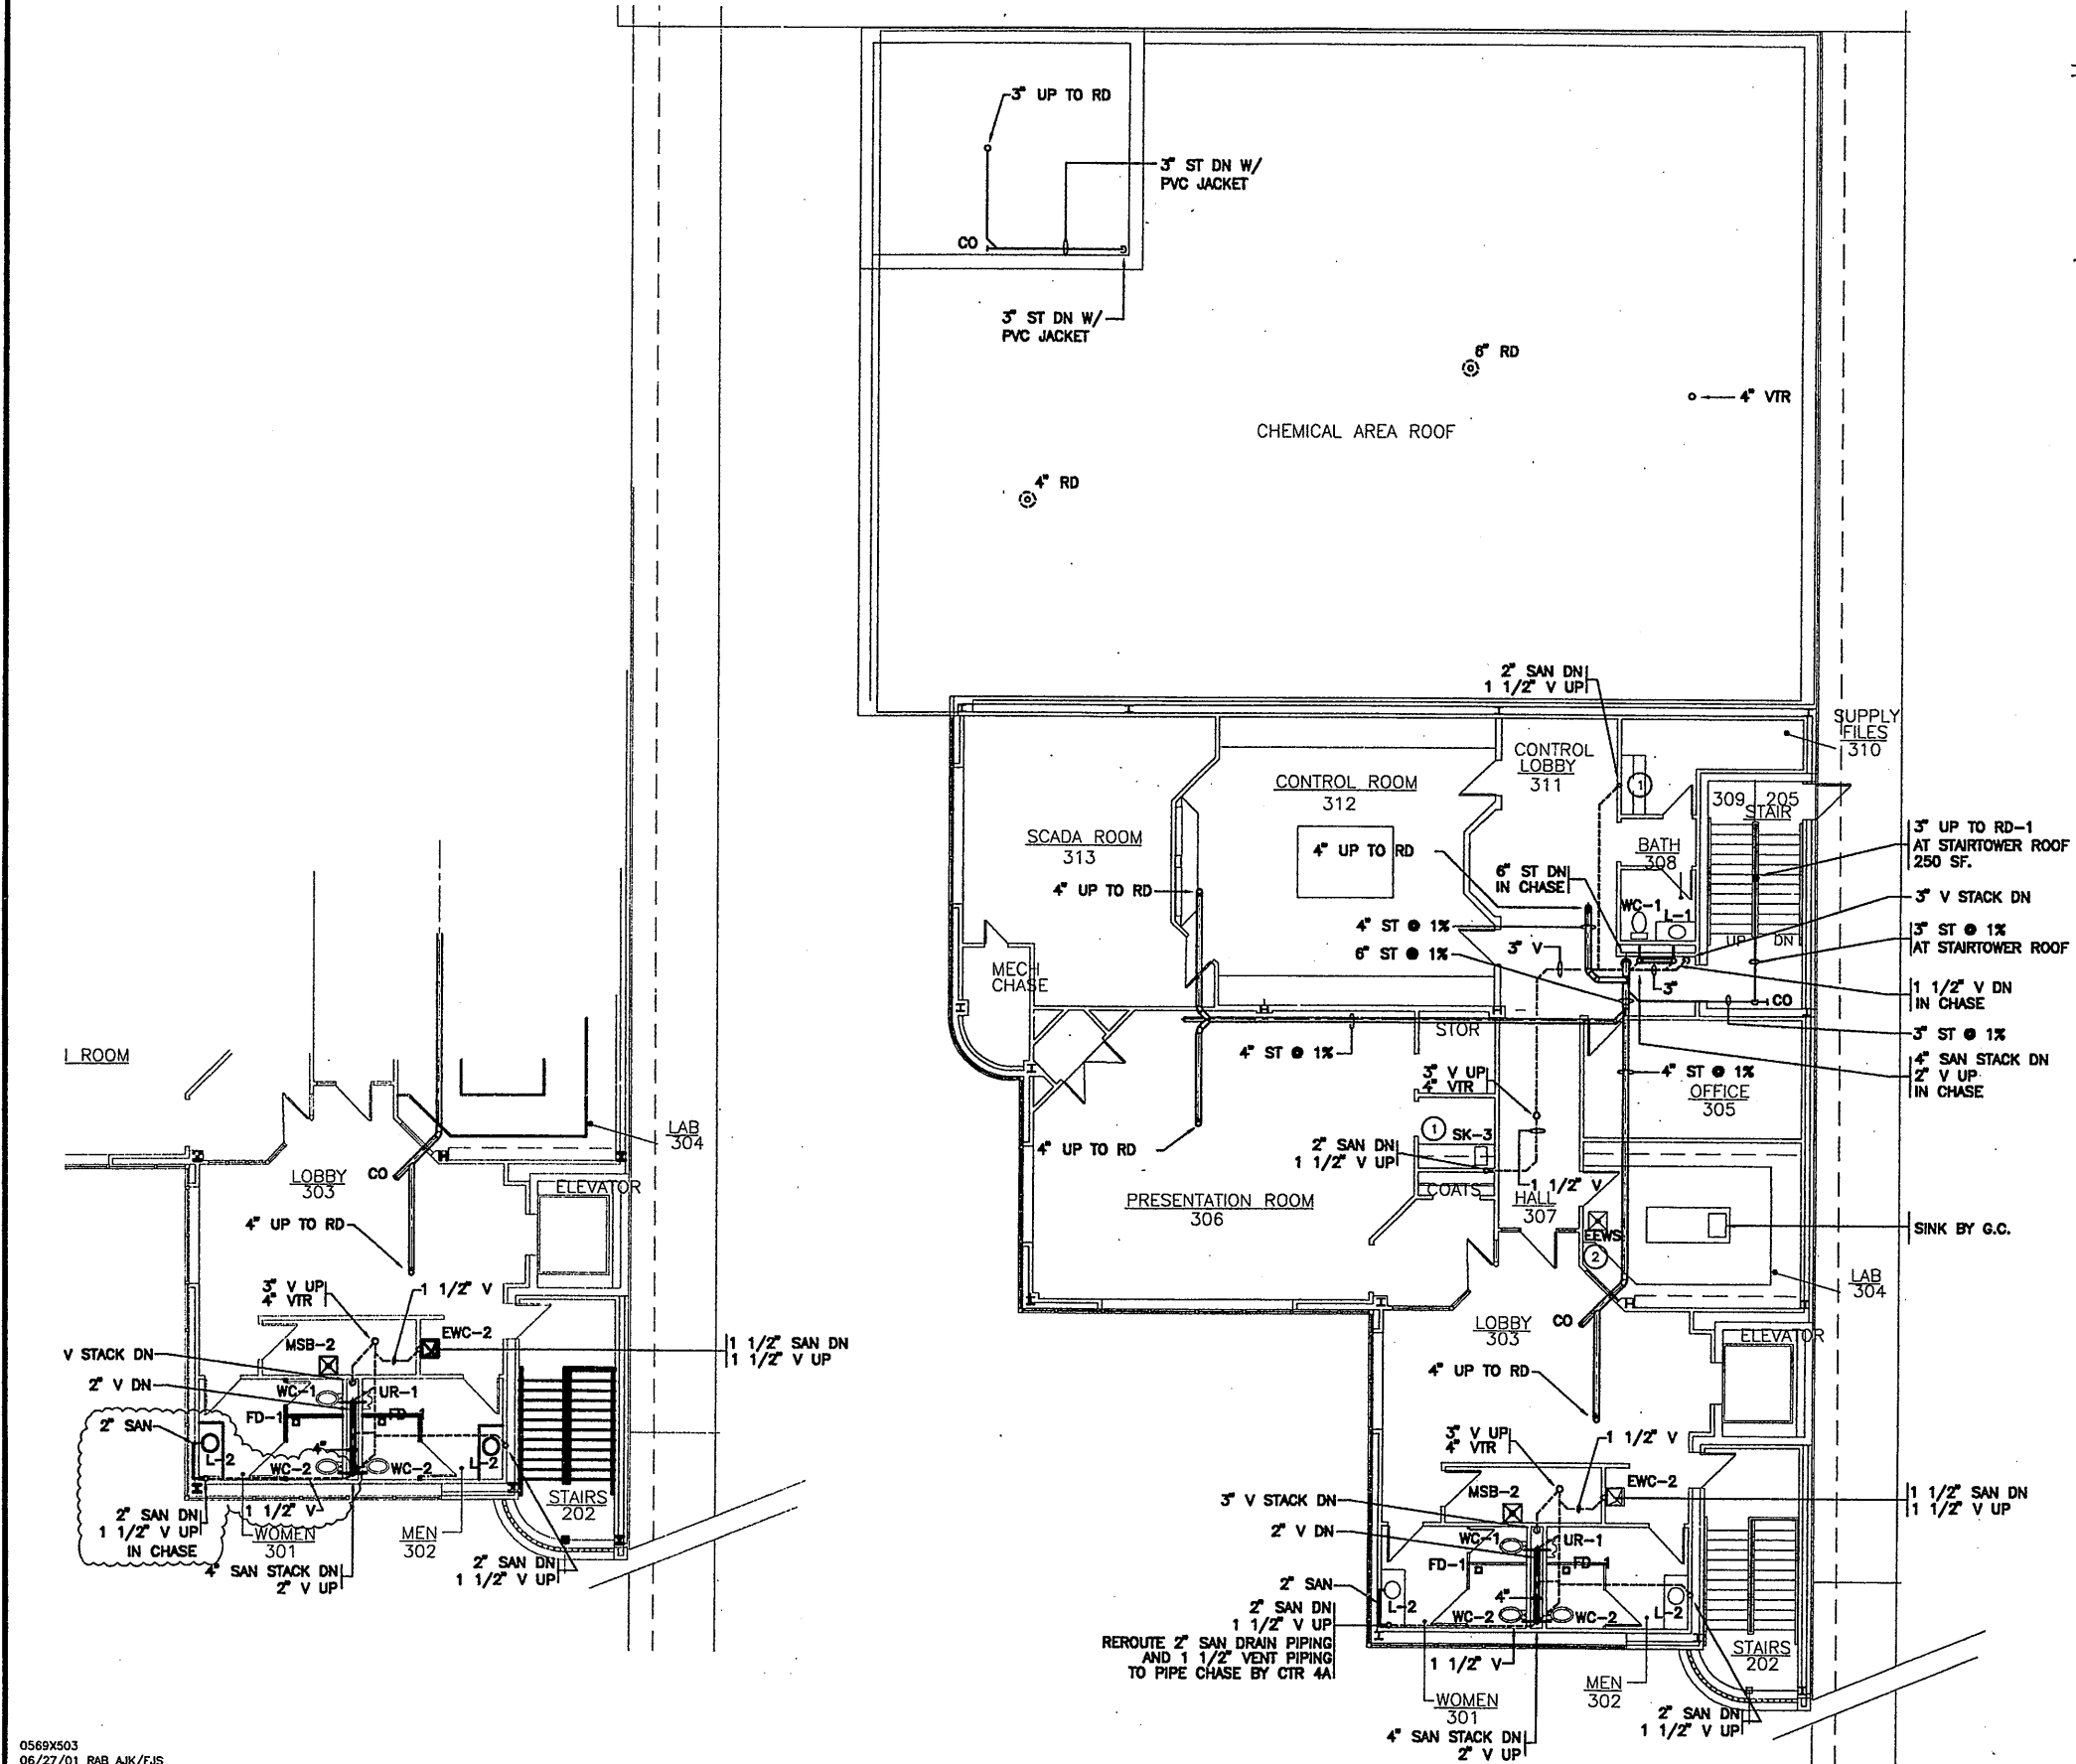

RECORD DRAWING

THESE DRAWINGS HAVE BEEN REVISED TO REFLECT MAJOR CHANGES, IF ANY, WHICH OCCURRED DURING CONSTRUCTION. REVISIONS ARE BASED UPON INFORMATION SUPPLIED BY CONTRACTOR.
 DATE: _____ PER: _____

THIS DRAWING WAS PREPARED AT THE SCALE INDICATED IN THE TITLE BLOCK. INACCURACIES IN THE STATED SCALE MAY BE INTRODUCED WHEN DRAWINGS ARE REPRODUCED BY ANY MEANS. USE THE GRAPHIC SCALE BAR IN THE TITLE BLOCK TO DETERMINE THE ACTUAL SCALE OF THIS DRAWING.

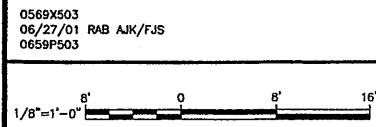

| No. | Date | Revisions | Init |
|-----|---------|---------------------|------|
| 0 | 4/20/01 | ISSUED FOR APPROVAL | |
| 1 | 1/05 | FOR RECORD | |

In charge of FJS
 Designed by FJS
 Drawn by AJK
 Checked by FJS



ENVIRONMENTAL ENGINEERS ASSOCIATED, LLP
 SYRACUSE, NEW YORK



ONONDAGA COUNTY • DEPARTMENT OF DRAINAGE AND SANITATION • SYRACUSE, NEW YORK
 METROPOLITAN SYRACUSE WASTEWATER TREATMENT PLANT
 STAGE III AMMONIA AND STAGE II PHOSPHORUS REMOVAL PROJECT
OPERATIONS CENTER - THIRD FLOOR
PLUMBING PLAN - DRAIN/WASTE/VENT

| | |
|-------------|------------|
| File Number | 00659 |
| Date | APRIL 2001 |
| | P-503 |

PLUMBING

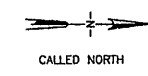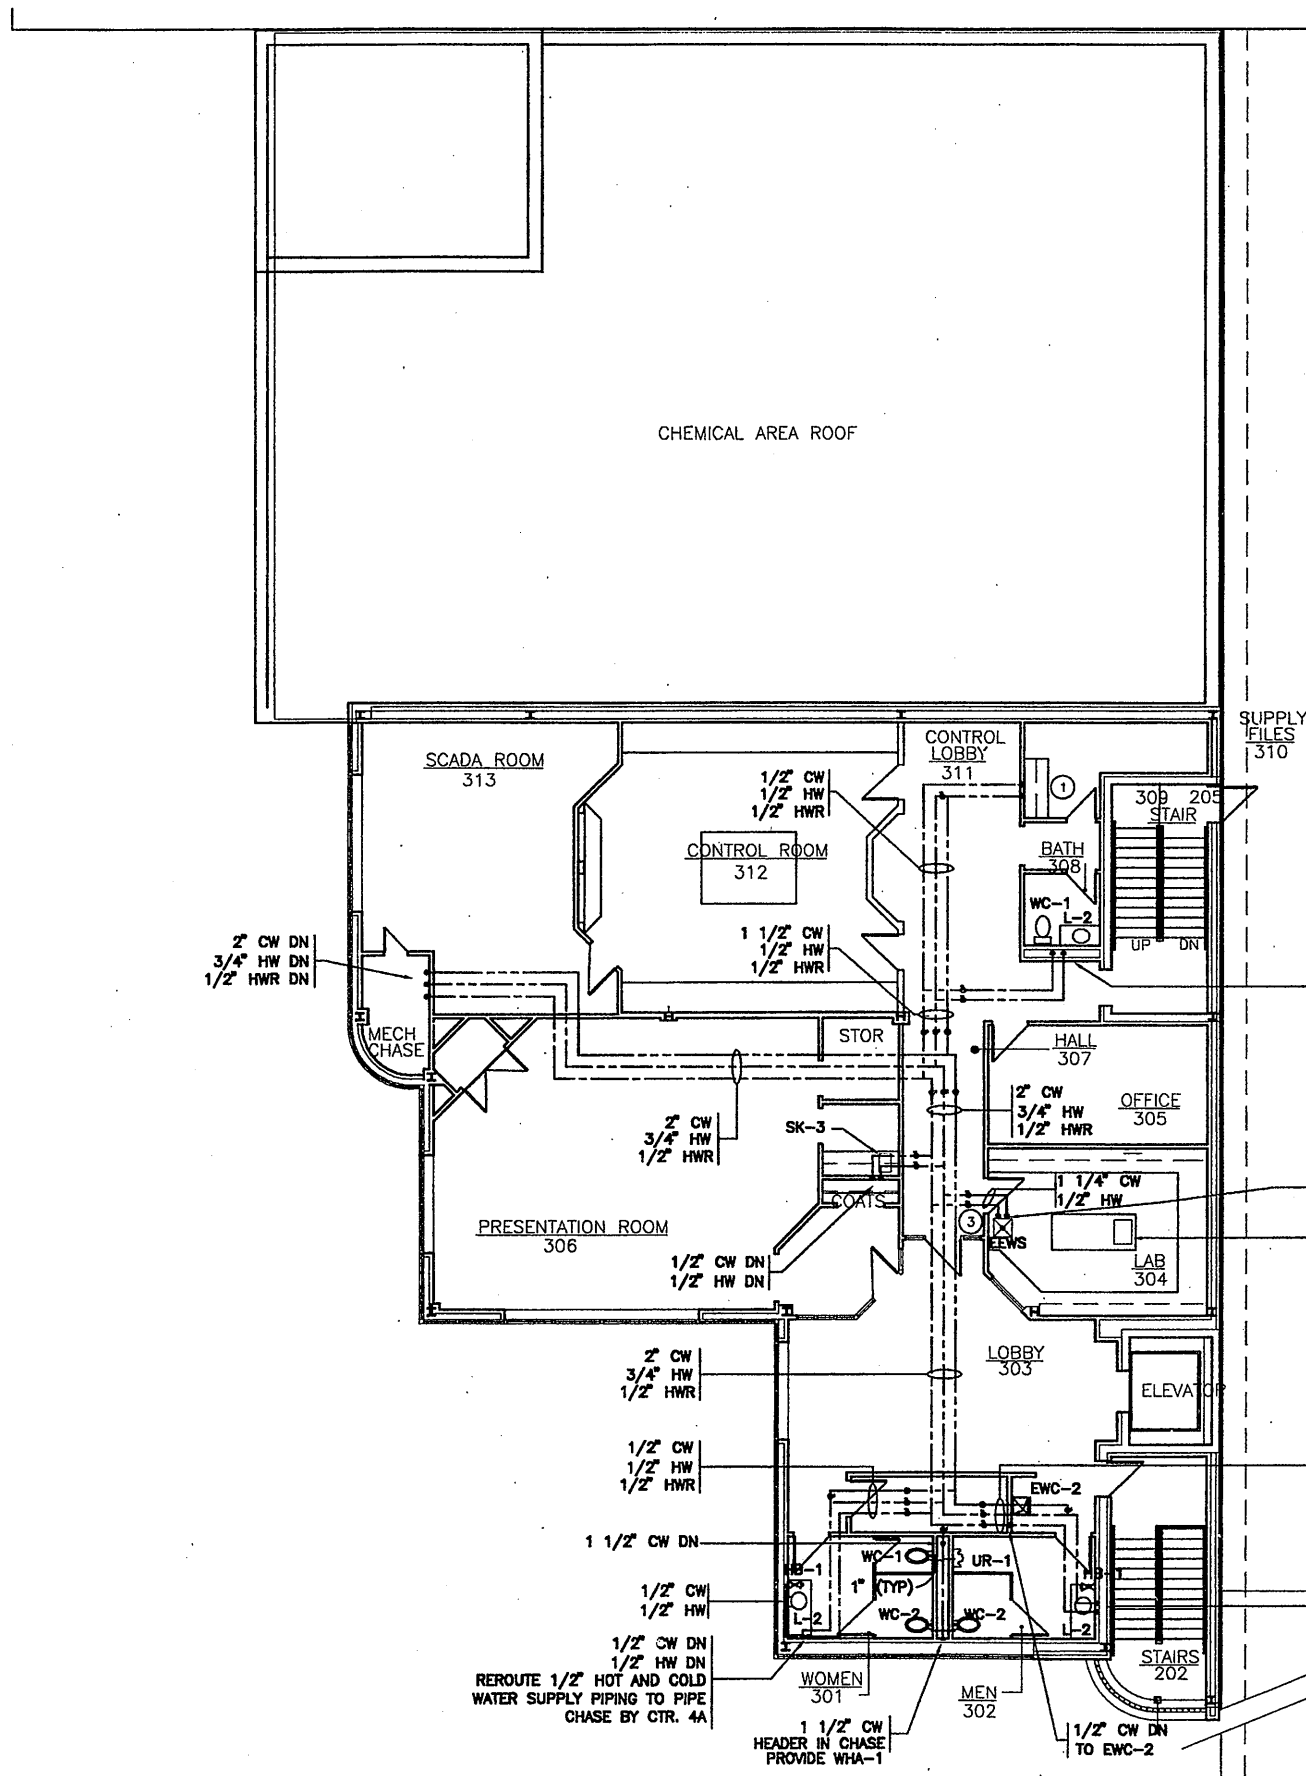

KEYED NOTES: #


1. CONNECT 1/2" CW & HW TO KITCHENETTE
2. VERIFY FIXTURE LOCATION WITH OWNER.

RECORD DRAWING

THESE DRAWINGS HAVE BEEN REVISED TO REFLECT MAJOR CHANGES, IF ANY, WHICH OCCURRED DURING CONSTRUCTION. REVISIONS ARE BASED UPON INFORMATION SUPPLIED BY CONTRACTOR.

DATE: _____ PER: _____

THIS DRAWING WAS PREPARED AT THE SCALE INDICATED IN THE TITLE BLOCK. INACCURACIES IN THE STATED SCALE MAY BE INTRODUCED WHEN DRAWINGS ARE REPRODUCED BY ANY MEANS. USE THE GRAPHIC SCALE BAR IN THE TITLE BLOCK TO DETERMINE THE ACTUAL SCALE OF THIS DRAWING.

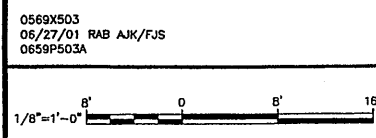

| No. | Date | Revisions | Init |
|-----|---------|---------------------|------|
| 0 | 4/20/01 | ISSUED FOR APPROVAL | |
| 1 | 1/05 | FOR RECORD | |

In charge of FJS
 Designed by FJS
 Drawn by AJK
 Checked by FJS




ONONDAGA COUNTY • DEPARTMENT OF DRAINAGE AND SANITATION • SYRACUSE, NEW YORK
 METROPOLITAN SYRACUSE WASTEWATER TREATMENT PLANT
 STAGE III AMMONIA AND STAGE II PHOSPHORUS REMOVAL PROJECT
OPERATIONS CENTER - THIRD FLOOR
PLUMBING PLAN - WATER

| | |
|-------------|---------------|
| File Number | 00659 |
| Date | APRIL 2001 |
| | P-503A |

NO ALTERATIONS PERMITTED HEREON EXCEPT AS PROVIDED UNDER SECTION 7209 SUBDIVISION 2 OF THE NEW YORK STATE EDUCATION LAW

PLUMBING

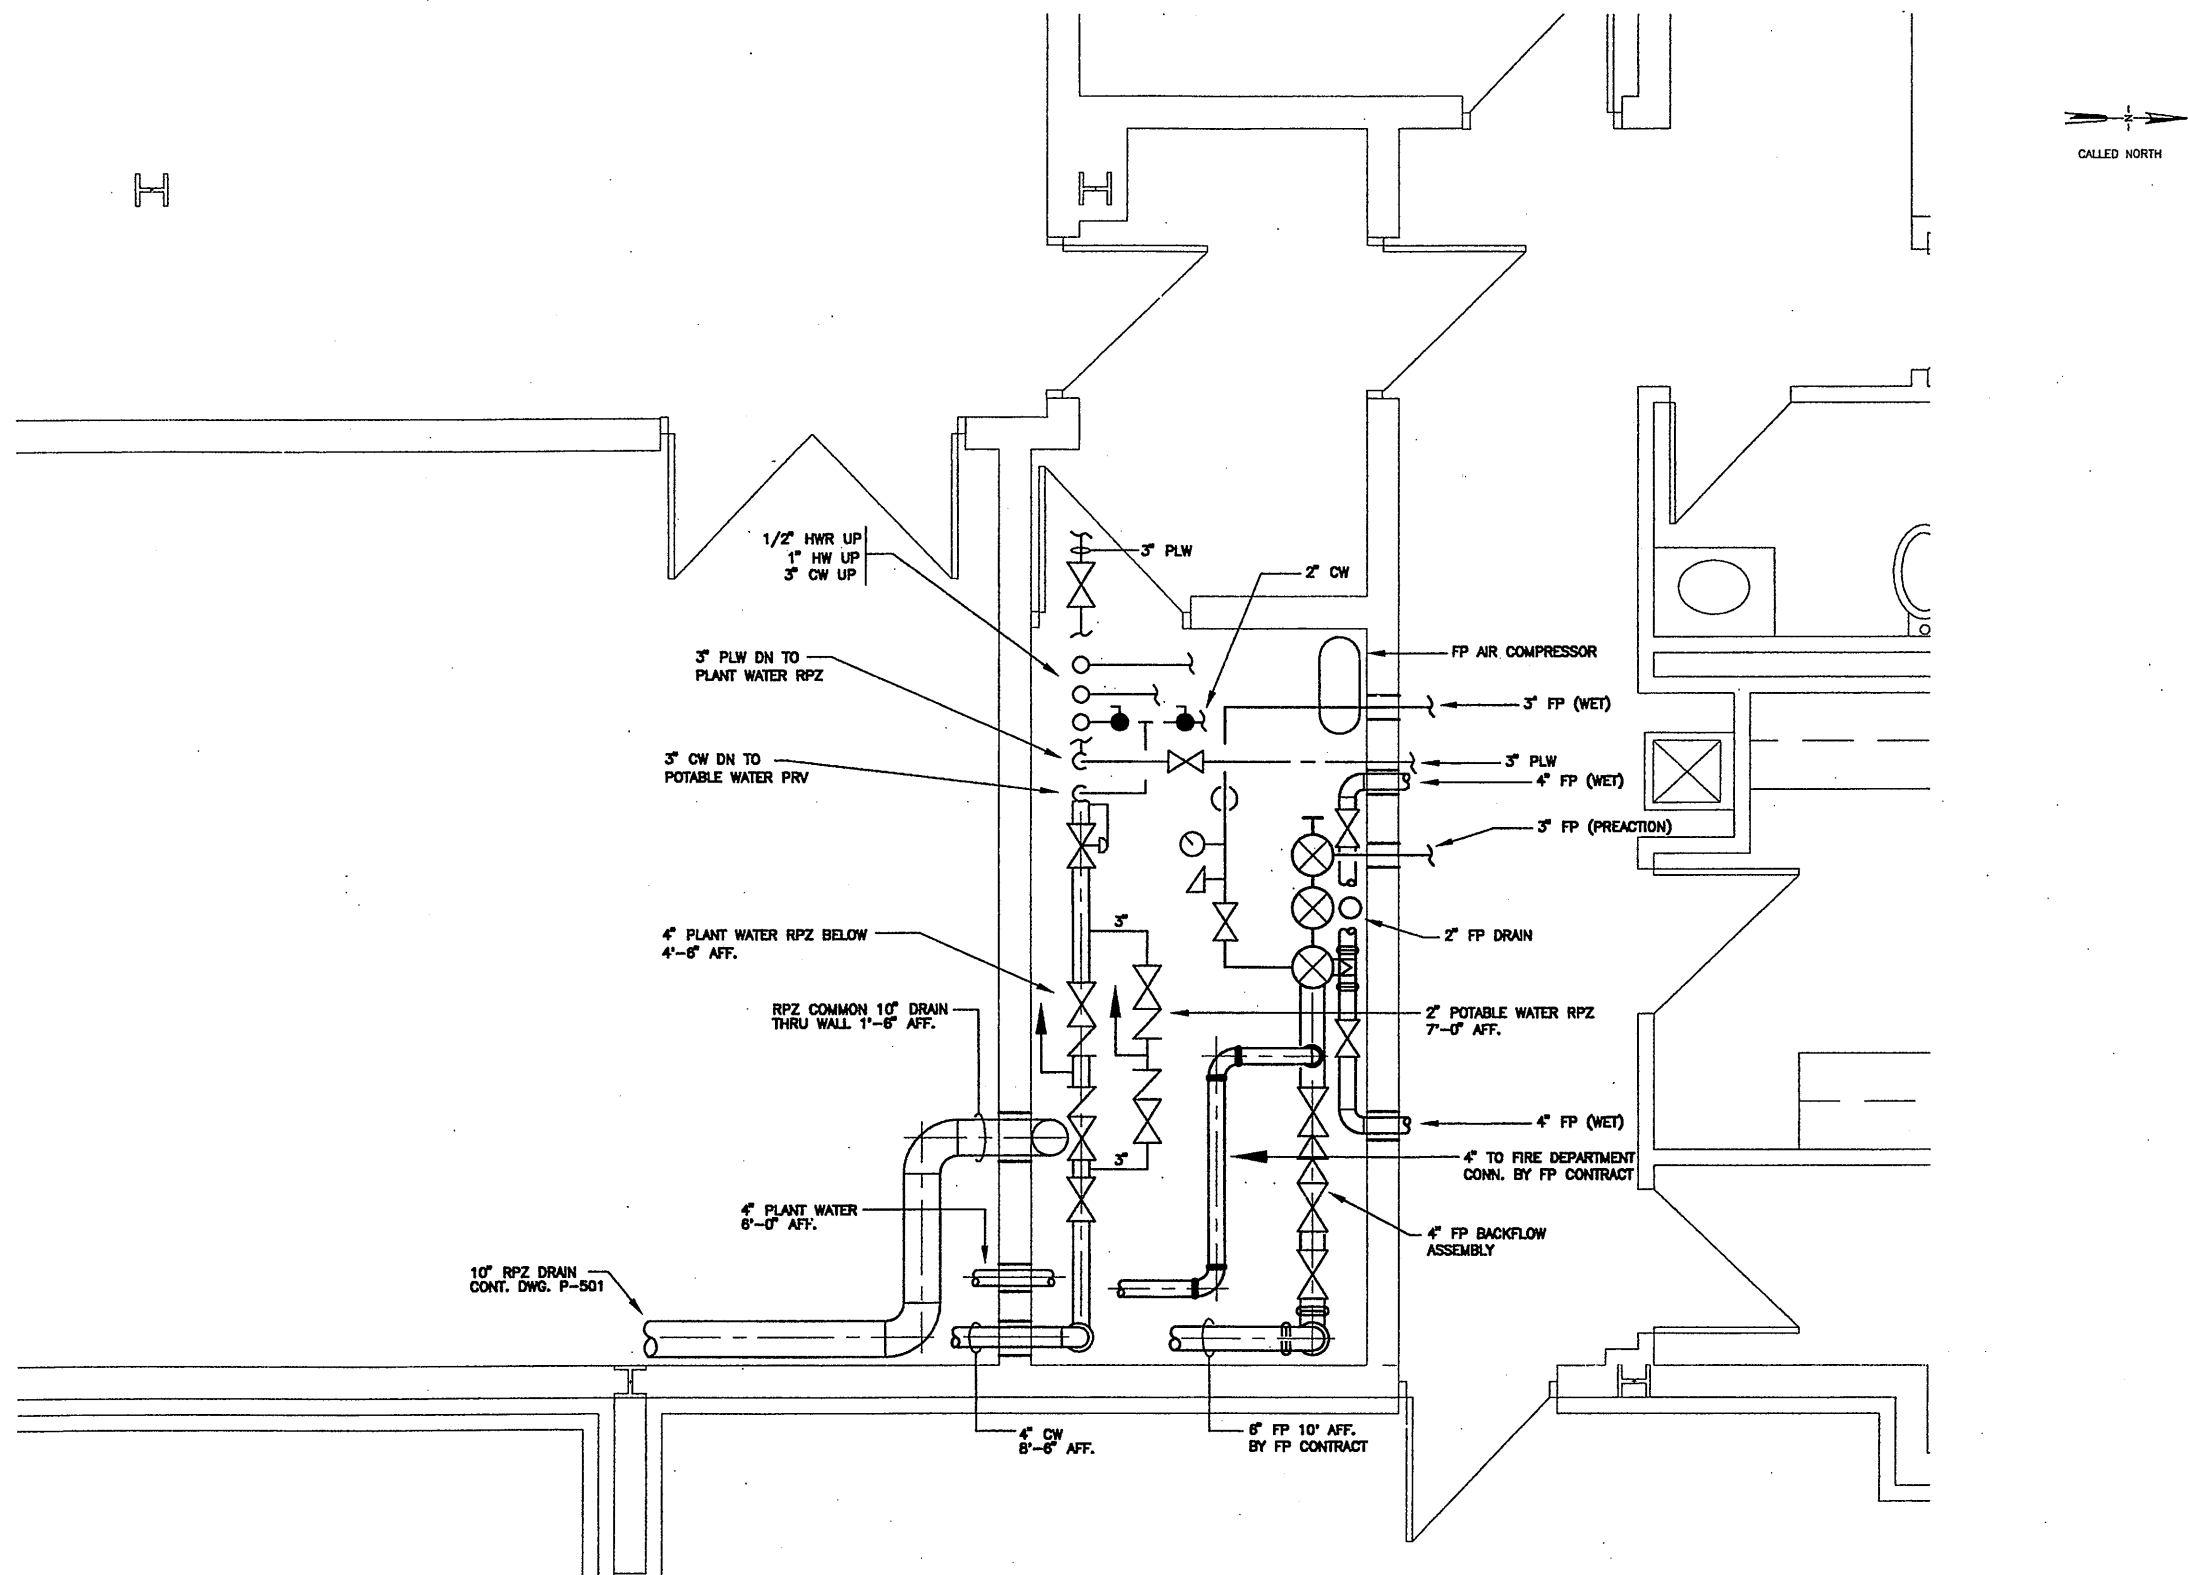

SPRINKLER ROOM PLAN - OPERATIONS CENTER
SCALE: 1/2"=1'-0"


RECORD DRAWING

THESE DRAWINGS HAVE BEEN REVISED TO REFLECT MAJOR CHANGES, IF ANY, WHICH OCCURRED DURING CONSTRUCTION. REVISIONS ARE BASED UPON INFORMATION SUPPLIED BY CONTRACTOR.

DATE: _____ PER: _____

THIS DRAWING WAS PREPARED AT THE SCALE INDICATED IN THE TITLE BLOCK. INACCURACIES IN THE STATED SCALE MAY BE INTRODUCED WHEN DRAWINGS ARE REPRODUCED BY ANY MEANS. USE THE GRAPHIC SCALE BAR IN THE TITLE BLOCK TO DETERMINE THE ACTUAL SCALE OF THIS DRAWING.

0659X501
06/27/01 RAB AJK/FJS
0659P504

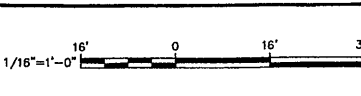

| No. | Date | Revisions | Init |
|-----|---------|---------------------|------|
| 0 | 4/20/01 | ISSUED FOR APPROVAL | |
| 1 | | AS BID | |
| 2 | 1/05 | FOR RECORD | |

In charge of FJS
Designed by FJS
Drawn by AJK
Checked by FJS









ONONDAGA COUNTY • DEPARTMENT OF DRAINAGE AND SANITATION • SYRACUSE, NEW YORK
METROPOLITAN SYRACUSE WASTEWATER TREATMENT PLANT
STAGE III AMMONIA AND STAGE II PHOSPHORUS REMOVAL PROJECT
**OPERATIONS CENTER
SPRINKLER ROOM PLAN**

| |
|----------------------|
| File Number 00659 |
| Date APRIL 2001 |

P-504

NO ALTERATIONS PERMITTED HEREON EXCEPT AS PROVIDED UNDER SECTION 7209 SUBDIVISION 2 OF THE NEW YORK STATE EDUCATION LAW

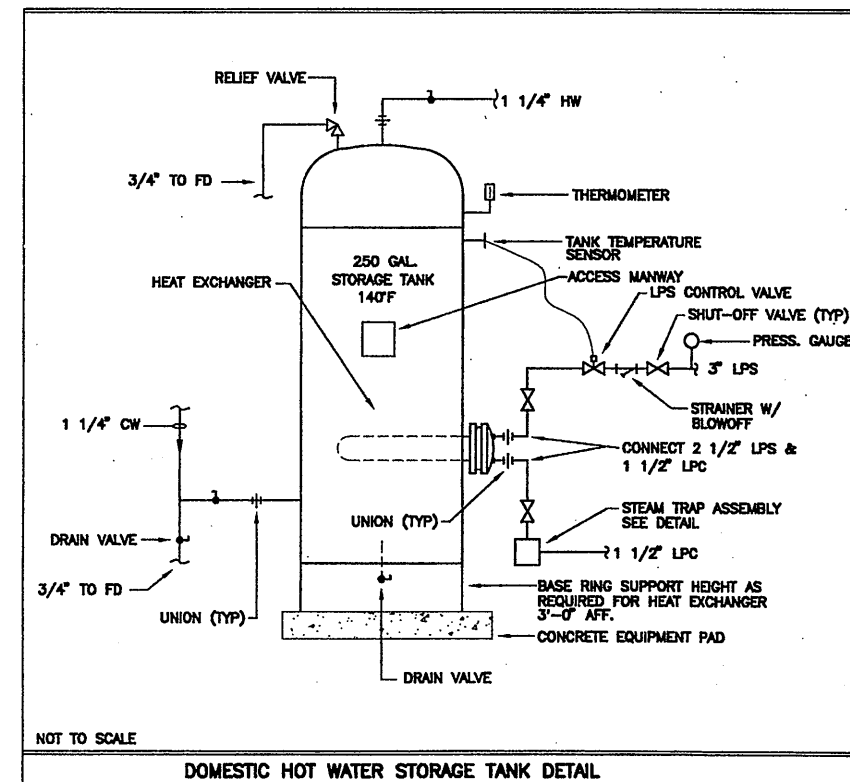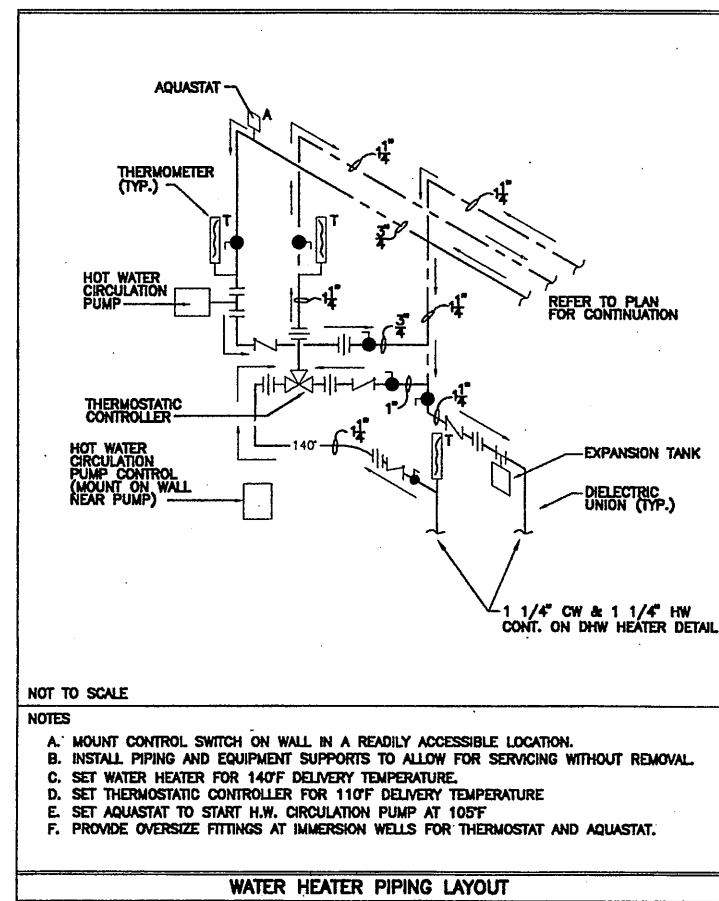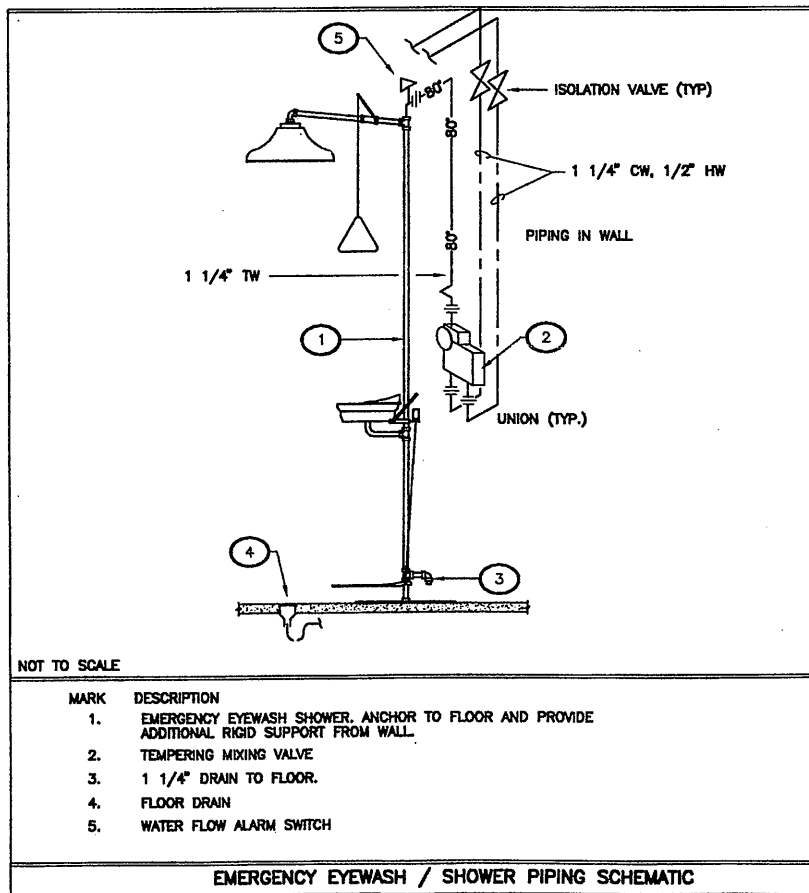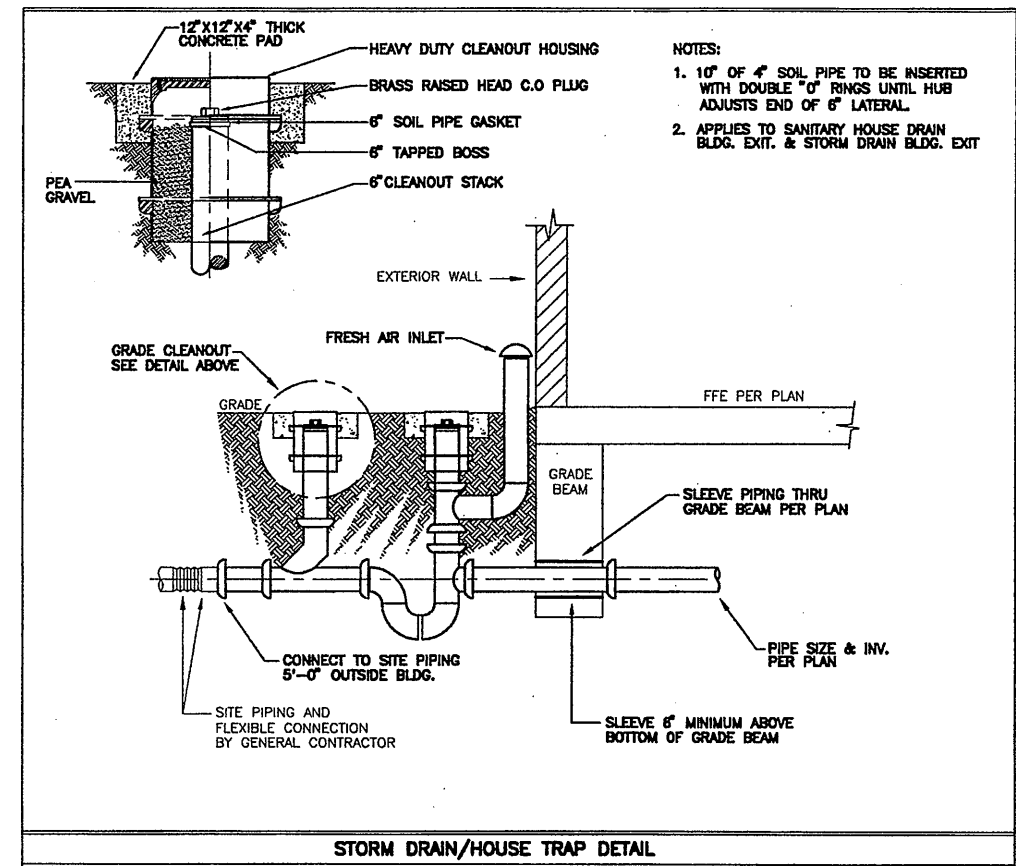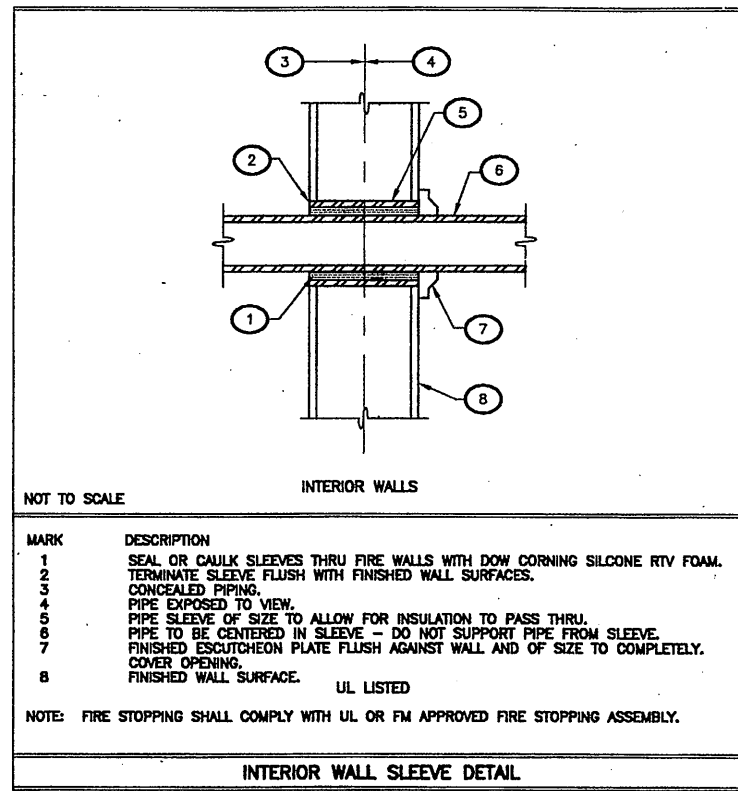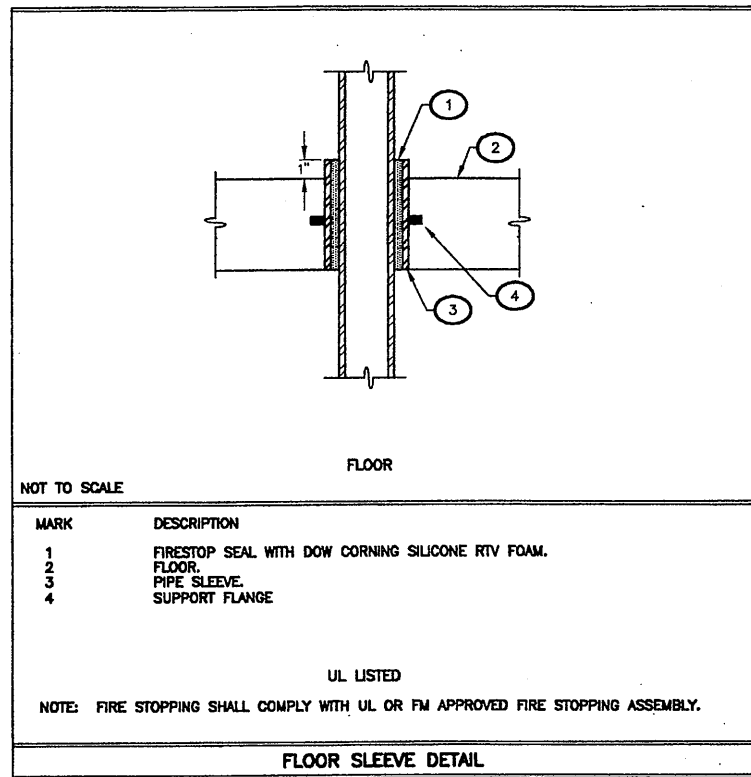

RECORD DRAWING

THESE DRAWINGS HAVE BEEN REVISED TO REFLECT MAJOR CHANGES, IF ANY, WHICH OCCURRED DURING CONSTRUCTION. REVISIONS ARE BASED UPON INFORMATION SUPPLIED BY CONTRACTOR.

DATE: _____ PER: _____


THIS DRAWING WAS PREPARED AT THE SCALE INDICATED IN THE TITLE BLOCK. INACCURACIES IN THE STATED SCALE MAY BE INTRODUCED WHEN DRAWINGS ARE REPRODUCED BY ANY MEANS. USE THE GRAPHIC SCALE BAR IN THE TITLE BLOCK TO DETERMINE THE ACTUAL SCALE OF THIS DRAWING.

06/27/01 RAB AJK/FJS
0659P505

NO SCALE

| No. | Date | Revisions | Init |
|-----|---------|---------------------|------|
| 0 | 4/20/01 | ISSUED FOR APPROVAL | |
| 1 | | AS BID | |
| 2 | 1/05 | FOR RECORD | |

In charge of FJS
 Designed by FJS
 Drawn by AJK
 Checked by FJS

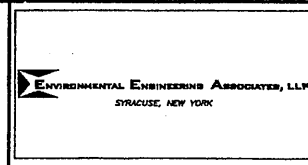

ONONDAGA COUNTY • DEPARTMENT OF DRAINAGE AND SANITATION • SYRACUSE, NEW YORK
 METROPOLITAN SYRACUSE WASTEWATER TREATMENT PLANT
 STAGE III AMMONIA AND STAGE II PHOSPHORUS REMOVAL PROJECT

MISCELLANEOUS DETAILS

PLUMBING

File Number
00659
Date
APRIL 2001

P-505





CONDENSATE PUMP SCHEDULE

| UNIT ID | LOCATION | #/HR | PUMP | | | | | | | NO. OF PUMPS | RECEIVER SIZE | DESIGN MAKE | NOTES |
|---------|-----------------------|------|------|-------|----|------|-------|----|---|--------------|------------------|-------------|-------|
| | | | GPM | HEAD | HP | RPM | VOLTS | PH | | | | | |
| CP-1 | OP. CENTER MECH. ROOM | 500 | 6 | 65psi | 3 | 3500 | 460 | 3 | 2 | 23 GALLONS | DOMESTIC 97.5 CC | 1, 2 | |

NOTES:
 1. PROVIDE UNIT MOUNTED DUPLEX CONTROL PANEL WITH MECHANICAL PUMP ALTERNATION
 2. PROVIDE HIGH WATER LEVEL ALARM

PRESSURE REDUCING VALVE SCHEDULE

| MARK | SERVICE | GPM | PSIG IN | PSIG OUT | SIZE | NOTES |
|-------|-----------------------|-----|---------|----------|--------|-------|
| PRV-1 | POTABLE WATER SERVICE | 80 | 90 | 60 | 2" | --- |
| PRV-2 | PUMP SEAL WATER | 25 | 90 | 30 | 3/4" | --- |
| PRV-3 | DECK HYDRANTS | 60 | 90 | 30 | 1 1/4" | --- |

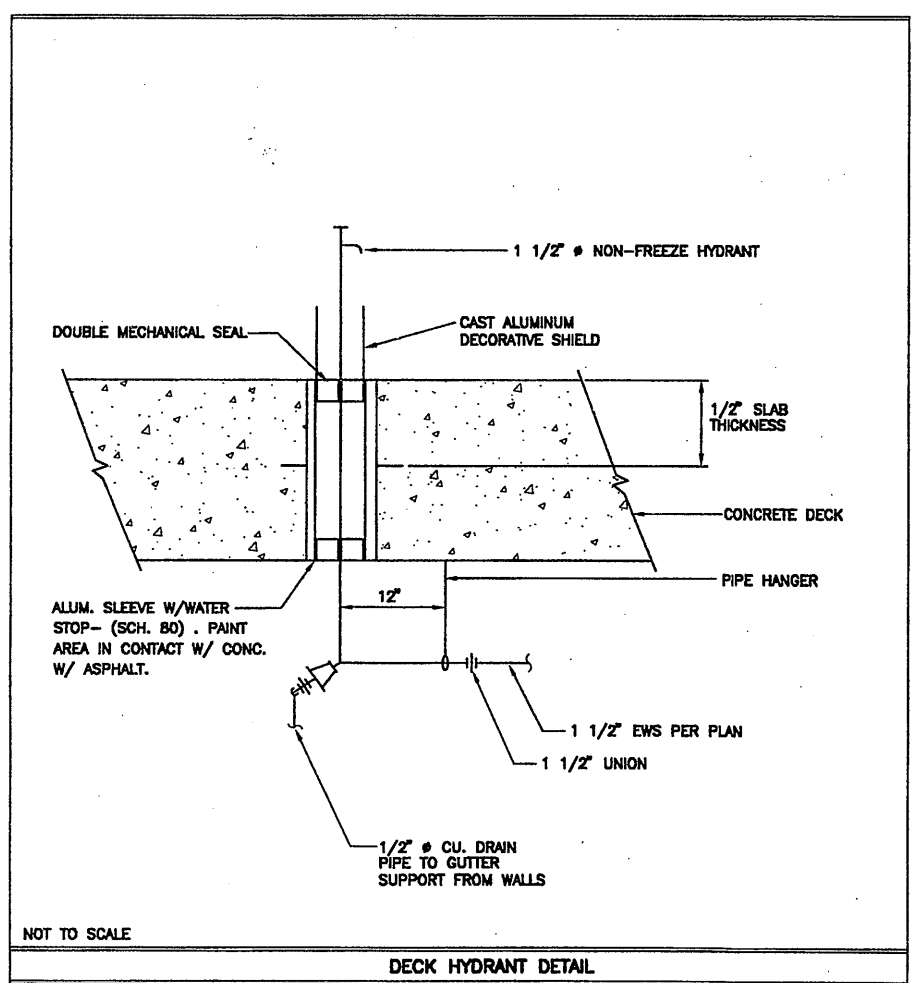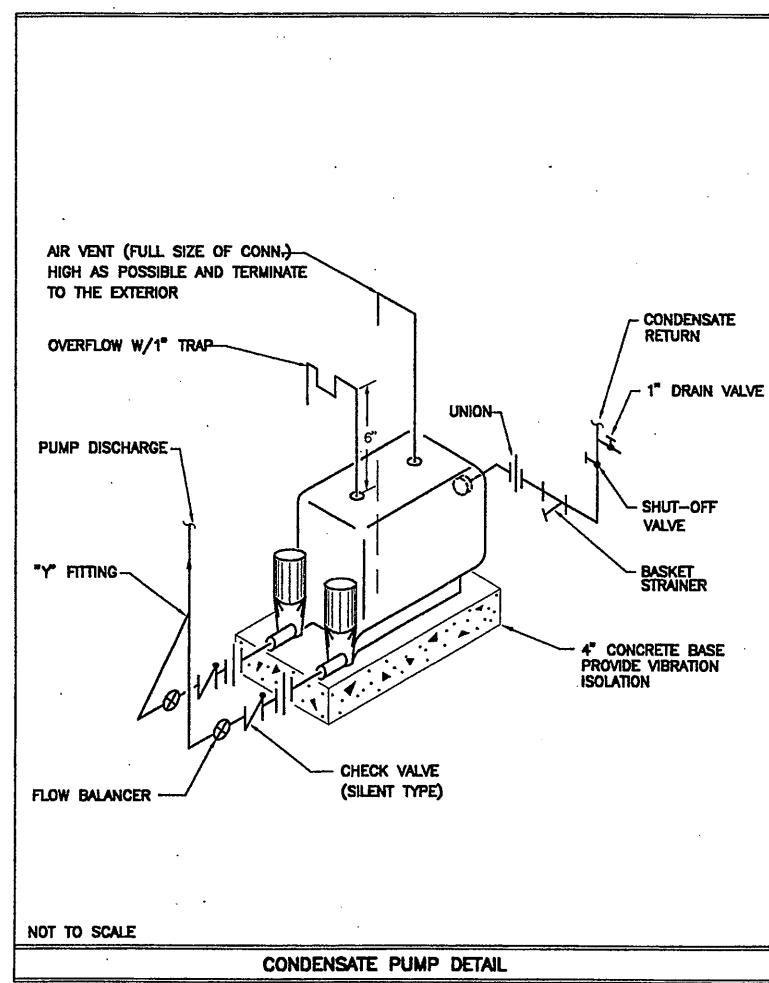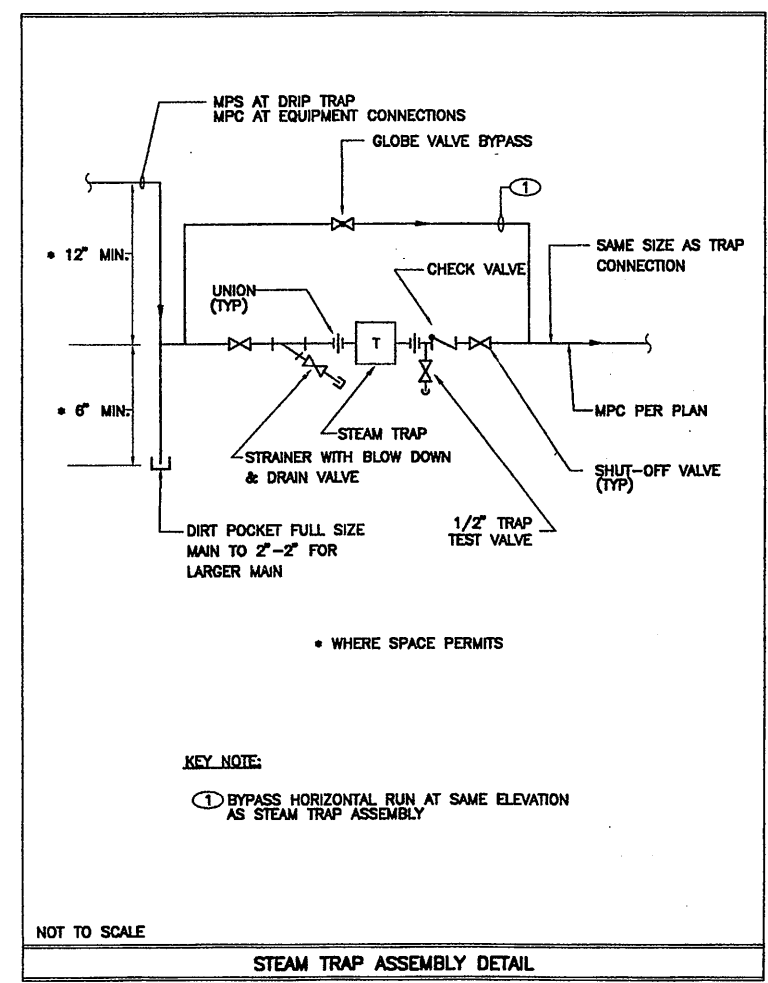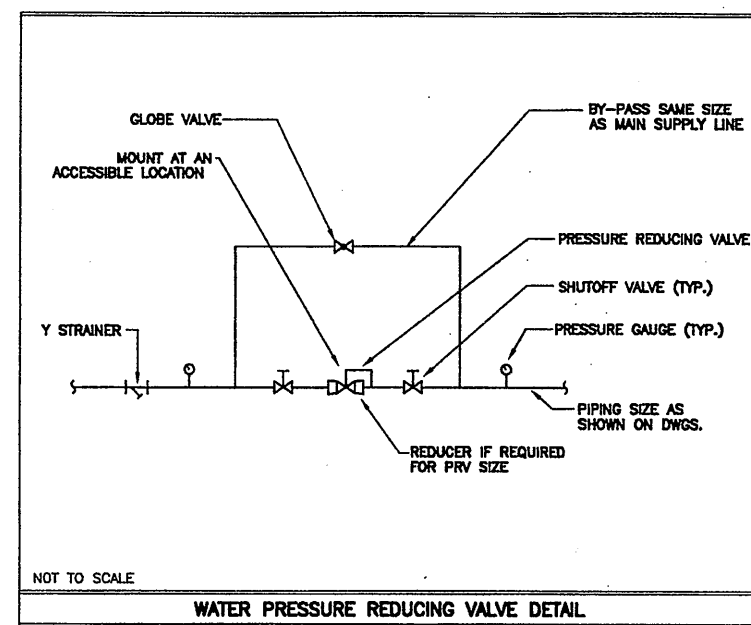

RECORD DRAWING
 THESE DRAWINGS HAVE BEEN REVISED TO REFLECT MAJOR CHANGES, IF ANY, WHICH OCCURRED DURING CONSTRUCTION. REVISIONS ARE BASED UPON INFORMATION SUPPLIED BY CONTRACTOR.
 DATE: _____ PER: _____



06/27/01 RAB AJK/FJS
 0659P506

NO SCALE

NO ALTERATIONS PERMITTED HEREON EXCEPT AS PROVIDED UNDER SECTION 7209 SUBDIVISION 2 OF THE NEW YORK STATE EDUCATION LAW

| No. | Date | Revisions | Init |
|-----|---------|---------------------|------|
| 0 | 4/20/01 | ISSUED FOR APPROVAL | |
| 1 | | AS BID | |
| 2 | 1/05 | FOR RECORD | |

In charge of FJS
 Designed by FJS
 Drawn by AJK
 Checked by FJS

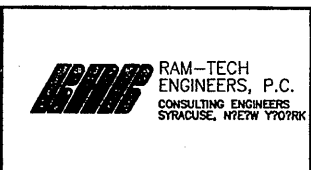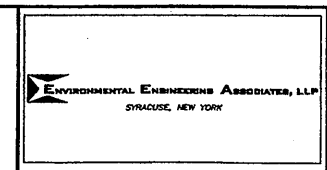

ONONDAGA COUNTY • DEPARTMENT OF DRAINAGE AND SANITATION • SYRACUSE, NEW YORK
 METROPOLITAN SYRACUSE WASTEWATER TREATMENT PLANT
 STAGE III AMMONIA AND STAGE II PHOSPHORUS REMOVAL PROJECT


MISCELLANEOUS DETAILS & SCHEDULE
 PLUMBING

File Number
 00659


Date
 APRIL 2001

P-506


THIS DRAWING WAS PREPARED AT THE SCALE INDICATED IN THE TITLE BLOCK. INACCURACIES IN THE STATED SCALE MAY BE INTRODUCED WHEN DRAWINGS ARE REPRODUCED BY ANY MEANS. USE THE GRAPHIC SCALE BAR IN THE TITLE BLOCK TO DETERMINE THE ACTUAL SCALE OF THIS DRAWING.

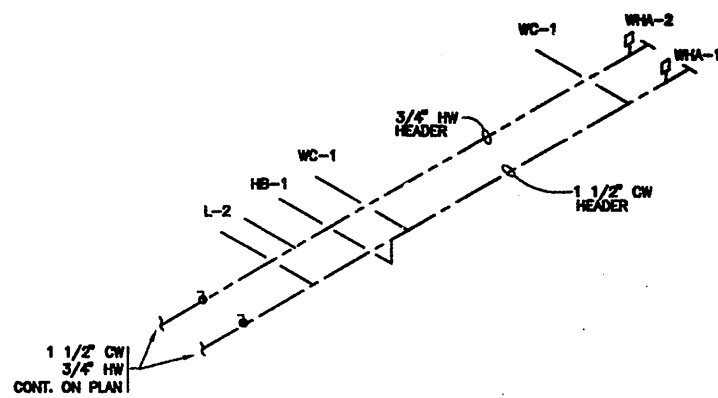


TOILET #111 & #112 WATER SUPPLY SCHEMATIC
NOT TO SCALE

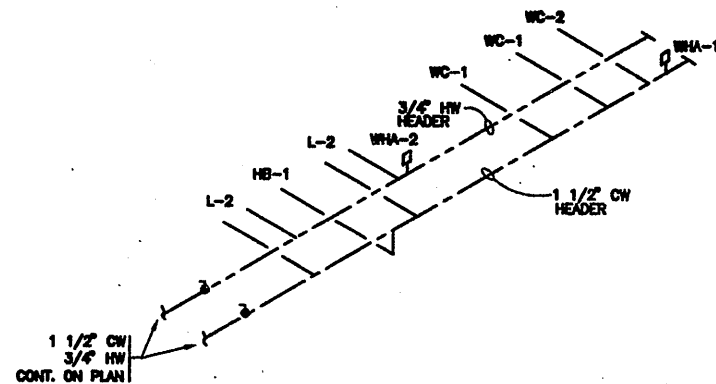


TOILET #204 WATER SUPPLY SCHEMATIC
NOT TO SCALE

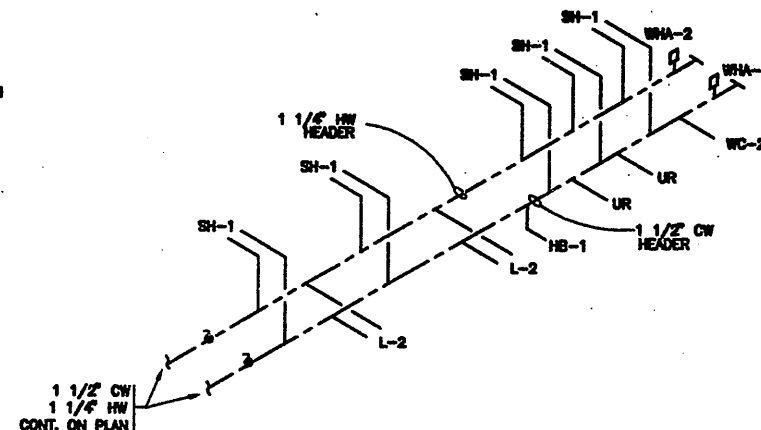


TOILET #211 WATER SUPPLY SCHEMATIC
NOT TO SCALE

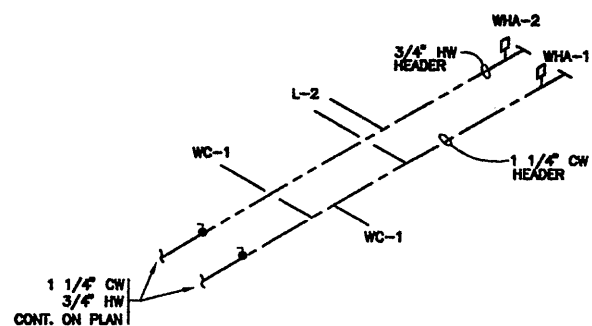

TOILET #308 WATER SUPPLY SCHEMATIC
NOT TO SCALE

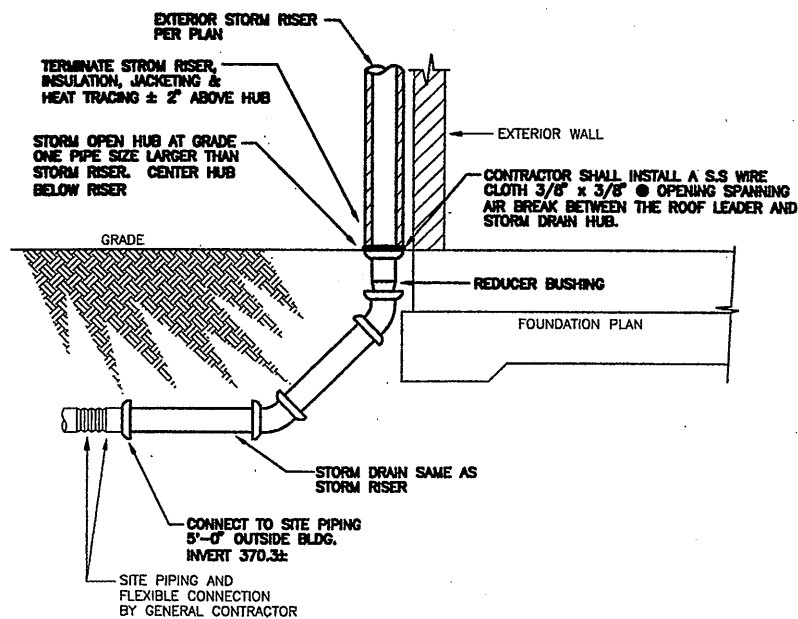


EXTERIOR STORM DRAIN DETAIL
NOT TO SCALE

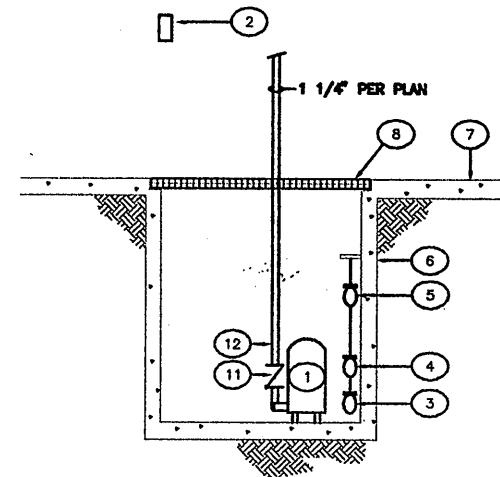

- | | |
|--|--------------|
| 1 SUMP PUMP | 9 NOT USED |
| 2 REMOTE HIGH WATER ALARM | 10 NOT USED |
| 3 PUMP OFF | 11 1 1/2\"/> |
| 4 LEAD PUMP ON | 12 1 1/4\"/> |
| 5 HIGH WATER ALARM | |
| 6 18\"/> | |
| 7 FINISHED FLOOR ELEVATOR | |
| 8 HEAVY DUTY OPEN GRID STEEL COVER BY GC | |

SUMP PUMP DETAIL
NOT TO SCALE

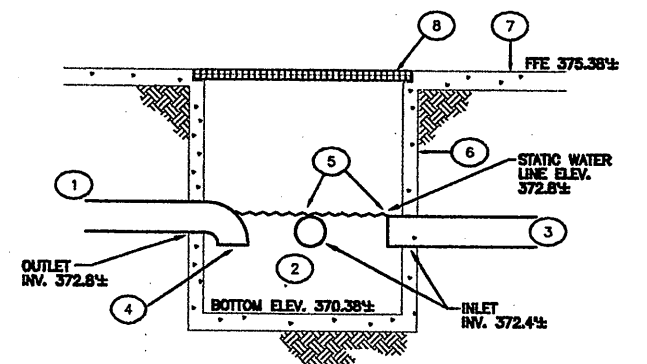

- | |
|--|
| 1 4\"/> |
| 2 4\"/> |
| 3 4\"/> |
| 4 OUTLET INV. 4\"/> |
| 5 TOP OF INLET HUB. 24\"/> |
| 6 36\"/> |
| 7 FINISHED FLOOR ELEVATOR |
| 8 HEAVY DUTY OPEN GRID STEEL COVER BY GC |

SEDIMENT INTERCEPTER DETAIL
NOT TO SCALE

RECORD DRAWING

THESE DRAWINGS HAVE BEEN REVISED TO REFLECT MAJOR CHANGES, IF ANY, WHICH OCCURRED DURING CONSTRUCTION. REVISIONS ARE BASED UPON INFORMATION SUPPLIED BY CONTRACTOR.

DATE: _____ PER: _____

THIS DRAWING WAS PREPARED AT THE SCALE INDICATED IN THE TITLE BLOCK. INACCURACIES IN THE STATED SCALE MAY BE INTRODUCED WHEN DRAWINGS ARE REPRODUCED BY ANY MEANS. USE THE GRAPHIC SCALE BAR IN THE TITLE BLOCK TO DETERMINE THE ACTUAL SCALE OF THIS DRAWING.

06/27/01 RAB AJK/FJS
0659P507

| | | | | | | | | | | |
|----------|-----|---------|---------------------|------|-------------------------|-------------------------------|--|---|-------------|-------|
| NO SCALE | No. | Date | Revisions | Init | In charge of <u>FJS</u> | | | ONONDAGA COUNTY • DEPARTMENT OF DRAINAGE AND SANITATION • SYRACUSE, NEW YORK METROPOLITAN SYRACUSE WASTEWATER TREATMENT PLANT STAGE III AMMONIA AND STAGE II PHOSPHORUS REMOVAL PROJECT | File Number | P-507 |
| | 0 | 4/20/01 | ISSUED FOR APPROVAL | | | | | | 00659 | |
| | 1 | | AS BID | | | | | | Date | |
| | 2 | 1/05 | FOR RECORD | | APRIL 2001 | SCHEMATICS PLUMBING | | | | |

PIPE AND FITTING SYMBOLS

- UNDERGROUND PIPING
- SPRINKLER BRANCH PIPING
- WET WET PIPE FIRE MAIN
- DRY DRY PIPE FIRE MAIN
- PREAC. PREACTION FIRE MAIN
- BLDG. FIRE ALARM SYSTEM LOOP
- SYSTEM RISER
- PIPE UP
- PIPE DOWN
- FC FLUSHING CAP CONN.
- FC CAP CONNECTION
- FIRESTOP
- FIRE DEPARTMENT CONN.
- WATER MOTOR GONG
- STRAINER
- UNION
- PIPE CROSS OVER (NO CONN.)
- CONNECTING PIPING

VALVE AND GATE SYMBOLS

- △ WET PIPE ALARM VALVE
- ◇ DRY PIPE ALARM VALVE
- ◆ PREACTION ALARM VALVE
- TS POST INDICATOR VALVE W/ TAMPER SWITCH
- ⌵ CHECK VALVE
- ⌵ GATE VALVE N/O
- ⌵ GATE VALVE N/C
- TS ⌵ GATE VALVE W/TAMPER SWITCH
- ⌵ SOLENOID VALVE
- ⌵ BACKFLOW VALVE
- ⌵ TEST AND DRAIN VALVE
- ⌵ 2 1/2" HOSE VALVE CONN.

MISCELLANEOUS SYMBOLS

- QUICK RESPONSE RECESSED PENDENT SPRINKLER 155°
- STANDARD RESPONSE UPRIGHT SPRINKLER 212°
- △ STANDARD RESPONSE SIDEWALL SPRINKLER
- △ STANDARD DRY SIDEWALL SPRINKLER
- △ FLOW SWITCH
- PRESSURE GAGE
- PRESSURE SWITCH
- PREACTION SMOKE DETECTOR
- HEAT DETECTOR 190°F
- MM MONITOR MODULE
- EMR PREACTION EMERGENCY MANUAL RELEASE
- RETARD CHAMBER
- ← FLOW DIRECTION
- WIRING
- ⊗ POINT OF CONNECTION BETWEEN EXISTING WORK TO REMAIN & NEW WORK

ABBREVEATIONS

- A.F.F. ABOVE FINISHED FLOOR
- BLDG. BUILDING
- CONN. CONNECTION
- DEPT. DEPARTMENT
- DN DOWN
- ELEV. ELEVATOR
- EMR EMERGENCY MANUAL RELEASE
- FLR. FLOOR
- FP FIRE PROTECTION
- I.D. IDENTIFICATION
- LH LIGHT HAZARD
- MAINT. MAINTENANCE
- MIN. MINIMUM REQUIREMENT
- MM MONITOR MODULE
- N.I.C. NOT IN CONTRACT
- N/O NORMALLY OPEN
- N/C NORMALLY CLOSED
- OH ORDINARY HAZARD
- P.I.V. POST INDICATOR VALVE
- PREAC. PREACTION
- PRESS. PRESSURE
- SD1 SMOKE DETECTOR IONIZATION
- SD2 SMOKE DETECTOR PHOTO-ELECTRIC
- TS TAMPER SWITCH
- TYP TYPICAL
- W/ WITH

GENERAL NOTES

- A. PROVIDE ALL CUTTING, PATCHING AND FIRESTOPPING REQUIRED TO ACCOMPLISH WORK SHOWN. PATCH AND SEAL OPENINGS TO MATCH ADJACENT WALLS, FLOORS, CEILINGS, ETC. UNLESS OTHERWISE INDICATED. CONCEAL ALL WORK IN FINISHED AREAS UNLESS OTHERWISE INDICATED OR DIRECTED BY ARCHITECT.
- B. CONTRACTOR SHALL FIELD VERIFY ALL LOCATIONS, DIMENSIONS (PIPING, SPRINKLER HEADS, RISERS, STRUCTURAL ELEMENTS, ETC.) PRIOR TO STARTING WORK. CONTRACTOR SHALL COORDINATE INSTALLATION OF EQUIPMENT, PIPING AND SPRINKLERS. PROVIDE FITTINGS, PIPING, OFFSETS, ELEVATION CHANGES, ETC. TO MINIMIZE CONFLICTS. CONTRACTOR SHALL REROUTE PIPING THAT WILL BE IN CONFLICT WITH OTHER TRADES.
- C. CONTRACTOR SHALL PROVIDE ALL SLEEVES, CORE DRILLING, WATER, SMOKE AND FIRE SEALING OF PIPING PENETRATIONS THROUGH WALLS AND FLOORS.
- D. LOCATE SPRINKLER HEADS IN THE CENTER OF CEILING TILES UNLESS OTHERWISE NOTED.
- E. CONTRACTOR SHALL PROVIDE ORDINARY HAZARD GROUPS 1&2 HYDRAULIC CALCULATIONS AT THE MOST REMOTE AREA FOR WET, DRY, AND PREACTION SYSTEMS. MINIMUM OPERATING PRESSURE PER SPRINKLER SHALL BE 7.12 PSI OR MINIMUM DISCHARGE OF 15 GPM. PROVIDE 20 FPS MAX. VELOCITY.
- F. IN CASE OF LOW POINTS, CONTRACTOR SHALL PROVIDE AUXILIARY DRAIN, IDENTIFICATION & ACCESS.
- G. PAINT ALL EXPOSED PIPING OSHA RED AND IDENTIFY WITH PIPE I.D. MARKINGS.
- H. ALL SINGLE SPRINKLER BRANCH LINES ARE 1" UNLESS OTHERWISE NOTED.
- I. PROVIDE COORDINATION WITH OTHER TRADES. IN CASE OF OBSTRUCTIONS TO SPRINKLERS, PROVIDE ADDITIONAL SPRINKLER(S) TO OBTAIN ADEQUATE COVERAGE AS REQUIRED BY NFPA 13.
- J. DESIGN, MATERIALS, INSTALLATION AND TESTING SHALL BE IN ACCORDANCE WITH NATIONAL STATE AND LOCAL CODES, NFPA REQUIREMENTS, AND MANUFACTURER'S RECOMMENDATIONS AND INSTRUCTIONS, SPECIFICATIONS.
- K. PLEASE NOTE THAT THE 2 1/2" HOSE CONNECTION IS PER NFPA 13 AND NOT IN ACCORDANCE WITH NFPA 14.
- M. CONTRACTOR SHALL PROVIDE TAMPER SWITCHES FOR ALL CONTROL VALVES.

HYDRAULIC CALCULATIONS - PRELIMINARY

WATER DEMAND @ 3RD FLR. = .227 GPM + .50 HOSE @ 45 PSI.

FLOW TEST - 6/13/01

OCWA STATIC PRESSURE AFTER RPZ #2 @ .50 PSI.
 SYRACUSE WATER STATIC PRESSURE AFTER RPZ #2 @ 74 PSI.

NOTE:

REFER TO ATTACHED DAVIS ULMER RECORD DRAWINGS (FP-1, FP-2, FP-3 AND FP-TAB) FOR FIRE PROTECTION RECORD DRAWING INFORMATION.

RECORD DRAWING

THESE DRAWINGS HAVE BEEN REVISED TO REFLECT MAJOR CHANGES, IF ANY, WHICH OCCURRED DURING CONSTRUCTION. REVISIONS ARE BASED UPON INFORMATION SUPPLIED BY CONTRACTOR.

DATE: 12/13/05 PER: RCG

THIS DRAWING WAS PREPARED AT THE SCALE INDICATED IN THE TITLE BLOCK. INACCURACIES IN THE STATED SCALE MAY BE INTRODUCED WHEN DRAWINGS ARE REPRODUCED BY ANY MEANS. USE THE GRAPHIC SCALE BAR IN THE TITLE BLOCK TO DETERMINE THE ACTUAL SCALE OF THIS DRAWING.

06/27/01 RAB AJK/ERH
0659FP001

NOT TO SCALE

| No. | Date | Revisions | Init |
|-----|----------|---------------------|------|
| 0 | 4/20/01 | ISSUED FOR APPROVAL | |
| 1 | | AS BID | |
| 2 | 11/30/05 | RECORD DRAWING | RCG |

In charge of: FJS
 Designed by: ERH
 Drawn by: AJK
 Checked by: ERH

ENVIRONMENTAL ENGINEERS ASSOCIATES, LLP
SYRACUSE, NEW YORK

RAM-TECH ENGINEERS, P.C.
CONSULTING ENGINEERS
SYRACUSE, NEW YORK


ONONDAGA COUNTY • DEPARTMENT OF DRAINAGE AND SANITATION • SYRACUSE, NEW YORK
 METROPOLITAN SYRACUSE WASTEWATER TREATMENT PLANT
 STAGE III AMMONIA AND STAGE II PHOSPHORUS REMOVAL PROJECT

**OPERATIONS CENTER
 SYMBOL LIST & NOTES**

FIRE PROTECTION

| | |
|-------------|------------|
| File Number | 00659 |
| Date | APRIL 2001 |
| | FP-001 |

NO ALTERATIONS PERMITTED HEREON EXCEPT AS PROVIDED UNDER SECTION 7209 SUBDIVISION 2 OF THE NEW YORK STATE EDUCATION LAW

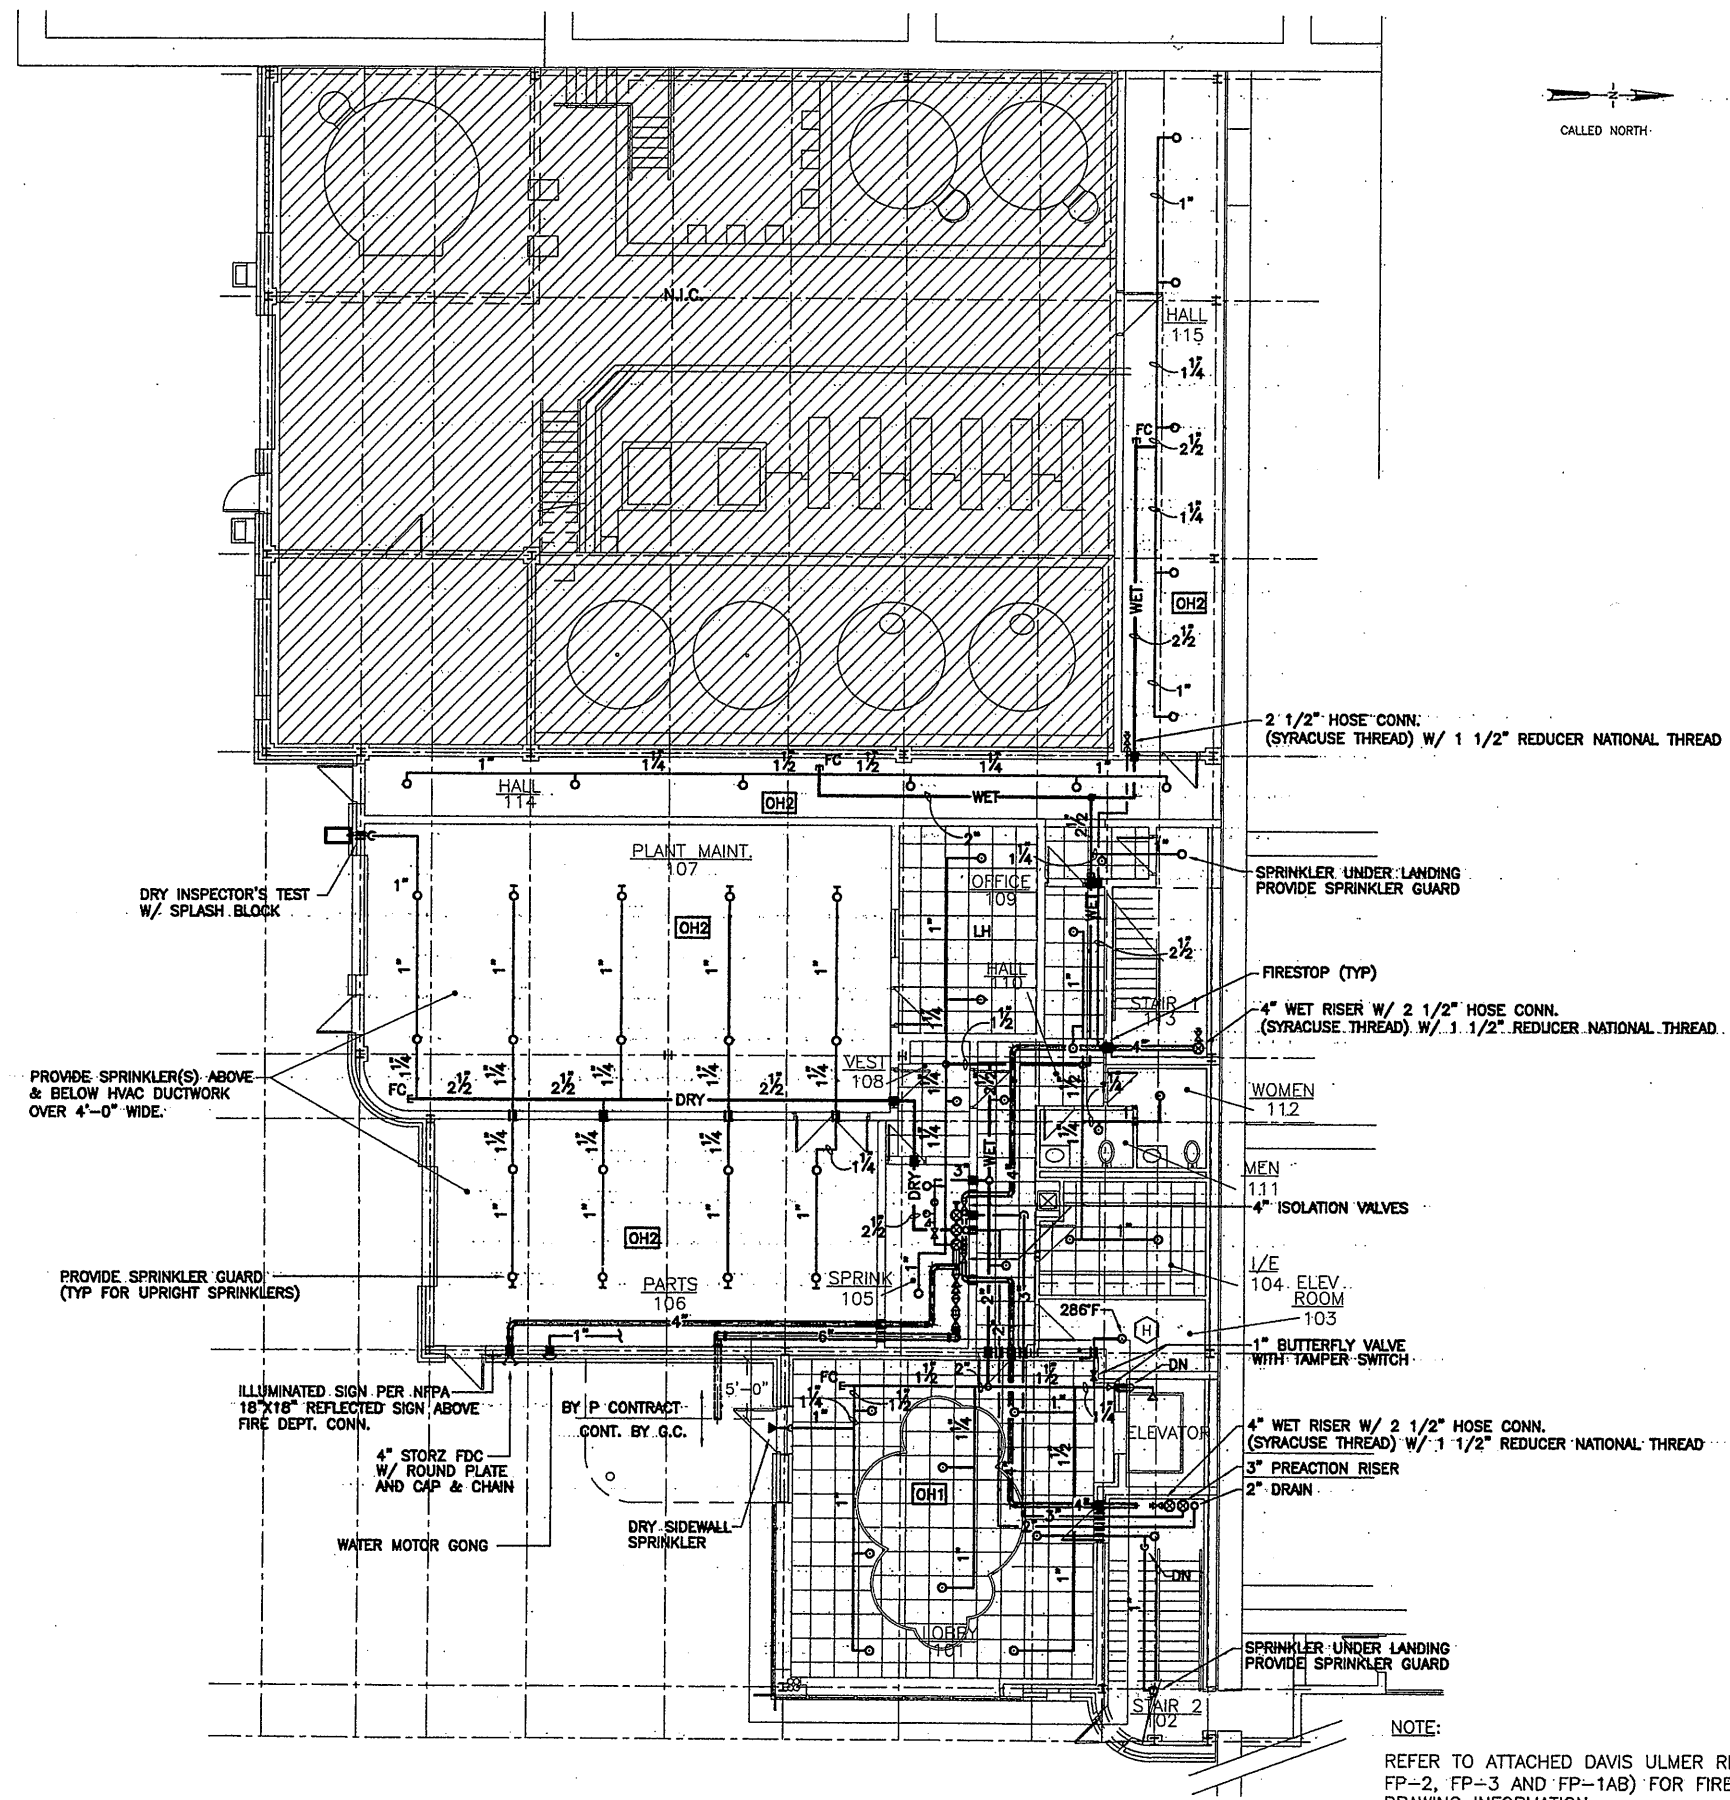

CALLLED NORTH

DRY INSPECTOR'S TEST W/ SPLASH BLOCK

PROVIDE SPRINKLER(S) ABOVE & BELOW HVAC DUCTWORK OVER 4'-0" WIDE.

PROVIDE SPRINKLER GUARD (TYP FOR UPRIGHT SPRINKLERS)

ILLUMINATED SIGN PER NFPA 18"x18" REFLECTED SIGN ABOVE FIRE DEPT. CONN.

4" STORZ FDC W/ ROUND PLATE AND CAP & CHAIN

WATER MOTOR GONG

BY P CONTRACT CONT. BY G.C.

DRY SIDEWALL SPRINKLER

2 1/2" HOSE CONN. (SYRACUSE THREAD) W/ 1 1/2" REDUCER NATIONAL THREAD

SPRINKLER UNDER LANDING PROVIDE SPRINKLER GUARD

FIRESTOP (TYP)
4" WET RISER W/ 2 1/2" HOSE CONN. (SYRACUSE THREAD) W/ 1 1/2" REDUCER NATIONAL THREAD

WOMEN 112

MEN 111
4" ISOLATION VALVES

1/E 104 ELEV. ROOM 103
1" BUTTERFLY VALVE WITH TAMPER SWITCH

4" WET RISER W/ 2 1/2" HOSE CONN. (SYRACUSE THREAD) W/ 1 1/2" REDUCER NATIONAL THREAD
3" PREACTION RISER
2" DRAIN

SPRINKLER UNDER LANDING PROVIDE SPRINKLER GUARD

NOTE:
REFER TO ATTACHED DAVIS ULMER RECORD DRAWINGS (FP-1, FP-2, FP-3 AND FP-1AB) FOR FIRE PROTECTION RECORD DRAWING INFORMATION.

RECORD DRAWING
THESE DRAWINGS HAVE BEEN REVISED TO REFLECT MAJOR CHANGES, IF ANY, WHICH OCCURRED DURING CONSTRUCTION. REVISIONS ARE BASED UPON INFORMATION SUPPLIED BY CONTRACTOR.
DATE: 12/13/05 PER: RCL

THIS DRAWING WAS PREPARED AT THE SCALE INDICATED IN THE TITLE BLOCK. INACCURACIES IN THE STATED SCALE MAY BE INTRODUCED WHEN DRAWINGS ARE REPRODUCED BY ANY MEANS. USE THE GRAPHIC SCALE BAR IN THE TITLE BLOCK TO DETERMINE THE ACTUAL SCALE OF THIS DRAWING.

0659X501/0659X520
06/27/01 RAB AJK/ERH
0659FP002

1/8"=1'-0"
NO ALTERATIONS PERMITTED HEREON EXCEPT AS PROVIDED UNDER SECTION 7209 SUBDIVISION 2 OF THE NEW YORK STATE EDUCATION LAW

| No. | Date | Revisions | Init |
|-----|---------|---------------------|------|
| 0 | 4/20/01 | ISSUED FOR APPROVAL | |
| 1 | | AS BID | |
| 2 | 1/30/05 | RECORD DRAWING | RCG |



In charge of FJS
Designed by ERH
Drawn by AJK
Checked by ERH

ENVIRONMENTAL ENGINEERS ASSOCIATES, LLP
SYRACUSE, NEW YORK

RAM-TECH ENGINEERS, P.C.
CONSULTING ENGINEERS
SYRACUSE, NEW YORK

ONONDAGA COUNTY • DEPARTMENT OF DRAINAGE AND SANITATION • SYRACUSE, NEW YORK
METROPOLITAN SYRACUSE WASTEWATER TREATMENT PLANT
STAGE III AMMONIA AND STAGE II PHOSPHORUS REMOVAL PROJECT
OPERATIONS CENTER - FIRST FLOOR
SPRINKLER PLAN
FIRE PROTECTION

| | |
|-------------|------------|
| File Number | 00659 |
| Date | APRIL 2001 |
| | FP-002 |

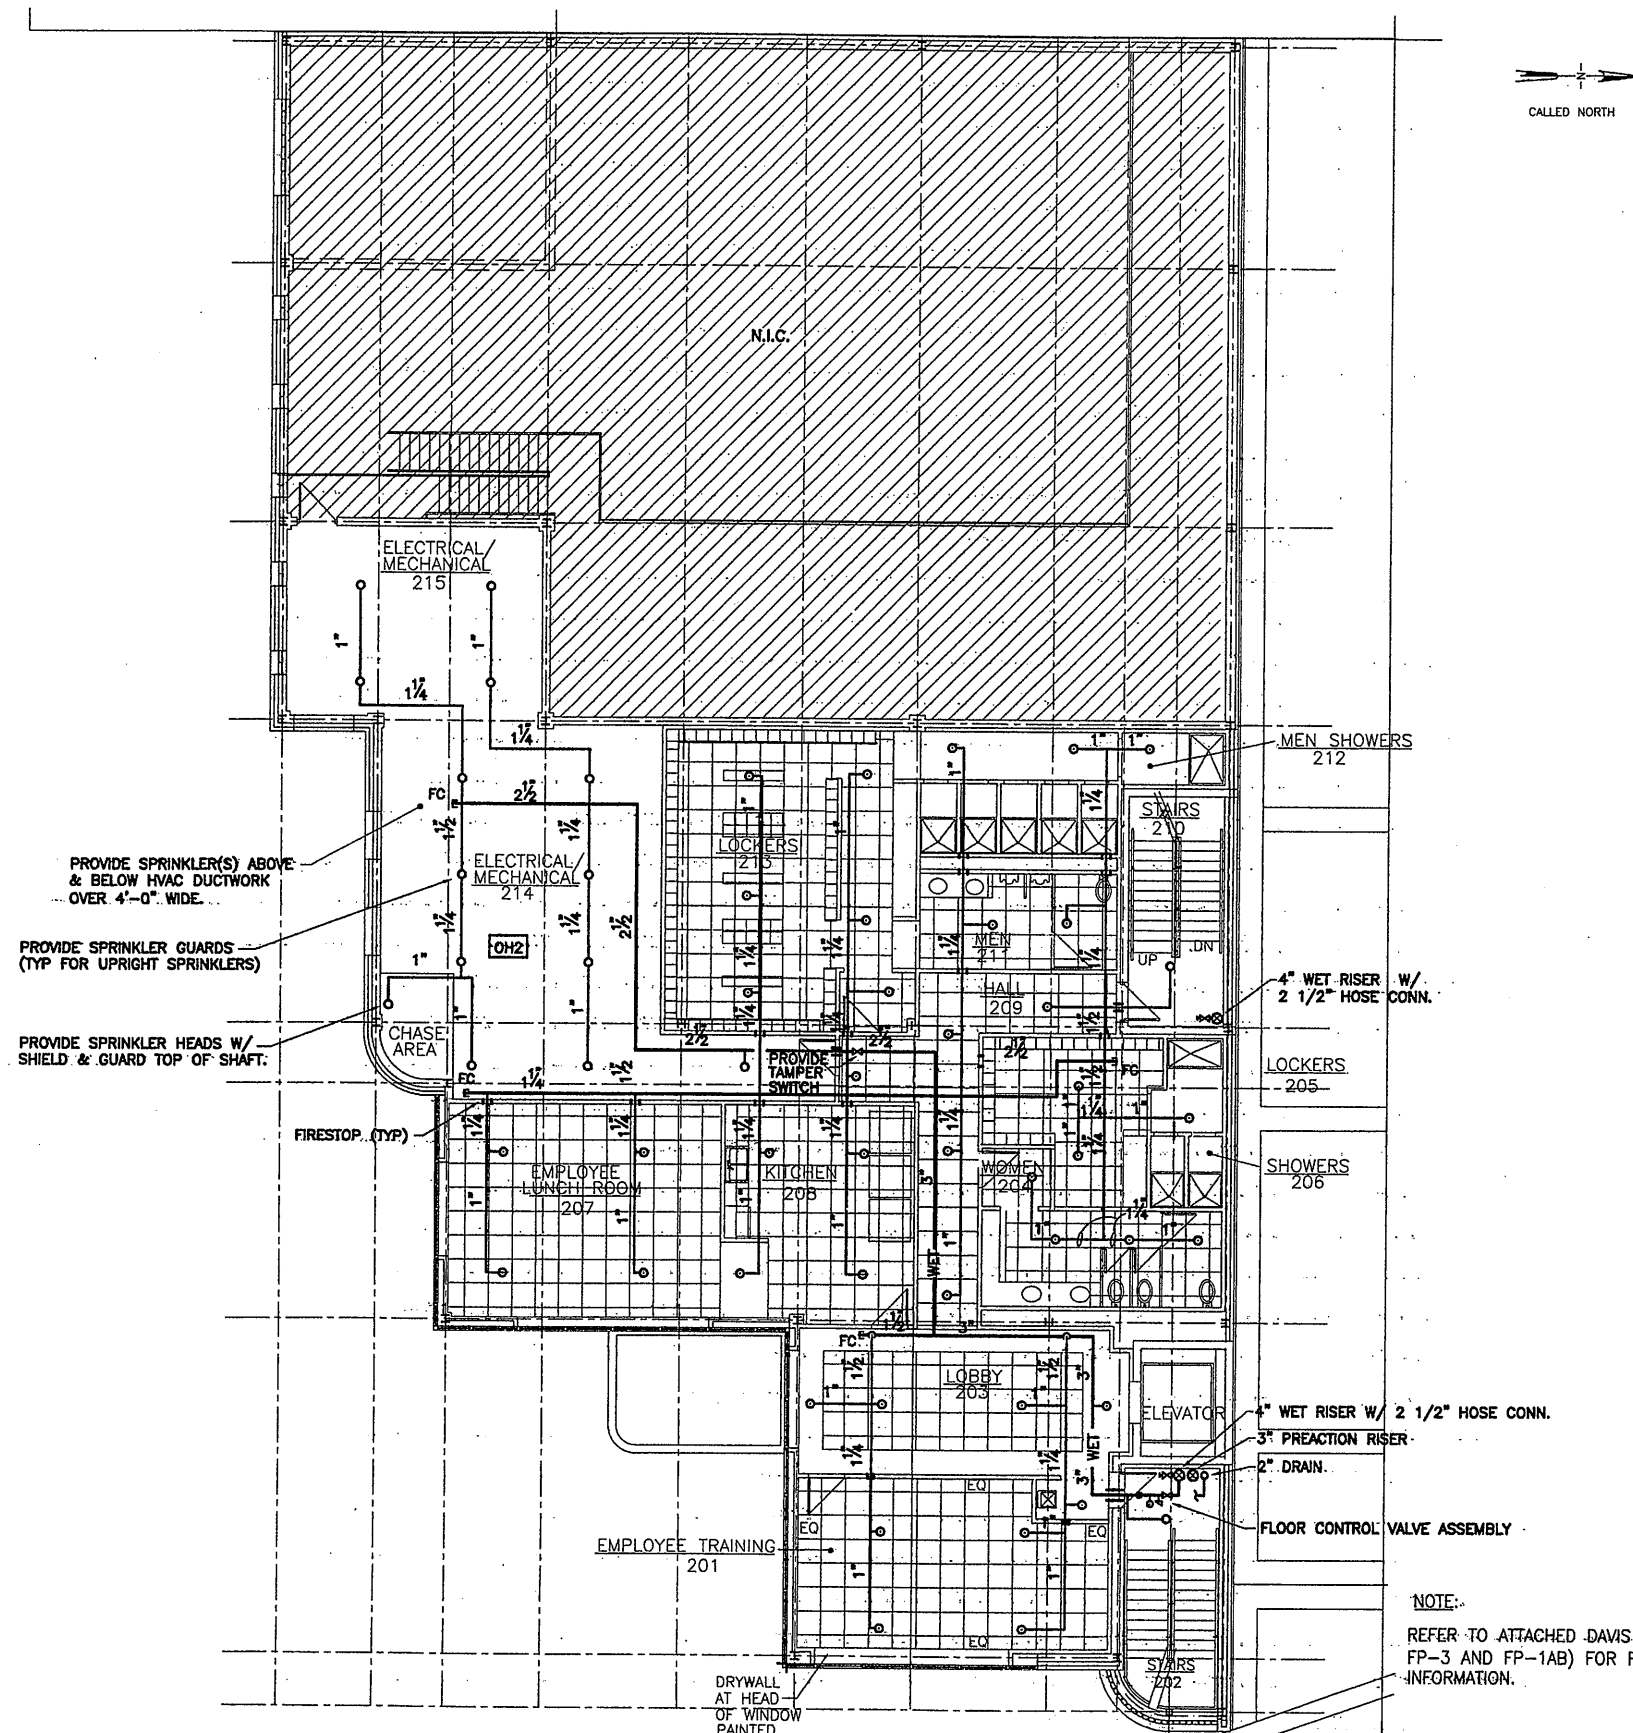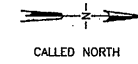

PROVIDE SPRINKLER(S) ABOVE & BELOW HVAC DUCTWORK OVER 4'-0" WIDE.

PROVIDE SPRINKLER GUARDS (TYP FOR UPRIGHT SPRINKLERS)


PROVIDE SPRINKLER HEADS W/ SHIELD & GUARD TOP OF SHAFT.

NOTE:
REFER TO ATTACHED DAVIS-ULMER RECORD DRAWINGS (FP-1, FP-2, FP-3 AND FP-1AB) FOR FIRE PROTECTION RECORD DRAWING INFORMATION.

RECORD DRAWING
THESE DRAWINGS HAVE BEEN REVISED TO REFLECT MAJOR CHANGES, IF ANY, WHICH OCCURRED DURING CONSTRUCTION. REVISIONS ARE BASED UPON INFORMATION SUPPLIED BY CONTRACTOR.
DATE: 12/13/05 PER: RCG


THIS DRAWING WAS PREPARED AT THE SCALE INDICATED IN THE TITLE BLOCK. INACCURACIES IN THE STATED SCALE MAY BE INTRODUCED WHEN DRAWINGS ARE REPRODUCED BY ANY MEANS. USE THE GRAPHIC SCALE BAR IN THE TITLE BLOCK TO DETERMINE THE ACTUAL SCALE OF THIS DRAWING.

0659X502/0659X520
06/27/01 RAB AJK/ERH
0659FP003

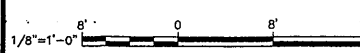



| No. | Date | Revisions | Init |
|-----|---------|---------------------|------|
| 0 | 4/20/01 | ISSUED FOR APPROVAL | |
| 1 | | AS BID | |
| 2 | 1/30/05 | RECORD DRAWING | RCG |

In charge of: FJS
Designed by: ERH
Drawn by: AJK
Checked by: ERH

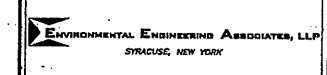

ONONDAGA COUNTY • DEPARTMENT OF DRAINAGE AND SANITATION • SYRACUSE, NEW YORK
METROPOLITAN SYRACUSE WASTEWATER TREATMENT PLANT
STAGE III AMMONIA AND STAGE II PHOSPHORUS REMOVAL PROJECT
OPERATIONS CENTER - SECOND FLOOR
SPRINKLER PLAN

File Number: 00659
Date: APRIL 2001
FP-003

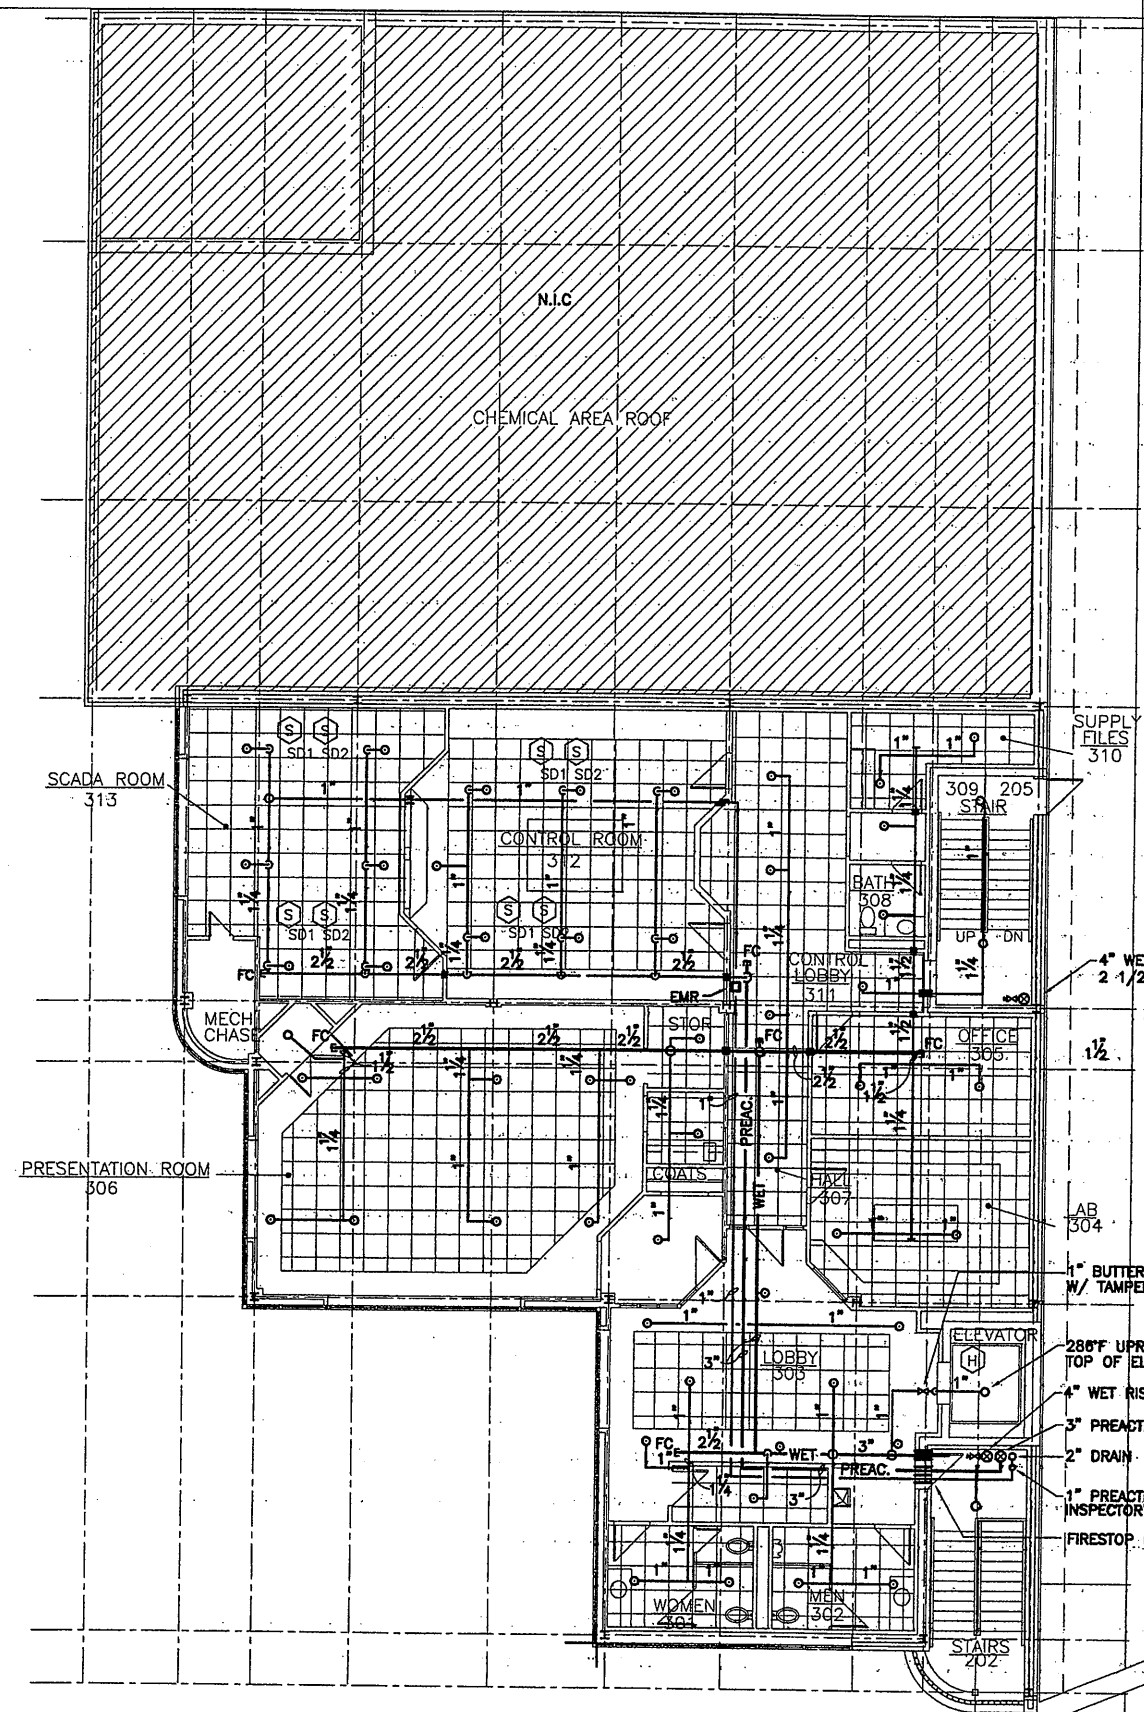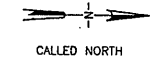

SUPPLY FILES 310

4\"/>

AB 304

1\"/>

28\"/>

4\"/>

3\"/>

2\"/>

1\"/>

FIRESTOP (TYP)

NOTE:
REFER TO ATTACHED DAVIS ULMER RECORD DRAWINGS (FP-1, FP-2, FP-3 AND FP-1AB) FOR FIRE PROTECTION RECORD DRAWING INFORMATION.

RECORD DRAWING
THESE DRAWINGS HAVE BEEN REVISED TO REFLECT MAJOR CHANGES, IF ANY, WHICH OCCURRED DURING CONSTRUCTION. REVISIONS ARE BASED UPON INFORMATION SUPPLIED BY CONTRACTOR.
DATE: 12/30/05 PER: RCB

THIS DRAWING WAS PREPARED AT THE SCALE INDICATED IN THE TITLE BLOCK. INACCURACIES IN THE STATED SCALE MAY BE INTRODUCED WHEN DRAWINGS ARE REPRODUCED BY ANY MEANS. USE THE GRAPHIC SCALE BAR IN THE TITLE BLOCK TO DETERMINE THE ACTUAL SCALE OF THIS DRAWING.

0659X503/0659X521
06/27/01 RAB AJK/ERH
0659P004

1/8"=1'-0"
NO ALTERATIONS PERMITTED HEREON EXCEPT AS PROVIDED UNDER SECTION 7209 SUBDIVISION 2 OF THE NEW YORK STATE EDUCATION LAW

| No. | Date | Revisions | Init |
|-----|----------|---------------------|------|
| 0 | 4/20/01 | ISSUED FOR APPROVAL | |
| 1 | | AS BID | |
| 2 | 11/30/05 | RECORD DRAWING | RCG |


In charge of: FJS
Designed by: ERH
Drawn by: AJK
Checked by: ERH



ONONDAGA COUNTY • DEPARTMENT OF DRAINAGE AND SANITATION • SYRACUSE, NEW YORK
METROPOLITAN SYRACUSE WASTEWATER TREATMENT PLANT
STAGE III AMMONIA AND STAGE II PHOSPHORUS REMOVAL PROJECT
OPERATIONS CENTER - THIRD FLOOR
SPRINKLER PLAN

FIRE PROTECTION

| | |
|-------------|------------|
| File Number | 00659 |
| Date | APRIL 2001 |
| | FP-004 |

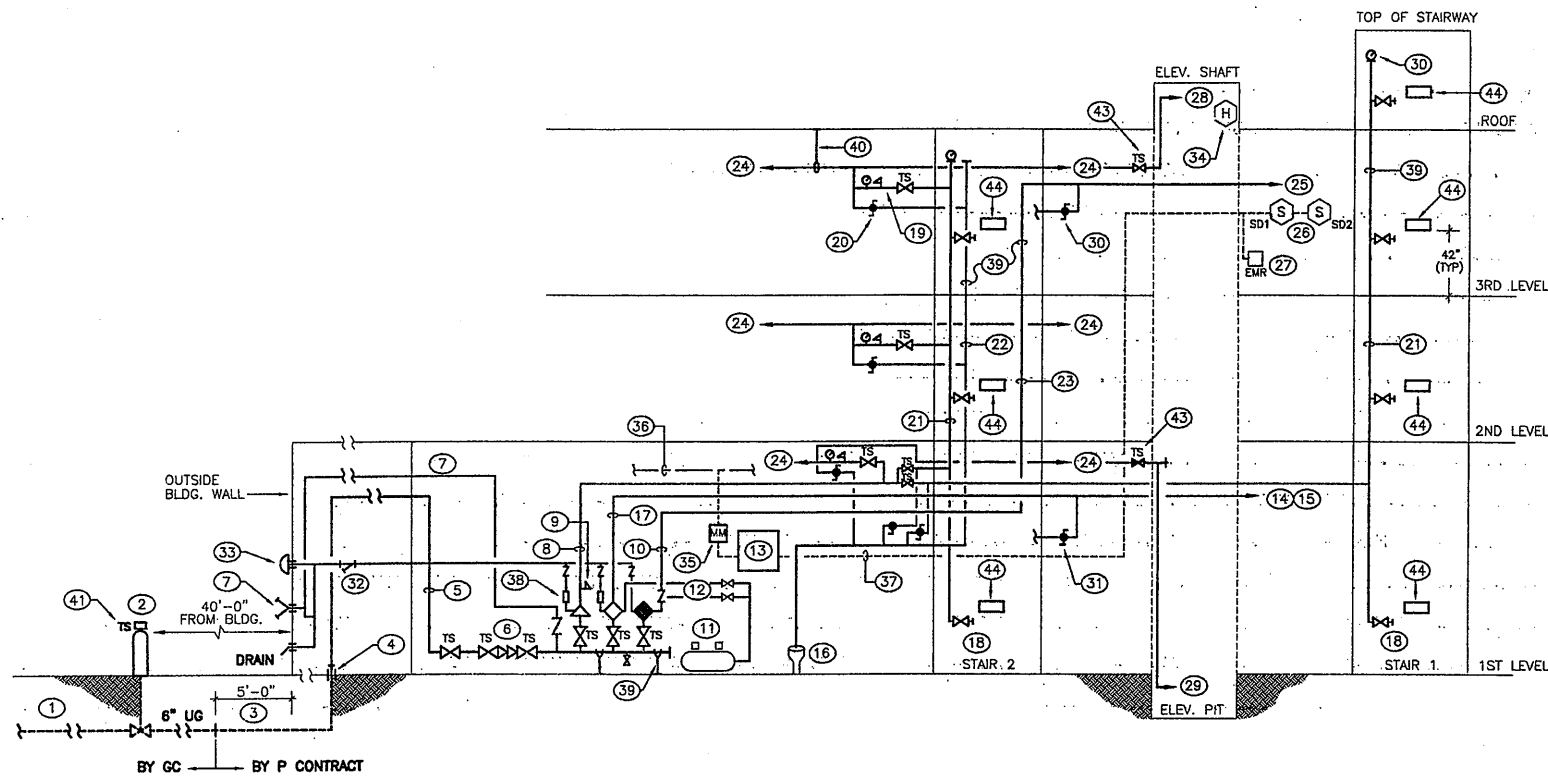


SCHEMATIC RISER DIAGRAM
NOT TO SCALE

- | Mark | Description |
|------|--|
| 1 | 6" U.G FIRE MAIN (BY GENERAL CONTRACTOR) |
| 2 | P.I.V. WITH TAMPER SWITCH (BY GENERAL CONTRACTOR) |
| 3 | 5'-0" TO BLDG. (BY P CONTRACT) |
| 4 | SUPPORT ENCASUREMENT |
| 5 | 6" MAIN WITH HEAT TRACING |
| 6 | 4" BACKFLOW VALVE ASSEMBLY |
| 7 | 4" FIRE DEPT. CONN. WITH CHECK VALVE AND BALL DRIP |
| 8 | 4" WET SPRINKLER RISER W/EASY SWING CHECK VALVE |
| 9 | WATER FLOW SWITCH - CONN. TO THE FIRE ALARM SYSTEM (BY E-CONTRACT) |
| 10 | 3" PREACTION SYSTEM RISER W/ELECTRIC PNEUMATIC RELEASE |
| 11 | DUAL AIR COMPRESSOR WITH ASME TANK (POWER BY E-CONTRACT) |
| 12 | AIR SUPPLY SYSTEM |
| 13 | PREACTION PANEL (REFER TO NOTE BELOW FOR CONNECTION). |
| 14 | DRY SYSTEM PIPING TO PLANT MAINT. ROOM |
| 15 | DRY SYSTEM PIPING TO PARTS. ROOM |
| 16 | STANDPIPE DRAIN 18" A.F.F. |
| 17 | 2 1/2" DRY PIPE SYSTEM RISER |
| 18 | 2 1/2" HOSE VALVE CONN. (TYP) PER NFPA 13 |
| 19 | FLOOR CONTROL VALVE ASSEMBLY (TYP OF 3) |
| 20 | WET INSPECTOR'S TEST AND DRAIN (TYP OF 3) |
| 21 | 4" WET SYSTEM RISER PIPING |
| 22 | 2" DRAIN PIPING |
| 23 | PREACTION PIPING |
| 24 | WET PIPE SPRINKLER SYSTEM |


- NOTES:
- POWER, WIRING AND CONNECTION TO THE FIRE ALARM SYSTEM SHALL BE BY E-CONTRACT. COORDINATE ALL ALARM FUNCTIONS WITH E-CONTRACT.
 - PROVIDE IDENTIFICATION AND LABELING ON THE CEILING FOR ALL SHUT-OFF VALVES ABOVE THE CEILING. PROVIDE ACCESS PANELS IF REQUIRED.

- | Mark | Description |
|------|--|
| 25 | PREACTION SYSTEM TO CONTROL ROOM |
| 26 | SMOKE DETECTORS ON THIRD FLOOR (BY FP CONTRACT) |
| 27 | ELECTRIC EMERGENCY MANUAL RELEASE |
| 28 | PIPING TO UPRIGHT SPRINKLER AT TOP OF ELEVATOR SHAFT |
| 29 | PIPING TO SIDEWALL SPRINKLER AT BOTTOM OF ELEVATOR SHAFT |
| 30 | PREACTION SYSTEM INSPECTOR'S TEST AND DRAIN |
| 31 | DRY SYSTEM INSPECTOR'S TEST AND DRAIN |
| 32 | STRAINER |
| 33 | WATER MOTOR ALARM GONG |
| 34 | HEAT DETECTOR 190°F. ASME A17.1, REQUIRES THE SHUTDOWN OF POWER TO THE ELEVATOR UPON OR PRIOR TO THE ACTIVATION OF WATER IN ELEVATOR MACHINE ROOMS OR HOISTWAYS. COORDINATE "SHUNT TRIP" WITH E-CONTRACT. SHUTDOWN PROCESS (BY E-CONTRACT) |
| 35 | MONITOR MODULE (TYP) (BY E-CONTRACT) |
| 36 | BUILDING FIRE ALARM SYSTEMS (BY E-CONTRACT) |
| 37 | WIRING (BY E-CONTRACT) |
| 38 | RETARD CHAMBER |
| 39 | ANCHOR SUPPORT (TYP) |
| 40 | HANGER SUPPORT (TYP) |
| 41 | TAMPER SWITCH - CONN. TO THE FIRE ALARM SYSTEM (BY E-CONTRACT) |
| 42 | PRESSURE GAUGE |
| 43 | BUTTERFLY VALVE W/ TAMPER SWITCH |
| 44 | COLOR CODED SIGN FOR EVERY LEVEL. (COLOR BY LOCAL AUTHORITY) |

NOTE:
REFER TO ATTACHED DAVIS ULMER RECORD DRAWINGS (FP-1, FP-2, FP-3 AND FP-1AB) FOR FIRE PROTECTION RECORD DRAWING INFORMATION.

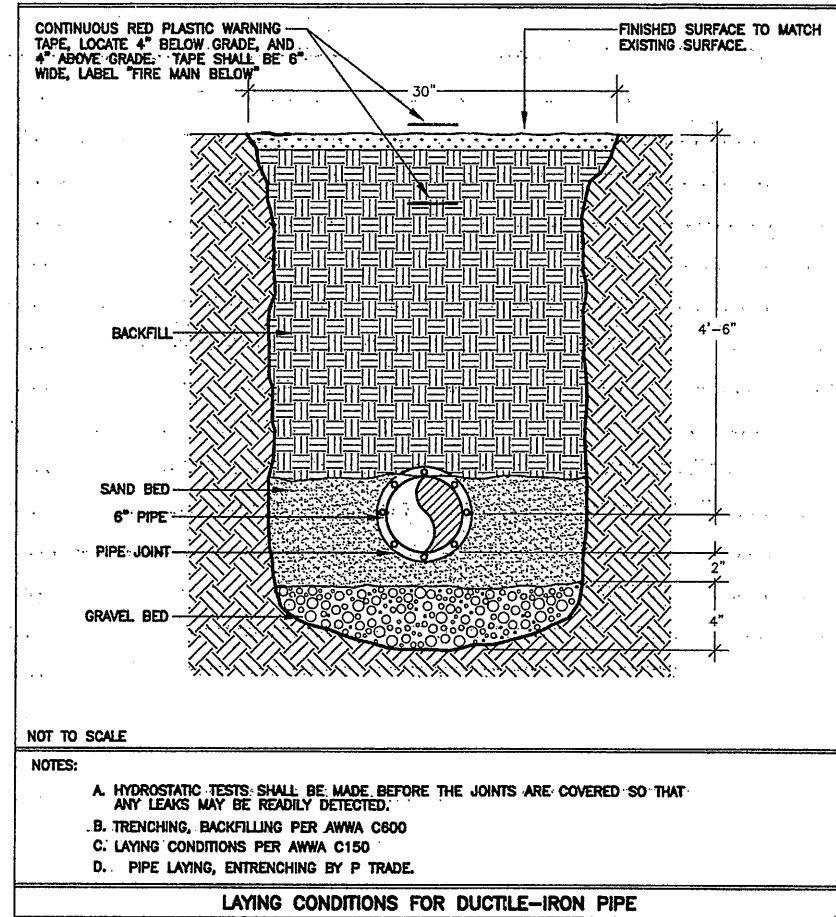

LAYING CONDITIONS FOR DUCTILE-IRON PIPE

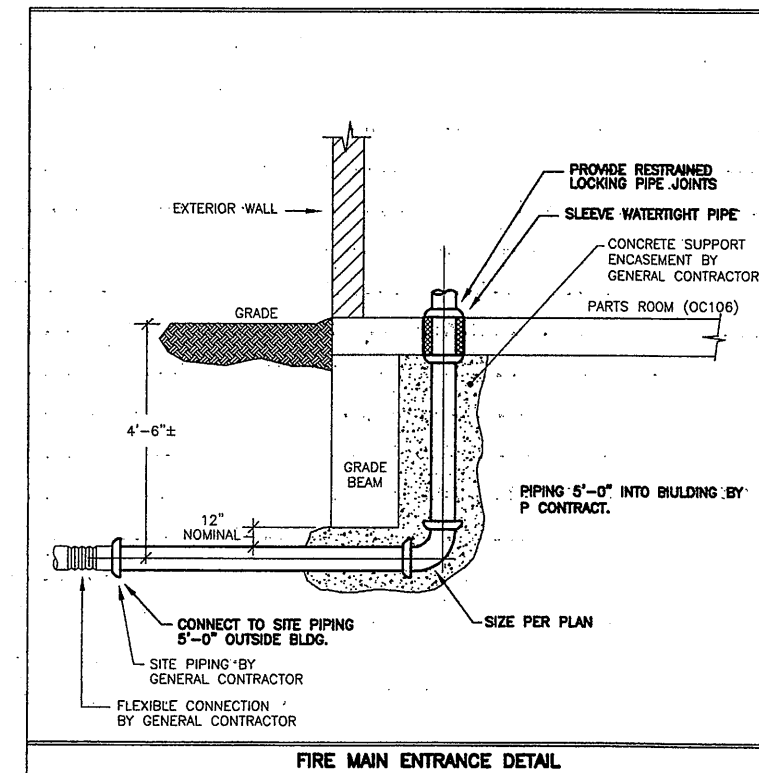

FIRE MAIN ENTRANCE DETAIL

RECORD DRAWING
THESE DRAWINGS HAVE BEEN REVISED TO REFLECT MAJOR CHANGES, IF ANY, WHICH OCCURRED DURING CONSTRUCTION. REVISIONS ARE BASED UPON INFORMATION SUPPLIED BY CONTRACTOR.
DATE: 12/13/05 PER: RCG

06/27/01 RAB AJK/ERH
0659FP005

| No. | Date | Revisions | Init |
|-----|---------|---------------------|------|
| 0 | 4/20/01 | ISSUED FOR APPROVAL | |
| 1 | | AS BID | |
| 2 | 1/30/05 | RECORD DRAWING | RCG |


In charge of FJS
Designed by ERH
Drawn by AJK
Checked by ERH

ENVIRONMENTAL ENGINEERS ASSOCIATES, LLP
SYRACUSE, NEW YORK

RAM-TECH ENGINEERS, P.C.
CONSULTING ENGINEERS
SYRACUSE, NEW YORK

ONONDAGA COUNTY • DEPARTMENT OF DRAINAGE AND SANITATION • SYRACUSE, NEW YORK
METROPOLITAN SYRACUSE WASTEWATER TREATMENT PLANT
STAGE III AMMONIA AND STAGE II PHOSPHORUS REMOVAL PROJECT
OPERATIONS CENTER
SCHEMATICS AND DETAILS

File Number
00659
Date
APRIL 2001
FP-005

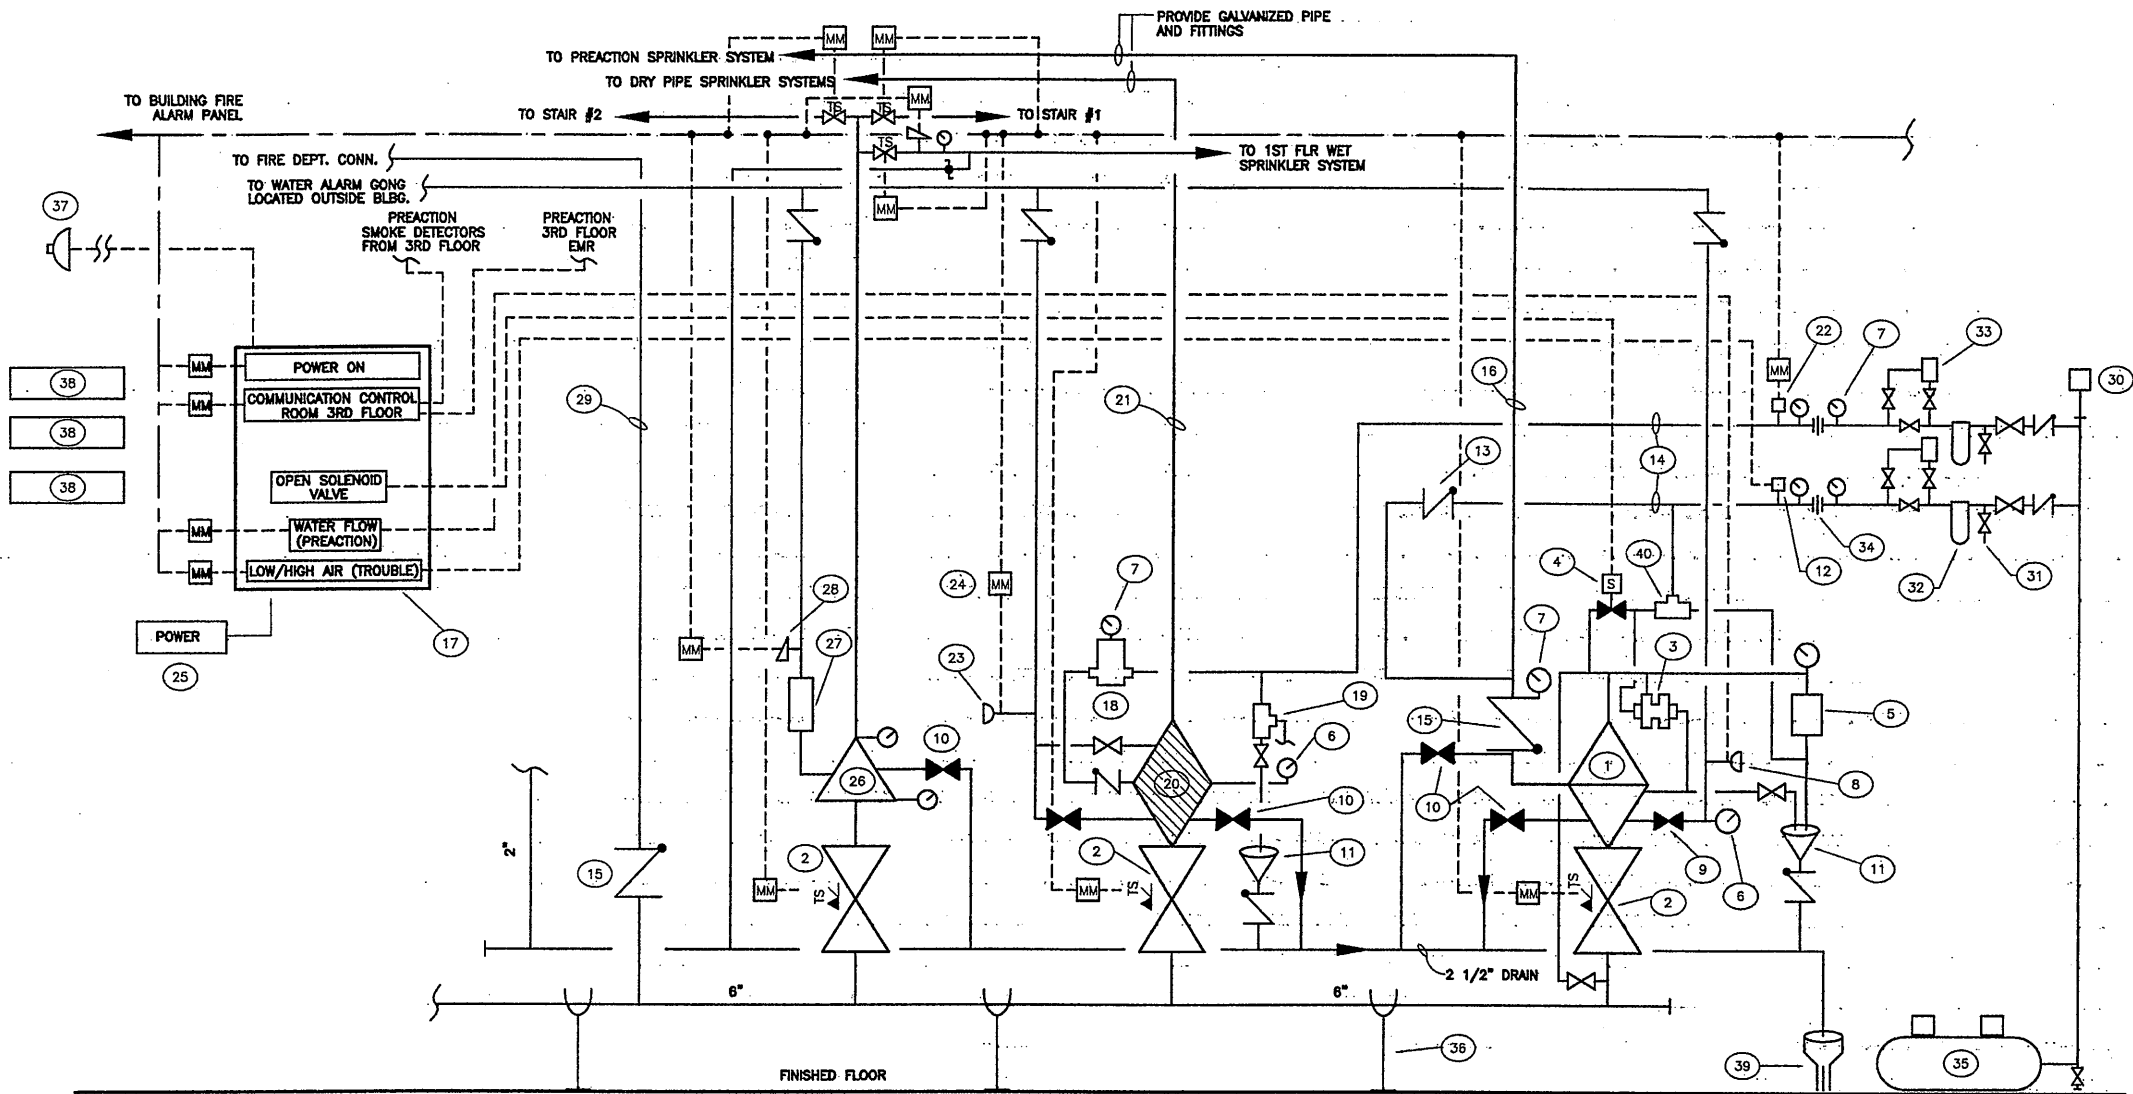

WET, DRY AND PREACTION PIPE RISER DETAIL
NOT TO SCALE.


- | Mark | Description |
|------|--|
| 1 | DELUGE VALVE AND TRIM |
| 2 | OS&Y WITH TAMPER SWITCH |
| 3 | PREACTION PRESSURE OPERATED RELIEF VALVE |
| 4 | SOLENOID VALVE (FM APPROVED) |
| 5 | EMERGENCY MANUAL RELEASE |
| 6 | PRESSURE GAUGE |
| 7 | PRESSURE GAUGE (AIR) |
| 8 | PREACTION FLOW ALARM PRESSURE SWITCH |
| 9 | TEST VALVE (N/C) |
| 10 | 1 1/2" ANGLE VALVE DRAIN (N/C) |
| 11 | DRIP CUP |
| 12 | PREACTION AIR SUPERVISORY SWITCH |
| 13 | CHECK VALVE |
| 14 | AIR SUPPLY LINES |
| 15 | CHECK VALVE (PREACTION) |
| 16 | 3" PREACTION RISER (GALVANIZED) |
| 17 | PREACTION CONTROL PANEL |
| 18 | MOD. E-1 ACCELERATOR |
| 19 | MOD. B-1 ANTI-FLOOD DEVICE |
| 20 | DRY PIPE ALARM VALVE AND TRIM |

- | Mark | Description |
|------|--|
| 21 | 3" DRY PIPE SYSTEM RISER (GALVANIZED) |
| 22 | DRY SYSTEM AIR SUPERVISORY SWITCH |
| 23 | DRY SYSTEM FLOW ALARM PRESSURE SWITCH |
| 24 | MONITOR MODULE (BY E-CONTRACT) |
| 25 | PREACTION PANEL POWER, WIRING AND CONN. TO FIRE ALARM SYSTEM (BY E-CONTRACT) |
| 26 | 4" WET PIPE ALARM VALVE AND TRIM |
| 27 | RETARD CHAMBER |
| 28 | WET FLOW ALARM PRESS. SWITCH |
| 29 | 4" FIRE DEPARTMENT CONNECTION |
| 30 | AIR SUPERVISORY SWITCH (COMPRESSOR ON/OFF CONTROL SWITCH) |
| 31 | DRAIN |
| 32 | DEHYDRATOR |
| 33 | AIR MAINTENANCE DEVICE |
| 34 | ORIFICE |
| 35 | COMPRESSOR/TANK (POWER BY E-CONTRACT) |
| 36 | FLOOR SUPPORT |
| 37 | ELECTRIC ALARM BELL (LOCATE OUTSIDE SPRINKLER VALVE ROOM) |
| 38 | SPARER SPRINKLER CABINET |
| 39 | 4" STANDPIPE DRAIN |
| 40 | PNEUMATIC RELEASE |


NOTES: - ALL MATERIALS SHALL BE UL AND FM APPROVED.
 - INSTALL PER NFPA AND MANUFACTURER'S RECOMMENDATIONS.
 - POWER, WIRING AND CONNECTION TO FIRE ALARM SYSTEM BY E-CONTRACT.
 - ALL VALVES SHALL BE PROVIDED WITH SEAL AND LOCKS.
 - PROVIDE IDENTIFICATION LABEL ON THE CEILING FOR ALL SHUT-OFF VALVES ABOVE THE CEILING.

NOTE:

REFER TO ATTACHED DAVIS ULMER RECORD DRAWINGS (FP-1, FP-2, FP-3 AND FP-1AB) FOR FIRE PROTECTION RECORD DRAWING INFORMATION.

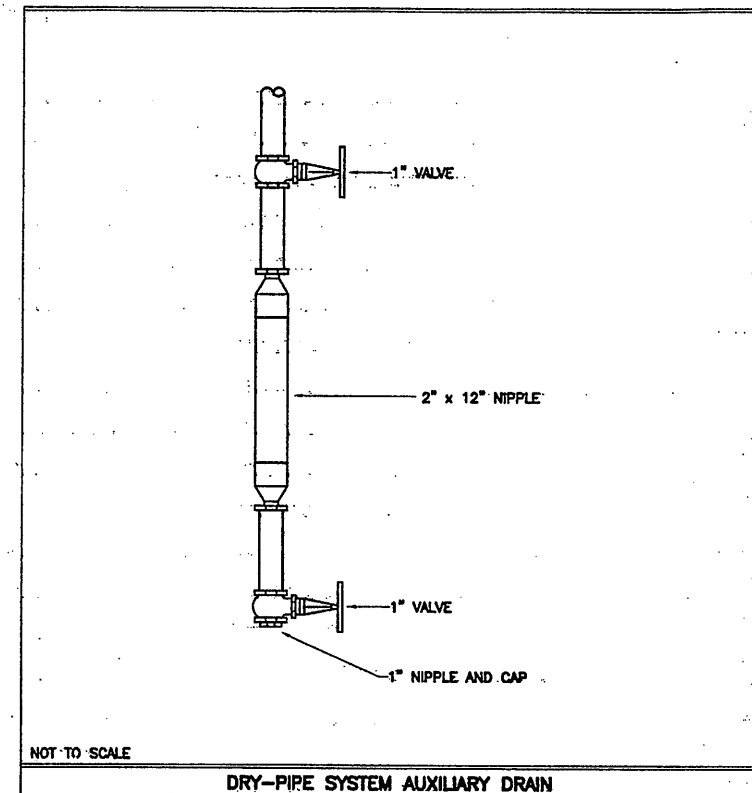

DRY-PIPE SYSTEM AUXILIARY DRAIN
NOT TO SCALE

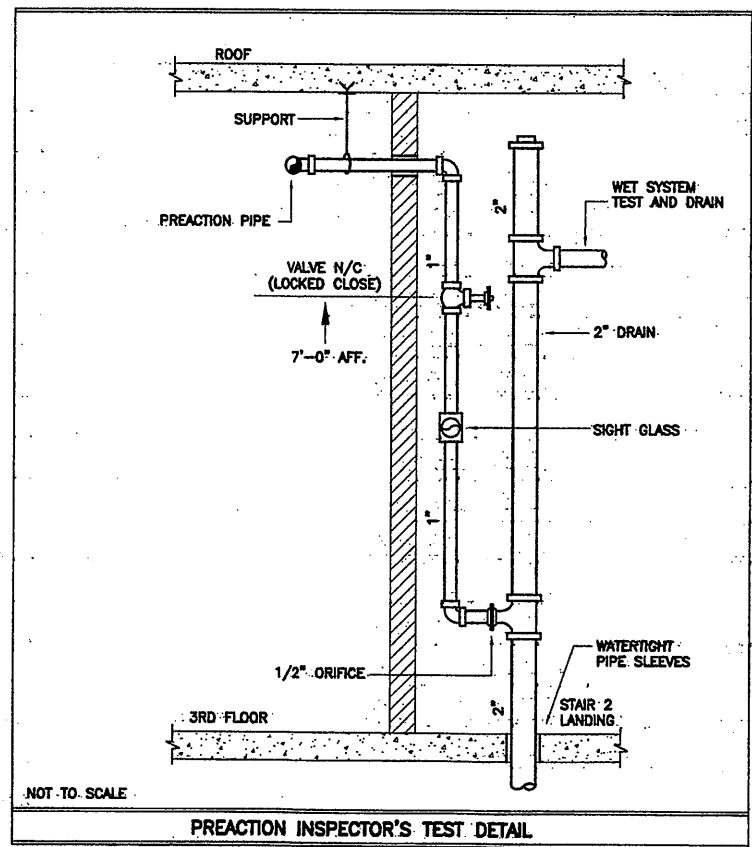

PREACTION INSPECTOR'S TEST DETAIL
NOT TO SCALE

RECORD DRAWING

THESE DRAWINGS HAVE BEEN REVISED TO REFLECT MAJOR CHANGES, IF ANY, WHICH OCCURRED DURING CONSTRUCTION. REVISIONS ARE BASED UPON INFORMATION SUPPLIED BY CONTRACTOR.
 DATE: 12/31/05 PER: PCG

THIS DRAWING WAS PREPARED AT THE SCALE INDICATED IN THE TITLE BLOCK. INACCURACIES IN THE STATED SCALE MAY BE INTRODUCED WHEN DRAWINGS ARE REPRODUCED BY ANY MEANS. USE THE GRAPHIC SCALE BAR IN THE TITLE BLOCK TO DETERMINE THE ACTUAL SCALE OF THIS DRAWING.


06/27/01 RAB AJK/ERH
0659FP006

NOT TO SCALE

NO ALTERATIONS PERMITTED HEREON EXCEPT AS PROVIDED UNDER SECTION 7209 SUBDIVISION 2 OF THE NEW YORK STATE EDUCATION LAW





| No. | Date | Revisions | Init |
|-----|----------|---------------------|------|
| 0 | 4/20/01 | ISSUED FOR APPROVAL | |
| 1 | | AS BID | |
| 2 | 11/30/05 | RECORD DRAWING | RCG |

In charge of FJS
 Designed by ERH
 Drawn by AJK
 Checked by ERH

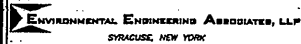

ONONDAGA COUNTY • DEPARTMENT OF DRAINAGE AND SANITATION • SYRACUSE, NEW YORK
 METROPOLITAN SYRACUSE WASTEWATER TREATMENT PLANT
 STAGE III AMMONIA AND STAGE II PHOSPHORUS REMOVAL PROJECT
OPERATIONS CENTER
SCHEMATICS AND DETAILS

File Number 00659
 Date APRIL 2001
FP-006

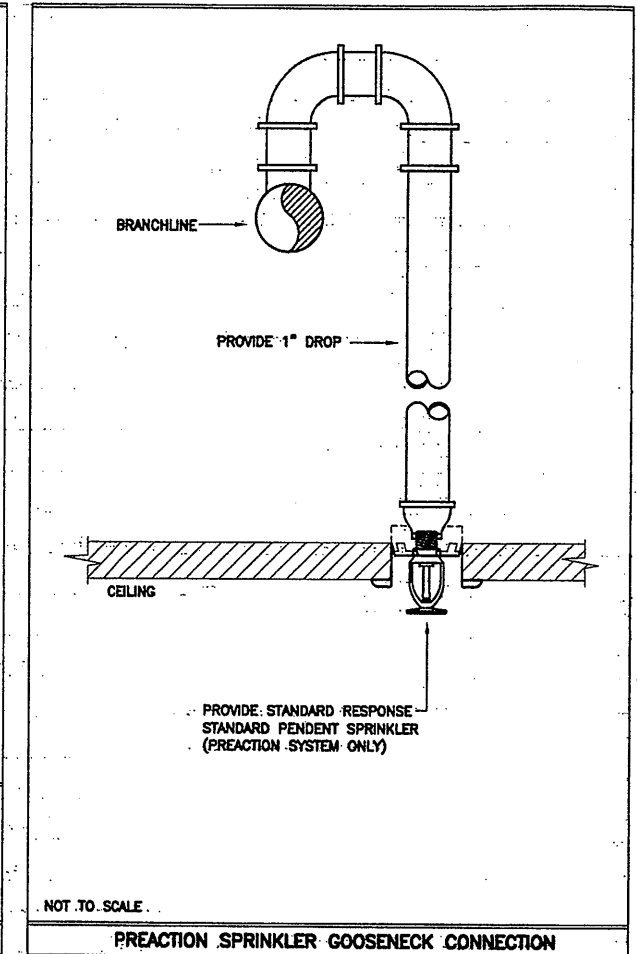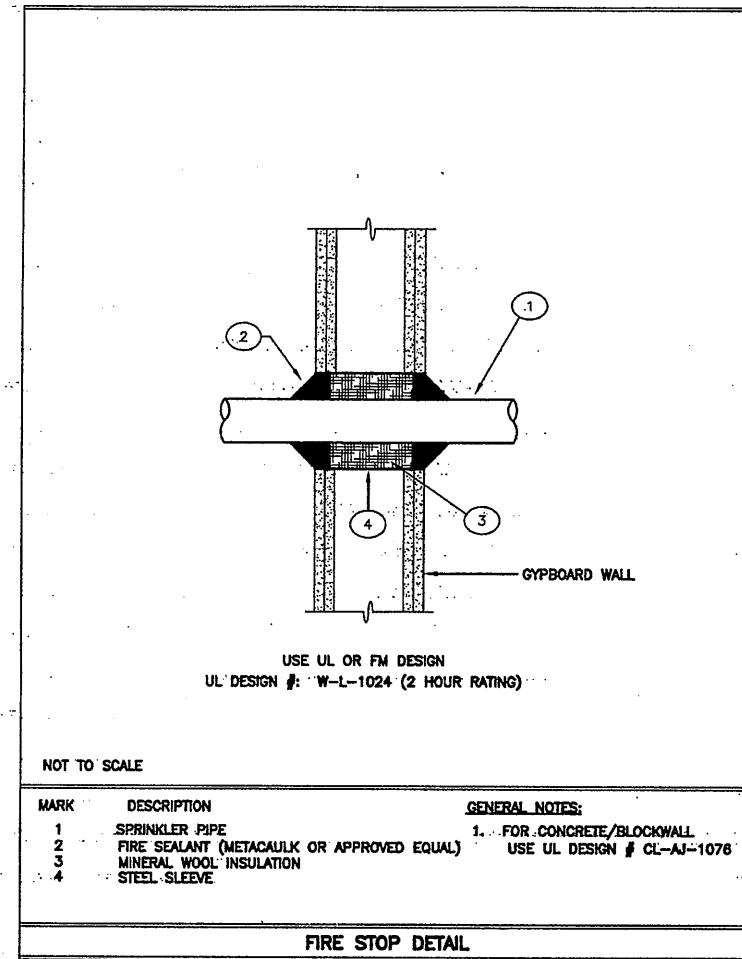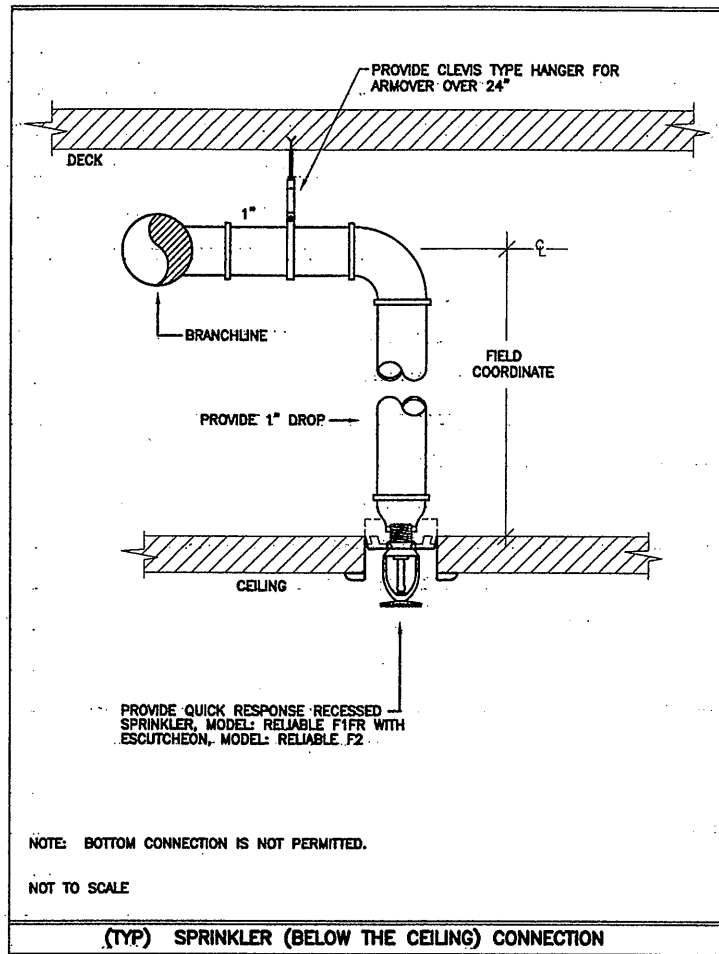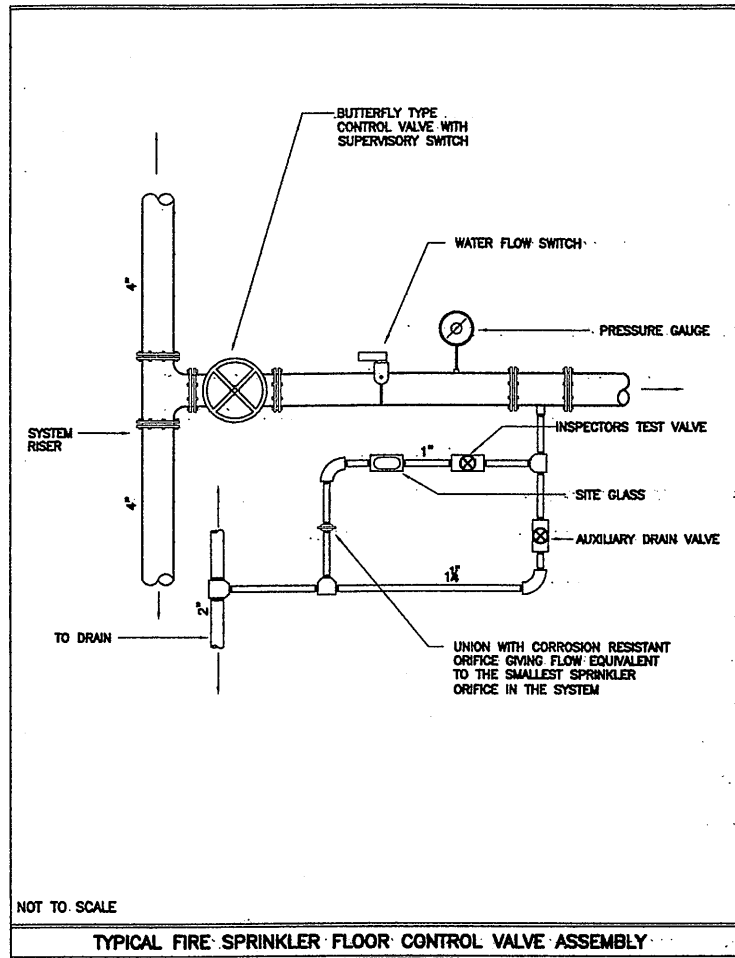

05/27/01 RAB AJK/ERH
0659FP007

NOTE:

REFER TO ATTACHED DAVIS ULMER RECORD DRAWINGS (FP-1, FP-2, FP-3 AND FP-1AB) FOR FIRE PROTECTION RECORD DRAWING INFORMATION.

RECORD DRAWING

THESE DRAWINGS HAVE BEEN REVISED TO REFLECT MAJOR CHANGES, IF ANY, WHICH OCCURRED DURING CONSTRUCTION. REVISIONS ARE BASED UPON INFORMATION SUPPLIED BY CONTRACTOR.

DATE: 12/13/05 PER: [Signature]

THIS DRAWING WAS PREPARED AT THE SCALE INDICATED IN THE TITLE BLOCK. INACCURACIES IN THE STATED SCALE MAY BE INTRODUCED WHEN DRAWINGS ARE REPRODUCED BY ANY MEANS. USE THE GRAPHIC SCALE BAR IN THE TITLE BLOCK TO DETERMINE THE ACTUAL SCALE OF THIS DRAWING.

NOT TO SCALE

| No. | Date | Revisions | Init |
|-----|---------|---------------------|------|
| 0 | 4/20/01 | ISSUED FOR APPROVAL | |
| 1 | | AS BID | |
| 2 | 1/30/05 | RECORD DRAWING | RCG |

In charge of FJS
 Designed by ERH
 Drawn by AJK
 Checked by FJS

ENVIRONMENTAL ENGINEERS ASSOCIATES, LLP
SYRACUSE, NEW YORK

RAM-TECH
ENGINEERS, P.C.
CONSULTING ENGINEERS
SYRACUSE, NEW YORK

ONONDAGA COUNTY • DEPARTMENT OF DRAINAGE AND SANITATION • SYRACUSE, NEW YORK
METROPOLITAN SYRACUSE WASTEWATER TREATMENT PLANT
STAGE III AMMONIA AND STAGE II PHOSPHORUS REMOVAL PROJECT

**OPERATIONS CENTER
DETAILS**


FIRE PROTECTION

File Number
00659


Date
APRIL 2001

FP-007


NO ALTERATIONS PERMITTED HEREON EXCEPT AS PROVIDED UNDER SECTION 7209 SUBDIVISION 2 OF THE NEW YORK STATE EDUCATION LAW

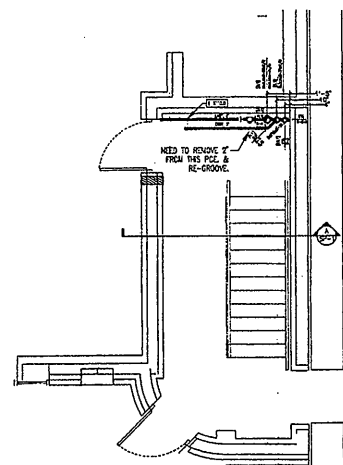


STAIR #1 - 1ST FLR
SCALE: 1/4" = 1'-0"

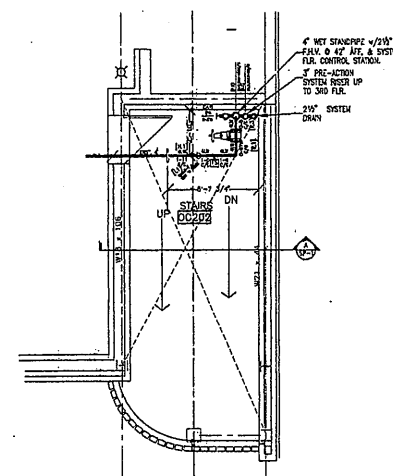


STAIR #1 - 2ND FLR
SCALE: 1/4" = 1'-0"

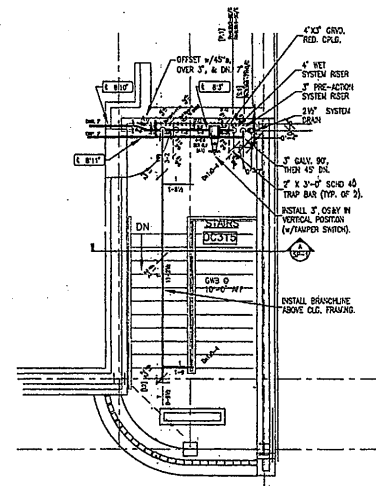


STAIR #1 - 3RD FLR
SCALE: 1/4" = 1'-0"

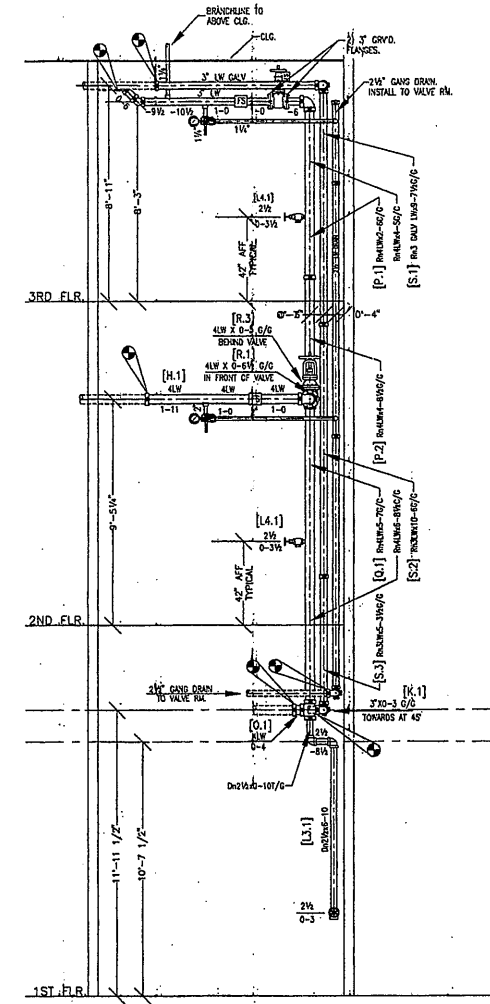


A STAIR #1 - ELEVATION
SCALE: 3/8" = 1'-0"

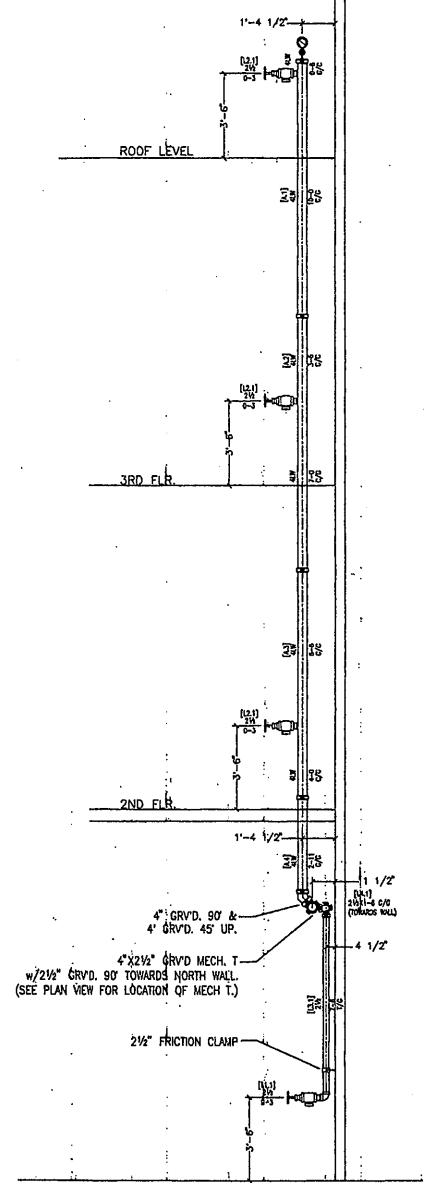


B STAIR #2 - ELEVATION
SCALE: 3/8" = 1'-0" (LOOKING NORTH)

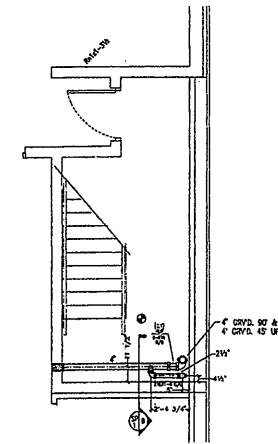


STAIR #2 (BACK) - 1ST FLR
SCALE: 1/4" = 1'-0"

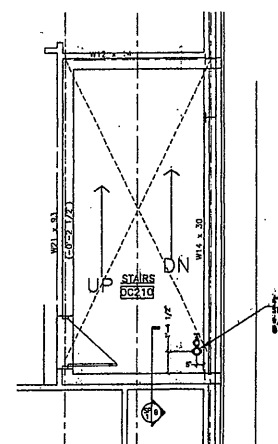

STAIR #2 (BACK) - 2ND FLR
SCALE: 1/4" = 1'-0"

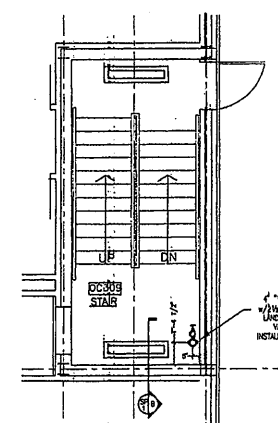

STAIR #2 (BACK) - 3RD FLR
SCALE: 1/4" = 1'-0"

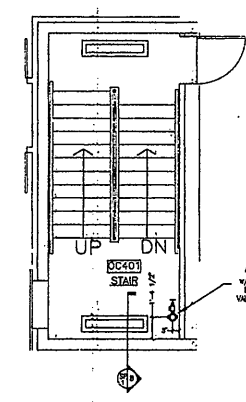


STAIR #2 (BACK) - ROOFLEVEL
SCALE: 1/4" = 1'-0"

'AS BUILT' DRAWING
DATE: 8/15/04


FP SYMBOL LEGEND:

| | | | |
|--|----------------------|--|------------------------|
| | = UPRIGHT SPRINKLER | | = HYDRAULIC REF. POINT |
| | = HANGER | | = CLG/DECK ELEVATION |
| | = RISE/DROP FROM TEE | | = PIPE & AFF |
| | = RISE/DROP FROM 90° | | = CONNECT TO EXISTING |
| | = GROOVED COUPLING | | |

| HYDRAULIC DESIGN DATA CALCULATION # 1 CALCULATION # 2 CALCULATION # 3 Hazard Class: _____ System Type: _____ Density: _____ Coverage Area: _____ Alarm: _____ Diameter: _____ Pressure: _____ Location: _____ Date: _____ Test By: _____ | | | CONTRACTOR: DAVIS-ULMER SPRINKLER CO., INC. Since 1946 Address: Liverpool, NY REVISION DATE: _____ DESCRIPTION: _____ BY: _____ | | | SPRINKLER SCHEDULE & LEGEND <table border="1"> <tr> <th>SYMBOL</th> <th>SPRINKLER DESCRIPTION</th> <th>CLG</th> <th>DECK</th> <th>TRIP</th> <th>FRONT</th> <th>ORF.</th> </tr> <tr> <td> </td> <td> </td> <td> </td> <td> </td> <td> </td> <td> </td> <td> </td> </tr> </table> | | | SYMBOL | SPRINKLER DESCRIPTION | CLG | DECK | TRIP | FRONT | ORF. | | | | | | | |
|--|-----------------------|-----|--|------|-------|--|--|--|--------|-----------------------|-----|------|------|-------|------|--|--|--|--|--|--|--|
| SYMBOL | SPRINKLER DESCRIPTION | CLG | DECK | TRIP | FRONT | ORF. | | | | | | | | | | | | | | | | |
| | | | | | | | | | | | | | | | | | | | | | | |
| IMPORTANT TO PREVENT FREEZING OF WATER IN WET PIPE SPRINKLER PIPING, OWNERS TO PROVIDE SUFFICIENT HEAT THROUGHOUT AREAS WHERE SPRINKLER PIPES ARE INSTALLED, UNLESS AN ANTI-FREEZE SYSTEM. | | | DAVIS-ULMER SINCE 1946 7897 Edgecomb Dr., Liverpool, NY PHONE (315) 451-0921 FAX (315) 451-3950 | | | SYRACUSE METRO WATER TREATMENT PLANT NORTH Hoitatho Blvd., Syracuse, NY Fire Protection - Stair #1 & 2 DAVIS-ULMER SPRINKLER CO., INC. "Serving New York State Since 1946" DESIGNER: KEB SCALE: AS NOTED CHECK BY: _____ FILE NUMBER: 02321 APPROVAL: AHI DATE: 6/28/04 DWG. NO. SP-1 | | | | | | | | | | | | | | | | |

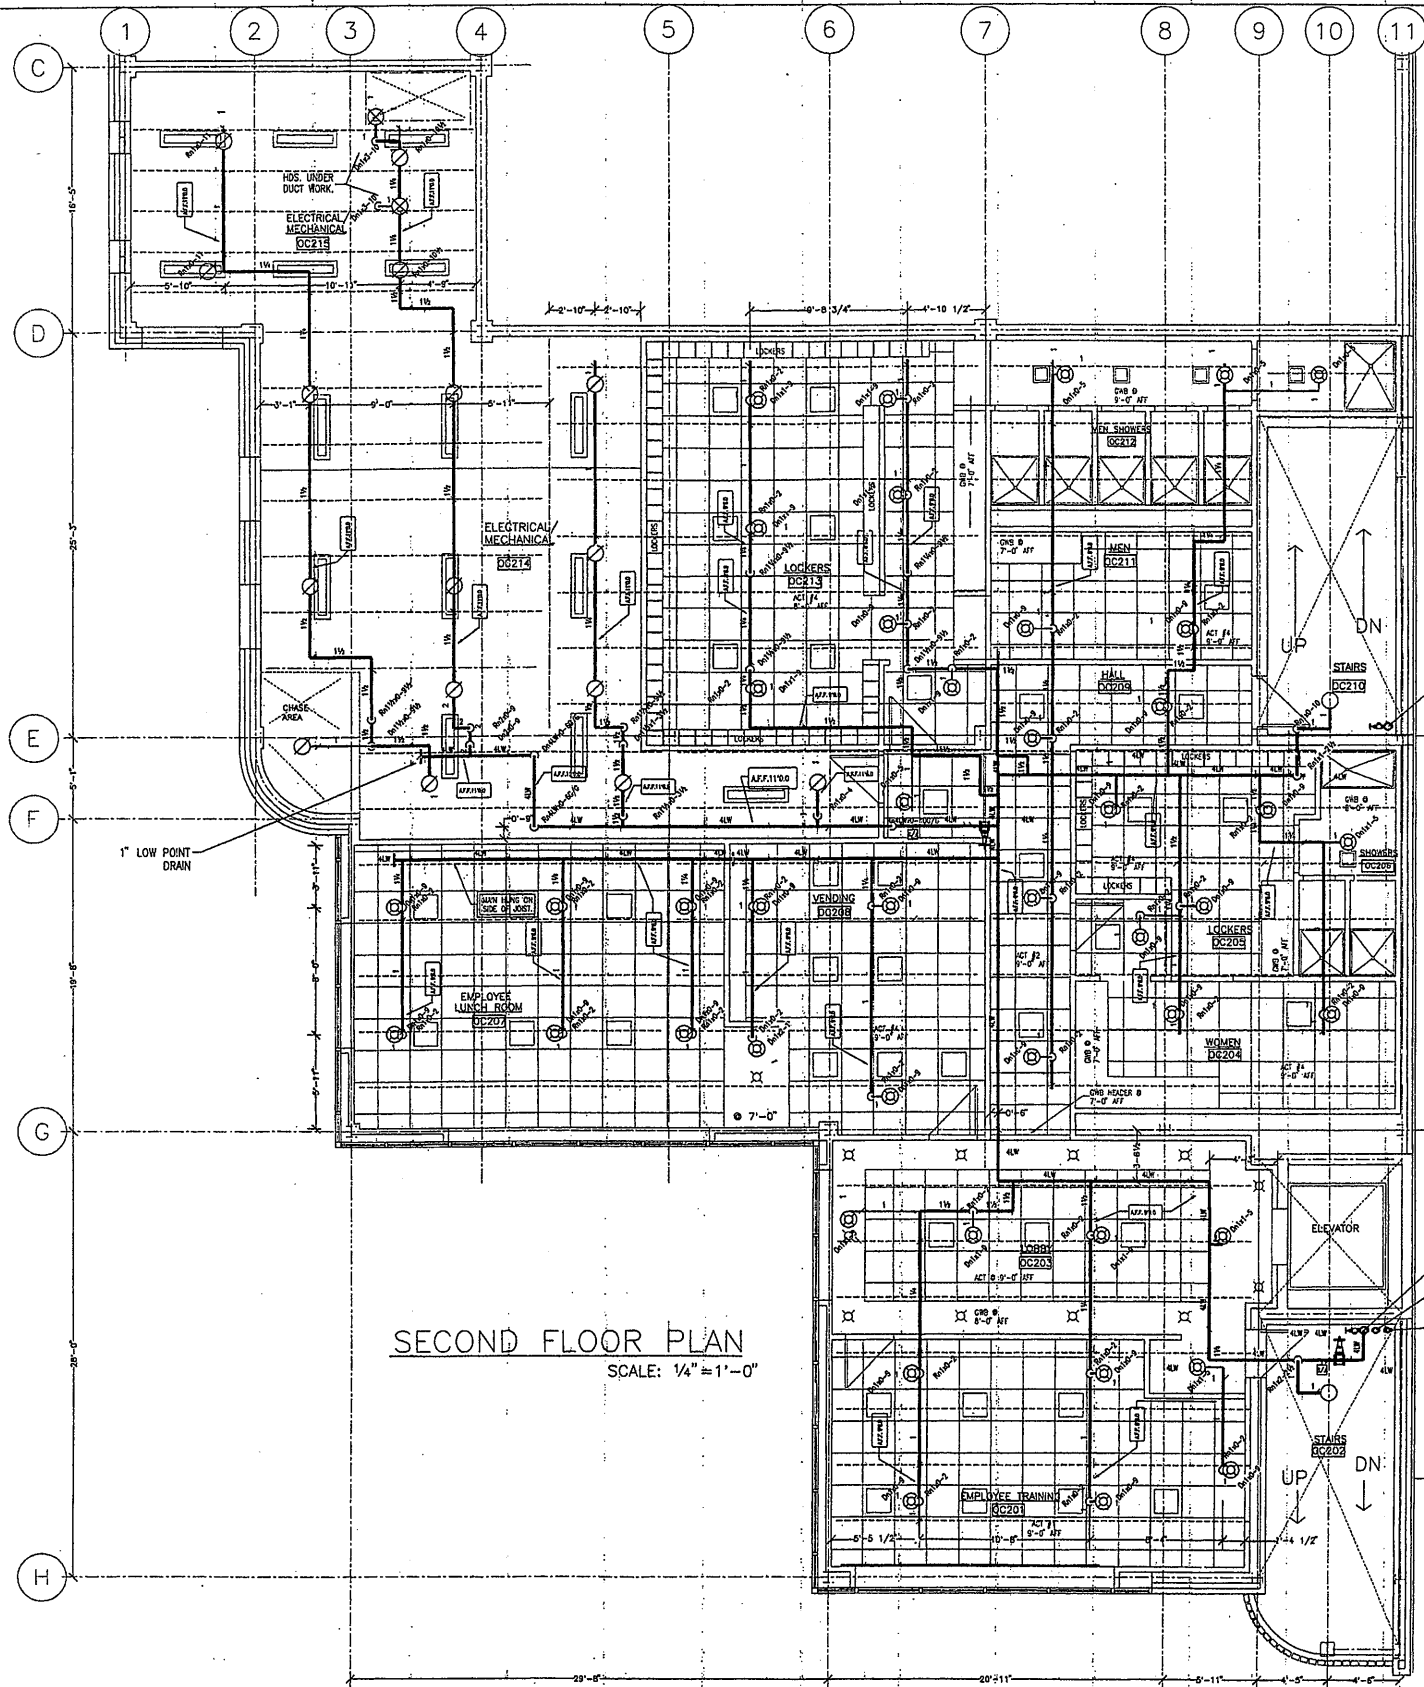

SECOND FLOOR PLAN
SCALE: 1/4" = 1'-0"

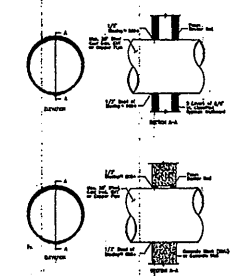

FIRE STOP DETAILS
NOT TO SCALE

SYSTEM DESIGN NOTES

Dry system designed IAW NFPA-13 for Ordinary CP, 2 Hazard, Calculated at a density of .20GPM/100 SQ. FT. with a maximum Hedd Spacing of 130 SQ. FT. w/250 GPM Hose Allowance.
Pre-Action system designed IAW NFPA-13 for Ordinary CP, 1 Hazard, Calculated at a density of .15GPM/100 SQ. FT. with a maximum Hedd Spacing of 130 SQ. FT. w/250 GPM Hose Allowance.
Wet system designed IAW NFPA-13 for Ordinary CP, 1 Hazard, Calculated at a density of .15GPM/100 SQ. FT. with a maximum Hedd Spacing of 130 SQ. FT. w/250 GPM Hose Allowance.
(Area of operation reduced to 950 SQ. FT. through the use of Quick Response sprinklers as per NFPA-13 (99 EQL), Section 7-2.3.2.4)

NFPA NOTE:

4-14.3.3 In dry pipe systems and portions of preaction systems subject to freezing, branch lines shall be pitched at least 1/2" in per 10 ft. and mains shall be pitched at least 1/4" in per 10 ft.

HANGERS

Pipe hangers shall be installed as required by NFPA for supporting sprinkler piping. No other piping and/or devices are to be attached to the sprinkler pipe hanger system unless the hanger has been specifically designed for the additional loading.

HANGER MATERIALS

All Thread Rod - Black Carbon Steel
Misc. Hanger Material (eg. Top Beam Clamp) - Black


PIPE MATERIALS

All pipe for dry & pre-action system to be galvanized steel. Pipe shall be as per the following schedule - (Unless Noted Otherwise)
Line Piping - Galvanized Schedule 40
X-Main Piping - Galvanized Schedule 10
Bulk Main Piping - Galvanized Schedule 10
Riser Piping - Galvanized Schedule 10


All pipe for wet system & standpipes to be black steel. Pipe shall be as per the following schedule - (Unless Noted Otherwise)
Line Piping - Black Schedule 40
X-Main Piping - Black Schedule 10
Bulk Main Piping - Black Schedule 10
Riser Piping - Black Schedule 10

FITTINGS


Dry & Pre-Action System:
Screwed Fittings - Galvanized
Grooved Fittings - Galvanized
Grooved Couplings - Galvanized
Wet System:
Screwed Fittings - Black
Grooved Fittings - Black
Grooved Couplings - Black

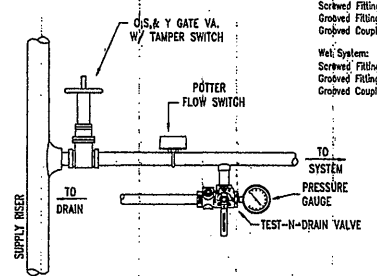

FLR CONTROL ASSEMBLY
NOT TO SCALE

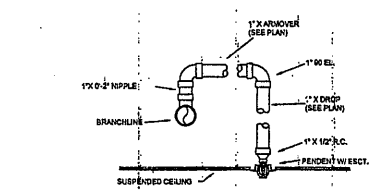

TYP. RETURN BEND ASSEMBLY

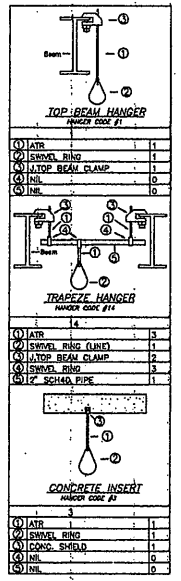

HANGER DETAILS
NOT TO SCALE

FP SYMBOL LEGEND:

| | |
|--------------------|----------------------|
| Upright Sprinkler | Hydraulic Ref. Point |
| Hanger | CLG/DECK ELEVATION |
| Rise/Drop from Tee | PIPE & AFF |
| Rise/Drop from 90° | CONNECT TO EXISTING |
| Grooved Coupling | |

'AS BUILT' DRAWING
DATE: 8/15/04

HYDRAULIC DESIGN DATA

| ITEM | DESCRIPTION | UNIT | VALUE |
|------|---------------|------------|-------|
| 1 | Office Site | Flow (GPM) | 100 |
| 2 | No. of Outlet | Flow (GPM) | 100 |
| 3 | Flow (GPM) | Flow (GPM) | 100 |

CONTRACTOR: DAVIS-ULMER SPRINKLER CO., INC.


Address: Liverpool, NY

REVISION

| NO. | DESCRIPTION | DATE |
|-----|-------------|------|
| 1 | | |

SPRINKLER SCHEDULE & LEGEND


| SPRINKLER DESCRIPTION | OFFICE | TRIP | PKIN | QUANTITY |
|---------------------------------|--------|------|------|----------|
| RELIABLE MOD. FTR REC. PEN. | 1/2" | 125' | CH | 51 |
| RELIABLE MOD. F1 SSU | 1/2" | 125' | BR | 2 |
| RELIABLE MOD. F1 SSU (W/SHIELD) | 1/2" | 212' | BR | 2 |
| RELIABLE MOD. C SSU | 1/2" | 212' | BR | 16 |

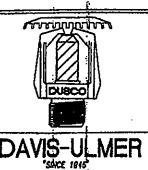

Syracuse Metro: Water Treatment Plant
Stage 3 Armonia & Stage 2 Phosphorus Removal Project
Fire Protection
DAVIS-ULMER SPRINKLER CO., INC.
"Serving New York State Since 1946"
7637 Edgecomb Dr., Liverpool, NY
PHONE (315) 451-0971 FAX (315) 451-3880


NORTH

| | |
|-------------|----------|
| DESIGNER | KEB |
| SCALE | AS NOTED |
| CHECK BY | MKS |
| FILE NUMBER | 02321 |
| APPROVAL | ASB |
| DATE | 5/11/04 |
| DRAWING NO. | FP-2 |

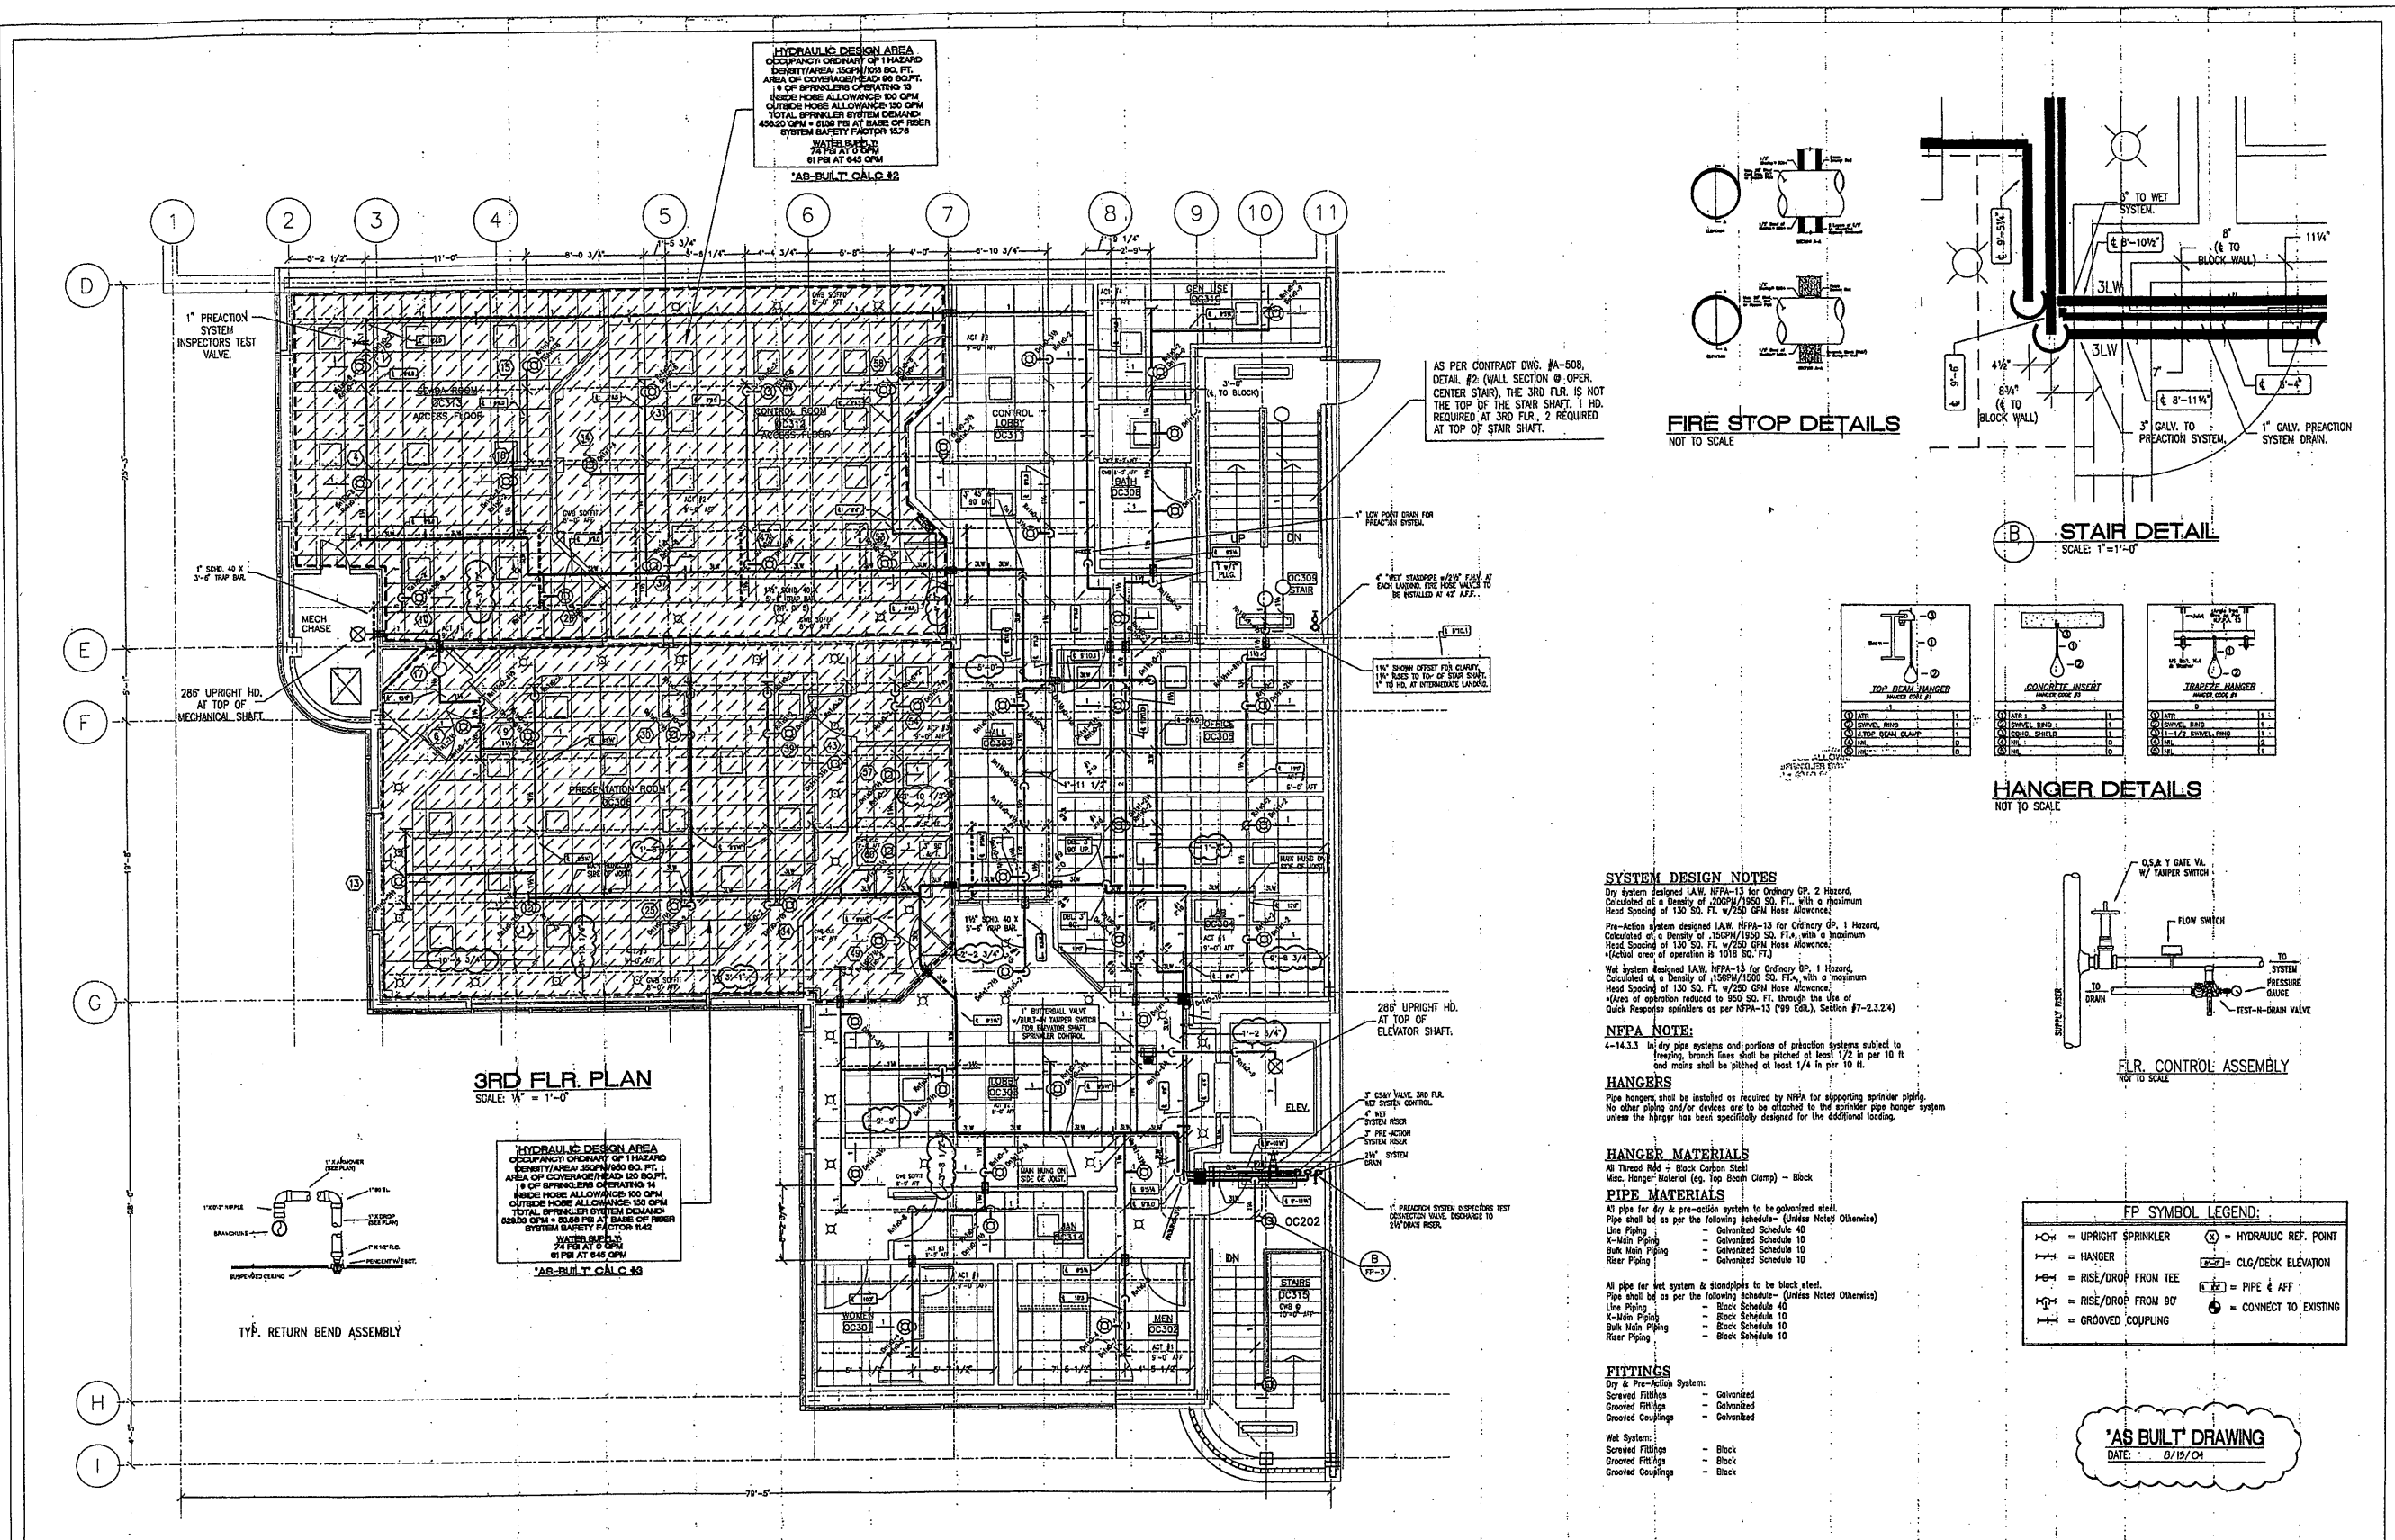


HYDRAULIC DESIGN AREA
 OCCUPANCY CATEGORY OF HAZARDOUS
 DENSITY/AREA: 500PM/100 SQ. FT.
 AREA OF COVERAGE/HEAD: 90 SQ. FT.
 # OF SPRINKLERS OPERATING: 14
 INSIDE HOSE ALLOWANCE: 100 GPM
 OUTSIDE HOSE ALLOWANCE: 150 GPM
 TOTAL SPRINKLER SYSTEM DEMAND:
 4540 GPM @ 8.100 PSI AT BASE OF RISER
 SYSTEM SAFETY FACTOR: 1.25
 WATER SUPPLY:
 4 PSI AT 0 PSI
 6 PSI AT 845 GPM
 *AS-BUILT CALC #2

HYDRAULIC DESIGN AREA
 OCCUPANCY CATEGORY OF HAZARDOUS
 DENSITY/AREA: 500PM/100 SQ. FT.
 AREA OF COVERAGE/HEAD: 90 SQ. FT.
 # OF SPRINKLERS OPERATING: 14
 INSIDE HOSE ALLOWANCE: 100 GPM
 OUTSIDE HOSE ALLOWANCE: 150 GPM
 TOTAL SPRINKLER SYSTEM DEMAND:
 4540 GPM @ 8.100 PSI AT BASE OF RISER
 SYSTEM SAFETY FACTOR: 1.25
 WATER SUPPLY:
 4 PSI AT 0 PSI
 6 PSI AT 845 GPM
 *AS-BUILT CALC #3

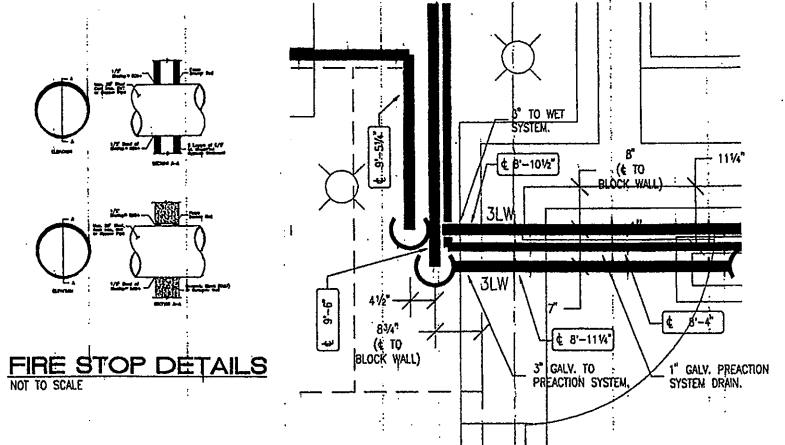

FIRE STOP DETAILS
 NOT TO SCALE

STAIR DETAIL
 SCALE: 1"=1'-0"

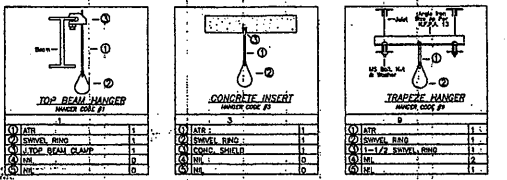

HANGER DETAILS
 NOT TO SCALE

SYSTEM DESIGN NOTES

Dry system designed IAW NFPA-13 for Ordinary CP, 2 Hazard, Calculated at a Density of 200PM/100 SQ. FT. with a maximum Head Spacing of 130 SQ. FT. w/250 GPM Hose Allowance.
 Pre-action system designed IAW NFPA-13 for Ordinary CP, 1 Hazard, Calculated at a Density of 150PM/100 SQ. FT. with a maximum Head Spacing of 130 SQ. FT. w/250 GPM Hose Allowance.
 Wet system designed IAW NFPA-13 for Ordinary CP, 1 Hazard, Calculated at a Density of 150PM/100 SQ. FT. with a maximum Head Spacing of 130 SQ. FT. w/250 GPM Hose Allowance.
 (Actual area of operation is 1018 SQ. FT.)
 (Area of operation reduced to 850 SQ. FT. through the use of Quick Response sprinklers as per NFPA-13 (99 Ed.), Section 7-2.1.2.4)

NFPA NOTE:

4-14.3.3 In dry pipe systems and portions of pre-action systems subject to freezing, branch lines shall be pitched at least 1/2" in per 10 ft and masts shall be pitched at least 1/4" in per 10 ft.

HANGERS

Pipe hangers shall be installed as required by NFPA for supporting sprinkler piping. No other piping and/or devices are to be attached to the sprinkler pipe hanger system unless the hanger has been specifically designed for the additional loading.

HANGER MATERIALS


All Thread Rod - Black Carbon Steel
 Misc. Hanger Material (eg. Top Beam Clamp) - Black

PIPE MATERIALS

All pipe for dry & pre-action system to be galvanized steel.
 Pipe shall be as per the following schedule - (Unless Noted Otherwise)
 Line Piping - Galvanized Schedule 40
 X-Main Piping - Galvanized Schedule 10
 Bulk Main Piping - Galvanized Schedule 10
 Rear Piping - Galvanized Schedule 10
 All pipe for wet system & standpipes to be black steel.
 Pipe shall be as per the following schedule - (Unless Noted Otherwise)
 Line Piping - Black Schedule 40
 X-Main Piping - Black Schedule 10
 Bulk Main Piping - Black Schedule 10
 Rear Piping - Black Schedule 10

FITTINGS

Dry & Pre-action System:
 Serrated Filings - Galvanized
 Grooved Filings - Galvanized
 Grooved Couplings - Galvanized
 Wet System:
 Serrated Filings - Black
 Grooved Filings - Black
 Grooved Couplings - Black

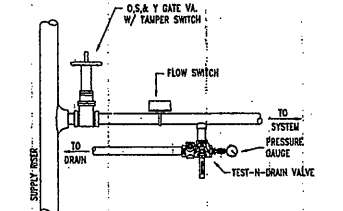

F.L.R. CONTROL ASSEMBLY
 NOT TO SCALE

FP SYMBOL LEGEND:

| | |
|--------------------|----------------------|
| Upright Sprinkler | Hydraulic Ref. Point |
| Hanger | CLG/DECK ELEVATION |
| Rise/Drop from Tee | Pipe & Aff |
| Rise/Drop from 90° | Connect to Existing |
| Grooved Coupling | |

'AS BUILT' DRAWING
 DATE: 8/15/04


HYDRAULIC DESIGN DATA

| Calculation # | Calculation # 1 | Calculation # 2 | Calculation # 3 |
|----------------|-------------------------------------|-------------------------------------|-------------------------------------|
| System Class | Ordinary CP | Ordinary CP | Ordinary CP |
| System Type | Wet | Wet | Wet |
| Design Density | 150 PM/100 SQ. FT. | 150 PM/100 SQ. FT. | 150 PM/100 SQ. FT. |
| Area | 1018 SQ. FT. | 1018 SQ. FT. | 1018 SQ. FT. |
| Head Spacing | 130 SQ. FT. | 130 SQ. FT. | 130 SQ. FT. |
| Flow Test Info | Pressure: 8.100 PSI, Flow: 4540 GPM | Pressure: 8.100 PSI, Flow: 4540 GPM | Pressure: 8.100 PSI, Flow: 4540 GPM |

CONTRACTOR: DAVIS-ULMER SPRINKLER CO., INC.
 ADDRESS: Liverpool, NY
 REVISION: _____
 DATE: _____ BY: _____

SPRINKLER SCHEDULE & LEGEND


| Symbol | Description | Qty | Unit | Material |
|--------|-----------------------------|-----|------|----------|
| ○ | RELIABLE MOD. FTR REC. PEN. | 12 | CH | 5.3 |
| ○ | RELIABLE MOD. FT SSU | 12 | BR | 4.1 |
| ○ | RELIABLE MOD. FT SSU | 12 | BR | 1.1 |

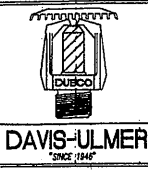


SYRACUSE METRO. WATER TREATMENT PLANT NORTH
 Stage 3 Ammonia & Stage 2 Phosphorus Removal Project
 Fire Protection - 3rd Flr.

DAVIS-ULMER SPRINKLER CO., INC.
 "Serving New York State Since 1946"
 7637 Edgecomb Dr., Liverpool, NY
 PHONE (315) 451-0971 FAX (315) 451-3890


DESIGNER: KEB
 SCALE: AS NOTED
 CHECK BY: MB
 FILE NUMBER: 02321
 APPROVAL: AHJ
 DATE: 9/15/03
 DRAWING NO. FP-9

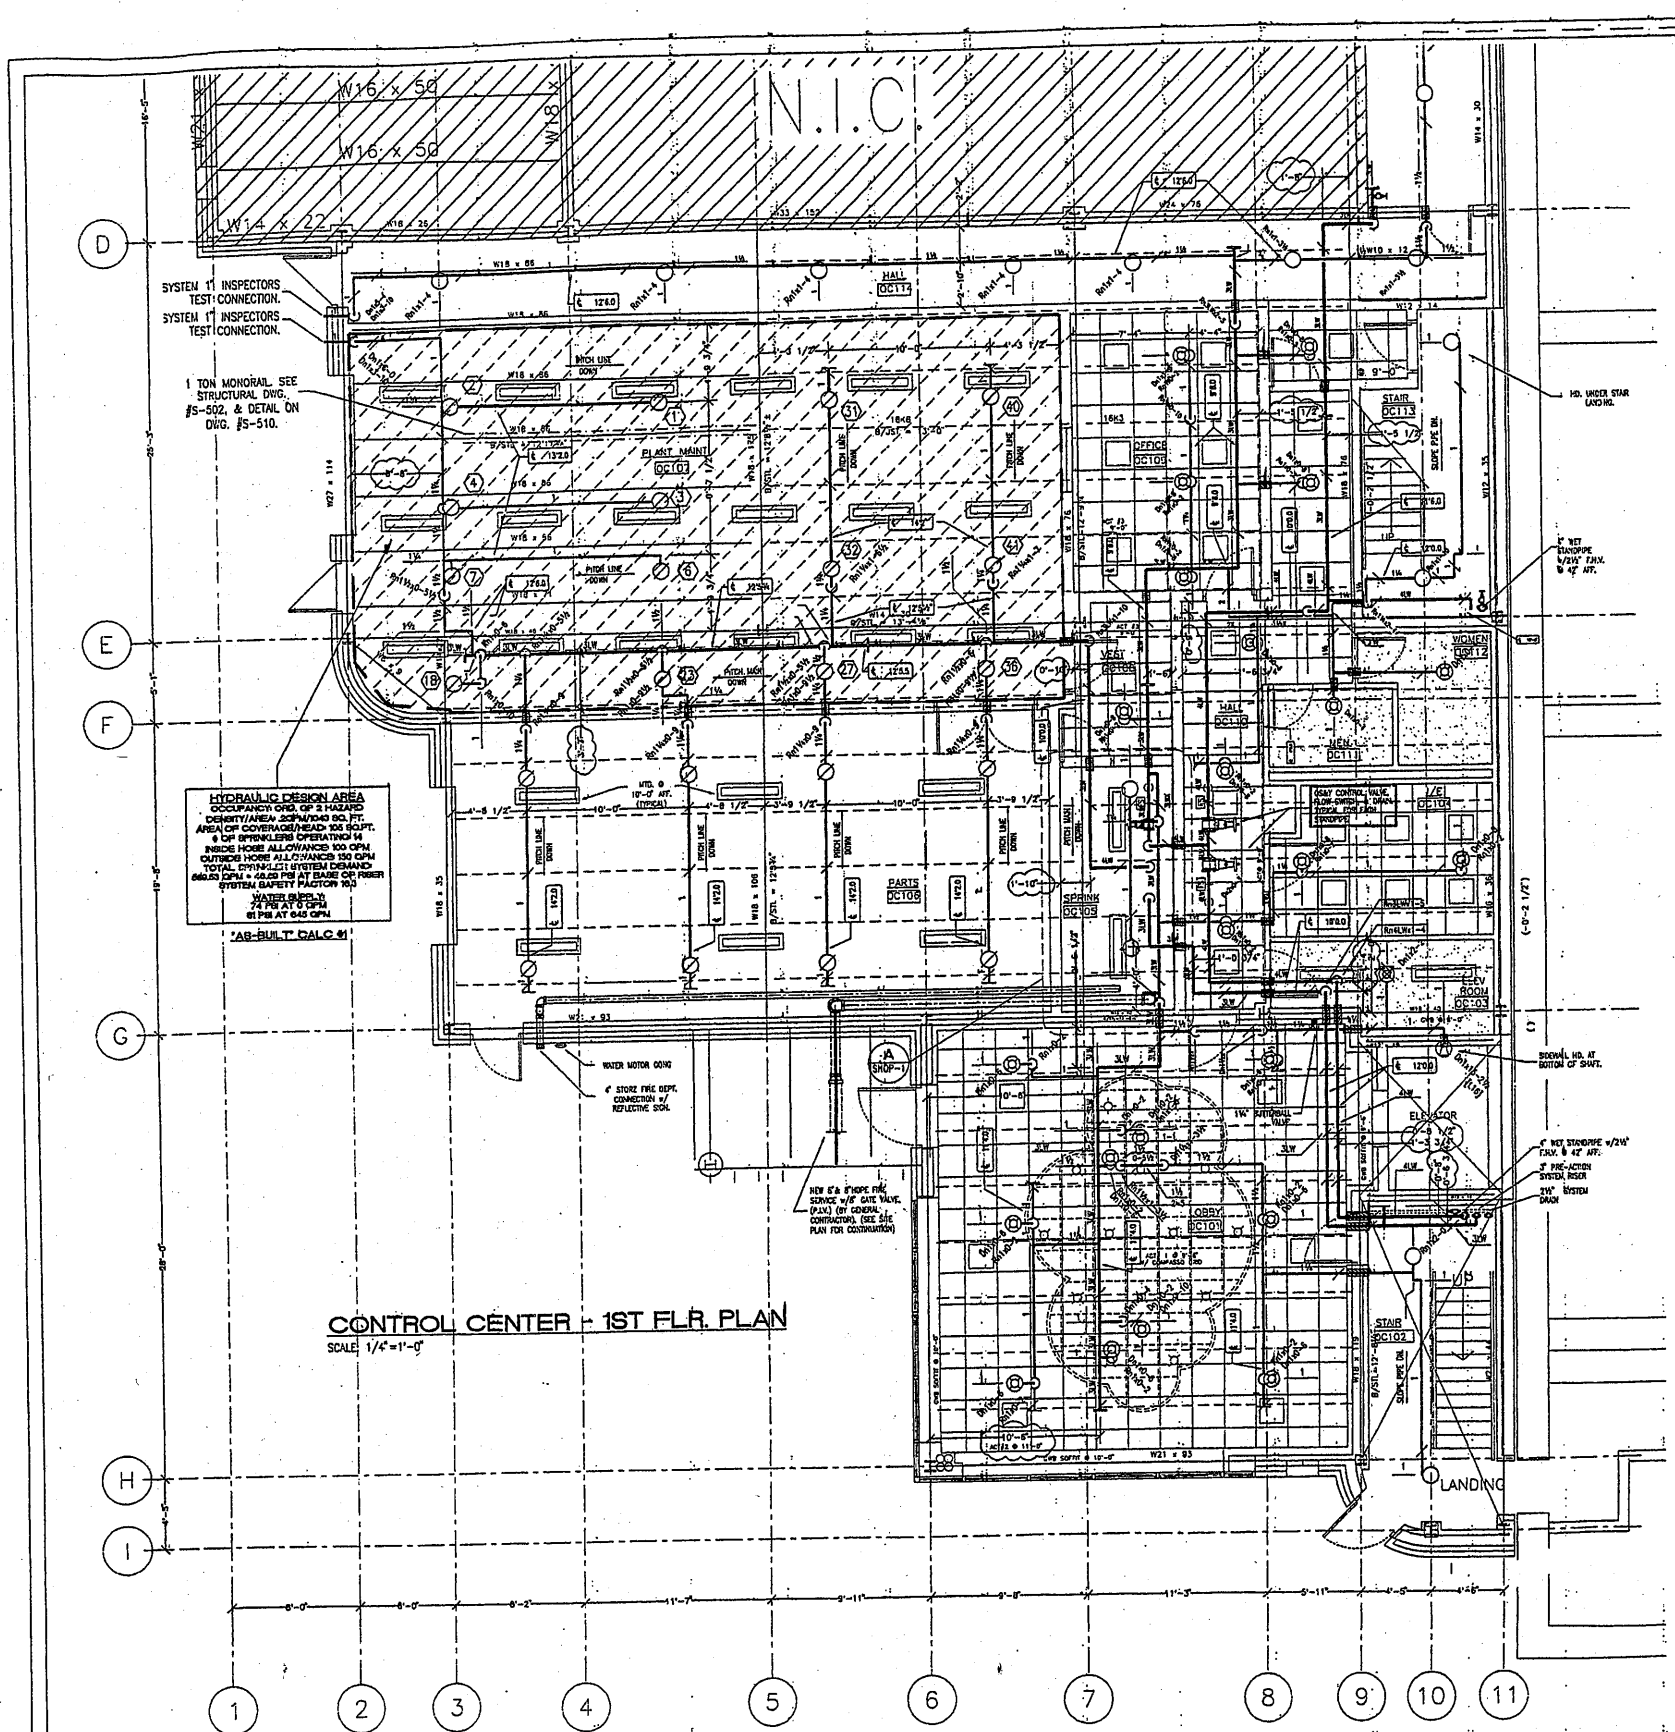

CONTROL CENTER - 1ST FLR. PLAN
SCALE: 1/8"=1'-0"

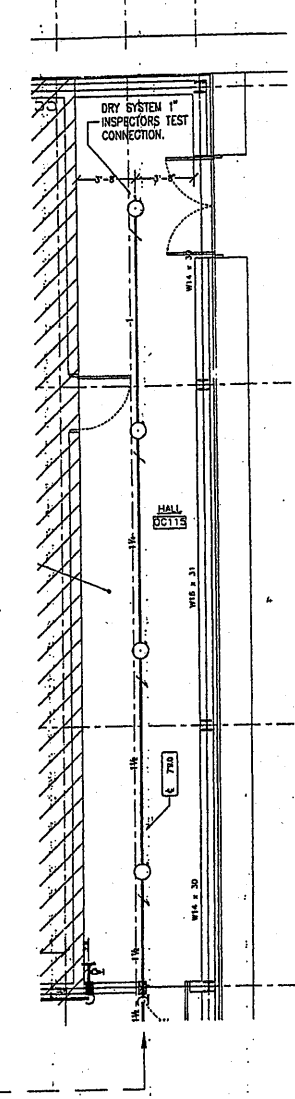

DETAIL A - RISER RM. PLAN
SCALE: 3/8"=1'-0"

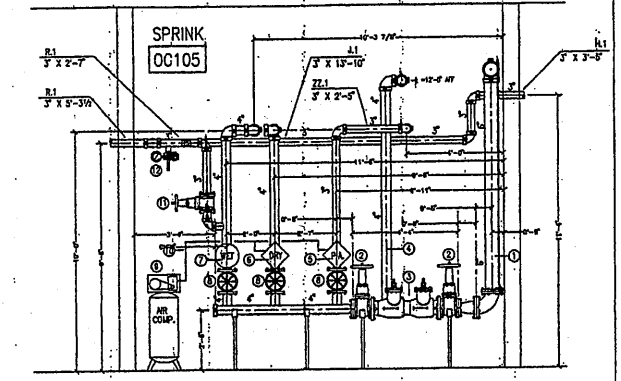


SECTION B - RISER ELEVATION
SCALE: 3/8"=1'-0"

- ① 6" FIRE PROTECTION SUPPLY
- ② 6" OS&Y VALVE w/TAMPER SWITCH
- ③ 6" WATTS #709 DOUBLE CHECK ASSEMBLY
- ④ 4" TO STORZ FDC
- ⑤ 4" DELUGE VALVE (PREACTION SYSTEM)
- ⑥ 4" DRY PIPE VALVE
- ⑦ 4" ALARM CHECK VALVE
- ⑧ 4" OS&Y VALVE w/TAMPER SWITCH
- ⑨ AIR COMPRESSOR
- ⑩ 3/4" GALVANIZED AIR LINE
- ⑪ 3" OS&Y VALVE w/TAMPER SWITCH
- ⑫ 1 1/2" TEST 'N' DRAIN VALVE

SLEEVE SCHEDULE

| PIPE | SLEEVE | CORR. | TYPE | QTY. |
|--------|--------|--------|-------|------|
| 1" | 2" | 2 1/2" | S40 | |
| 1 1/4" | 2" | 2 1/2" | S40 | |
| 1 1/2" | 2 1/2" | 3" | S40 | |
| 2" | 3" | 4" | S40 | |
| 3" | 4" | 5" | S40 | |
| 4" | 6" | 6" | 16' G | |
| 6" | 6" | 6" | 16' G | |

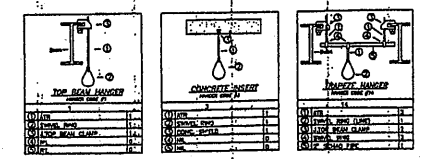


HANGER DETAILS
NOT TO SCALE

'AS BUILT' DRAWING
DATE: 10/19/04

PIPING NOTES:

1. ALL EXPOSED PIPING TO BE PRIMED & PAINTED.
2. ALL WALL PENETRATIONS TO BE SLEEVED & FIRE CALKED.
3. ALL DRY SYSTEM PIPING TO BE GALVANIZED (PRIMED & PAINTED).
4. ALL DRY SYSTEM MAINS TO BE PITCHED MIN. 1/4" PER 10'.
5. ALL DRY SYSTEM BRANCHLINES TO BE PITCHED MIN. 1/2" PER 10'.

| HYDRALIC DESIGN DATA | | | | CONTRACTOR: DAVIS-ULMER SPRINKLER CO., INC. | | | | SPRINKLER SCHEDULE & LEGEND | | | | | | | |
|----------------------|---------------|---------------|---------------|---|------------|--------------------------|-----------|-----------------------------|----|----|-----------------|-----------|-----|----|----|
| System Class | DRY | Calculation 1 | Calculation 2 | Address: Liverpool, NY | Since 1946 | Reliable FI SSU | 5.62 1/2" | 200 | BR | 21 | Reliable FI SSU | 5.62 1/2" | 155 | BR | 17 |
| System Size | DRY | | | | | Reliable FIFR OR REC PEN | 5.62 1/2" | 155 | CH | 23 | | | | | |
| Design Area | 1000 | | | | | | | | | | | | | | |
| Area per Sprinkler | 100 | | | | | | | | | | | | | | |
| Design Pressure | 100 | | | | | | | | | | | | | | |
| Flow Test Info | Pressure: 100 | Flow: 100 | Test Sp: 100 | | | | | | | | | | | | |
| Design Date | 10/19/04 | | | | | | | | | | | | | | |
| Design By | 74 | | | | | | | | | | | | | | |
| Design Check | 81 | | | | | | | | | | | | | | |
| Design Date | 8/15 | | | | | | | | | | | | | | |
| Design Check | 815 | | | | | | | | | | | | | | |
| Design Date | | | | | | | | | | | | | | | |
| Design Check | | | | | | | | | | | | | | | |

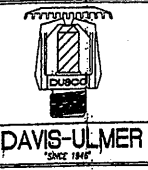

Syracuse Metro Water Treatment Plant
Stage 3 Ammonia & Stage 2 Phosphorus Removal Project
Fire Protection - 1st Flr. - AS BUILT
DAVIS-ULMER SPRINKLER CO., INC.
"Serving New York State Since 1946"
7697 Edgewood Dr., Liverpool, NY
PHONE (315) 451-0971 FAX (315) 451-3862

NORTH
DESIGNER: KEB
SCALE: AS NOTED
CHECK BY: 02321
FILE NUMBER: AHU
APPROVAL: 3/05/04
DATE: 3/05/04
DWG. NO. FP-1AB