


**HCP-1 ELEMENTARY DIAGRAM**  
TYPICAL FOR HCP-2

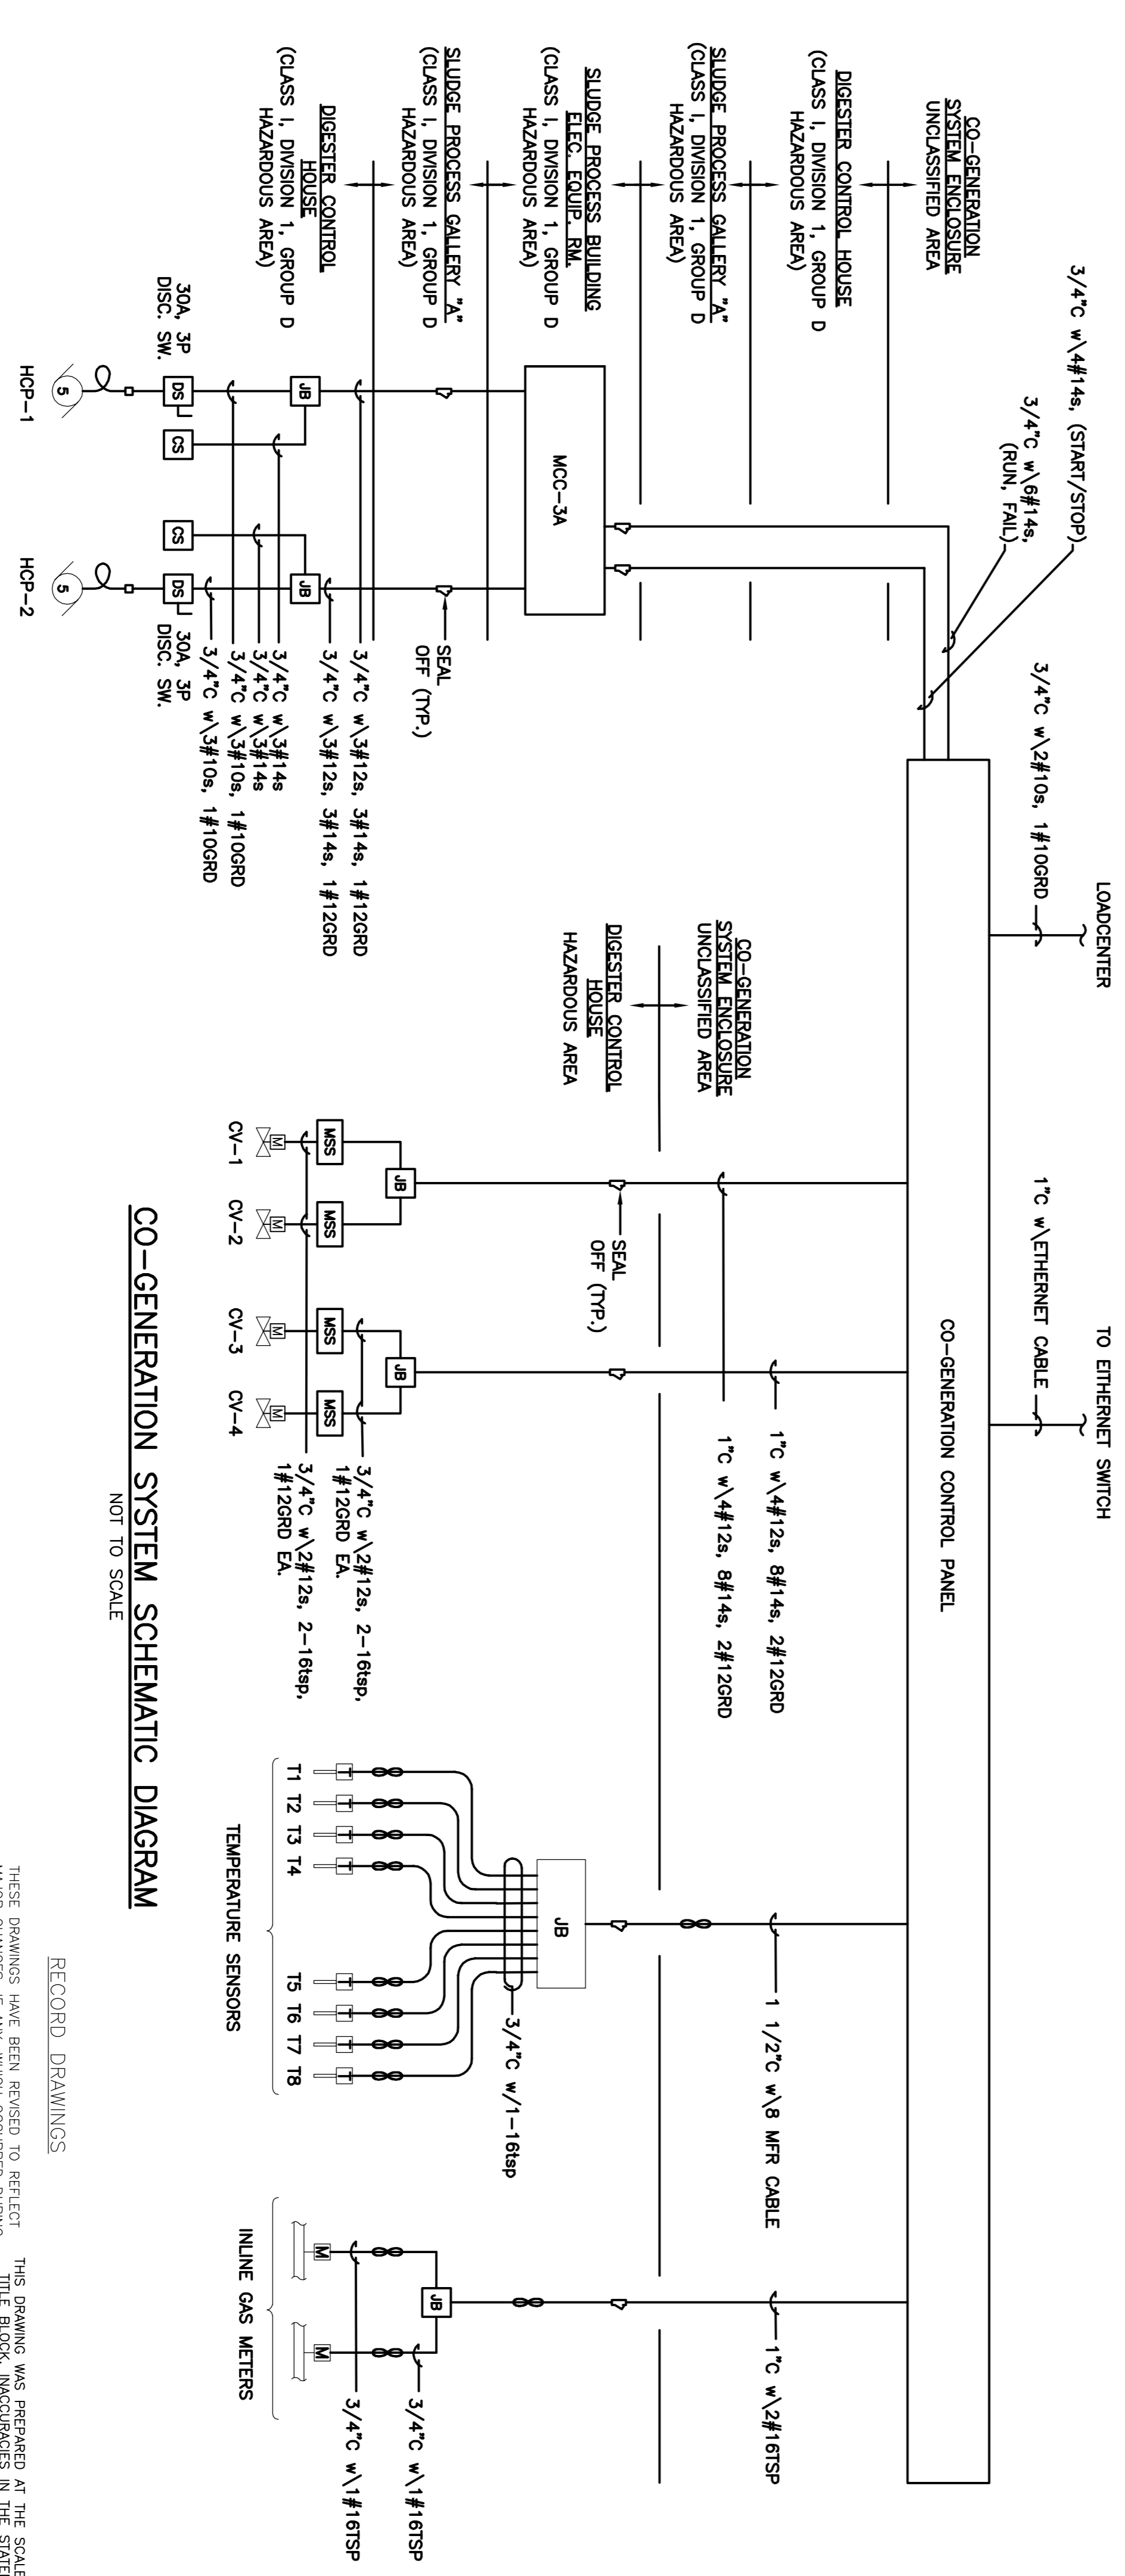


**CO-GENERATION SYSTEM SCHEMATIC DIAGRAM**  
NOT TO SCALE

RECORD DRAWINGS

THESE DRAWINGS HAVE BEEN REVISED TO REFLECT MAJOR CHANGES, IF ANY, WHICH OCCURRED DURING CONSTRUCTION AS DOCUMENTED BY ENGINEER. DATE: 2/10/2012, PER: GCH

ONONDAGA COUNTY • DEPARTMENT OF WATER ENVIRONMENT PROTECTION • SYRACUSE, NEW YORK  
METROPOLITAN SYRACUSE WASTEWATER TREATMENT PLANT  
BIOSOLIDS HANDLING IMPROVEMENTS PROJECT

**ELEMENTARY SCHEMATICS AND CO-GENERATION SYSTEM DIAGRAMS**  
ELECTRICAL

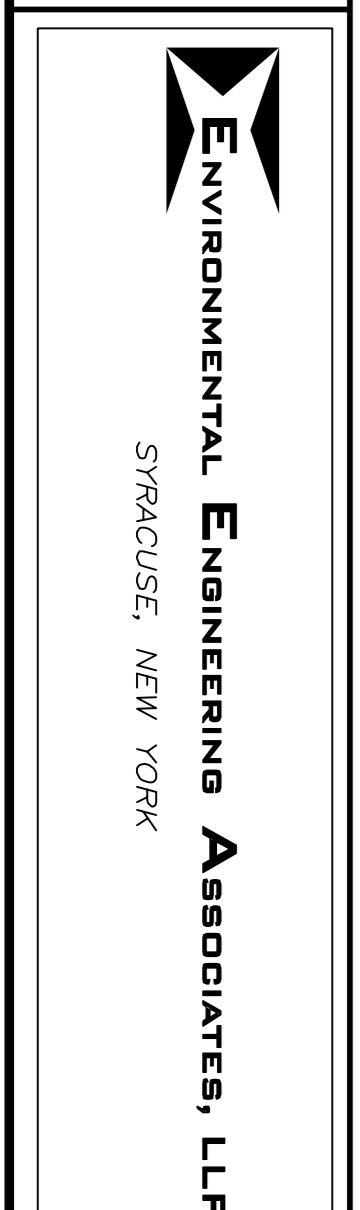

No.	Date	Revisions	Int.	In charge of
1	04/05	FOR REVIEW	GCH	NGH
2	07/05	ISSUED FOR APPROVAL	GCH	BTN
3	09/05	FOR CONSTRUCTION	GCH	BTN
4	03/11	AS BUILT		TWD

NO ALTERATIONS PERMITTED HEREON EXCEPT AS PROVIDED UNDER SECTION 2209 SUBDIVISION 2 OF THE NEW YORK STATE EDUCATION LAW

File Number	00662
Date	09/05
Sheet	E-34