


Contract Drawings

CLAY SANITARY DISTRICT

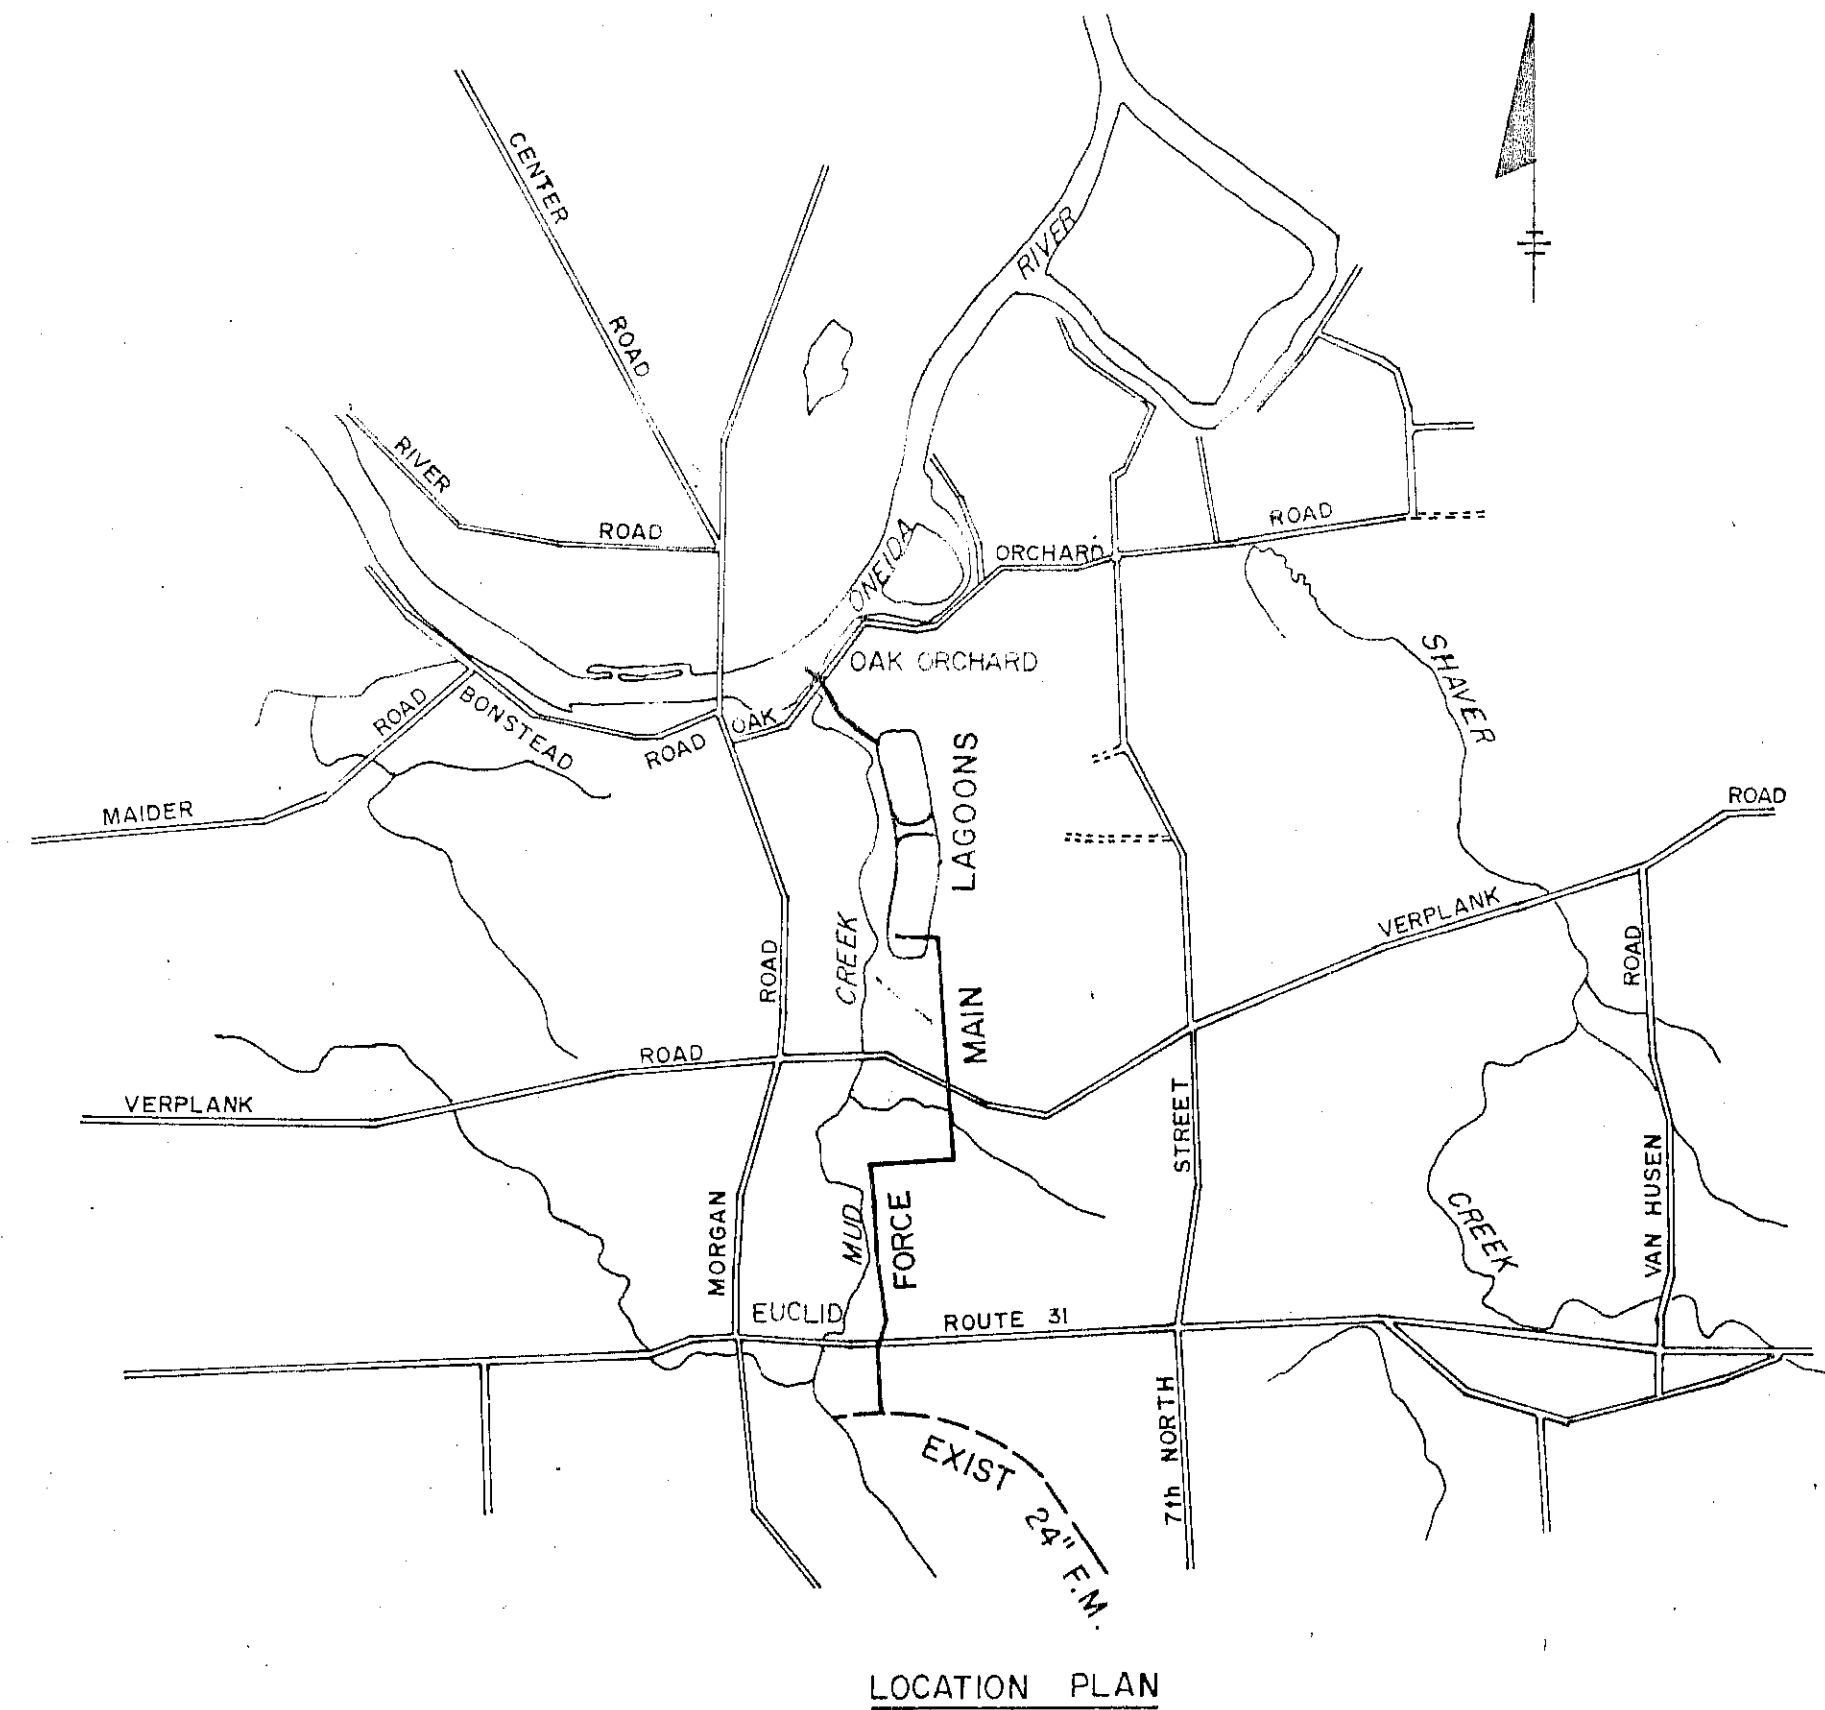

OAK ORCHARD FORCE MAIN & EFFLUENT SEWER CONTRACT IA

COUNTY OF ONONDAGA, NEW YORK
DEPARTMENT OF PUBLIC WORKS
DIVISION OF DRAINAGE & SANITATION

JOHN H. MULROY - COUNTY EXECUTIVE
JOHN J. HENNIGAN JR - DEPUTY COMMISSIONER

APPROVED BY ONONDAGA COUNTY
DEPARTMENT OF PUBLIC WORKS
DIVISION OF DRAINAGE SANITATION AND WATER SUPPLY

John J. Hennigan Jr.
DEPUTY COMMISSIONER

O'BRIEN & GERE
ENGINEERS, INC.

John J. Hennigan

INDEX TO DRAWINGS

1. GENERAL PLAN
2. PLAN & PROFILE
3. PLAN & PROFILE
4. PLAN & PROFILE
5. PLAN & PROFILE
- ~~6. PLAN & PROFILE~~
- ~~7. PLAN & PROFILE~~
- ~~8. CROSS SECTIONS~~
9. MISCELLANEOUS DETAILS
10. MISCELLANEOUS DETAILS
11. MISCELLANEOUS DETAILS
19. PLAN & PROFILE
20. PLAN & PROFILE
21. MISCELLANEOUS DETAILS
22. MISCELLANEOUS DETAILS
23. PLAN & SECTIONS
24. PLANS & ELEVATIONS
25. SECTIONS & DETAILS
26. POWER & LIGHTING PLAN
27. SCHEDULES & ONE LINE DIAGRAMS
28. OUTSIDE PIPING, GRADING & DRAINAGE

RECORD DRAWINGS
To the best of our knowledge, information and belief, these record drawings substantially represent the project as constructed.

DATE: 11/13/10
BY: [Signature]

115.216